

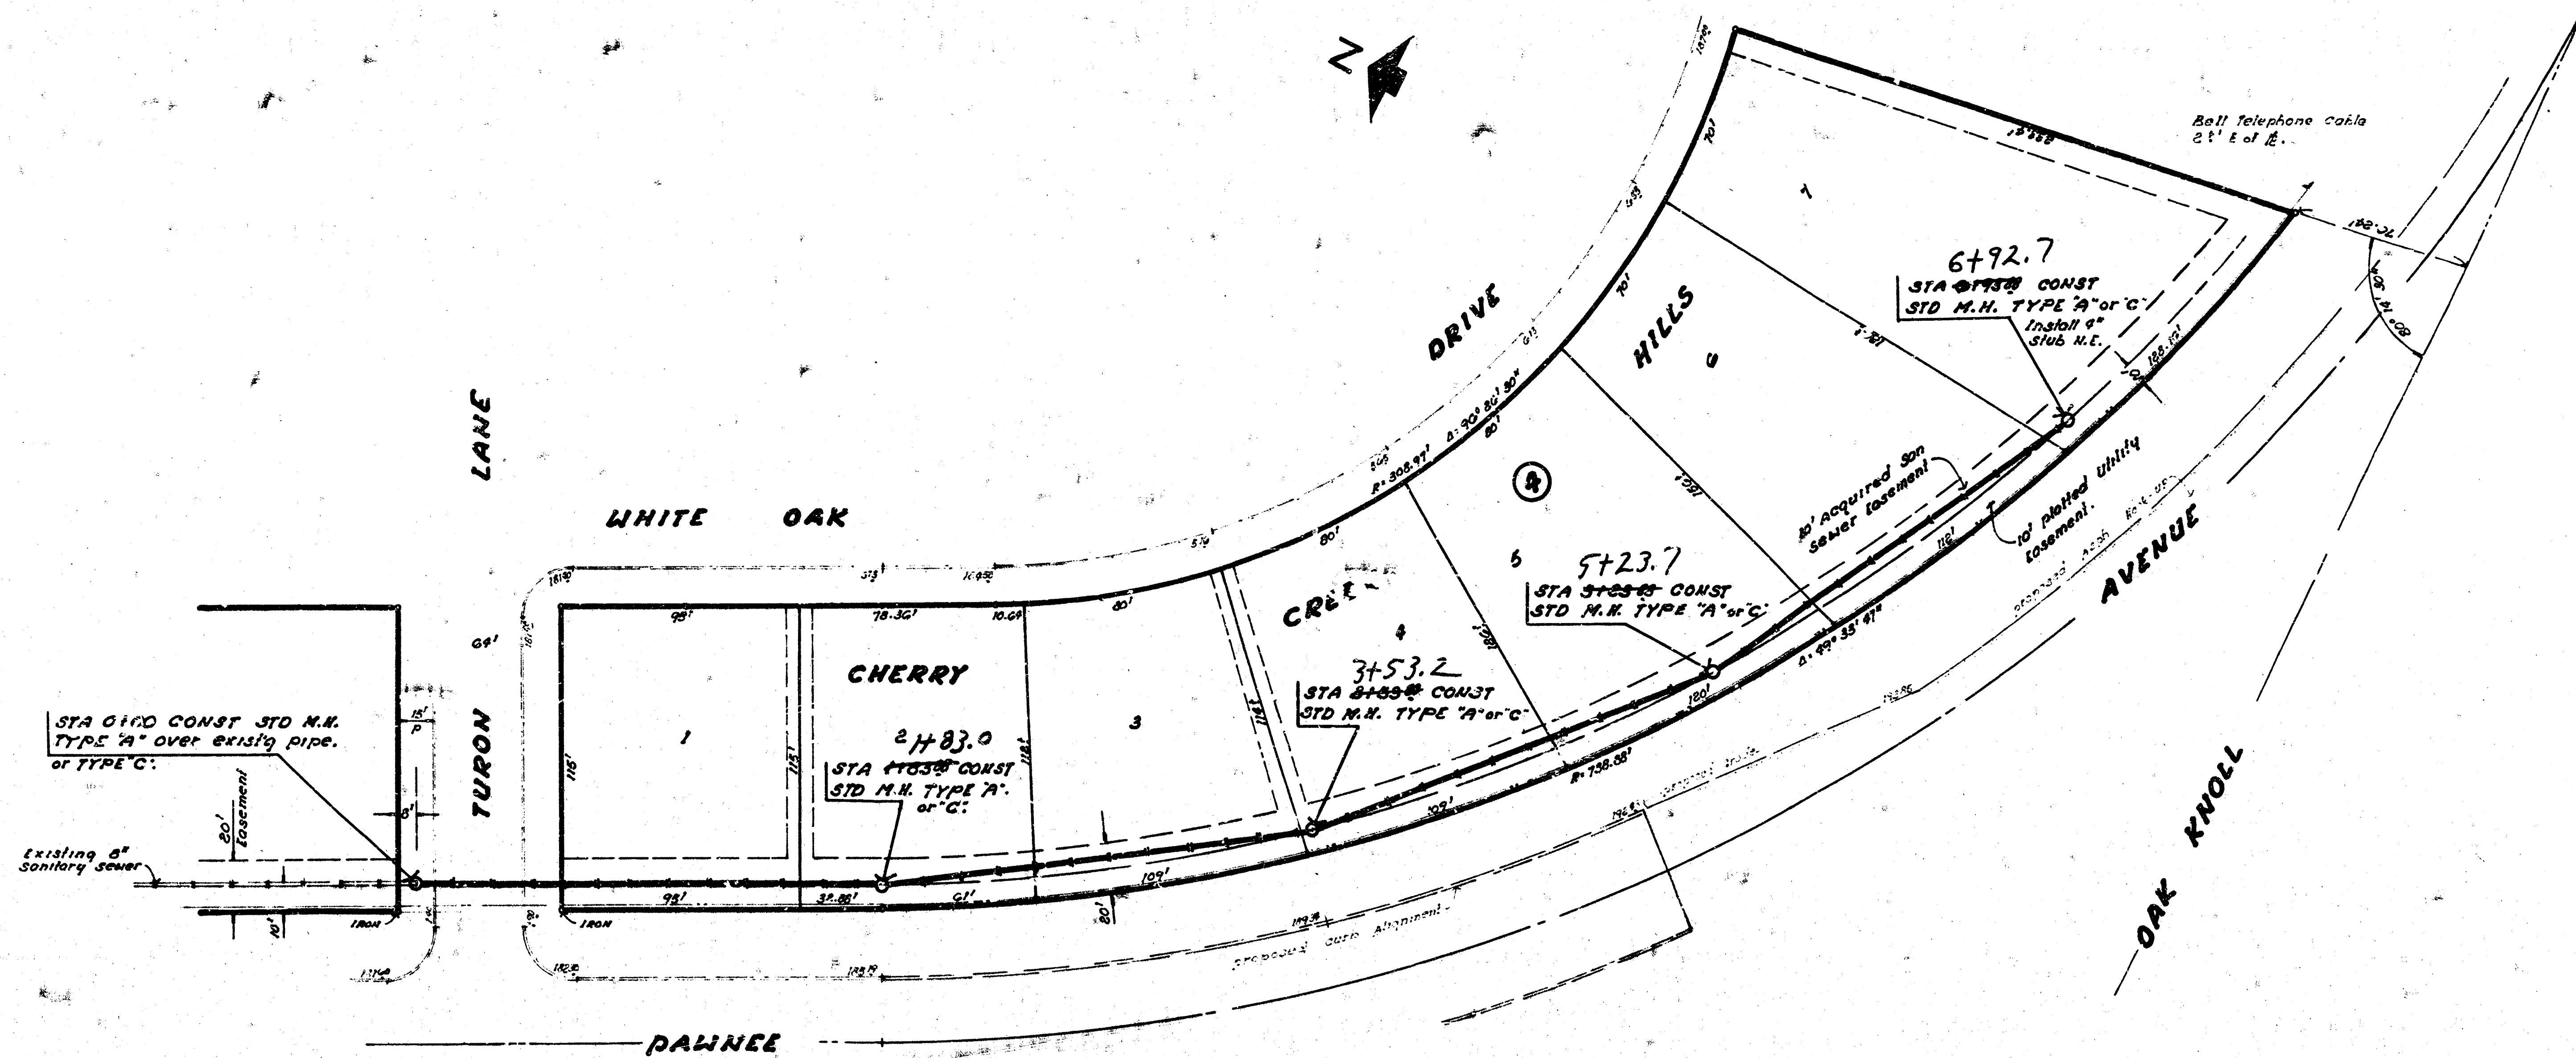


S.M. 1982 P.P. Spike in E. side p. pole 30' N. of intersection of
OAK KNOLL & Bray Co. Driveway.

CAUTION
UNDERGROUND
UTILITIES
Please check with K.G. & E. or
Southwestern Bell
Telephone Co. for Location

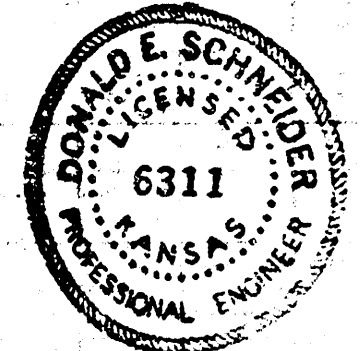

plan scale 1" = 40'
profile 1" = 40' Horiz
1" = 5' Vert

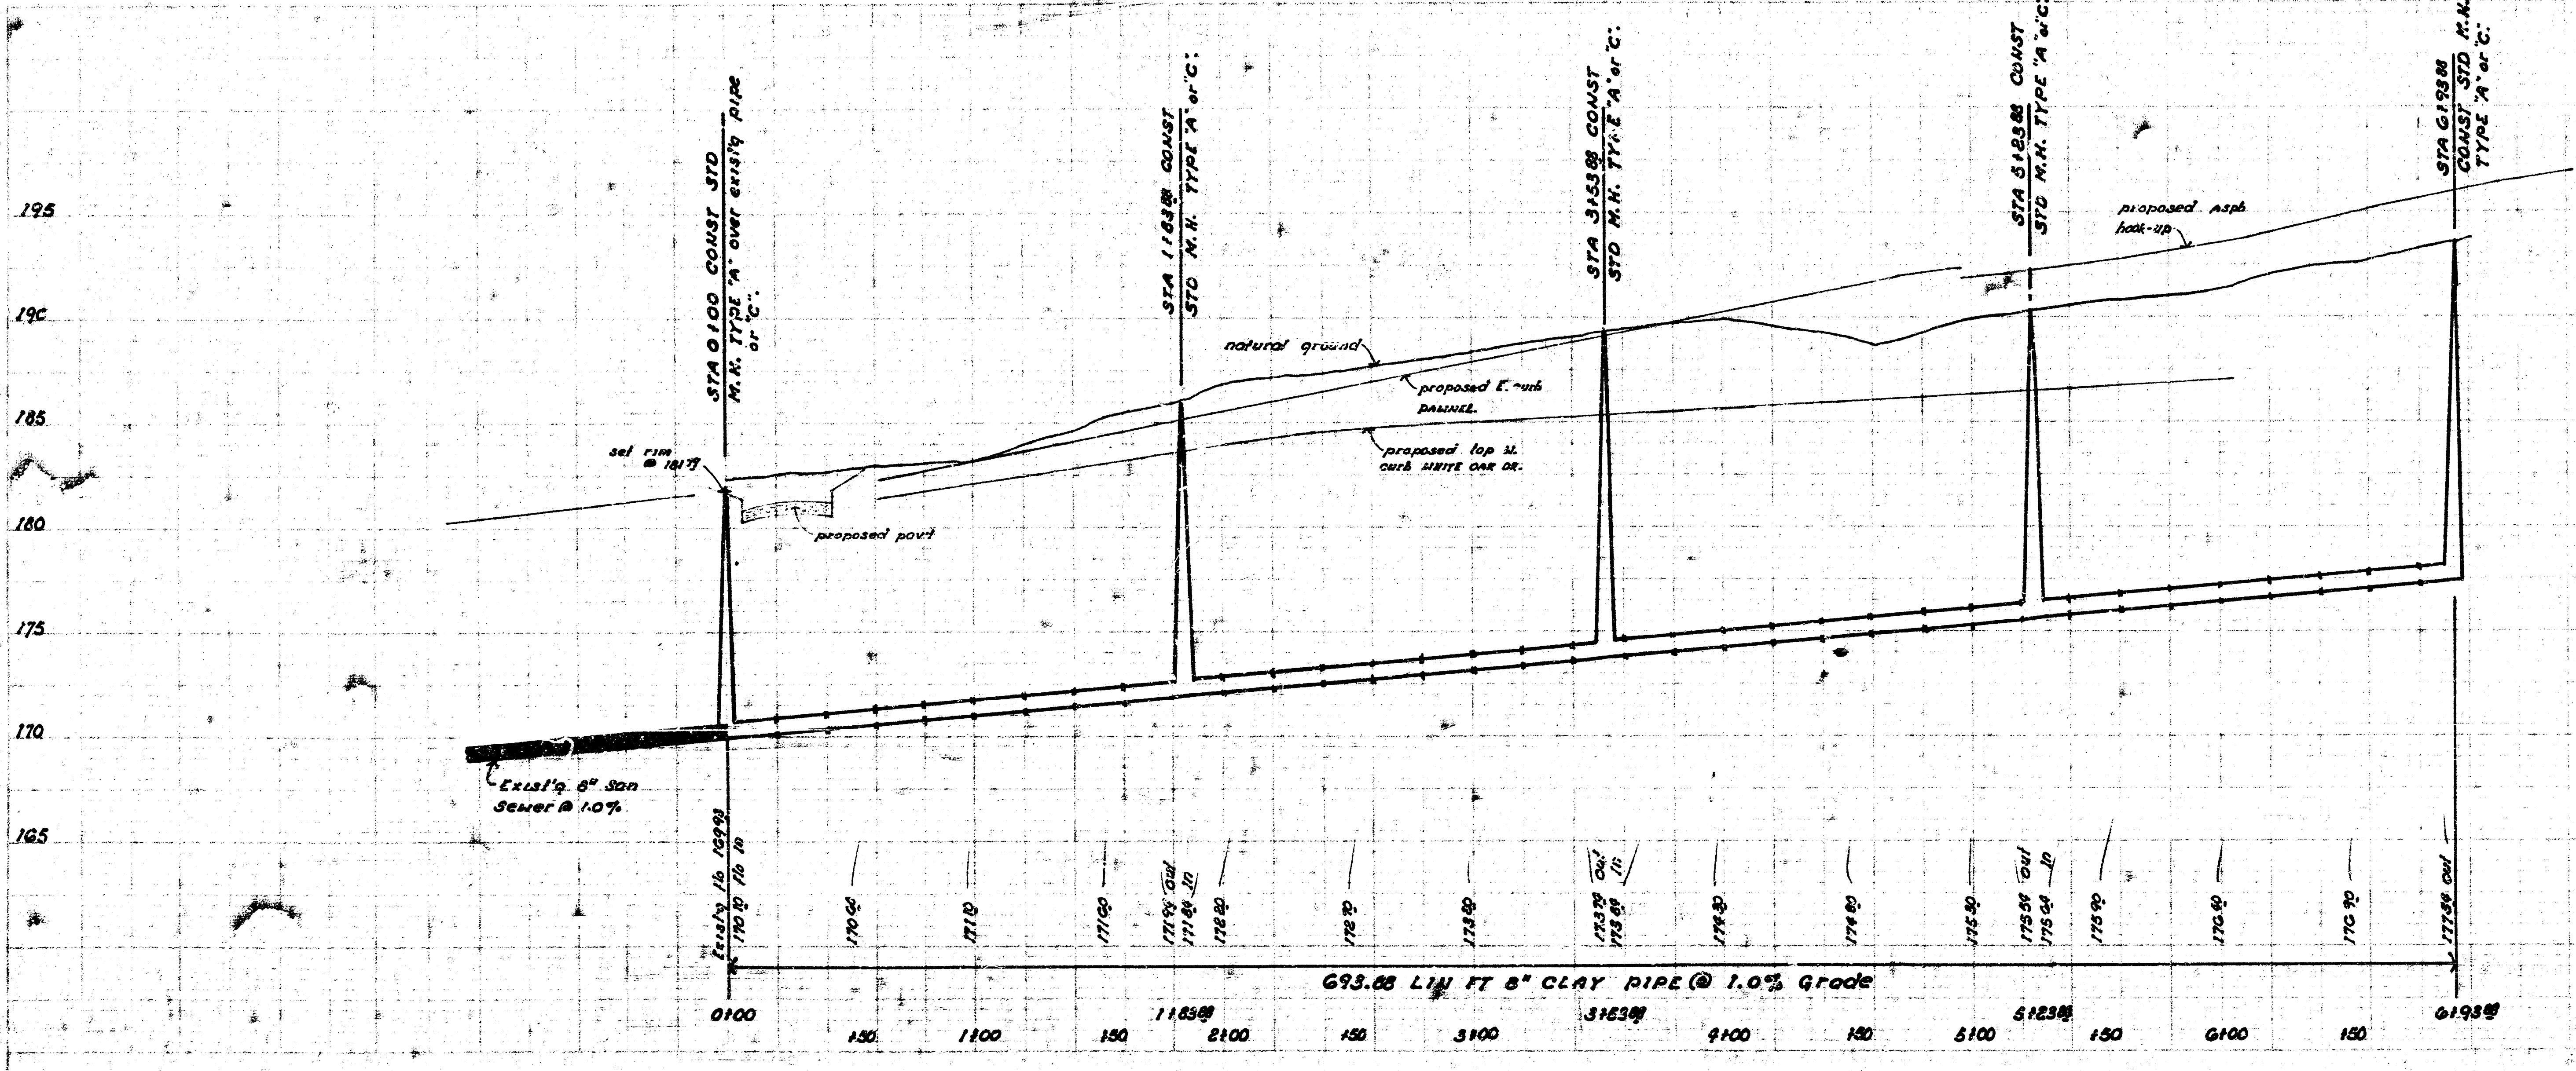

As Built 7-29-75
LAT. 5, MAIN 17, W. I. S.
 CITY OF WICHITA, KANSAS
 R.M. LINN CITY ENGINEER
 DATE PROJ. M. DAKL 87301G