

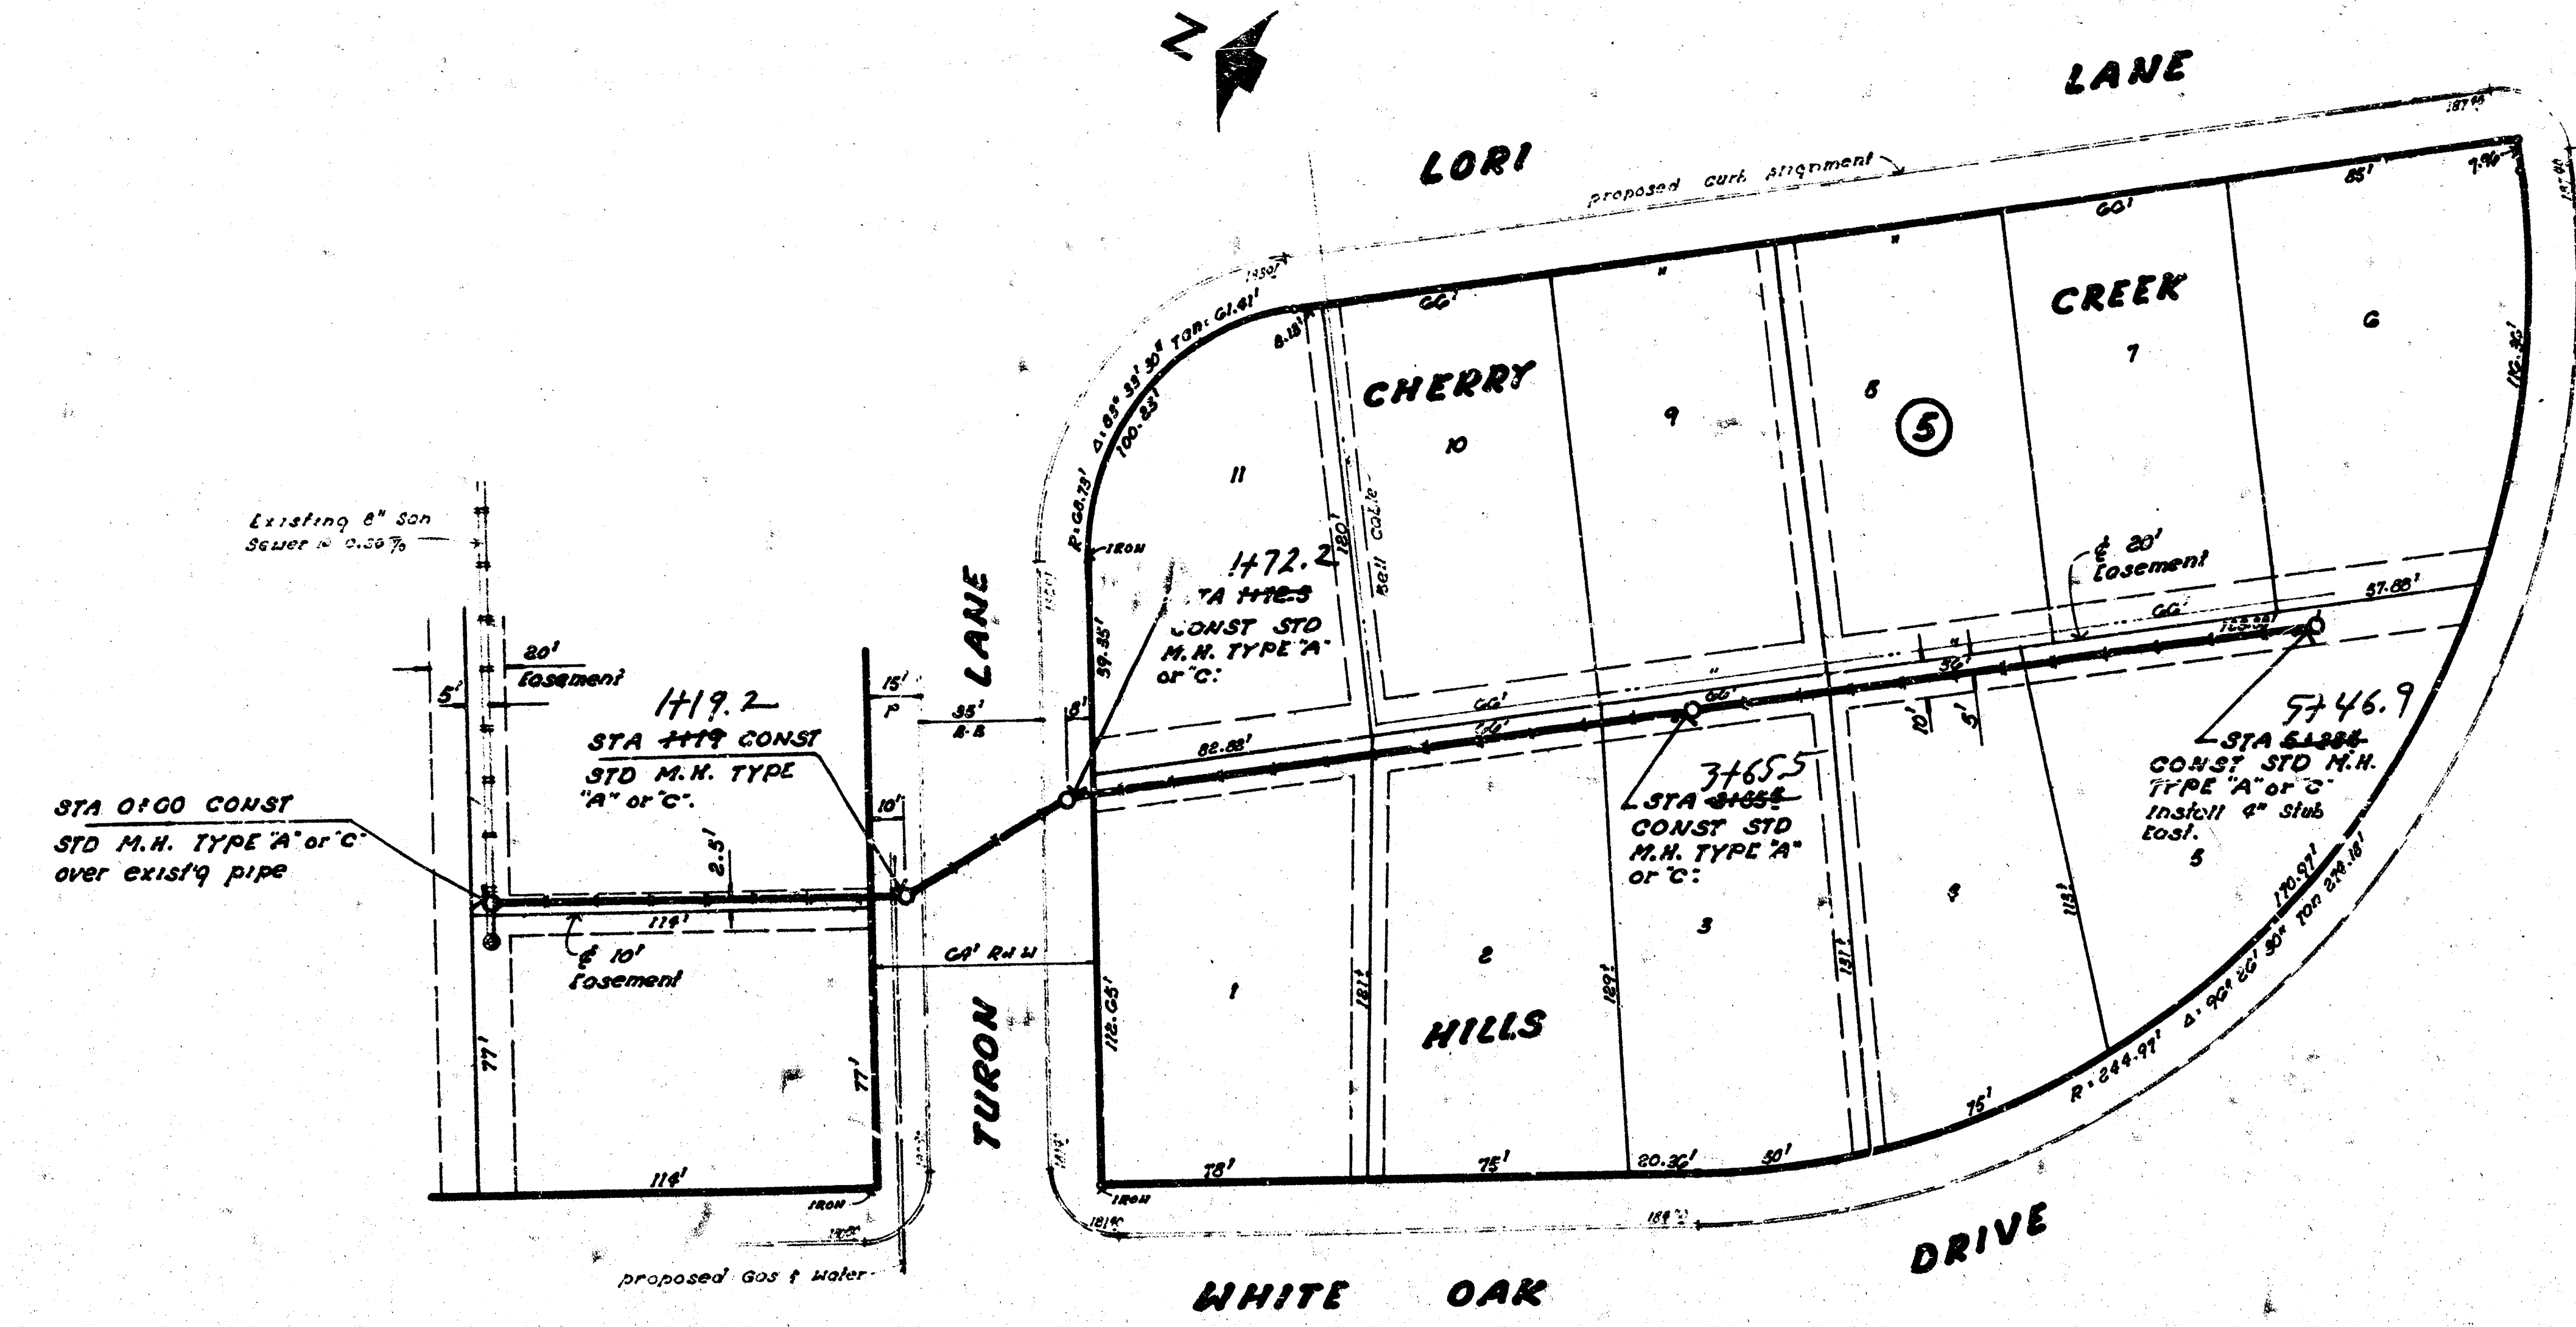


S.M. 1982 R.R. Spike E. Side 7 pole 30' N. of intersection of
OAK KNOLL & Brog Co. Driveway.

CAUTION
UNDERGROUND
UTILITIES
Please check with K.G. & B. or
So. Division City
Telephone Co. for location

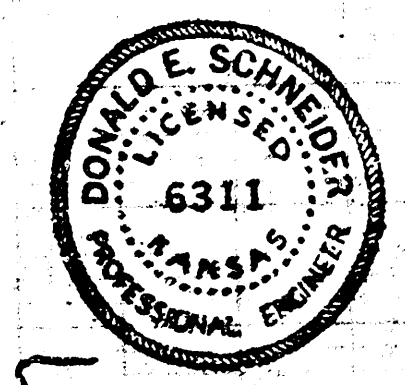

plan scale 1"=40'
profile 1"=40' Horiz
1"=5' Vert

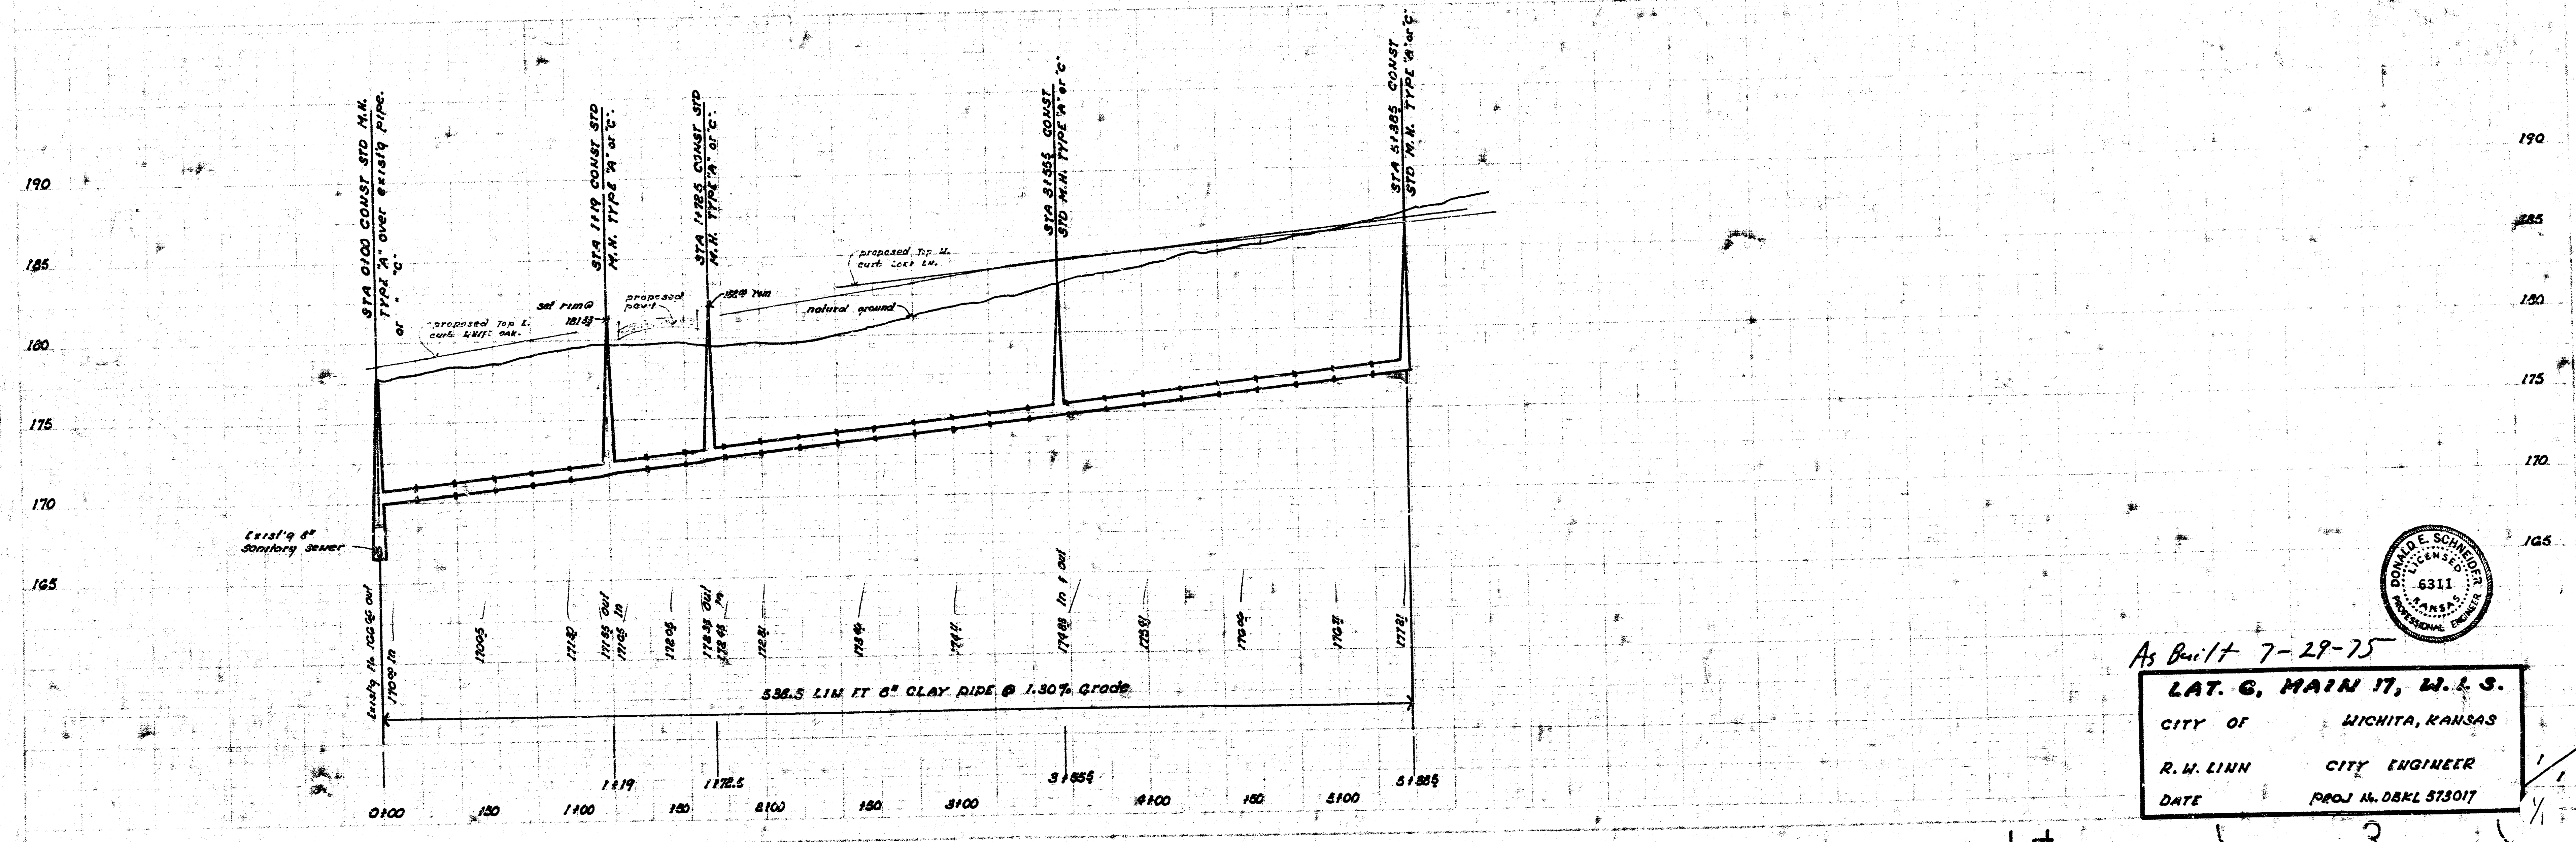

As Built 7-29-75
LAT. G, MAIN 17, W.L.S.
CITY OF WICHITA, KANSAS
R.W. LINN CITY ENGINEER
DATE PROJ W.D.B.K.L 573017