

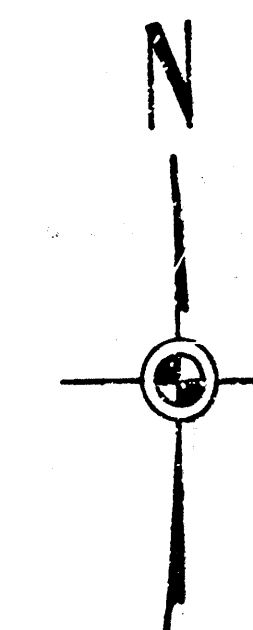
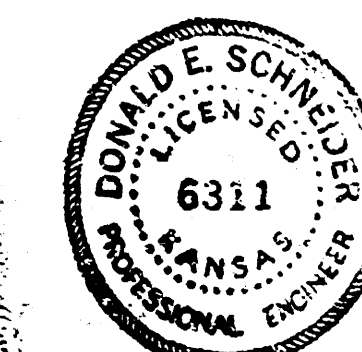


LAT. 10, MAIN 17, WAR INDUSTRIES SEWER
 CITY OF WICHITA, KANSAS
 R. W. LINN - CITY ENGINEER
 SEPT. 1973, PROJECT NO. DBKM 573043

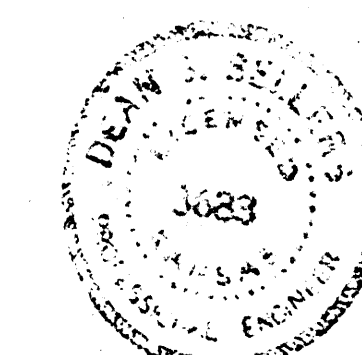

1" = 100'

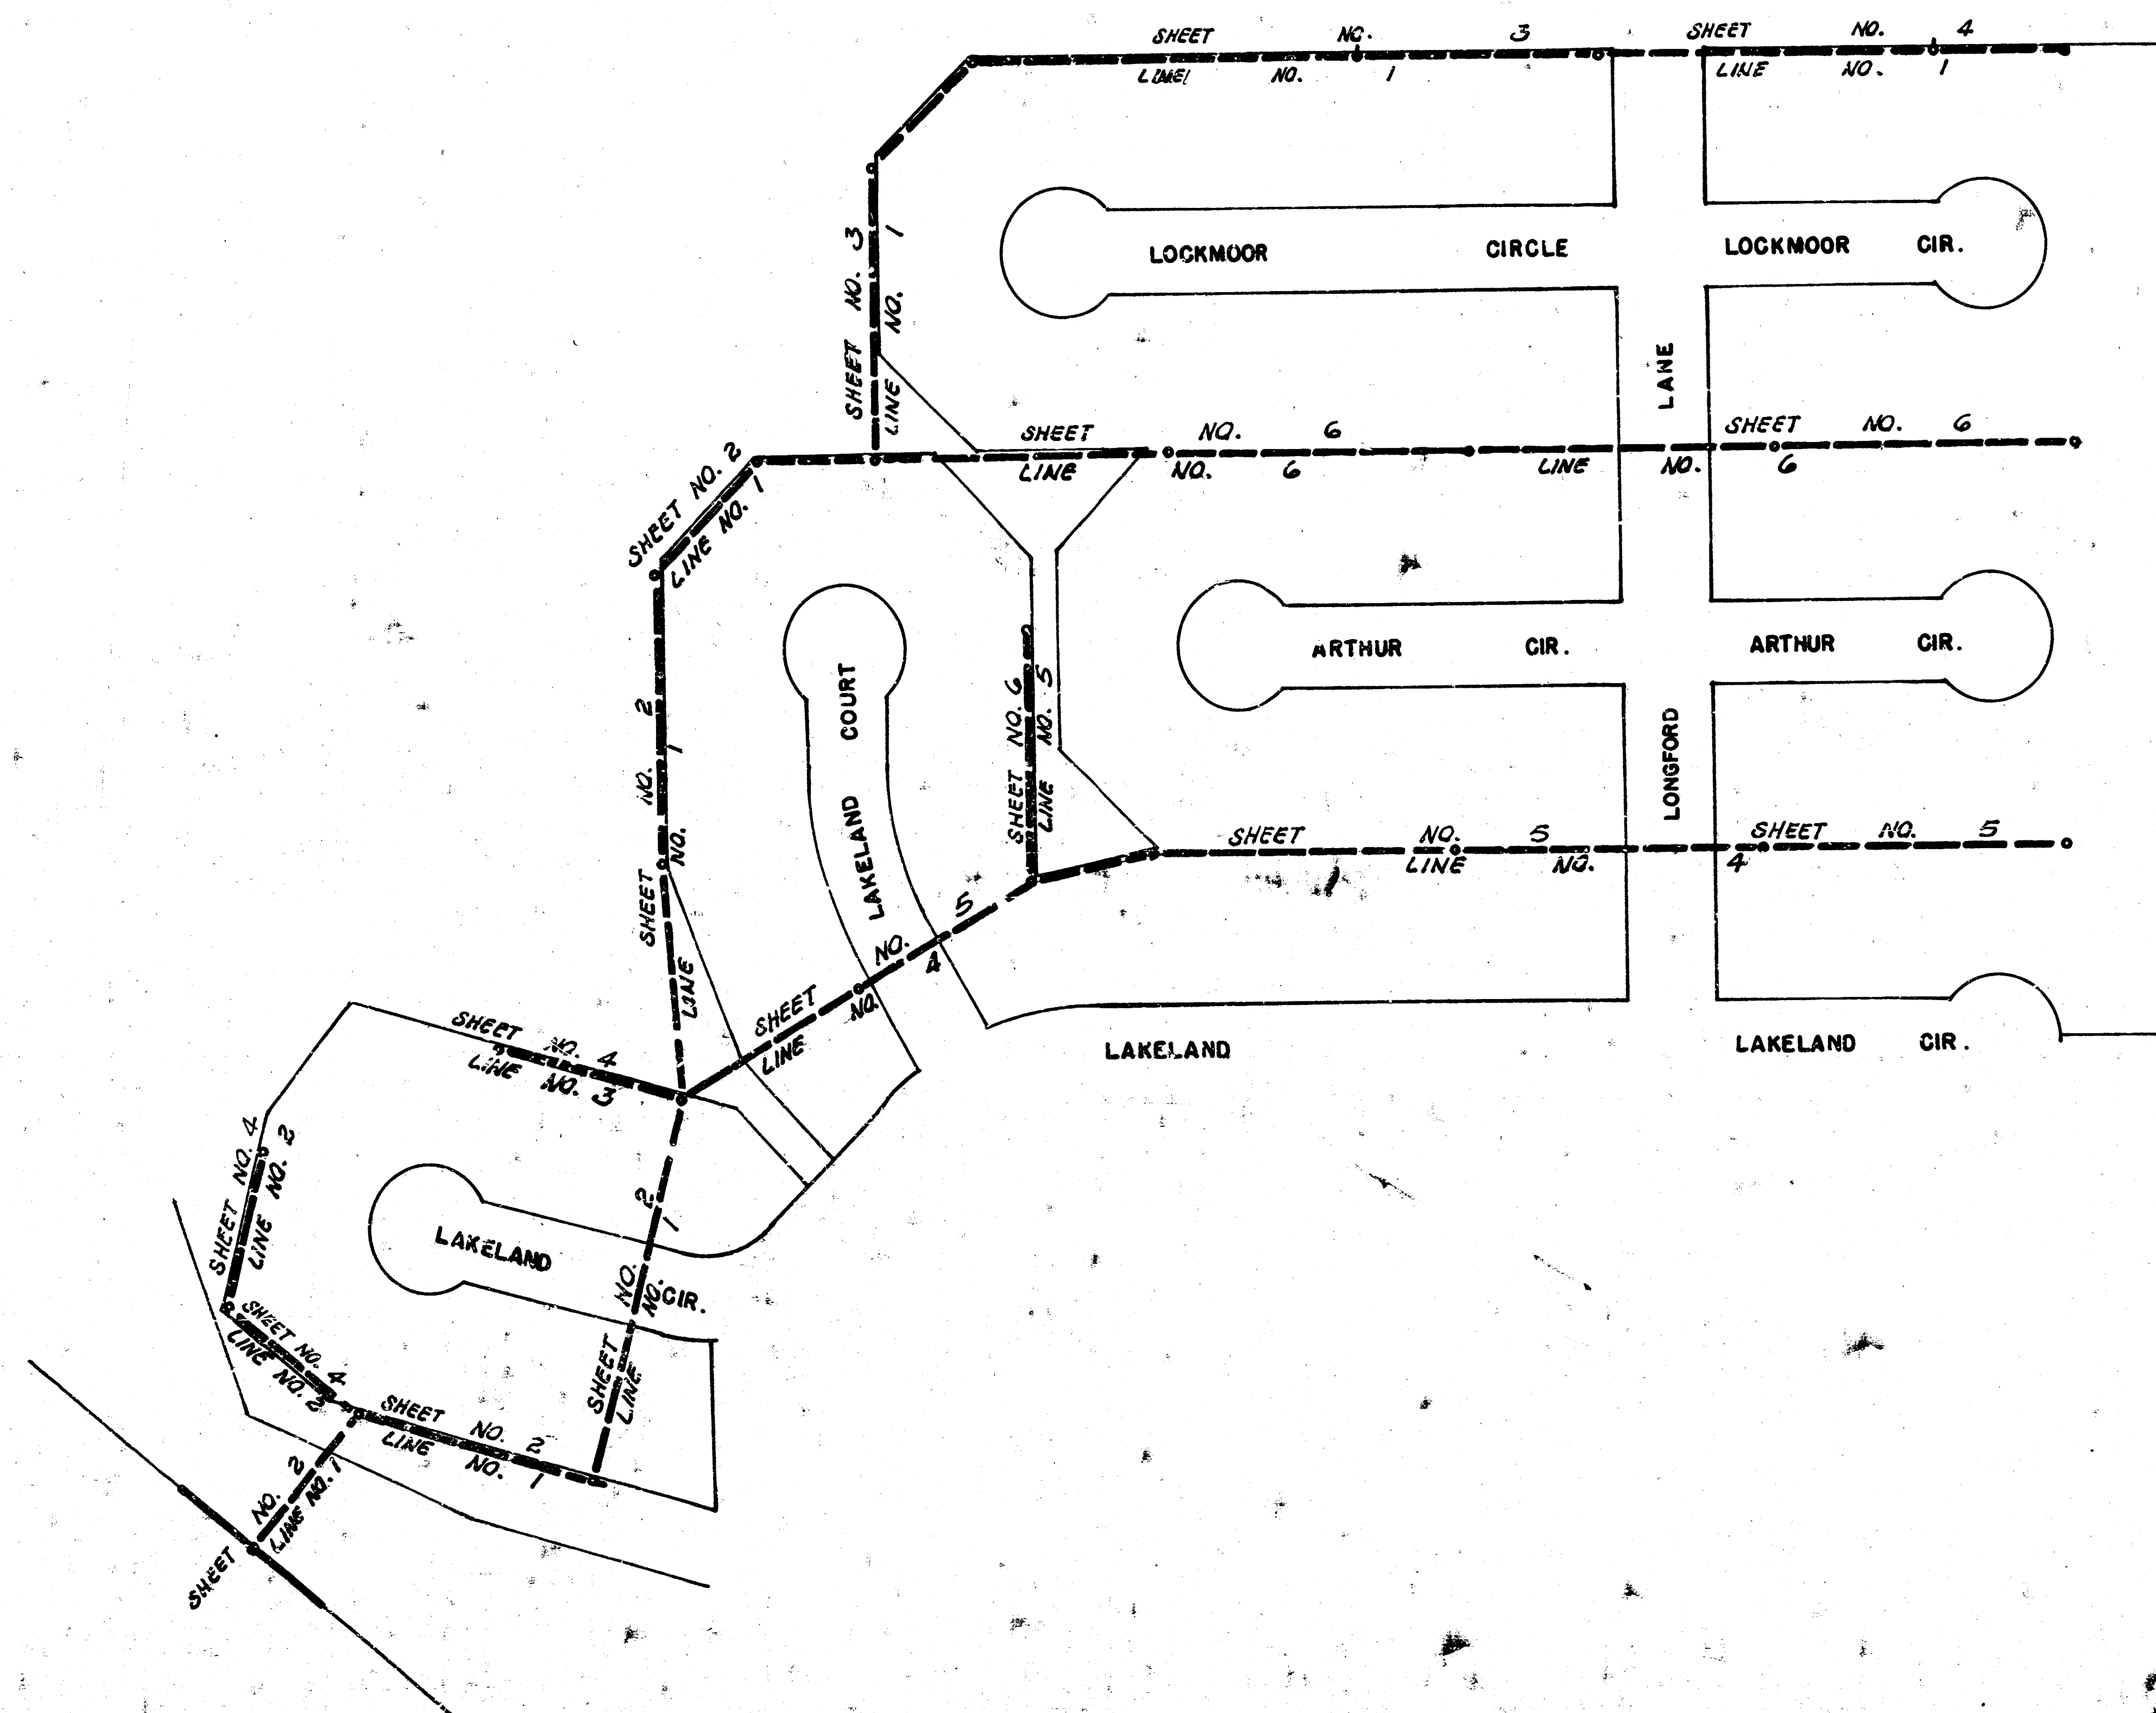

"As Built" final Meas. 279-4


1/6

LAT. 10, MAIN 17, WAR INDUSTRIES SEWER
 PROJECT NO. DBKL 573043

A.P. R. W.
84



- B.M. #1 City Std. 42' W. & 48' S. of 1/4 Sec. cor.
1/4 mi. E. of Rock Rd. & Harry 161.824
- B.M. #2 "x" on NW cor. N. Handrail R.C.B.C.
on Harry 238' E. of E. Rock Rd. 145.41
- B.M. #3 "a" cut NW. cor. N. Headwall 85' W. of
W.L. Langford Lane S. on Harry St 159.08
- B.M. #4 Top steel T-Fix. Post 38' N. of N.L.
Langford Lane & E.L. Cedar Lakes Addn. 164.53
- B.M. #5 "a" cut NW. cor. N. wing wall on Dam app.
130' S. of Lakeland Cir. 153.475

CEDAR LAKES VILLAGE FIRST ADDITION

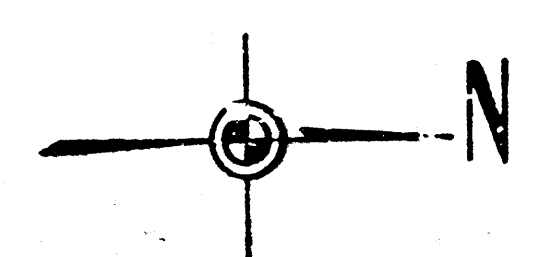


Plan Scale 1" = 100'
Profile Scale 1" = 40' Horiz
1" = 5' Vert.

• Irons set

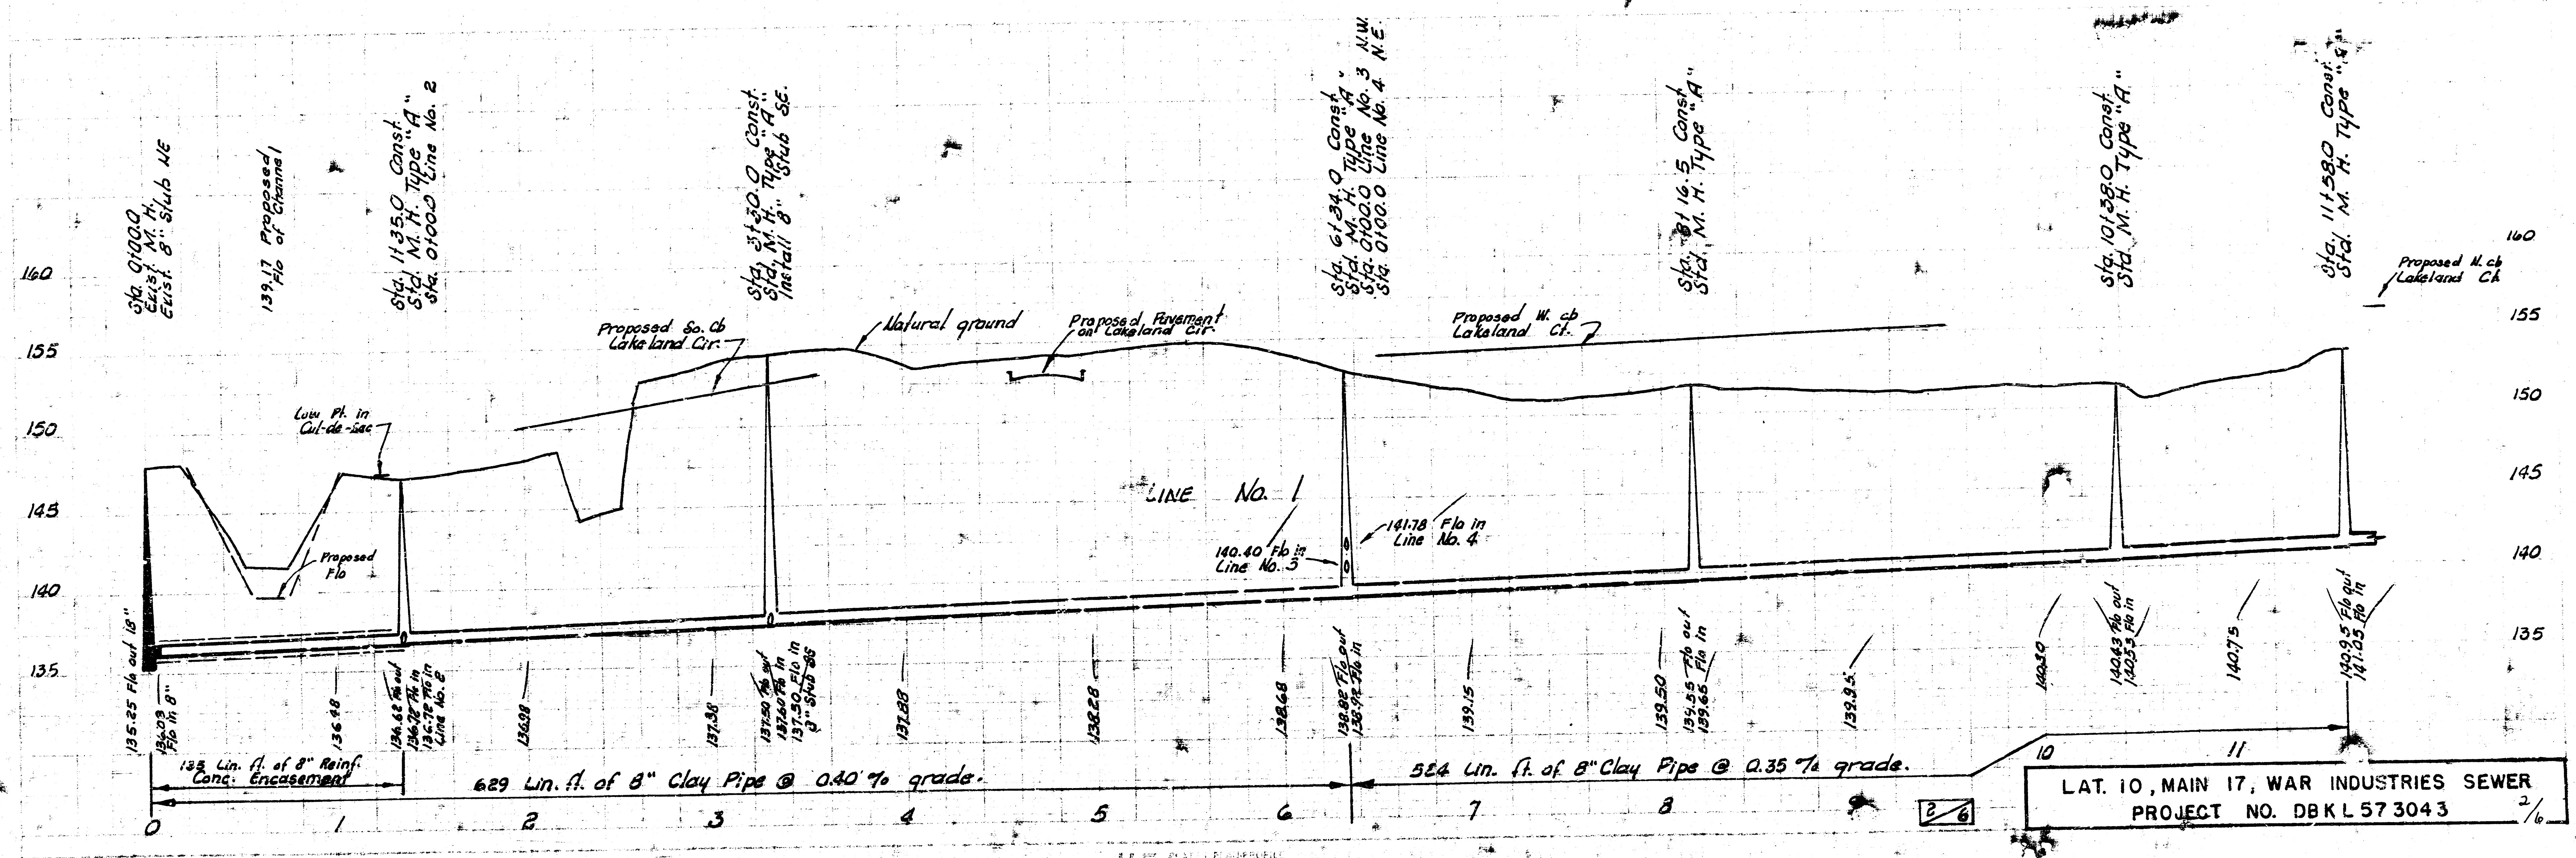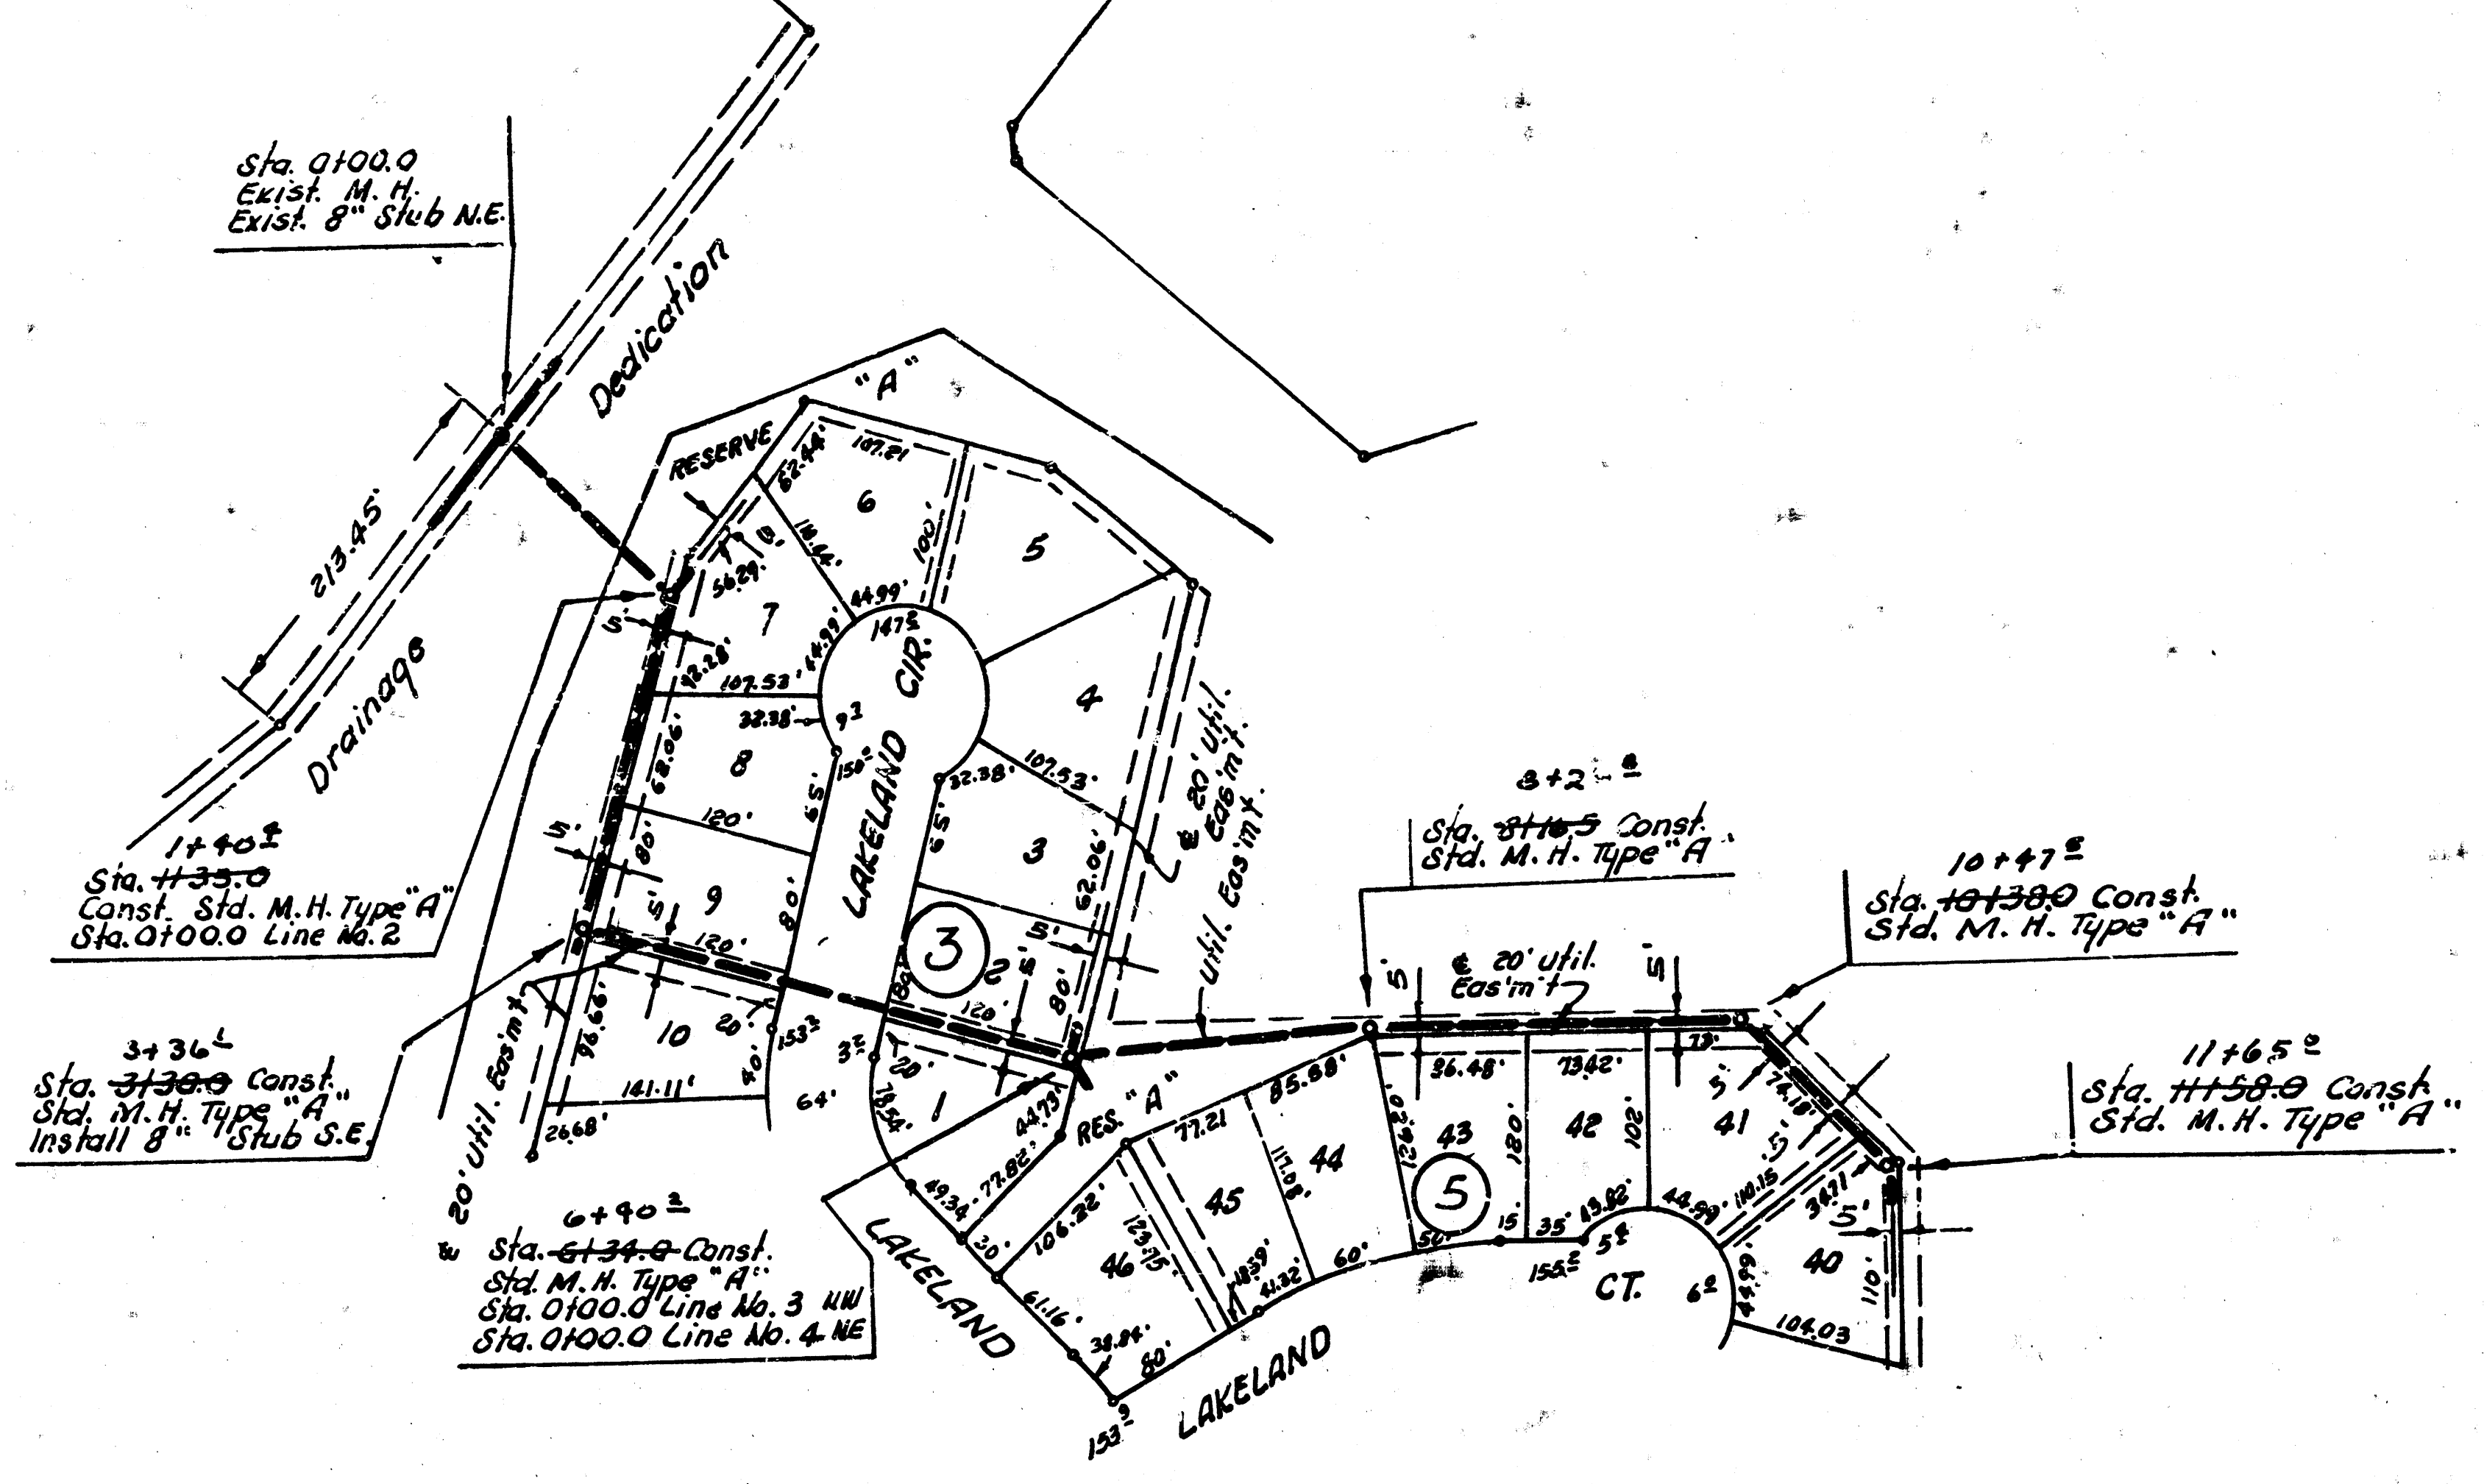







LAT. 10, MAIN 17, WAR INDUSTRIES SEWER
PROJECT NO. DBKL 57 3043

CEDAR LAKES VILLAGE FIRST ADDITION

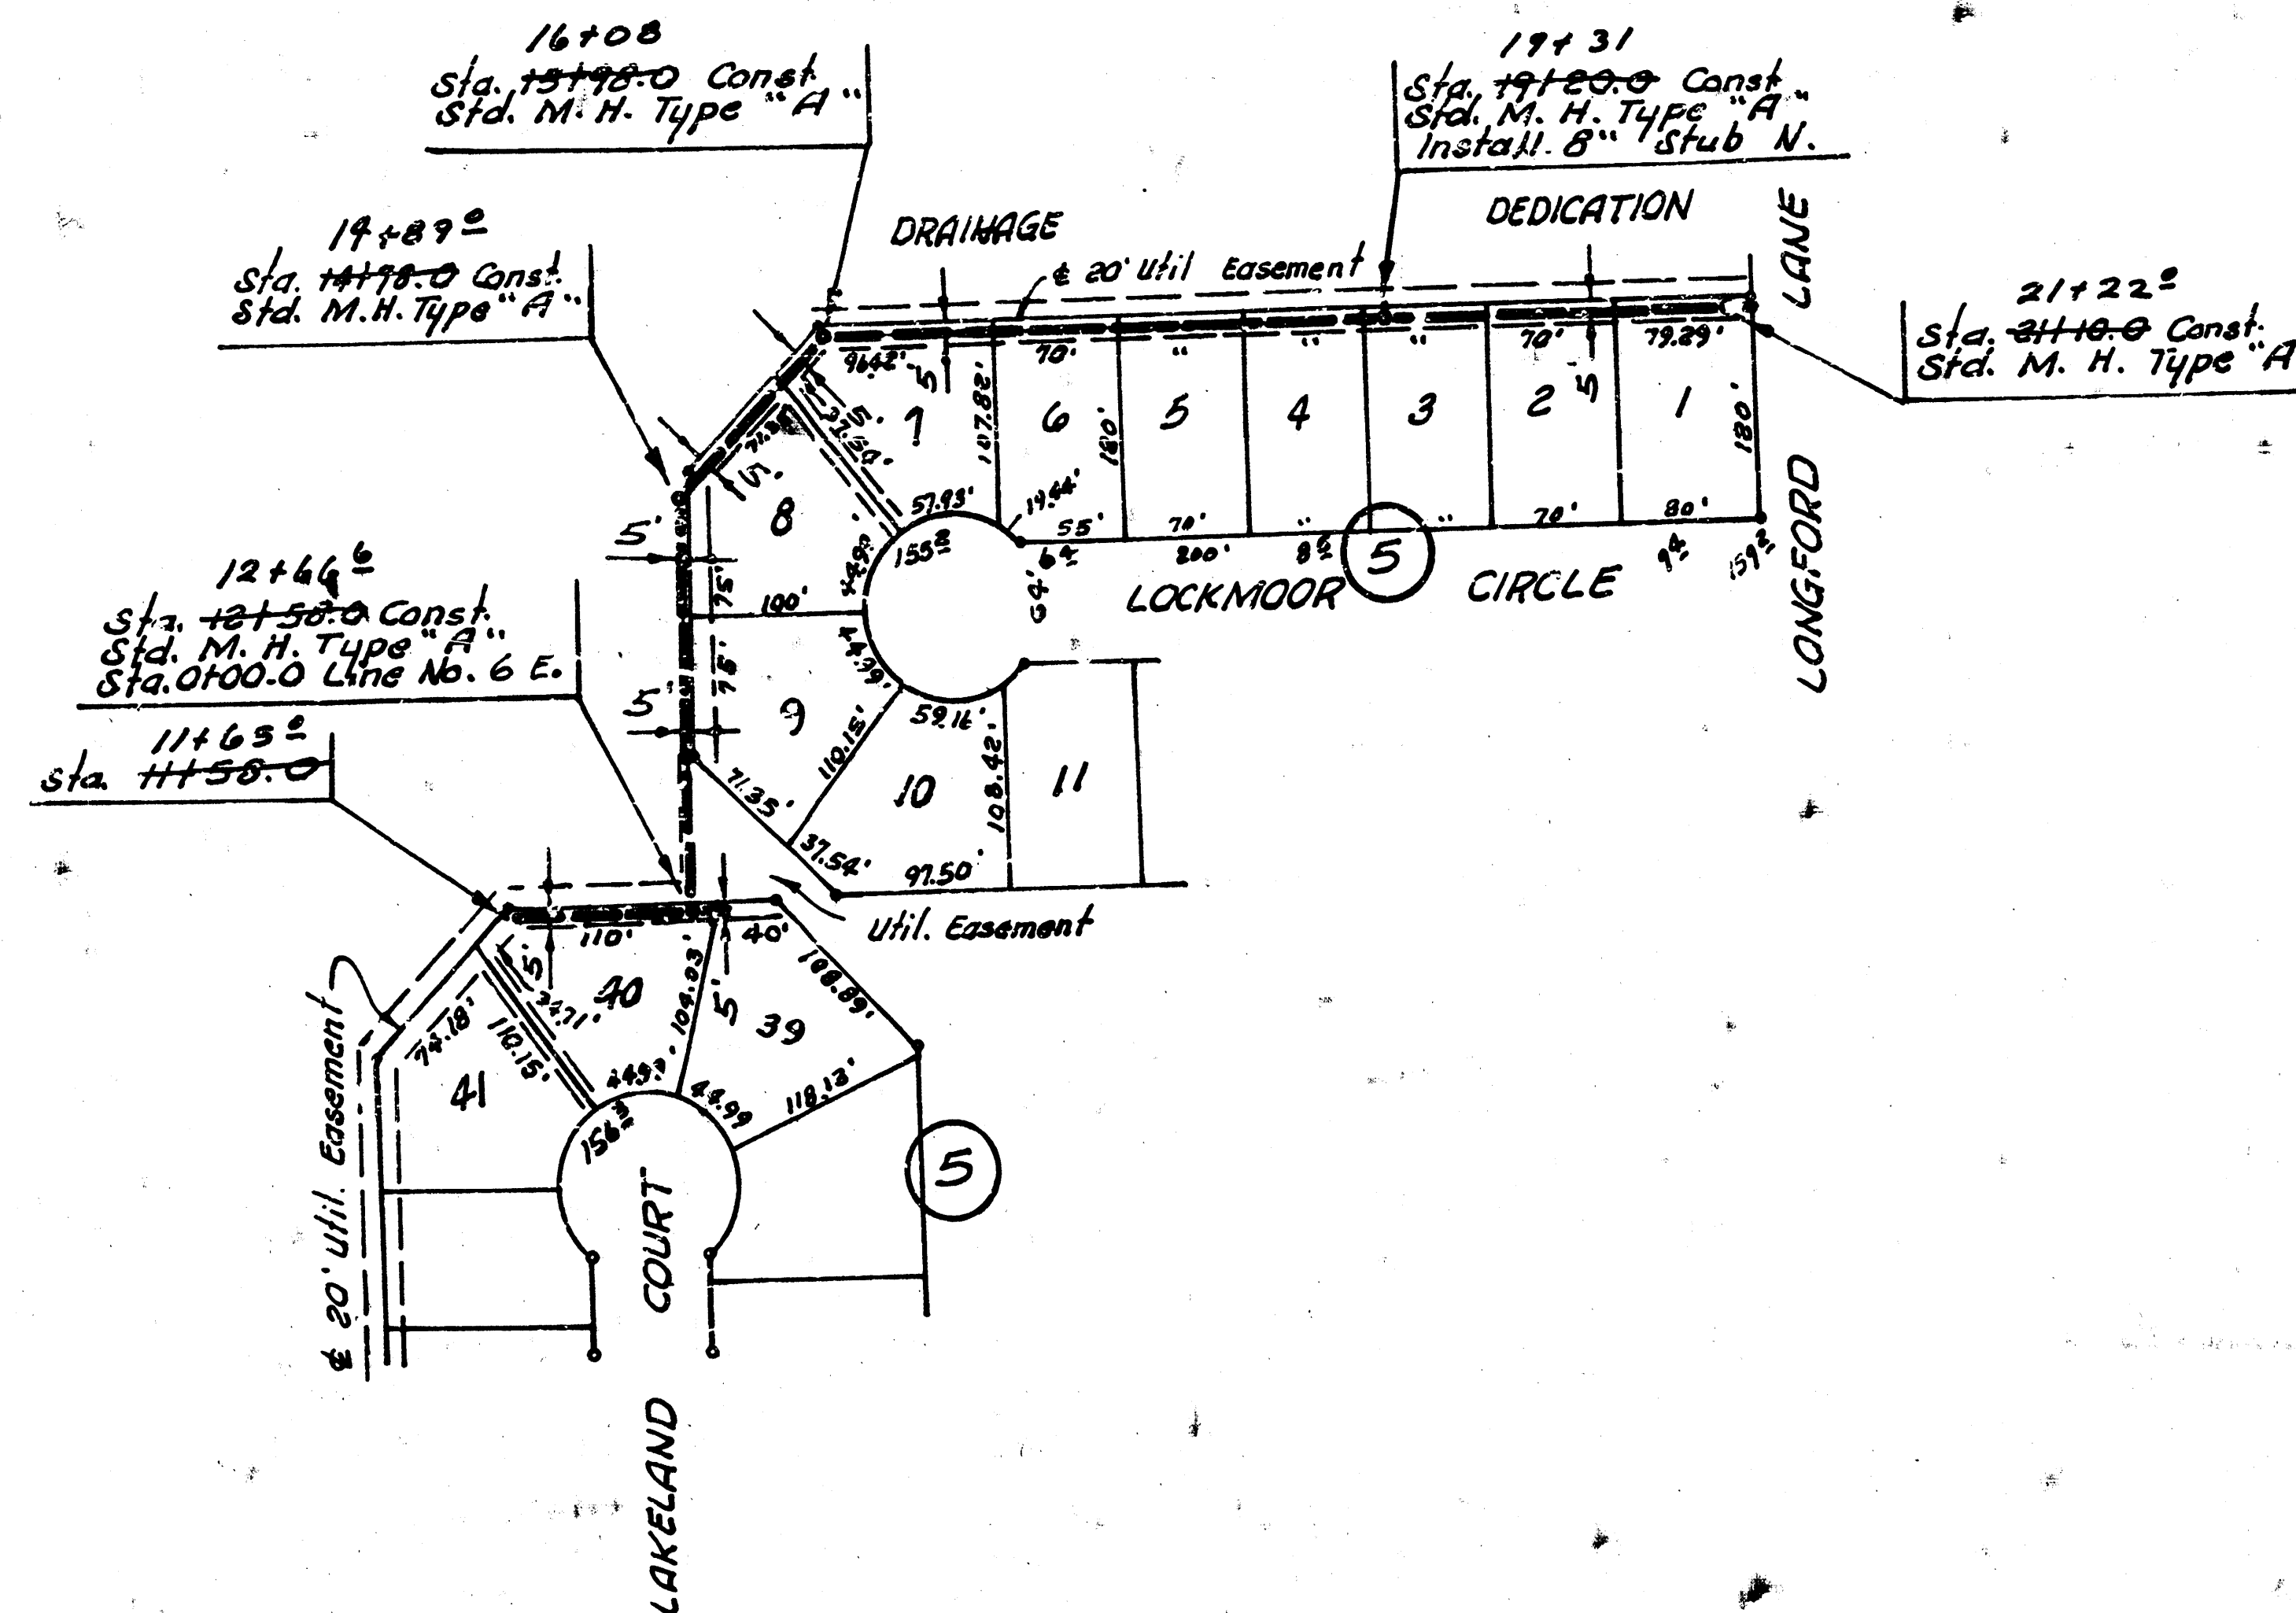


Pg. 12


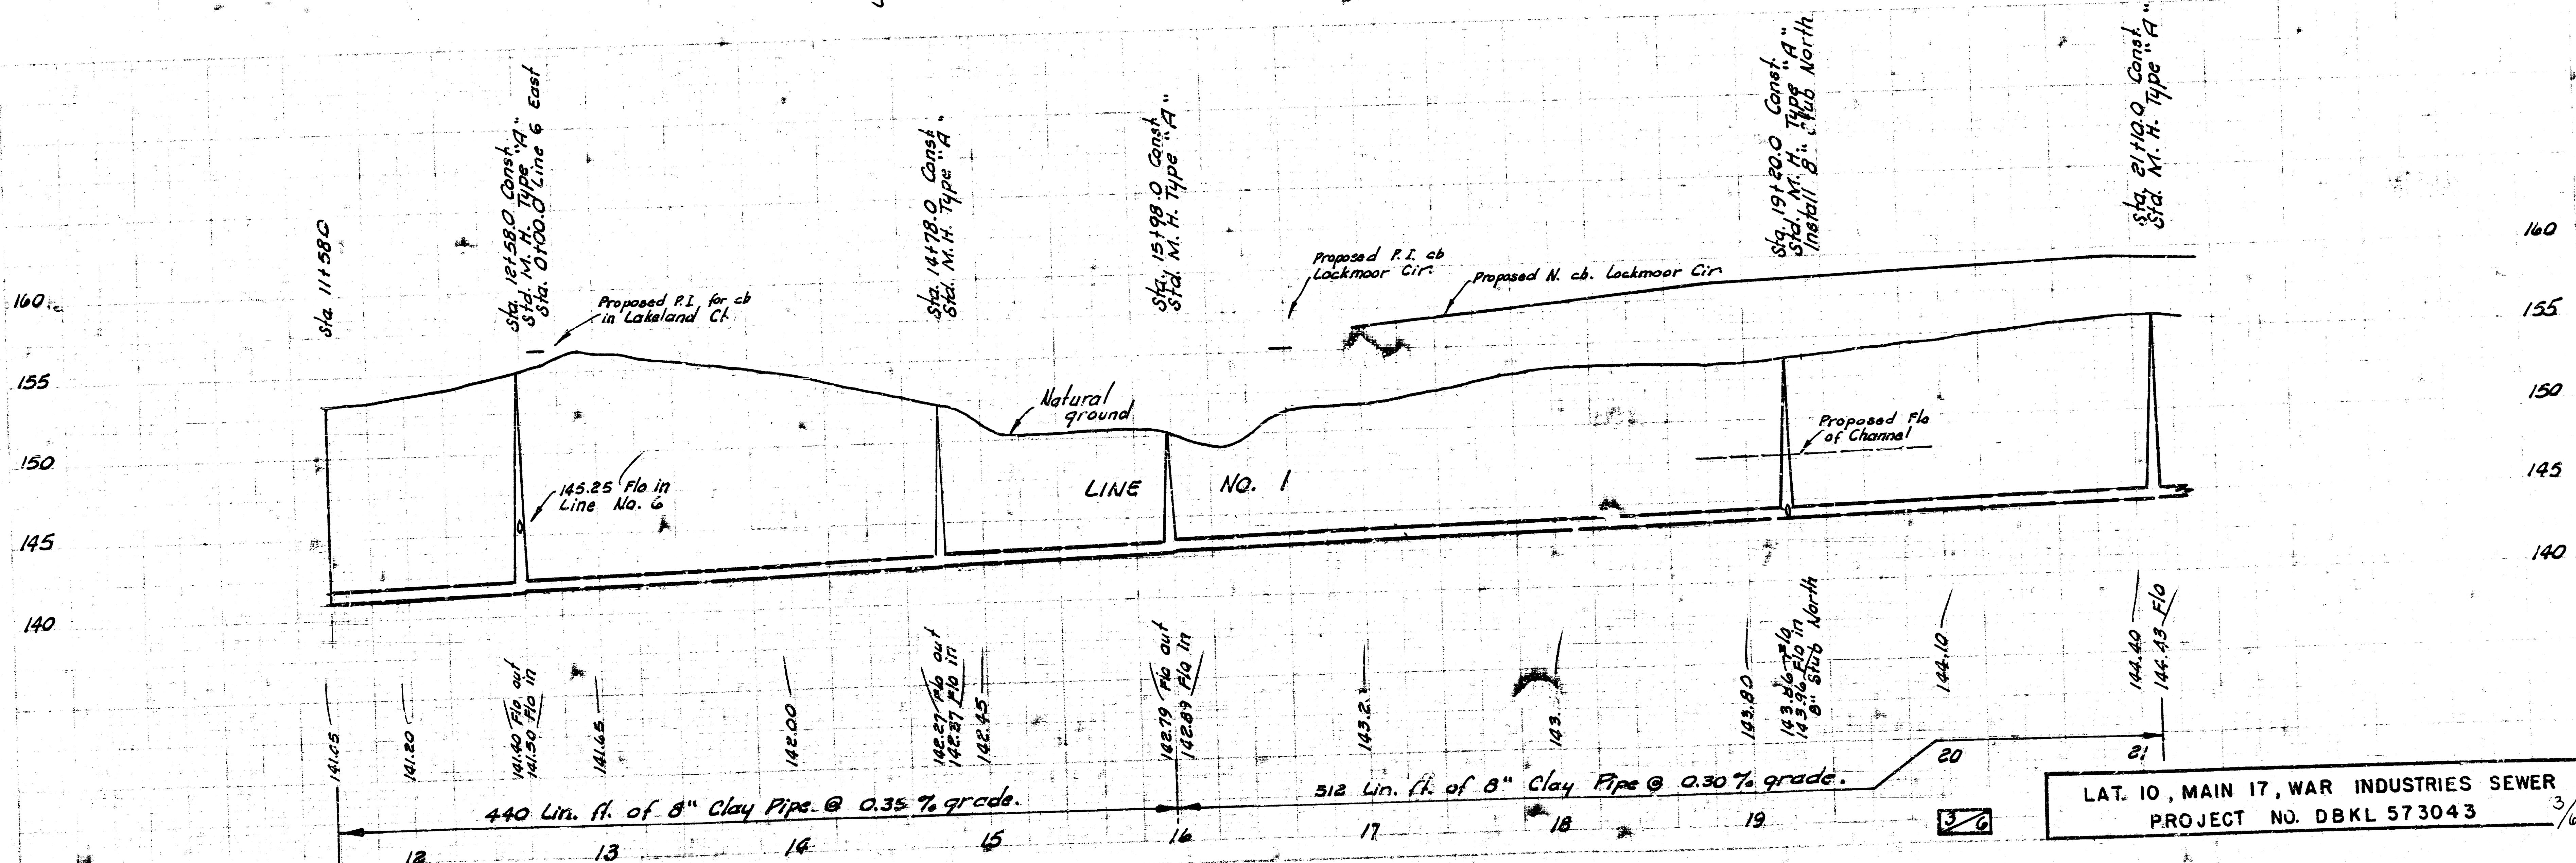


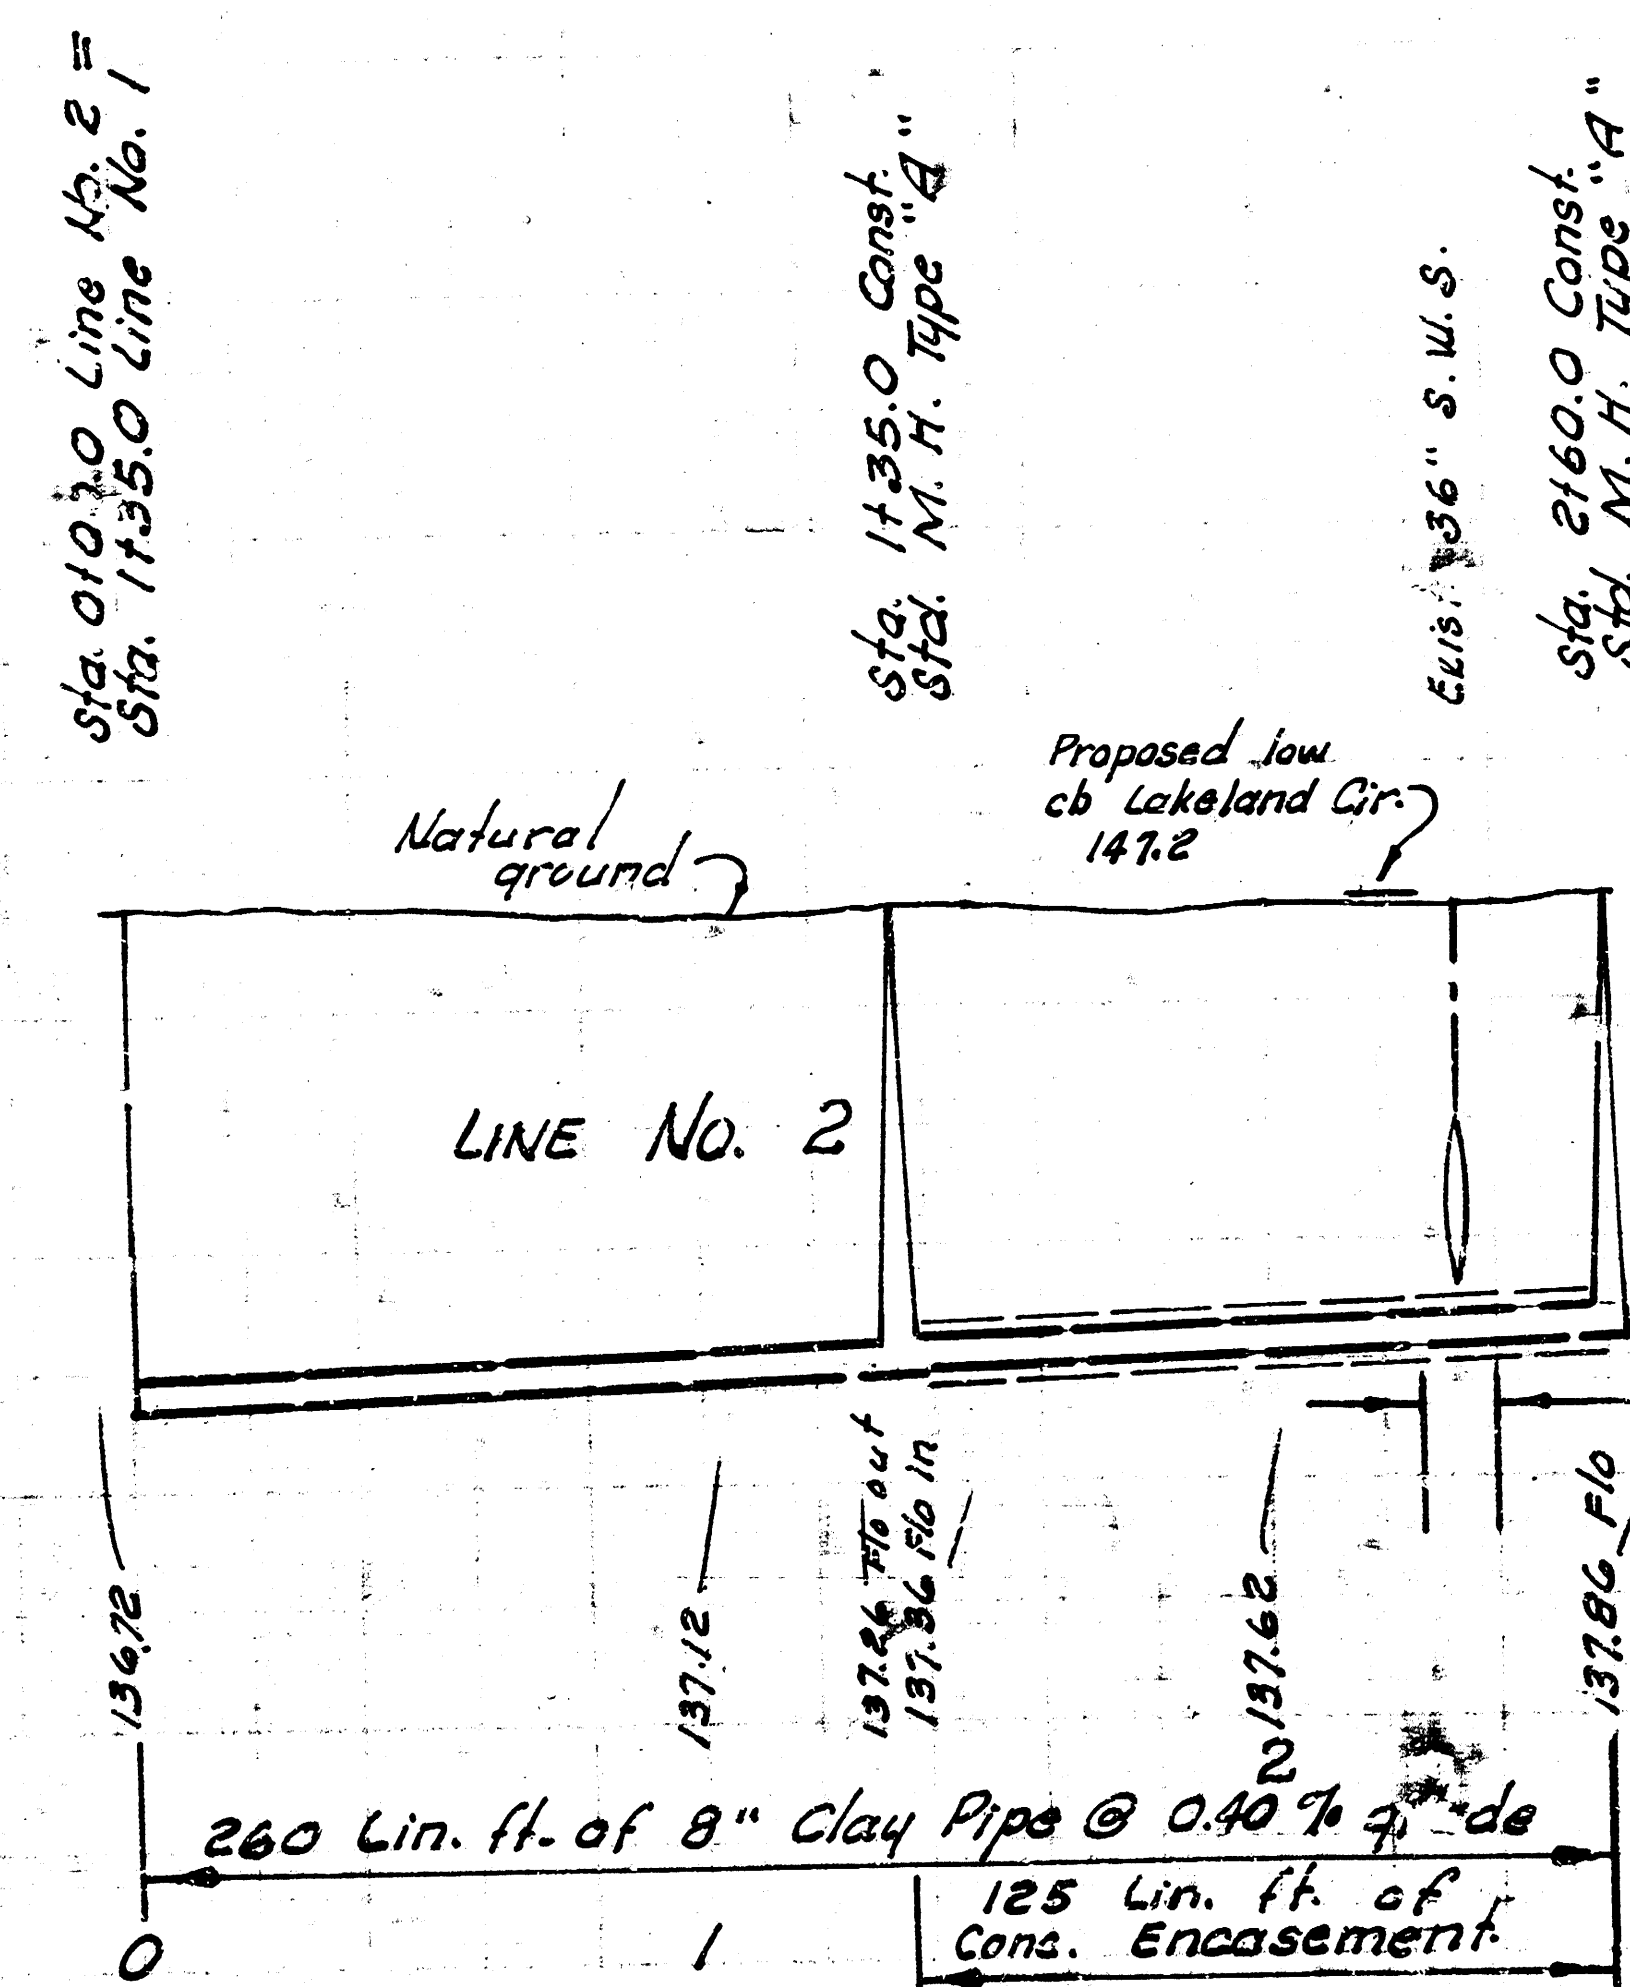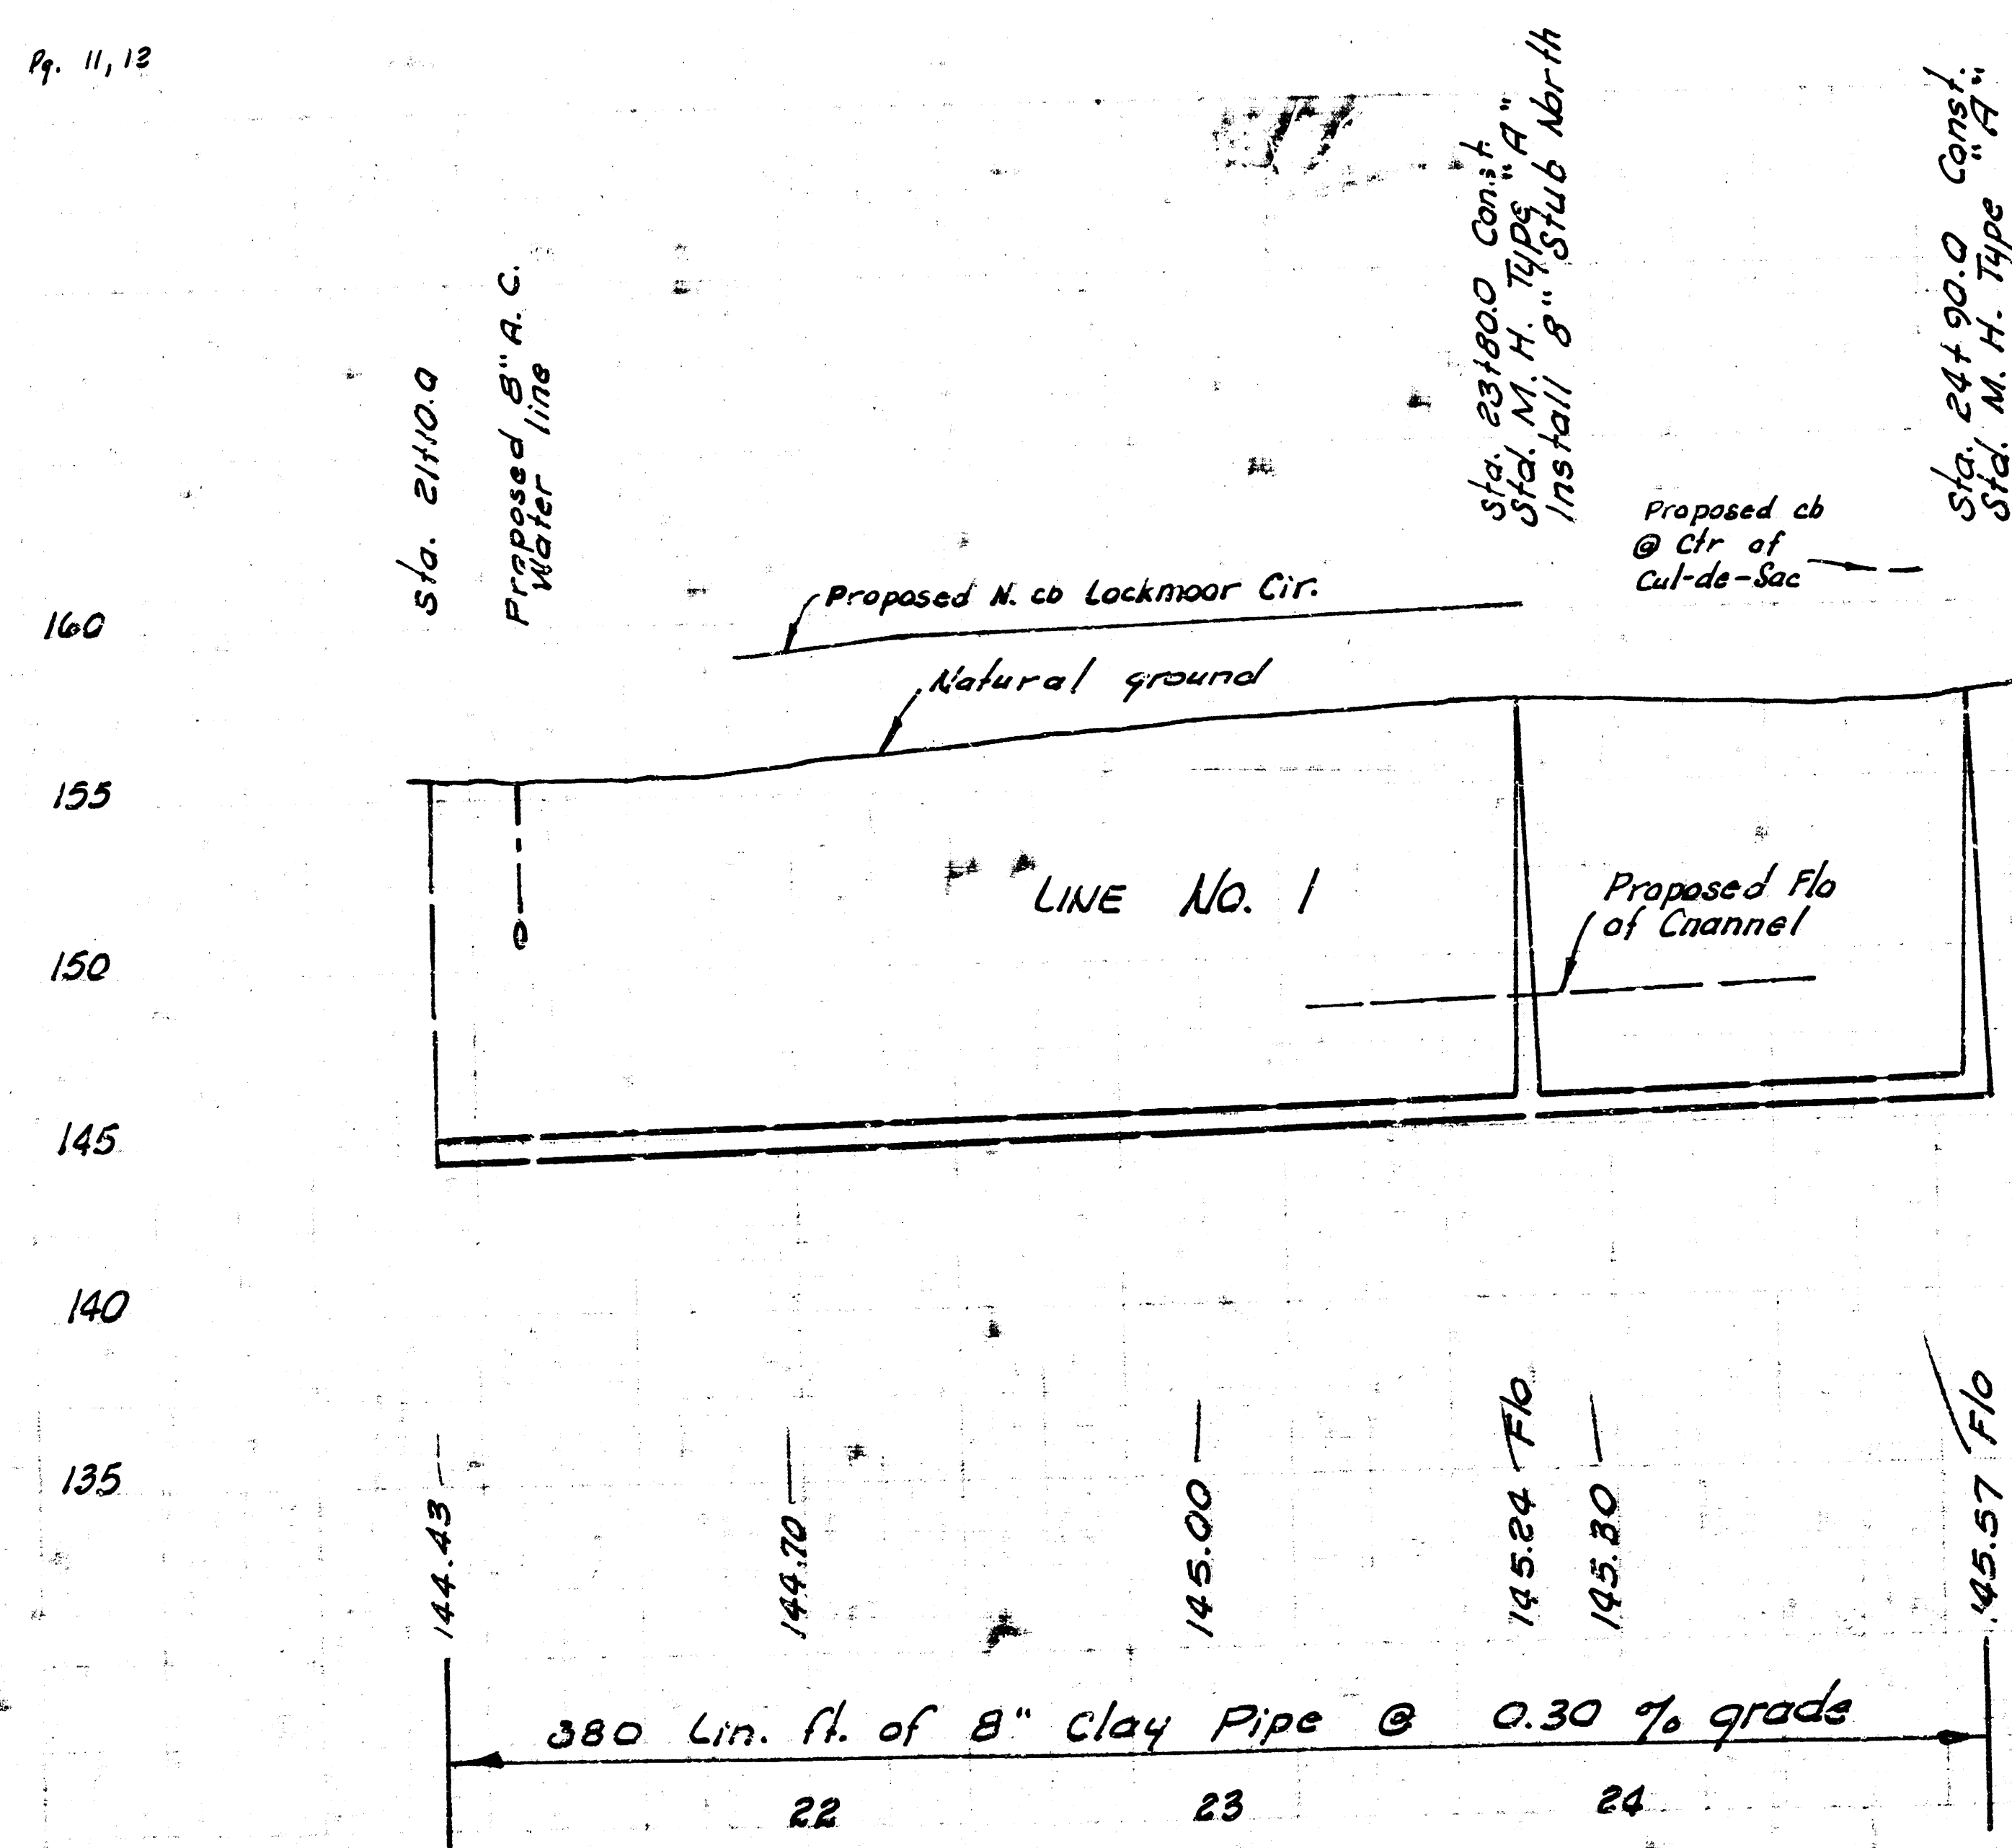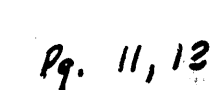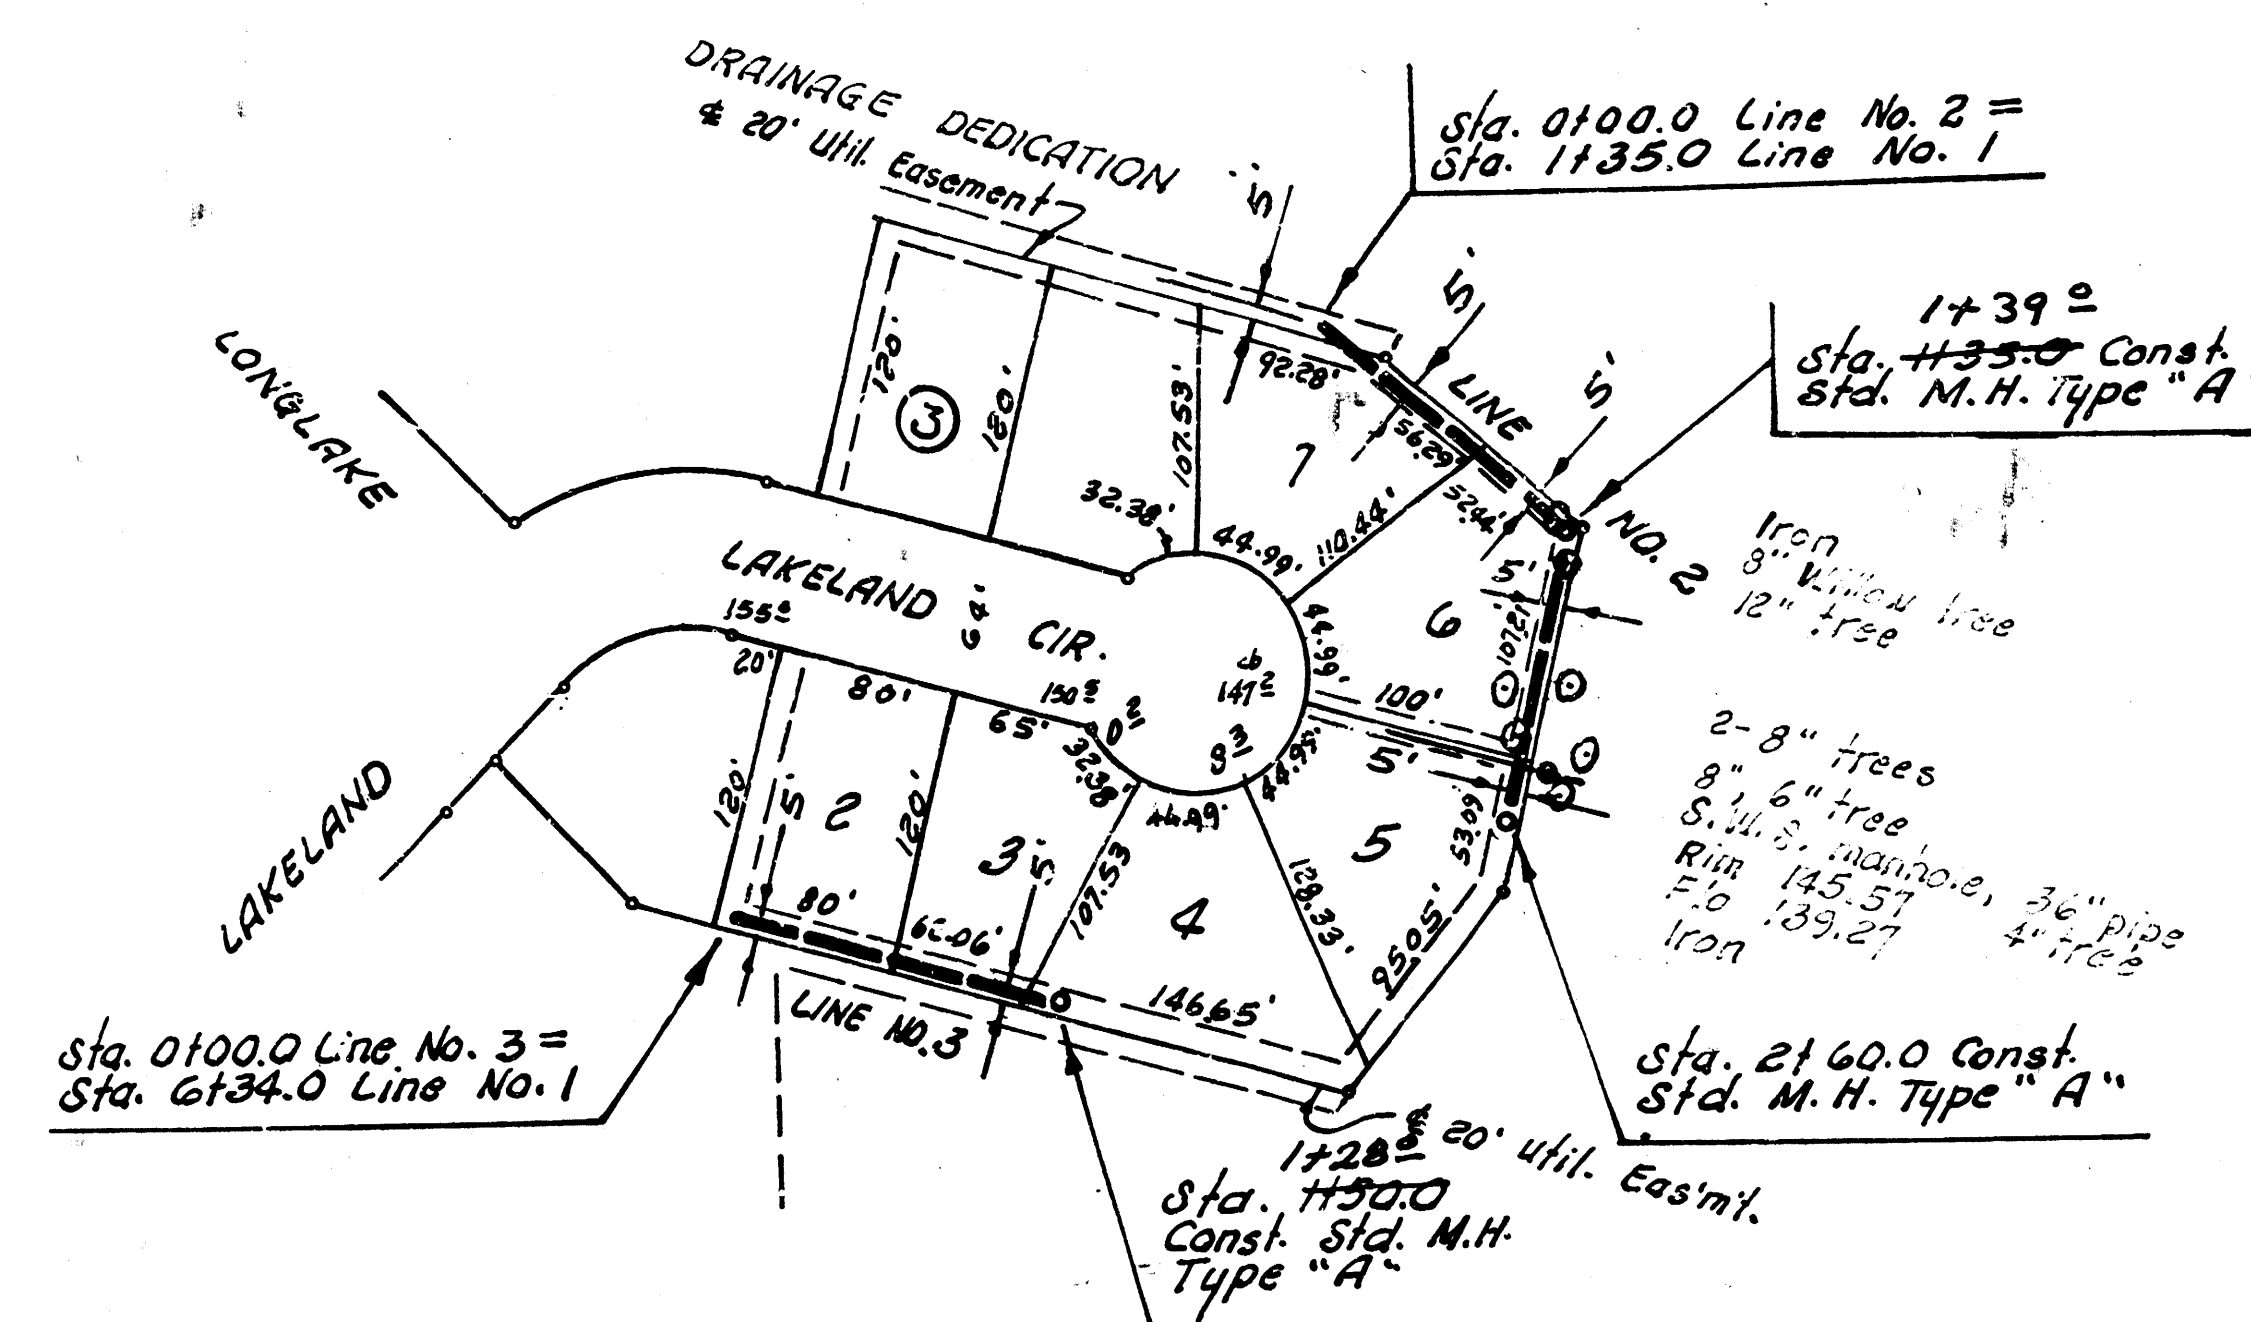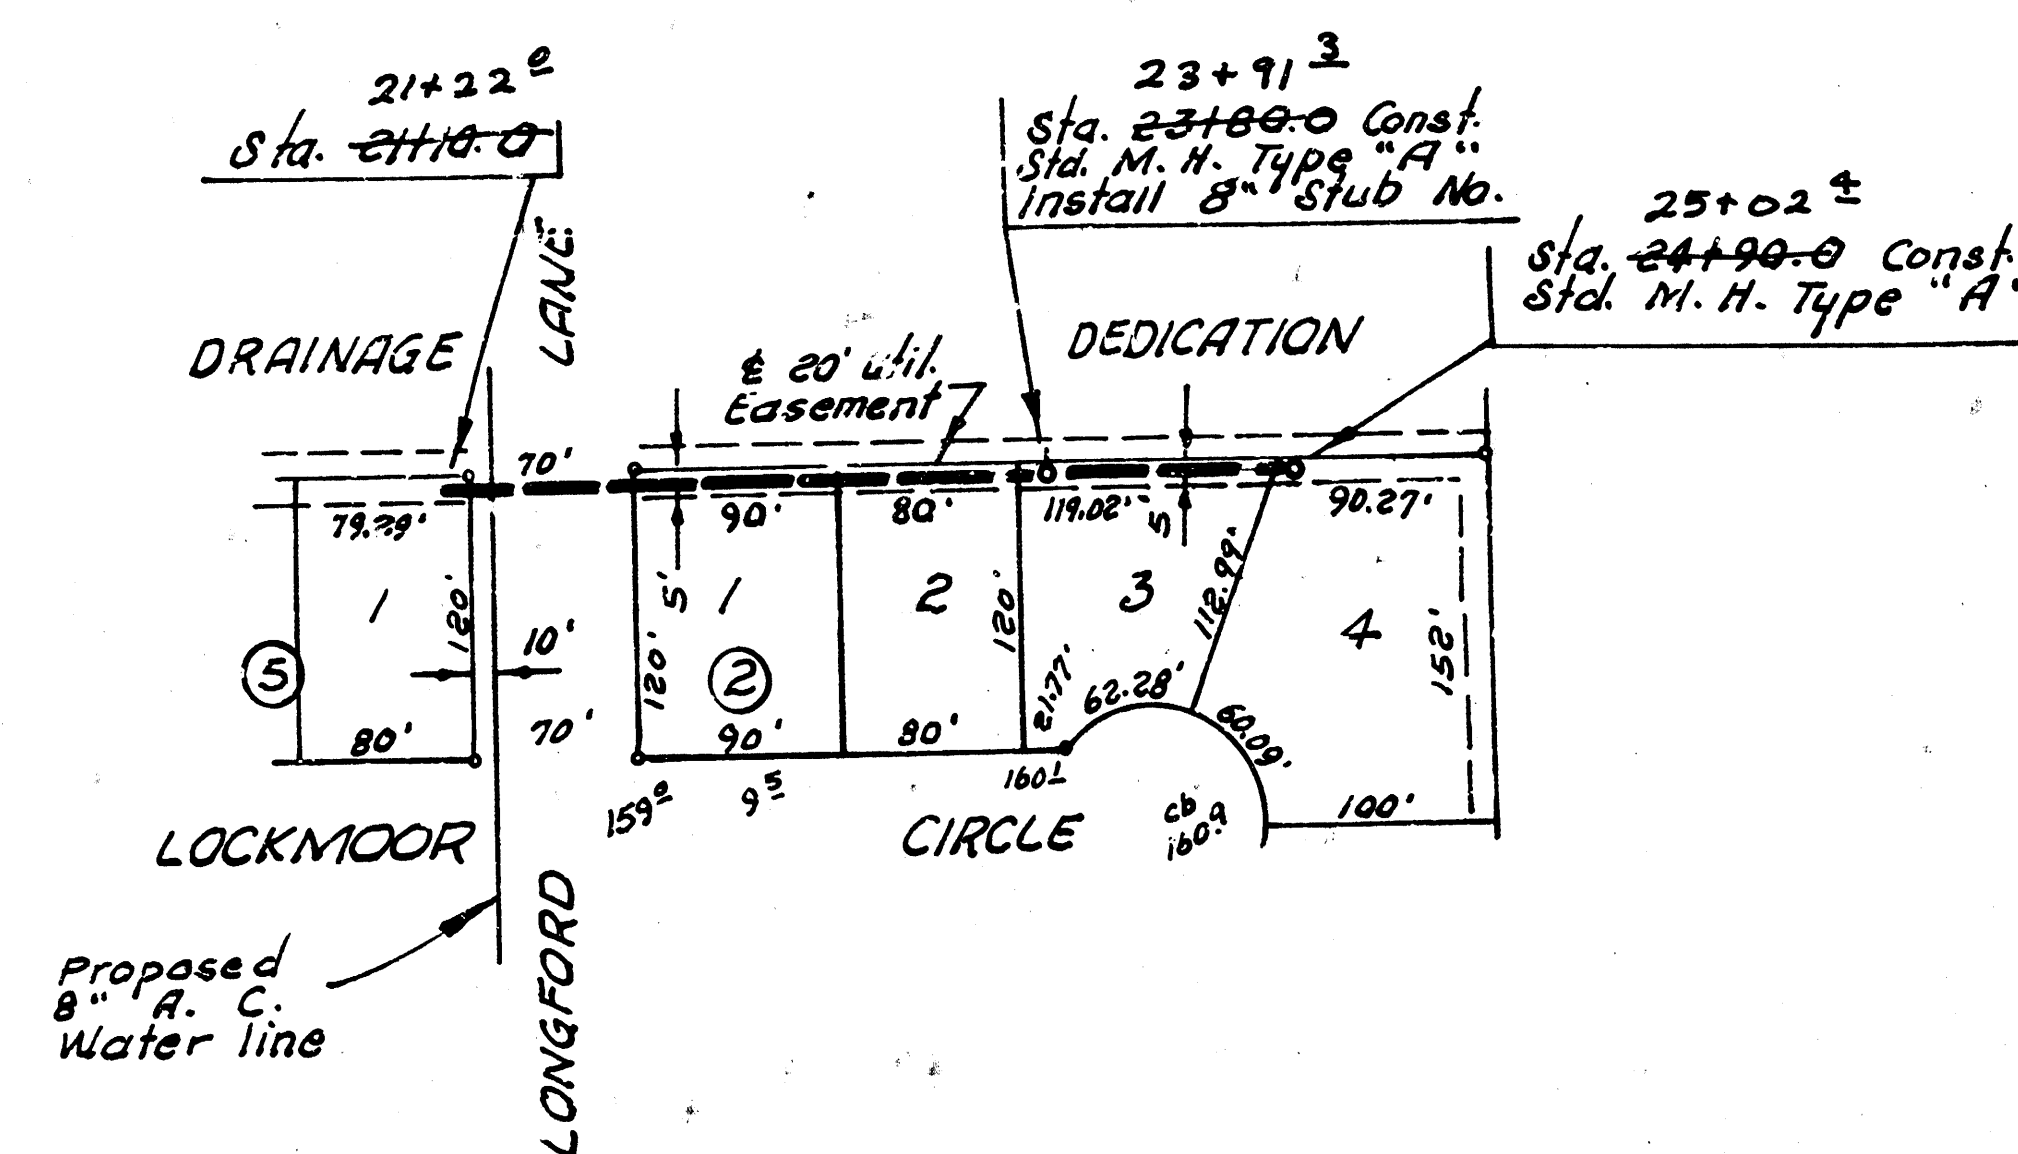

NOTE:
Contractor is to
tunnel under
Exist. 36" storm
water sewer.

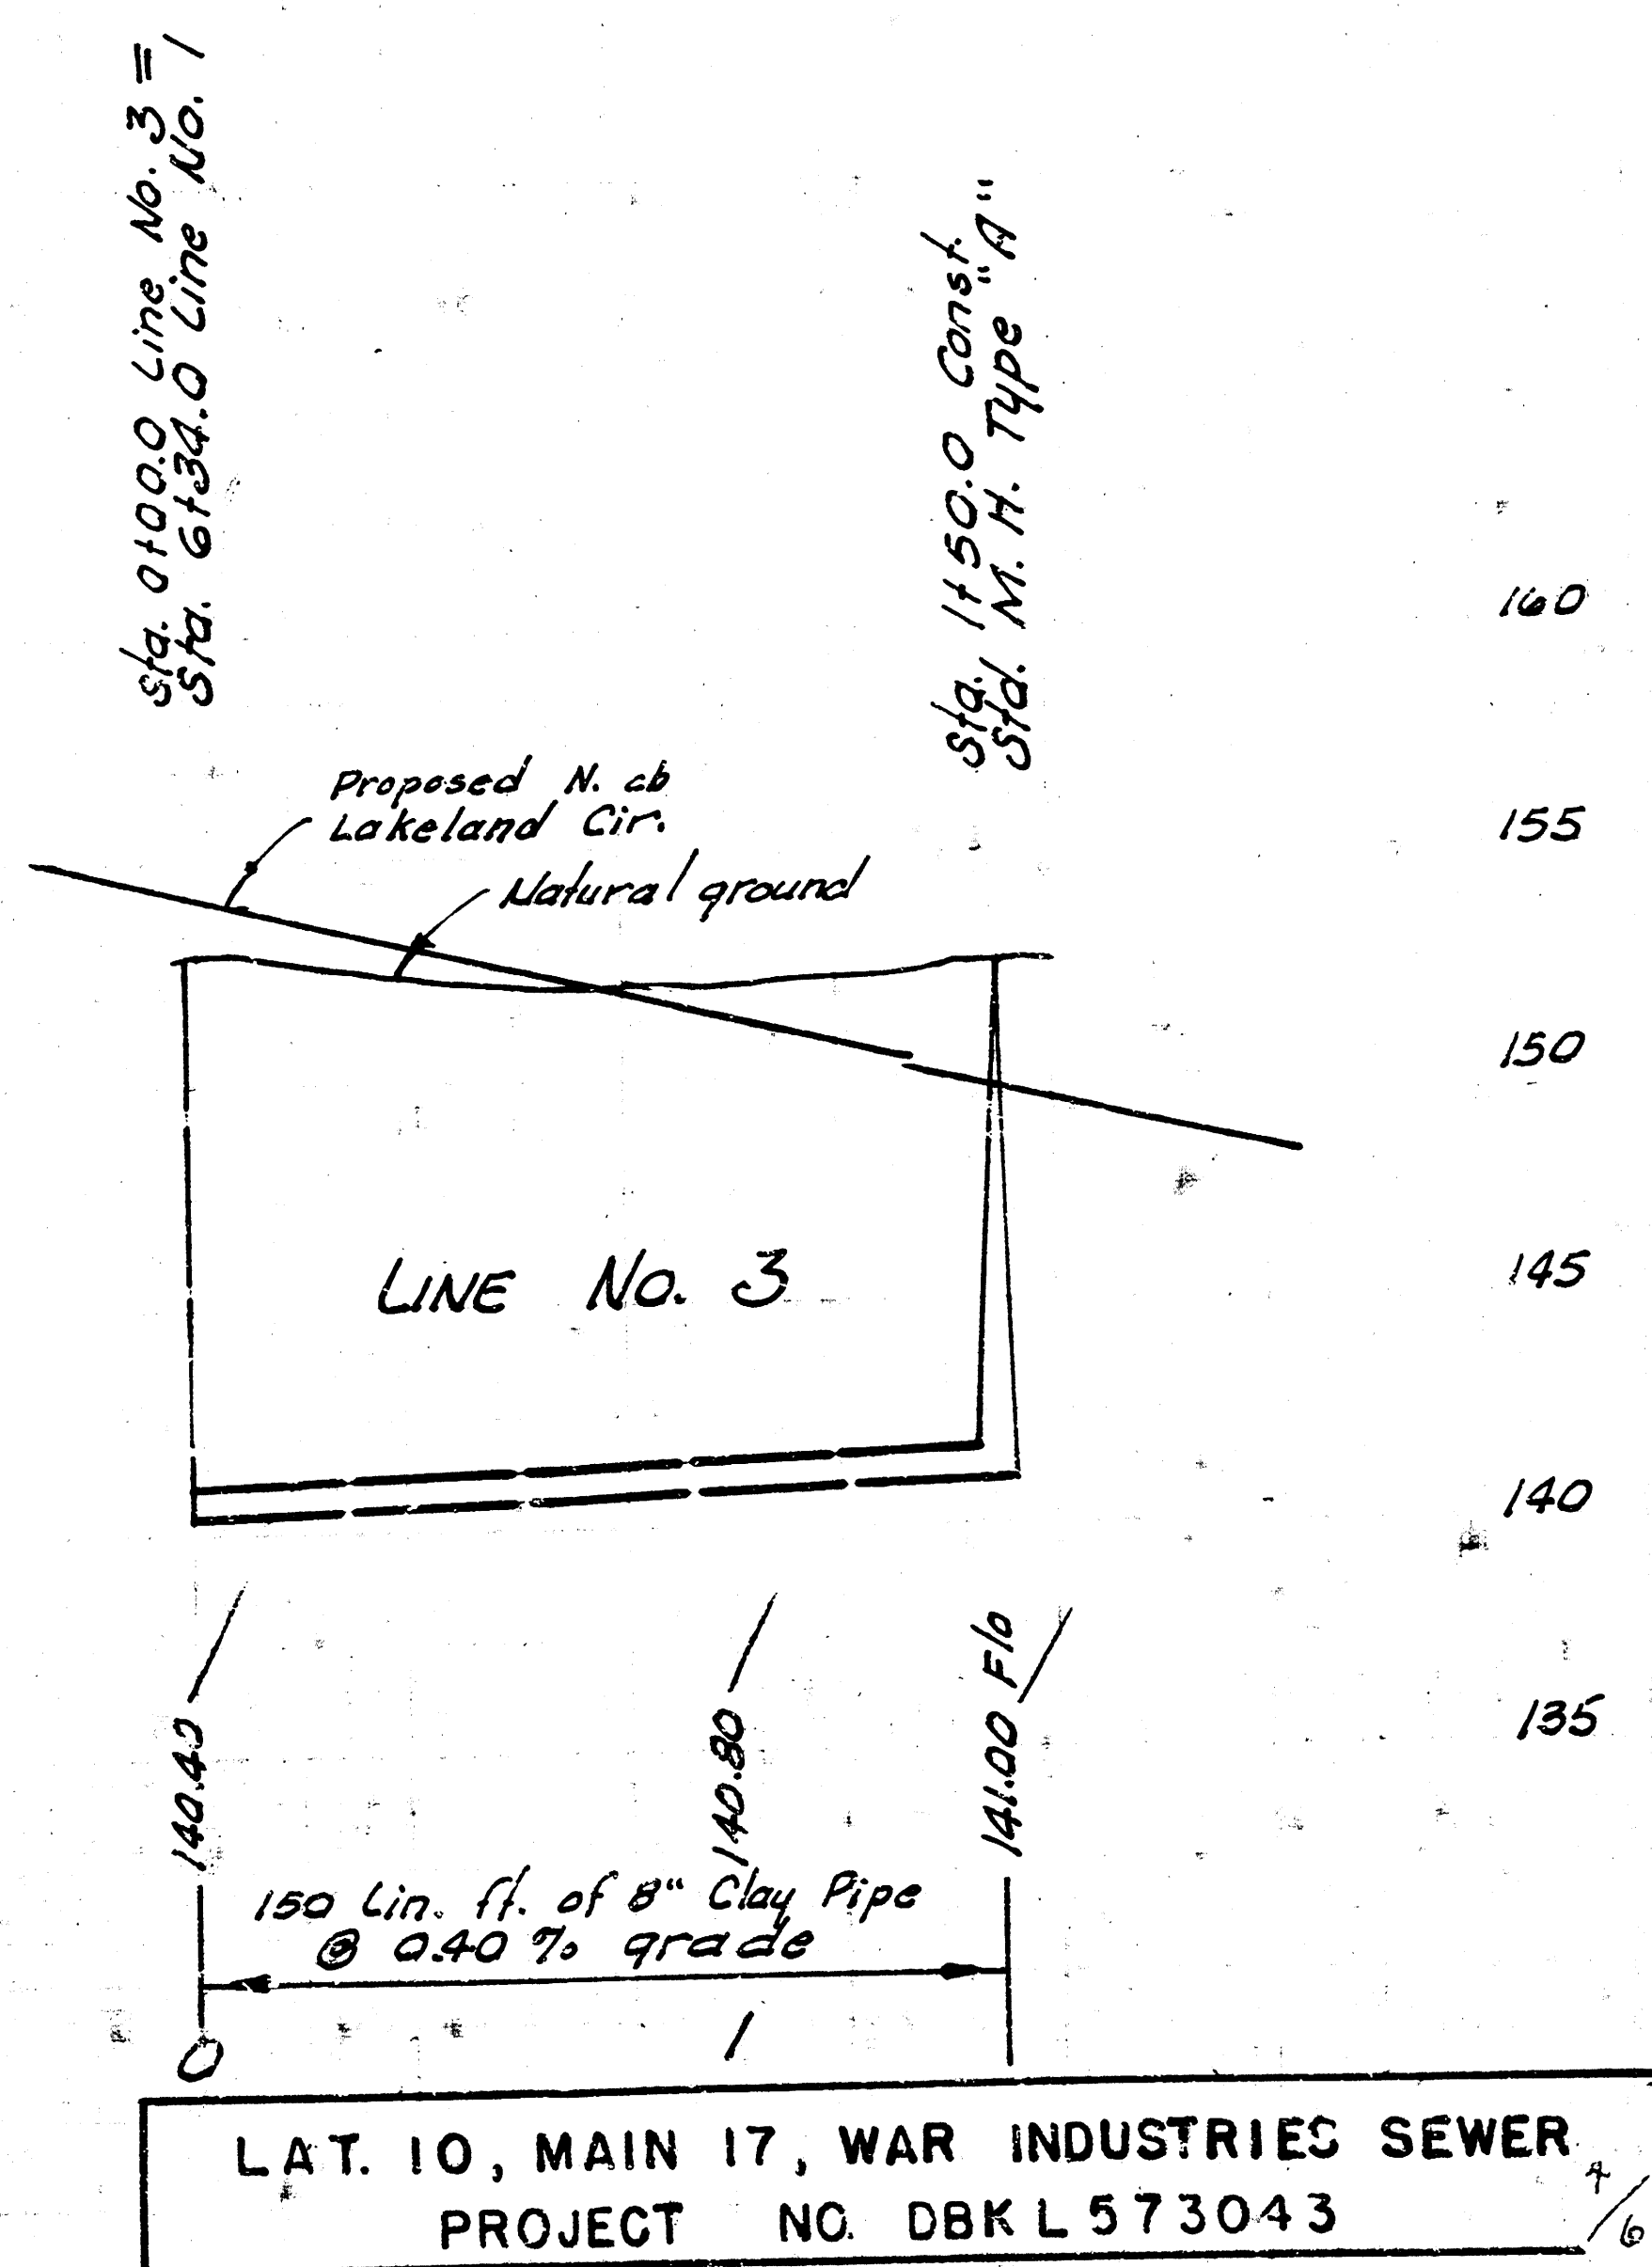

Pg. 5,6

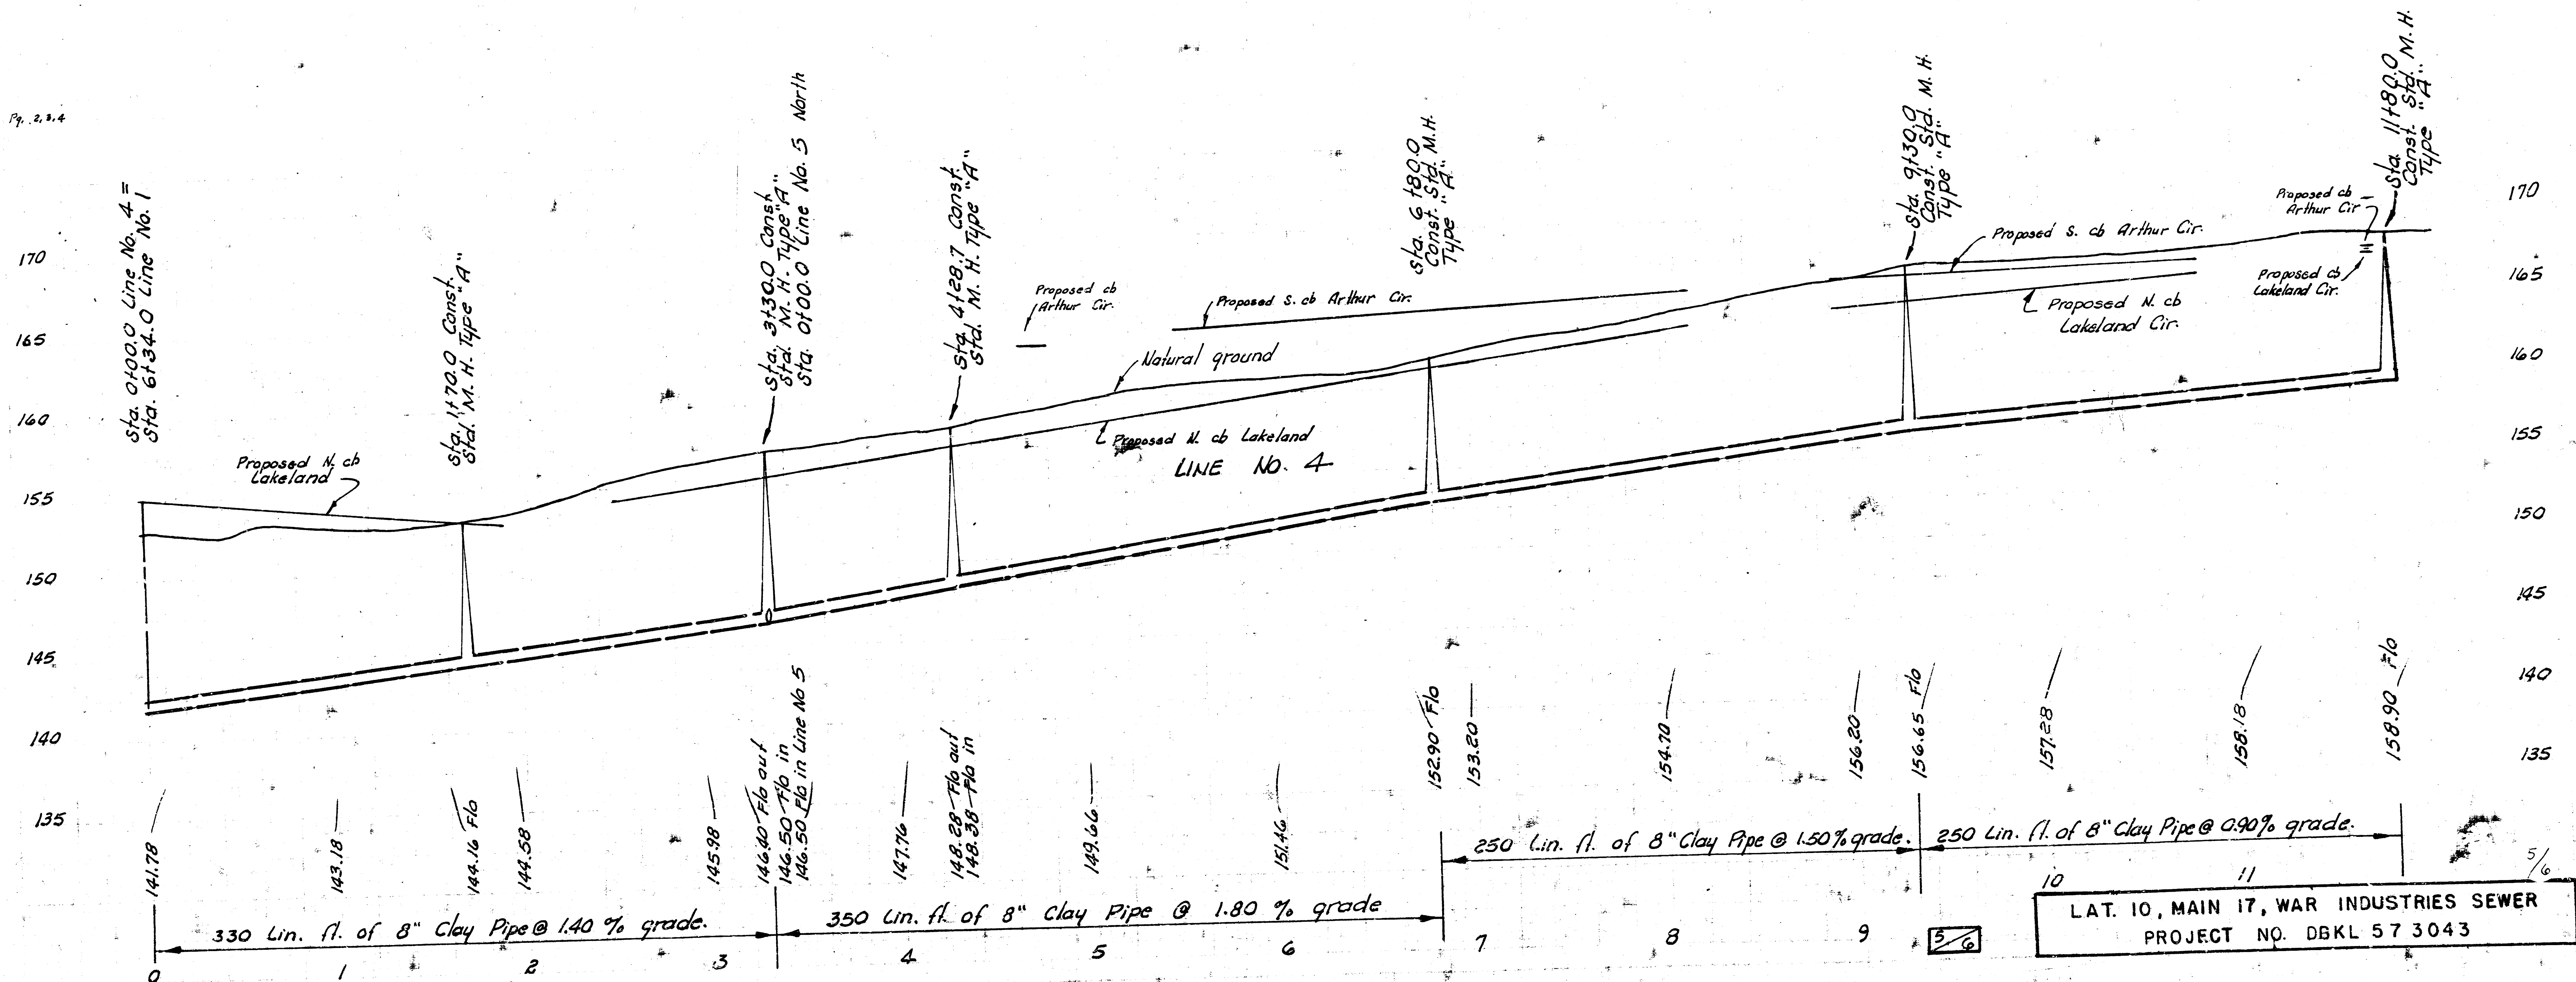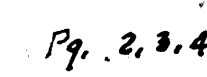

CEDAR LAKES VILLAGE FIRST ADDITION

