

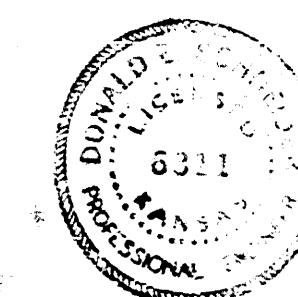


LAT. 10, MAIN 17, WAR INDUSTRIES SEWER
 CITY OF WICHITA, KANSAS
 R. W. LINN - CITY ENGINEER
 SEPT. 1973, PROJECT NO. DBK M 573 043


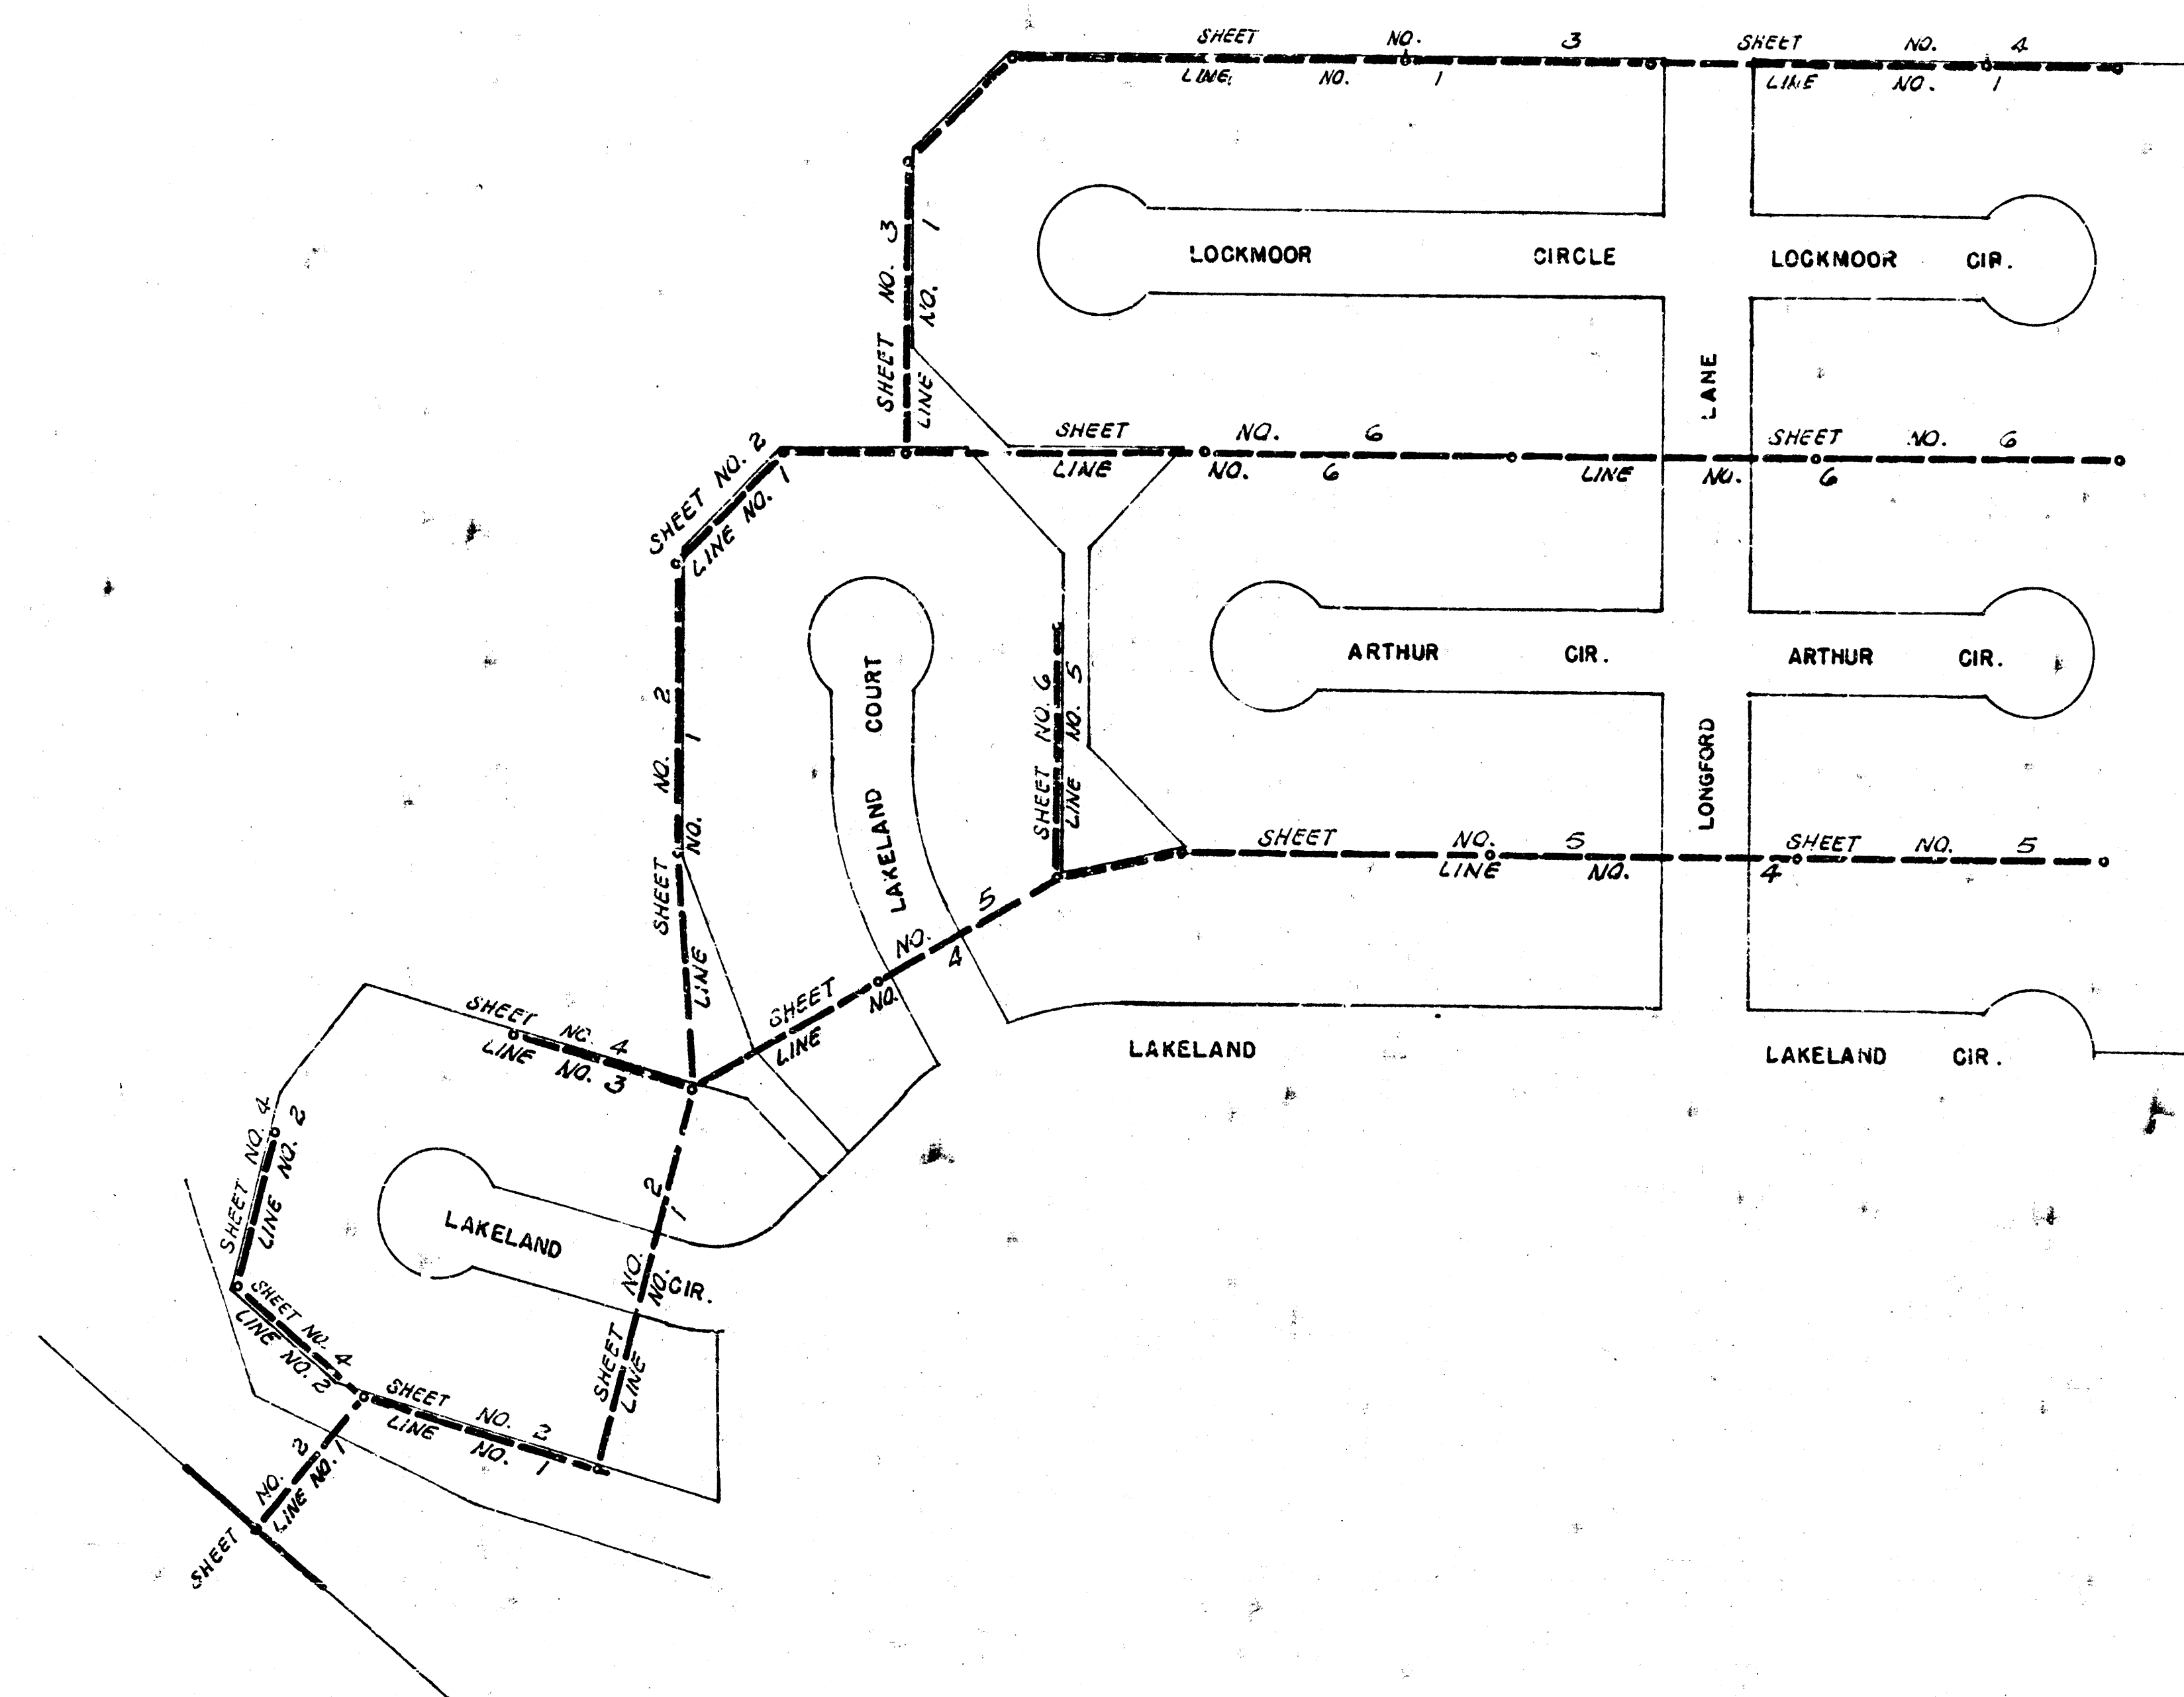


"As Built" final Meas. 279-Y

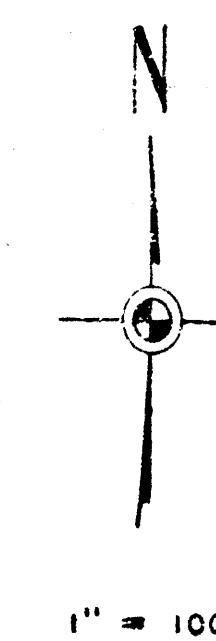


LAT. 10, MAIN 17, WAR INDUSTRIES SEWER
 PROJECT NO. DBK L 573 043

- B.M. #1 C. 1/4 Sec. 42' W. & 48' S. of 1/4 Sec. cor.
1/8 mi. E. of Rock Rd. & Harry 161.824
- B.M. #2 "T" on NW cor. N. Handrail R.C. B.C.
on Harry 238' E. of E. Rock Rd. 145.41
- B.M. #3 "a" cut NW cor. N. Headwall 85' W. of
W.L. Longford Lane So. on Harry St. 159.08
- B.M. #4 Top steel T-Fnc. Post 38' N. of N.L.
Longford Lane & E.L. Cedar Lakes Road. 164.53
- B.M. #5 "a" cut NW cor. N. wing wall on Dam opp.
130 S. of Lakeland Cir. 153.495


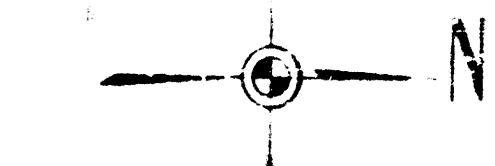
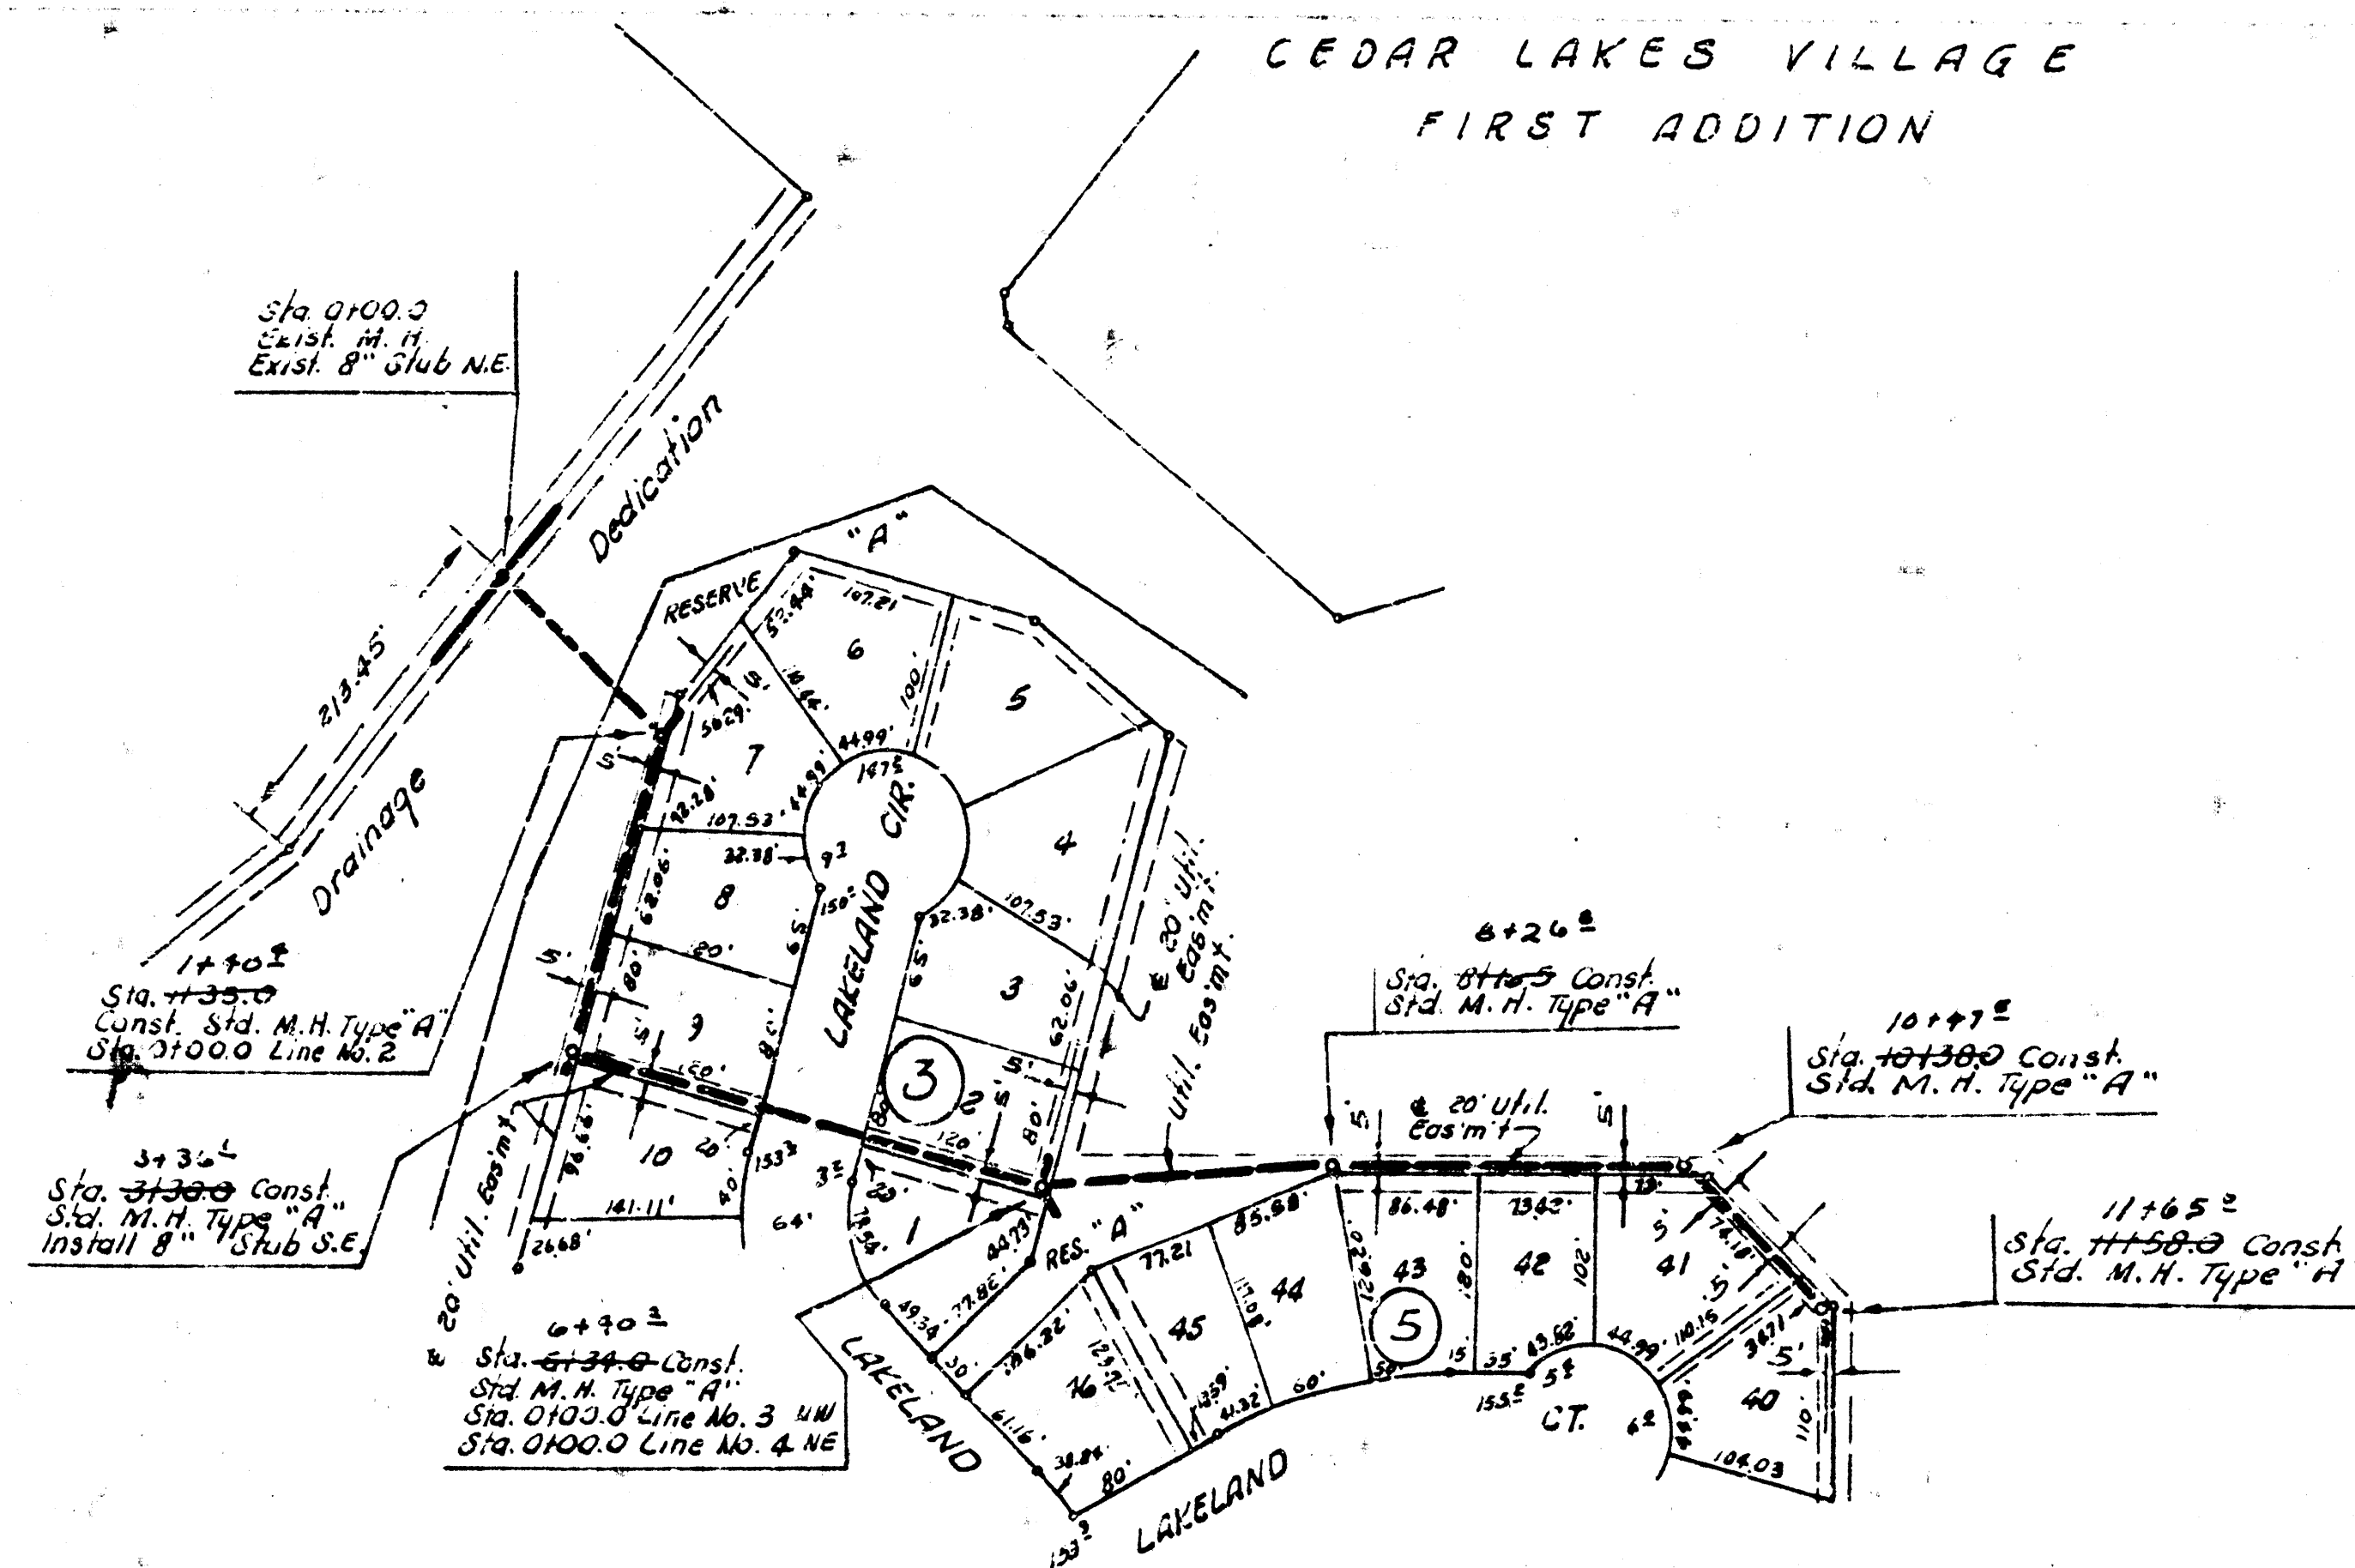


Plan Scale 1" = 100'
Profile Scale 1" = 40' horiz.
1" = 5' vert.

• Irons set



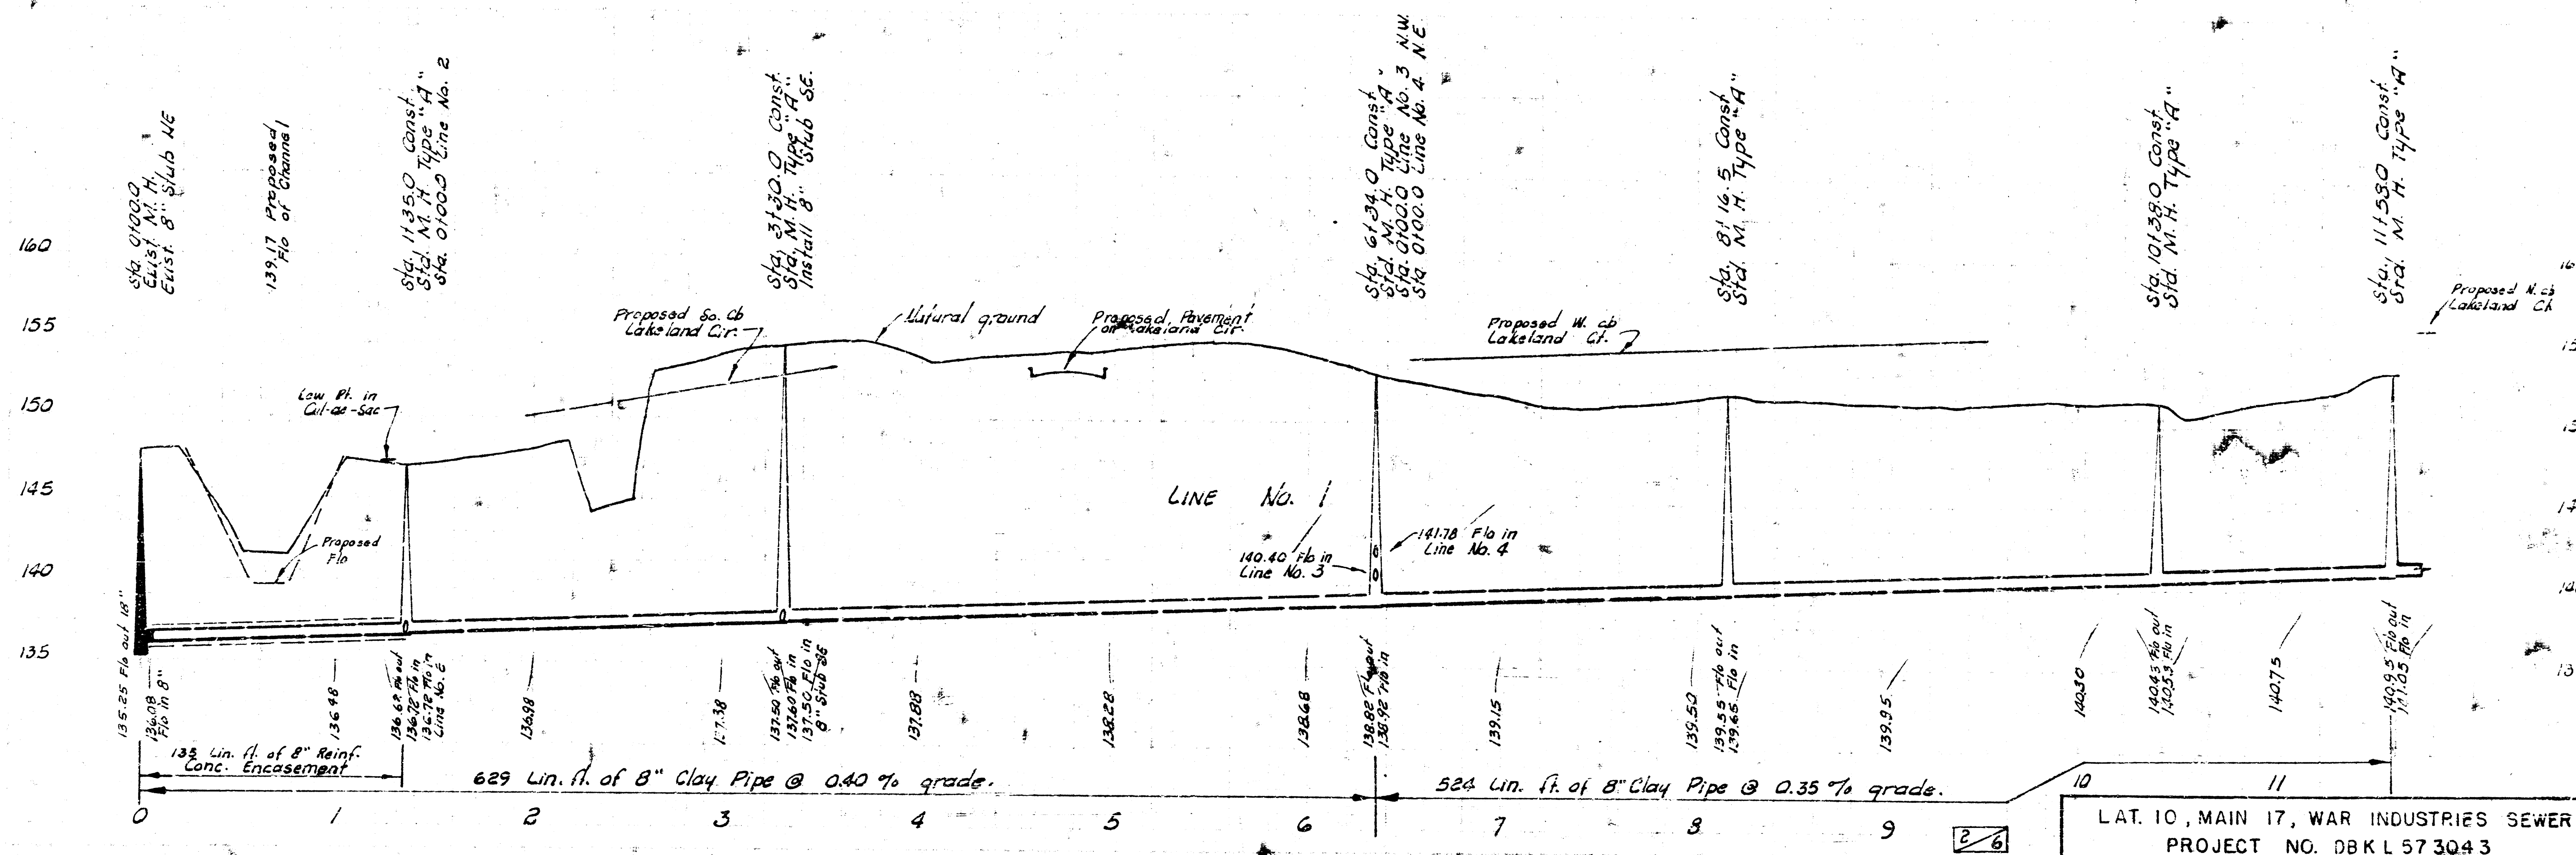


CEDAR LAKES VILLAGE
FIRST ADDITION

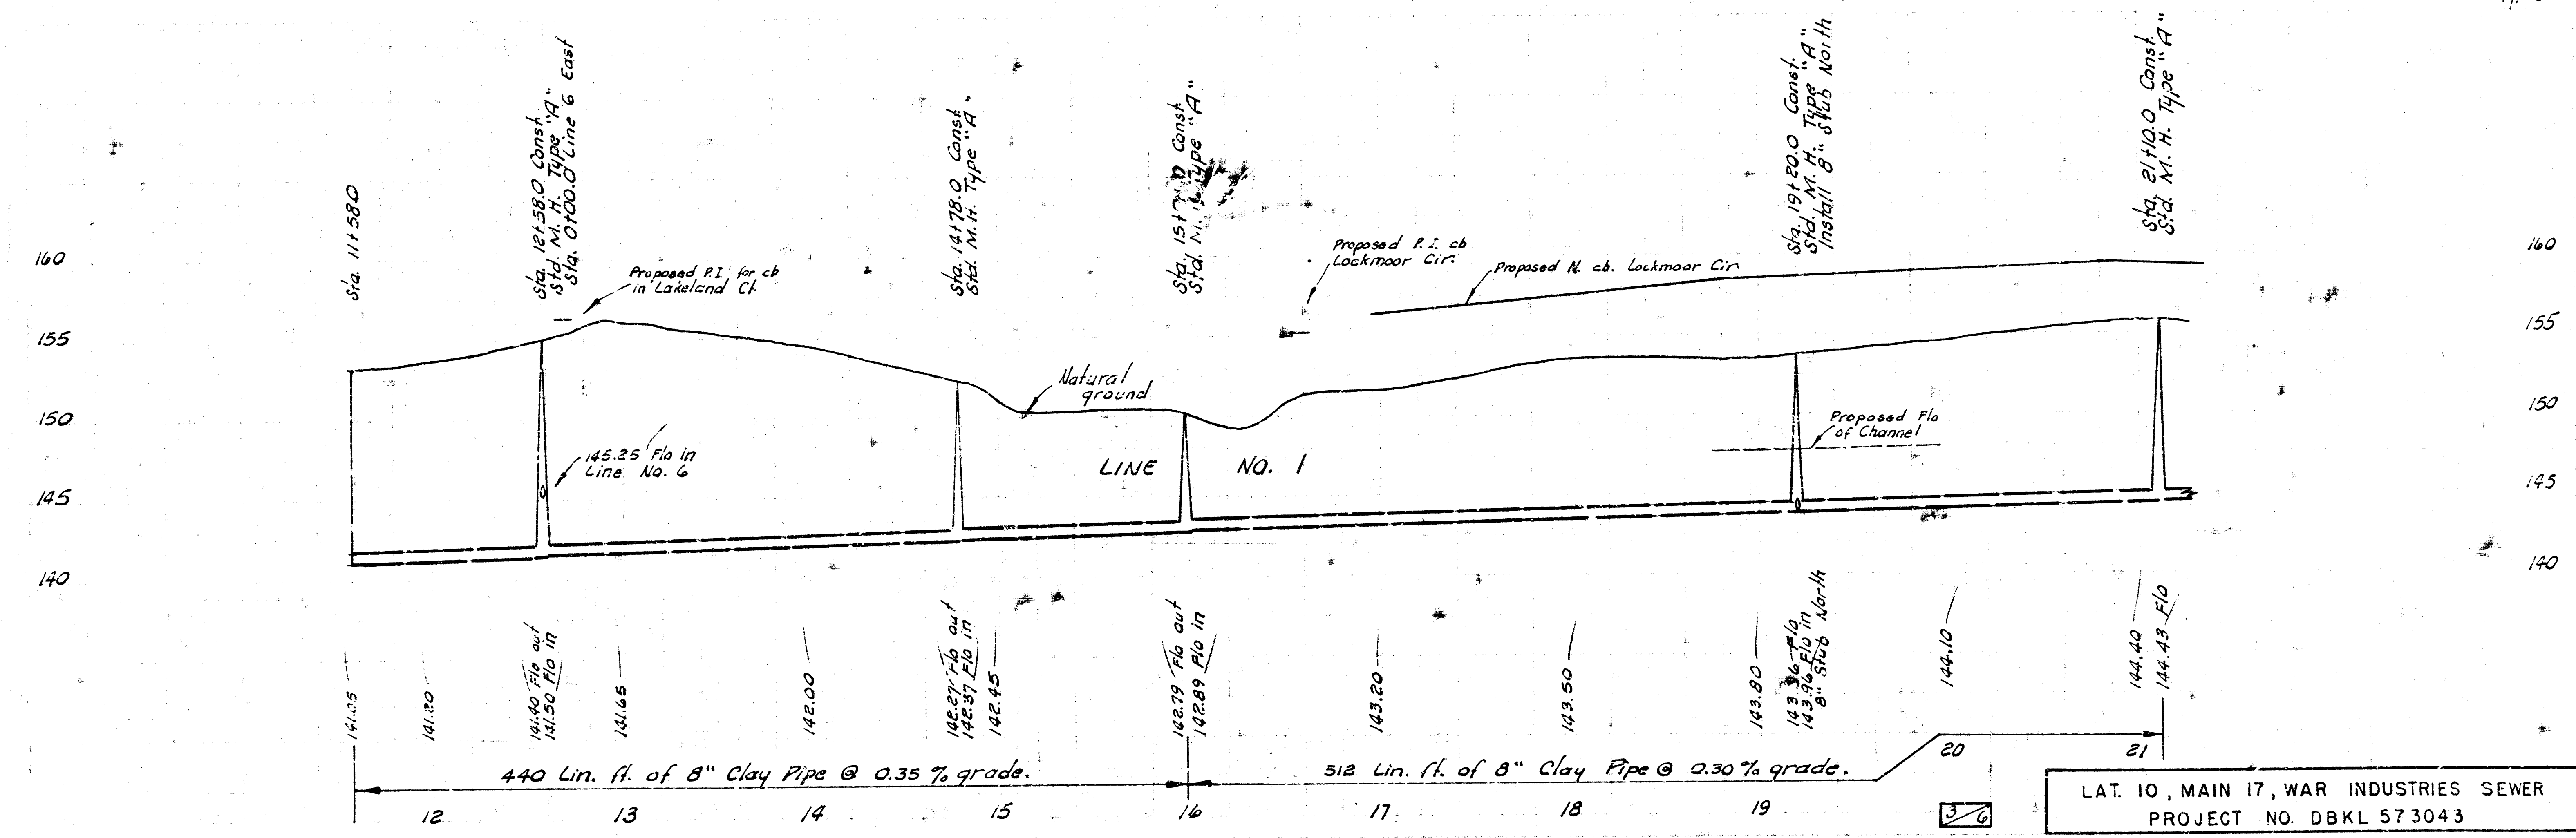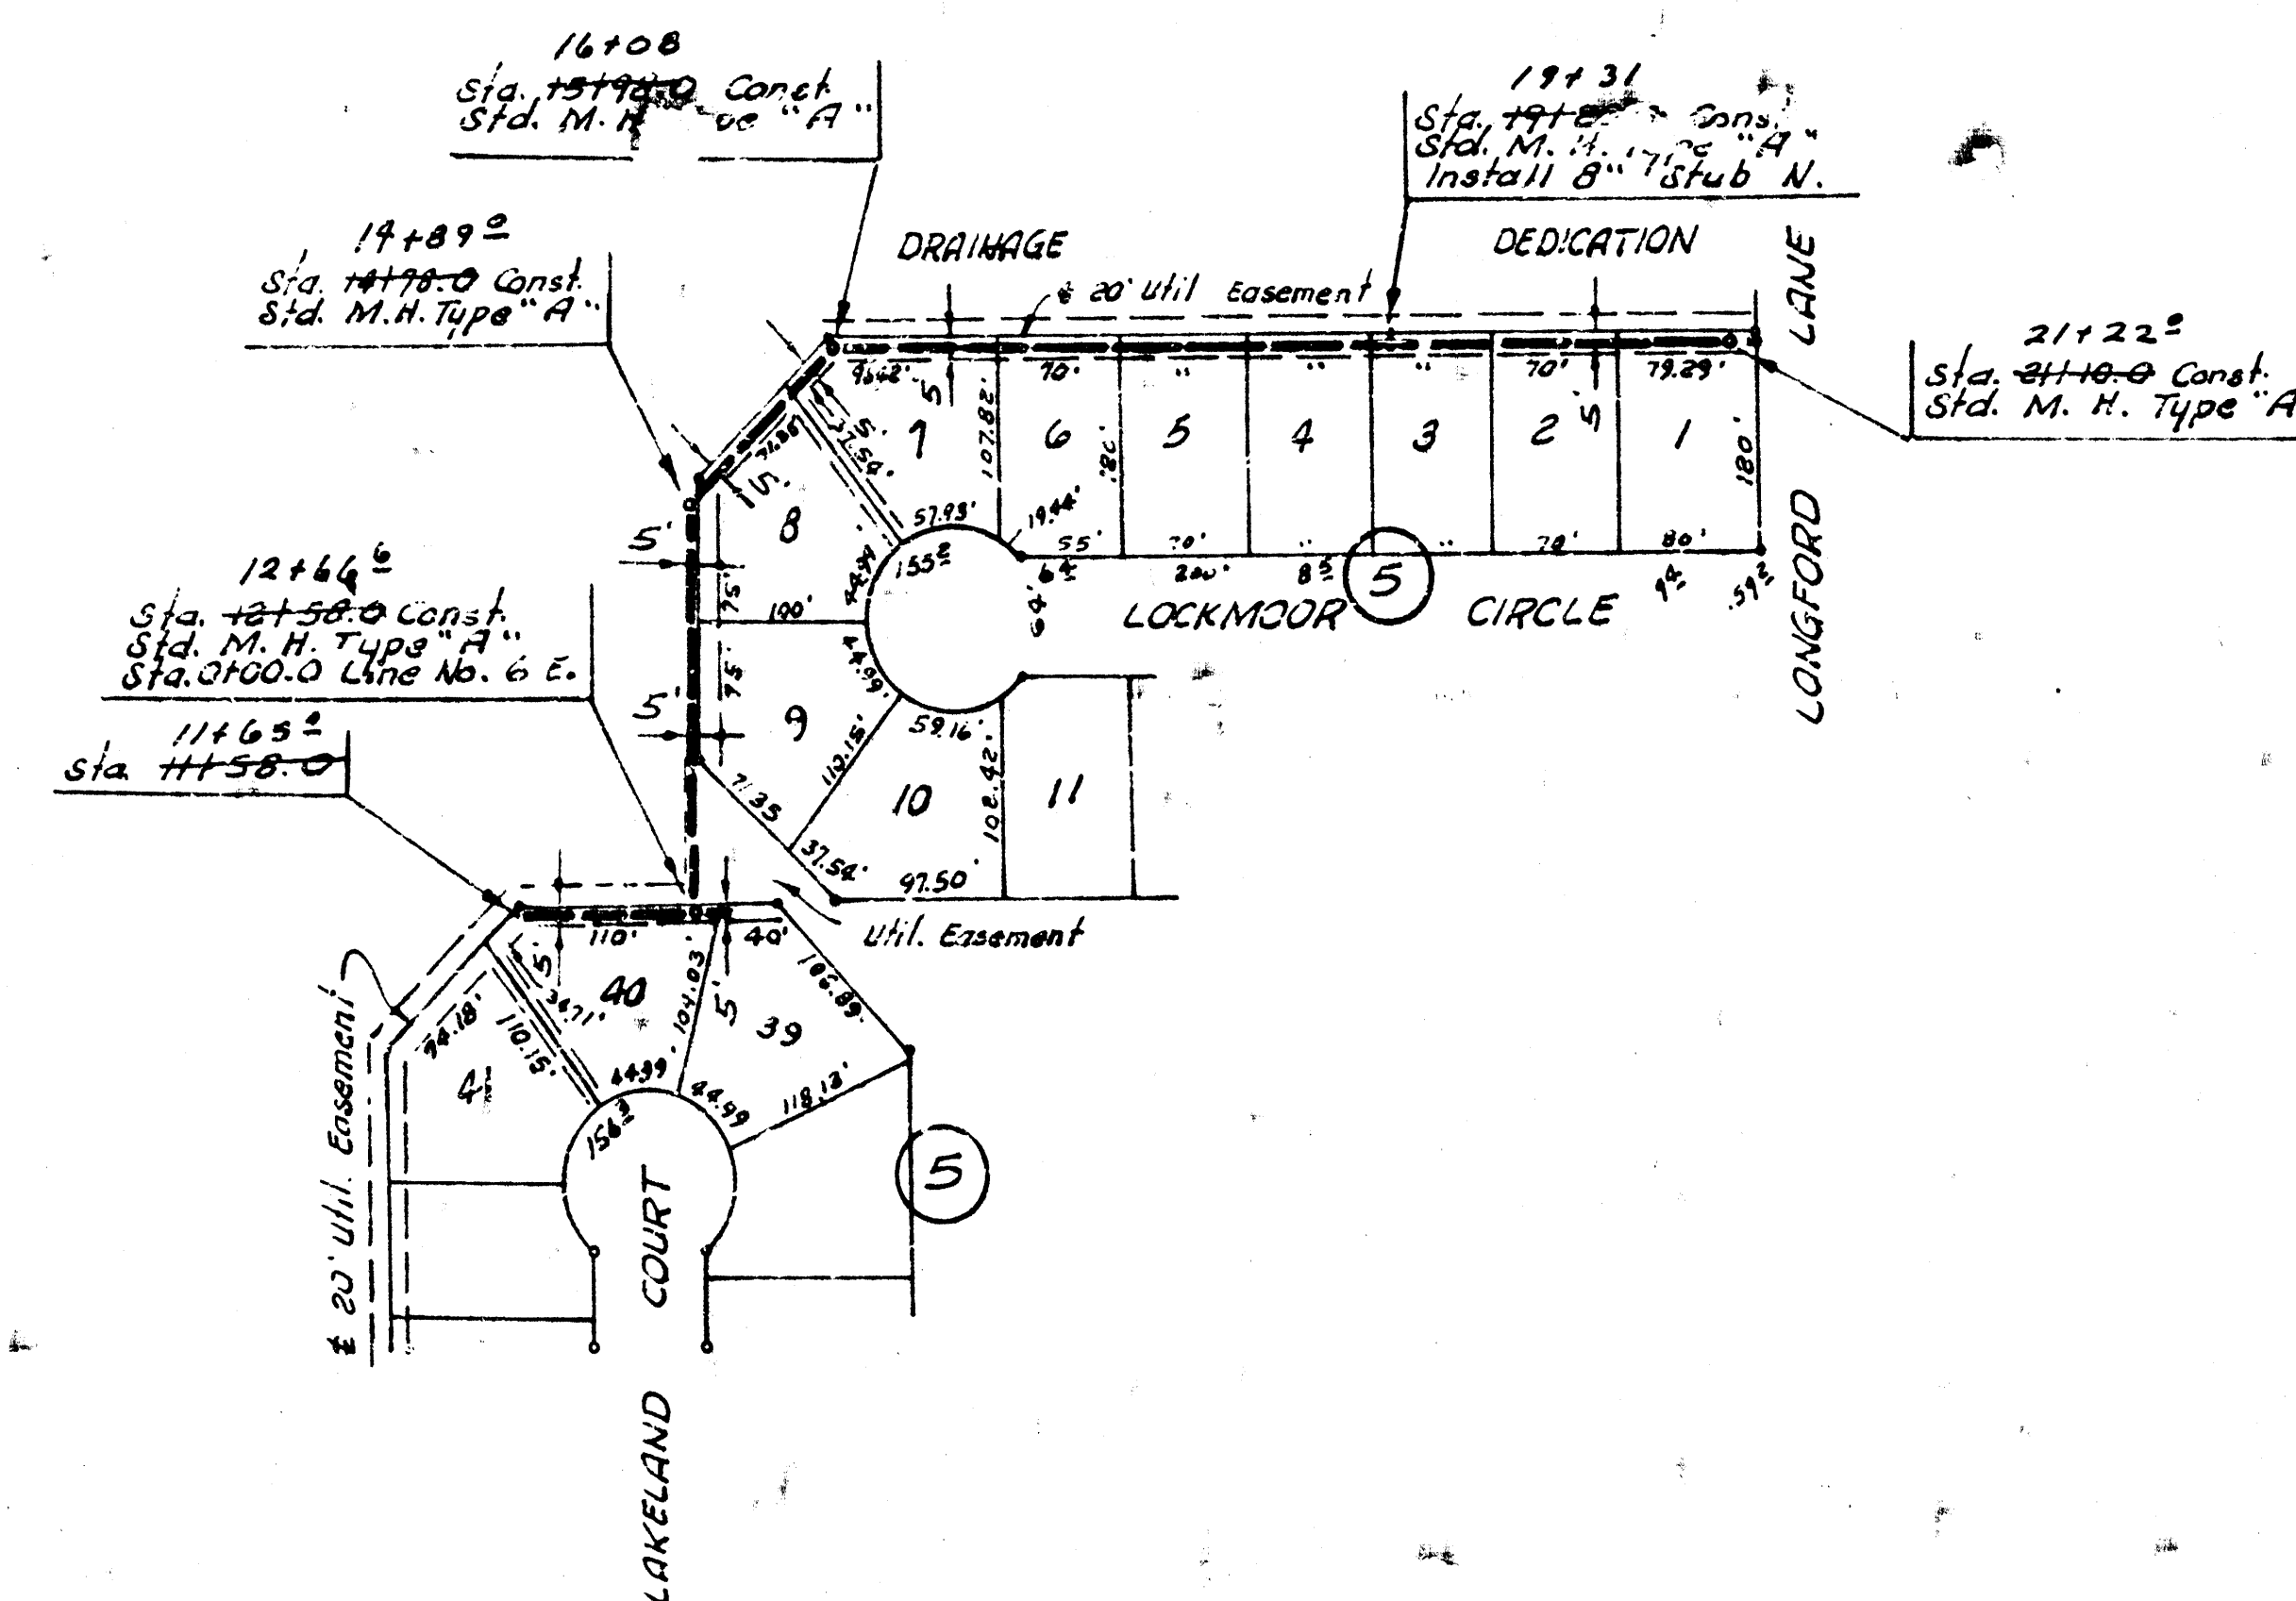
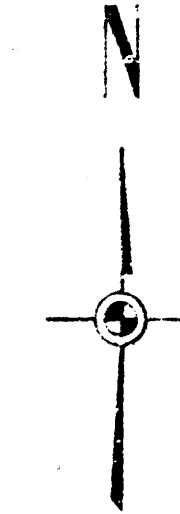


LAT. 10, MAIN 17, WAR INDUSTRIES SEWER
PROJECT NO. DBKL 573043


CEDAR LAKE VILLAGE
FIRST ADDITION

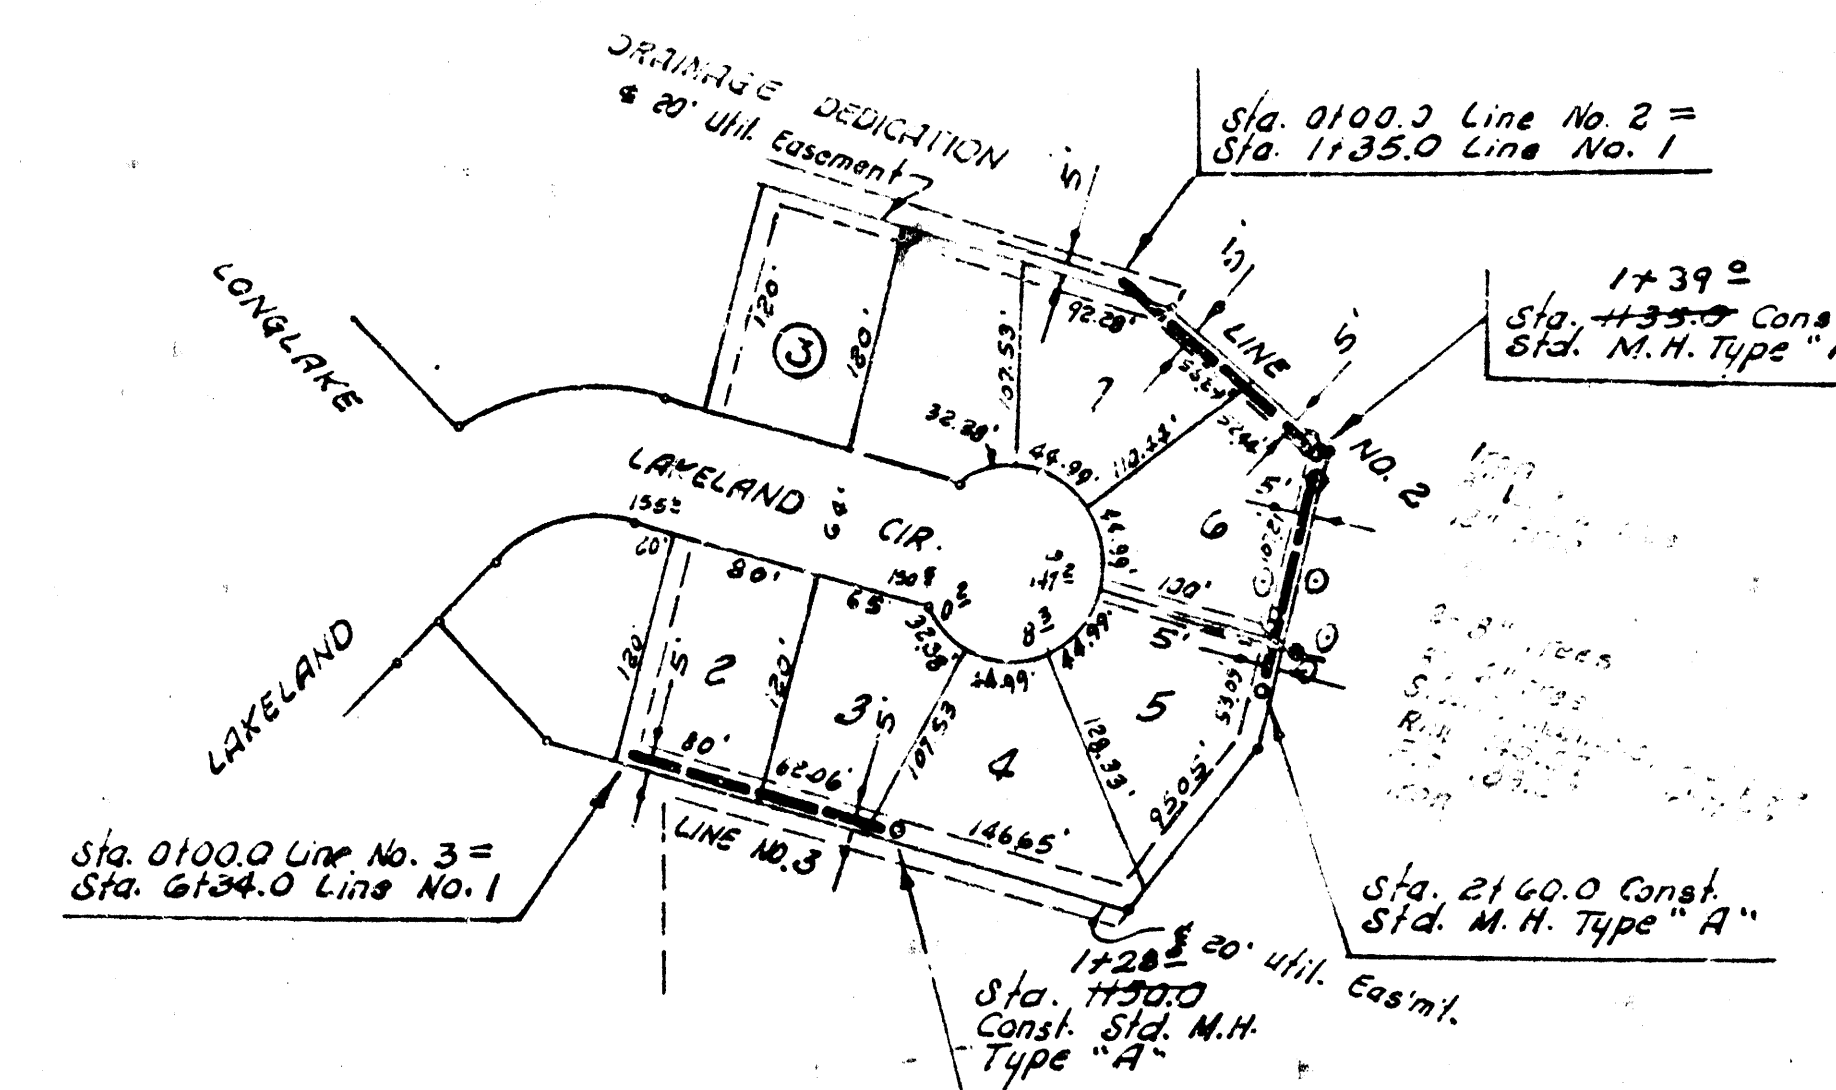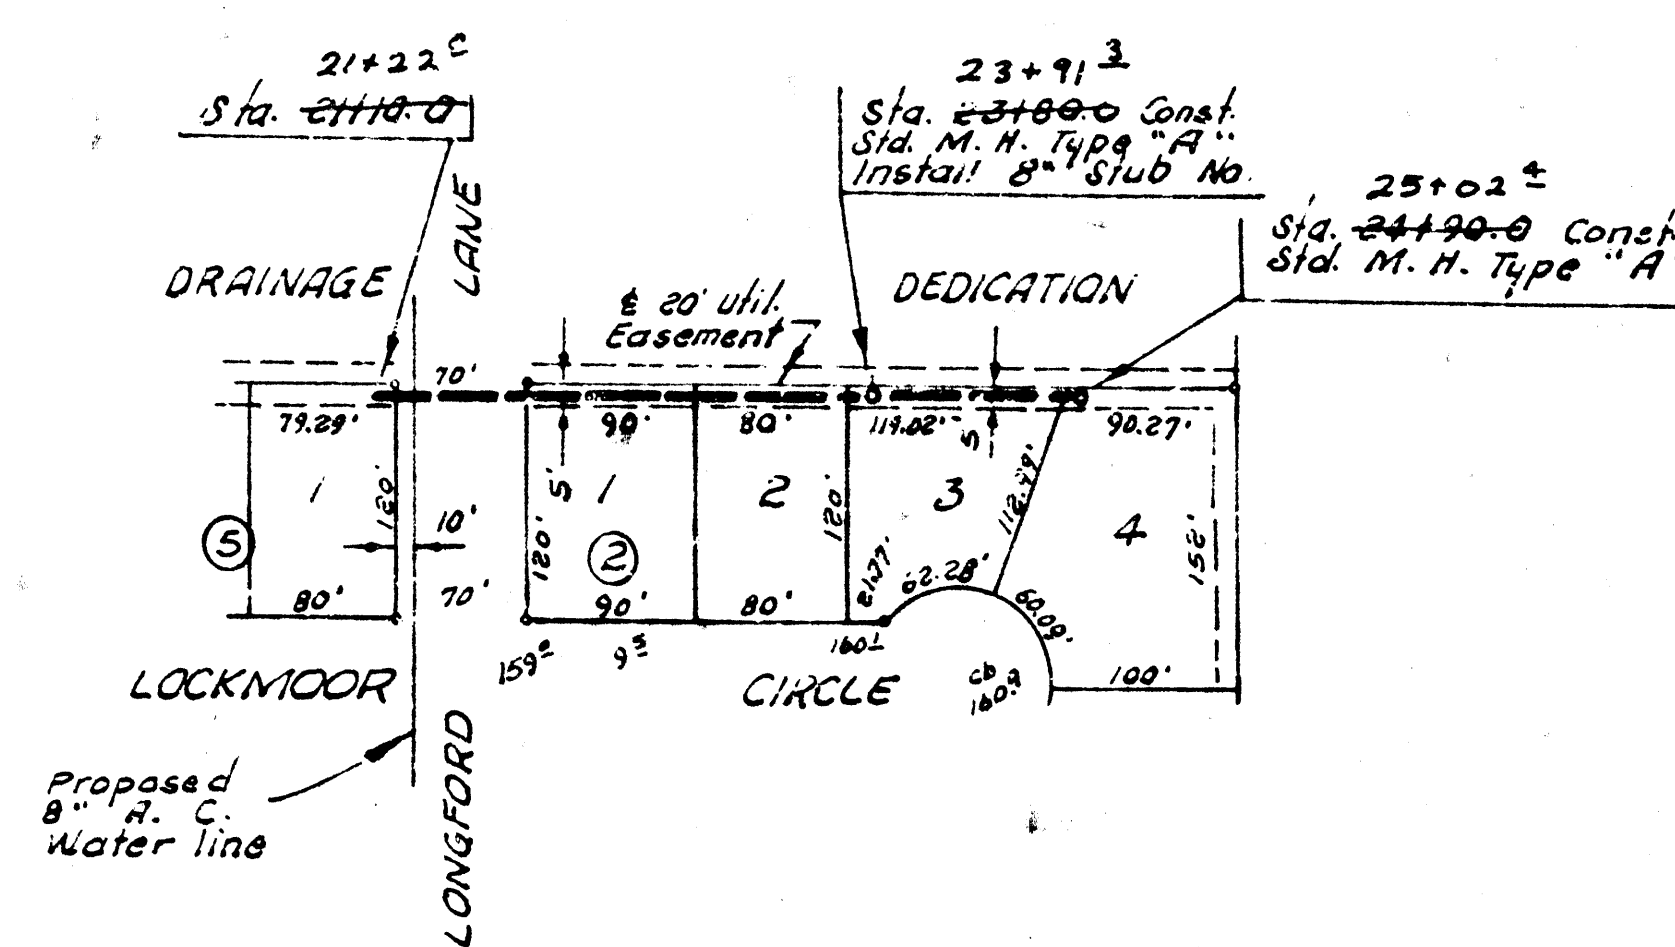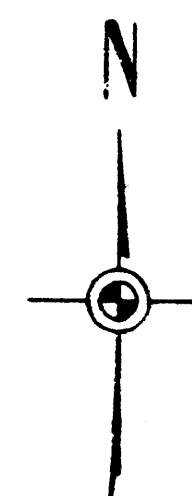


Pg. 11, 12

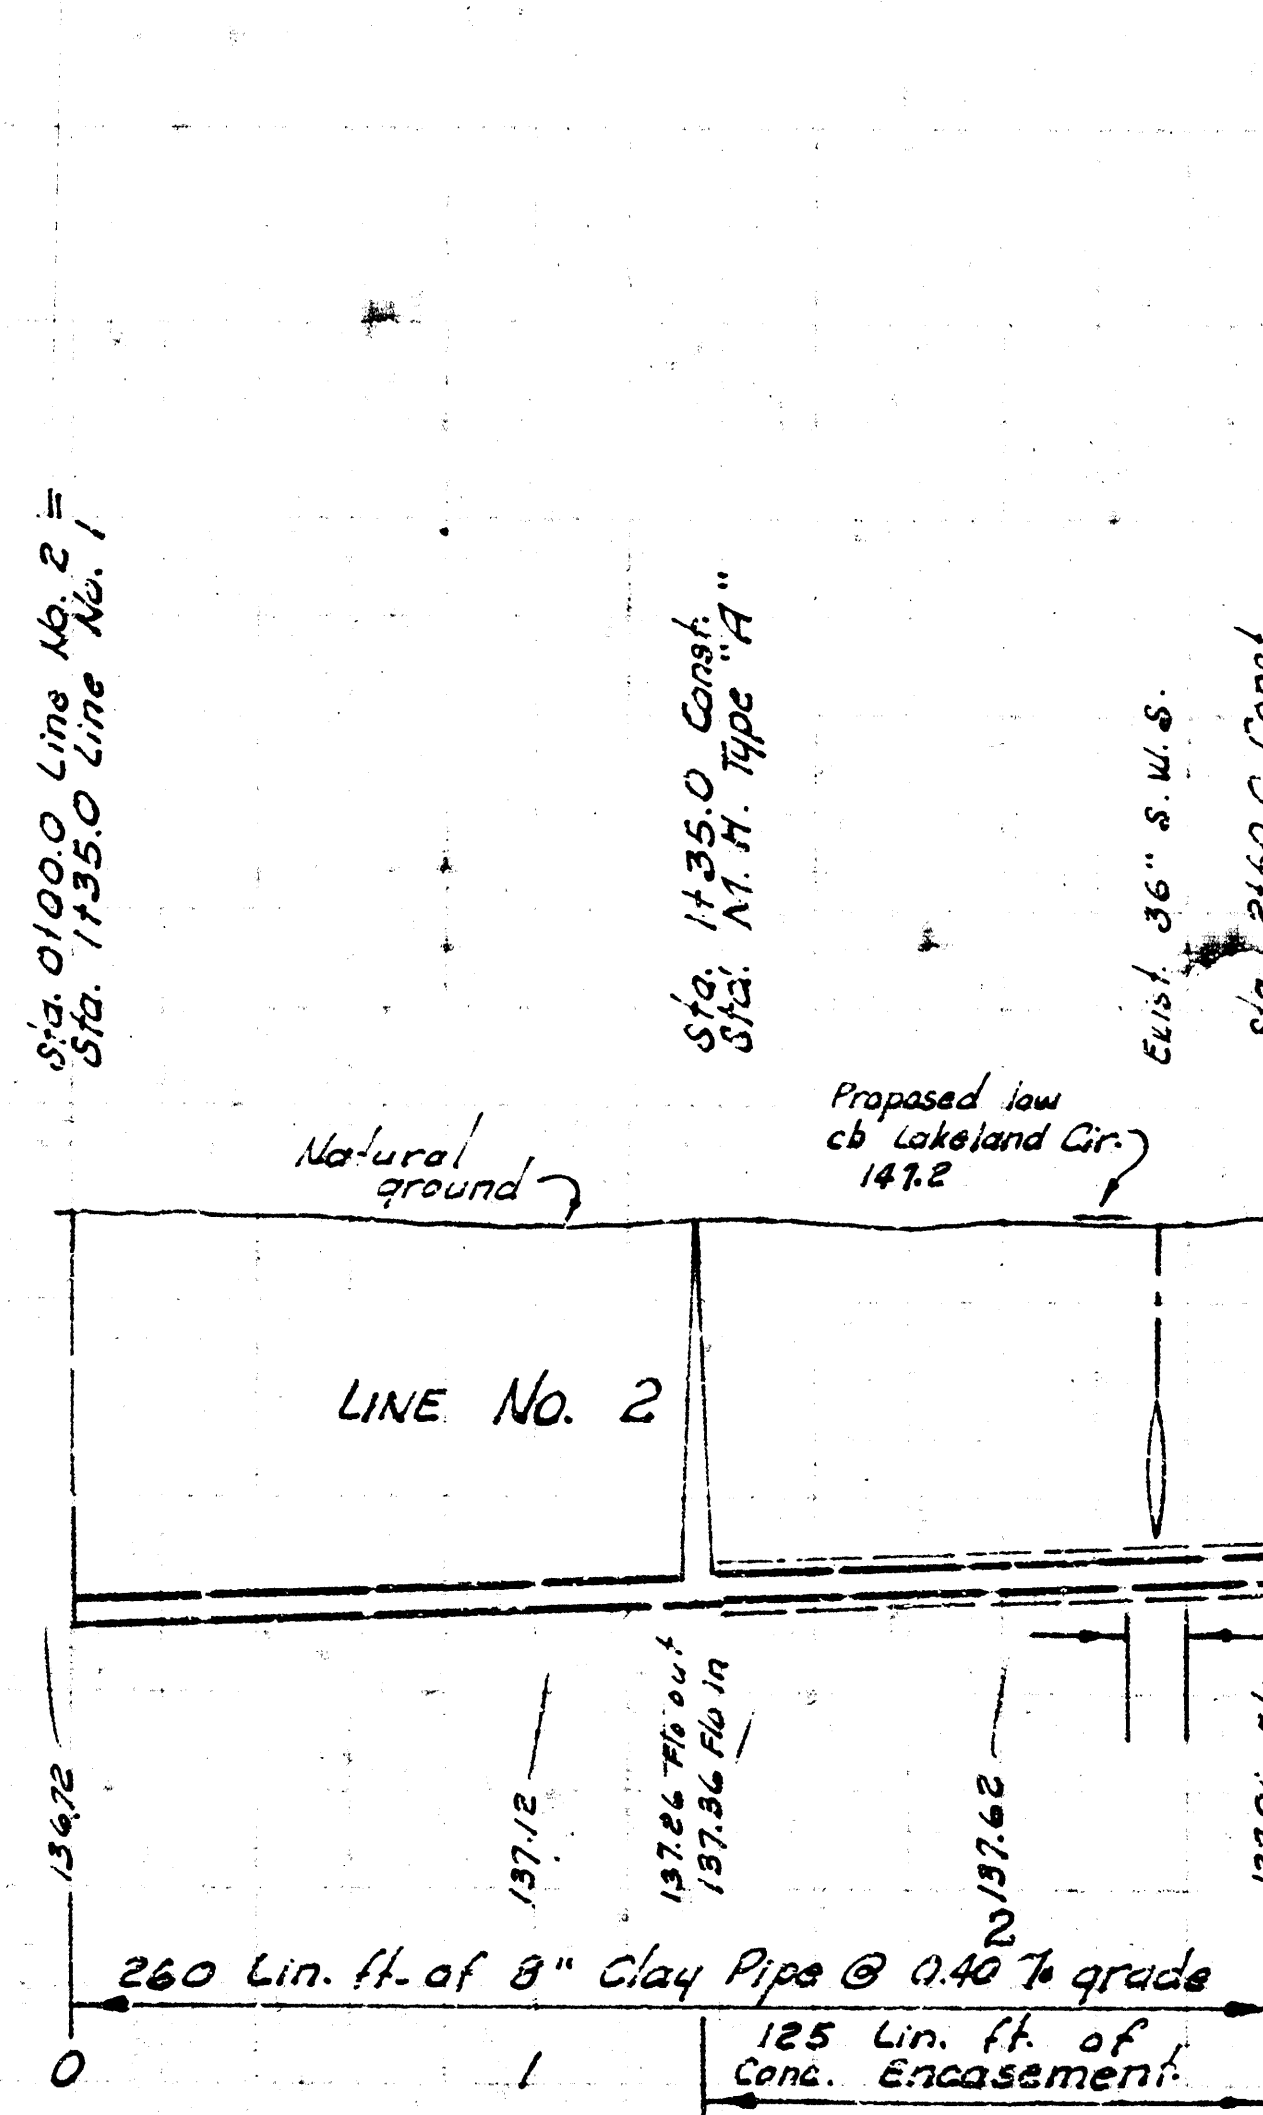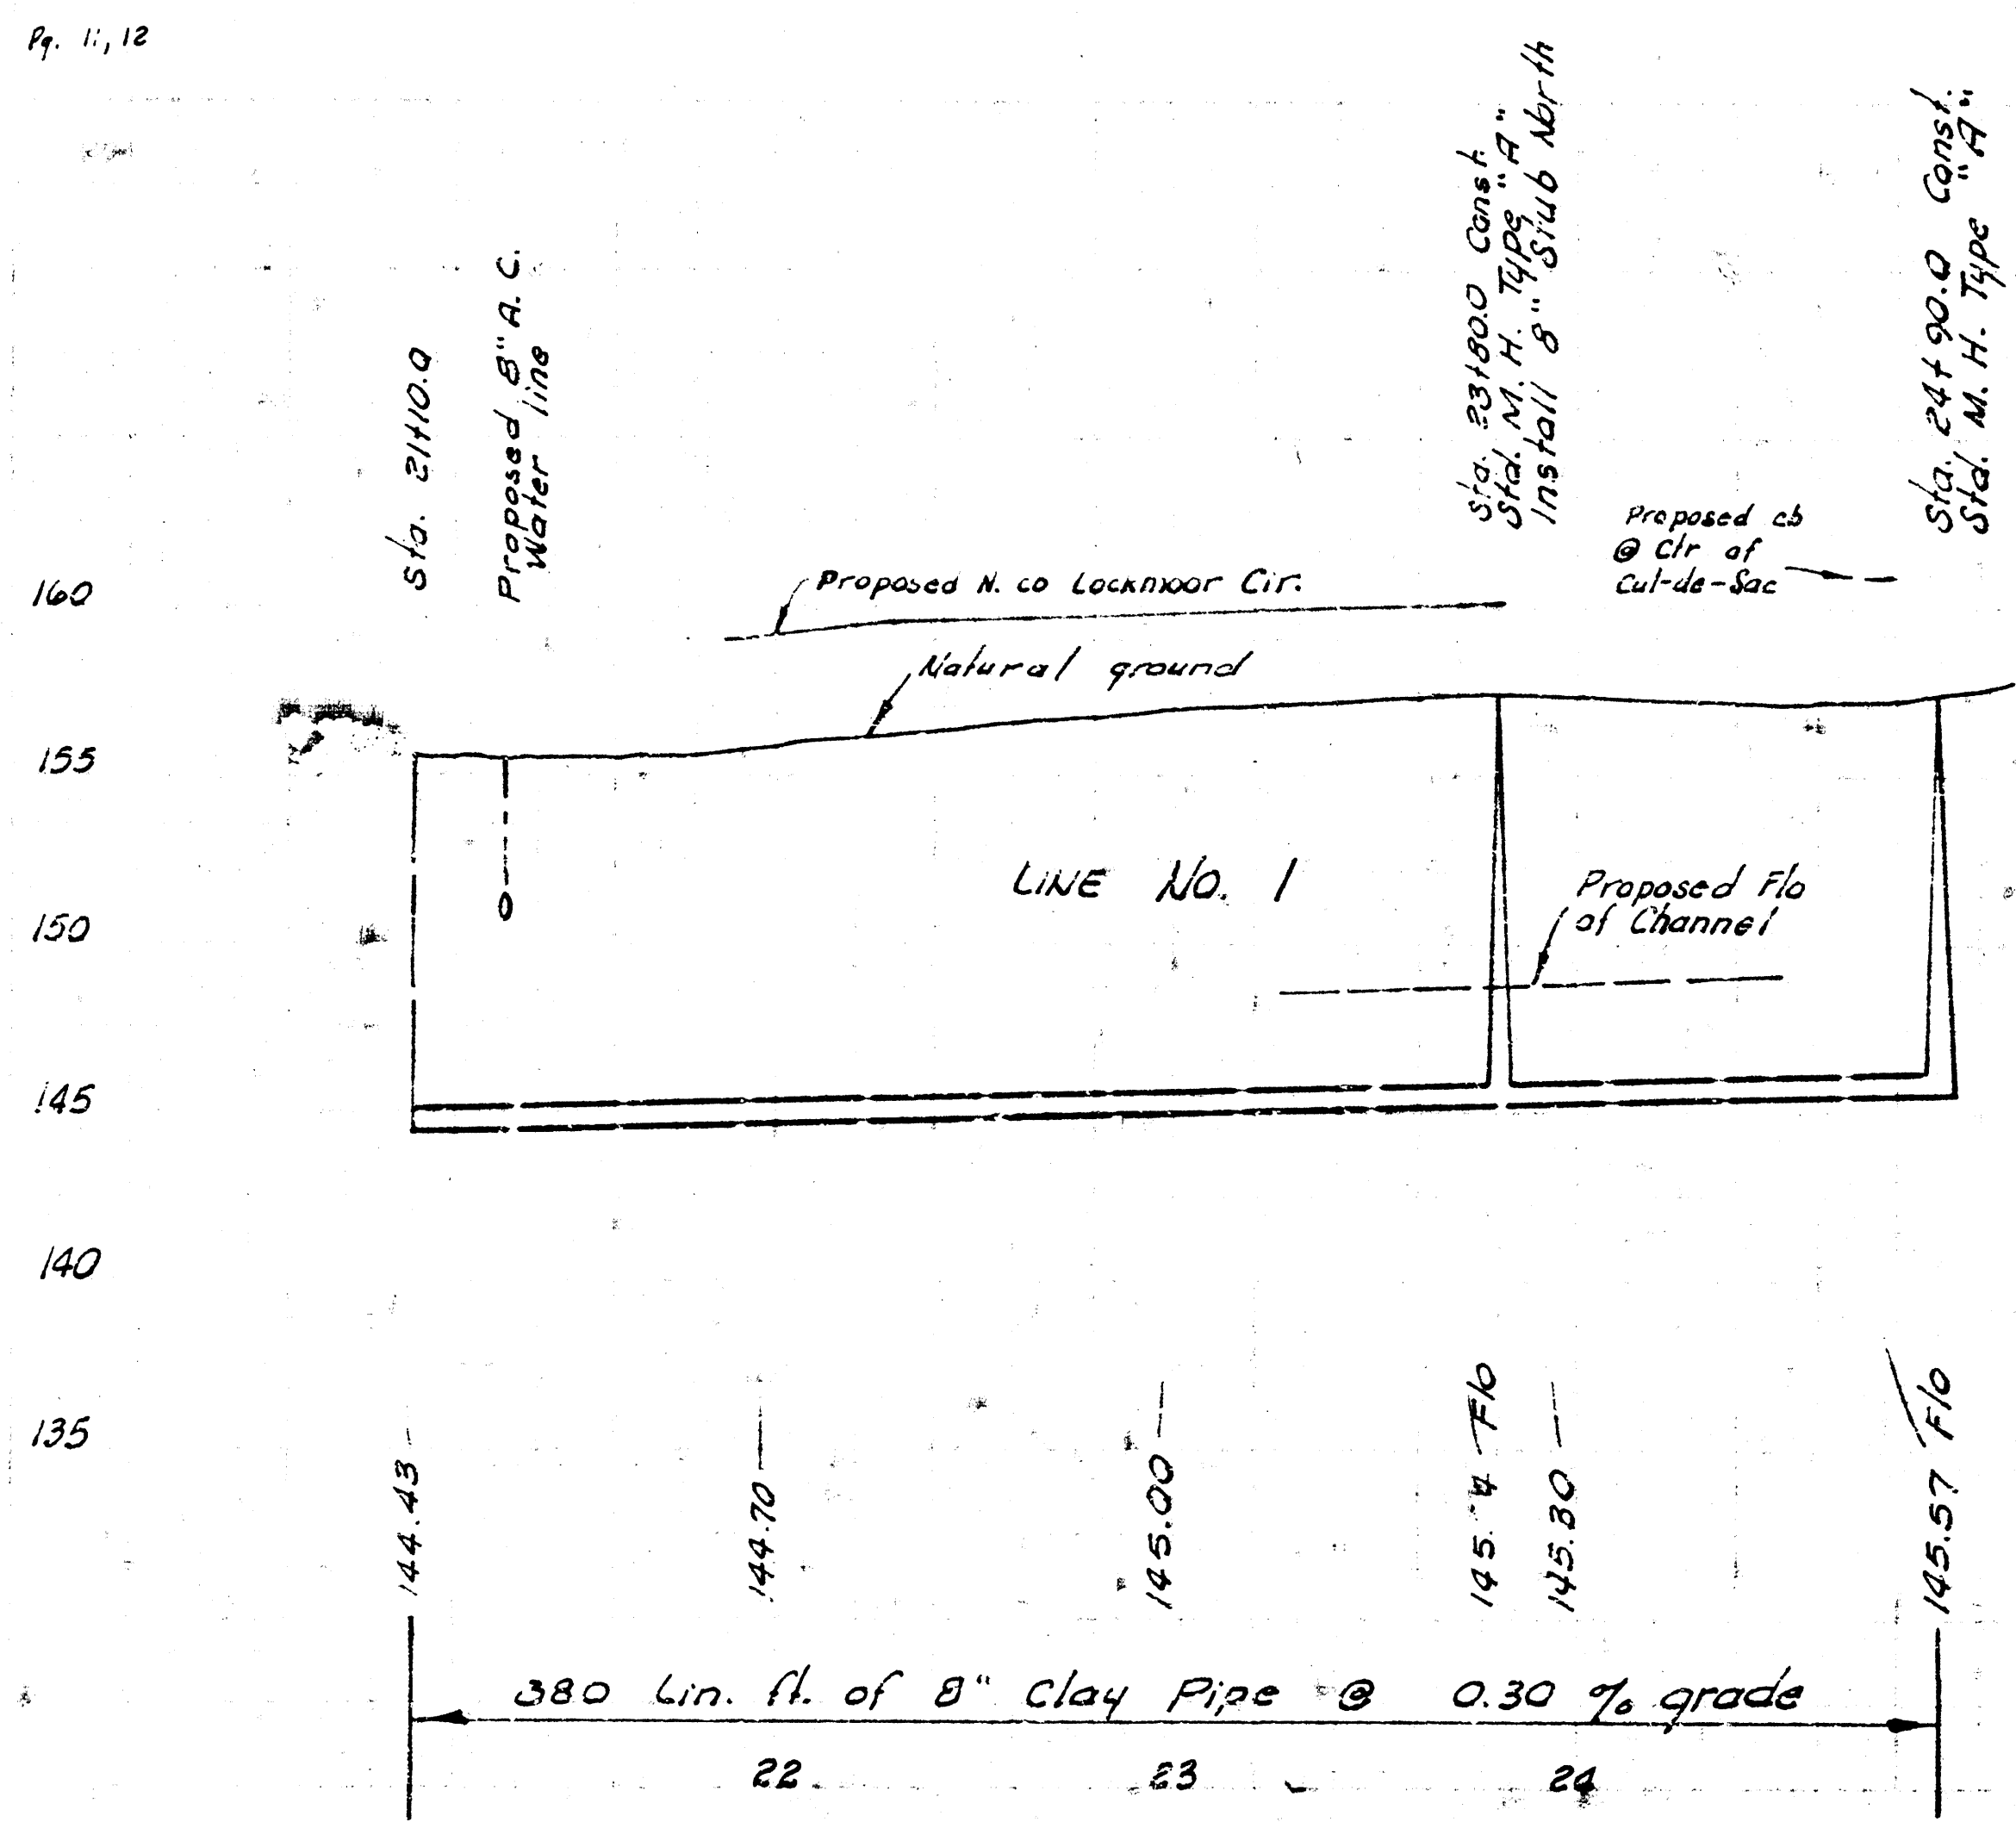



NOTE:
Contractor is to
tunnel under
Exist. 36\"/>

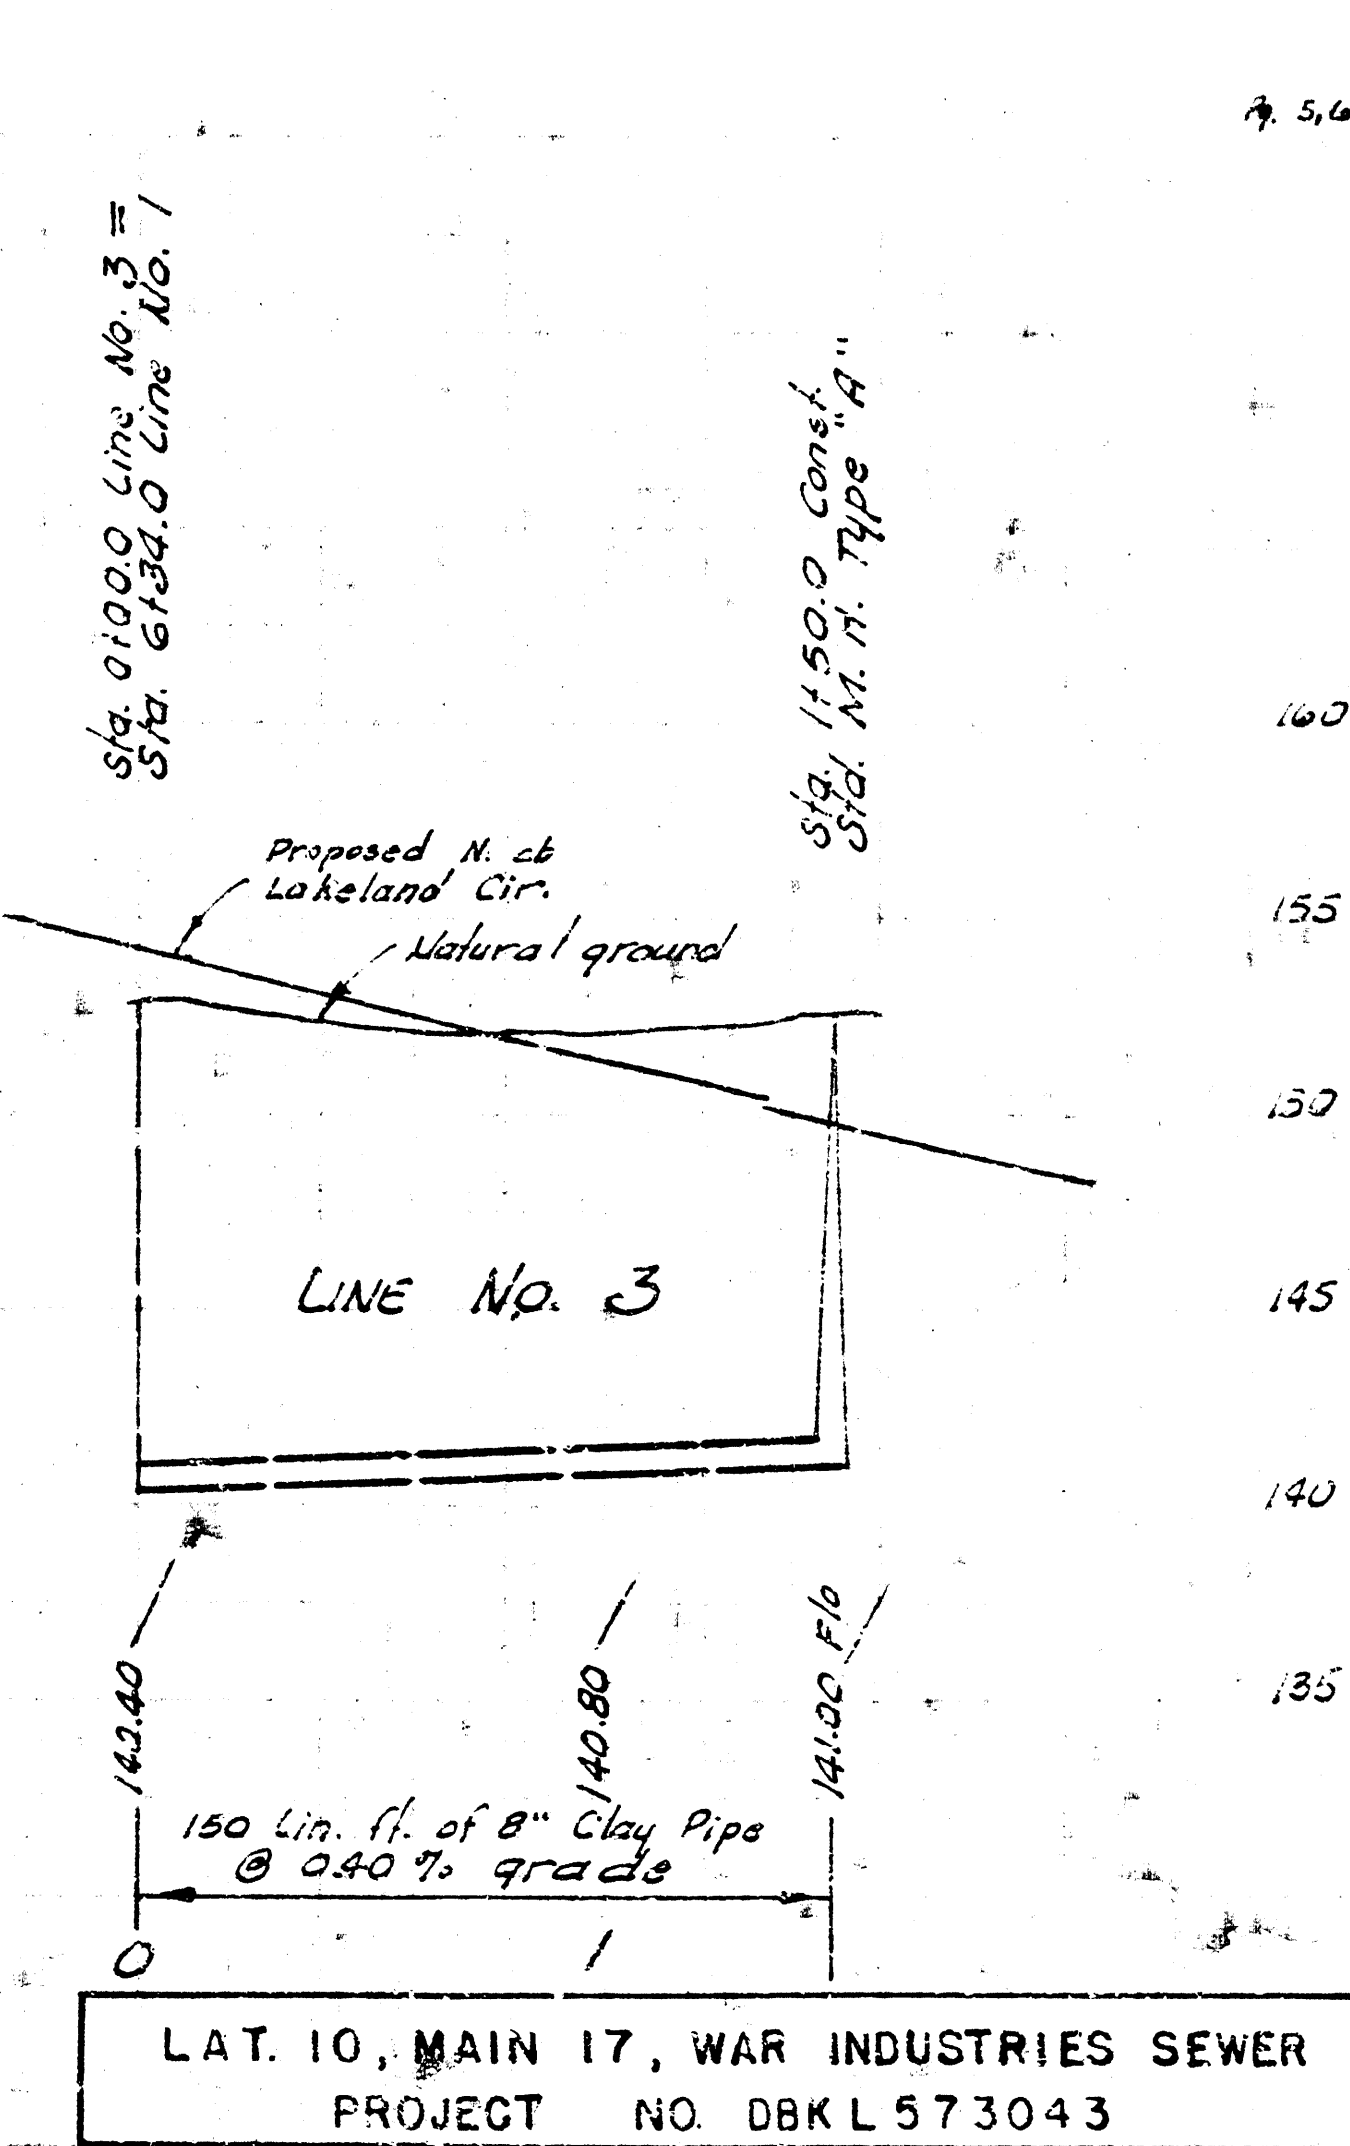

LAT. 10, MAIN 17, WAR INDUSTRIES SEWER
PROJECT NO. DBKL573043

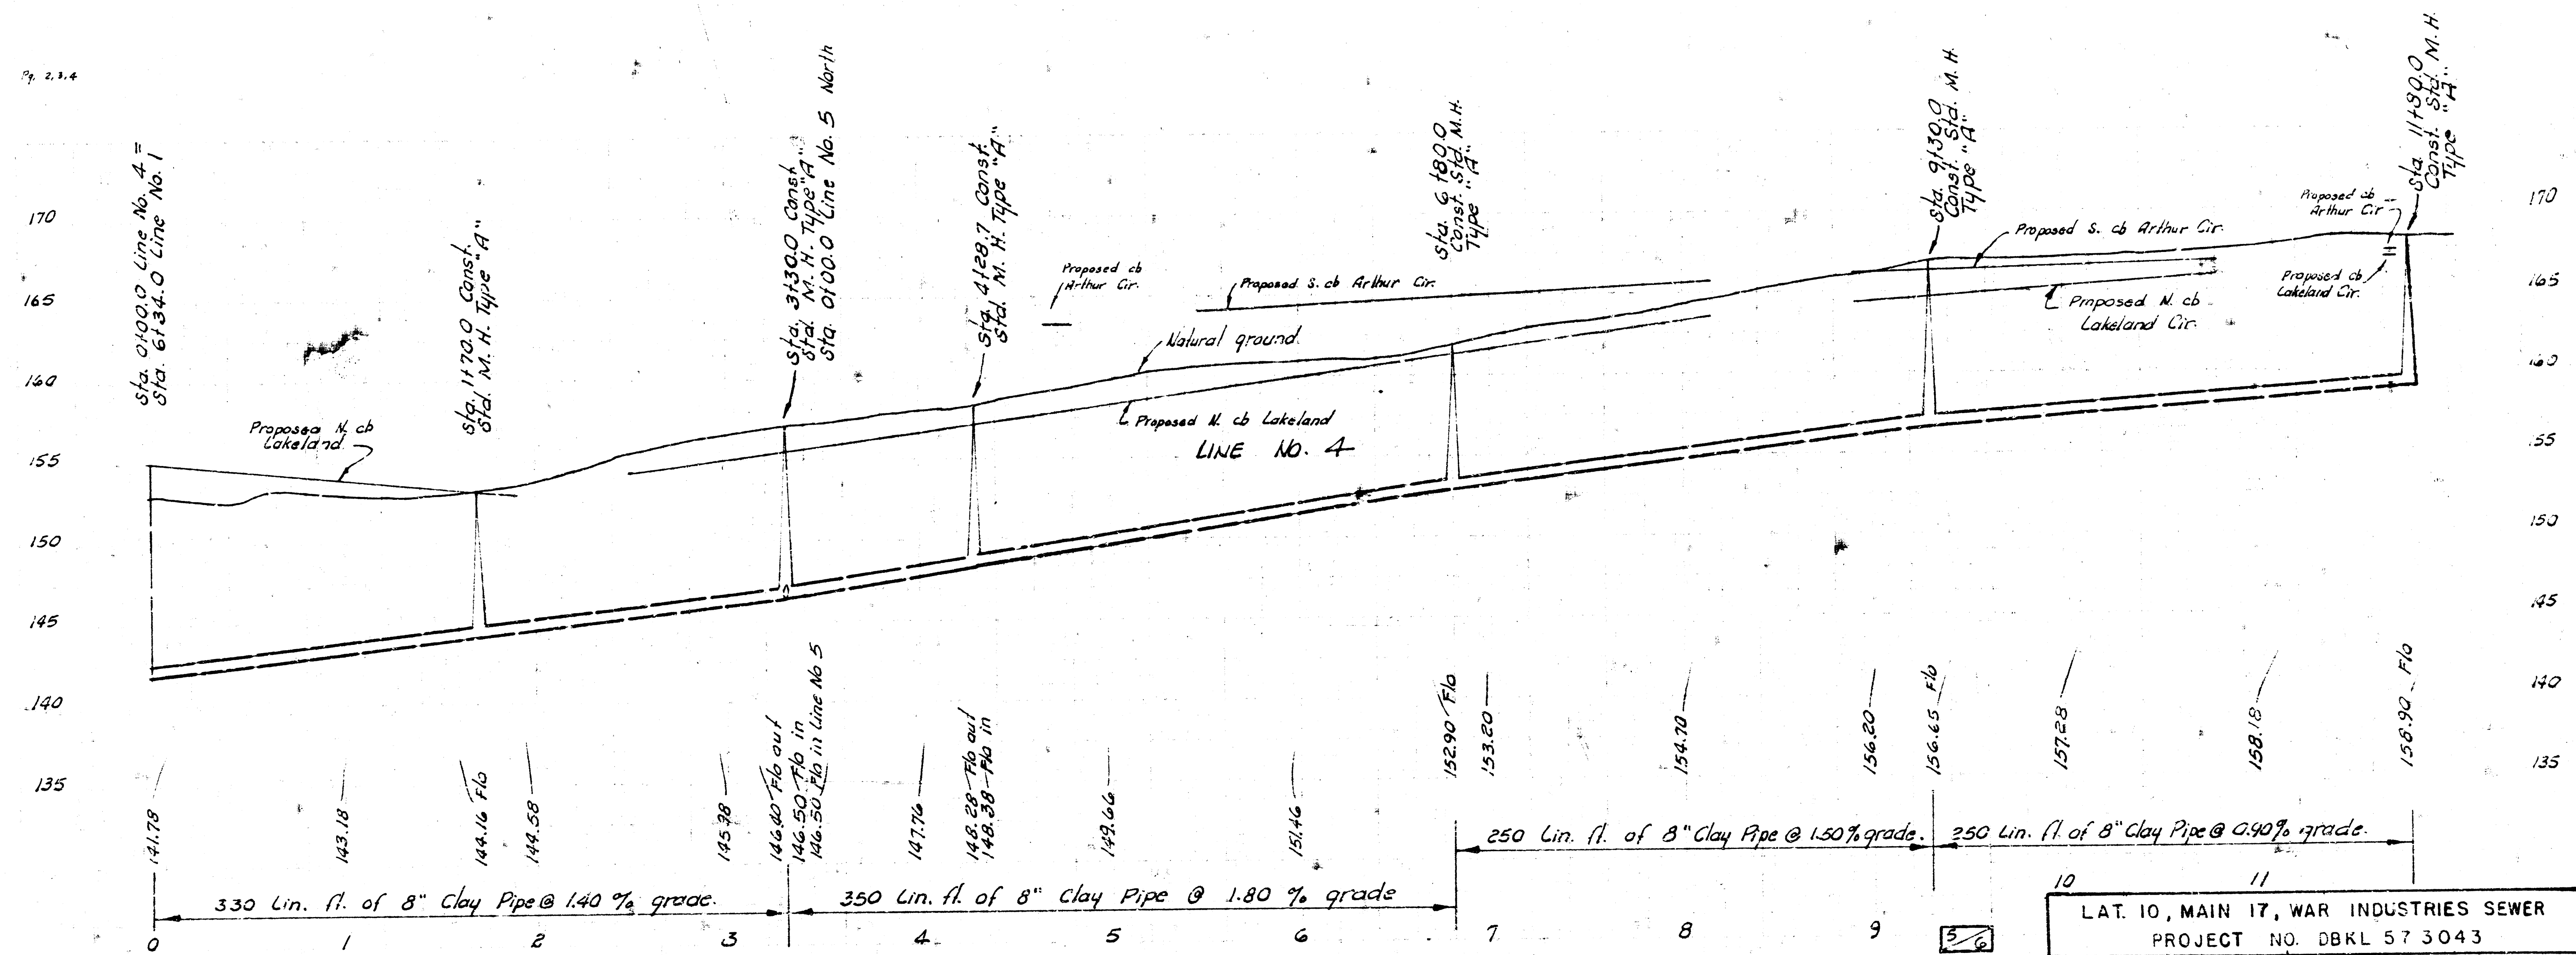

CEDAR LAKES VILLAGE FIRST ADDITION

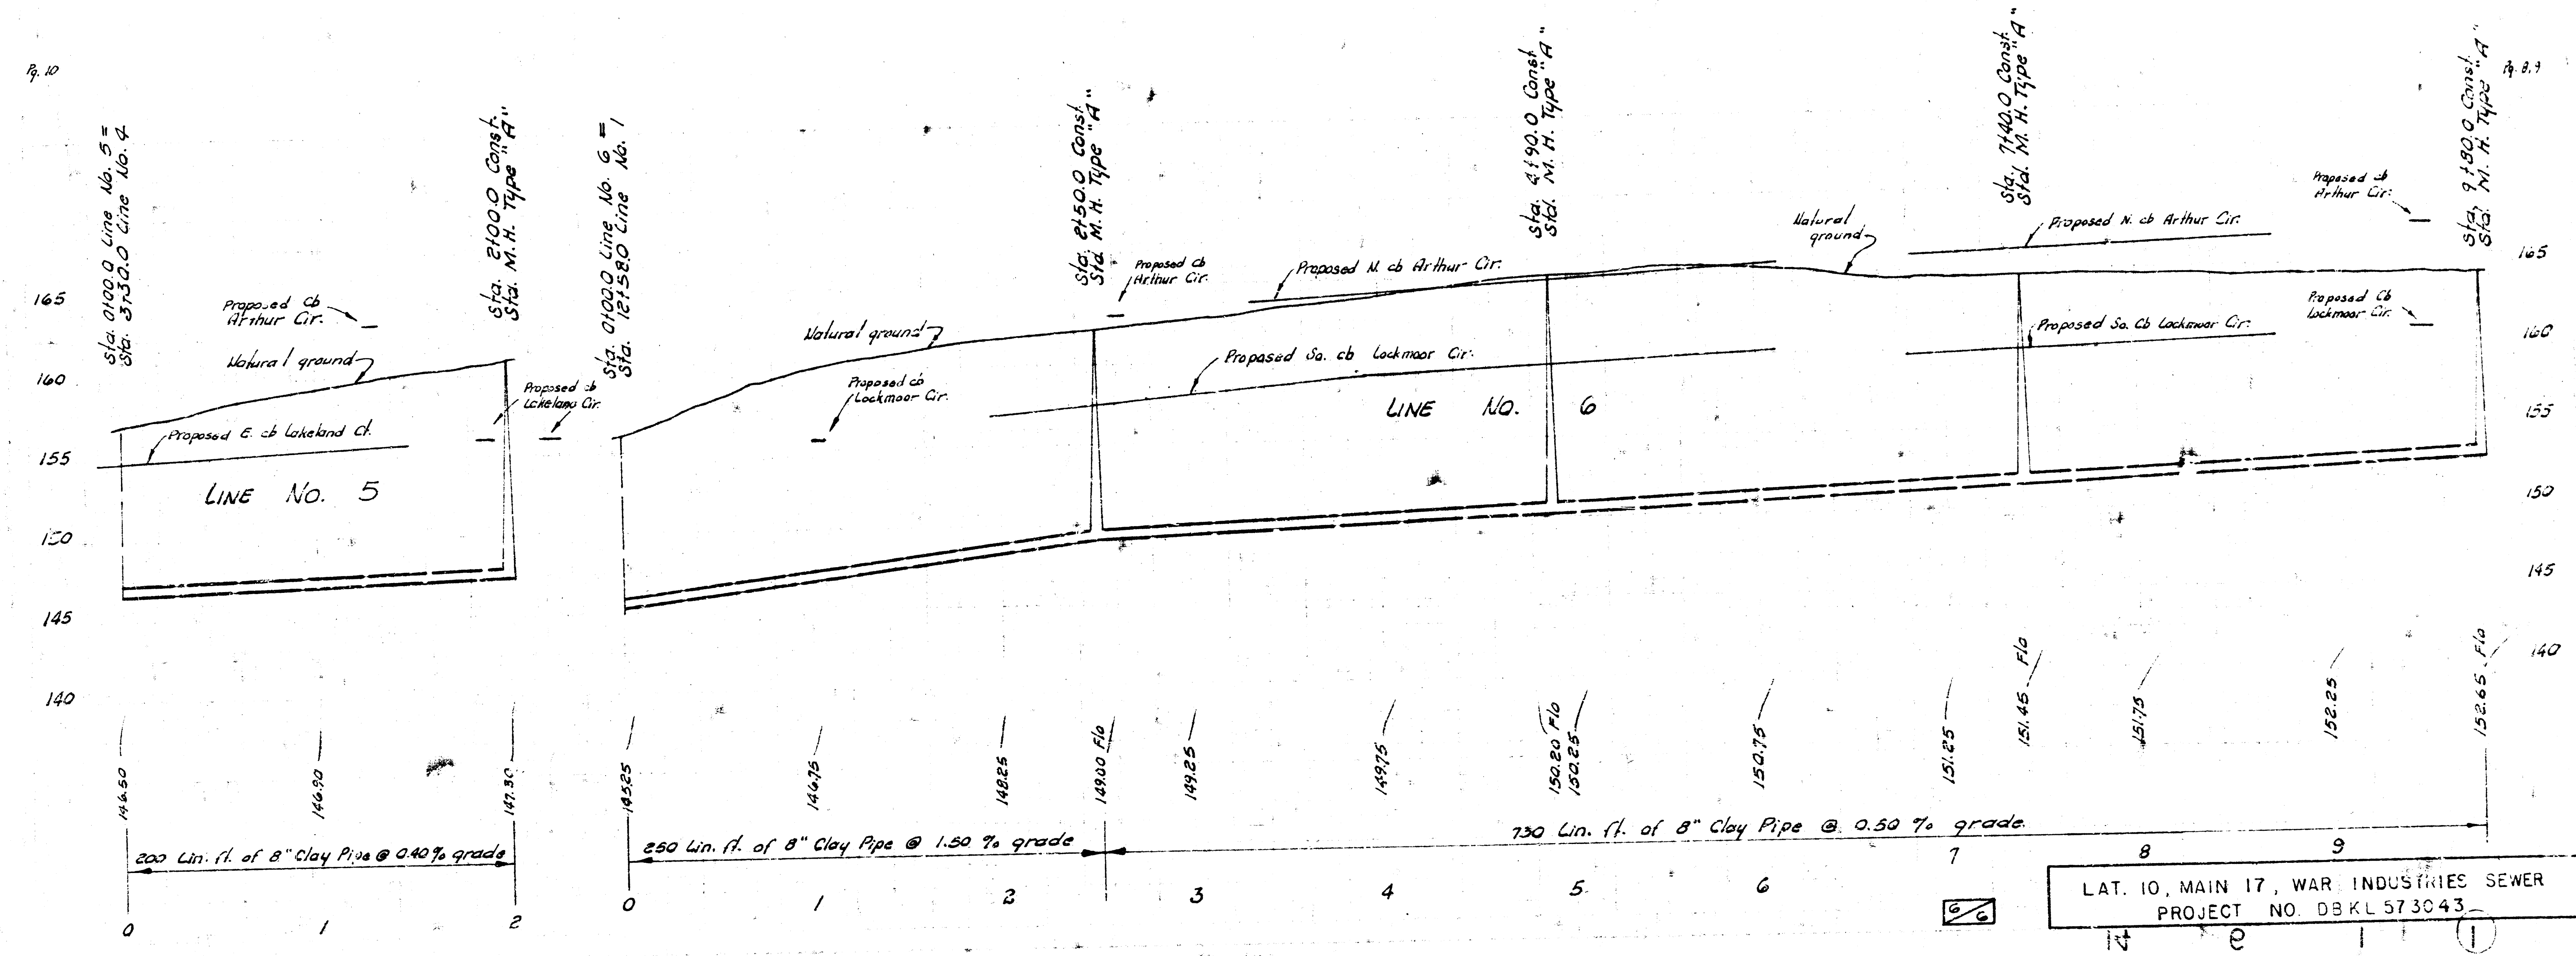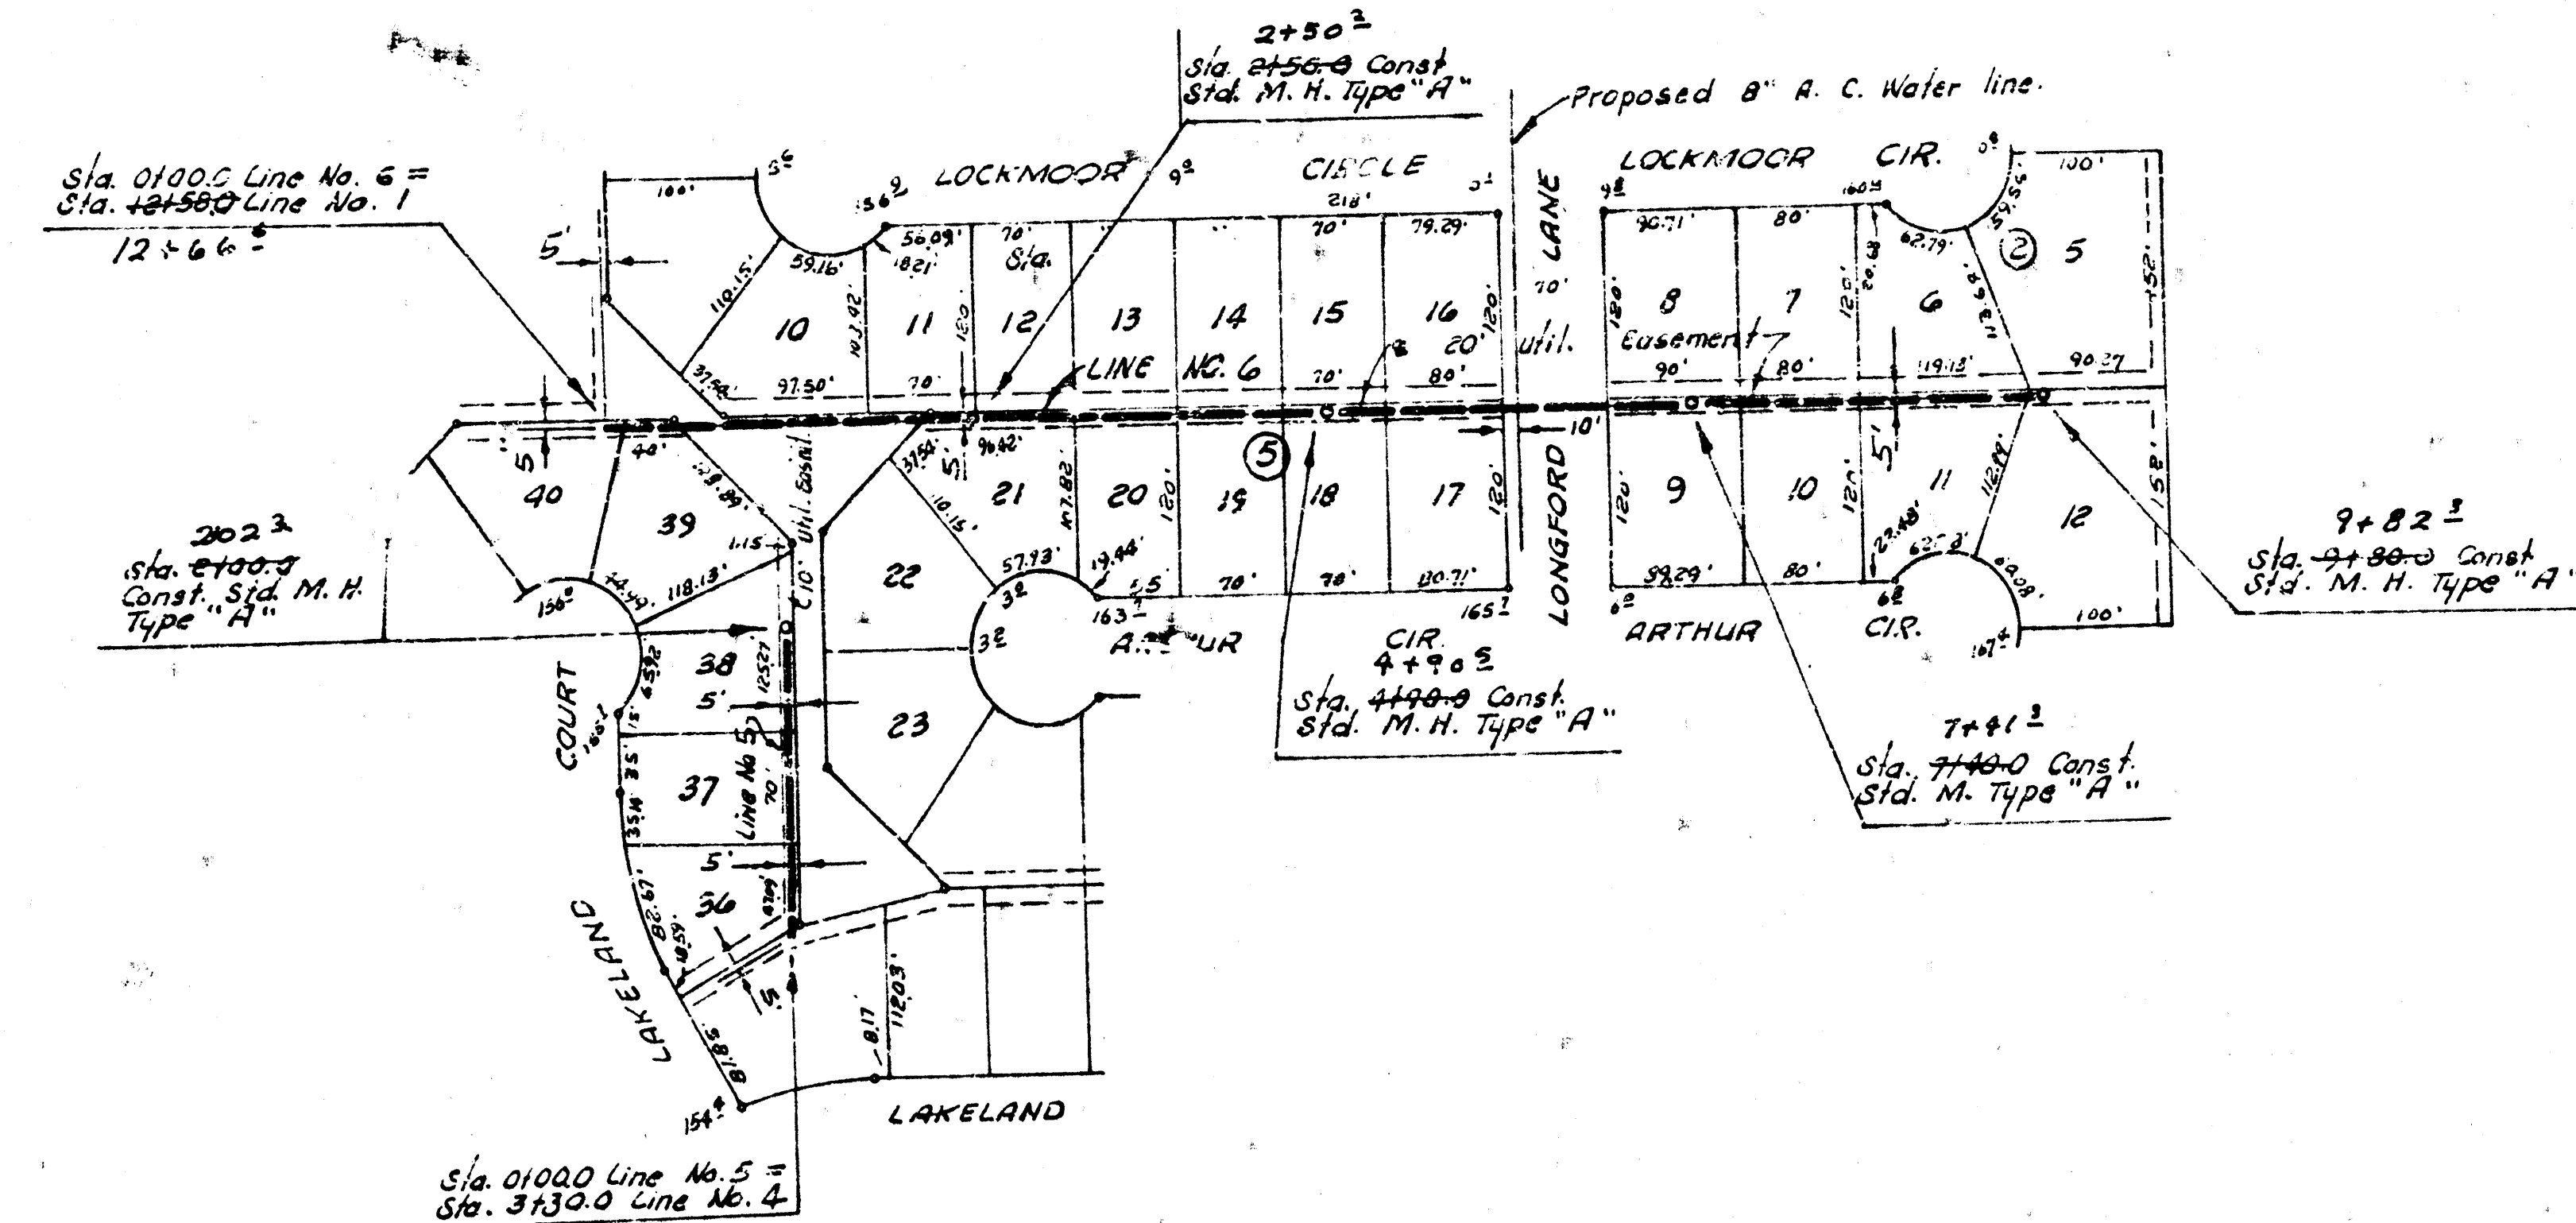

LAT. 10, MAIN 17, WAR INDUSTRIES SEWER
PROJECT NO. DB KL 573043