
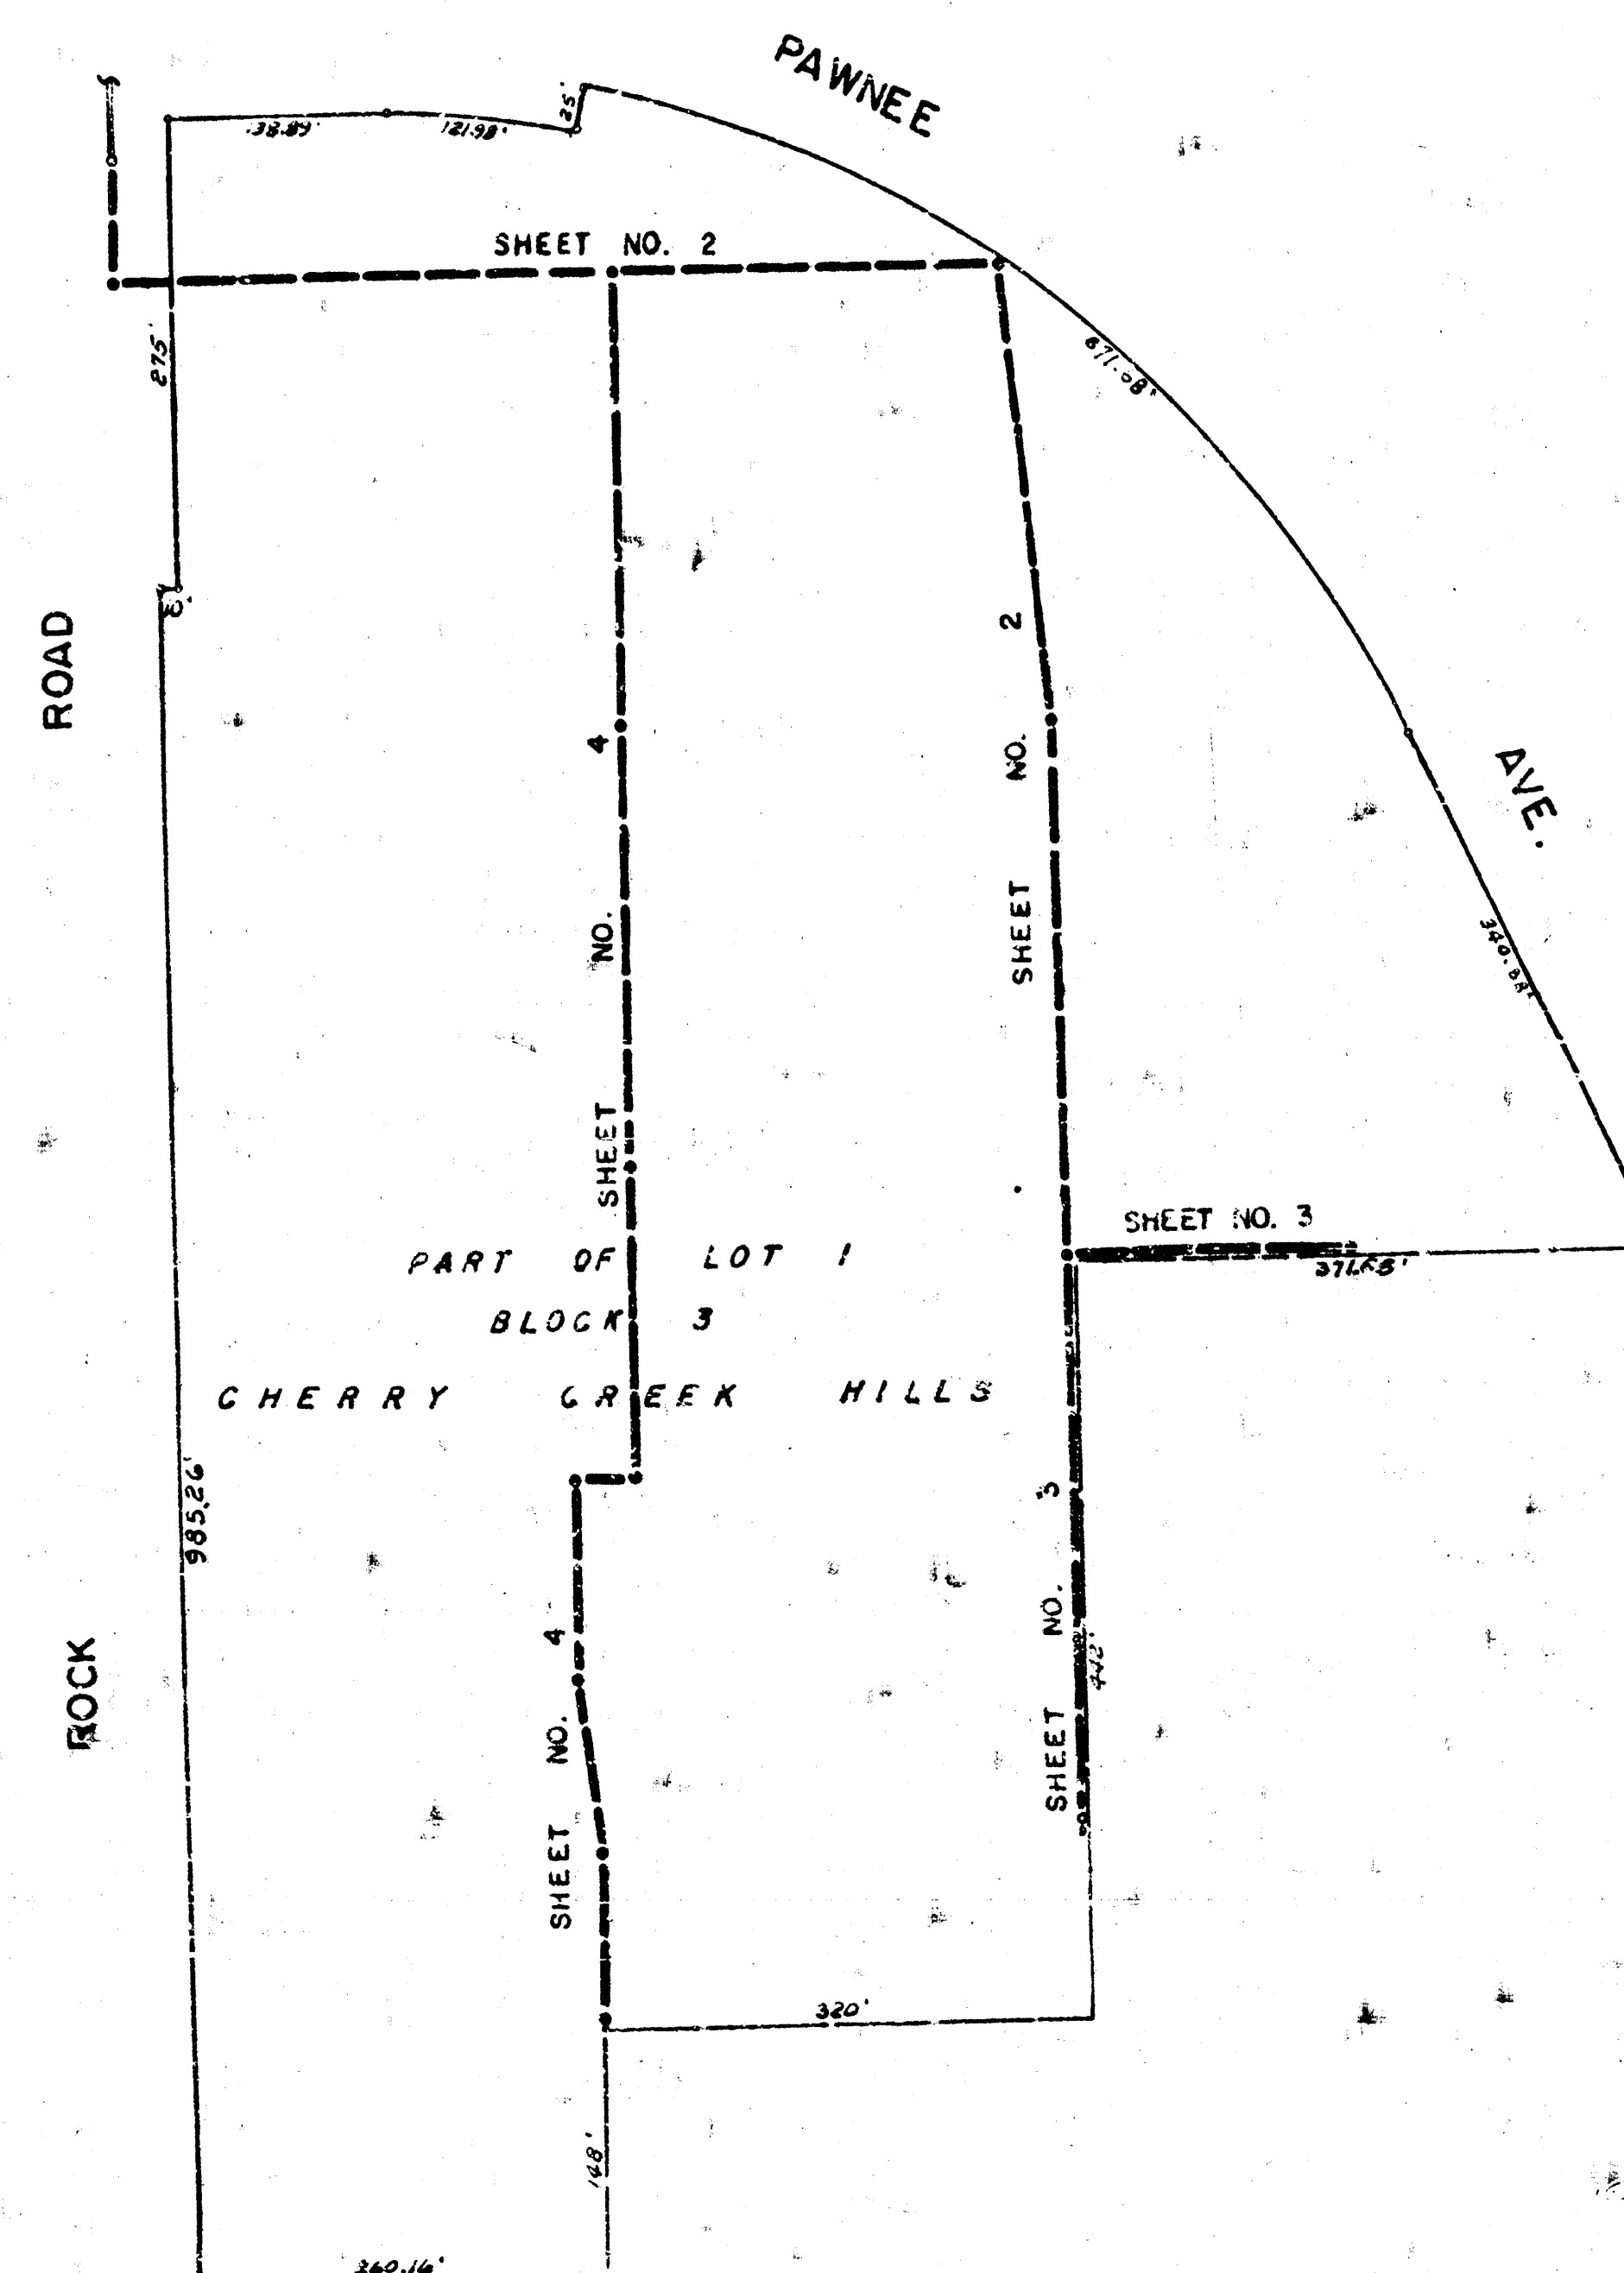


LAT. 16, MAIN 17, WAR INDUSTRIES SEWER
CITY OF WICHITA, KANSAS
R. W. LINN — CITY ENGINEER
JAN. 1974, PROJECT NO. DBKL 57 3082

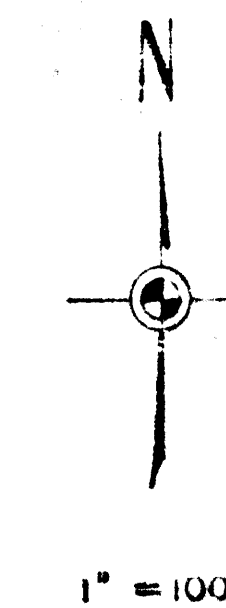

AS BUILT Final Mess. 9-E

LAT. 16, MAIN 17, W. I. S.
PROJECT NO. DBKL 57 3082

J. F. R. G. W.

