

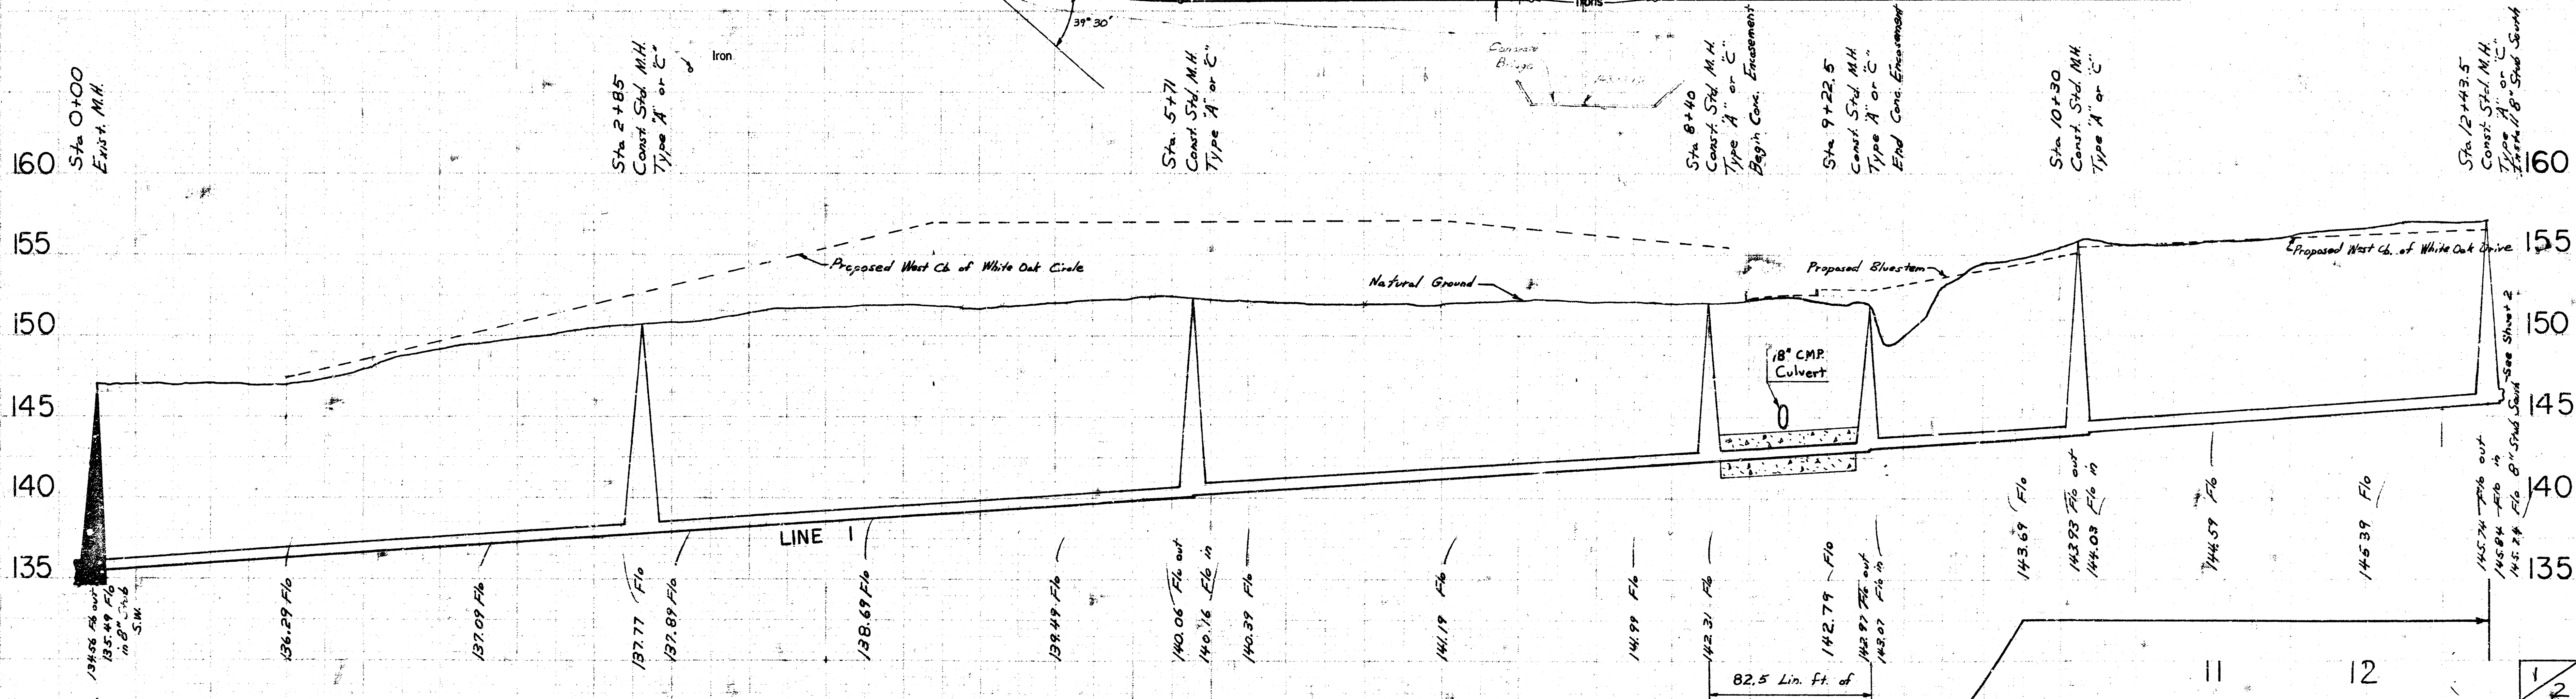
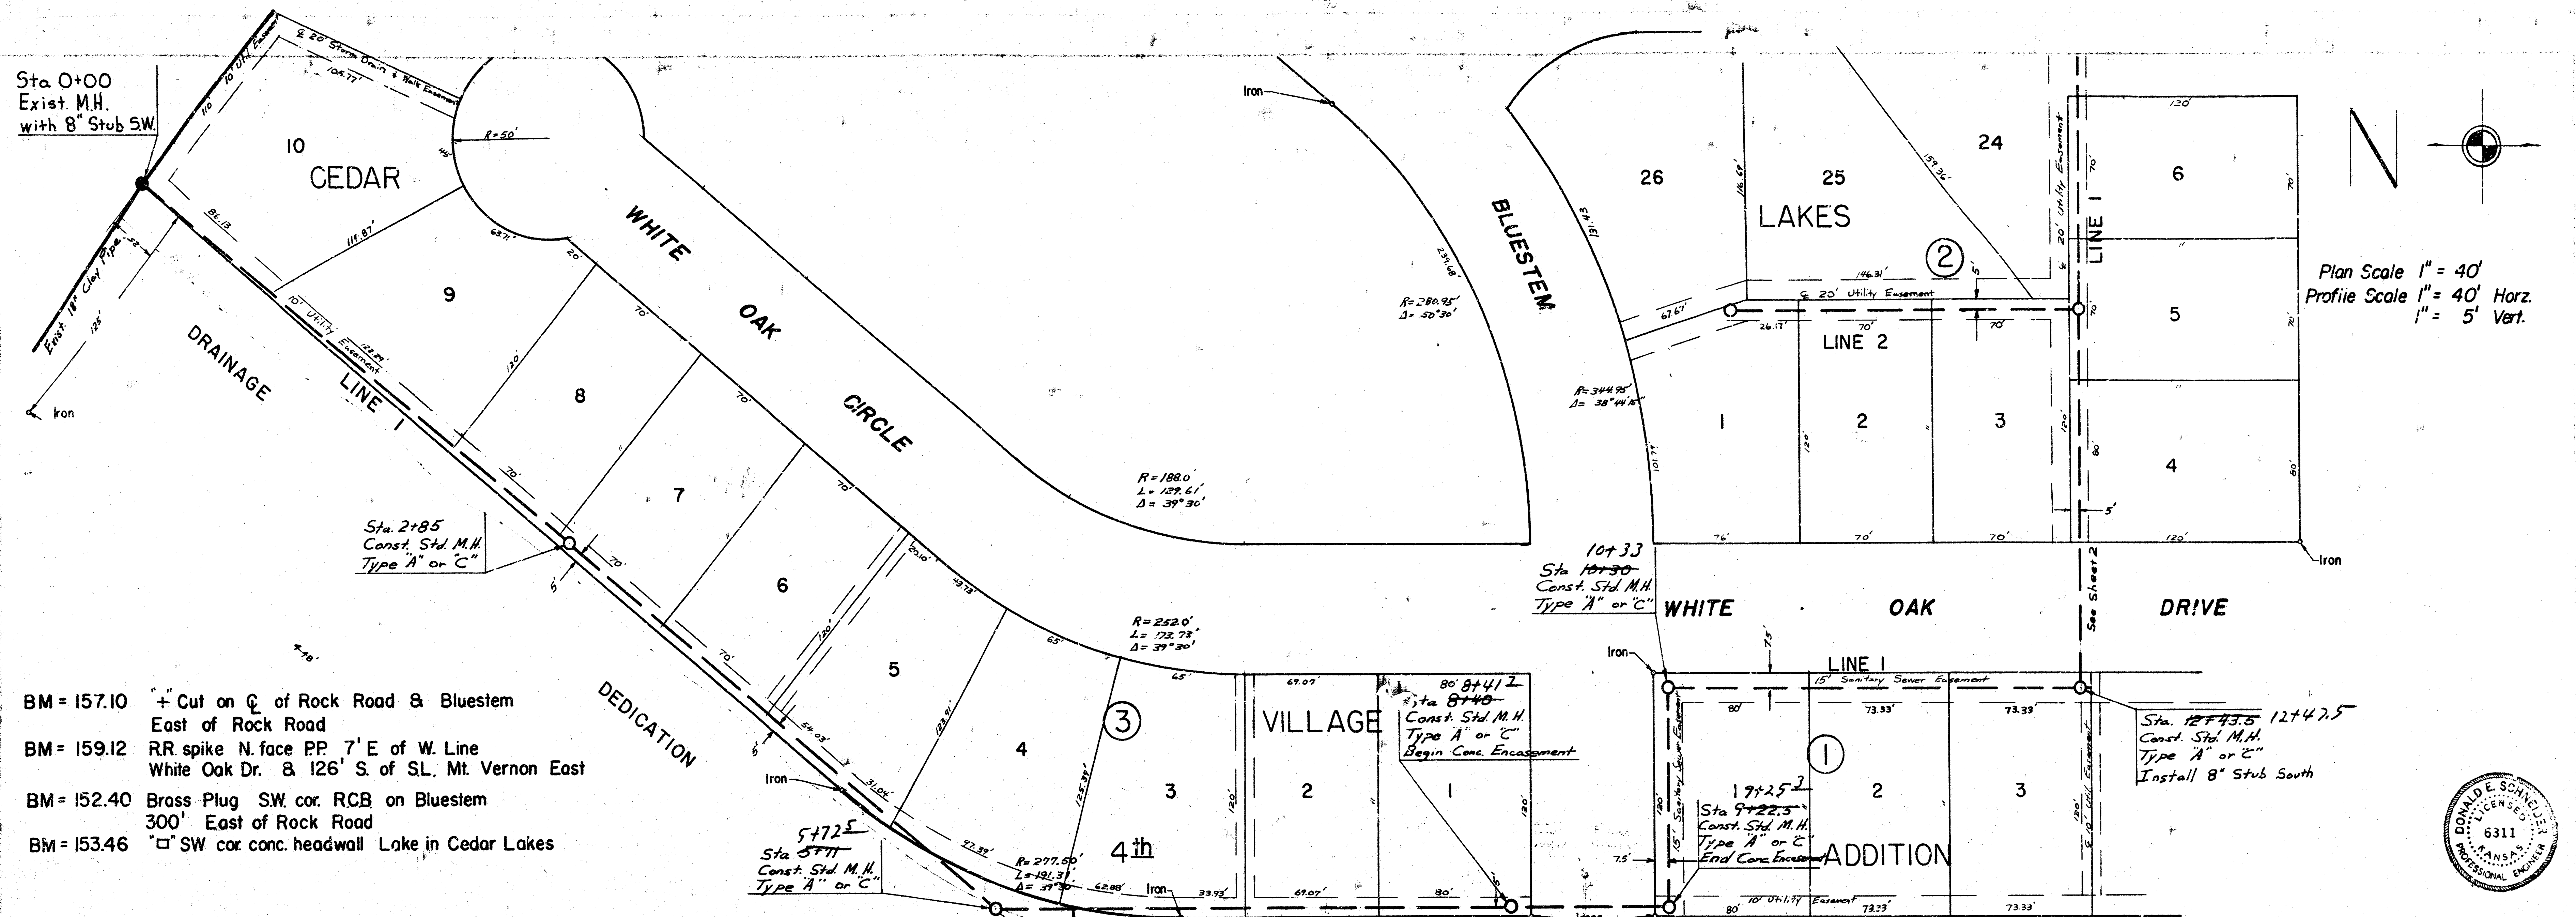


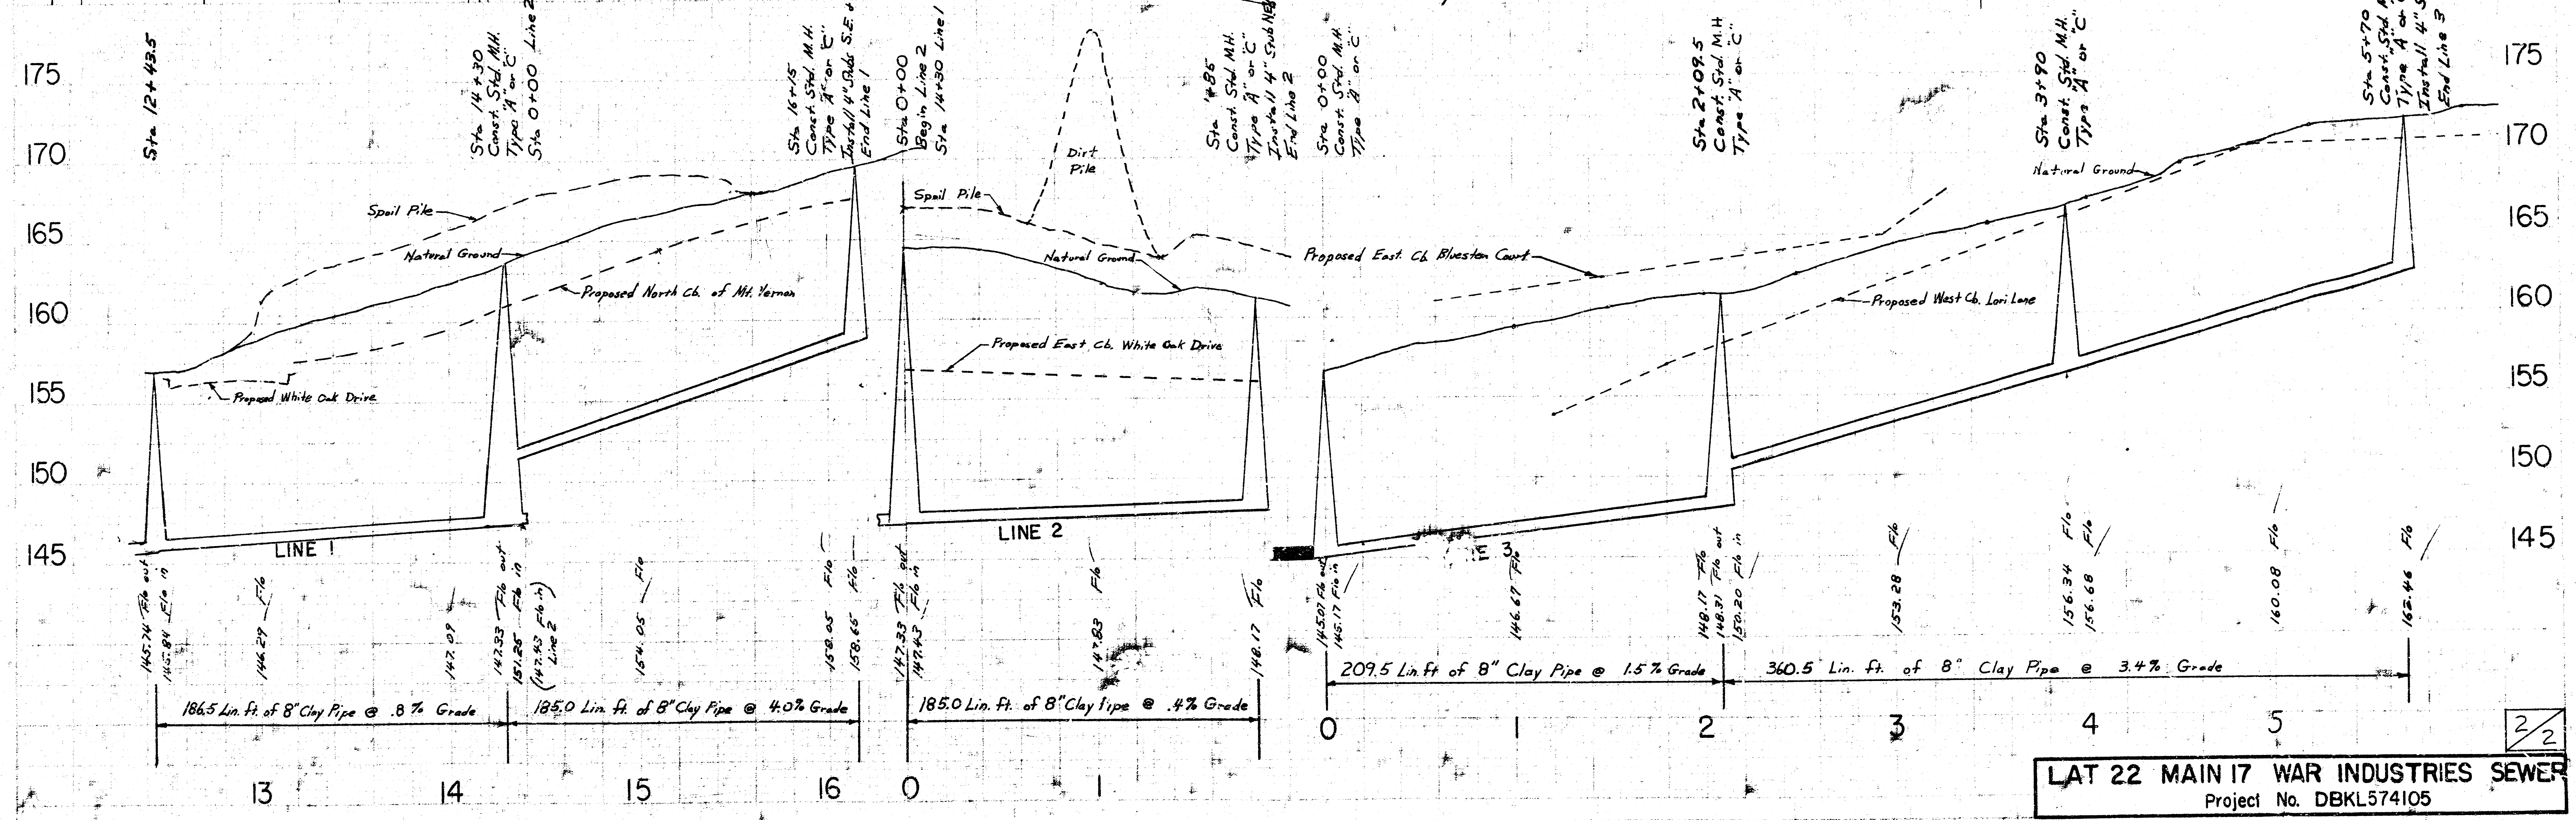

LAT. 22 MAIN 17 WAR INDUSTRIES
SEWER
CITY OF WICHITA, KANSAS
R. W. LINN CITY ENGINEER
PROJECT NO. DBKL574105
As Built 1-28-76

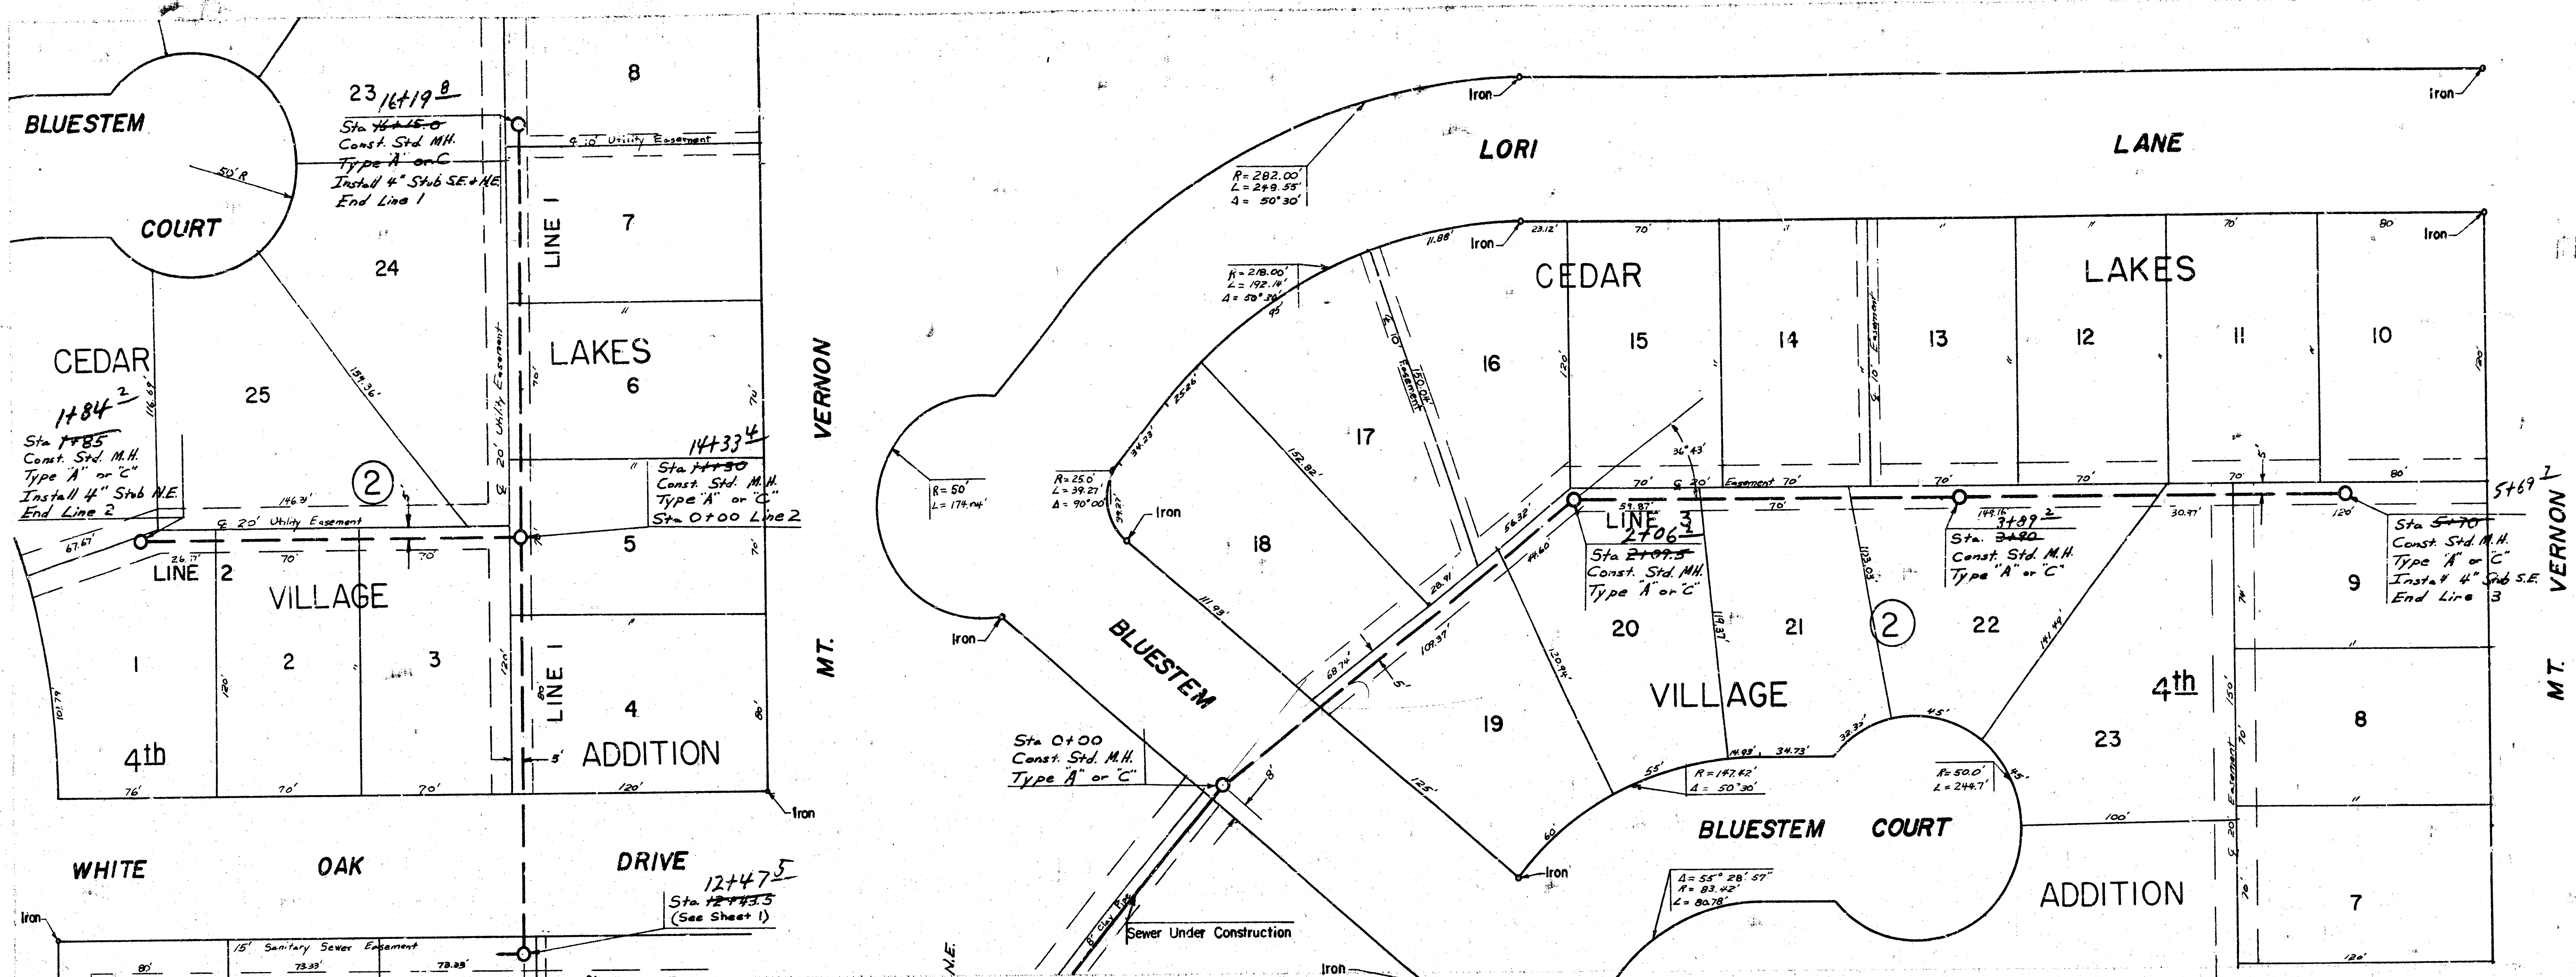

LAT 22 MAIN 17 WAR INDUSTRIES SEWER
Project No. DBKL574105