
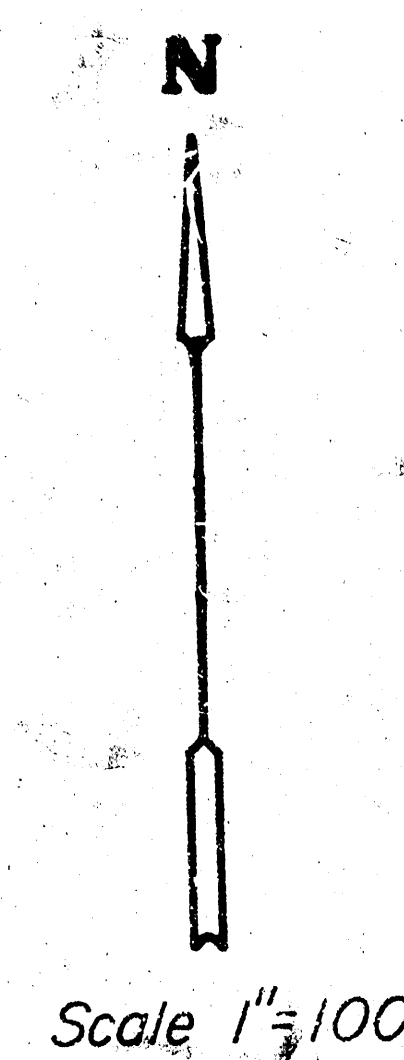


SANITARY SEWER EXTENSIONS FIRST ADDITION TO CEDAR RIDGE WICHITA, KANSAS

Lateral 33 Main 17 War Industries Sewer

City of Wichita Project No. 468-76-245-81014-000-000-001

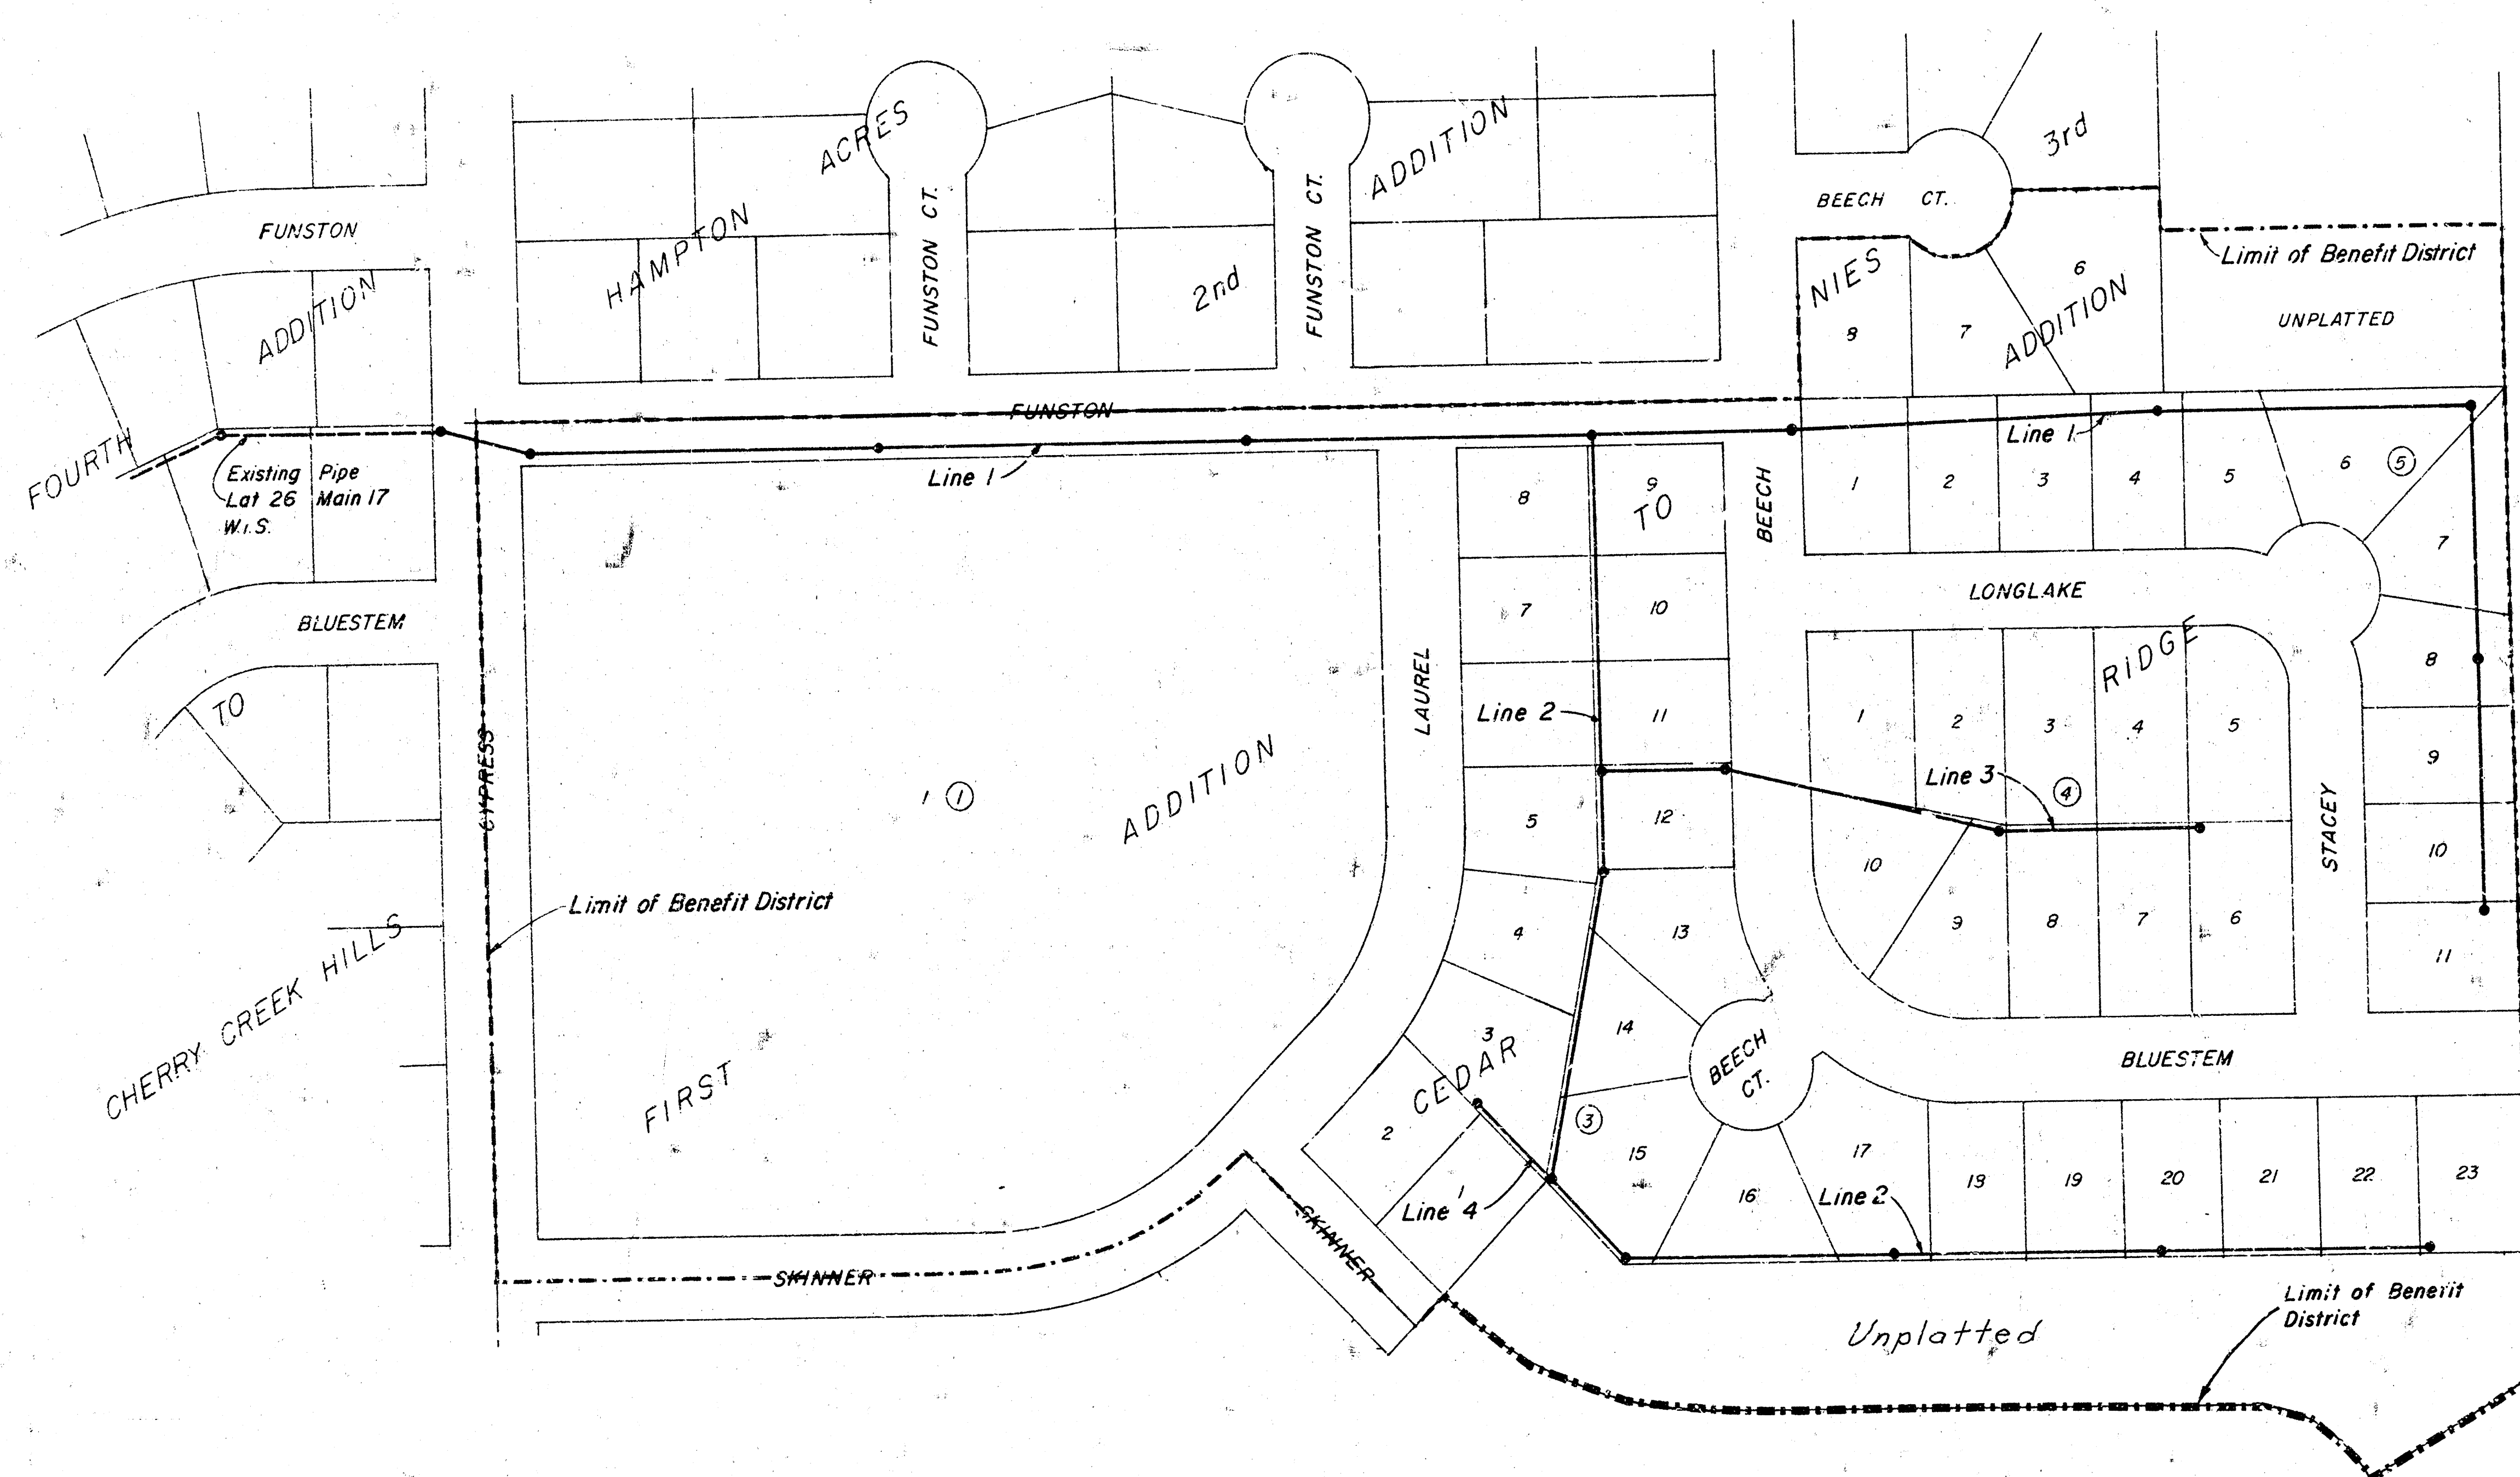

INDEX

- 1 AREA PLAN
- 2-4 PLAN-PROFILE
- 5 STANDARD APPURTENANCES


As Built
Jst
10/81

MOEHRING & ASSOCIATES
CONSULTING ENGINEERS
WICHITA
JANUARY 1981



FIRST ADDITION TO CEDAR RIDGE

WICHITA, KANSAS

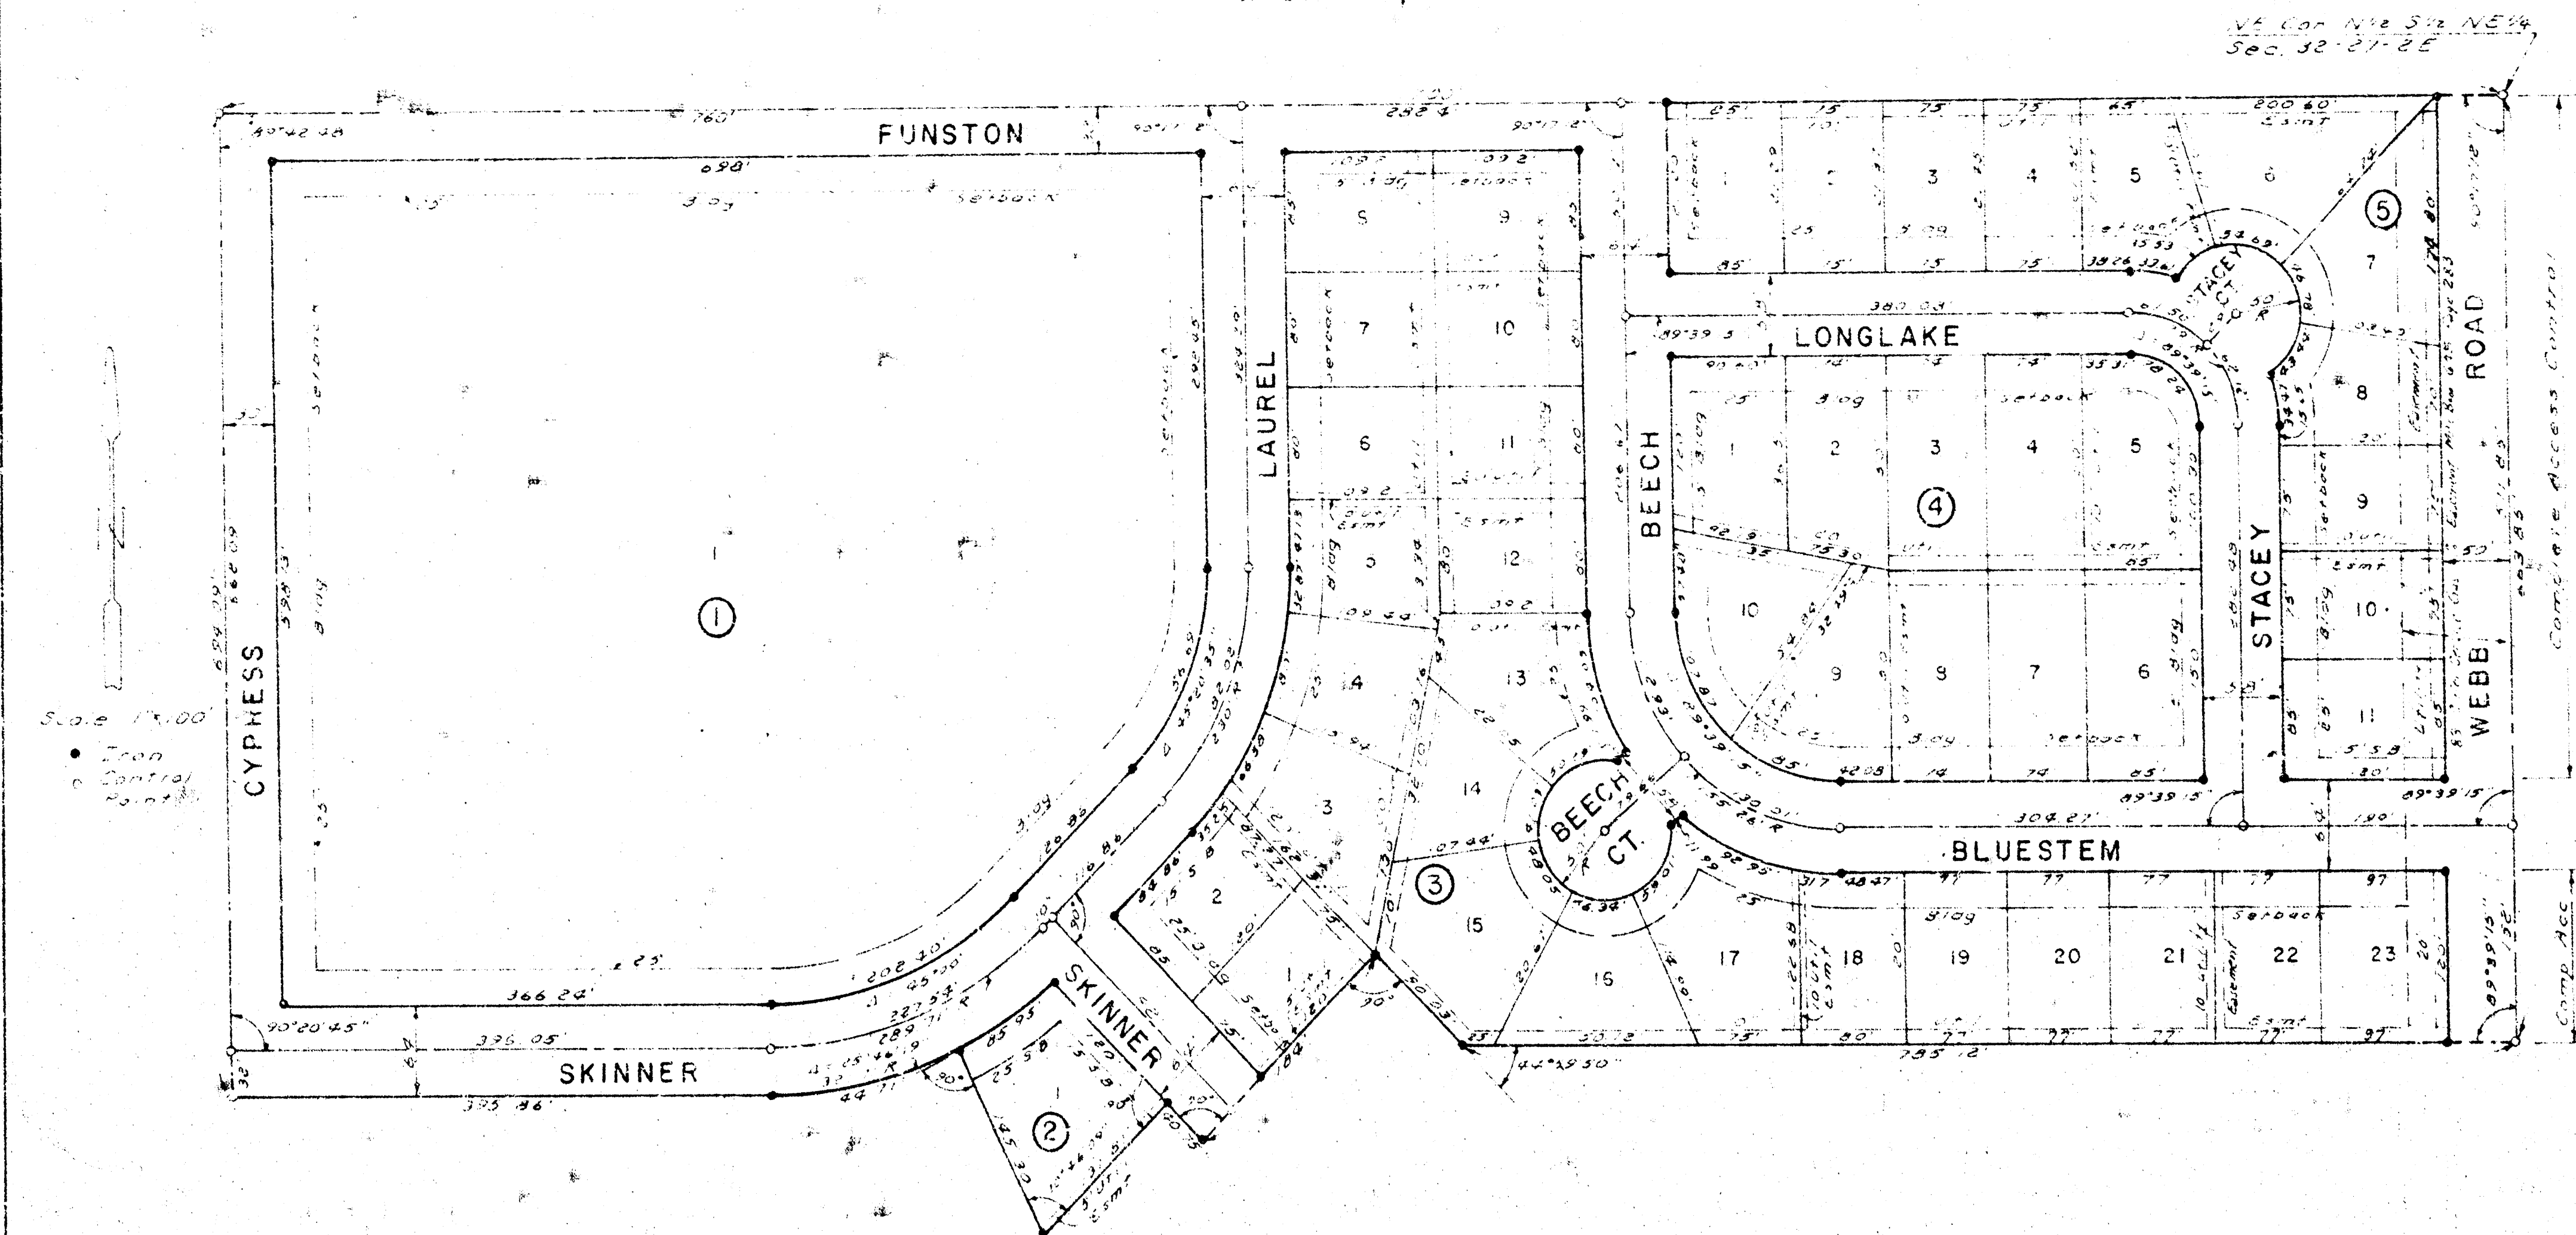

This plat of FIRST ADDITION TO CEDAR RIDGE, Wichita, Kansas, has been submitted to and approved by the Wichita Board of Planning Commissioners, Wichita, Kansas, this 3rd day of July, 1980.

Wichita Board of Planning Commissioners
Robert A. Nies, President

This plat approved and all dedications shown herein accepted by the Board of County Commissioners, Sedgewick County, Kansas, this 17th day of July, 1980.

This plat approved and all dedications shown herein accepted by the Board of County Commissioners, Sedgewick County, Kansas, this 17th day of July, 1980.

Entered on Transfer Record this day of July, 1980.
County Clerk

State of Kansas, ss. This is to certify that this plat has been filed for record in the Office of the Register of Deeds this 17th day of July, 1980, at 1:00 o'clock P.M. and is duly recorded.

Register of Deeds
Deputy

We, the East Side Bank and Trust of Wichita, Kansas, holder of a mortgage in part of the above described property, do hereby consent to this plat of FIRST ADDITION TO CEDAR RIDGE, Wichita, Kansas.

East Side Bank and Trust

State of Kansas, ss. The foregoing instrument has acknowledged before me this 17th day of July, 1980, by the East Side Bank and Trust, by _____, its President, in testimony whereof, I have hereunto set my hand and affixed my notarial seal the day and year above written.

Notary Public
My Commission Expires _____

State of Kansas, ss. We, the undersigned, have caused the land described in the surveyors certificate to be plotted into lots, blocks and streets to be known as "FIRST ADDITION TO CEDAR RIDGE", Wichita, Kansas. The easements are hereby granted as indicated for the construction and maintenance of public utilities. The streets are hereby dedicated to and for the use of the public. All egress rights of access to Webb Road over and across the east line of Blocks 3 and 5 are hereby granted to the City of Wichita, Kansas.

Date July 17, 1980
Baugman Company
Surveyor

State of Kansas, ss. The foregoing instrument was acknowledged before me this 17th day of July, 1980, by Clifford A. Nies and Nancy J. Nies, his wife, having suitable interest. In testimony whereof, I have hereunto set my hand and affixed my notarial seal the day and year above written.

Notary Public
My Commission Expires _____

Know all men by these presents that we, the undersigned, have caused the land described in the surveyors certificate to be plotted into lots, blocks and streets to be known as "FIRST ADDITION TO CEDAR RIDGE", Wichita, Kansas. The easements are hereby granted as indicated for the construction and maintenance of public utilities. The streets are hereby dedicated to and for the use of the public. All egress rights of access to Webb Road over and across the east line of Blocks 3 and 5 are hereby granted to the City of Wichita, Kansas.

Unified School District No. 259
President
Clerk of Board


State of Kansas, ss. The foregoing instrument was acknowledged before me this 17th day of July, 1980, by Clifford A. Nies, a single man, and Cherry Development, Inc., by Clifford A. Nies, President. In testimony whereof, I have hereunto set my hand and affixed my notarial seal the day and year above written.

Notary Public
My Commission Expires _____

State of Kansas, ss. The foregoing instrument was acknowledged before me this 2nd day of July, 1980, by Unified School District No. 259, by Jo Ann Peltorff, President, and Dr. Martin Martley, Clerk of Board. In testimony whereof, I have hereunto set my hand and affixed my notarial seal the day and year above written.


Notary Public
My Commission Expires _____



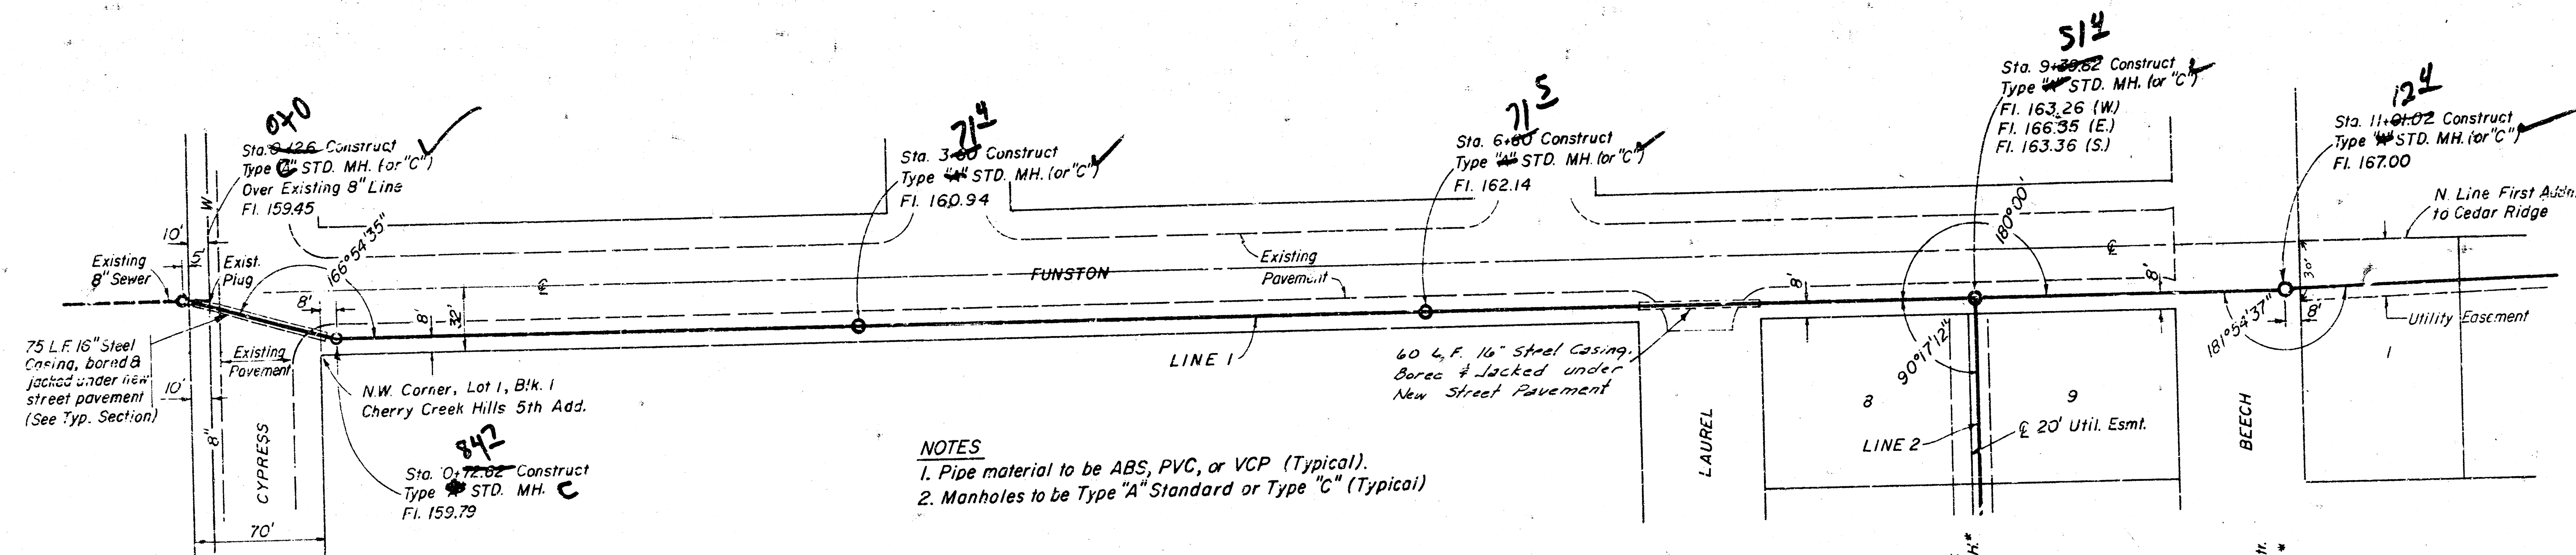

- NOTES
1. Pipe material to be ABS, PVC, or VCP (Typical).
 2. Manholes to be Type "A" Standard or Type "C" (Typical)

SCALE
1" = 50' Horiz.
1" = 5' Vert.

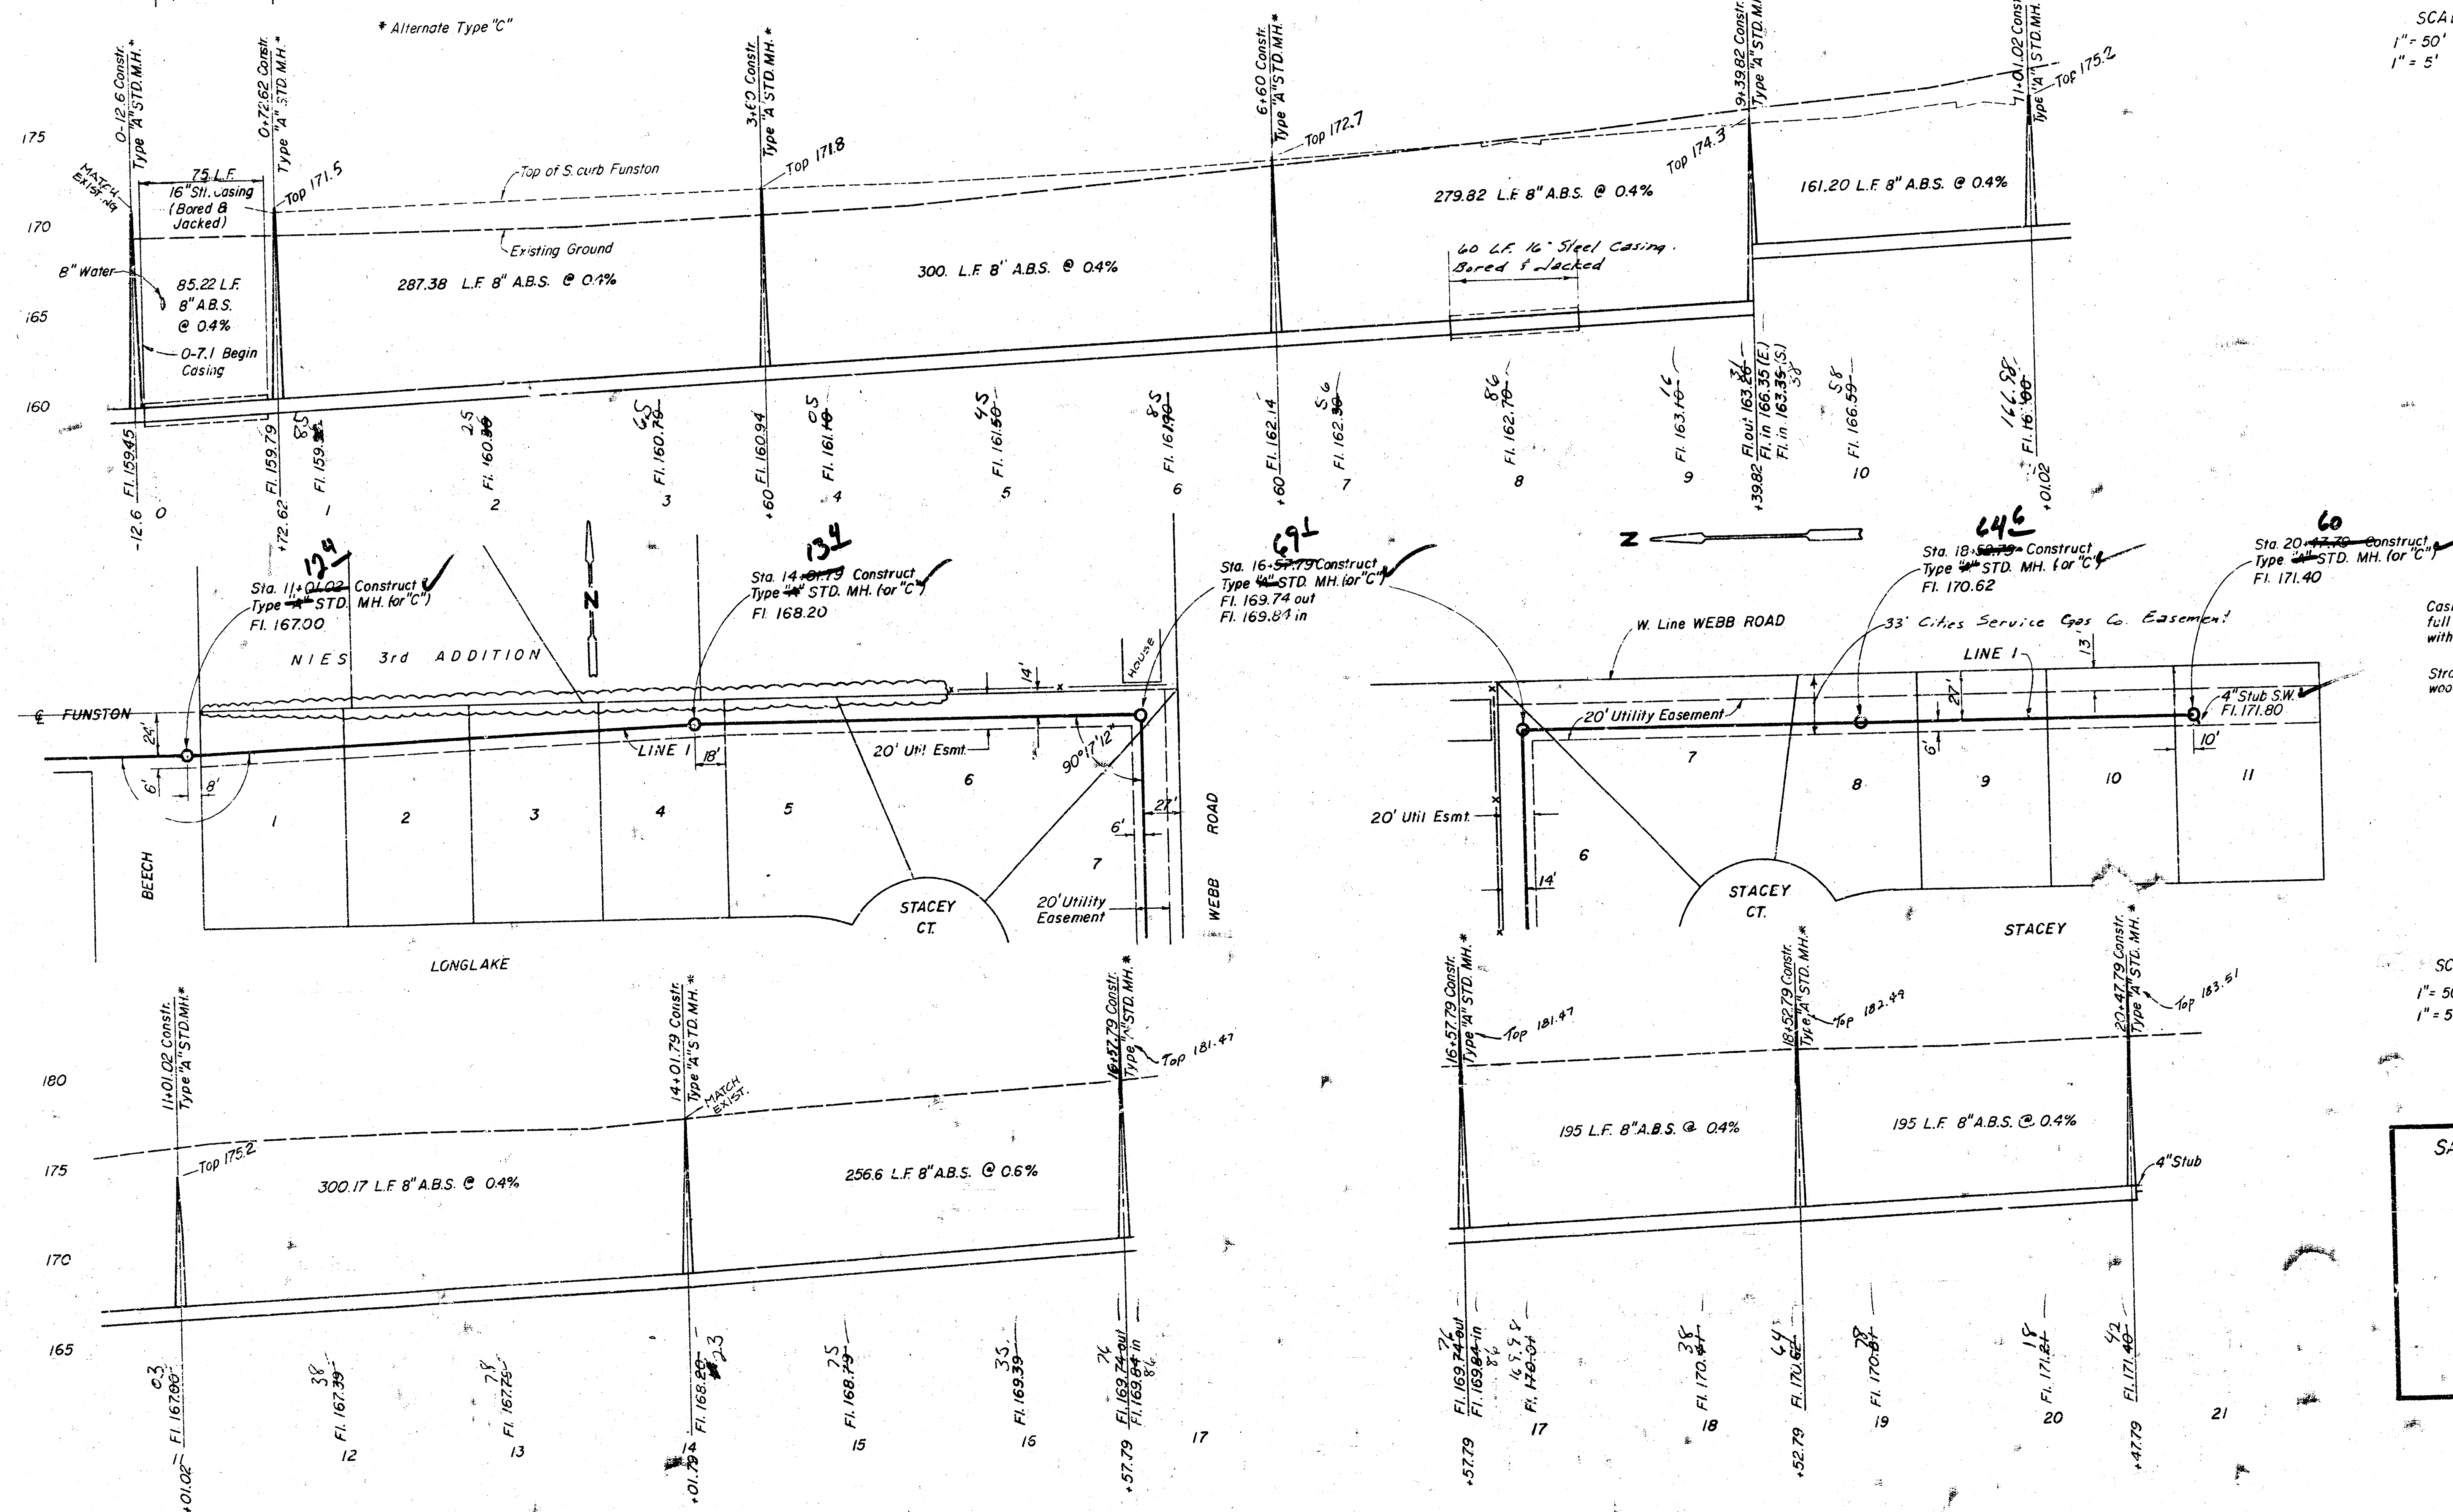


TYPICAL SECTION
CASING UNDER PAVEMENT
STA. 0+07.1 TO 0+67.9
Casing to be placed by boring and jacking per
City of Wichita specifications.

SCALE
1" = 50' Horiz.
1" = 5' Vert.

SANITARY SEWER EXTENSIONS
First Addition To Cedar Ridge
Wichita, Kansas
Lateral 33 Main 17
War Industries Sewer
Moehring & Associates
Consulting Engineers
Wichita


Sheet 2 of 2

FILMED FROM THE BEST

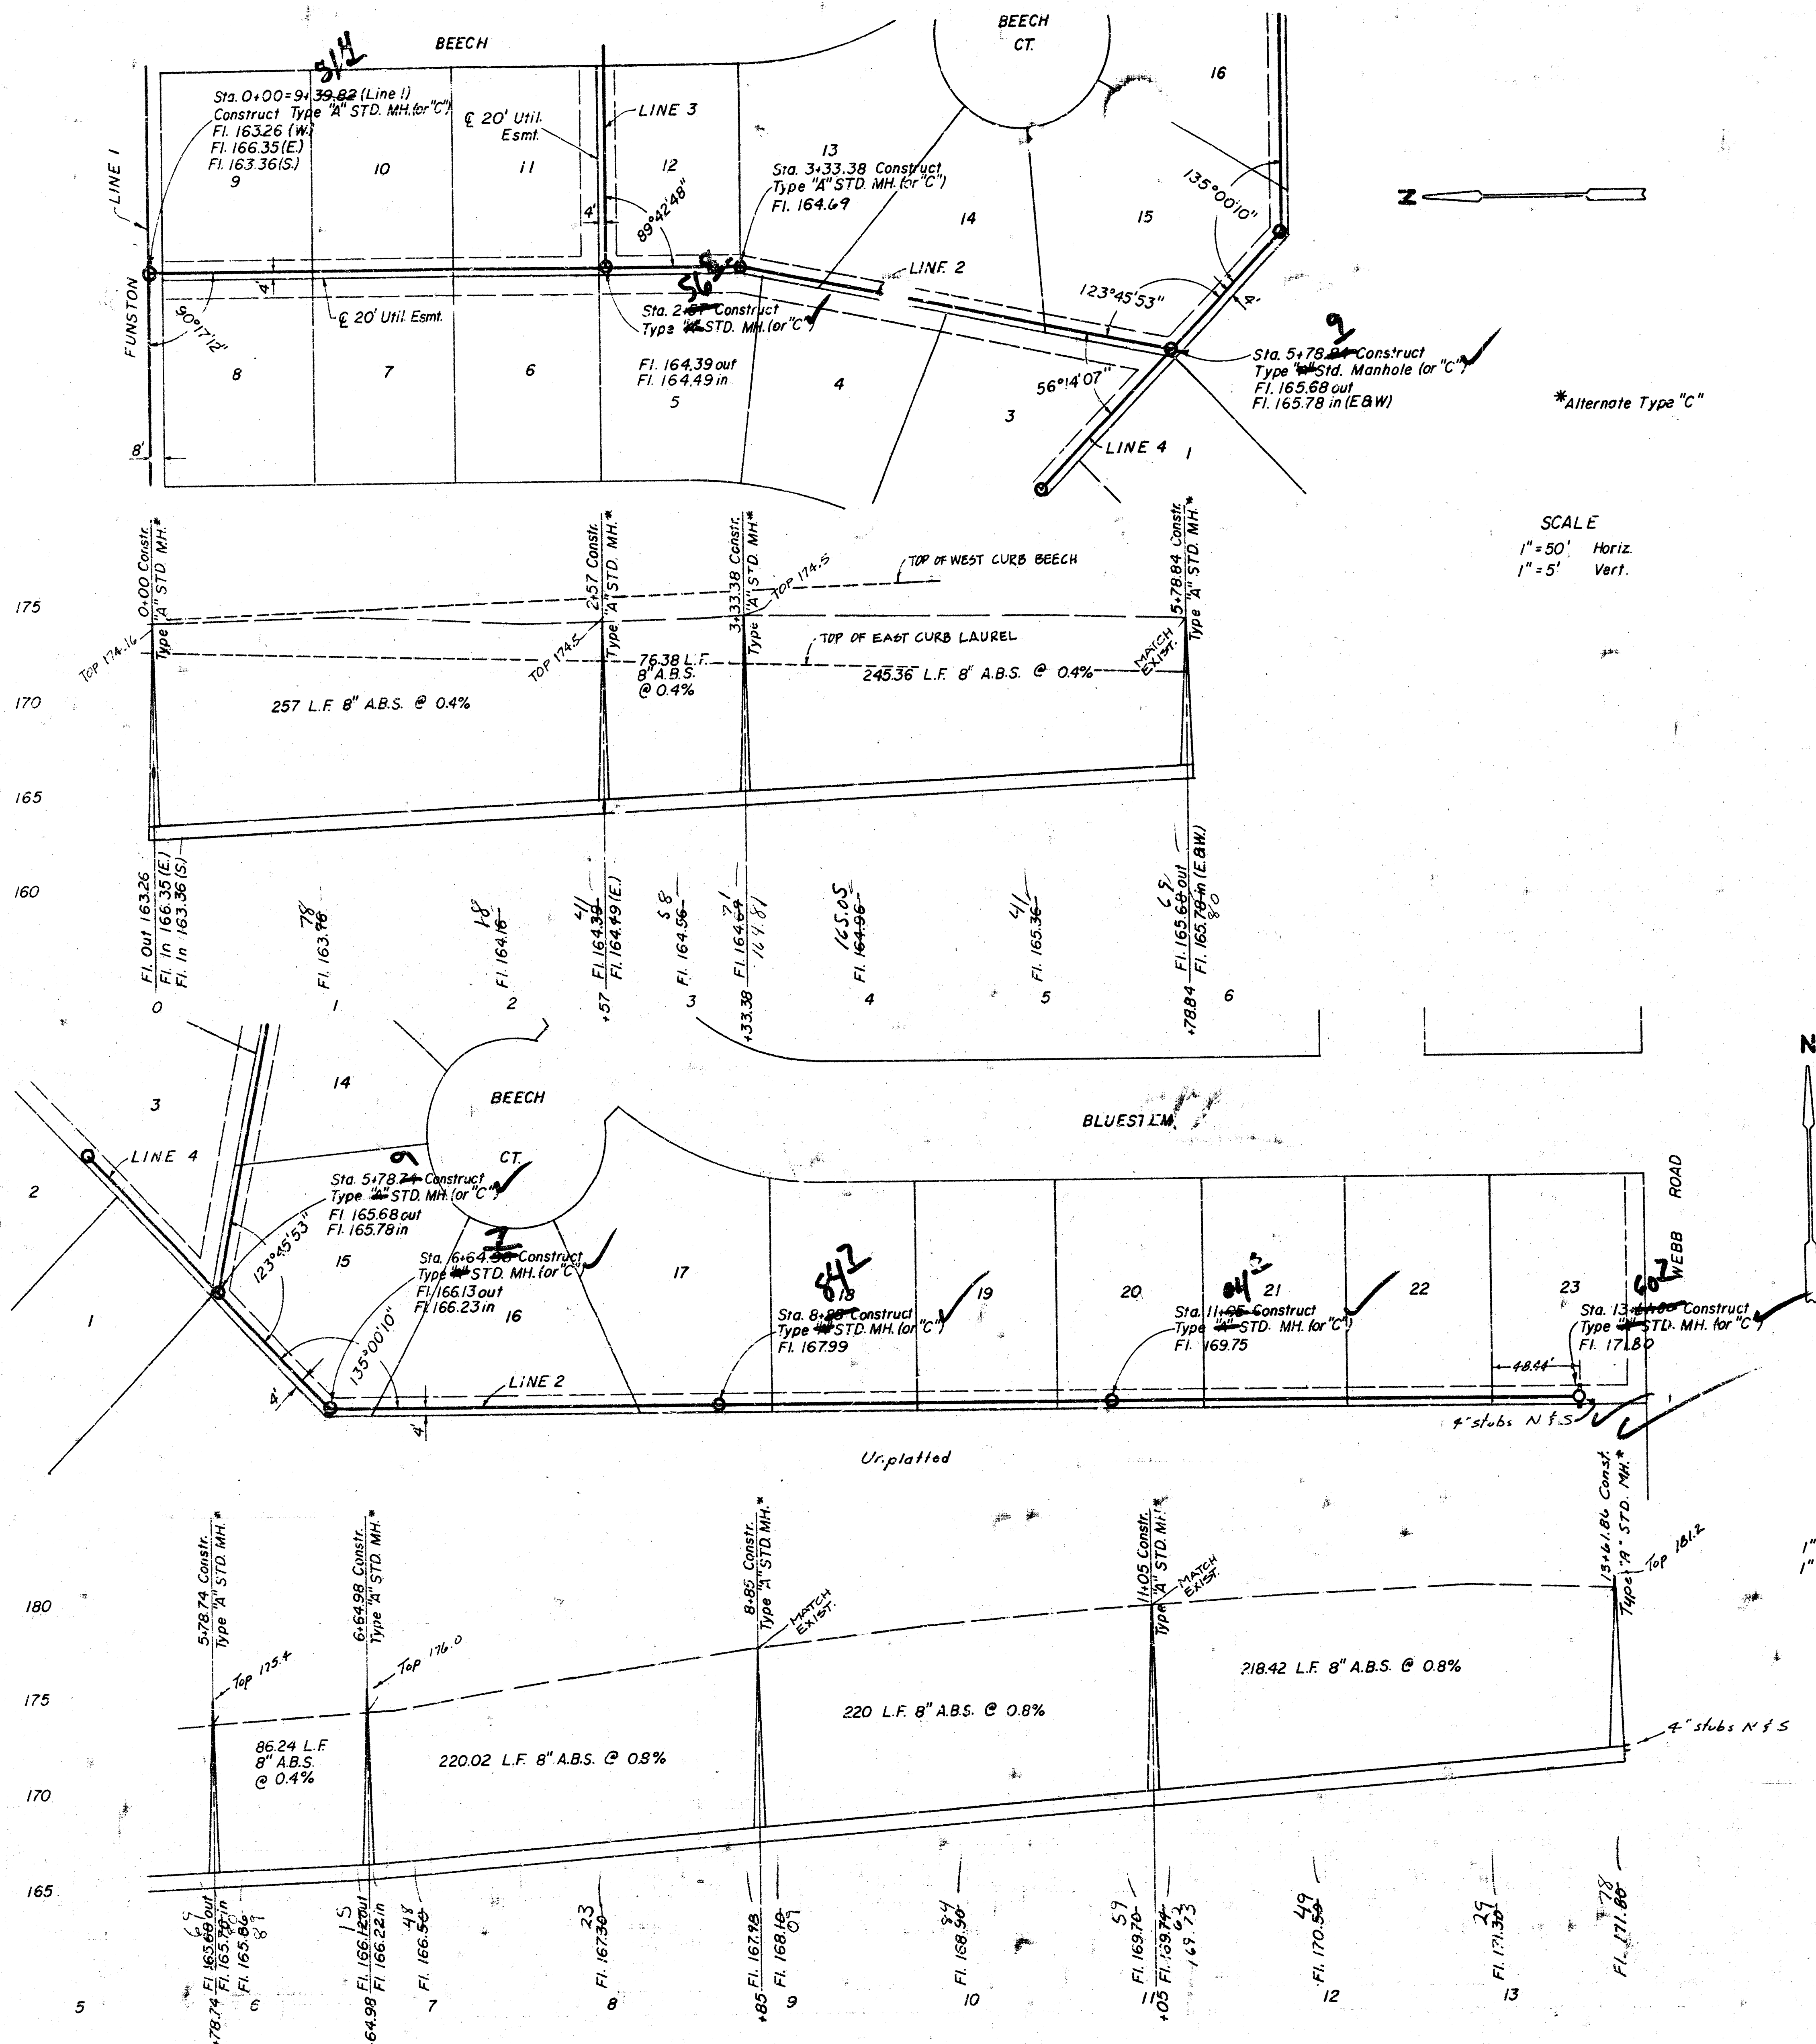

As Built
 10/81

SANITARY SEWER EXTENSIONS
 First Addition To Cedar Ridge
 Wichita, Kansas
 Lateral 33 Main 17
 War Industries Sewer
 Moehring & Associates
 Consulting Engineers
 Wichita

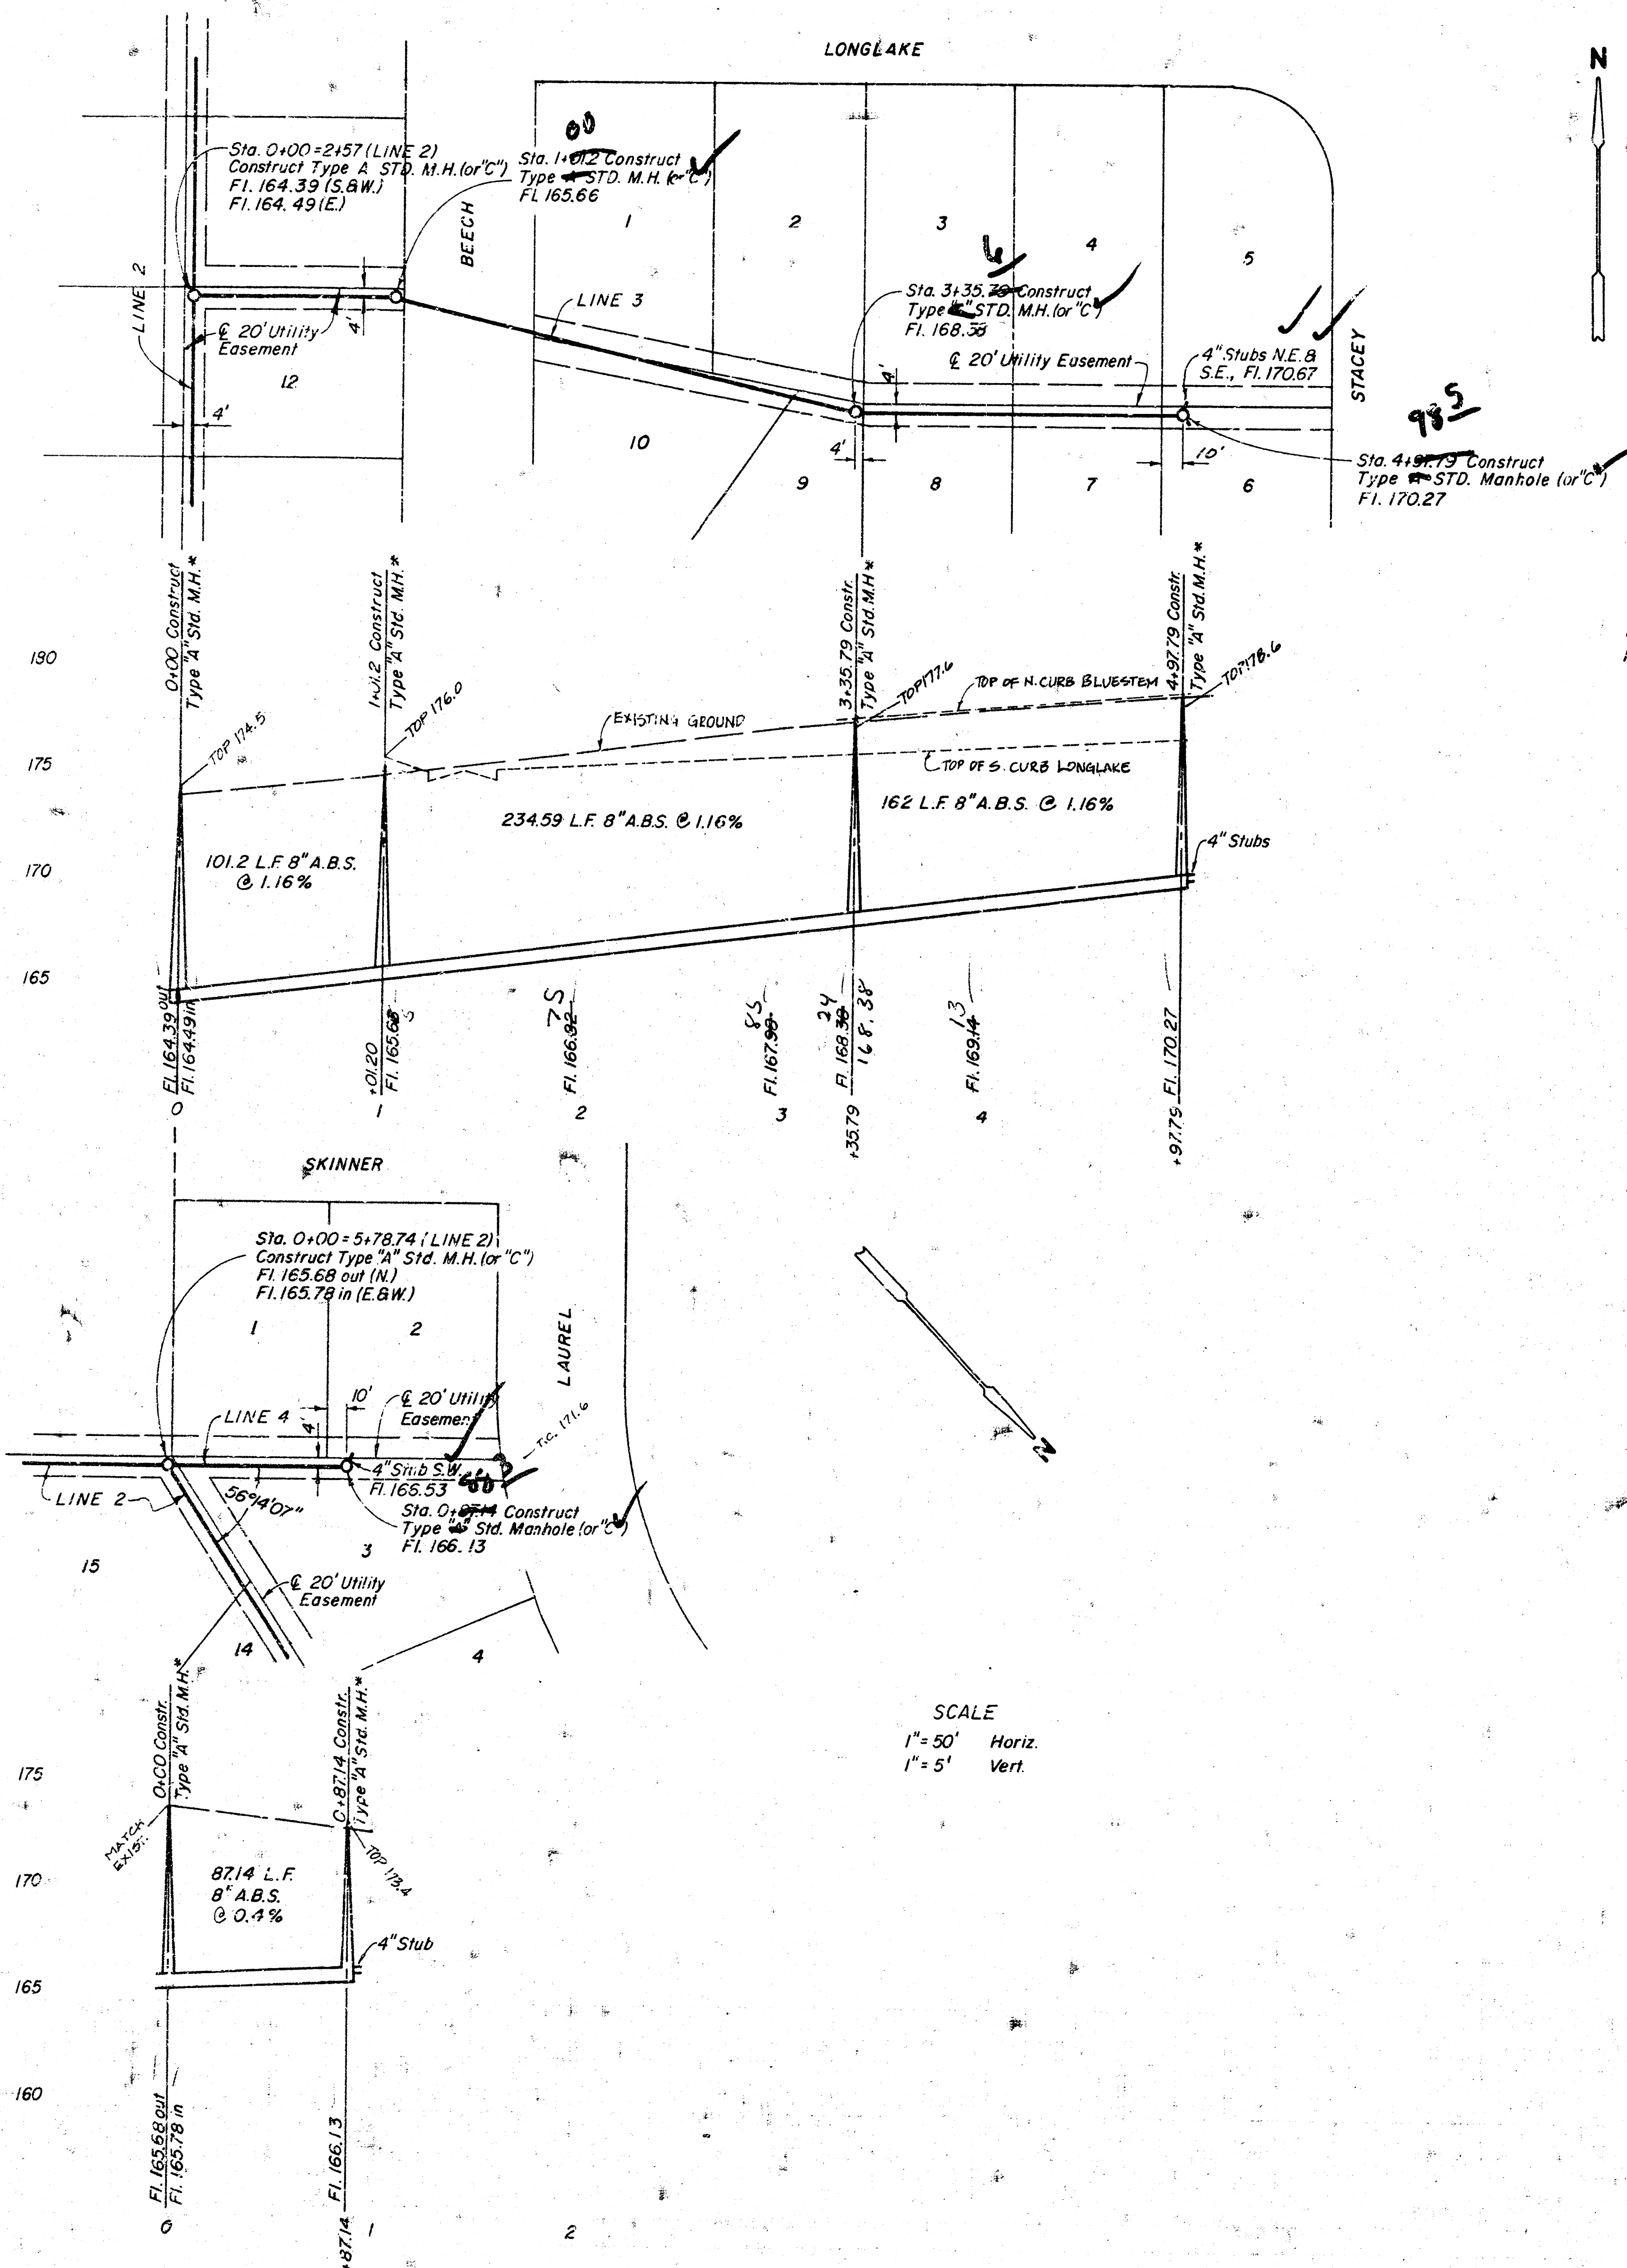

As Built
JLL
10/81

SANITARY SEWER EXTENSIONS
First Addition To Cedar Ridge
Wichita, Kansas
Lateral 33 Main 17
War Industries Sewer
Moehring & Associates
Consulting Engineers
Wichita