



MAIN 18, WAR INDUSTRIES SEWER
CITY OF WICHITA, KANSAS
R. W. LINN - CITY ENGINEER
FEB. 1974, PROJECT NO. DBKM573068

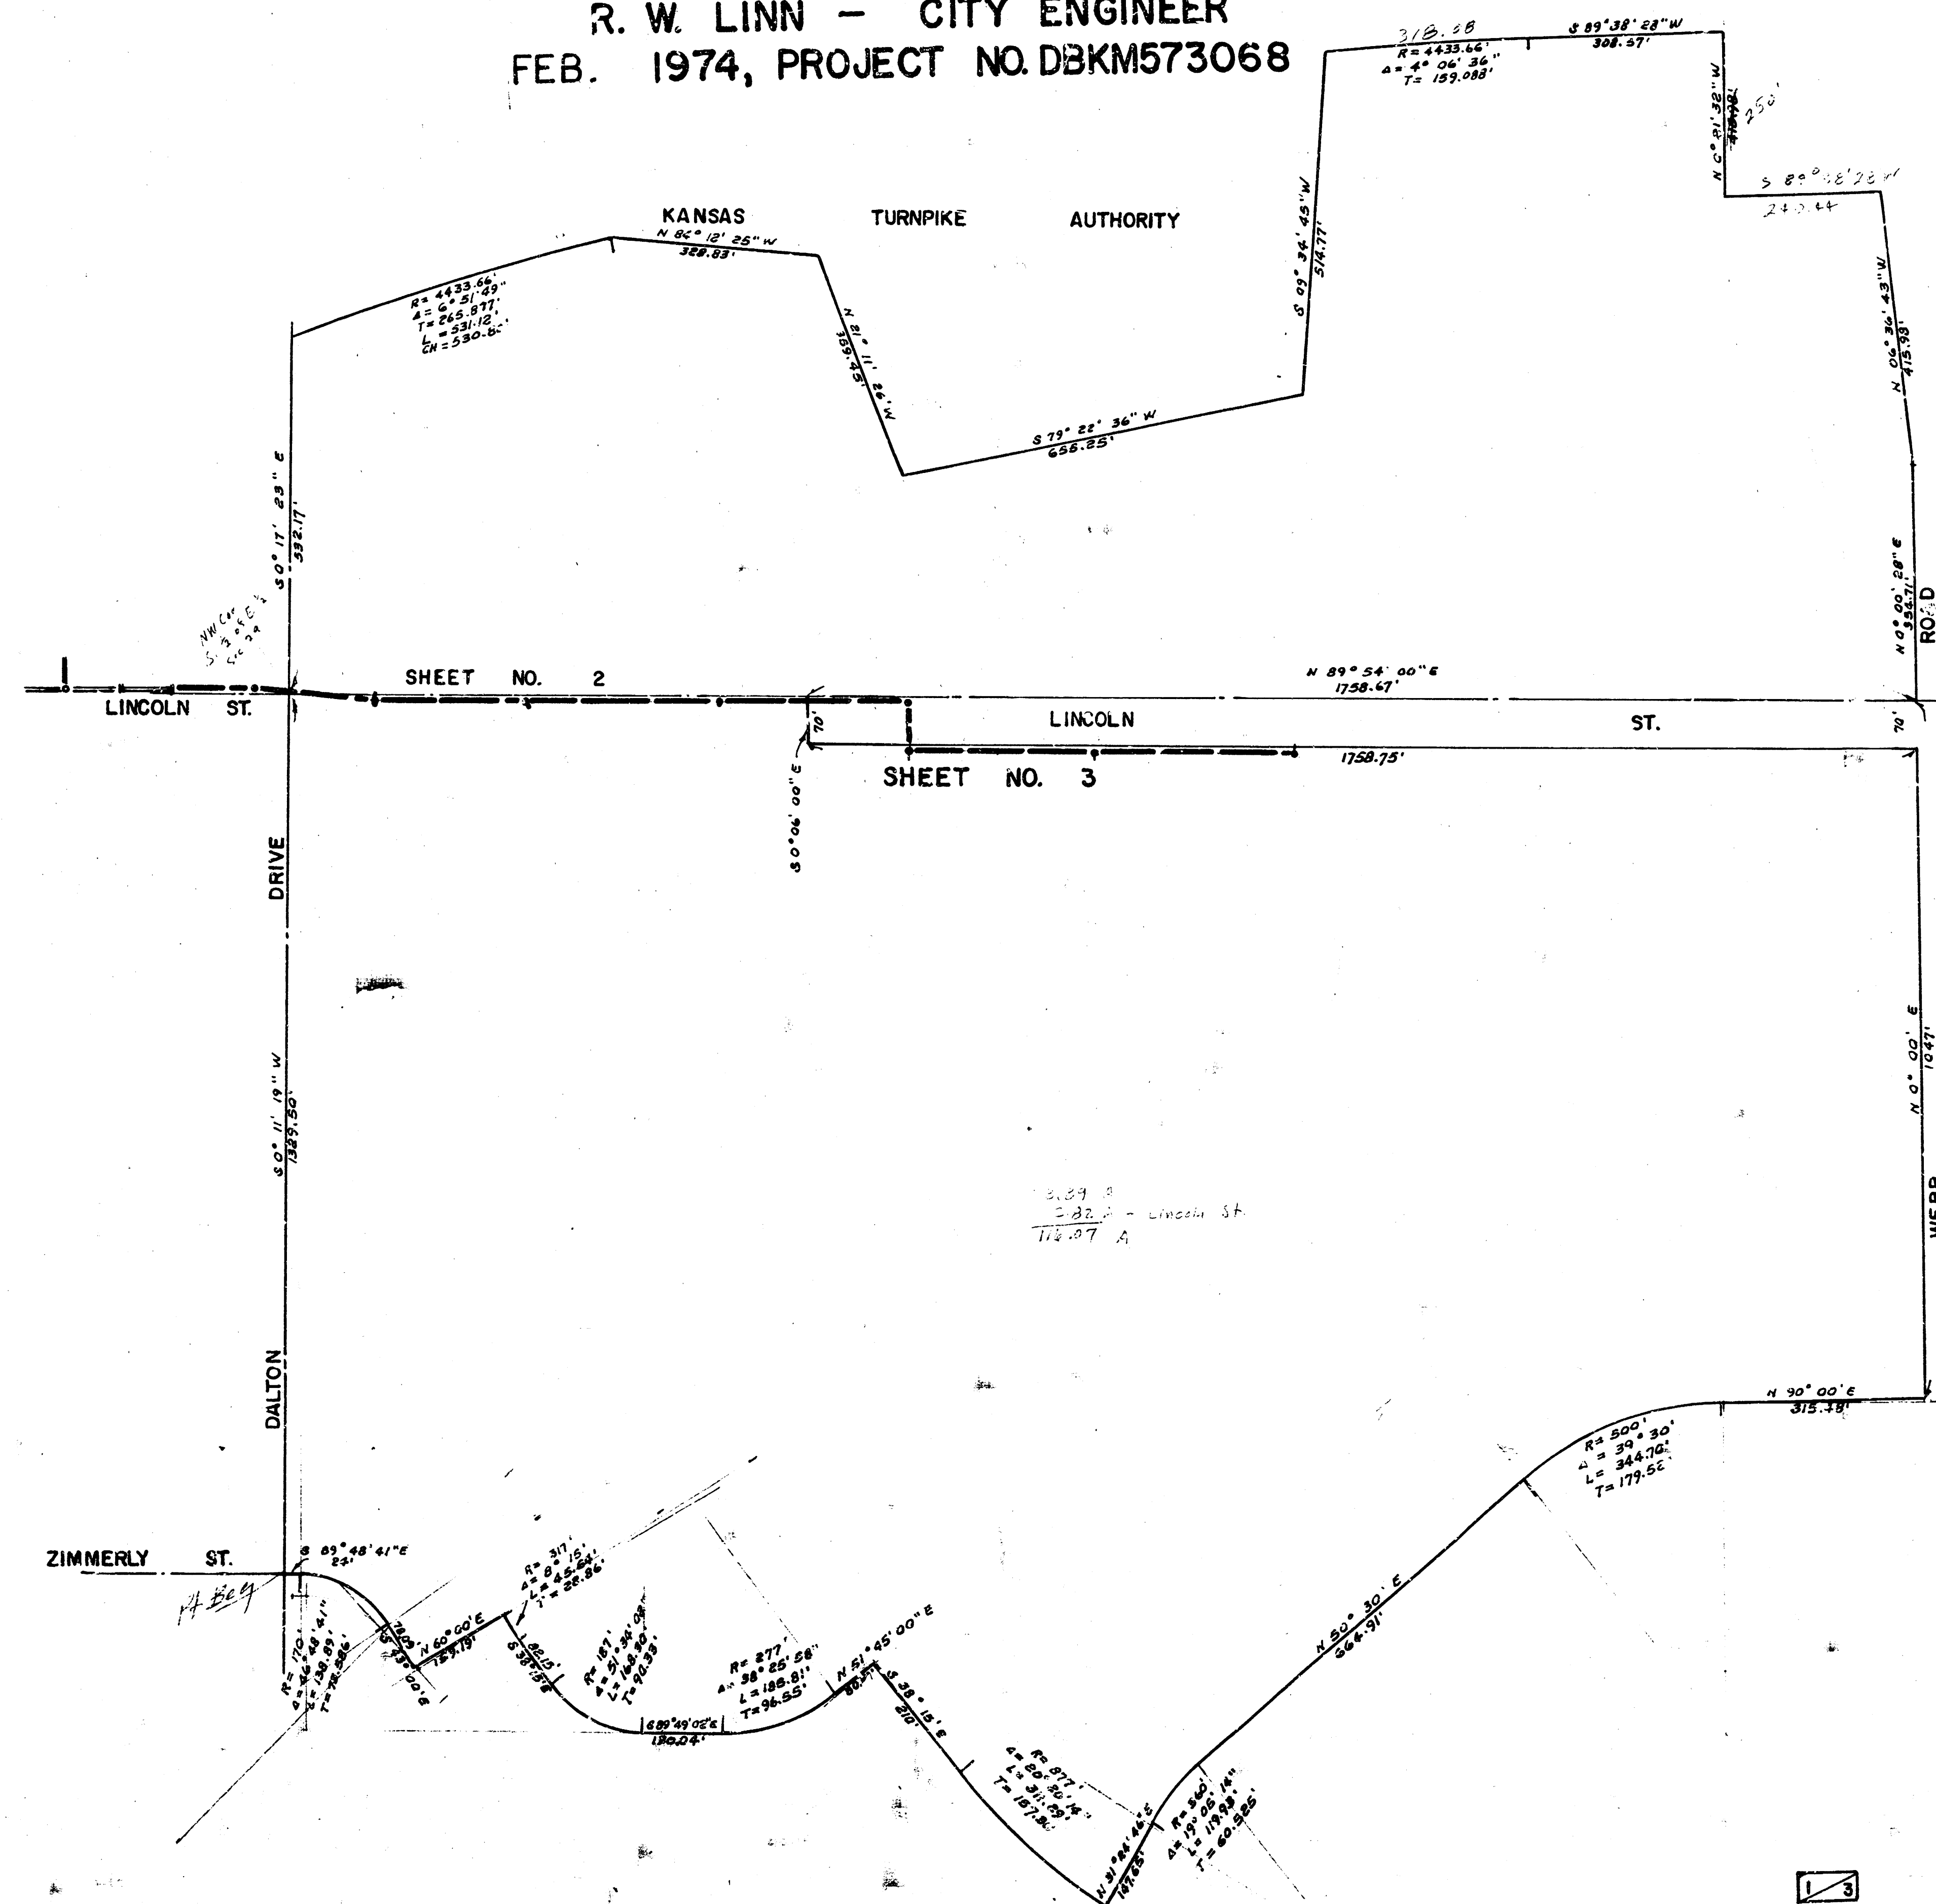

"As Built" Final Meas. 268-4
NOTE:
Sheet No. 3 Revised
March 6, 1974

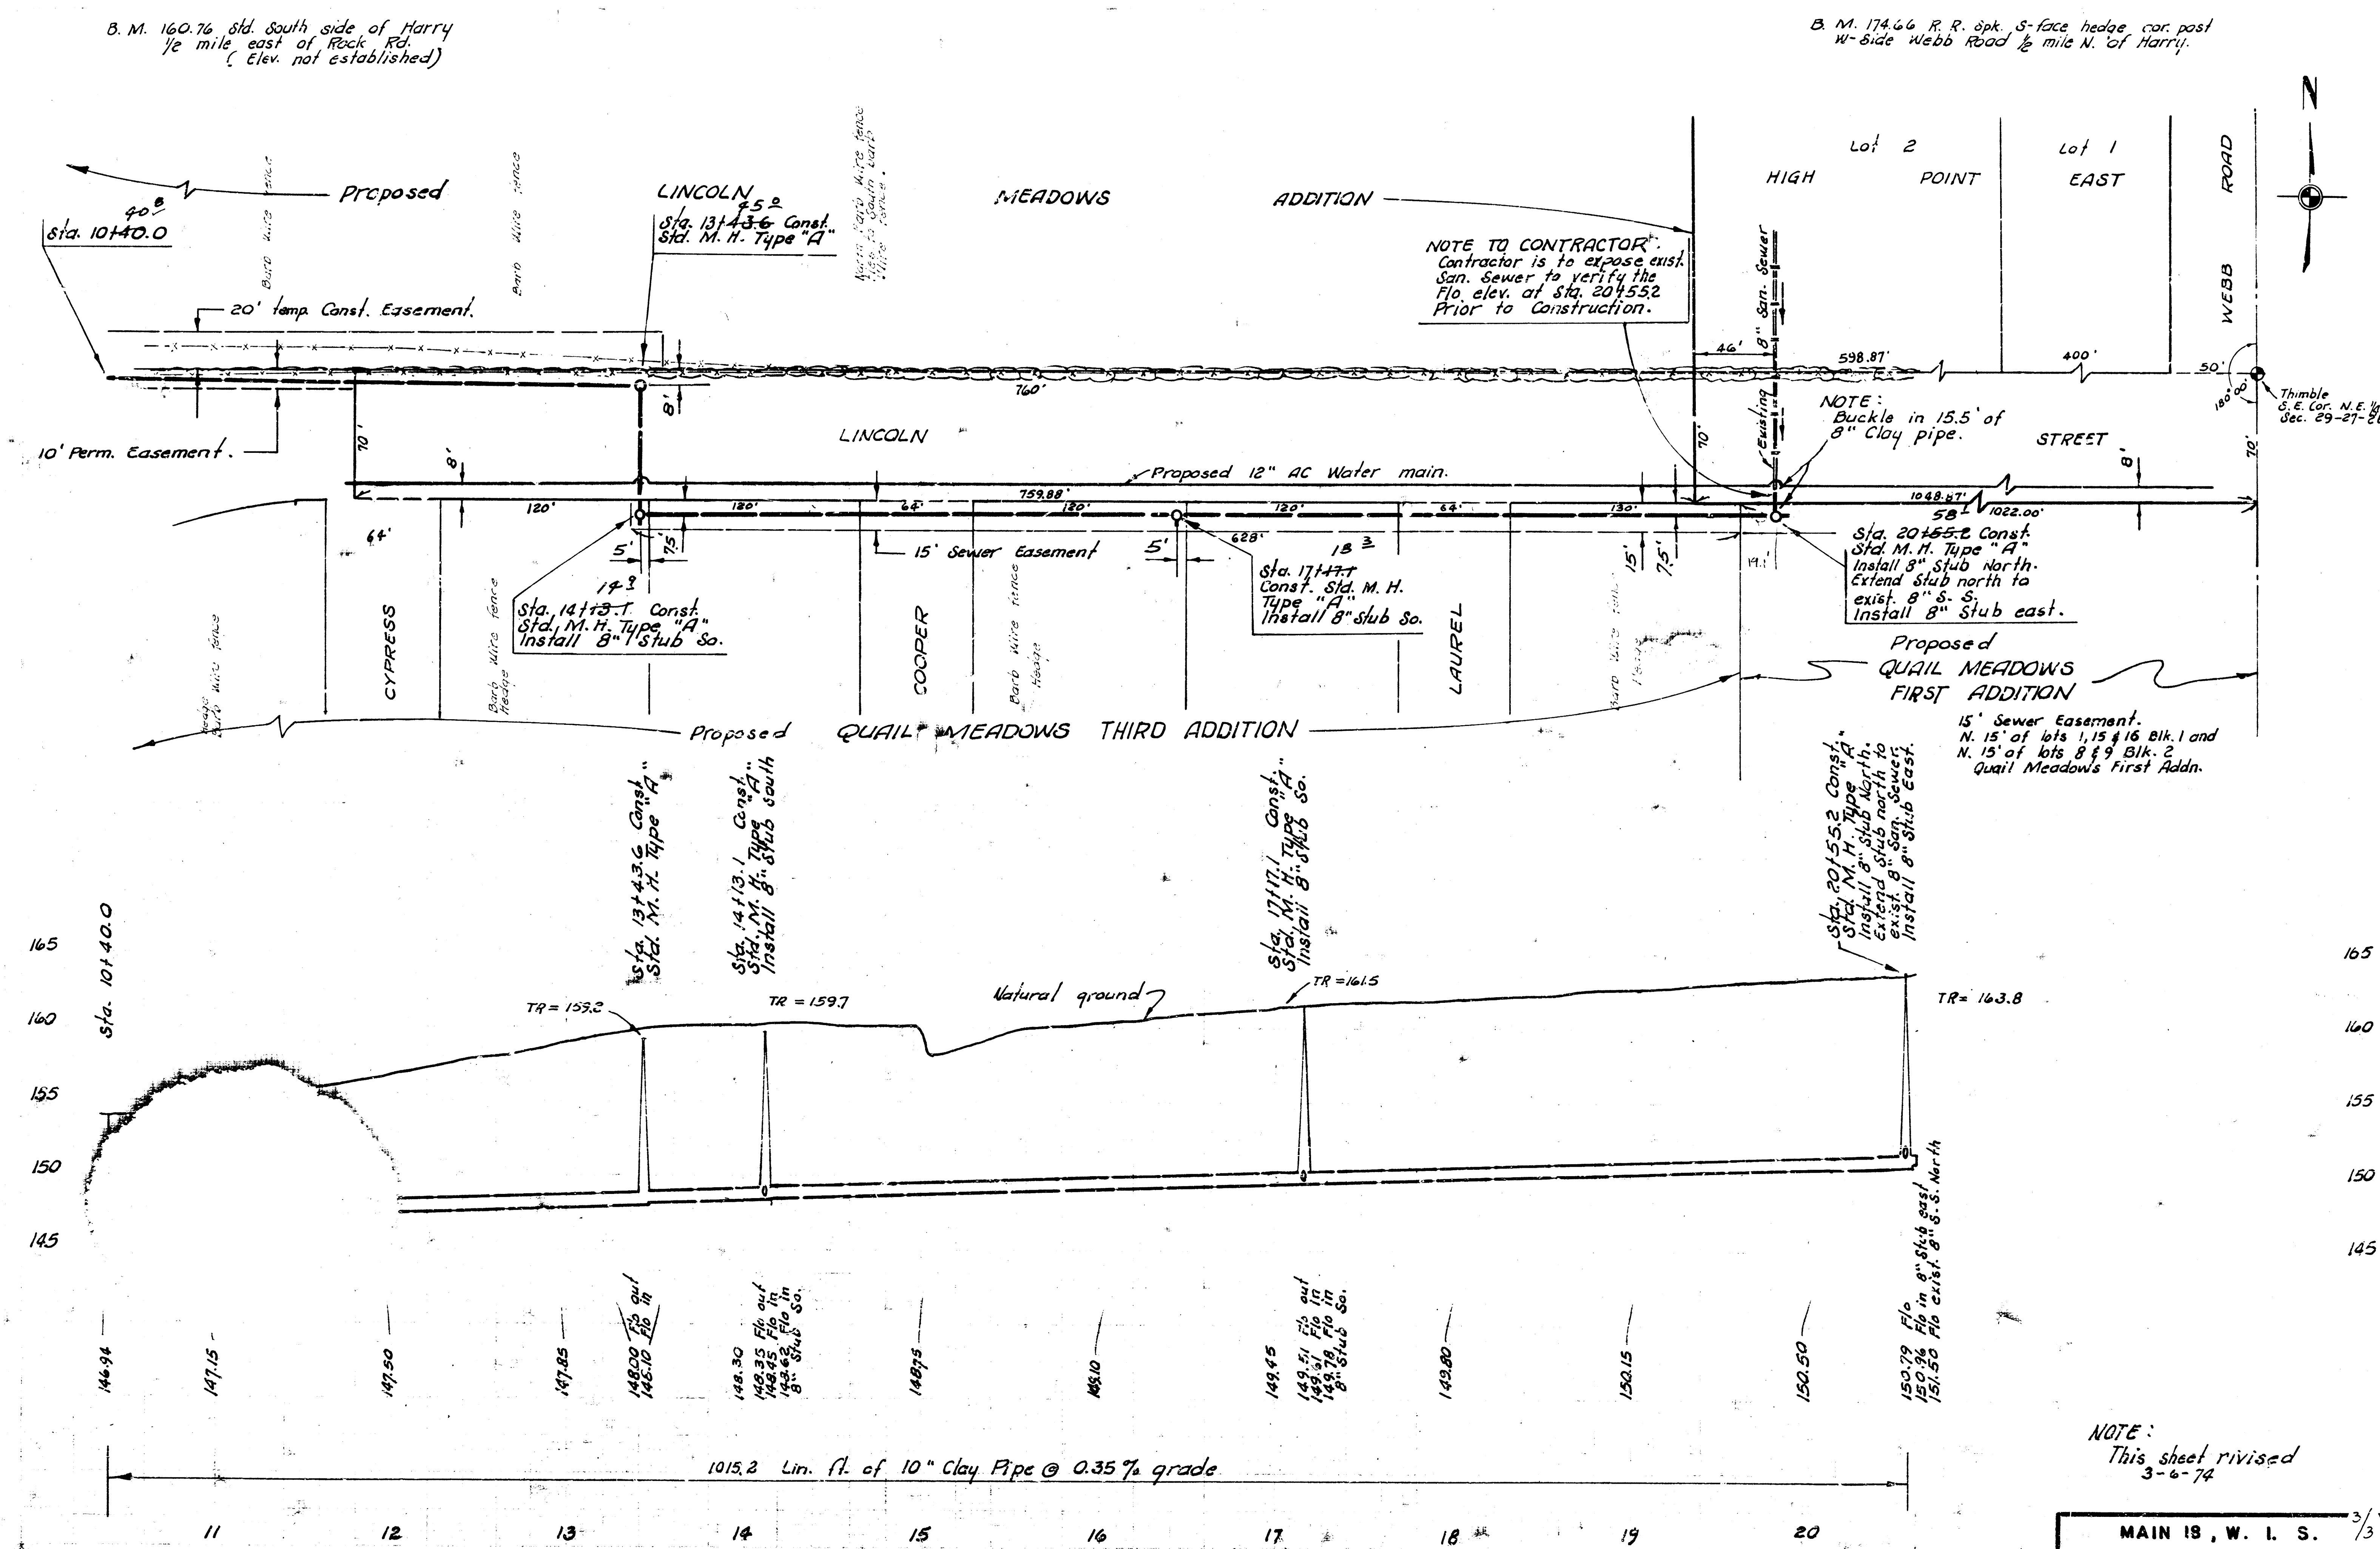

NOTE:
This sheet revised
3-6-74

MAIN 18, W. I. S. 3/3
PROJECT NO. DBKM573068