



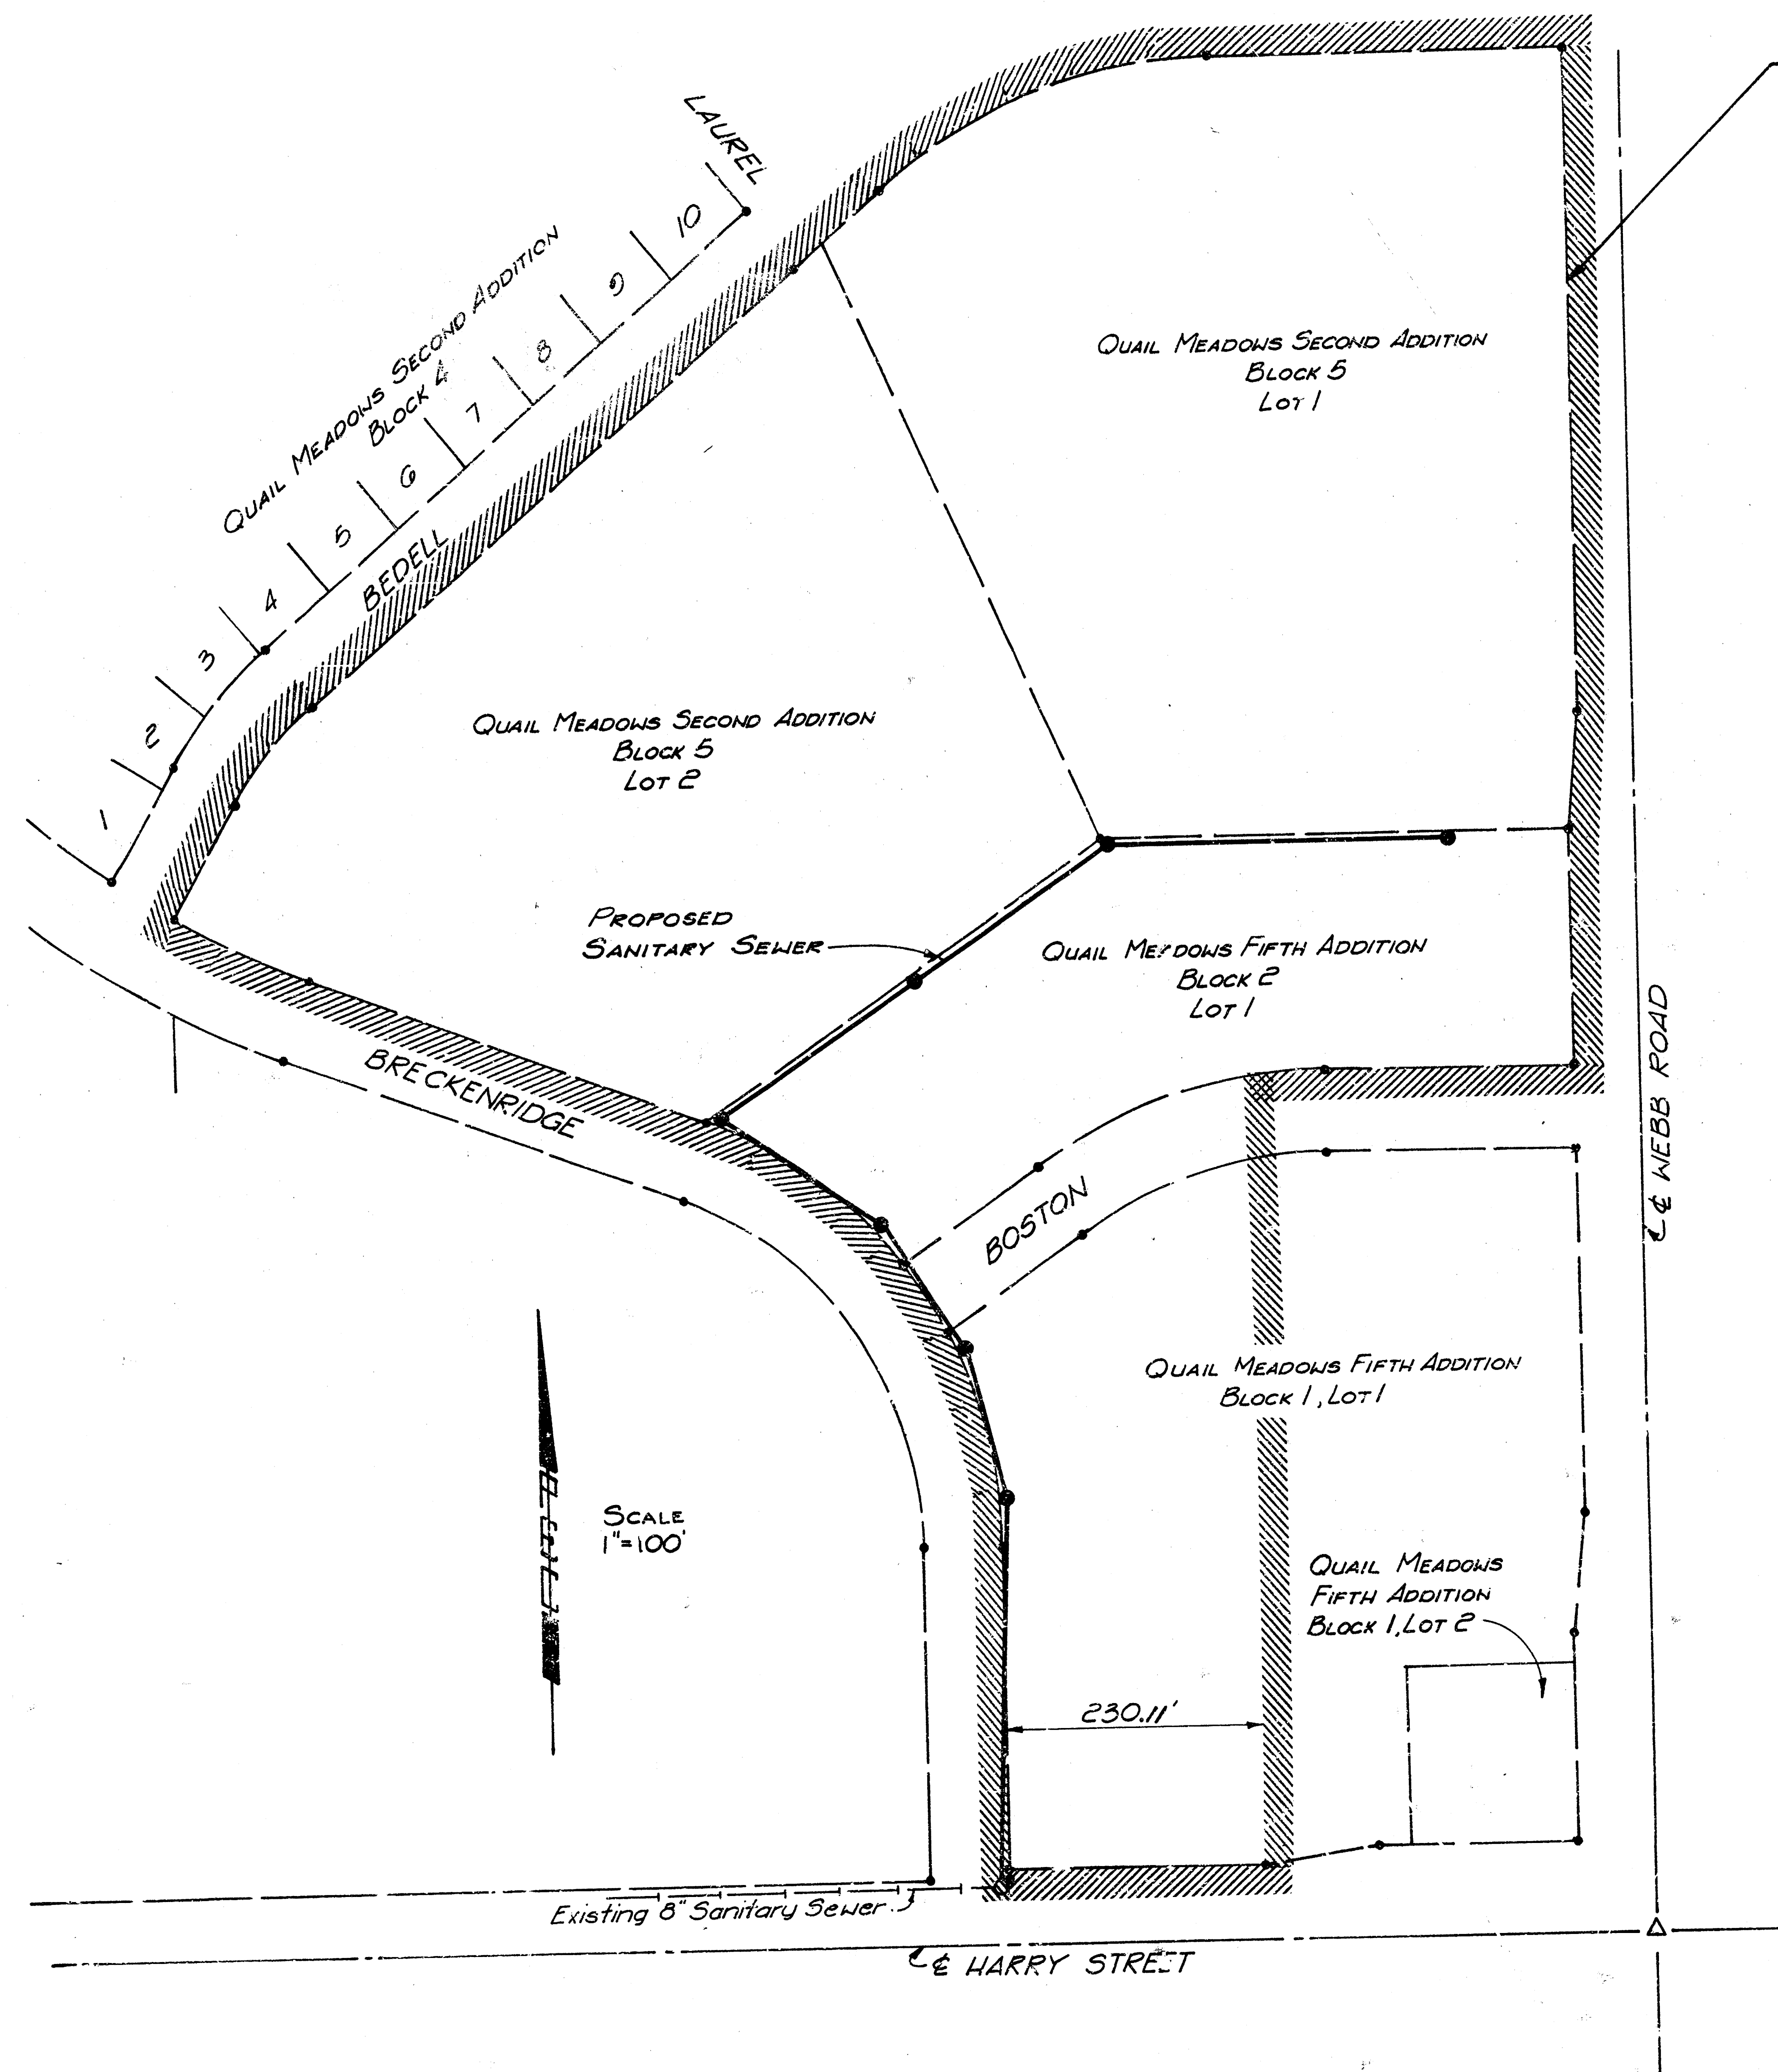


CITY OF WICHITA
SEDGWICK COUNTY, KANSAS
PROJECT NO. DBKL 574040
 PROJECT NUMBER: 468-76-245-80152-000-000-001

WAR INDUSTRY SEWER
LATERAL NO. 3, MAIN 19

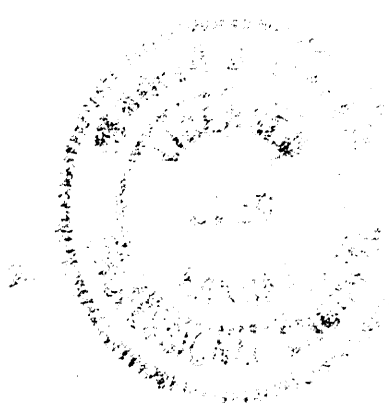


As built 11-6-78
PROFESSIONAL ENGINEERING CONSULTANTS, P.A.
 ENGINEERS
 WICHITA, KANSAS

NOTE: All materials and excavation necessary to connect the 8" Pipe to existing manhole, including the removal of pipe plugs, shall be considered subsidiary to the price bid for 8" Pipe.

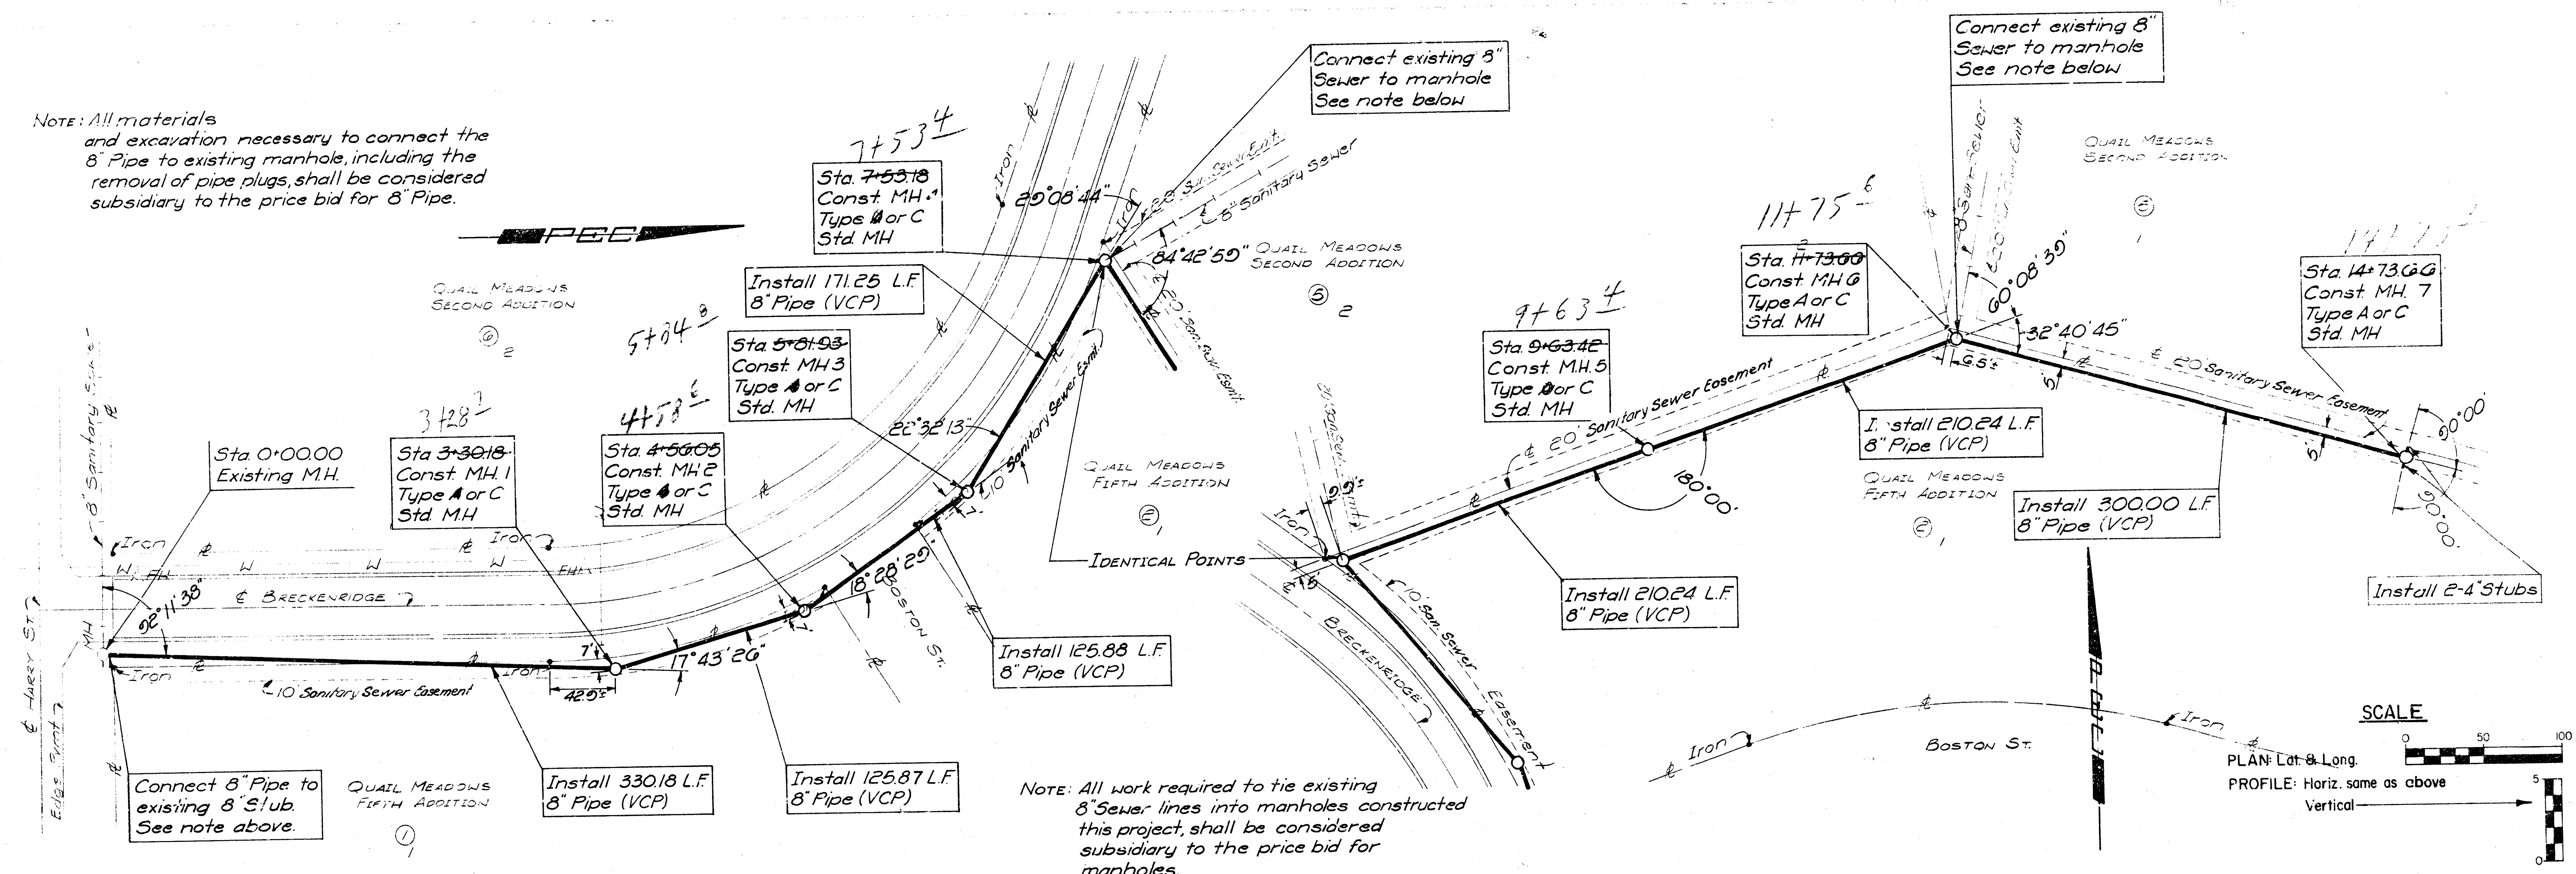

NOTE: All work required to tie existing 8" Sewer lines into manholes constructed this project, shall be considered subsidiary to the price bid for manholes.

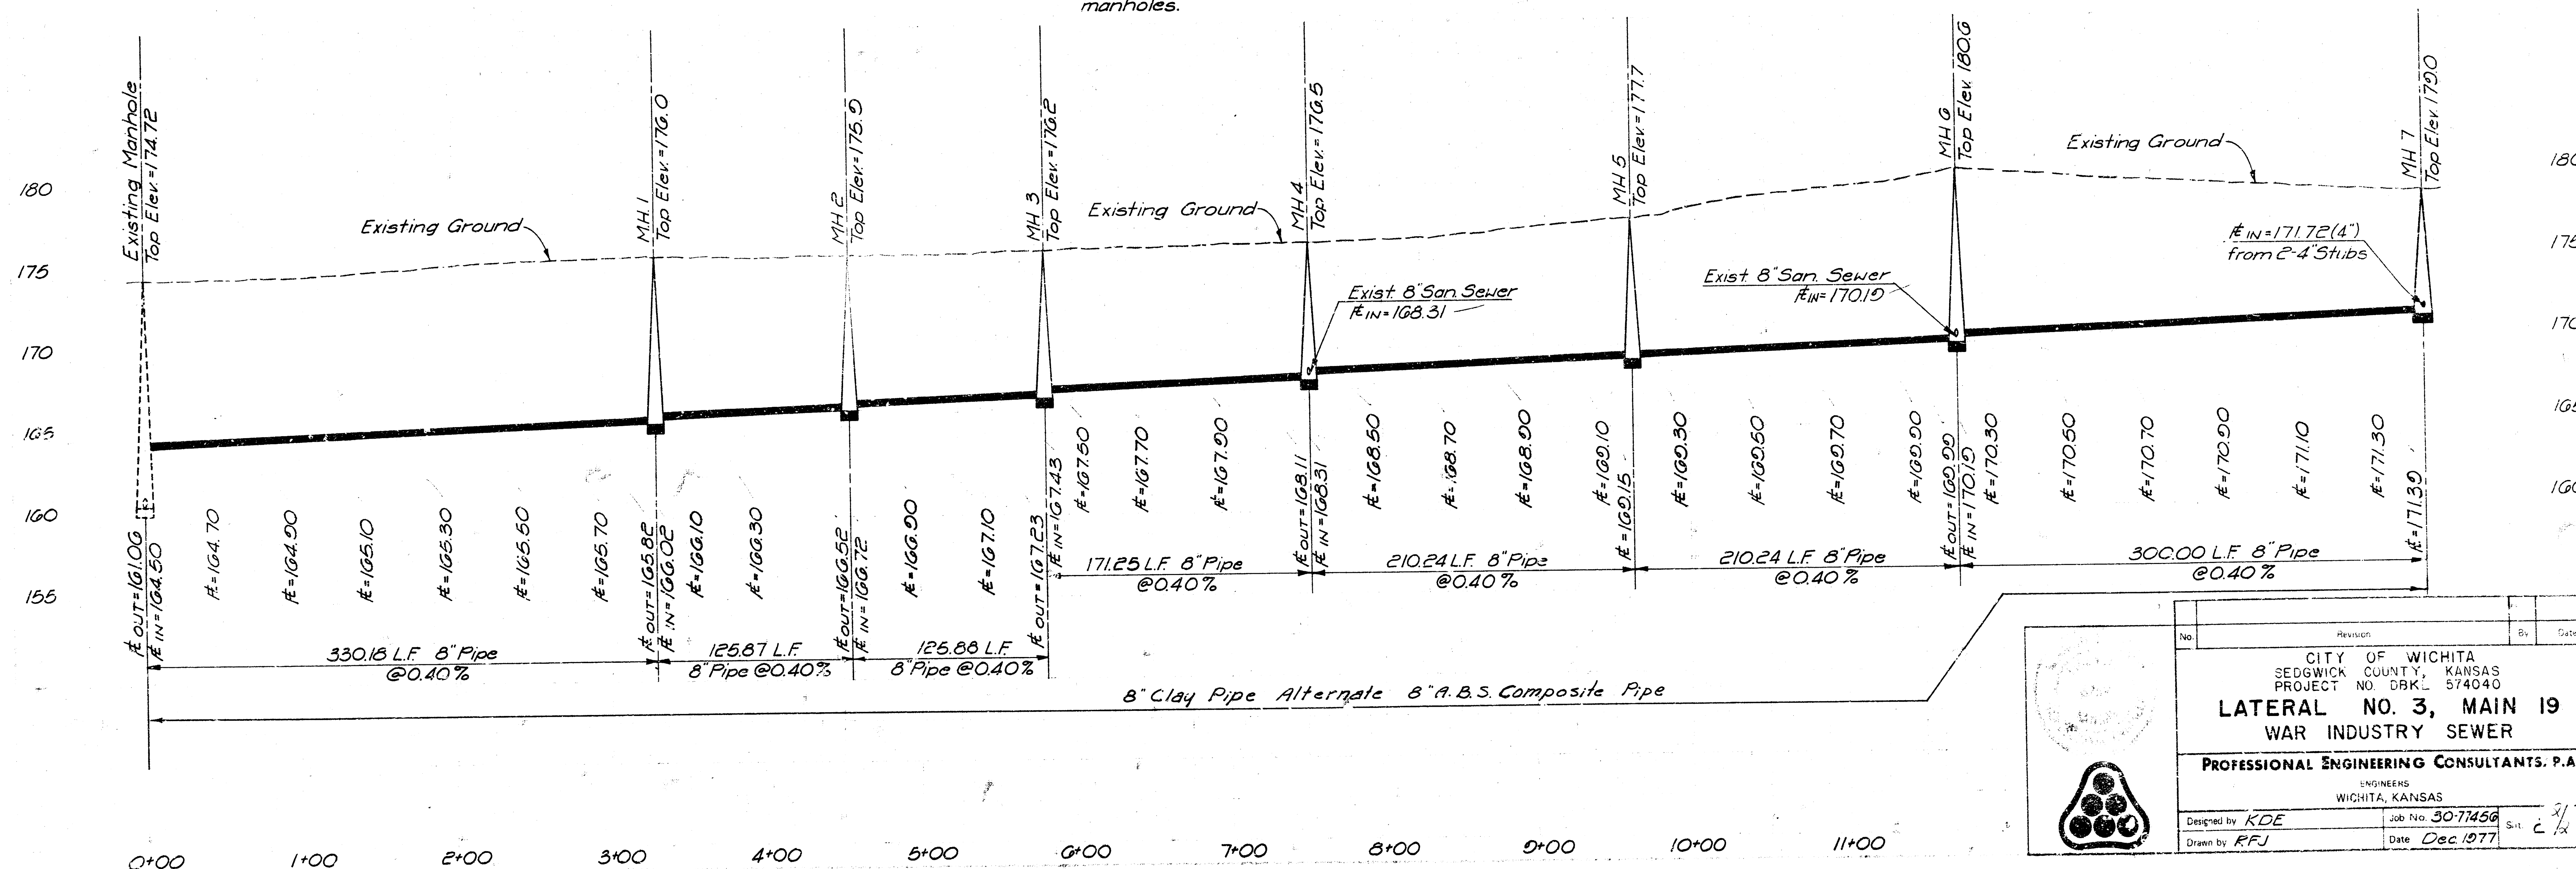

Revision		By	Date
No.			
CITY OF WICHITA SEDDWICK COUNTY, KANSAS PROJECT NO. DBKL 574040			
LATERAL NO. 3, MAIN 19			
WAR INDUSTRY SEWER			
PROFESSIONAL ENGINEERING CONSULTANTS, P.A.			
ENGINEERS WICHITA, KANSAS			
Designed by	KDE	Job No.	30-7456
Drawn by	RFJ	Date	Dec 1977
		Sheet	2 of 2