

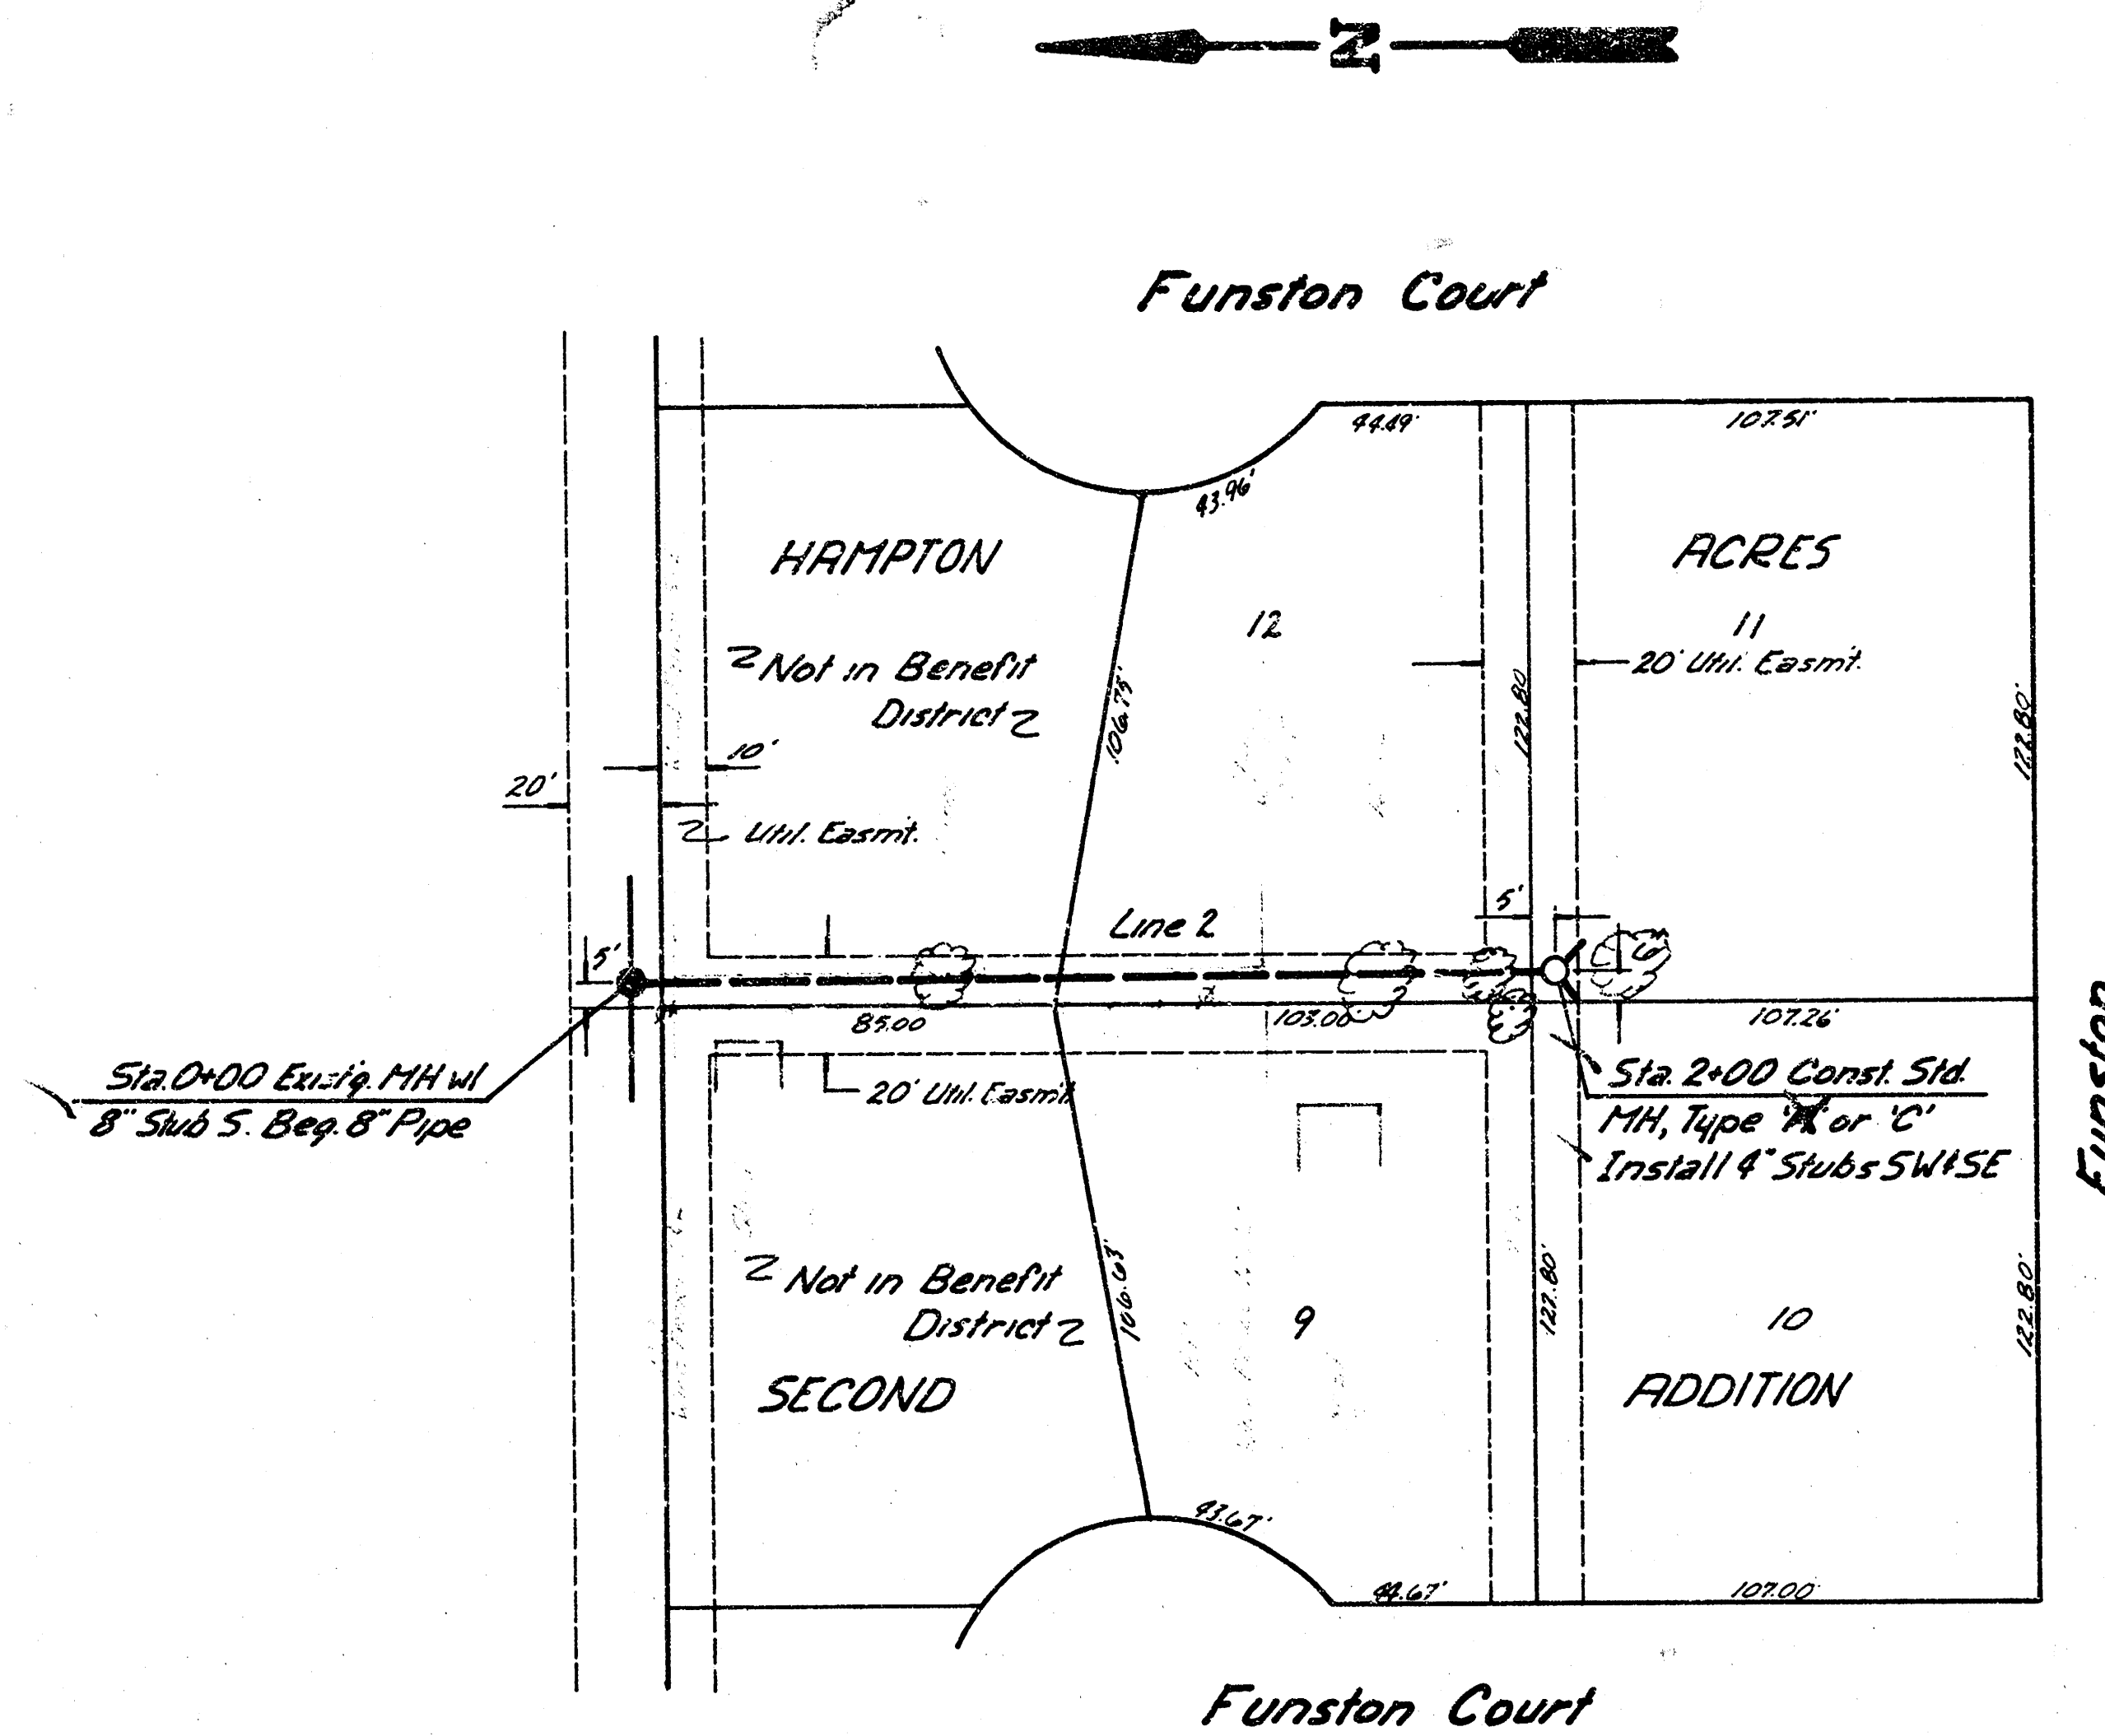
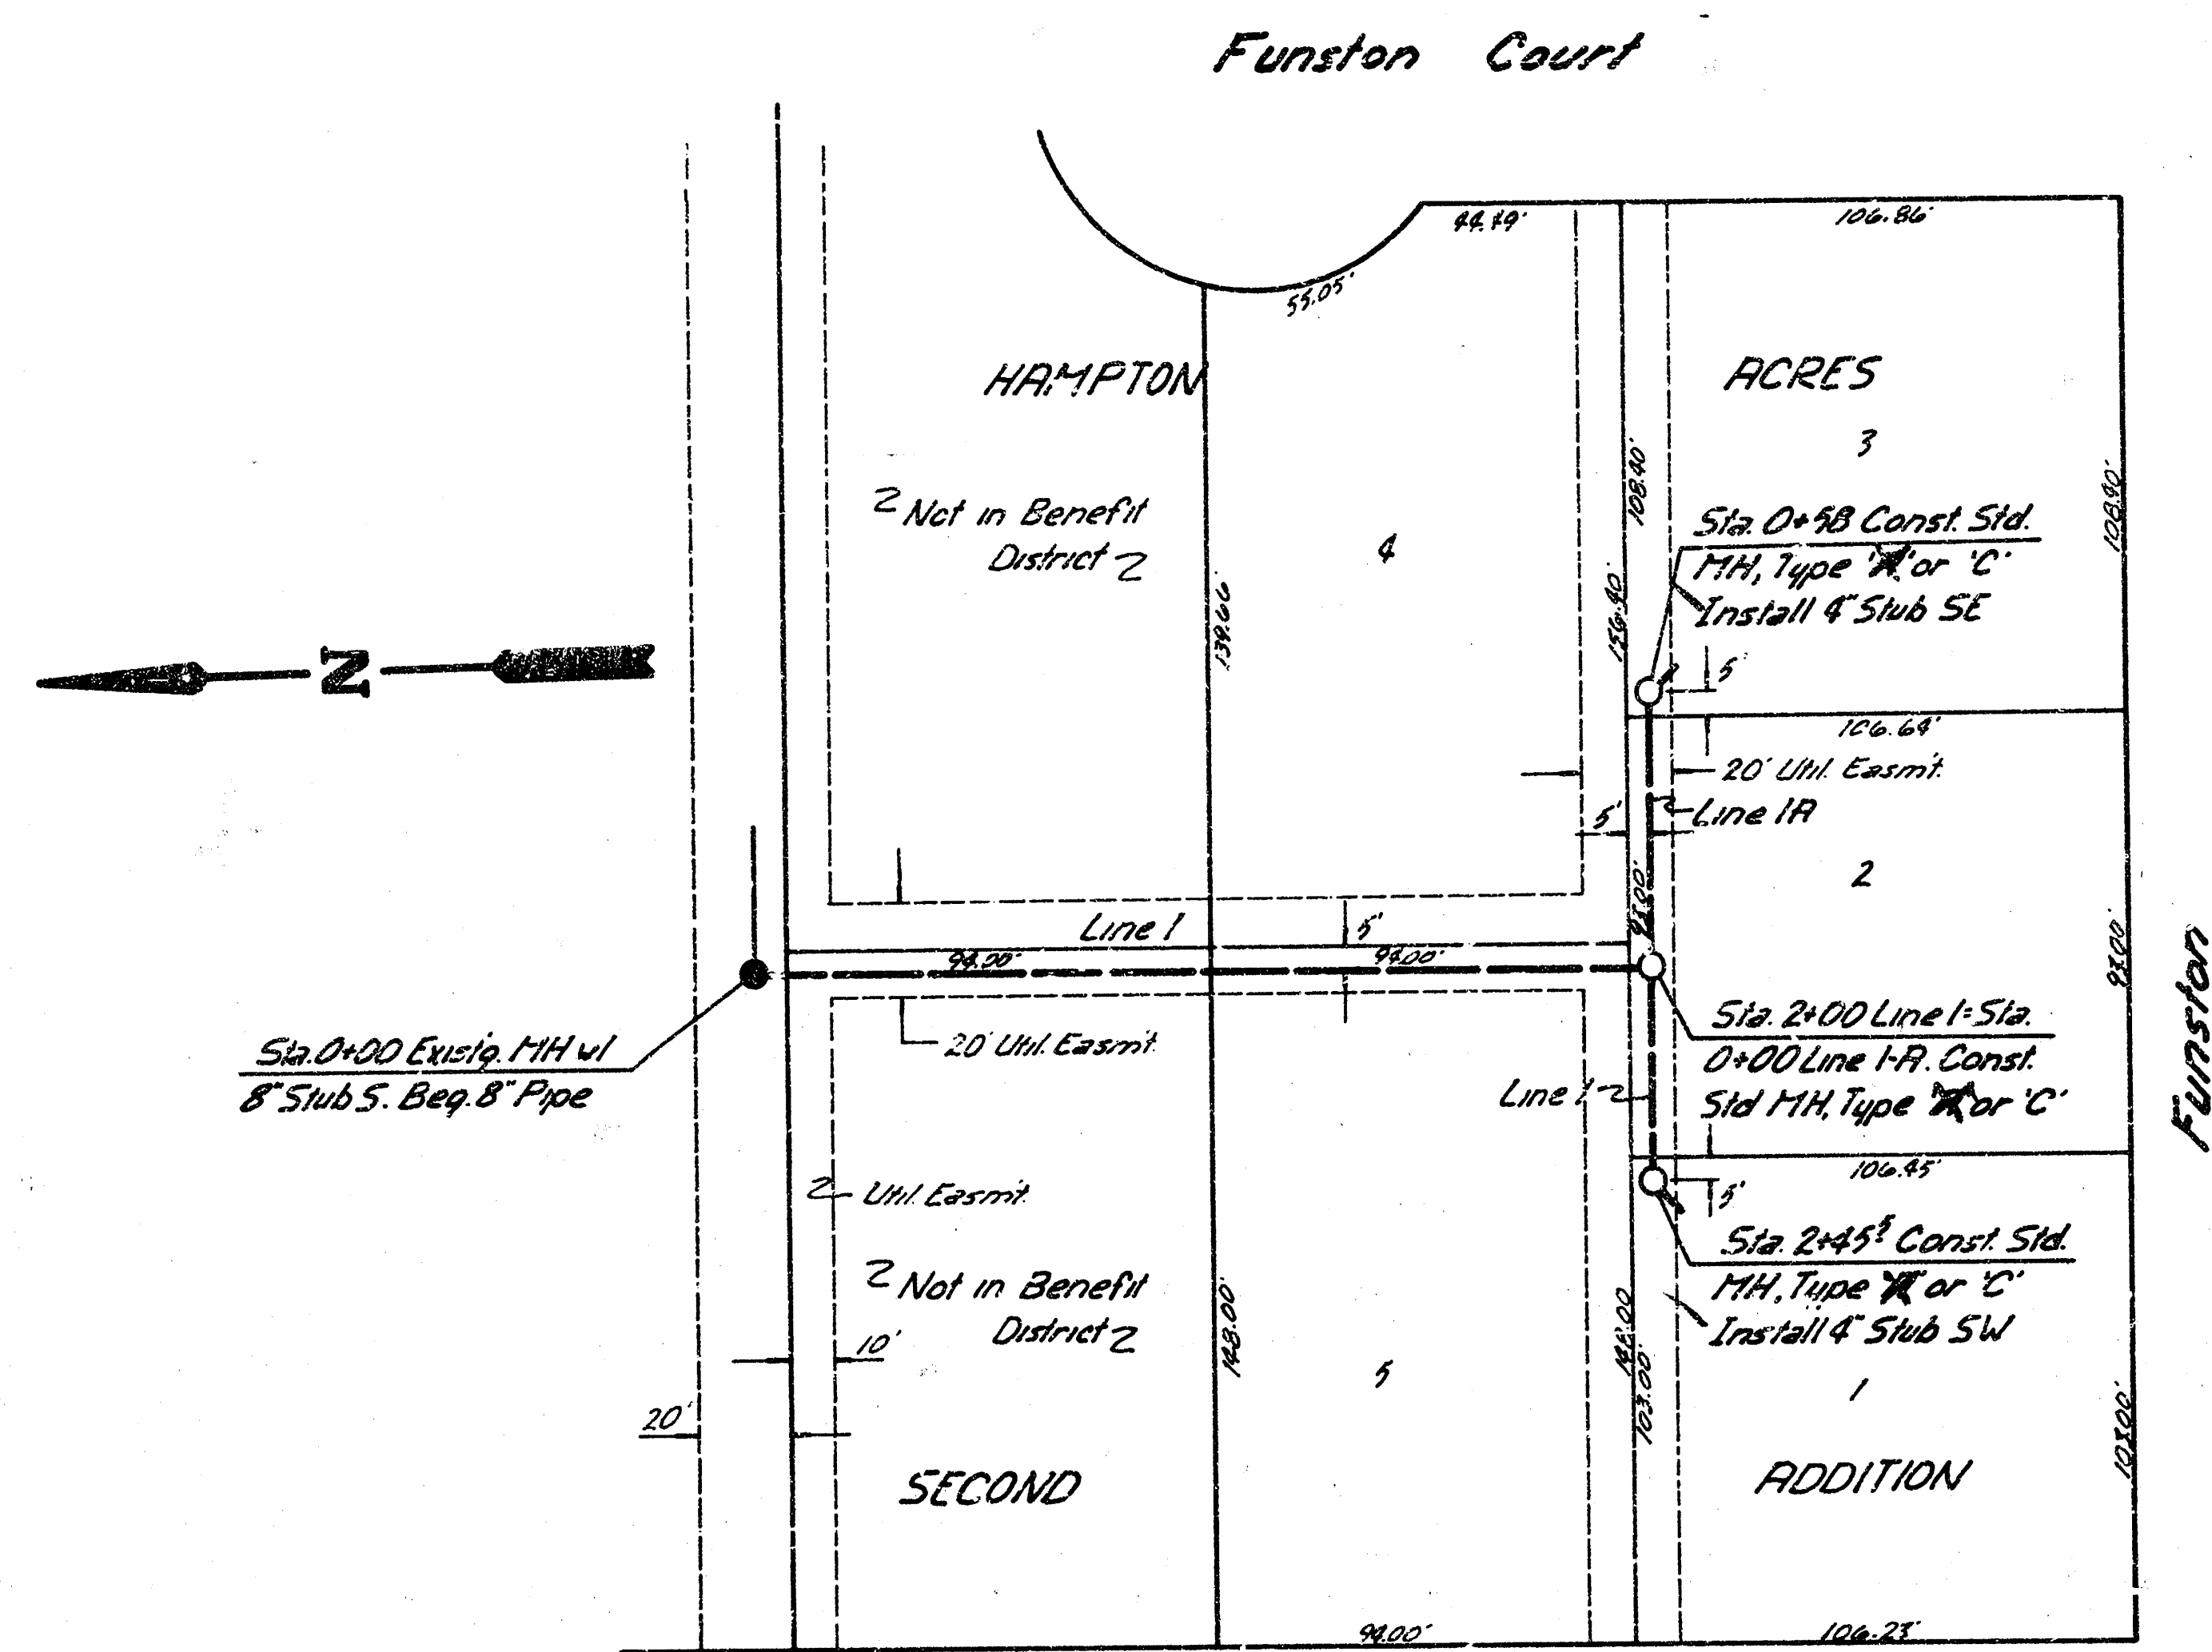


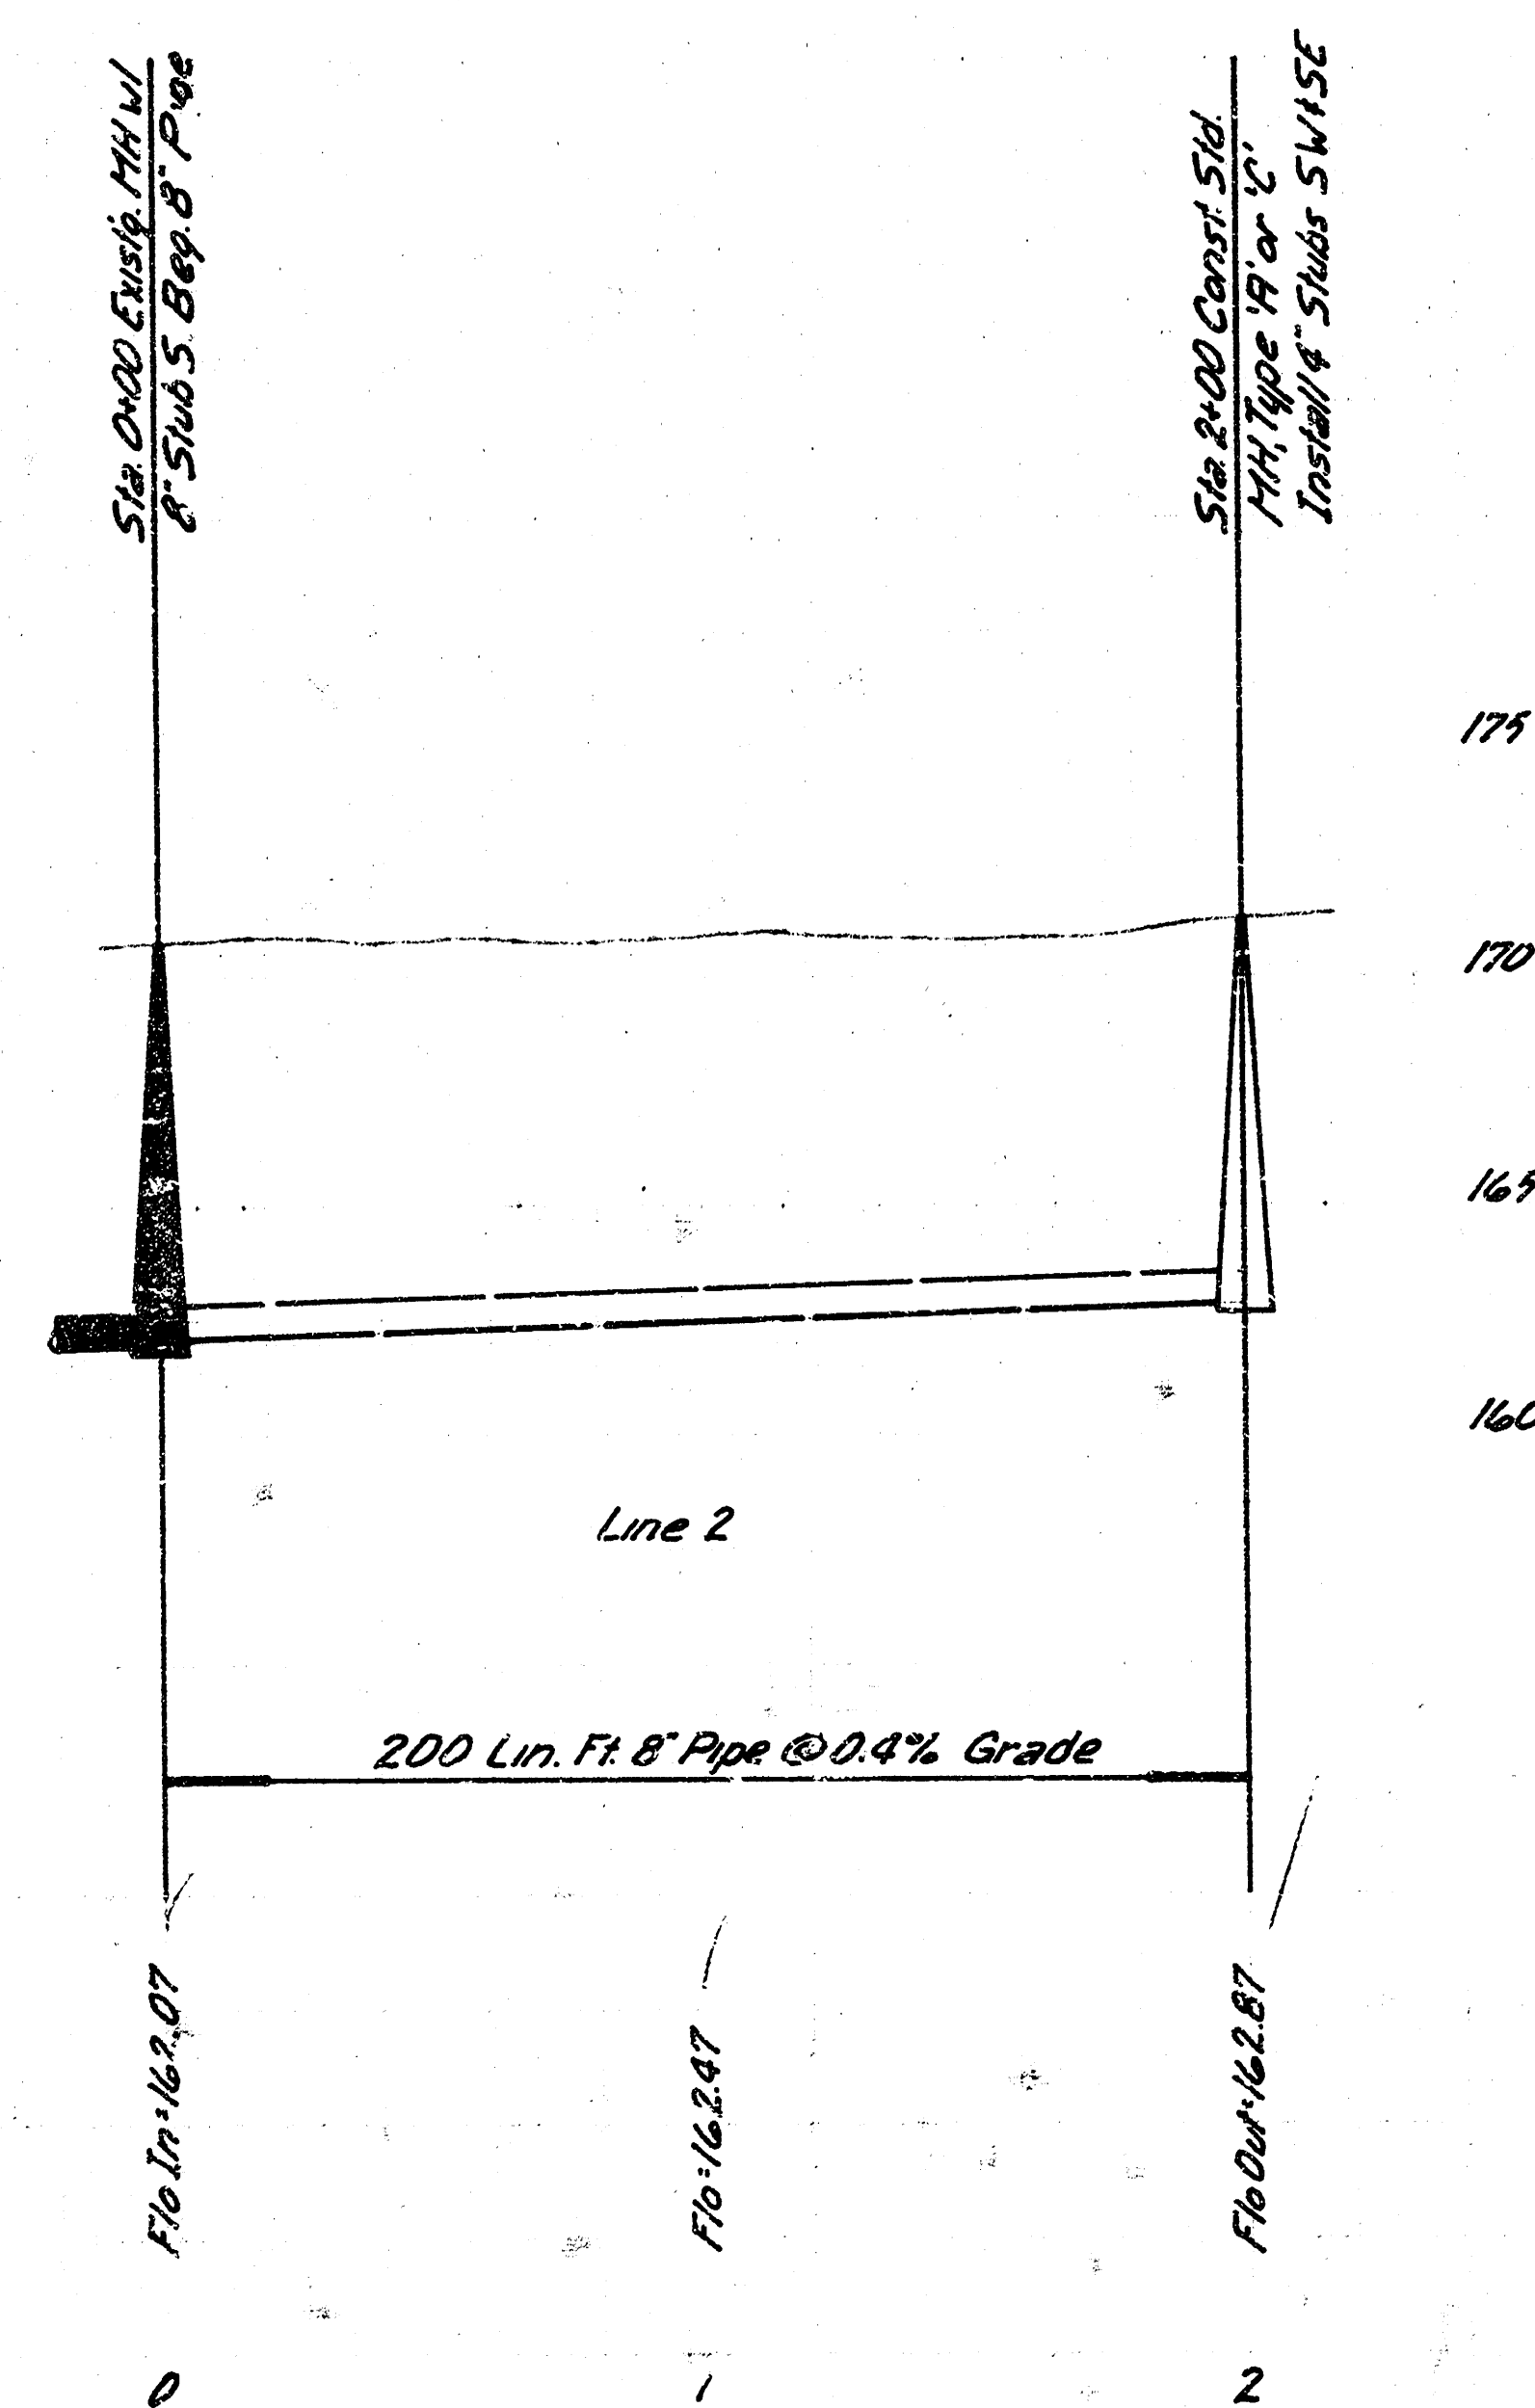

Field Engineer to set Top of MH's to Finish Grade as Determined by the Developer.

B.M. 16948 R.R. Spk. W. Face P. Pole N.E. Cor Funston & Cypress

SCALE
Plan 1"=40'
Profile Vert 1"=40'
Vert 1"=5'

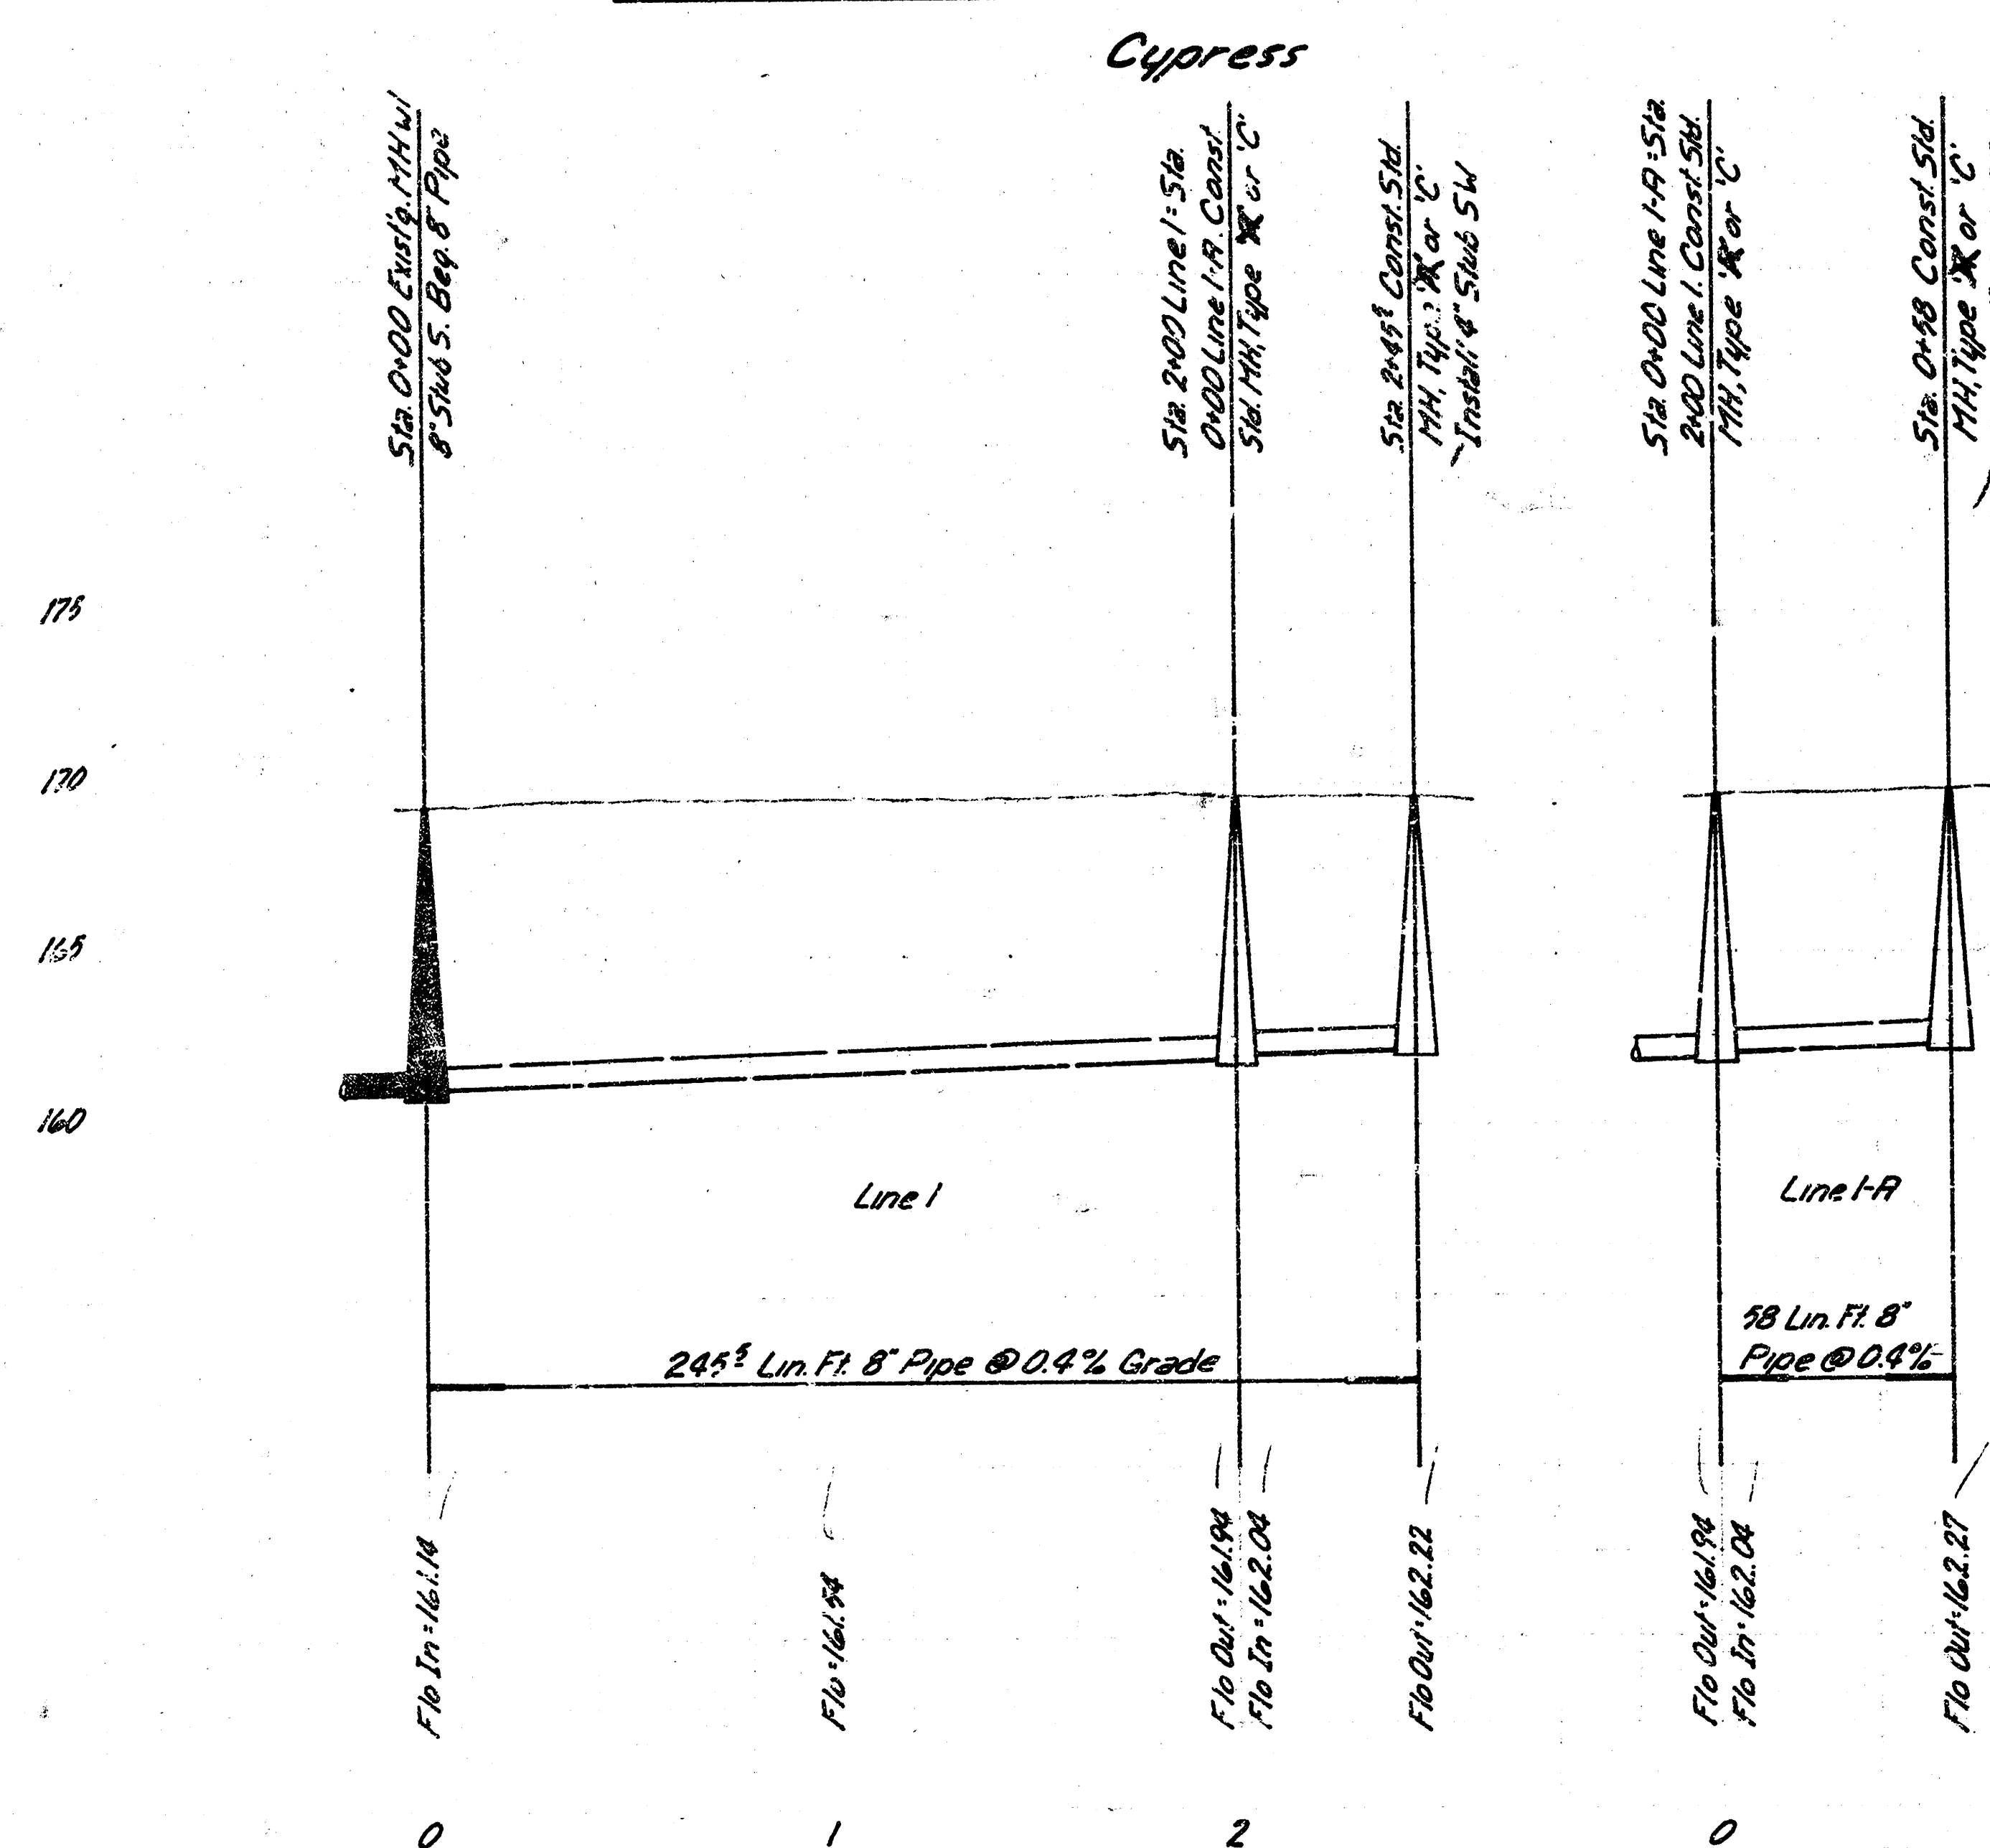

As Built 2d 9/15/00
BKJ-E286
Revised 3/14/00 QDS

Lateral 9, Main 19, War Industries Sewer
468-76-245-80871-000-000-501
Dept. of Public Works-Eng. Div.
City of Wichita, Kansas
Dean S. Sellers - Acting City Engineer

Date: _____

