


E. B. B. 1/8" = 1' 3/4" = 3/4"

D.R. 35

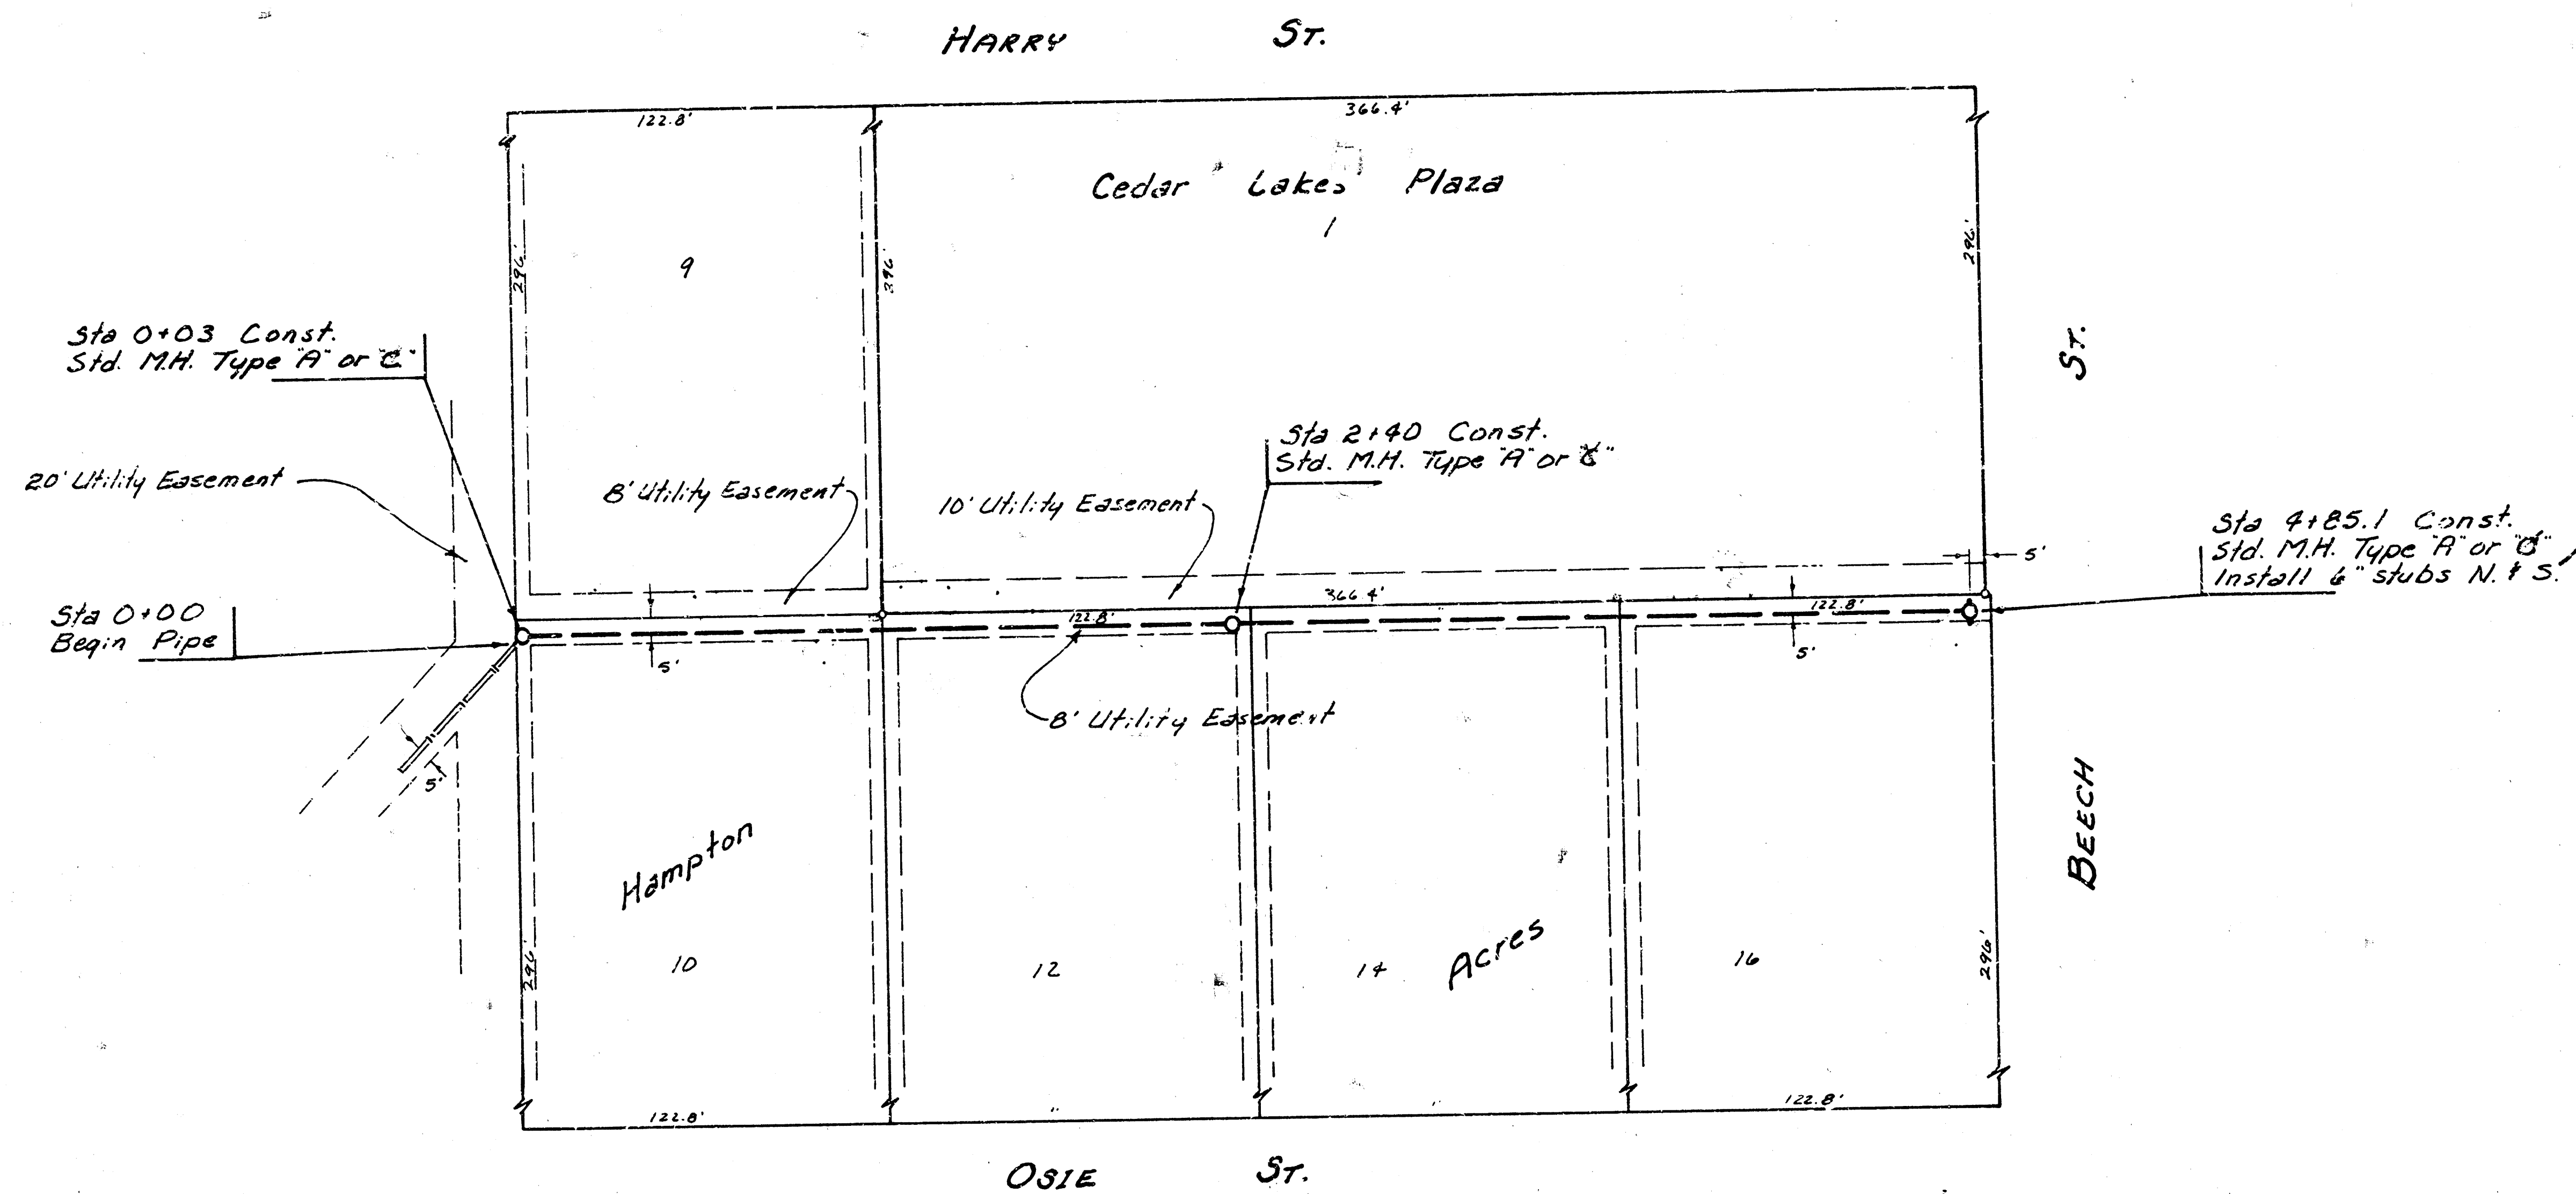

Scale Plan 1" = 40' Horiz.  
Profile 1" = 5' Vert.

B.M. 172.03 City Std. 48" S. & 46" W. of E's Webb Rd. & Harry.

B.M. 173.05 Bridge Spike, S Face of P.P.  $\approx$  295' S. of SL Harry St. &  $\approx$  7' E. of WL. of Beech.


175

170

165

160

155

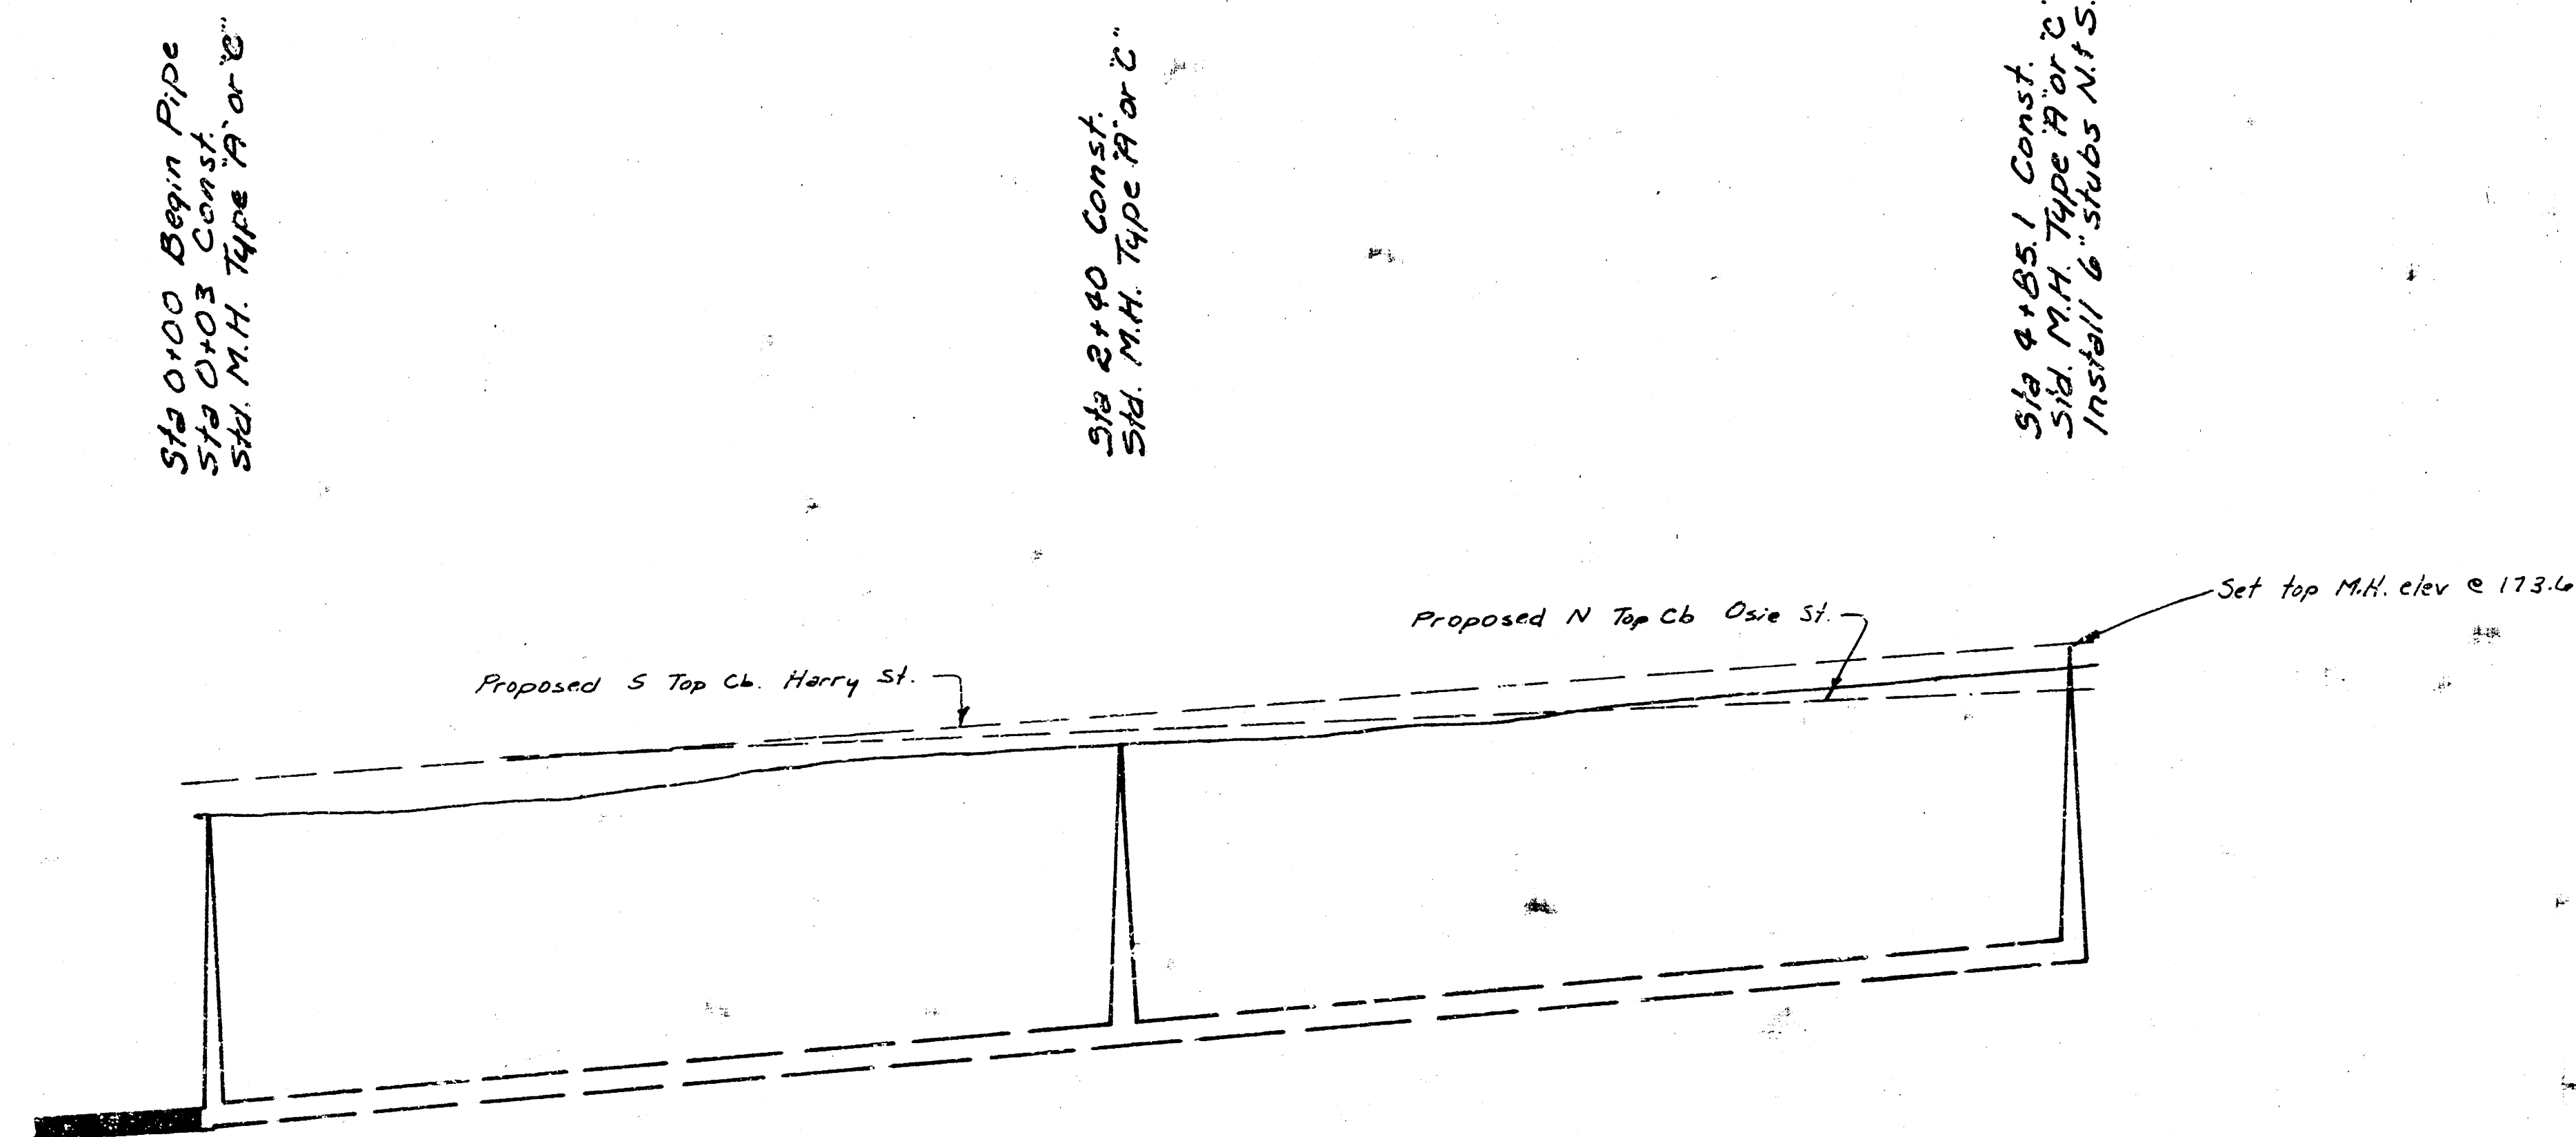

175

170

165

160

155

3 L.F. of 8" A.B.S. Composite Pipe @ 0.40% Grade

482.1 L.F. of 8" Clay Pipe @ 0.85% Grade

Alternate 8" A.B.S. Composite Pipe or 8" P.V.C. Pipe

0

1

2

3

4

5

As Built  
7-30-88  
E231

LAT 10, MAIN 19, WAR INDUSTRIES SEWER  
CITY OF WICHITA, KANSAS  
DEAN SELLERS — CITY ENGINEER  
PROJECT NO. 468-76-245-80900-000000-001