



B. M. 197.32 City Standard Disc 41.5' N. and 33' E. of E. of Gouverneur Rd and 13th St.
 B. M. 202.02 R.R. Spike W. side P.R. & W. side Gouverneur Rd approx. 30' N. of E. Lawrence Lane Court.

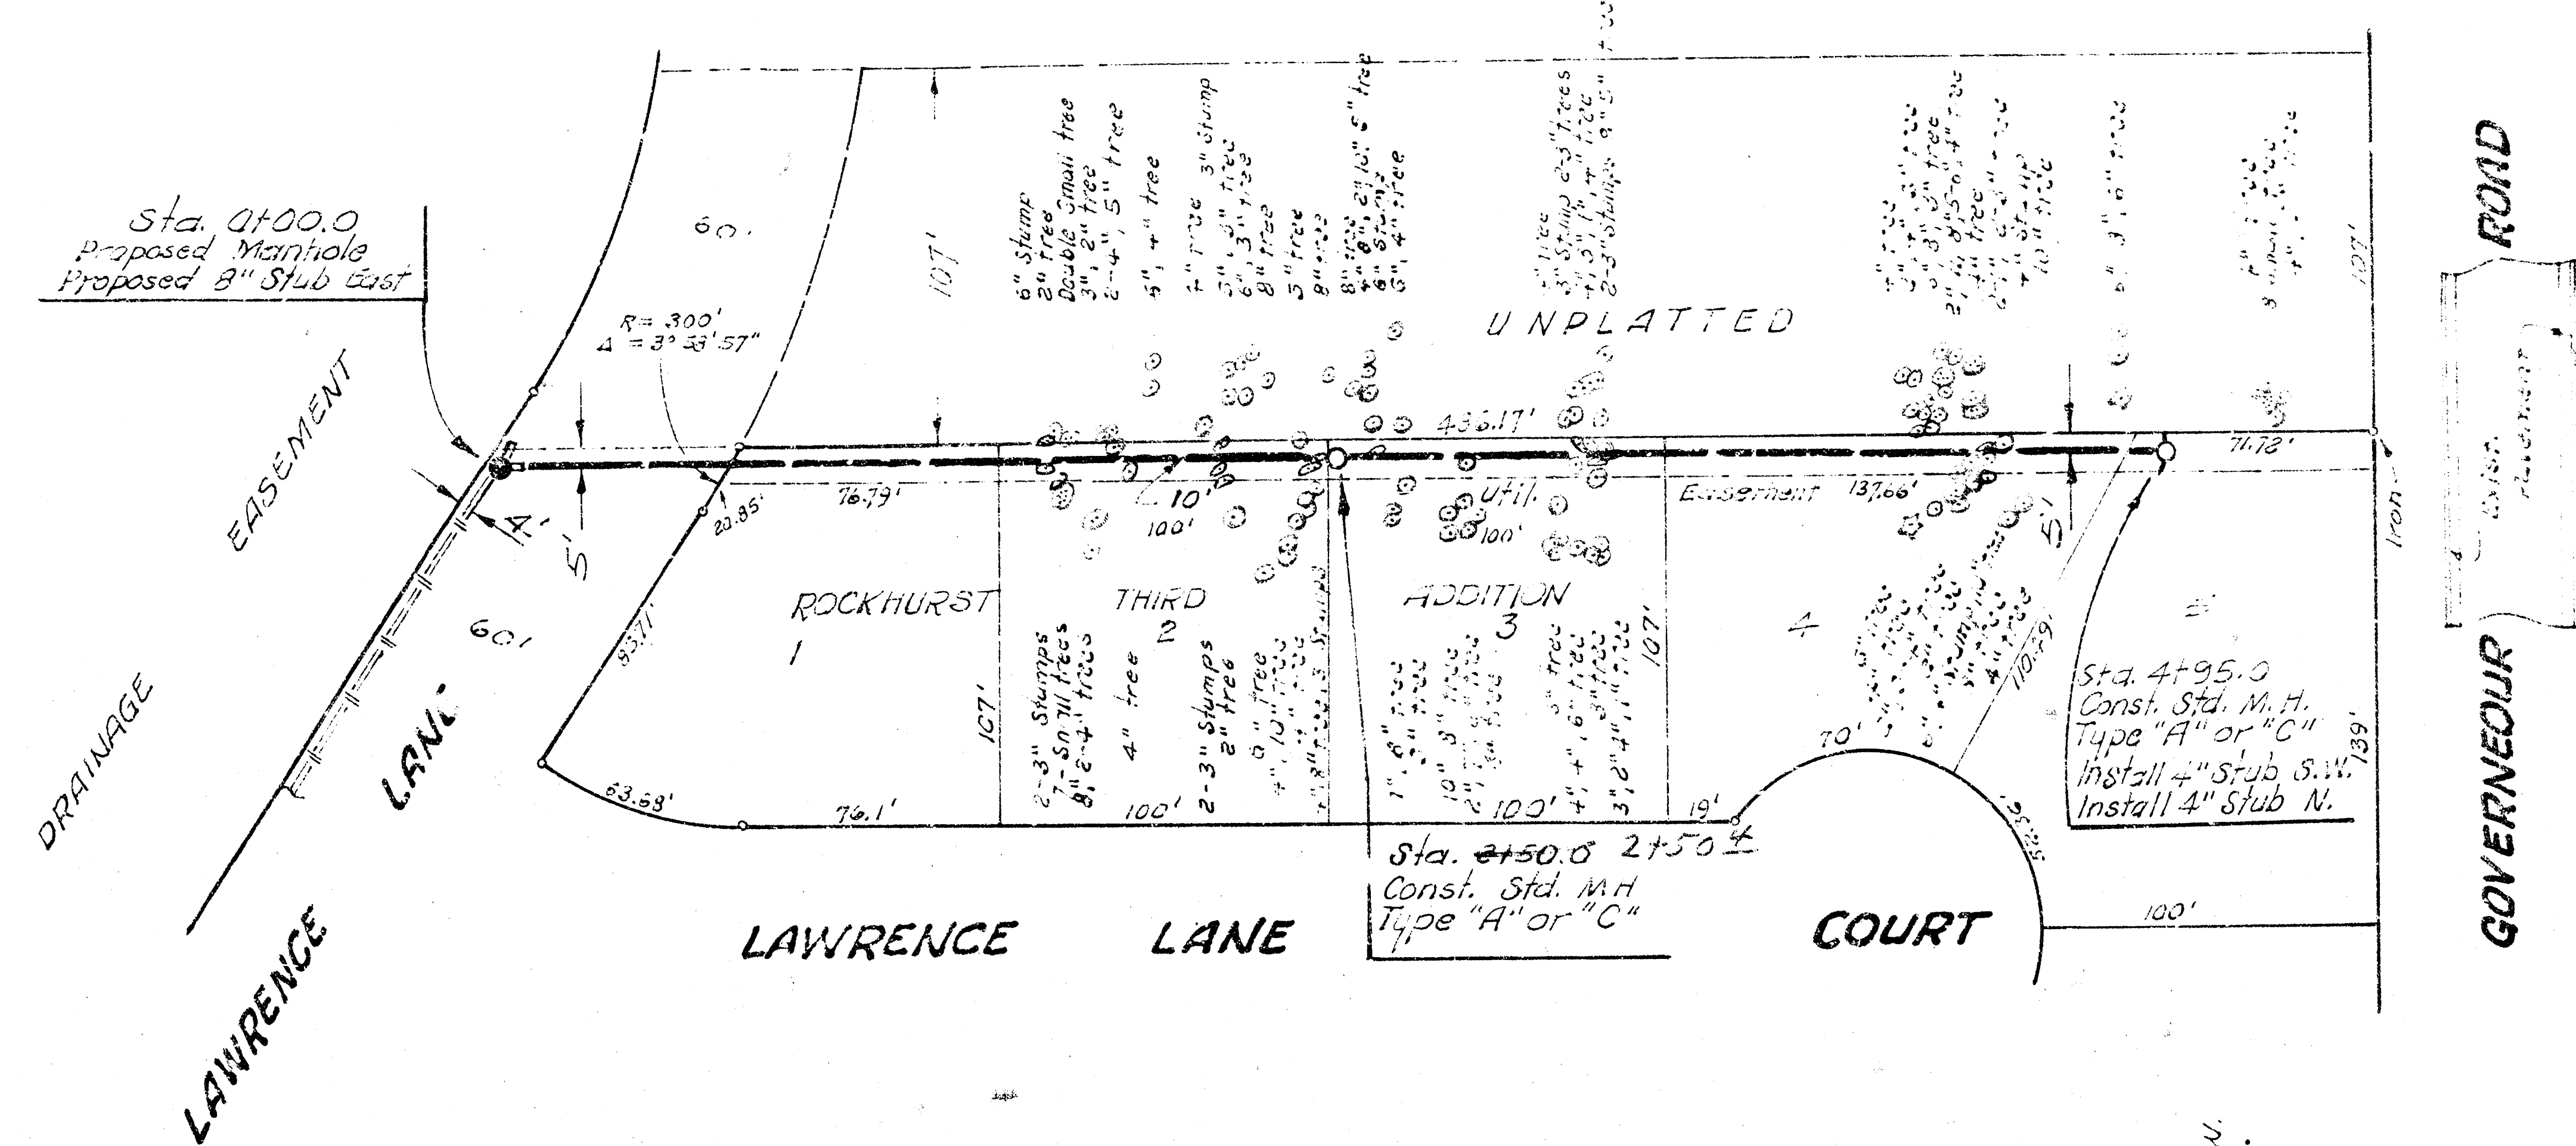

Plan Scale 1" = 40'
 Profile Scale 1" = 10'

205
 200
 195
 190
 185
 180
 175

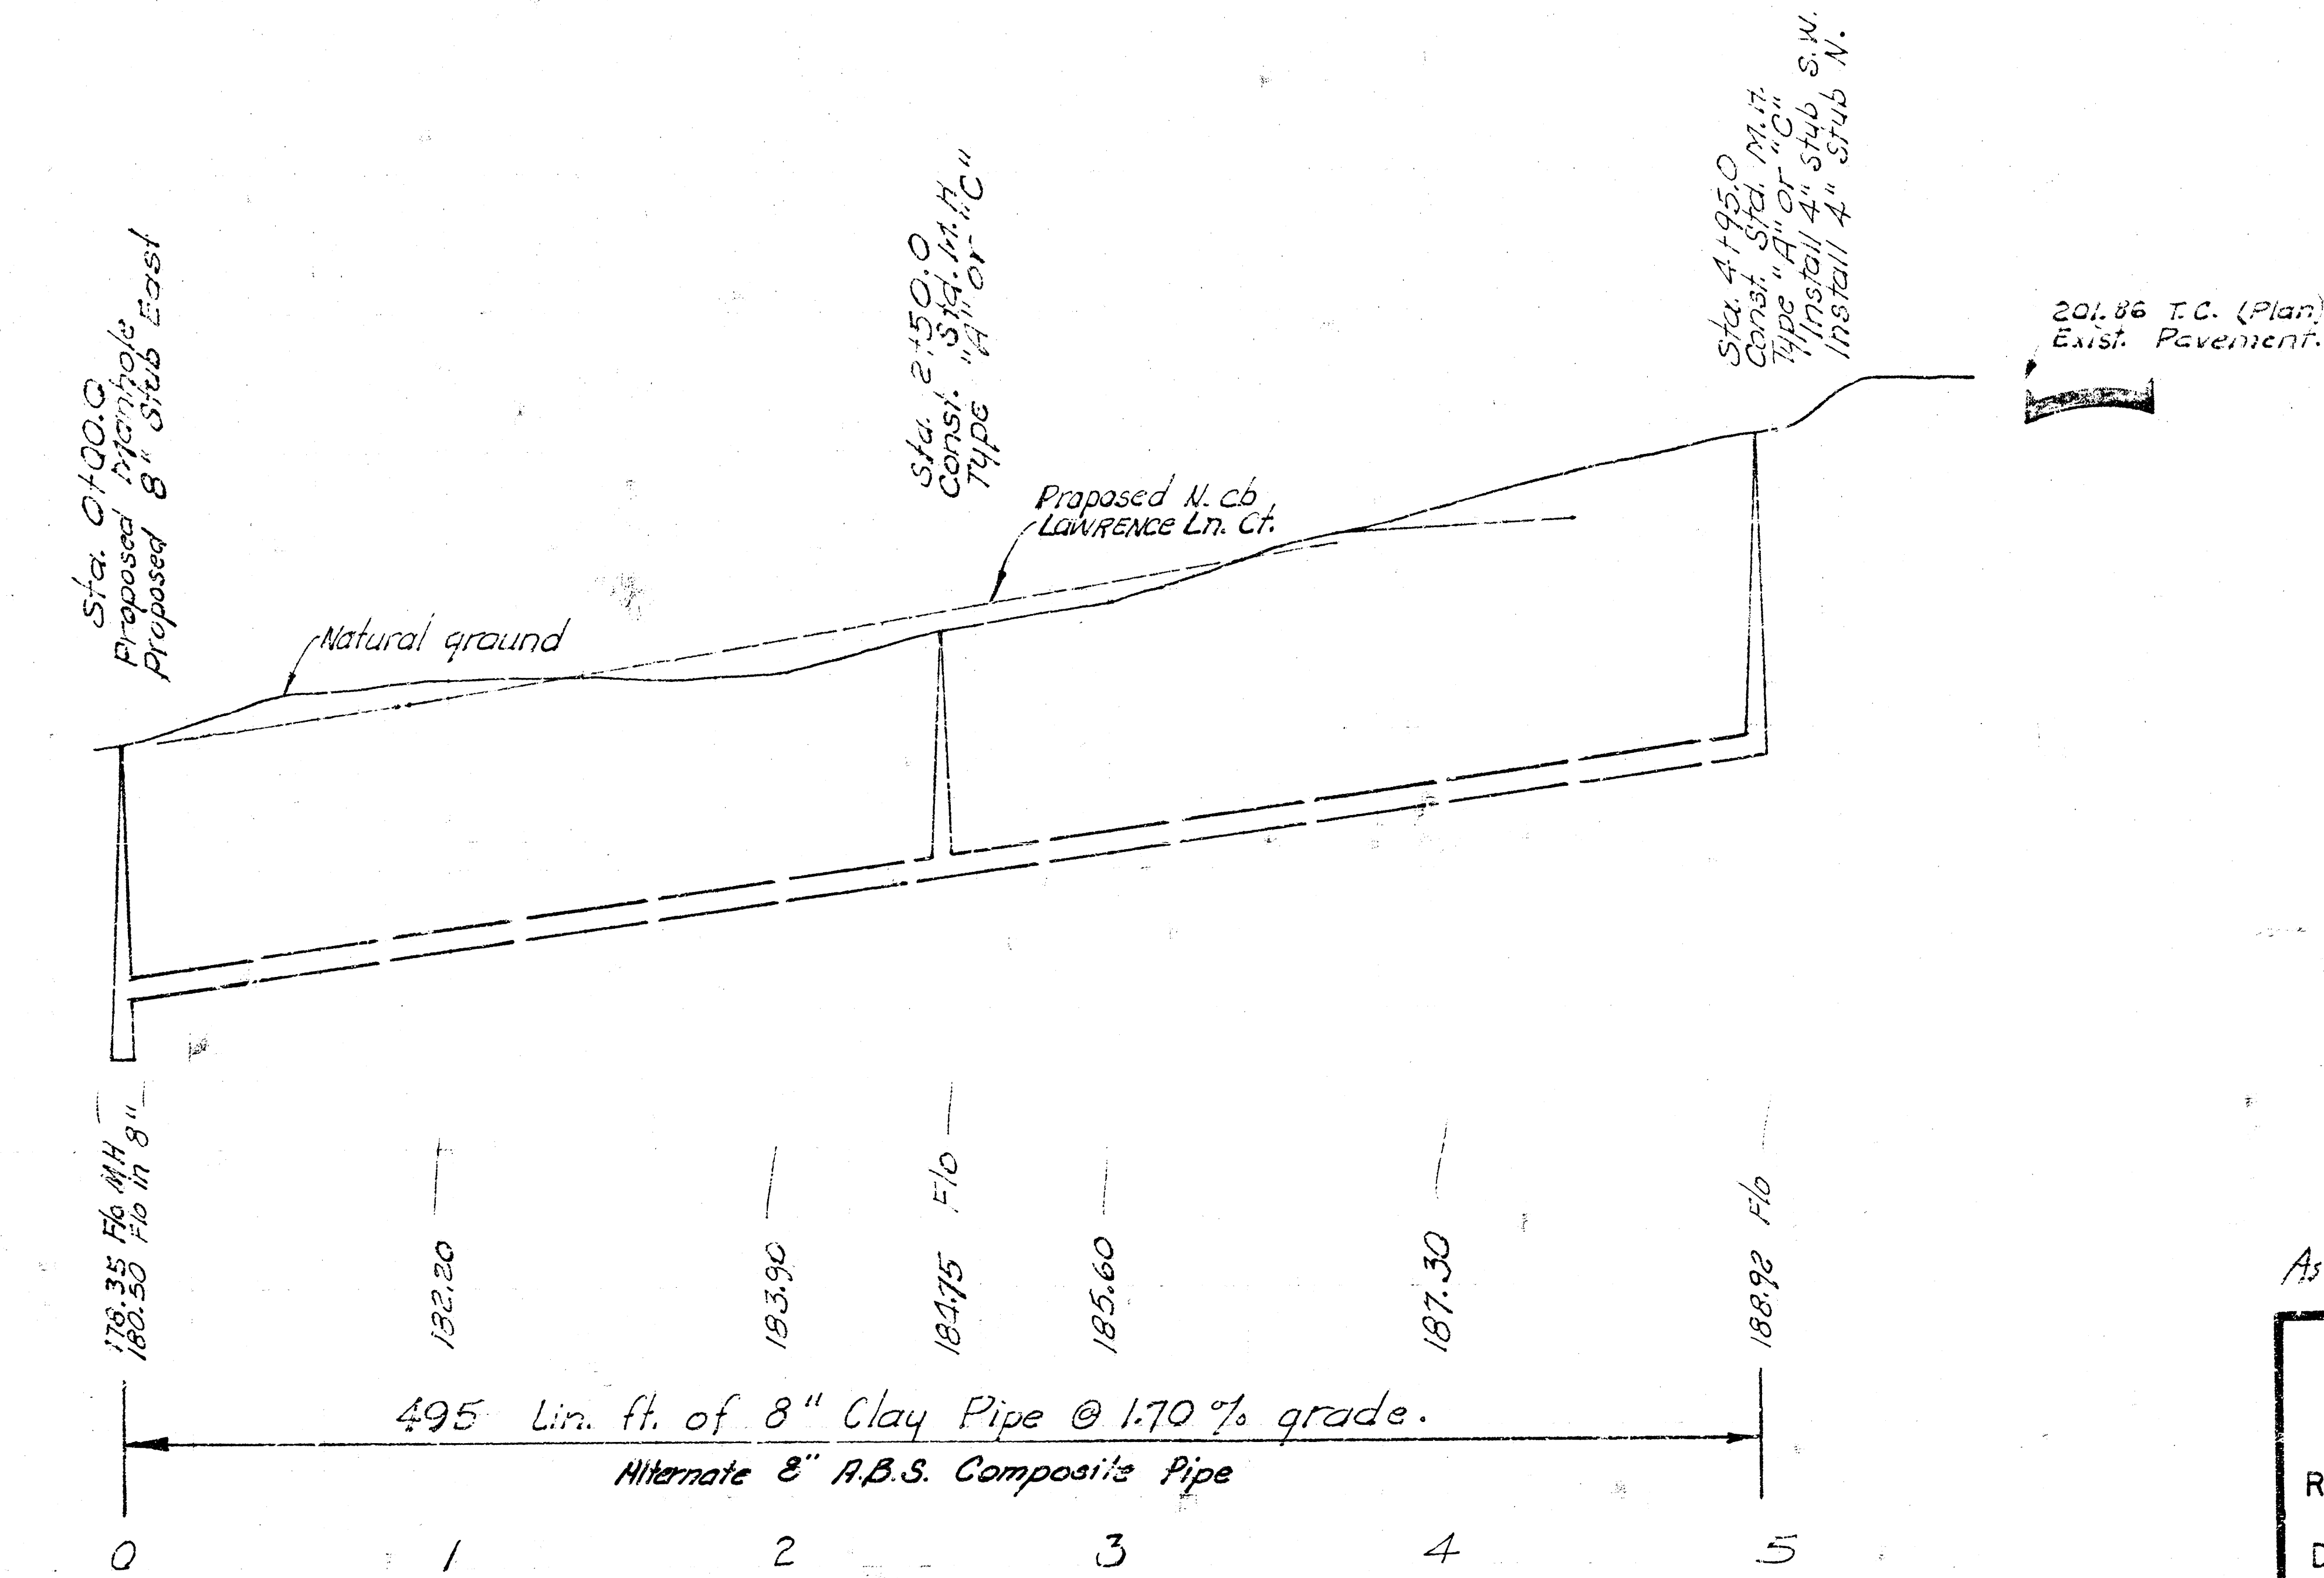

As built 2-24-77

LAT. I, MAIN 20 A, W. I. S.
 CITY OF WICHITA, KANSAS
 R. W. LINN CITY ENGINEER
 DATE: 10-76 PROJECT NO. DBKL 576046