

LATERAL 17, MAIN 20, W.I.S.

PROJECT NO.

468 - 76 - 245 - 81147 - 000 - 000 - 001

CITY OF WICHITA, KANSAS
R.W. BRUGGEMAN, CITY ENGINEER
AUGUST, 1981

INDEX TO DRAWINGS


SHEET NO.	DESCRIPTION
1	TITLE
2	LINES 1, 2, & 3
3	SITE PLAN

LEGEND

BENEFIT DISTRICT	---
EXISTING SEWER	---
EXISTING M.H.	---
PROPOSED SEWER	---
PROPOSED M.H.	---

B.M. "MUE" in Mueller on south
side of fire hydrant top
12' E of SE corner of
Chelsea Square.
Elev. = 215.75

THE CONTRACTOR SHALL BE RESPONSIBLE FOR PRE-
SERVING PROPERTY LINES. THE CONTRACTOR SHALL
BE REQUIRED TO RE-ESTABLISH ANY PROPERTY LINES
WHICH ARE CHANGED OR DESTROYED BY HIS CONSTRUCTION
OPERATIONS. SUCH LINES SHALL BE RE-ESTAB-
LISHED BY A LICENSED LAND SURVEYOR OR A LI-
CENSED PROFESSIONAL ENGINEER IN ACCORDANCE
WITH STATE LAWS.



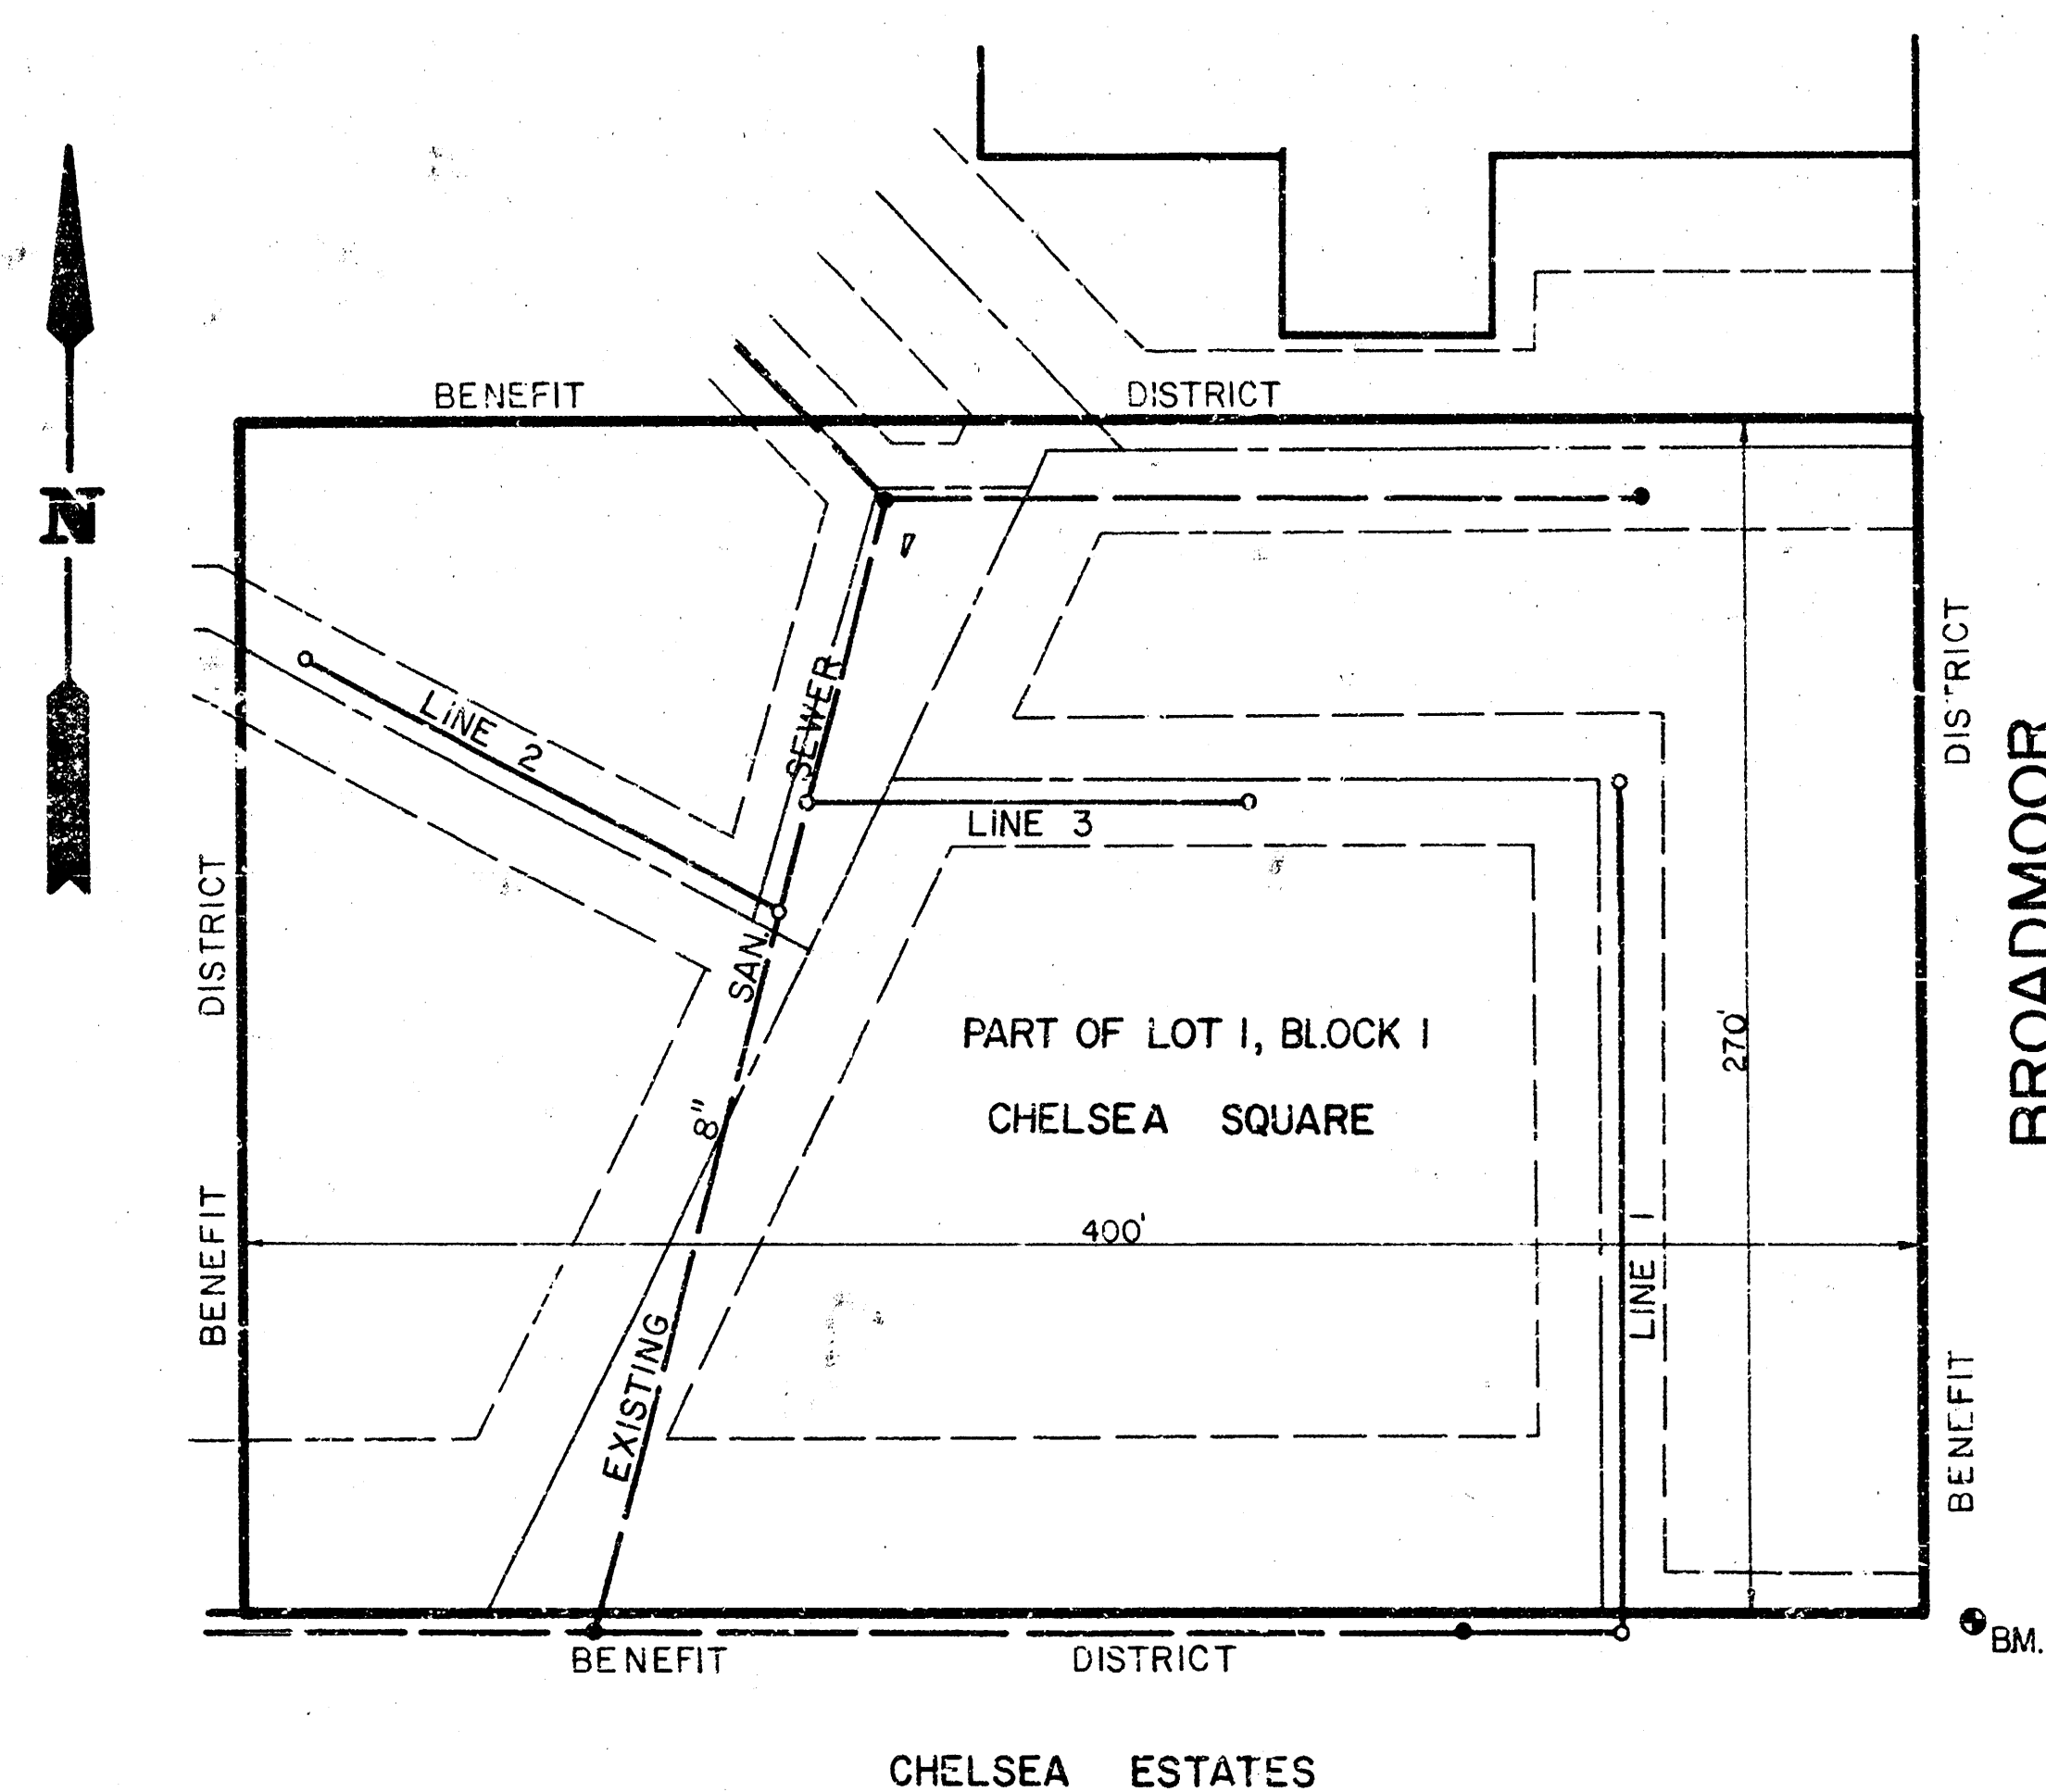


Van Doren - Hazard - Stallings

Architects • Engineers • Planners
Topeka Wichita Minneapolis

Sheet
1
3

NOTE: PAVEMENT SHOWN ON PLANS IS PROPOSED AND WILL BE CONSTRUCTED BY OTHERS.

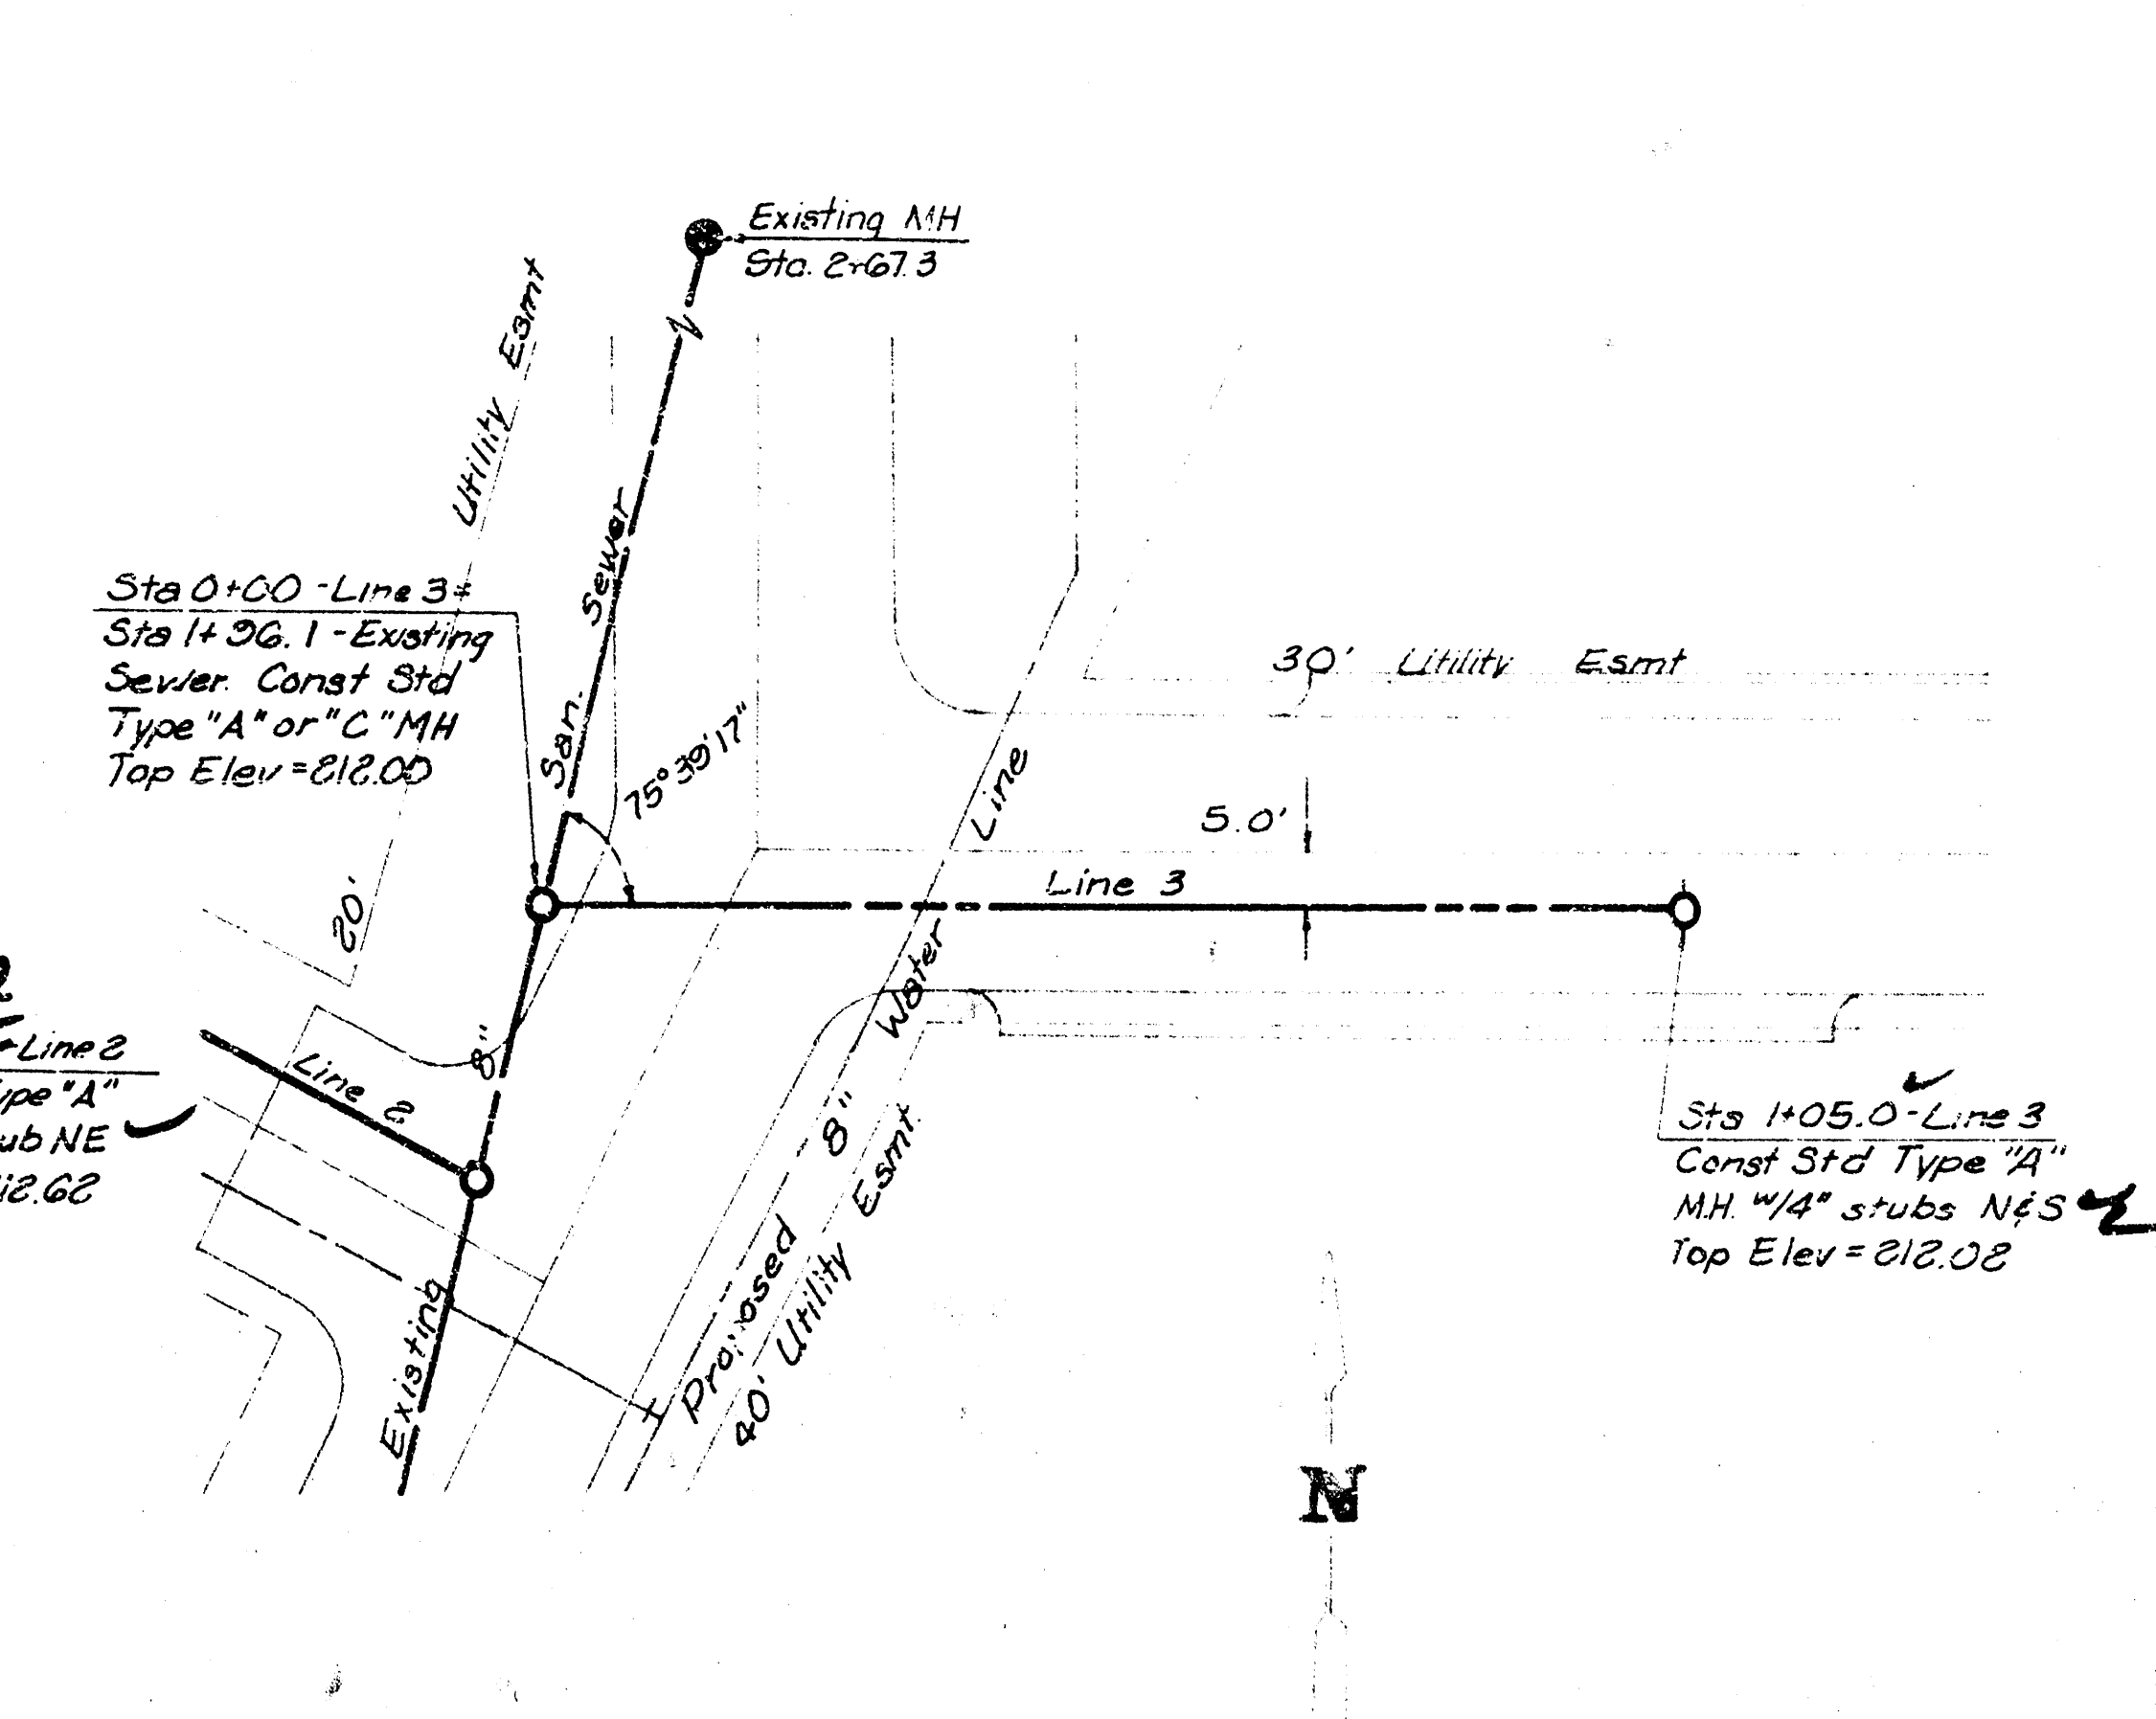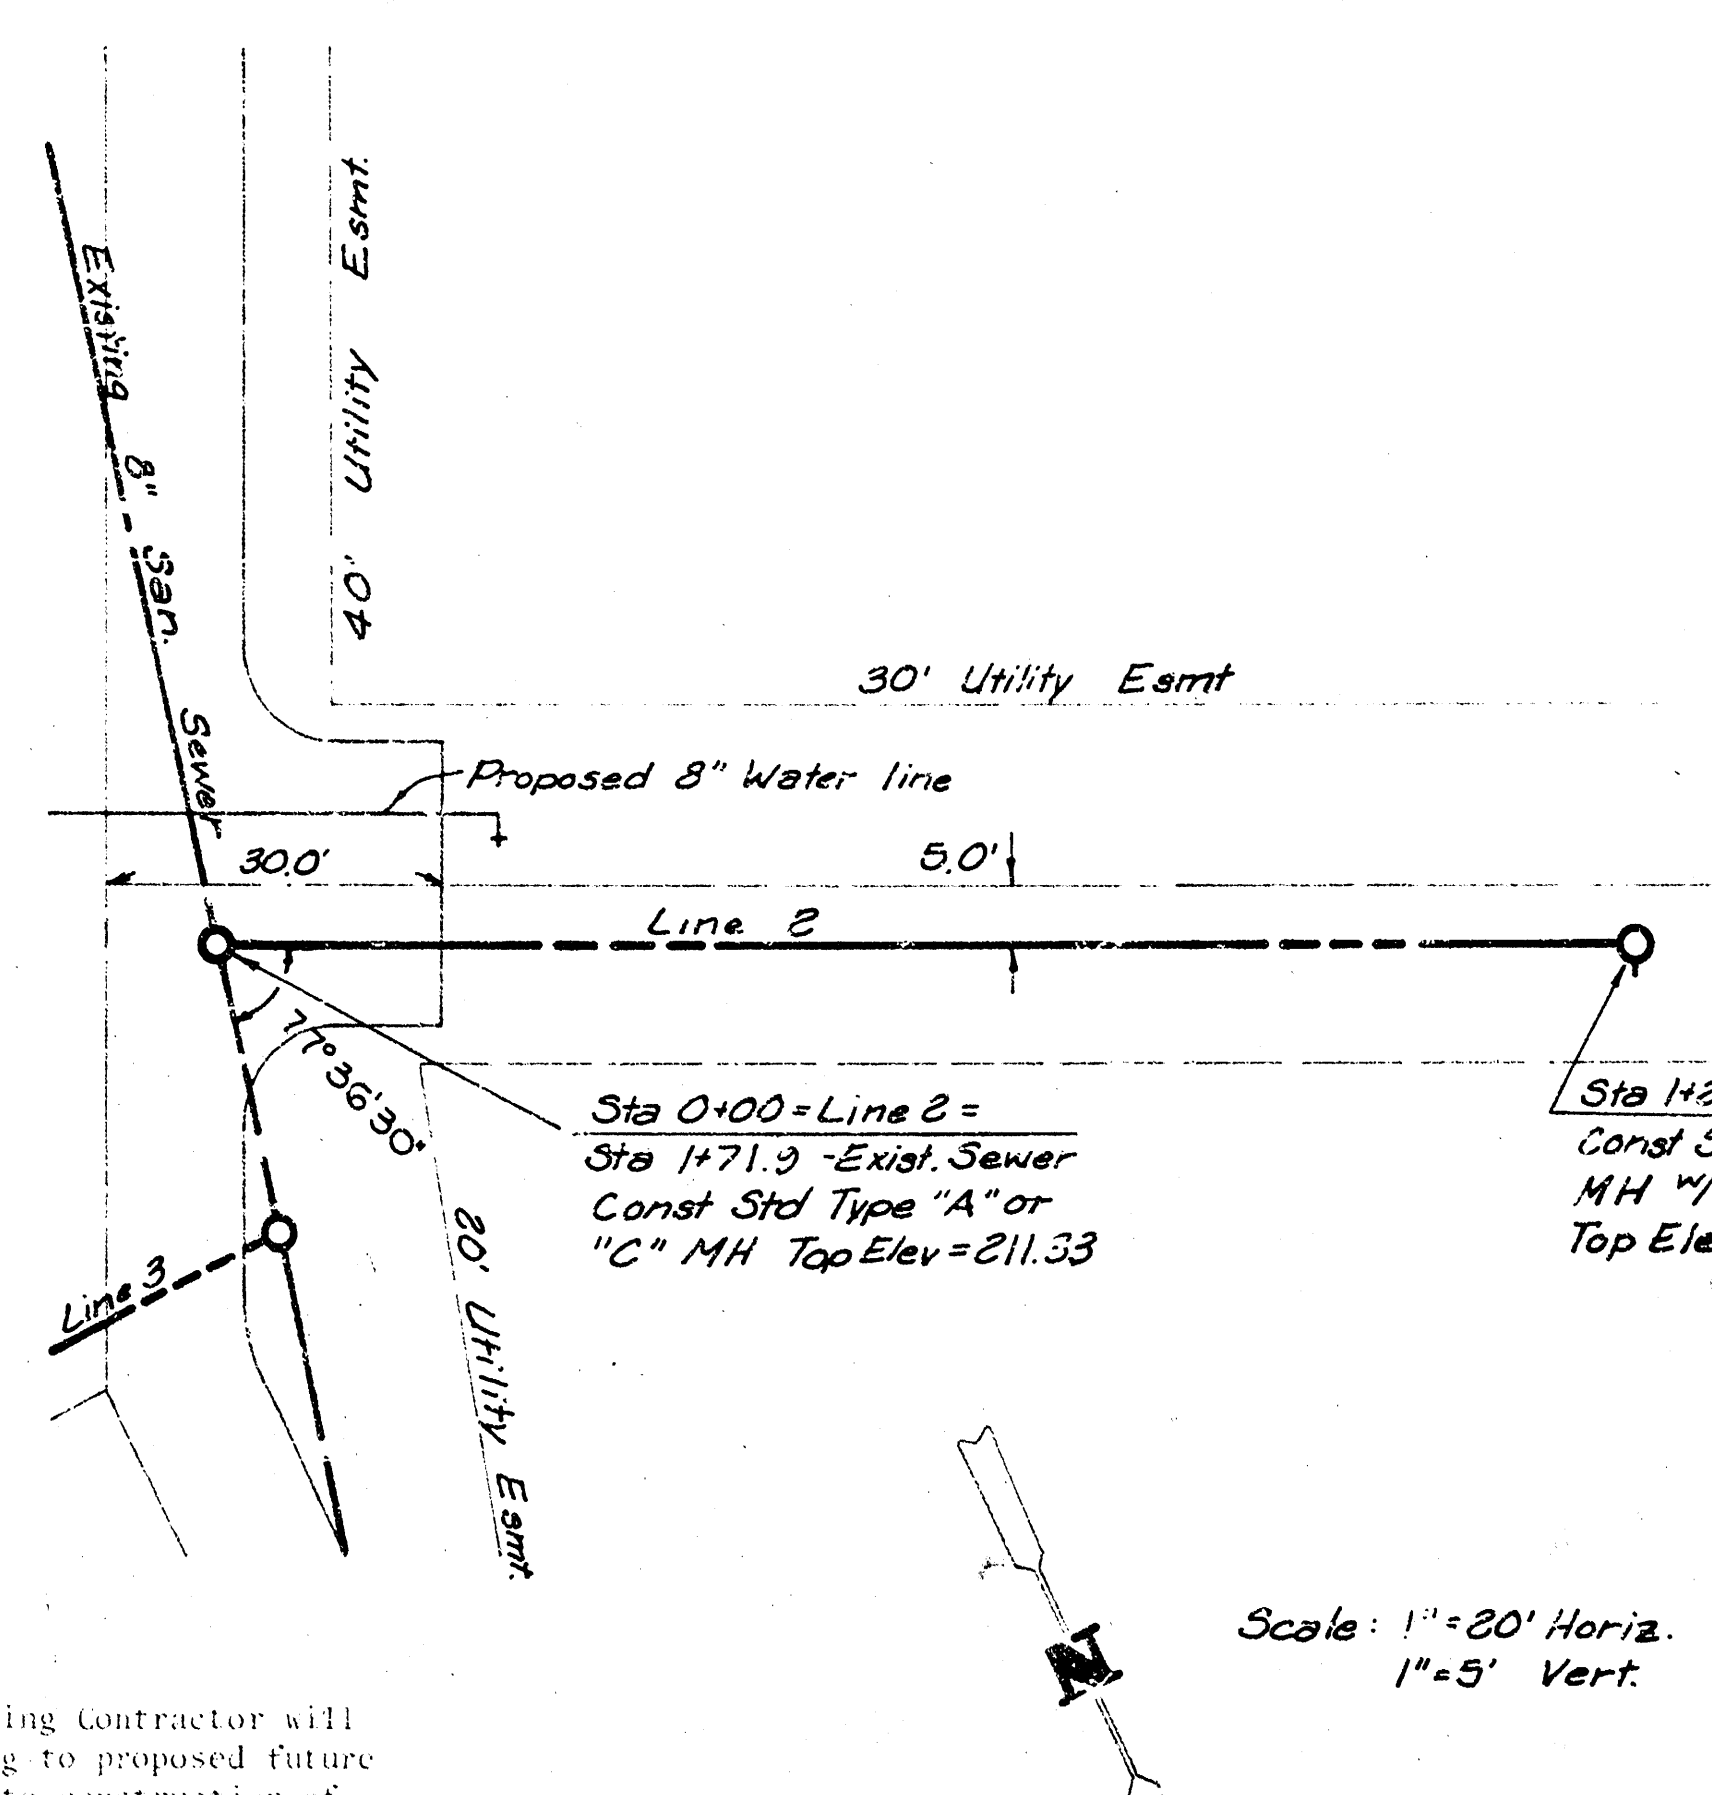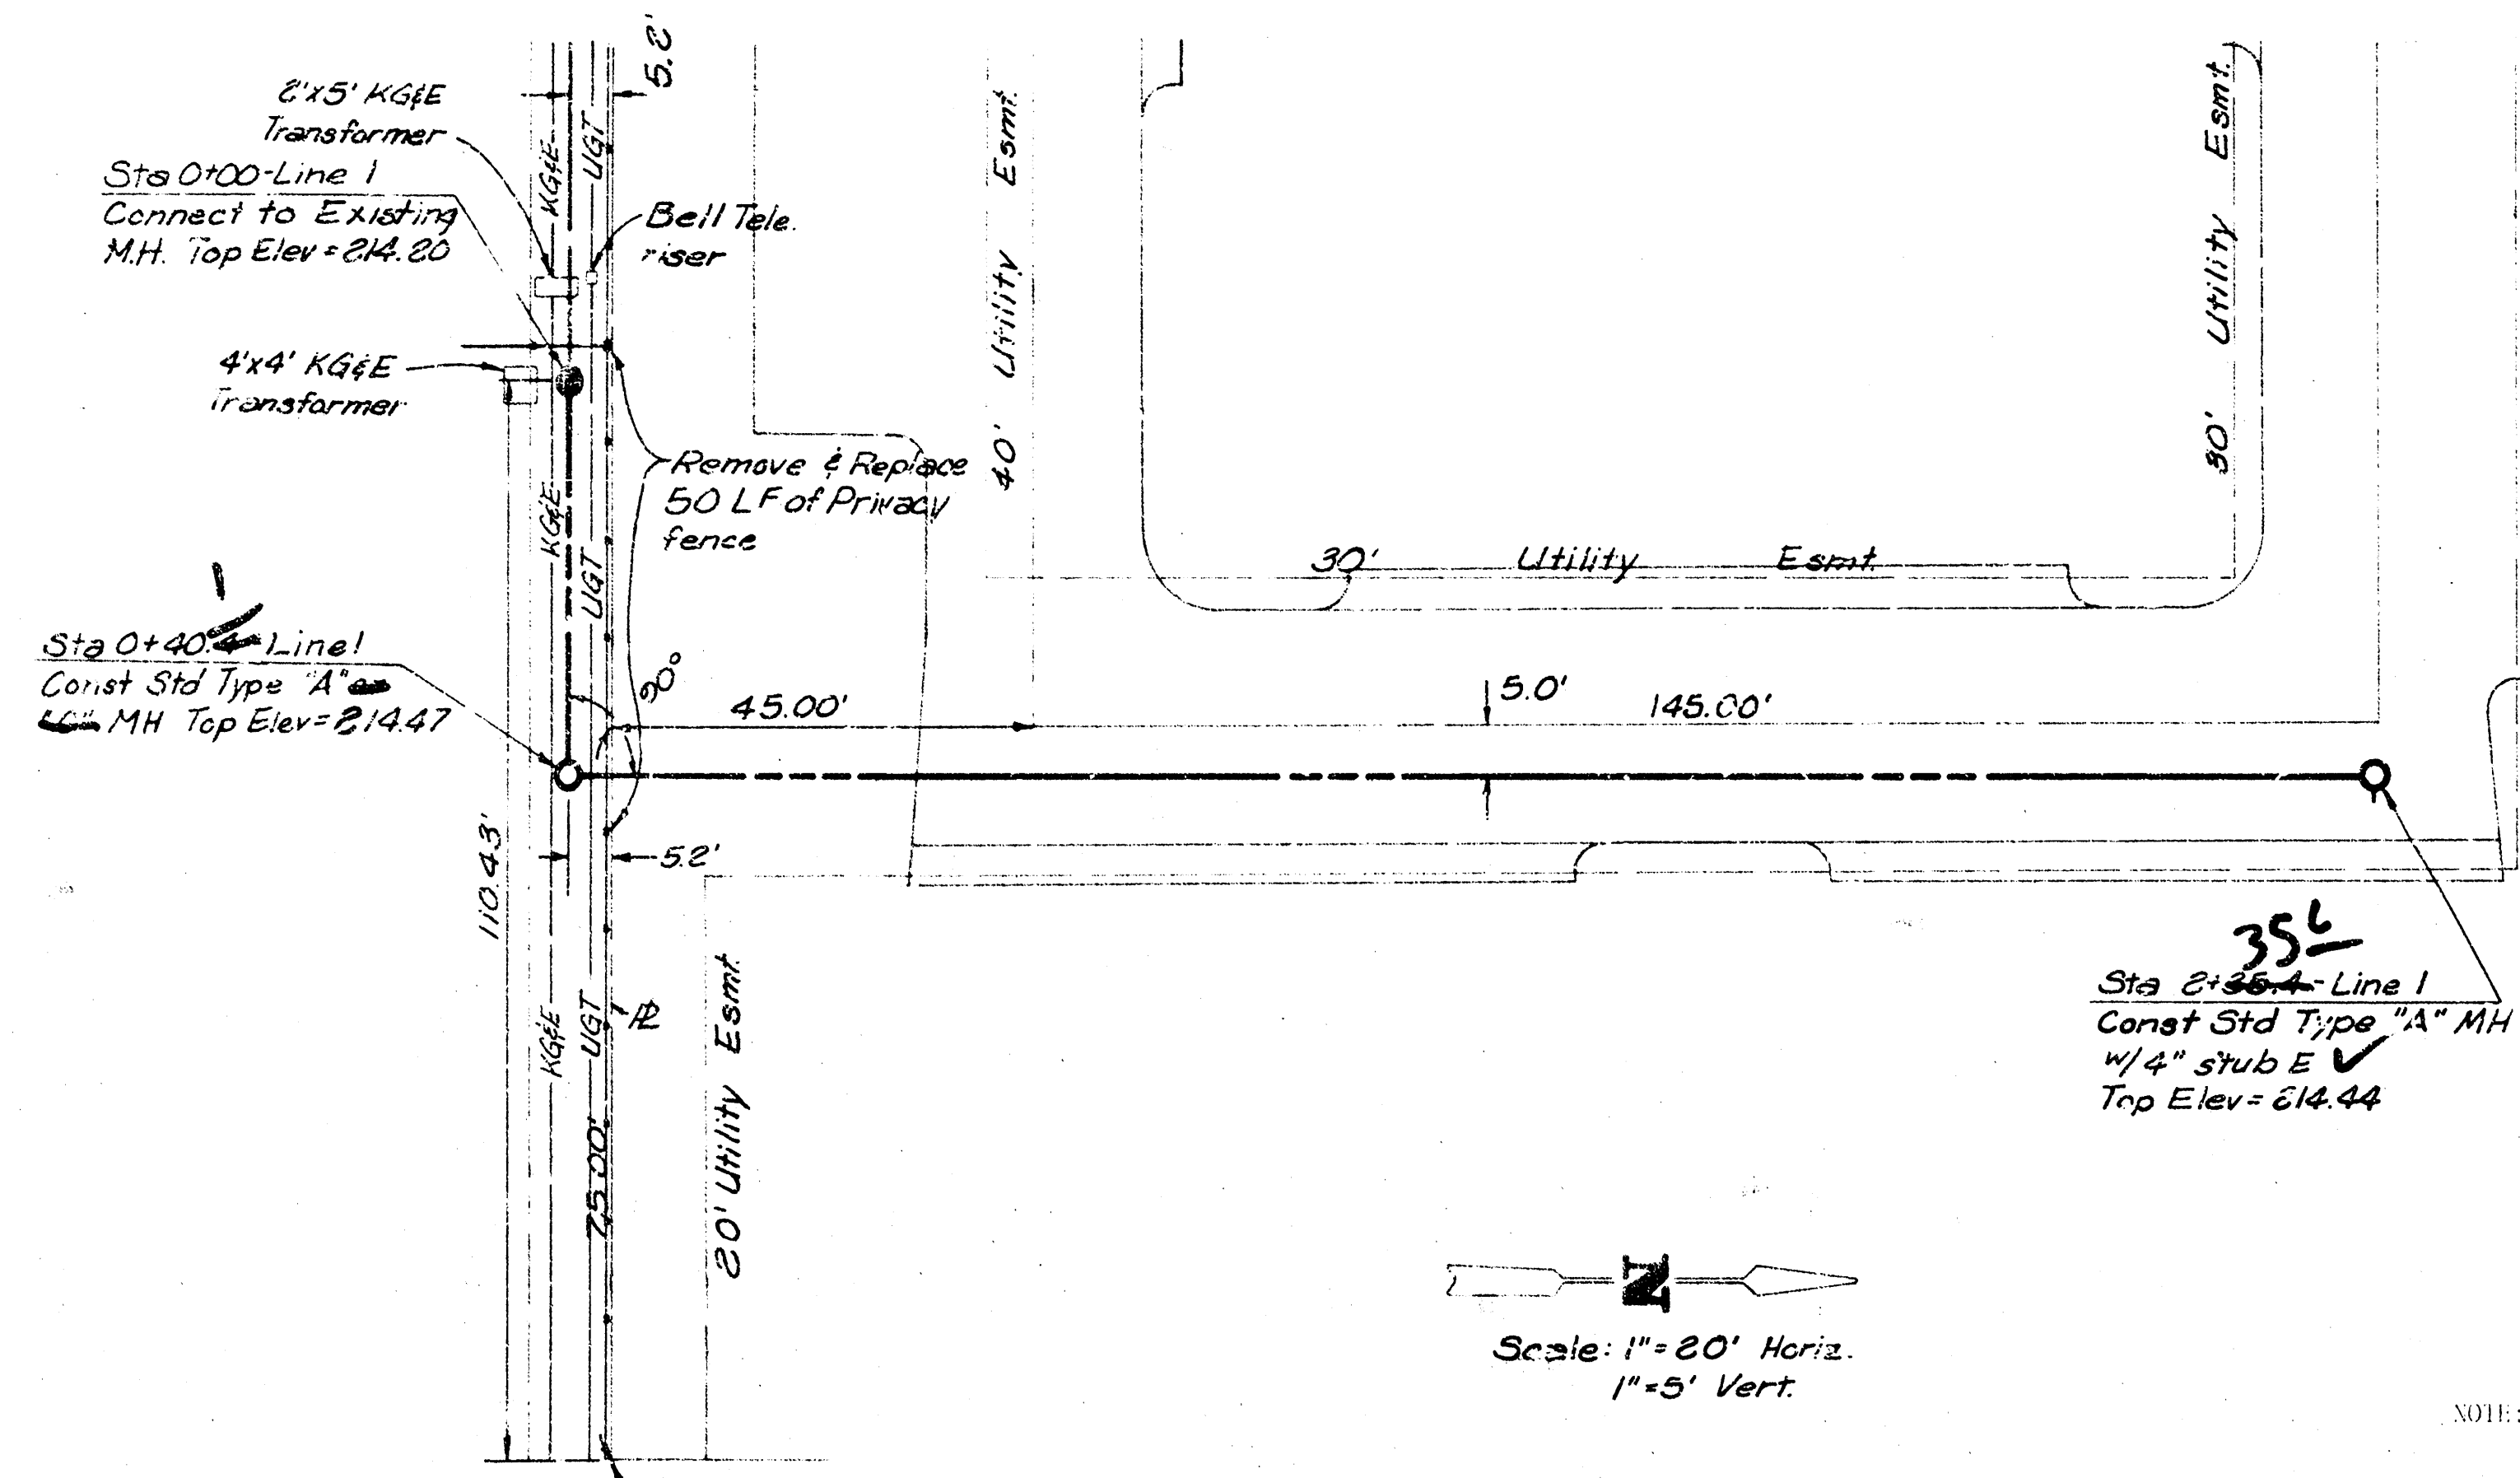




NOTE: Owners' Grading Contractor will be excavating to proposed future grade prior to construction of this lateral.
 Iron Bars set at center of all new manholes.

Line 1


Line 2

Line 3

NOTE: Contractor shall contact K.G.E. and Bell Telephone for location of buried lines before construction.

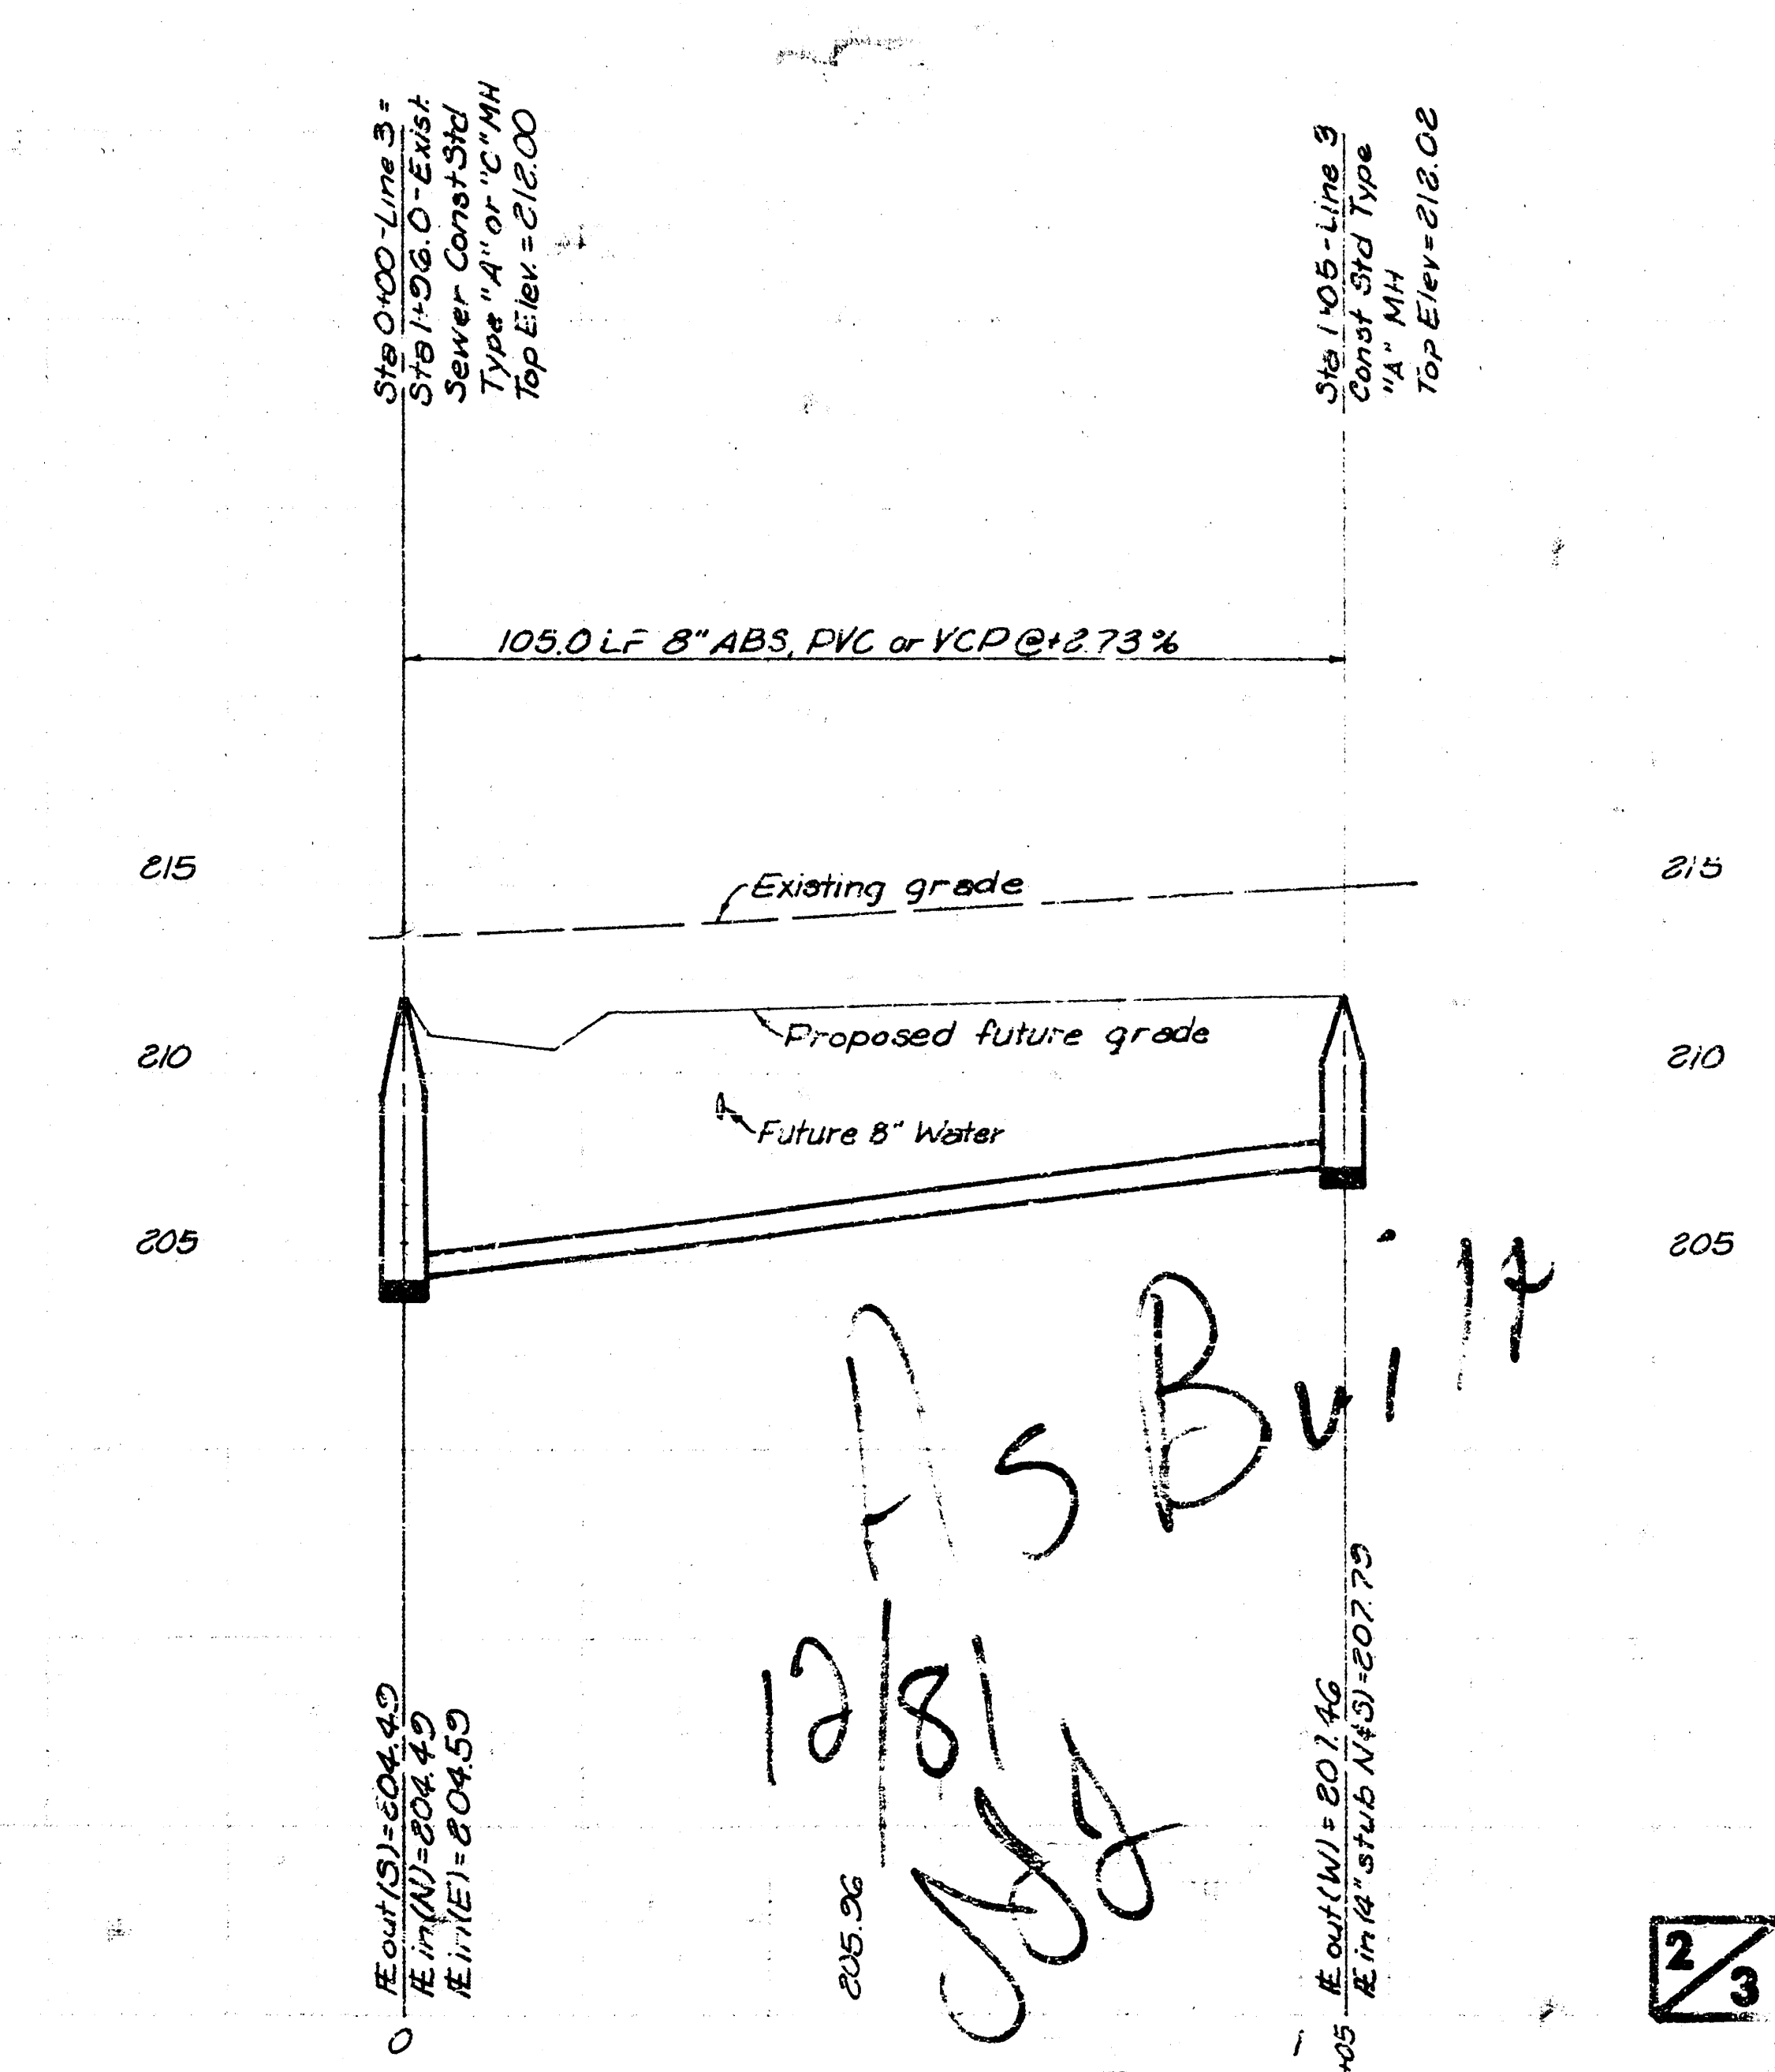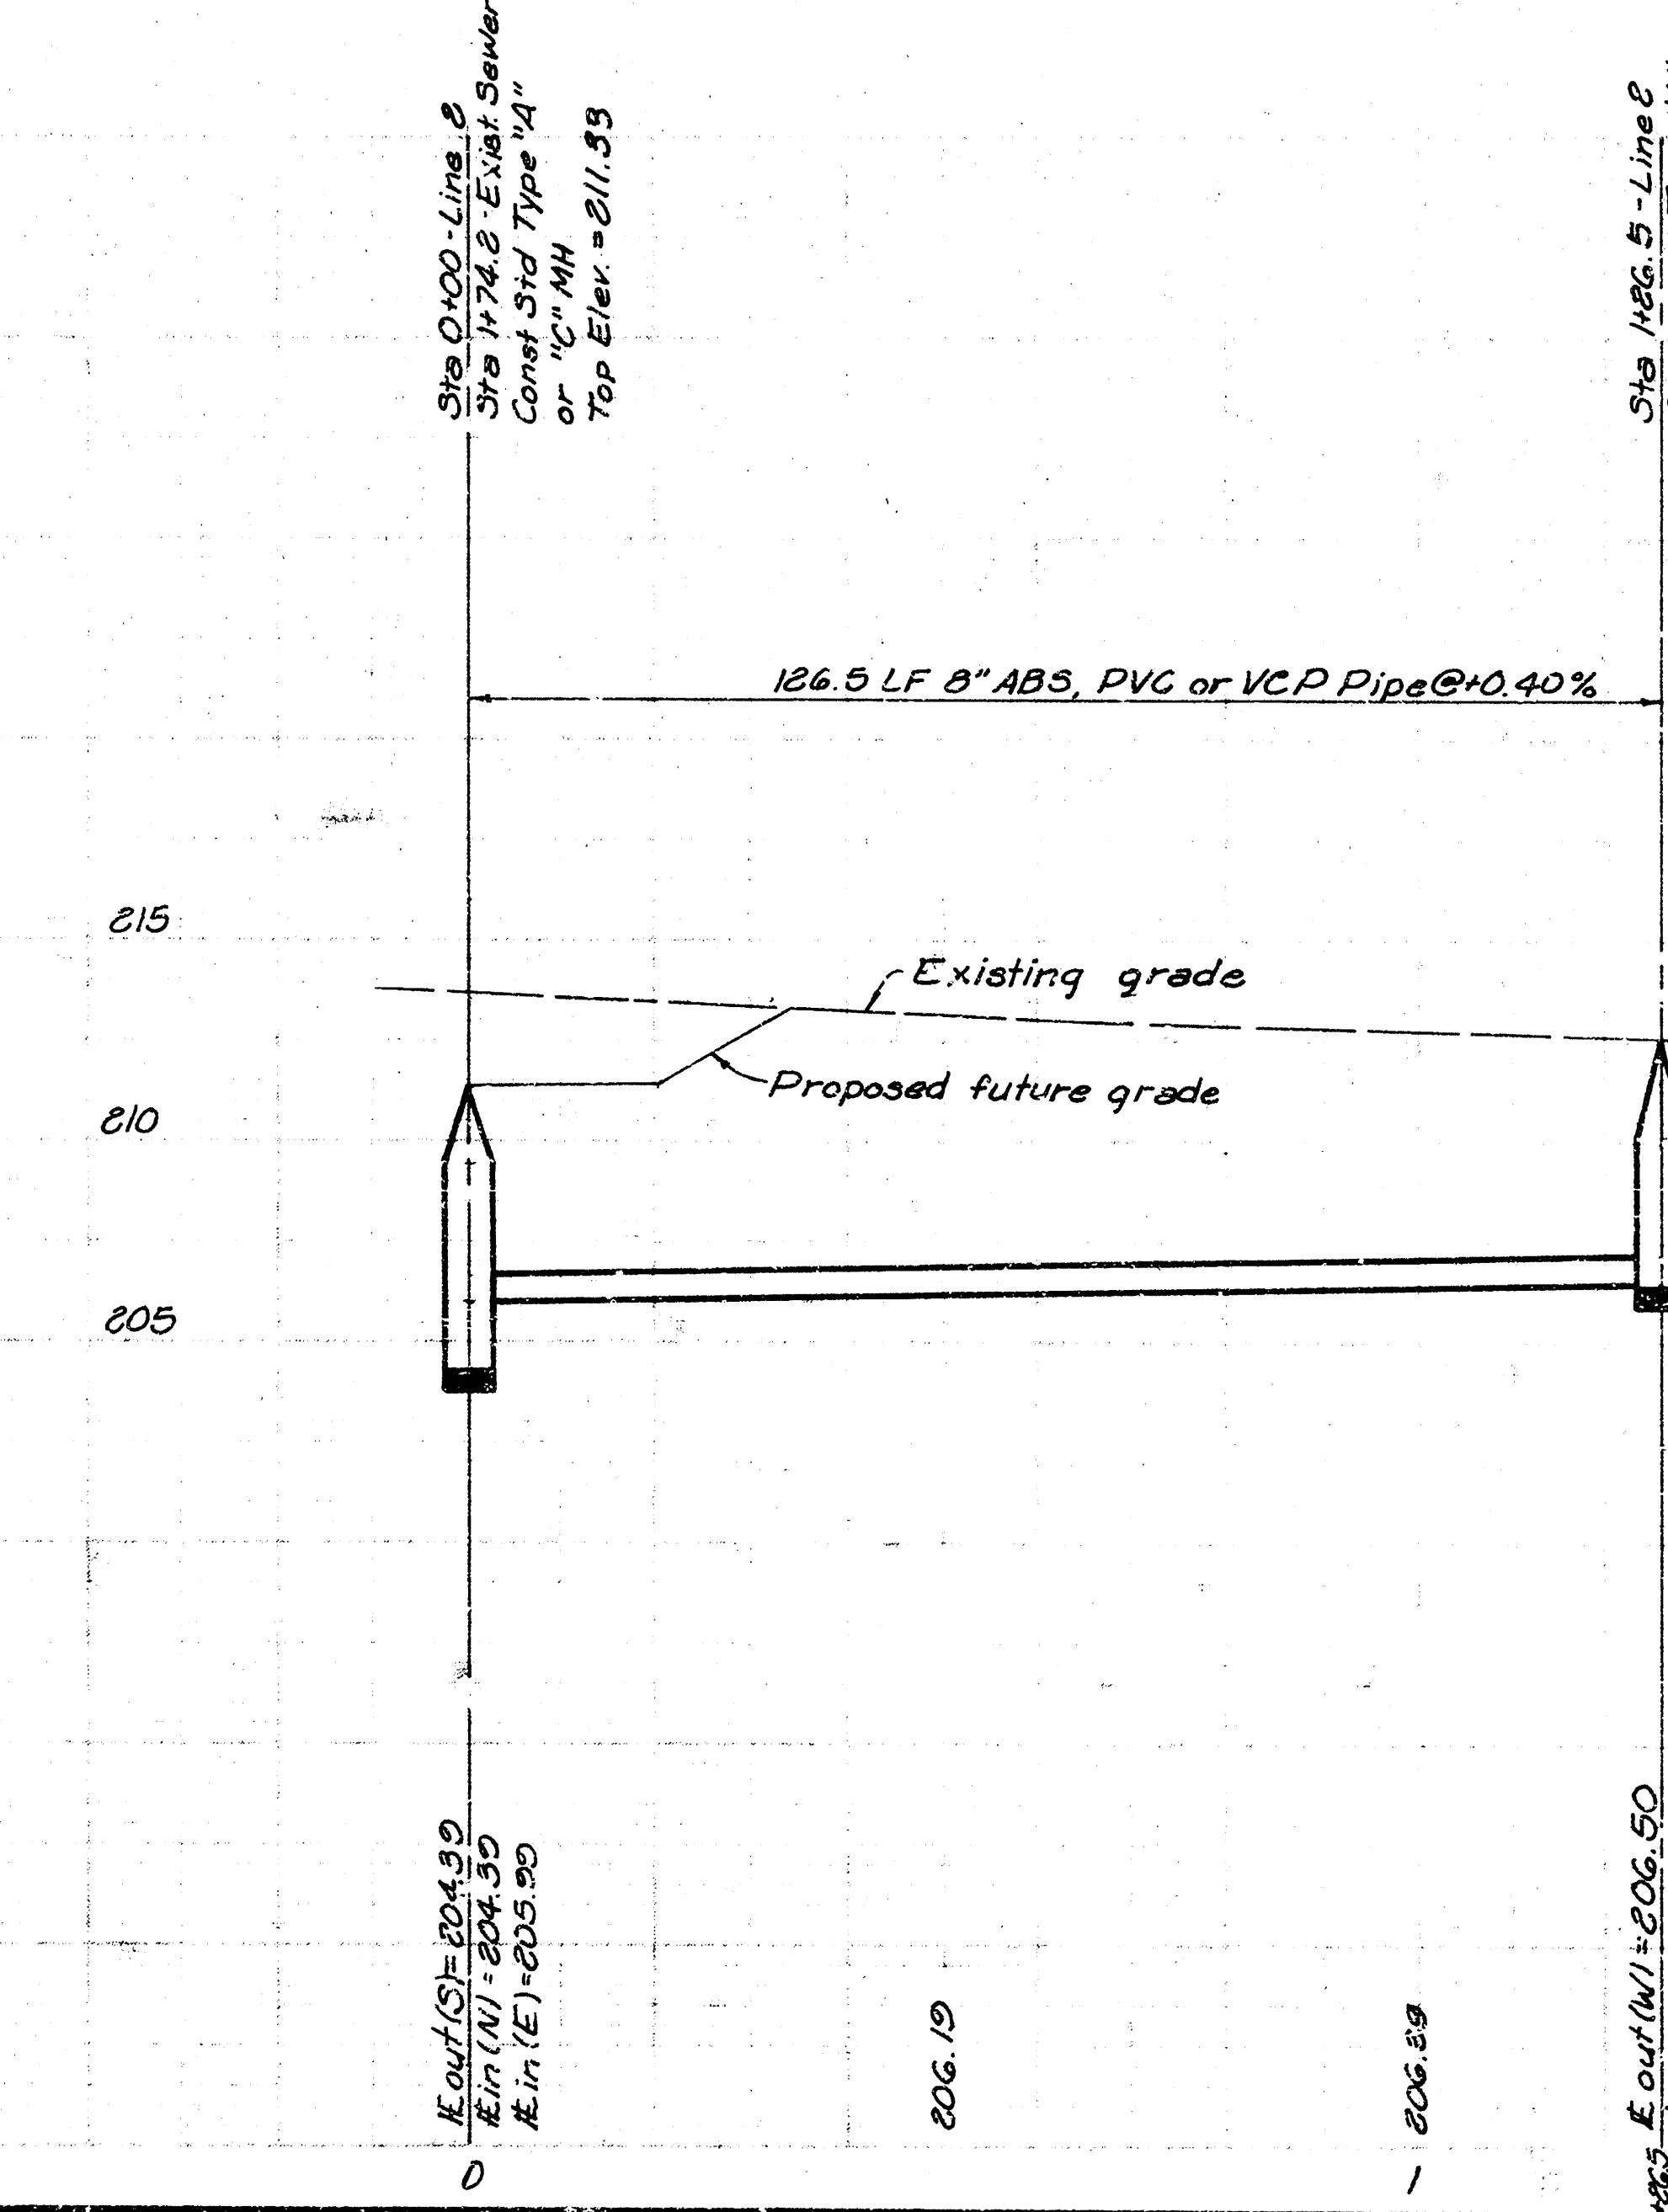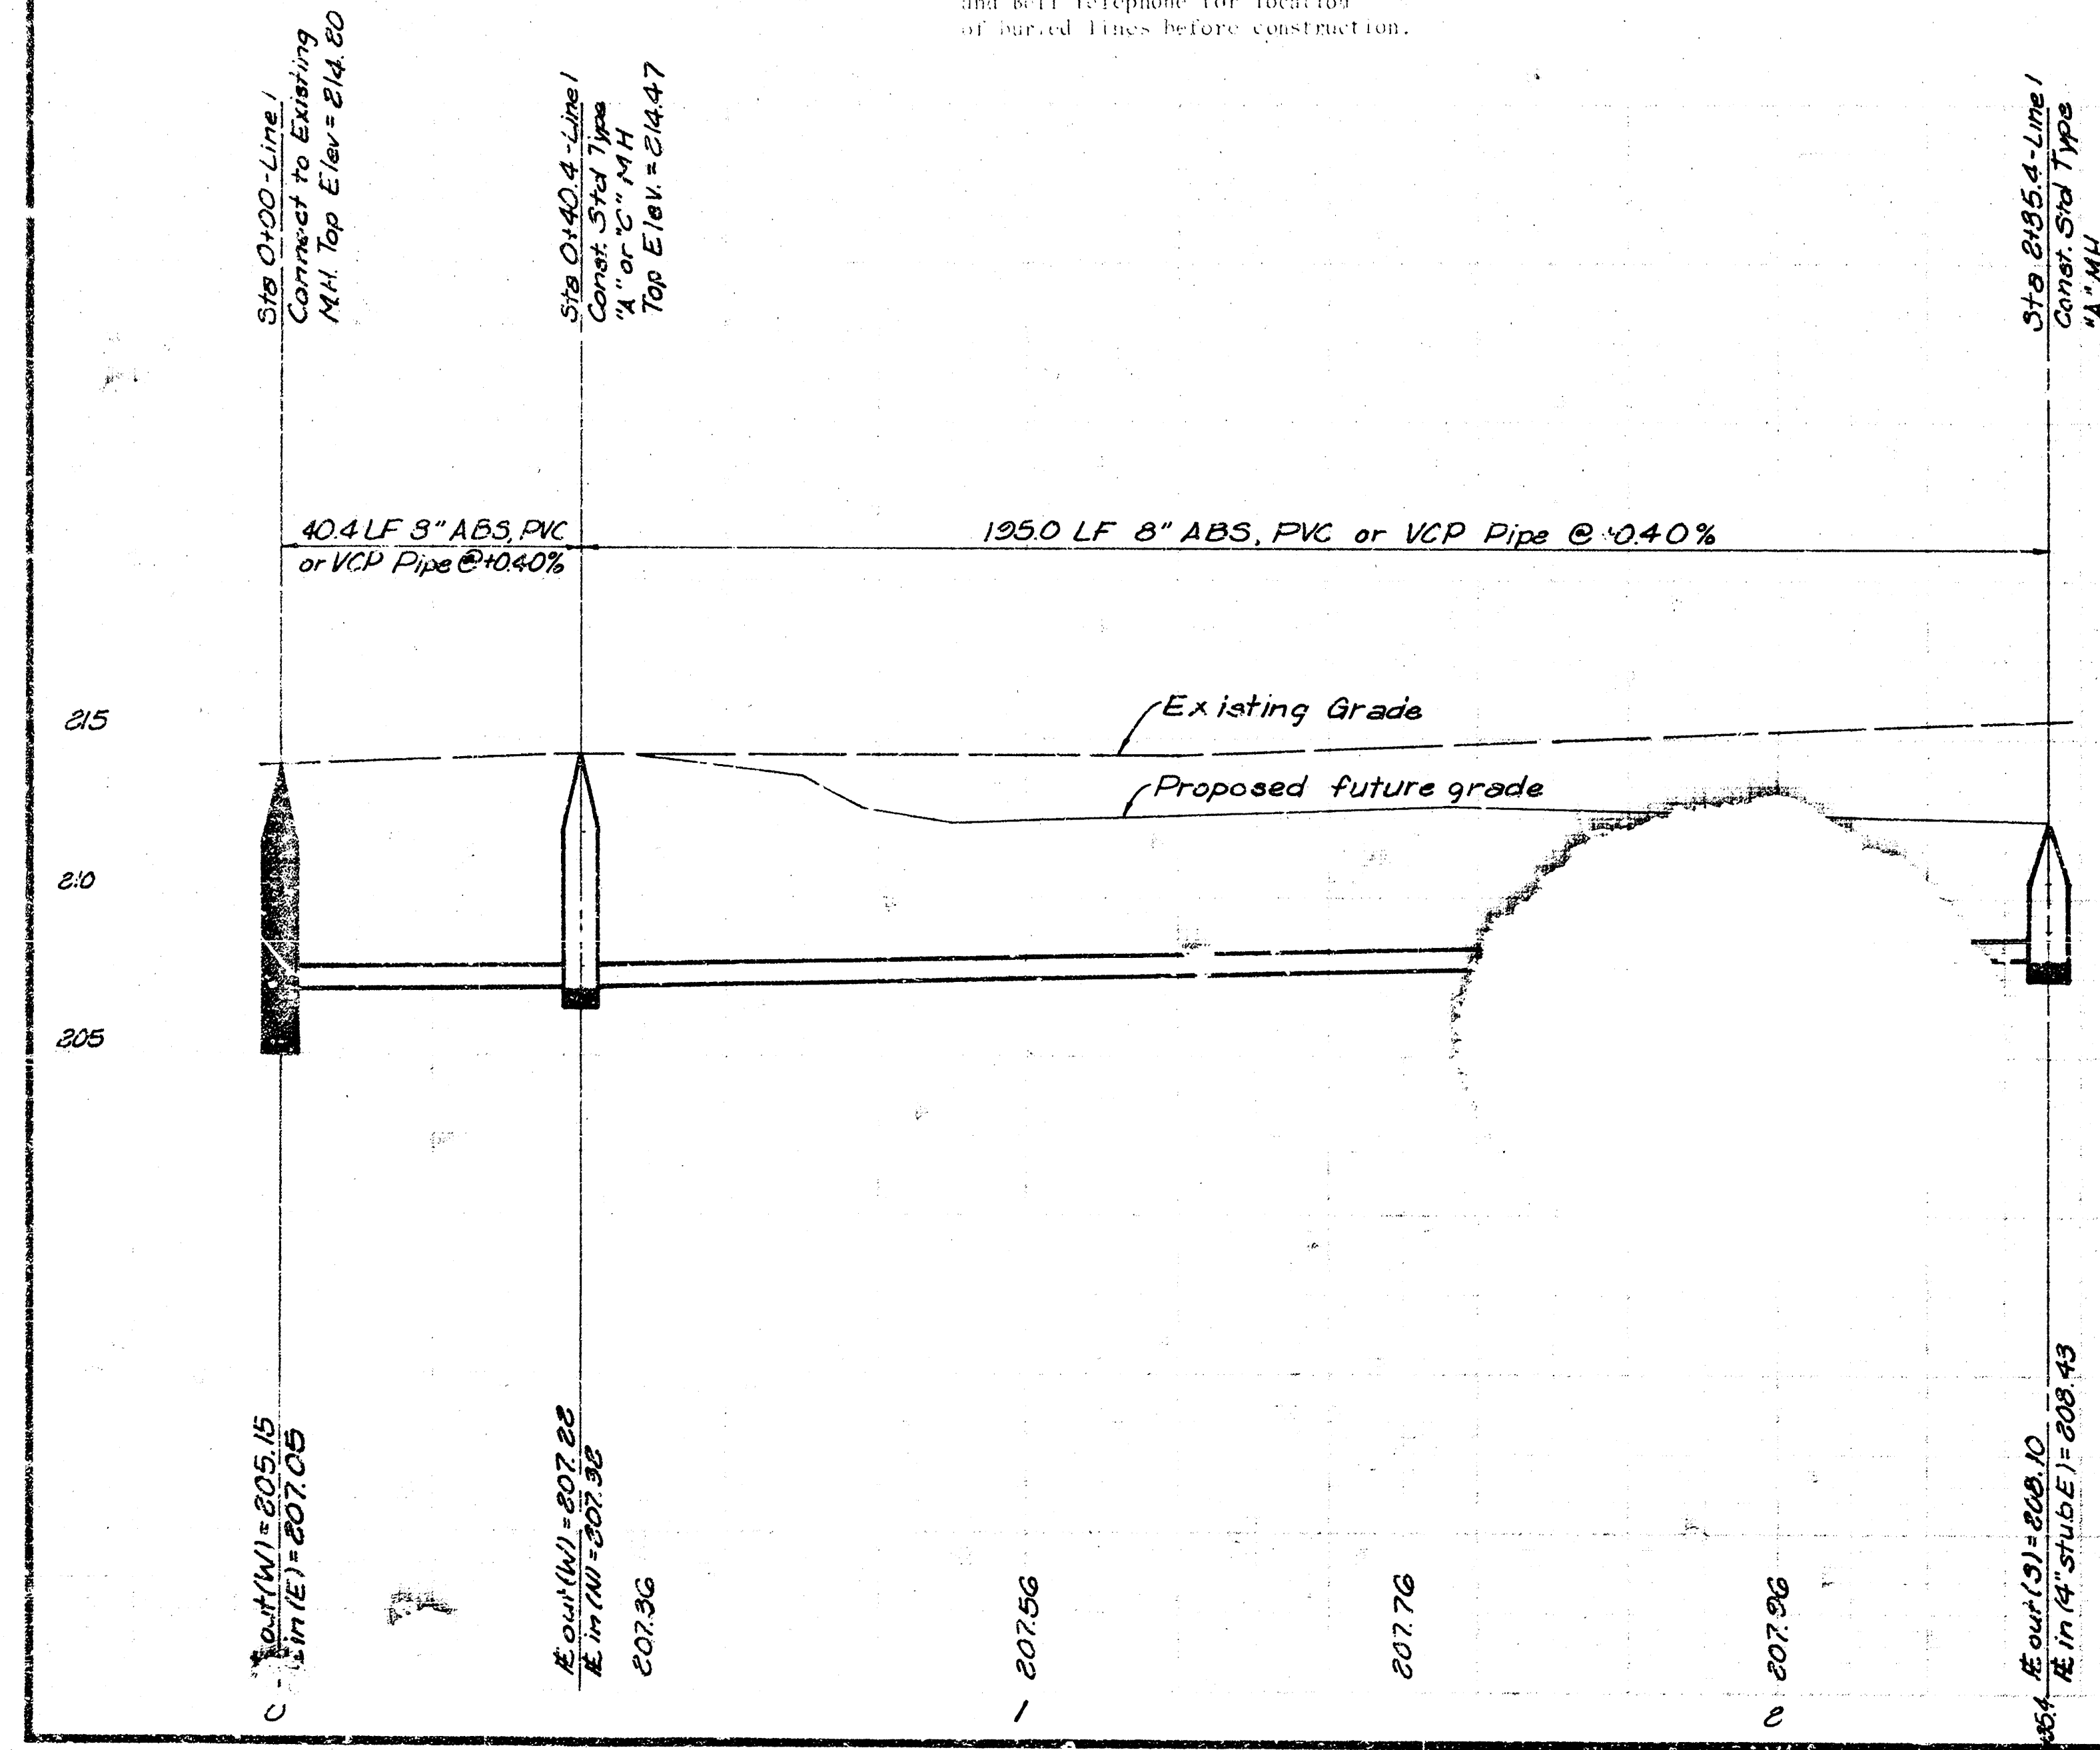

As Built
 12/8/01
 JG

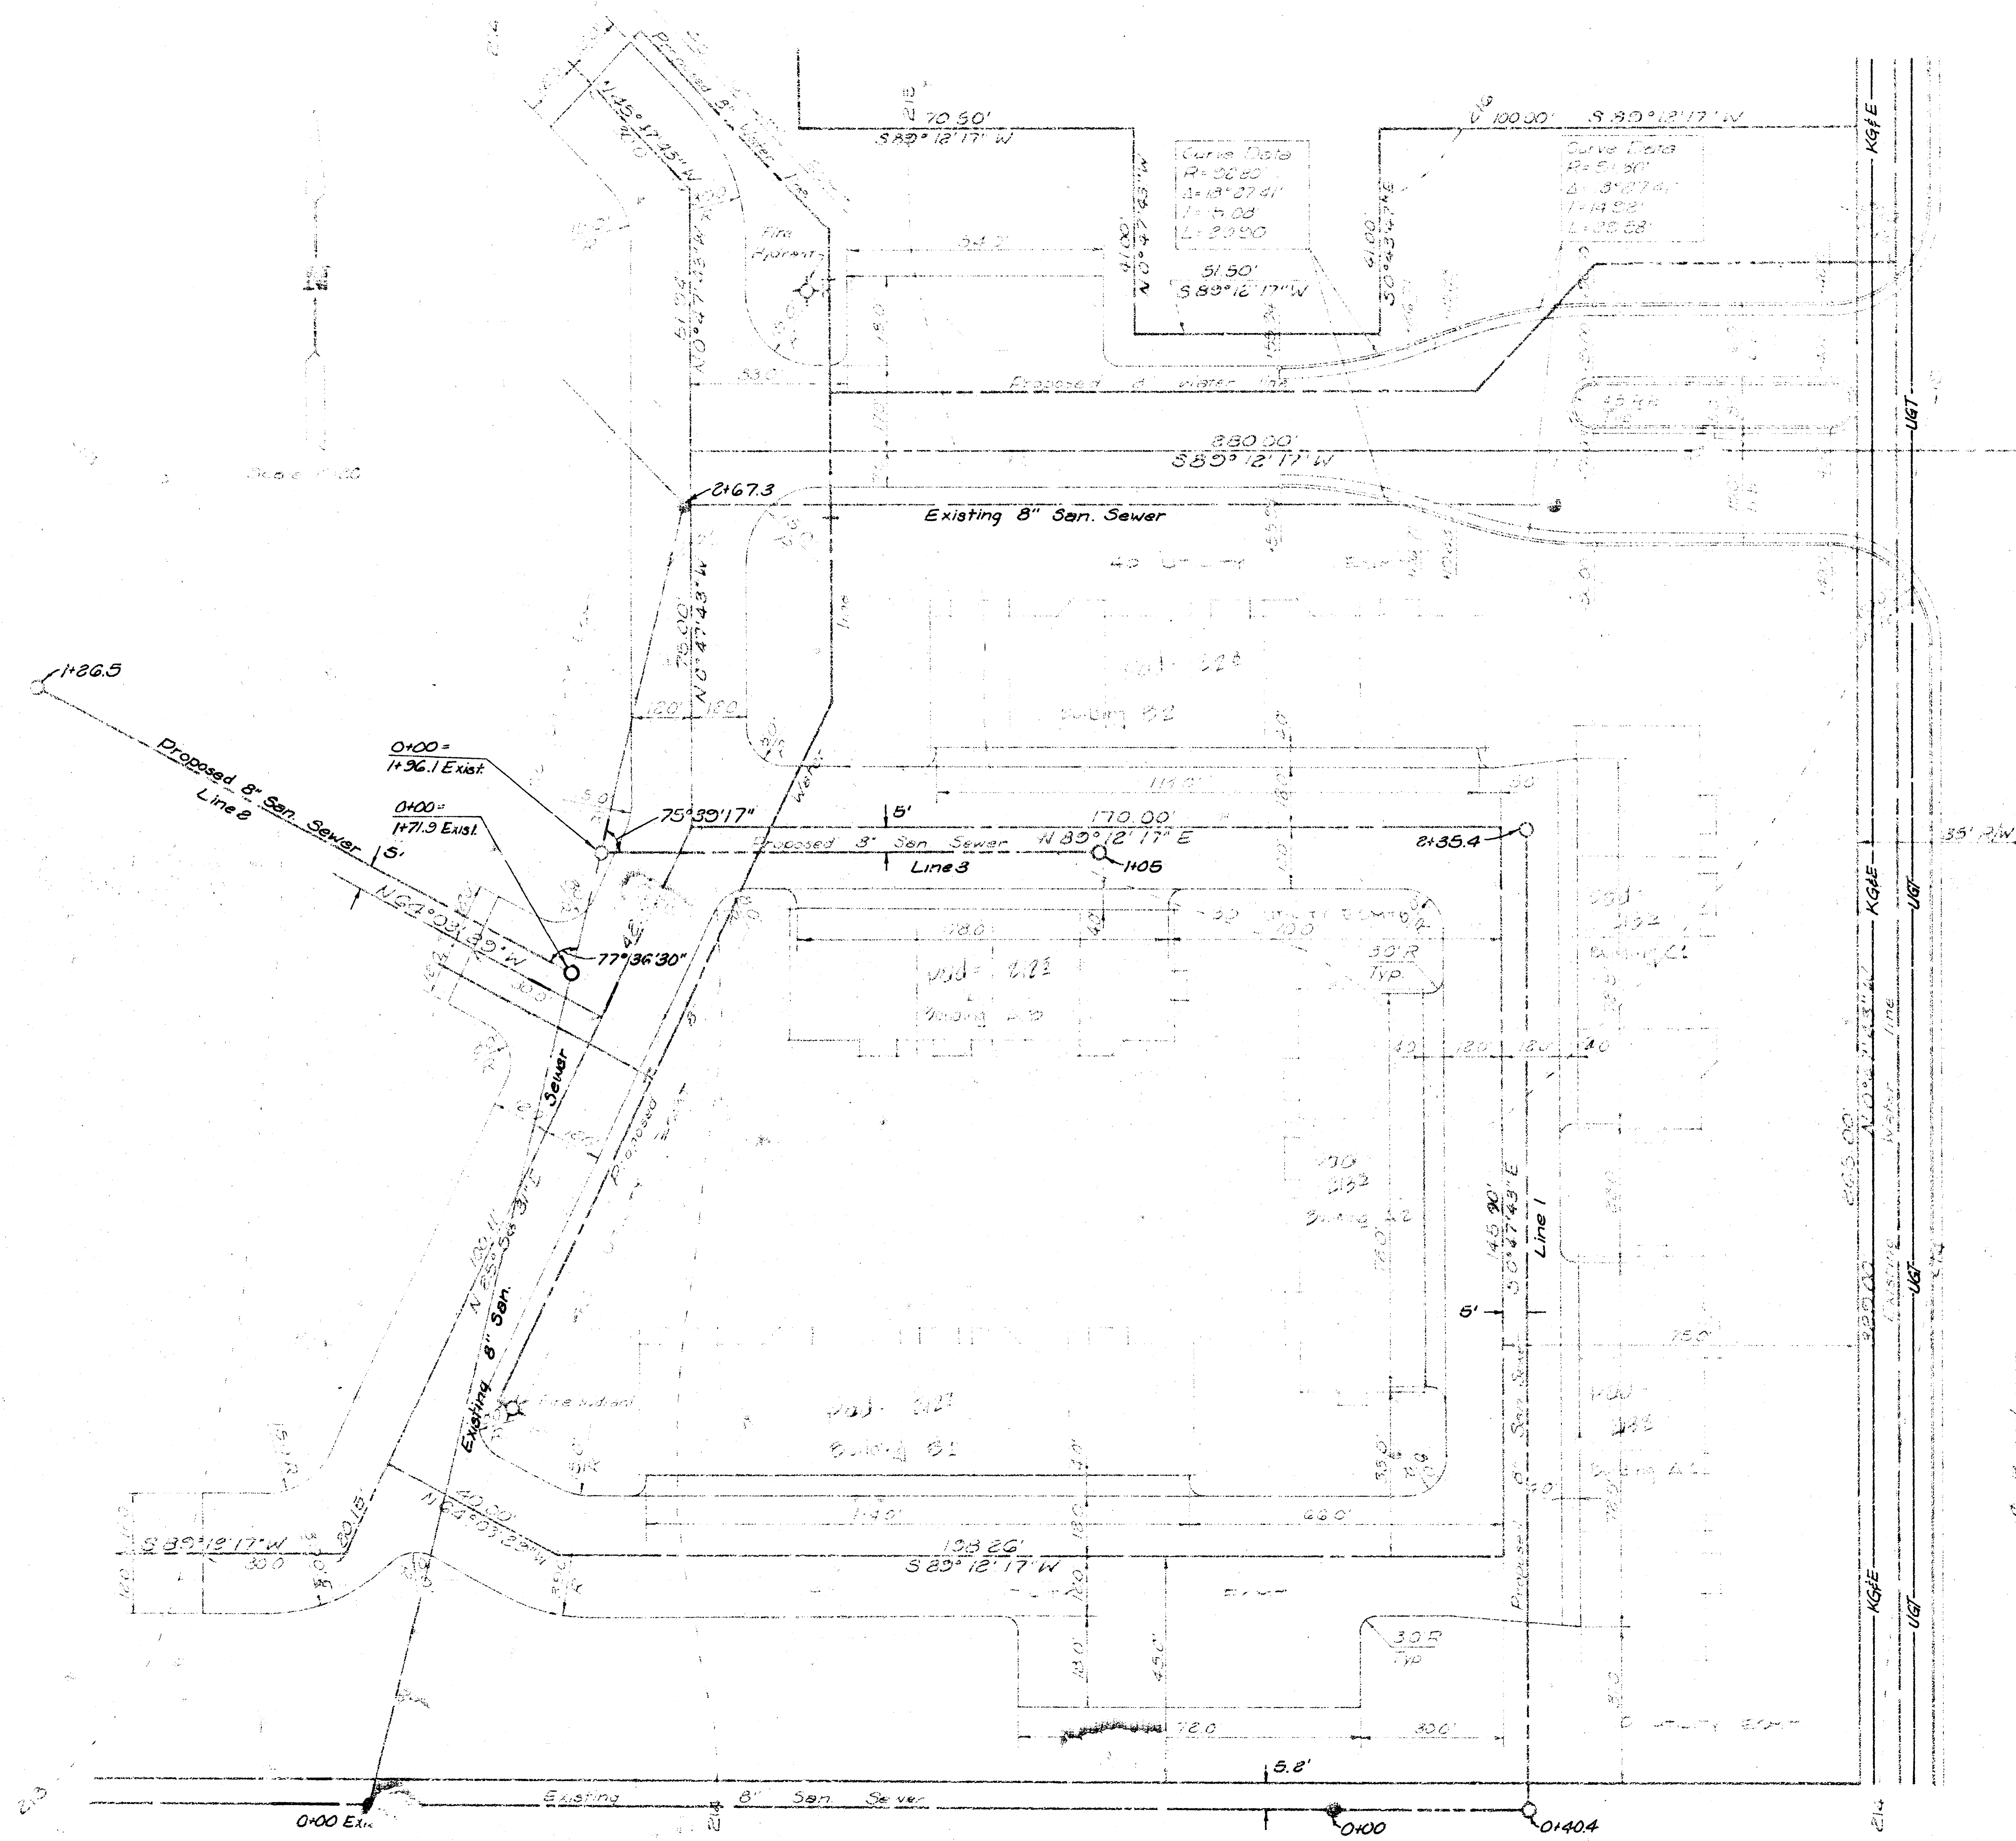

Chelsea Square Phase I Site Plan		DATE: 07/11/2001 DRAWN BY: 81-213 CHECKED BY: 3 SHEET: 3
Van Doron - Hazard - Stallinga		Architects - Engineers - Planners Surveyors - Drafters - Photographers