


MAIN EXTENSION - MAIN 22, W. I. S.

PROJECT NO.

468 76 245 80971 000 000 001


CITY OF WICHITA, KANSAS

DEAN SELLERS, ACTING CITY ENGINEER

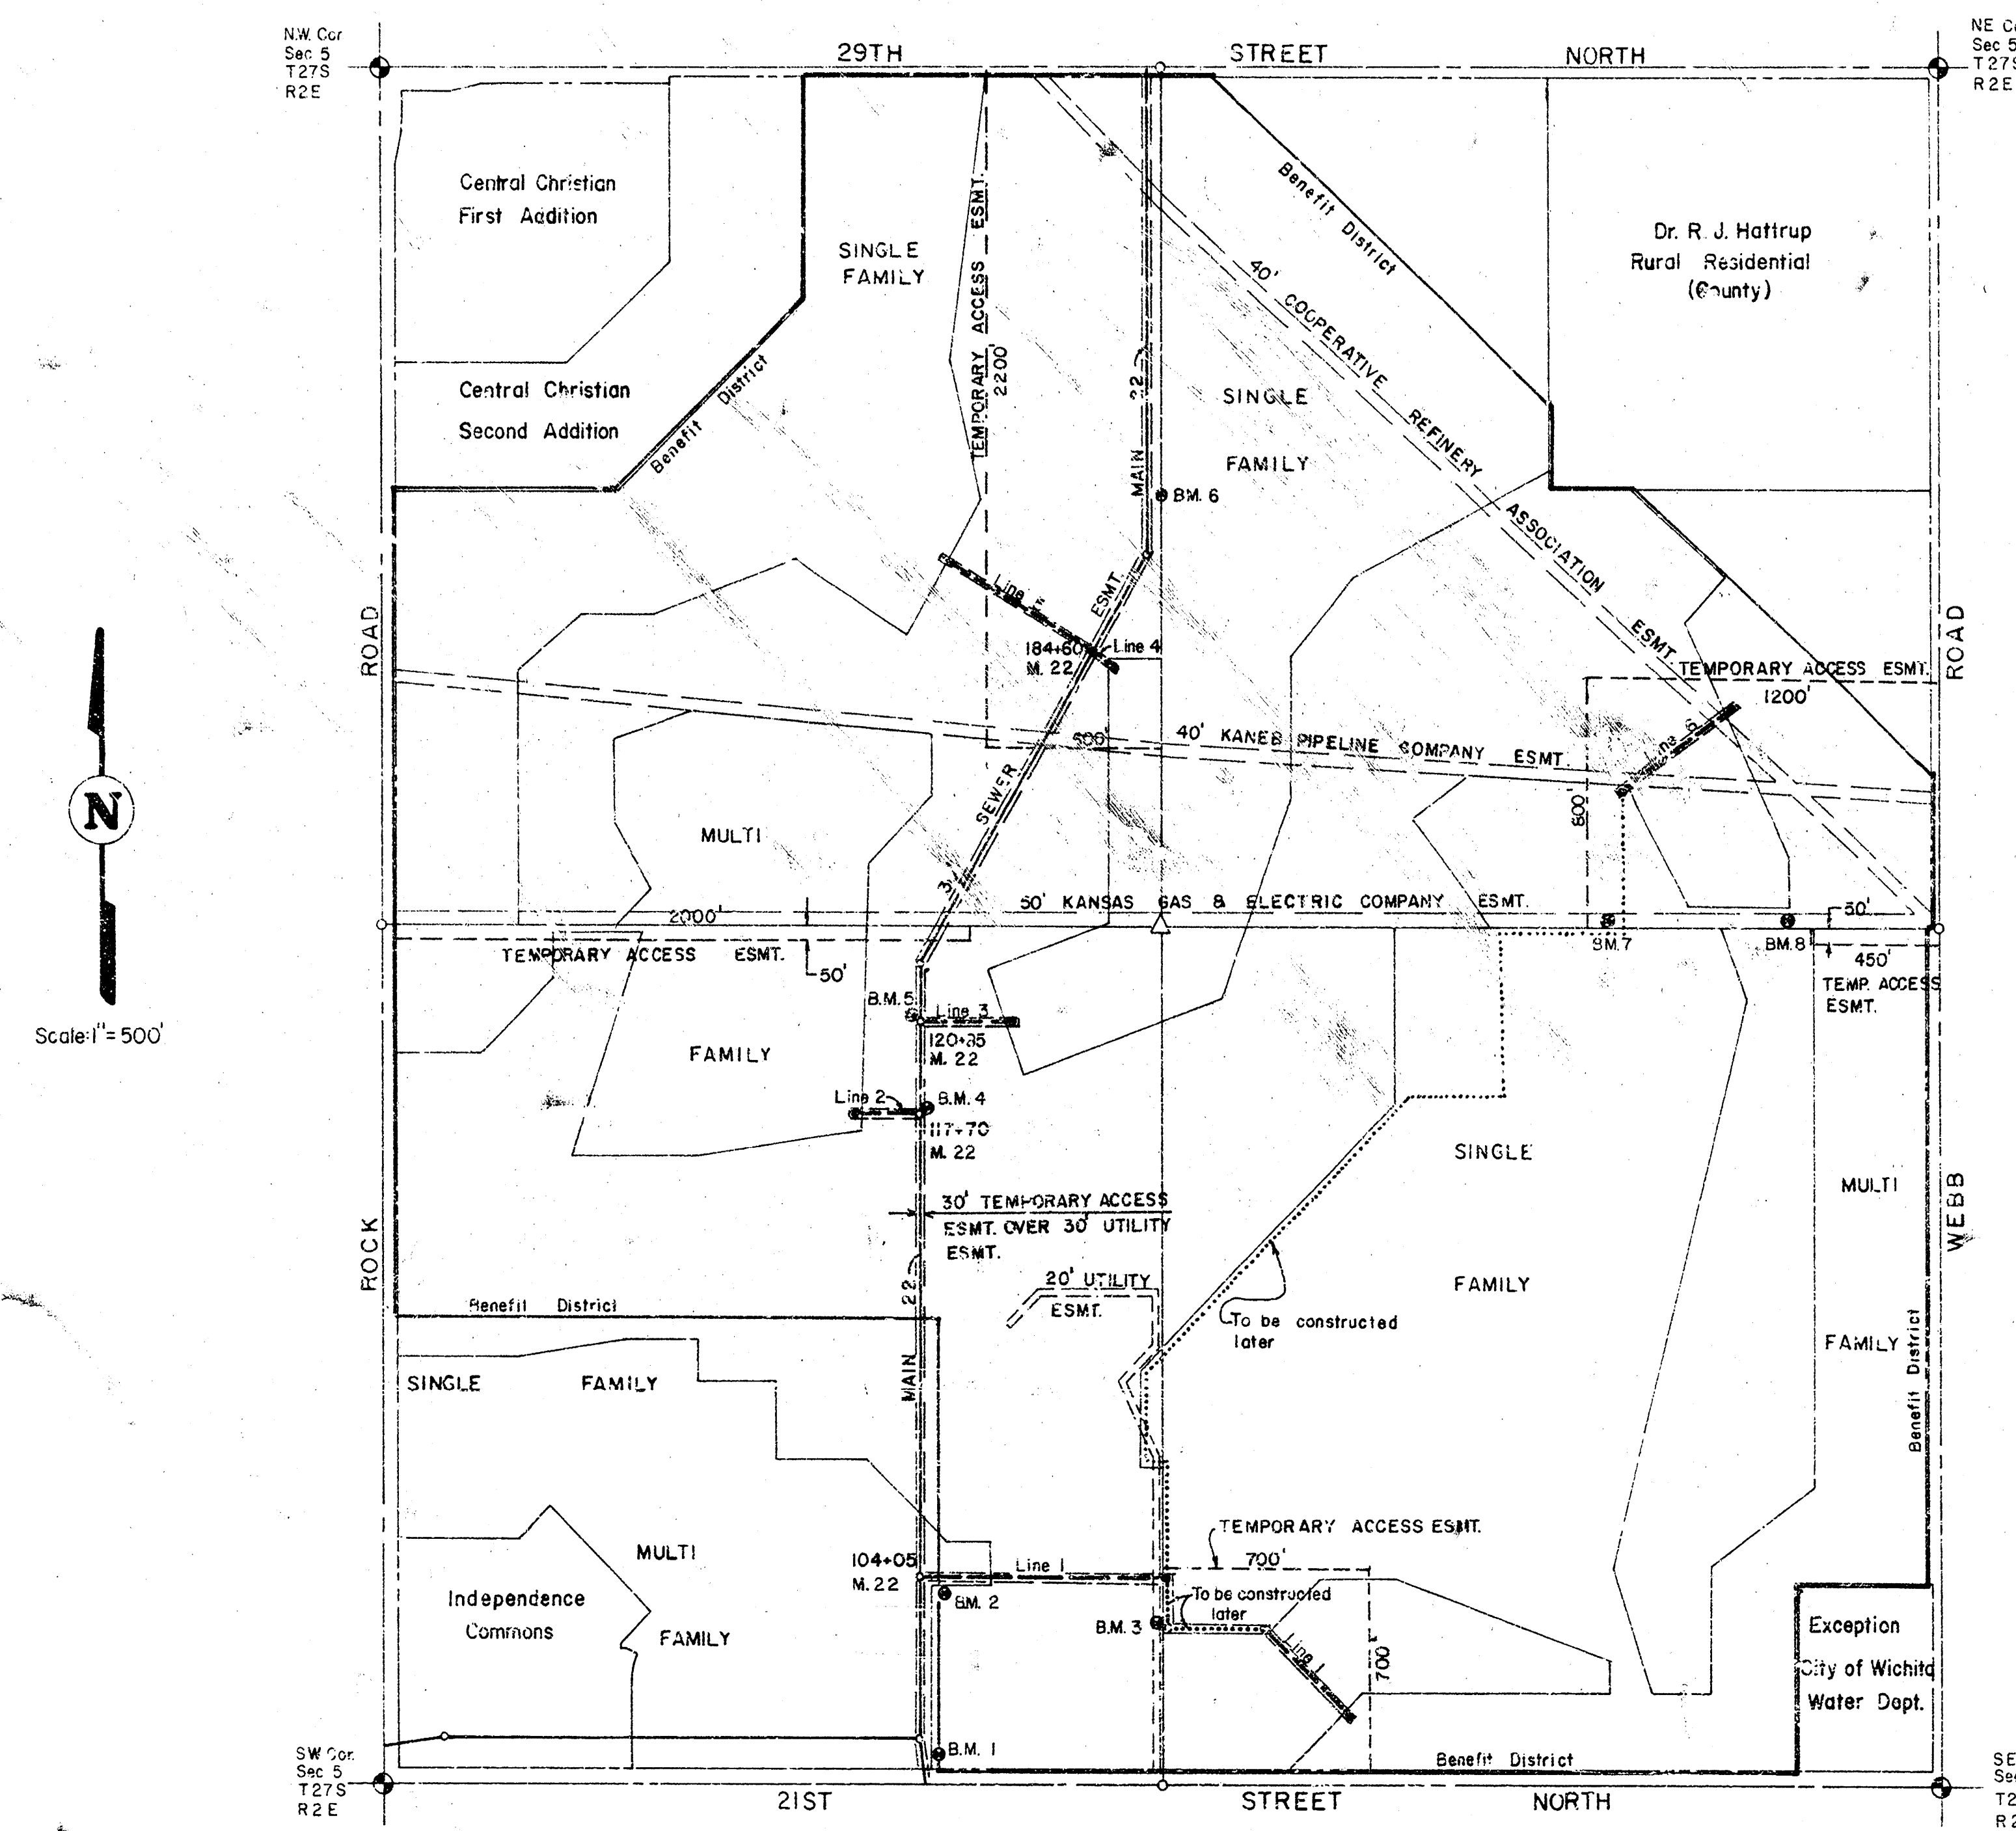

INDEX TO DRAWINGS

SHEET	DESCRIPTION
1	TITLE SHEET
2-3	LINE 1
4	LINE 2 & LINE 3
5	LINE 4 & LINE 5
6	LINE 6

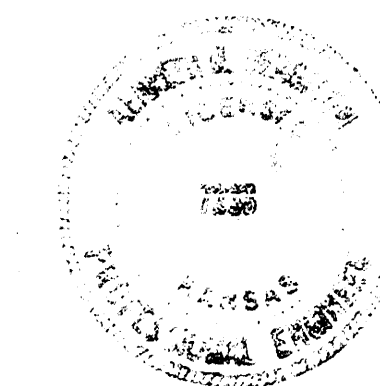


Van Doren - Hazard - Stallings

Architects • Engineers • Planners
Topeka Wichita Minneapolis


Sheet 1
of 6

MAIN EXTENSION, MAIN 22, W.I.S
468 76 245 80971 000 000 001

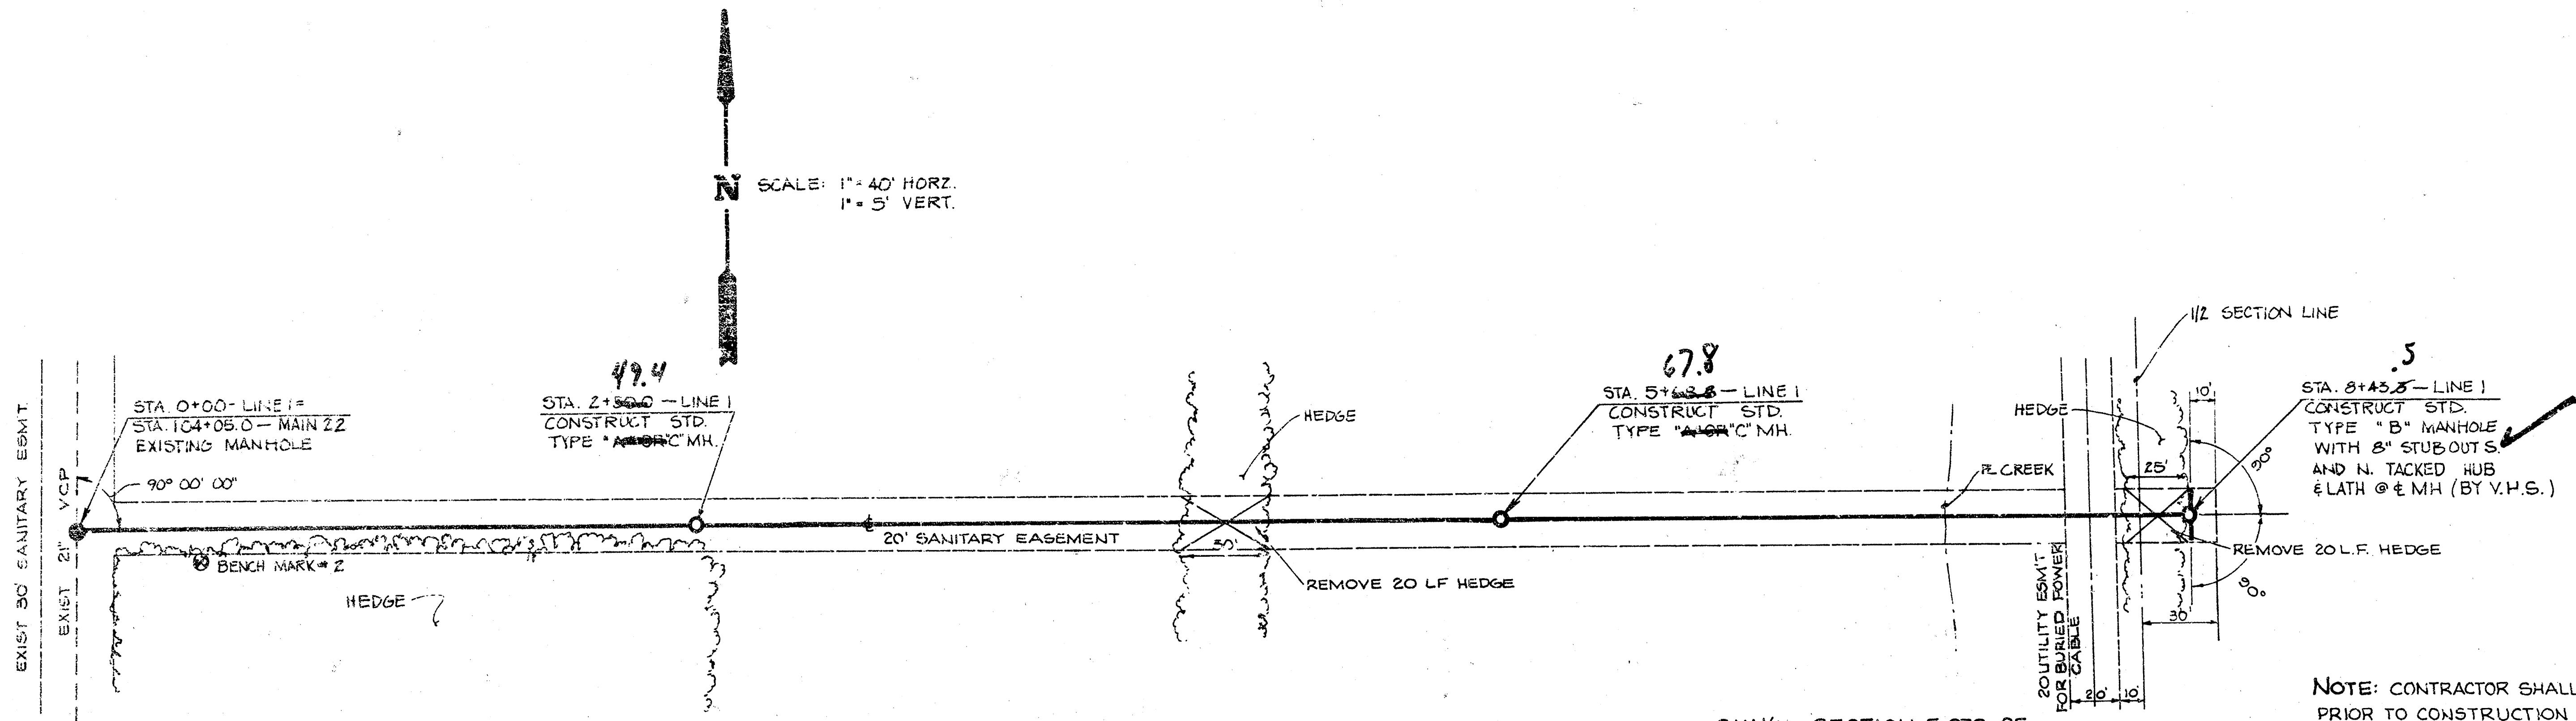

NOTE: CONTRACTOR SHALL CONTACT K.G.F.E
PRIOR TO CONSTRUCTION OF SEWER LINE

BENCH MARKS:
BENCH MARK #1: STP SPK. E.
FC P P S SIDE 21ST STREET
NORTH 1820' E. ROCK ROAD
STA. 96+96, 17' LT. MAIN ZZ WIS.
ELEV. = 193.26
BENCH MARK #2: RR SPK NE
FC 10" ELM. STA 0+50, 12' RT.
LINE 1
ELEV. = 194.92
BENCH MARK #3: TOP BENT SPK
E. RT 2'-6" HEDGE TREES
30' RT. 9+75. ELEV. = 194.36

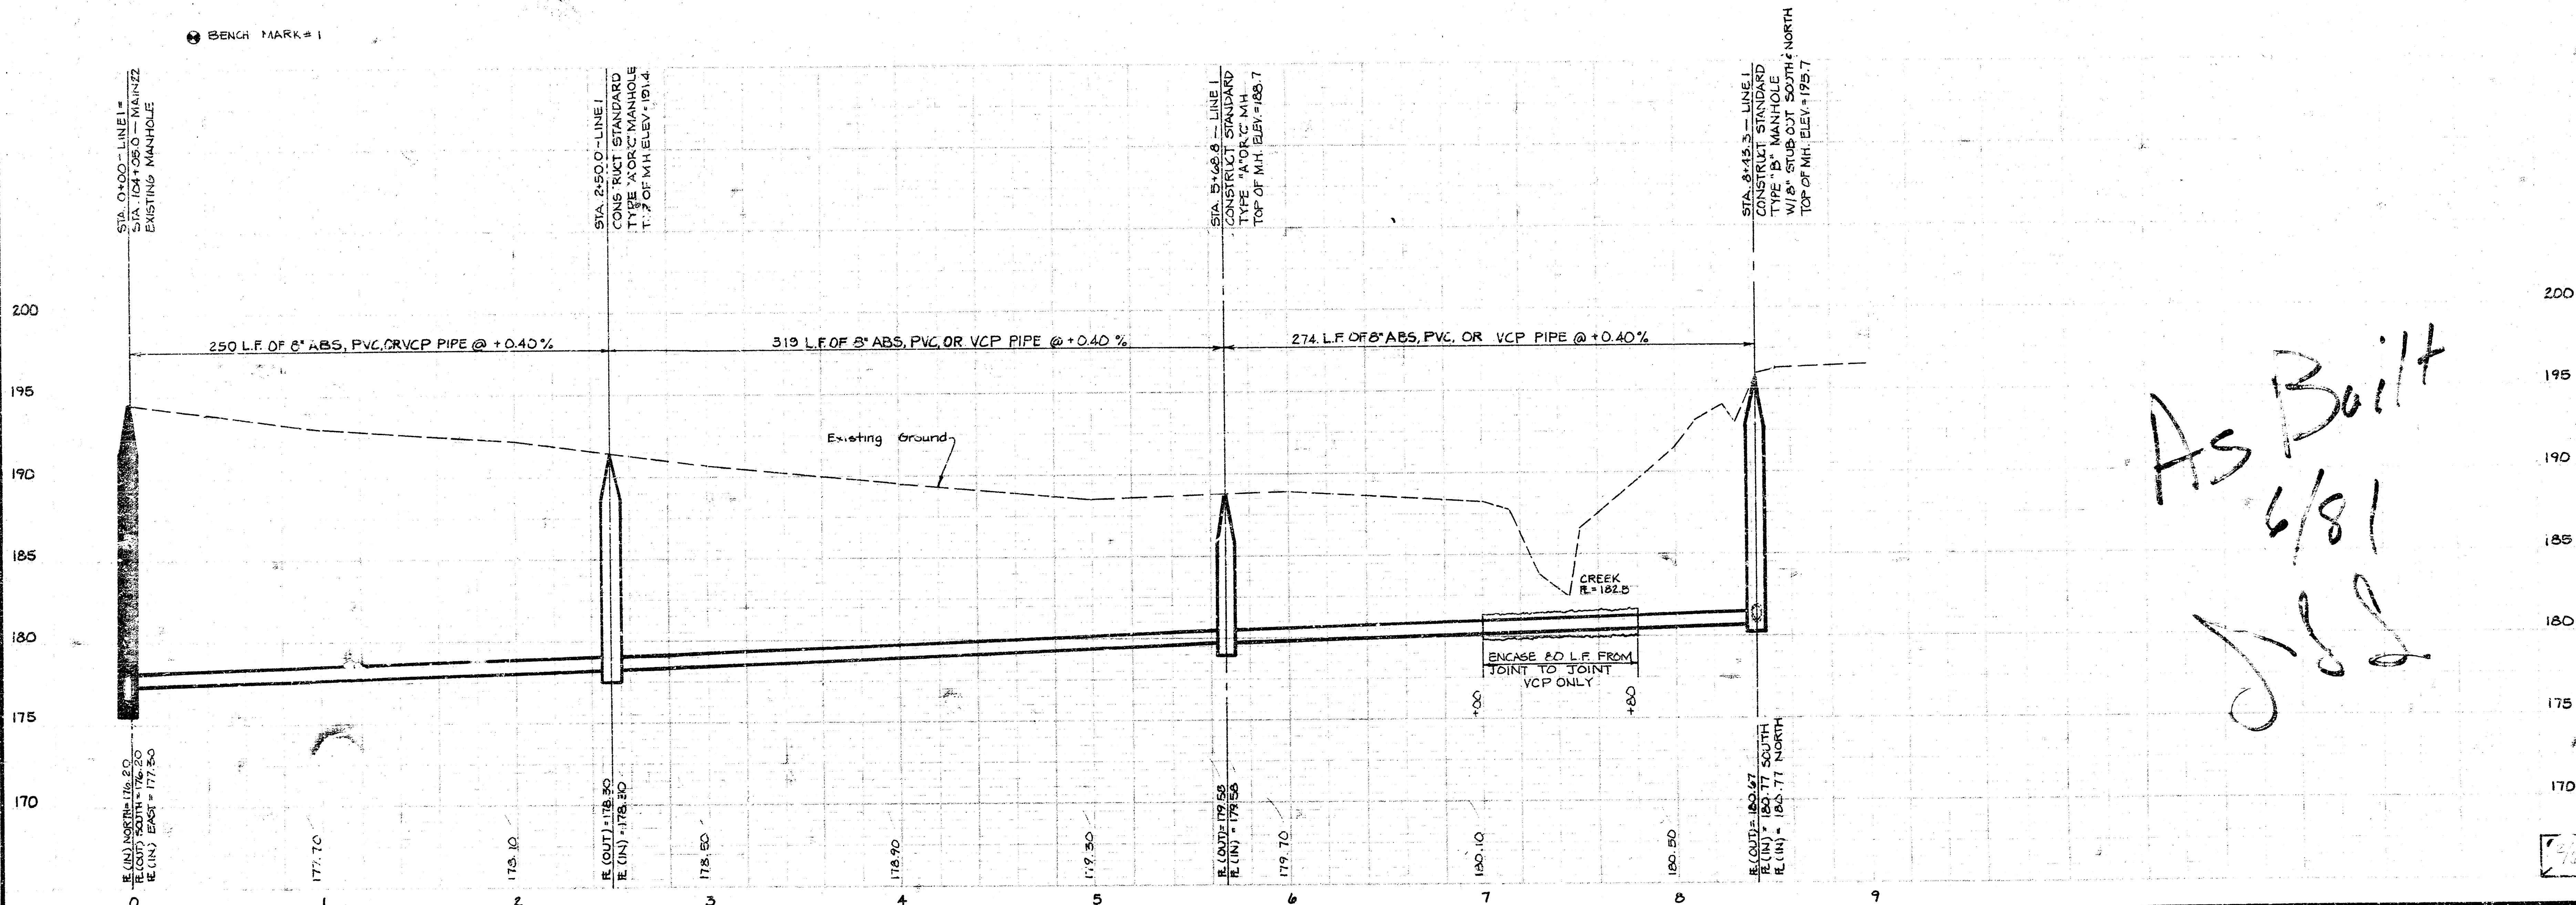


As Built
6/81
JSS


FILMED FROM THE BEST

MAIN EXTENSION, MAIN 22, W.I.S.
468-76-245-80971-000-000-001



SCALE: 1" = 40' HORIZ.
1" = 5' VERT.

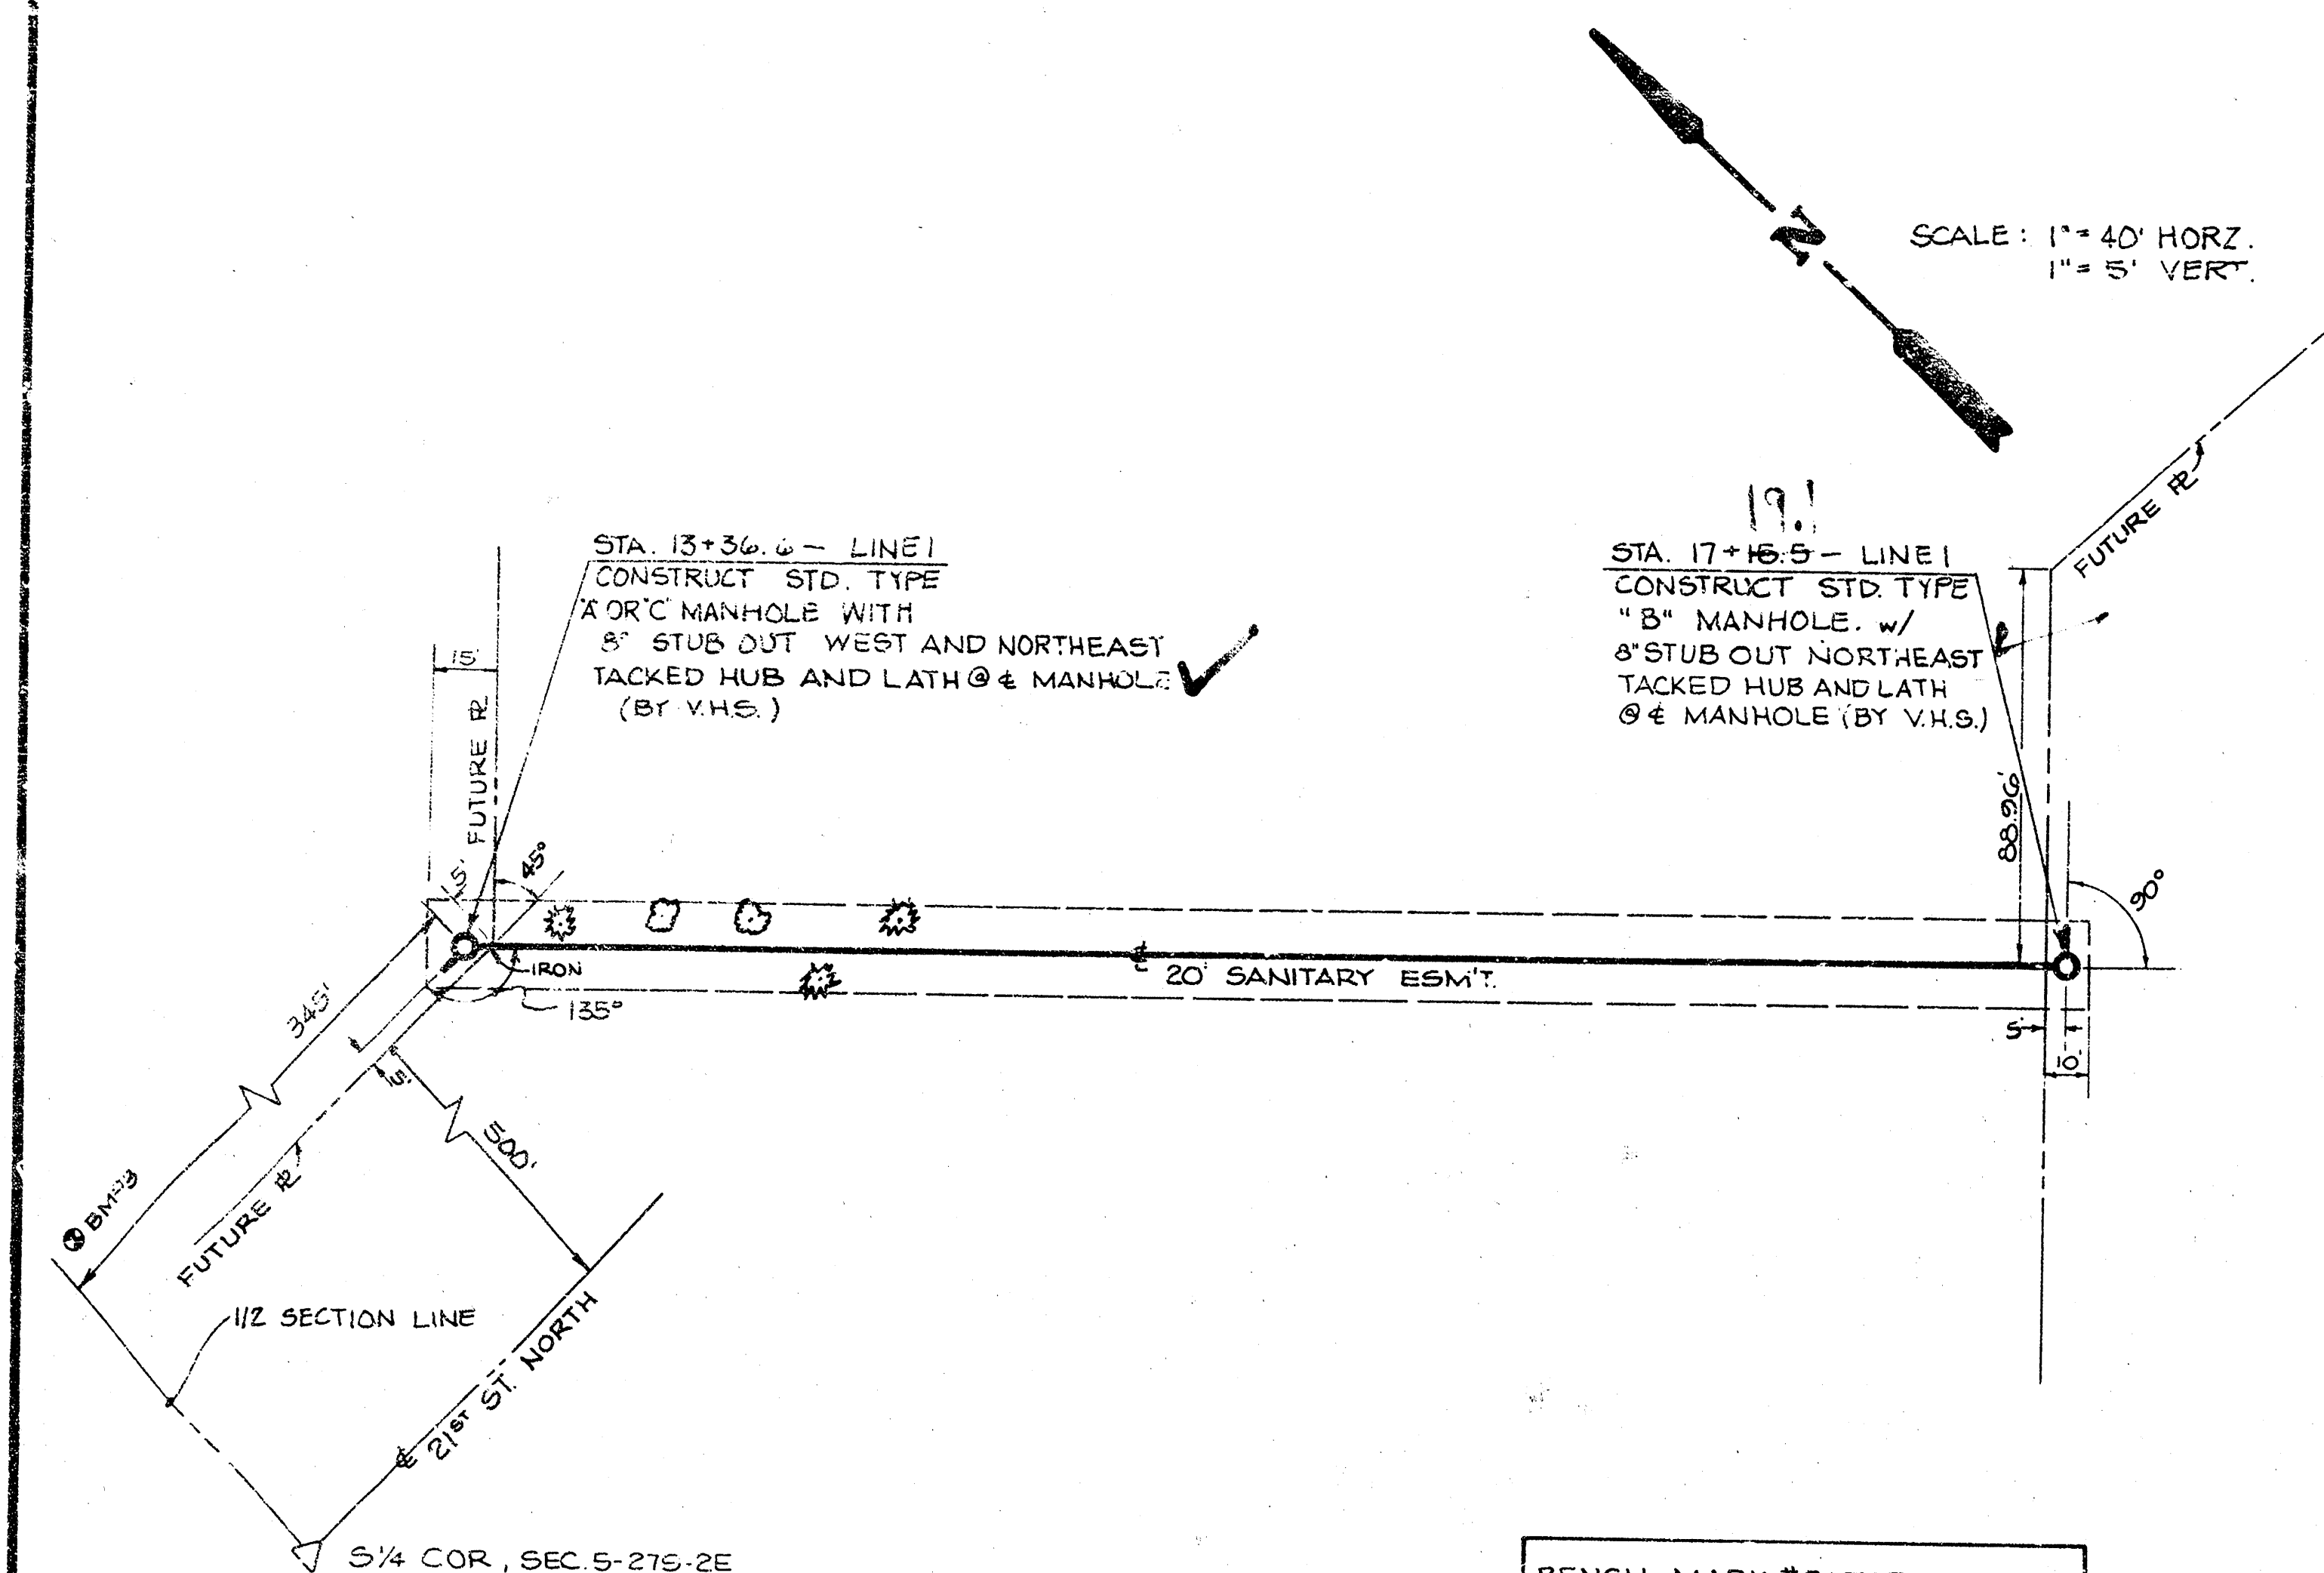

BENCH MARK #3: TOP BENT OF
E ROOT 2-6\"/>

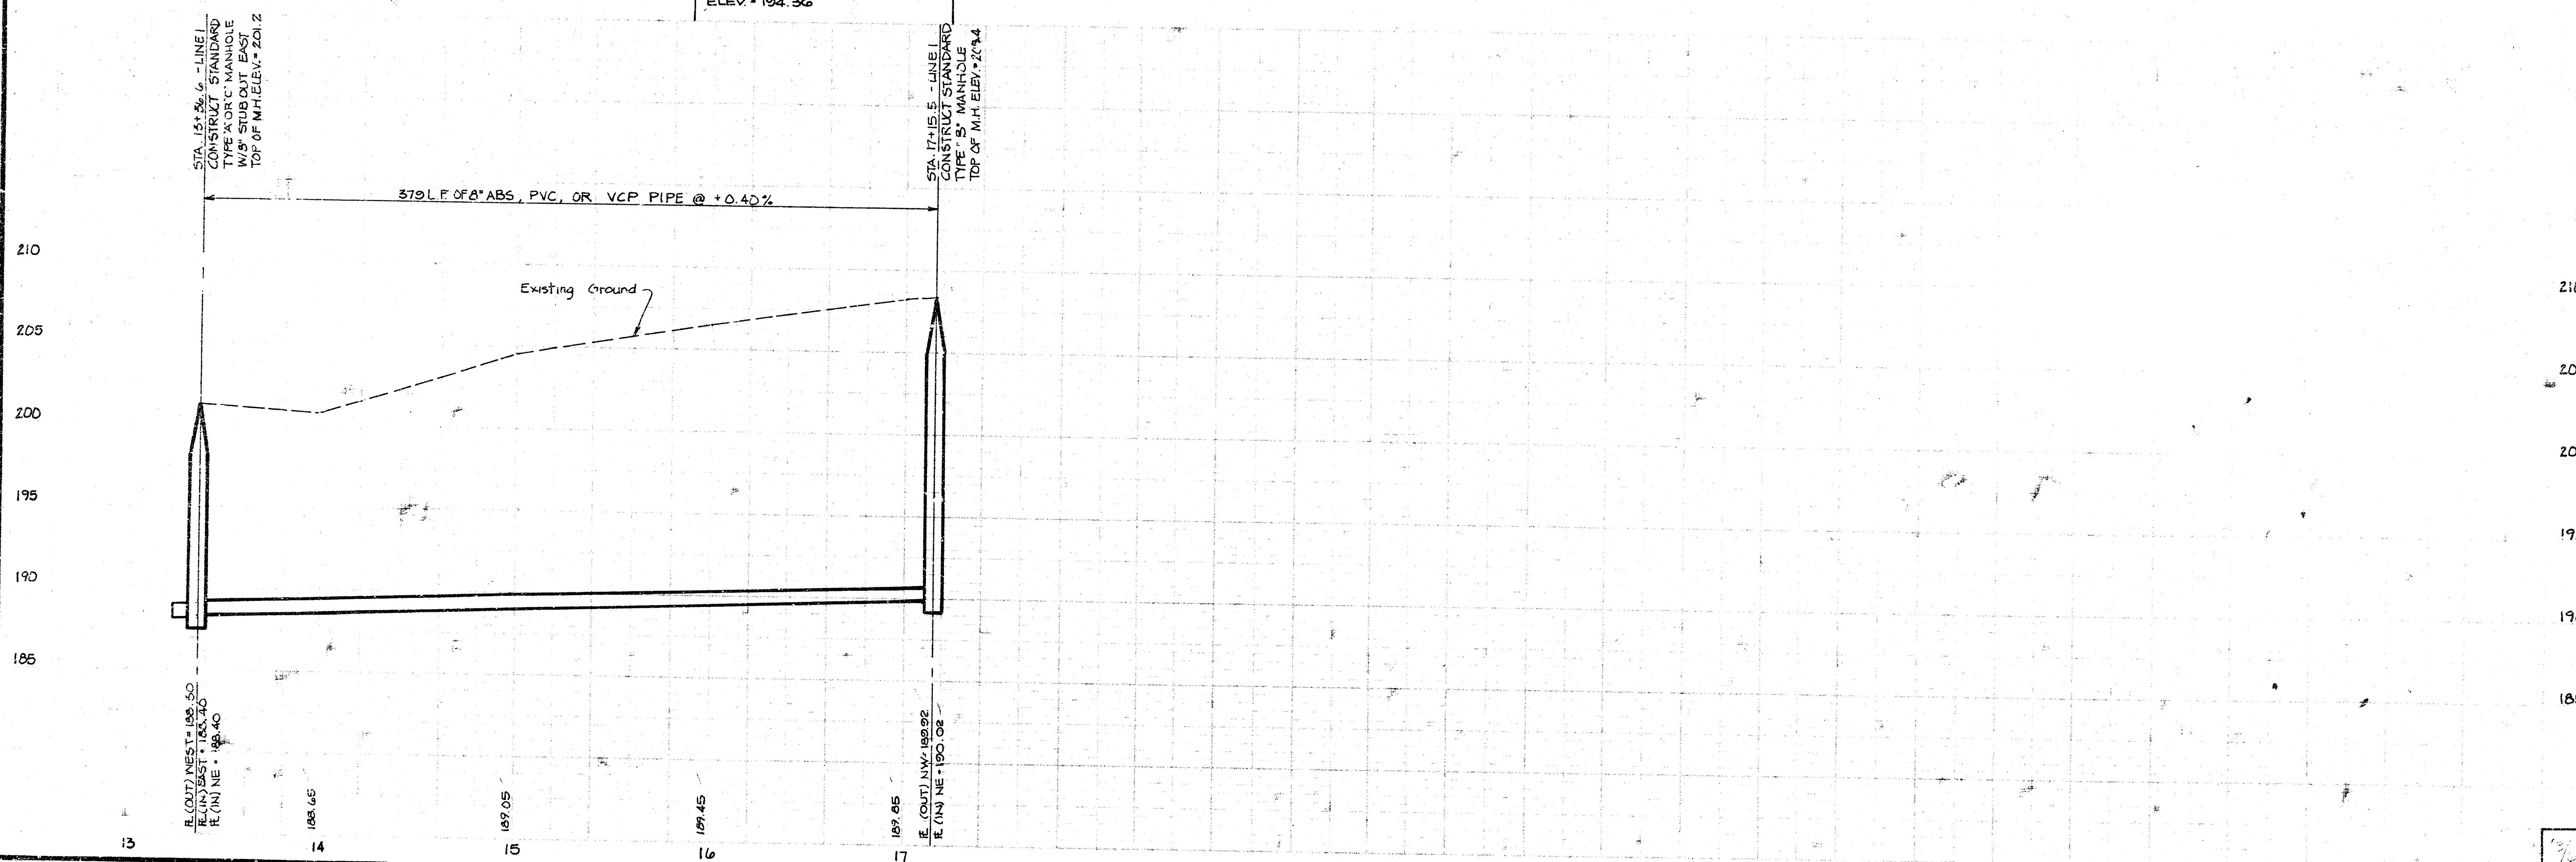


MAIN EXTENSION, MAIN 22, W.I.S.
463-76-245-80971-000-000-001

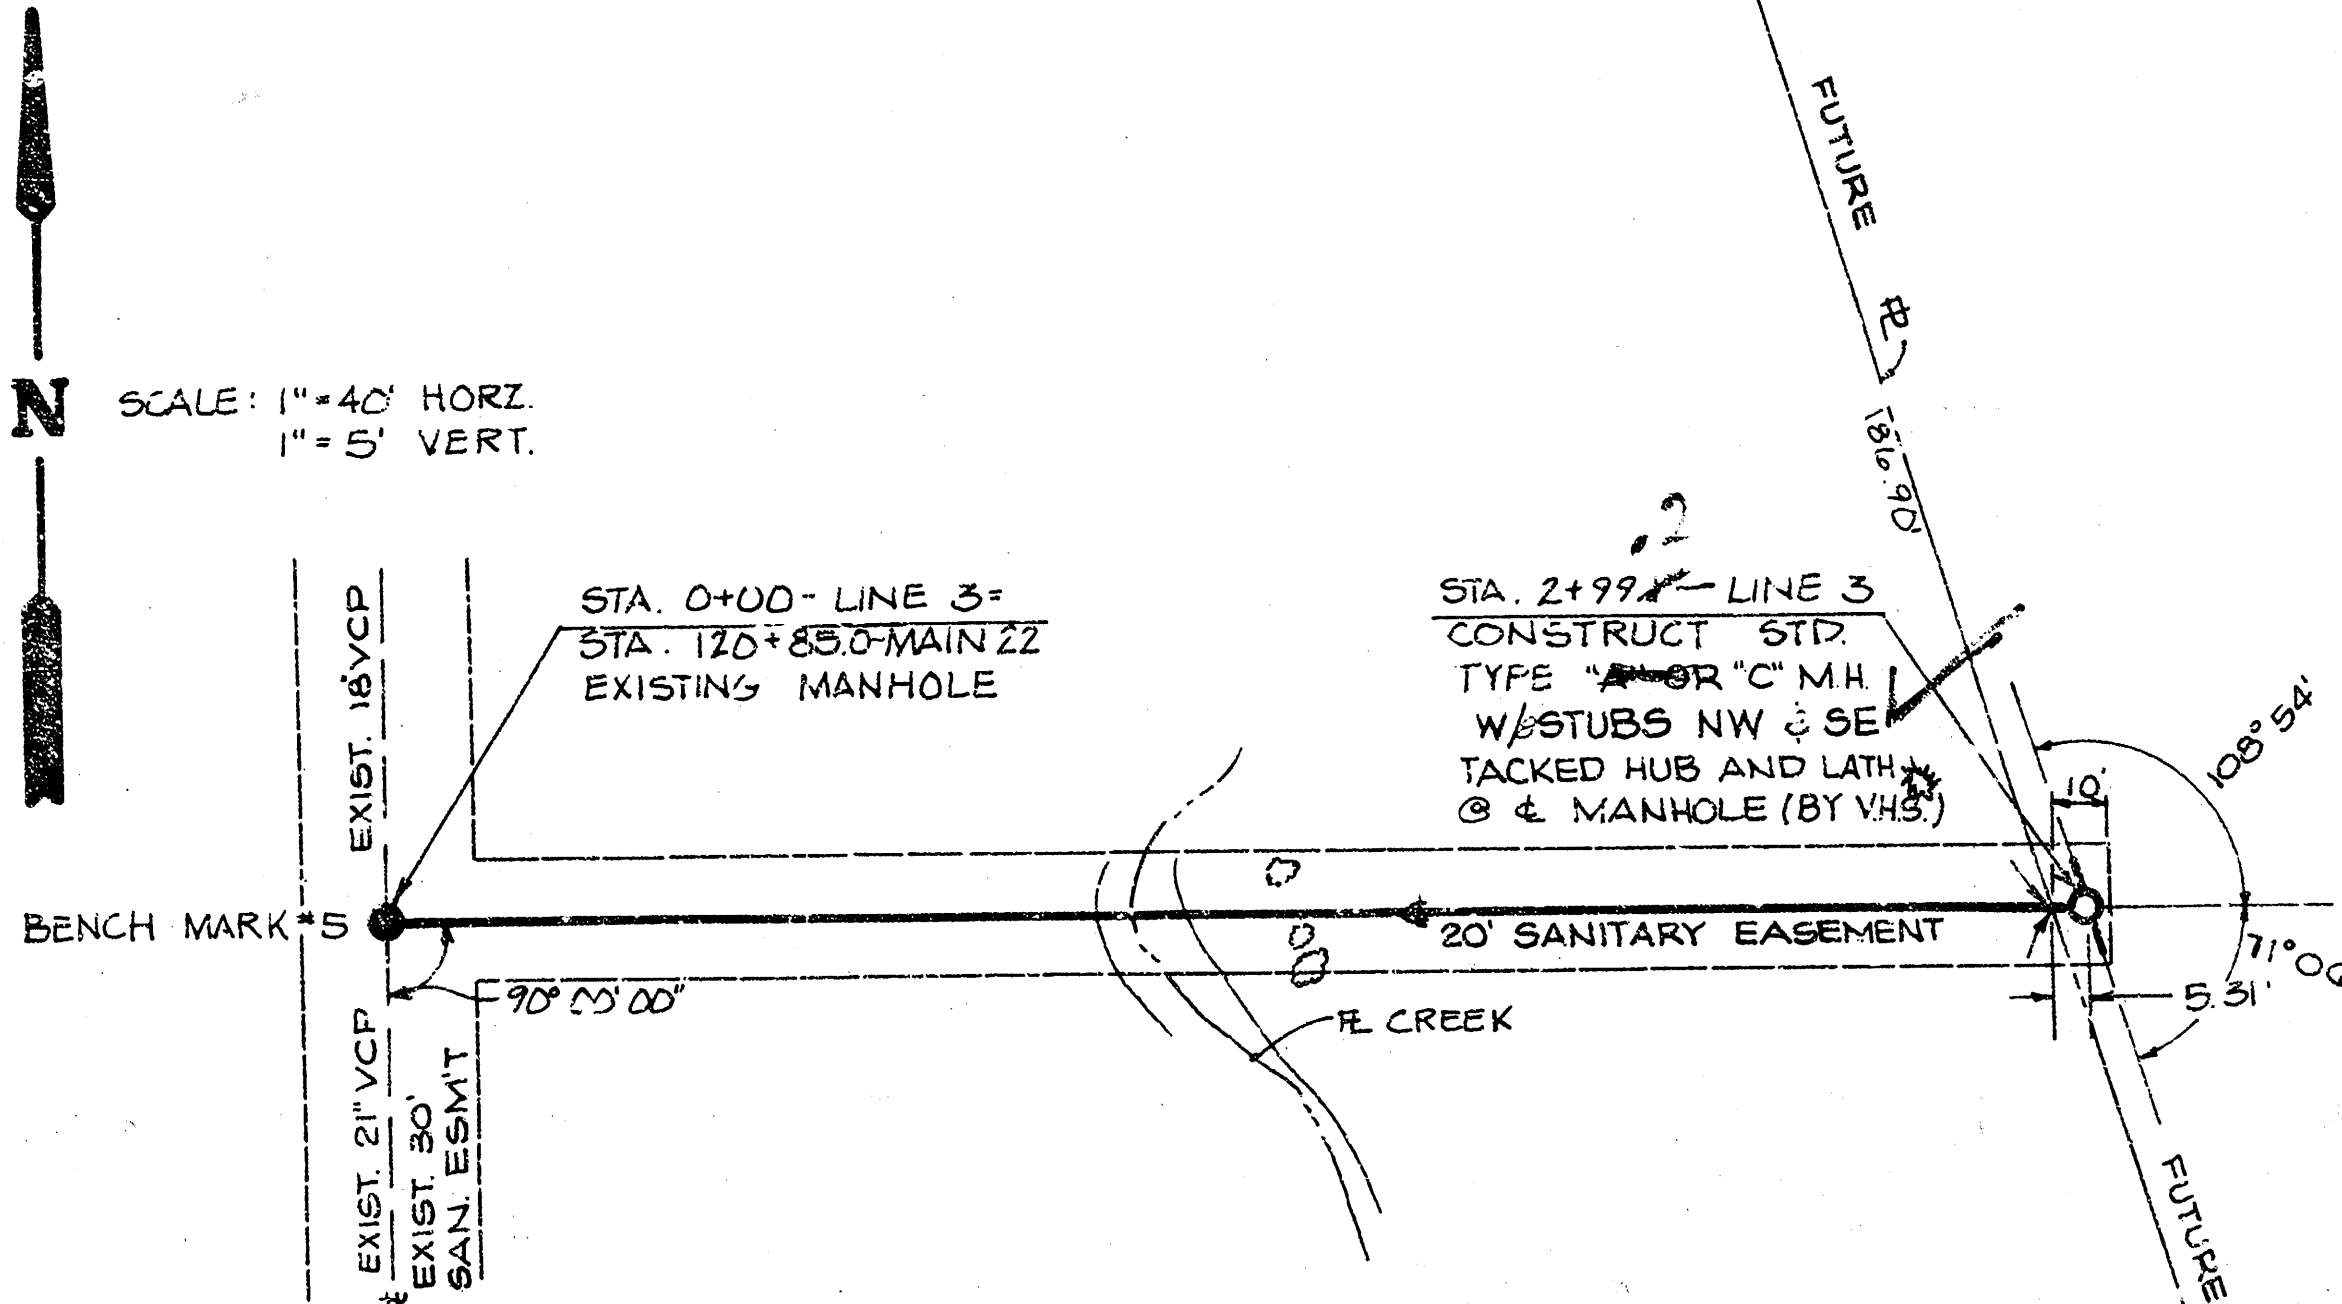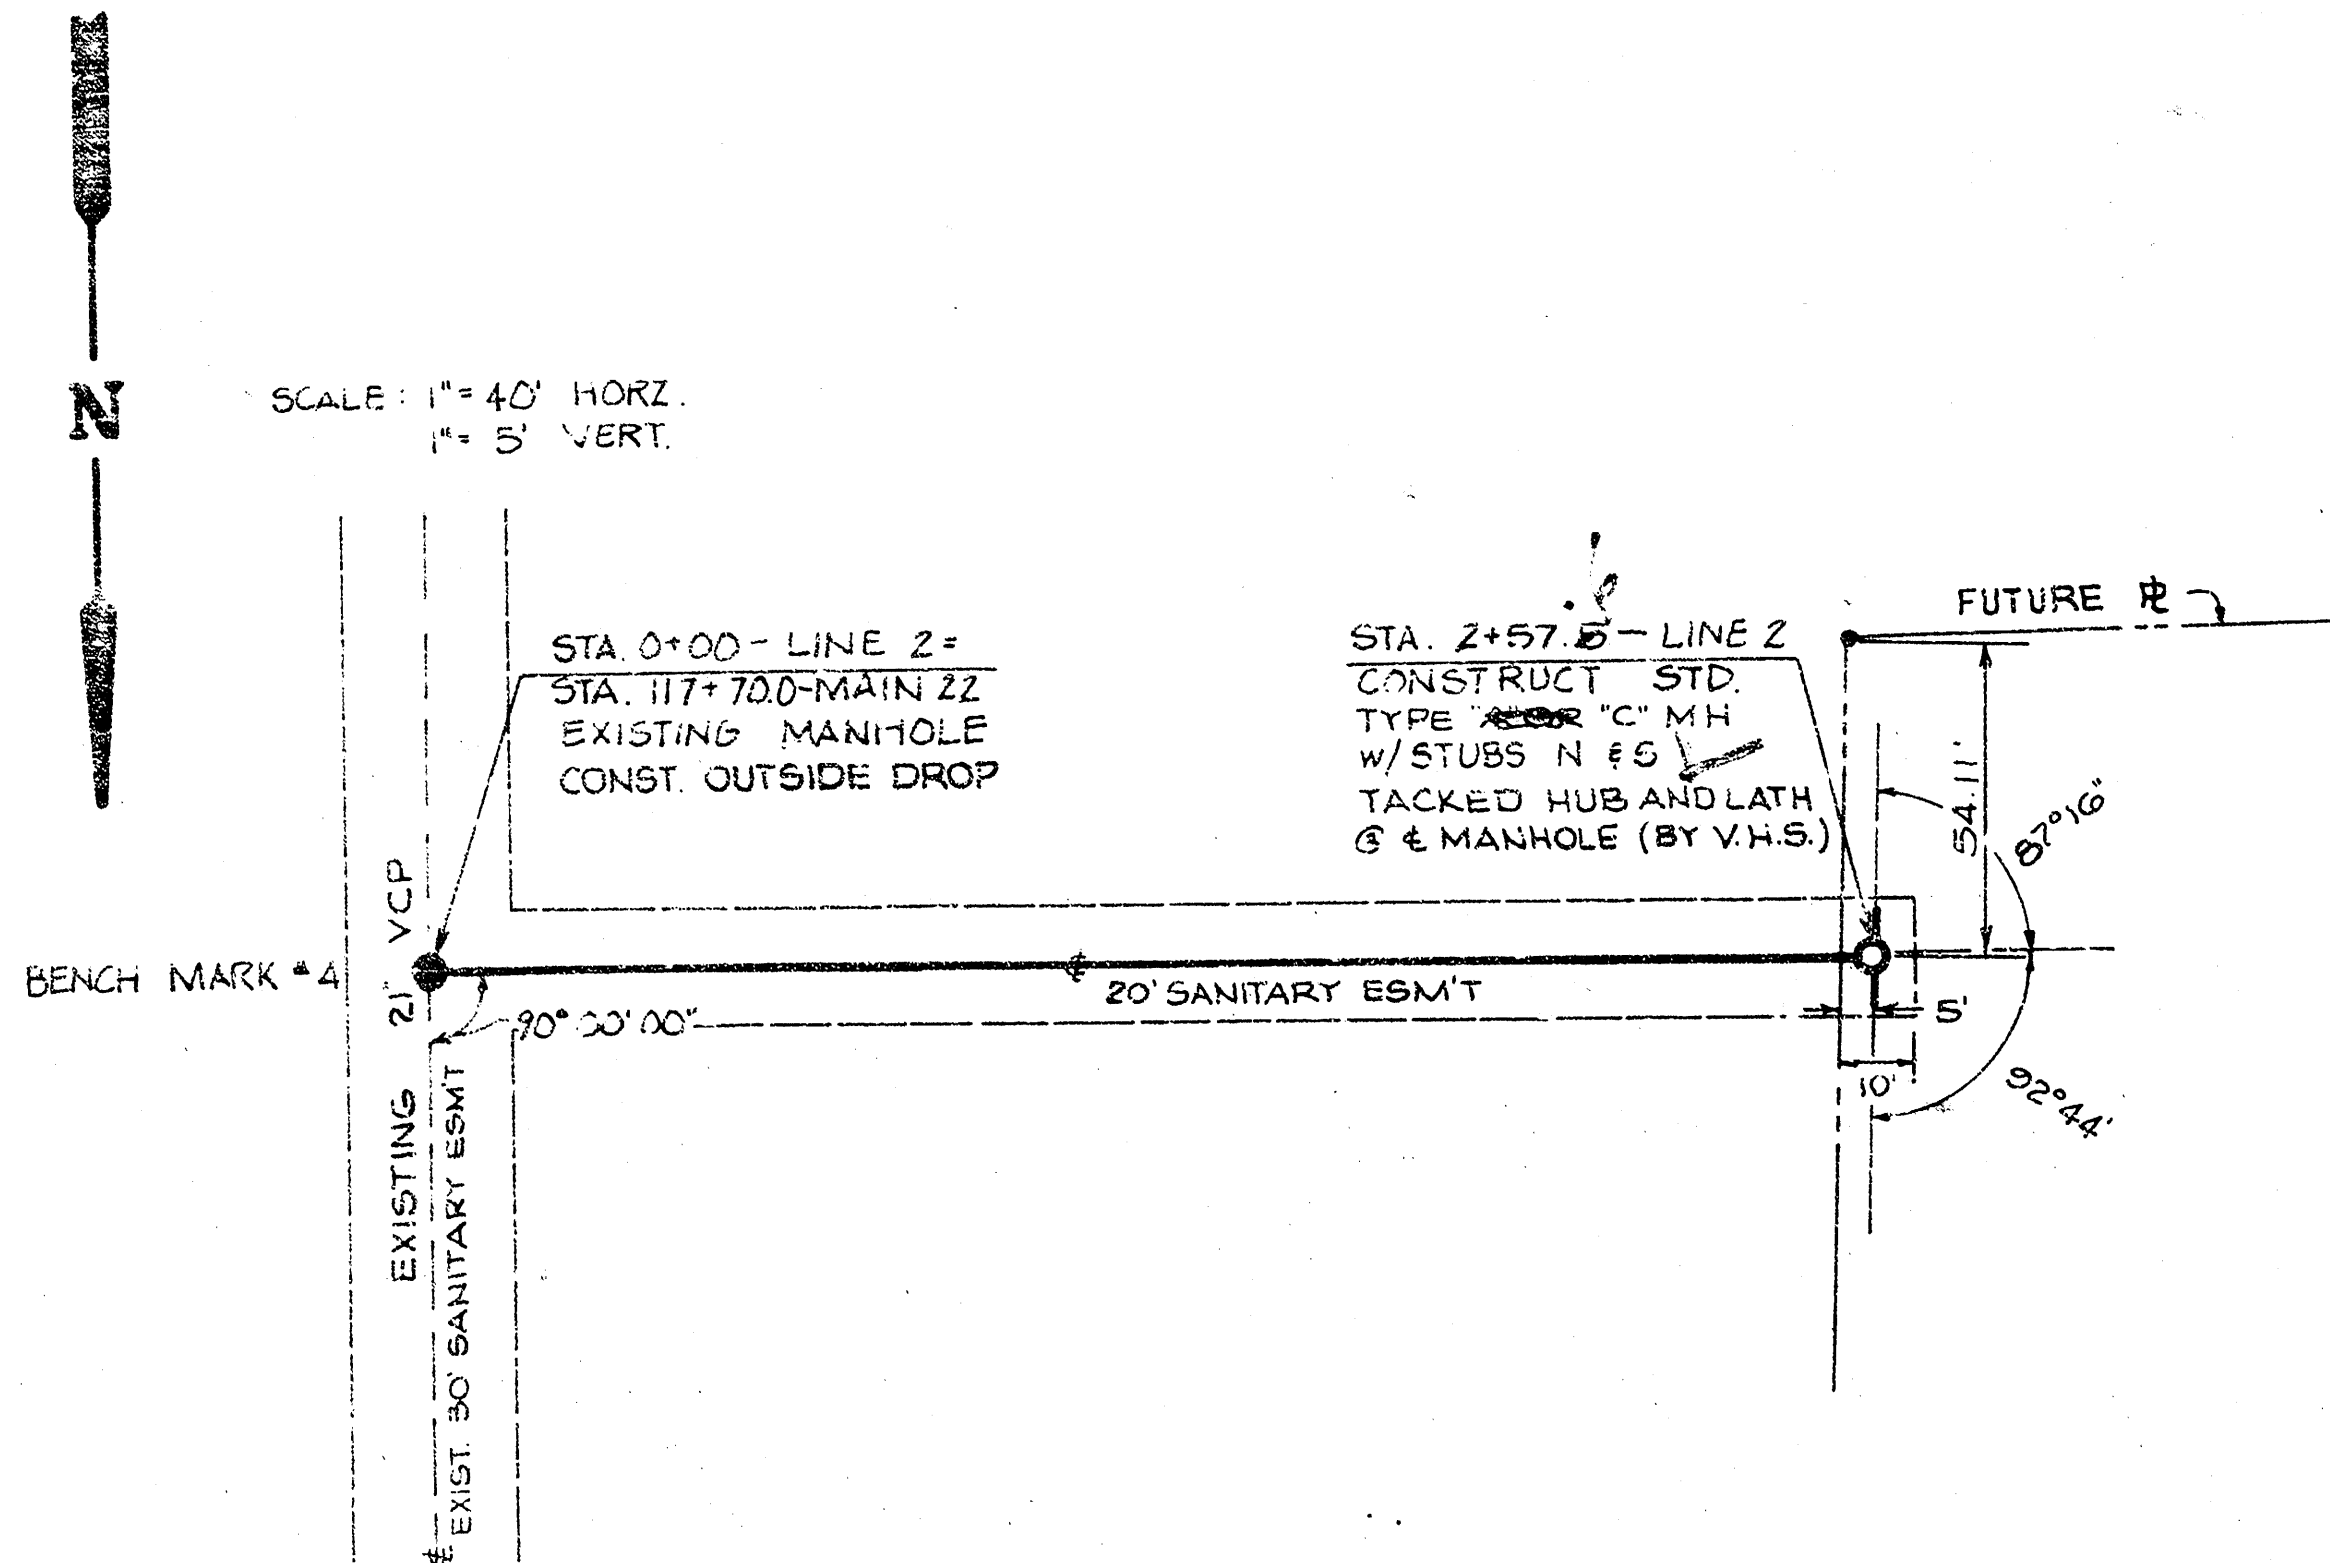

BENCH MARKS


BENCH MARK #4: SW MH
RIM STA. 117+70
ELEV. = 195.26

BENCH MARK #5: E RIM
MH. STA. 120+85
ELEV. = 198.38

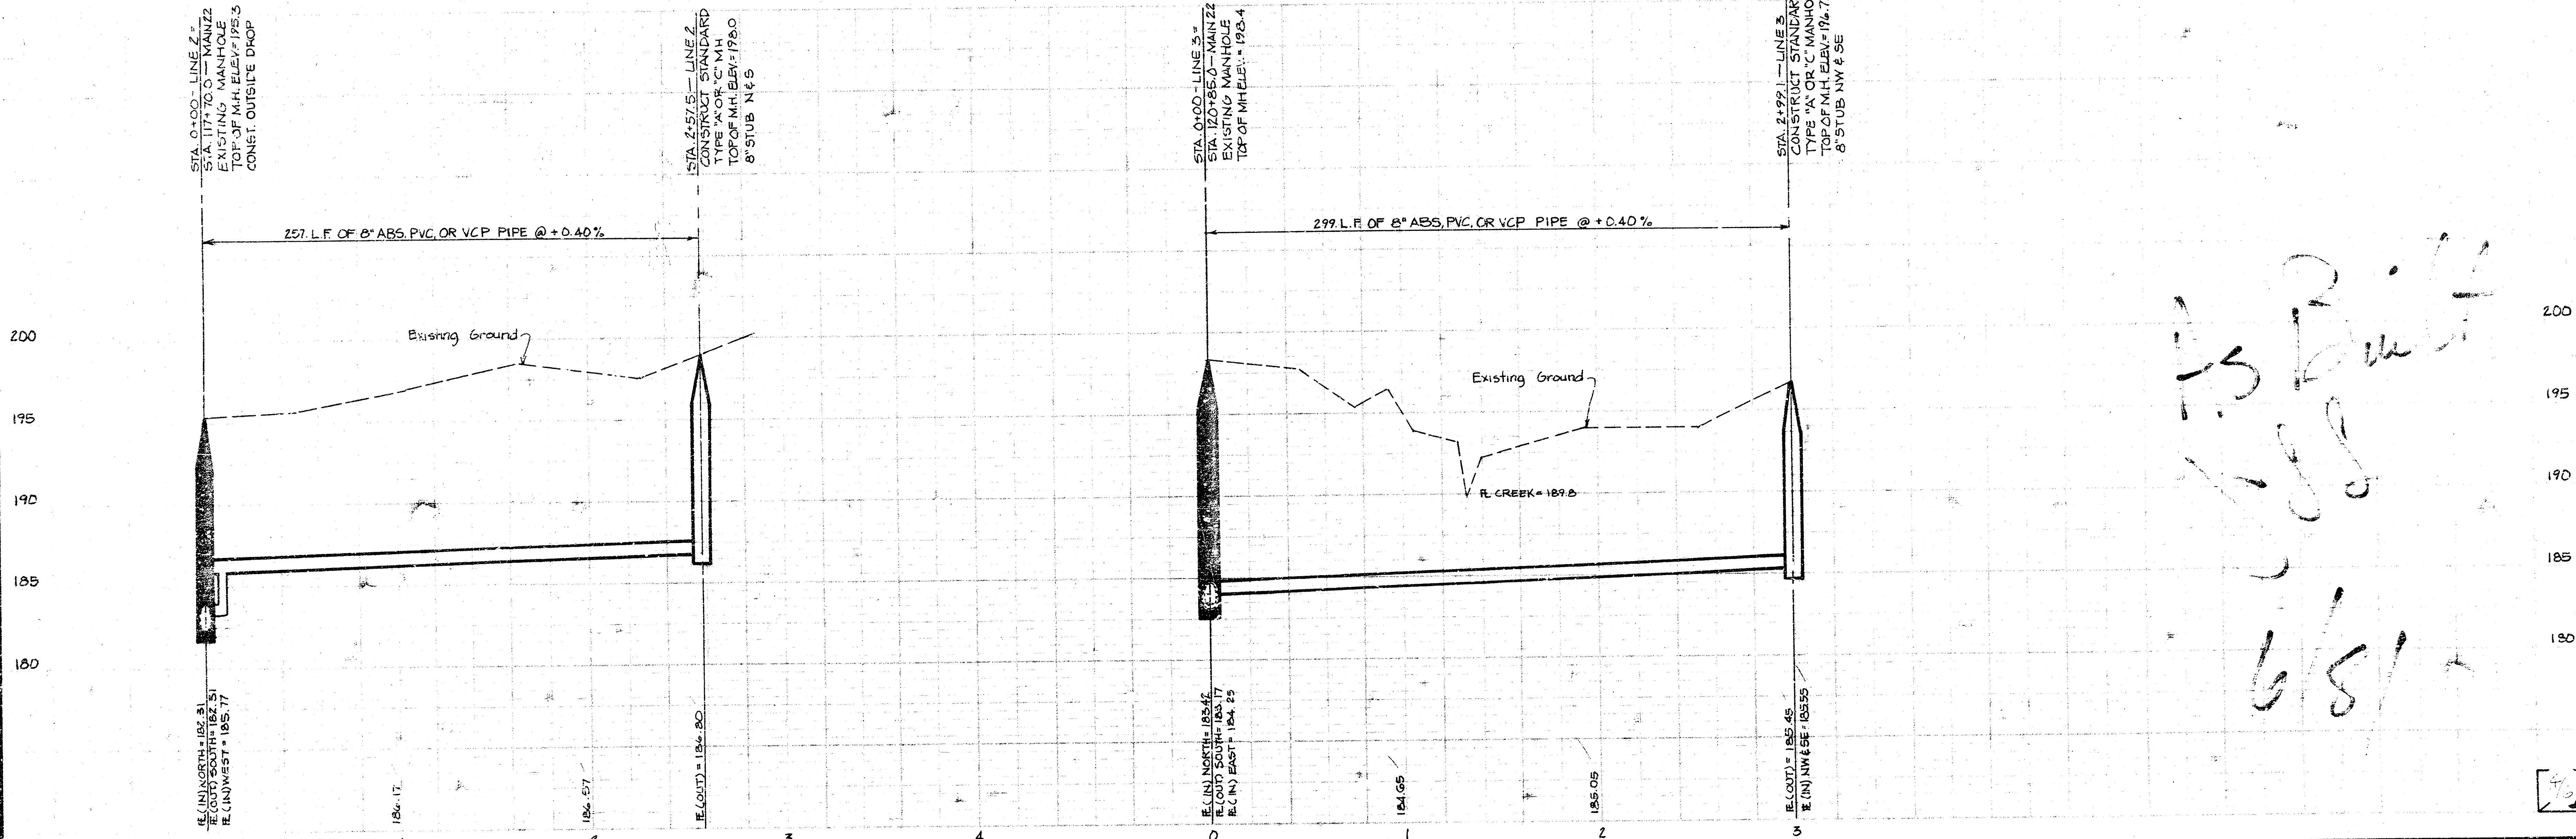


6/5/10

MAIN EXTENSION, MAIN 22, W.I.S.
468-76-245-80971 000-000-001

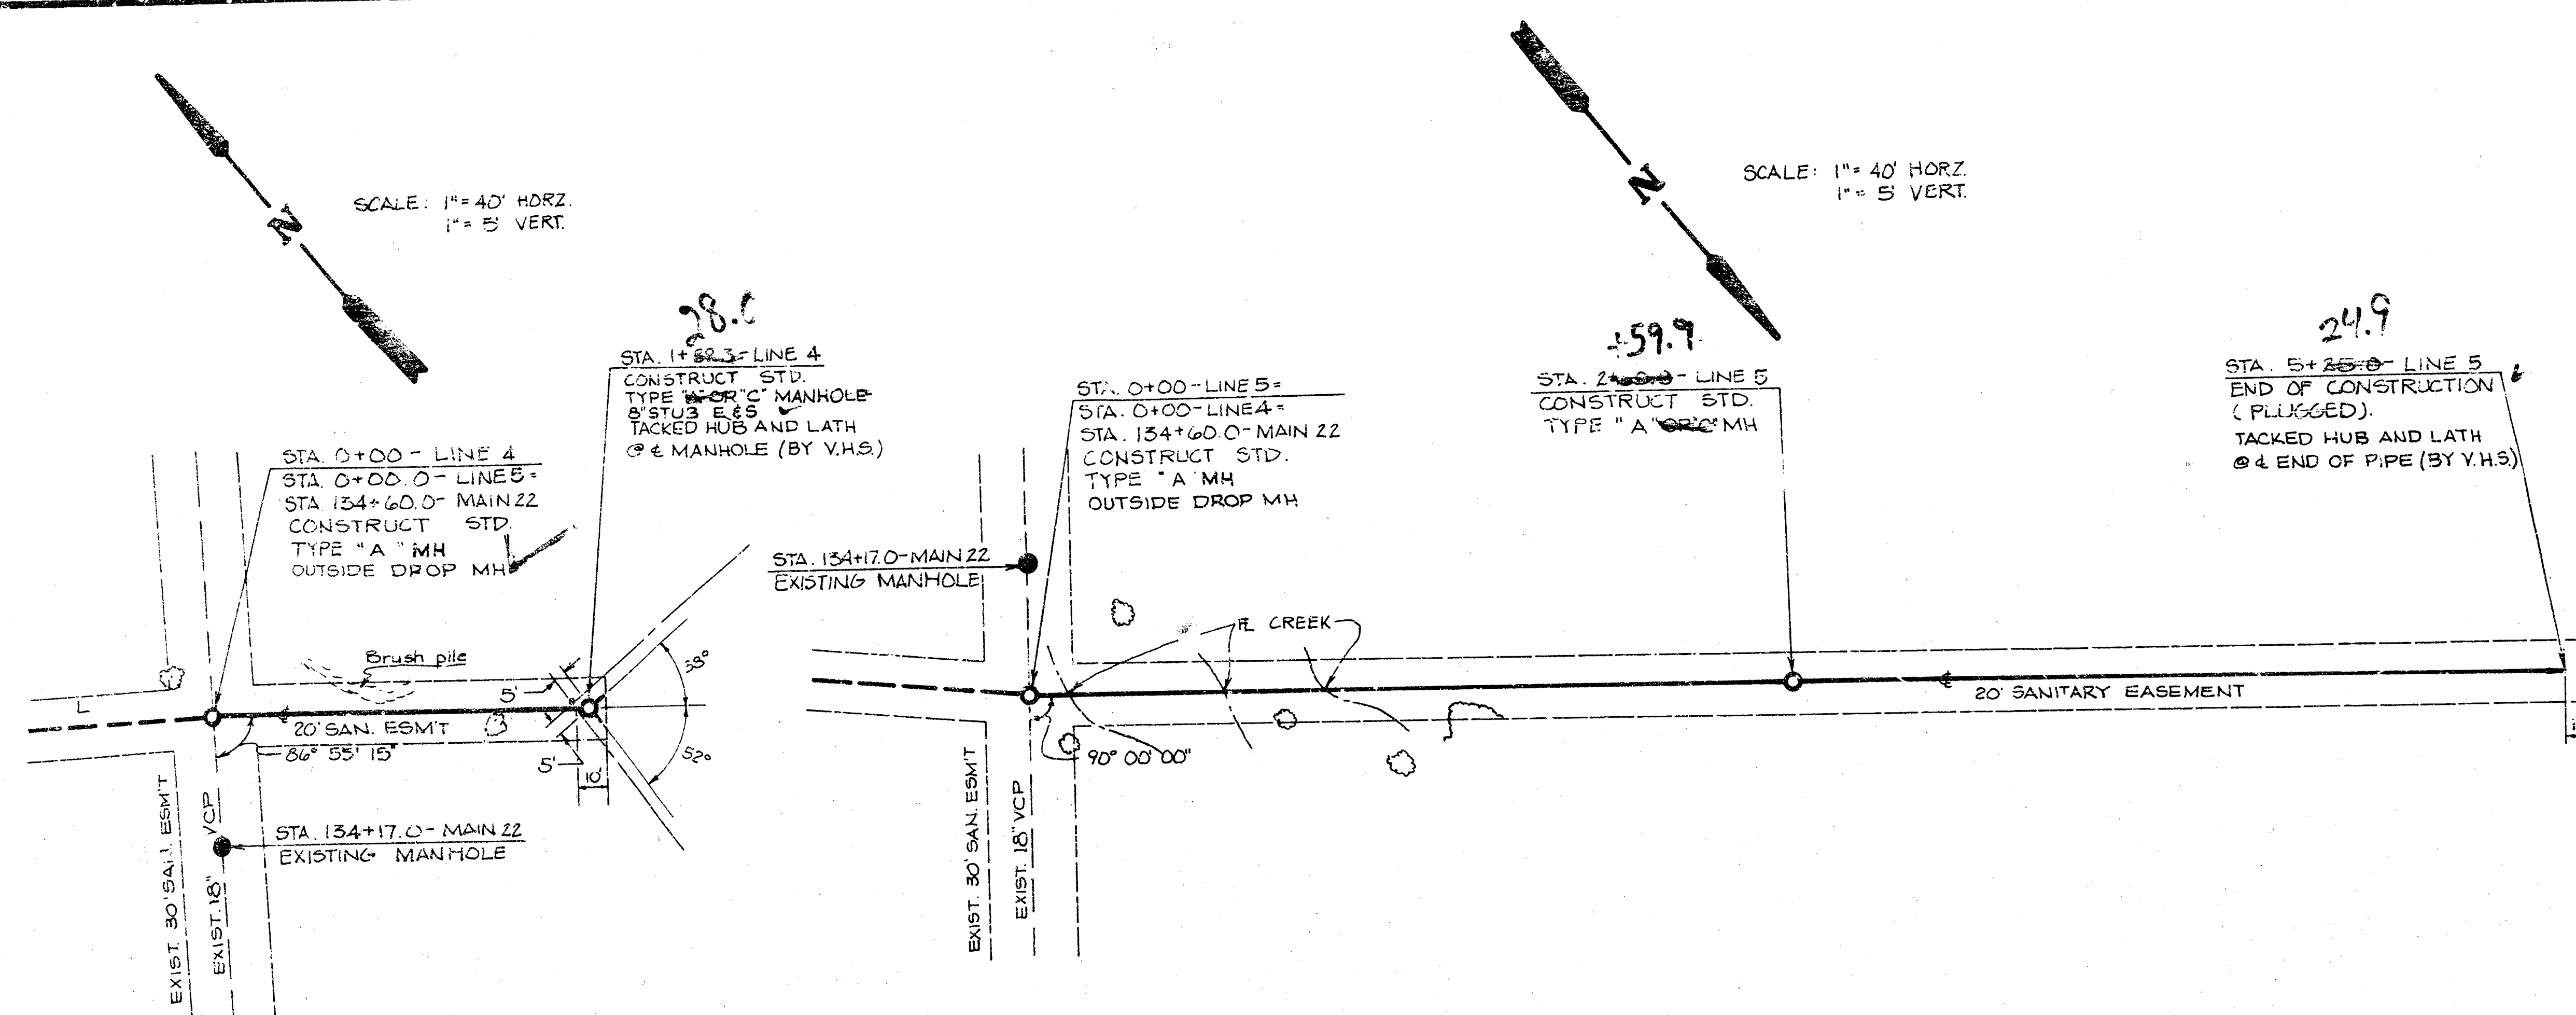


BENCH MARKS:

BENCH MARK # 6: BENT SPIKE
W. ROOT 25" HEDGE 139+72
50' RT. MAIN 22.
ELEV. = 2' 9.06

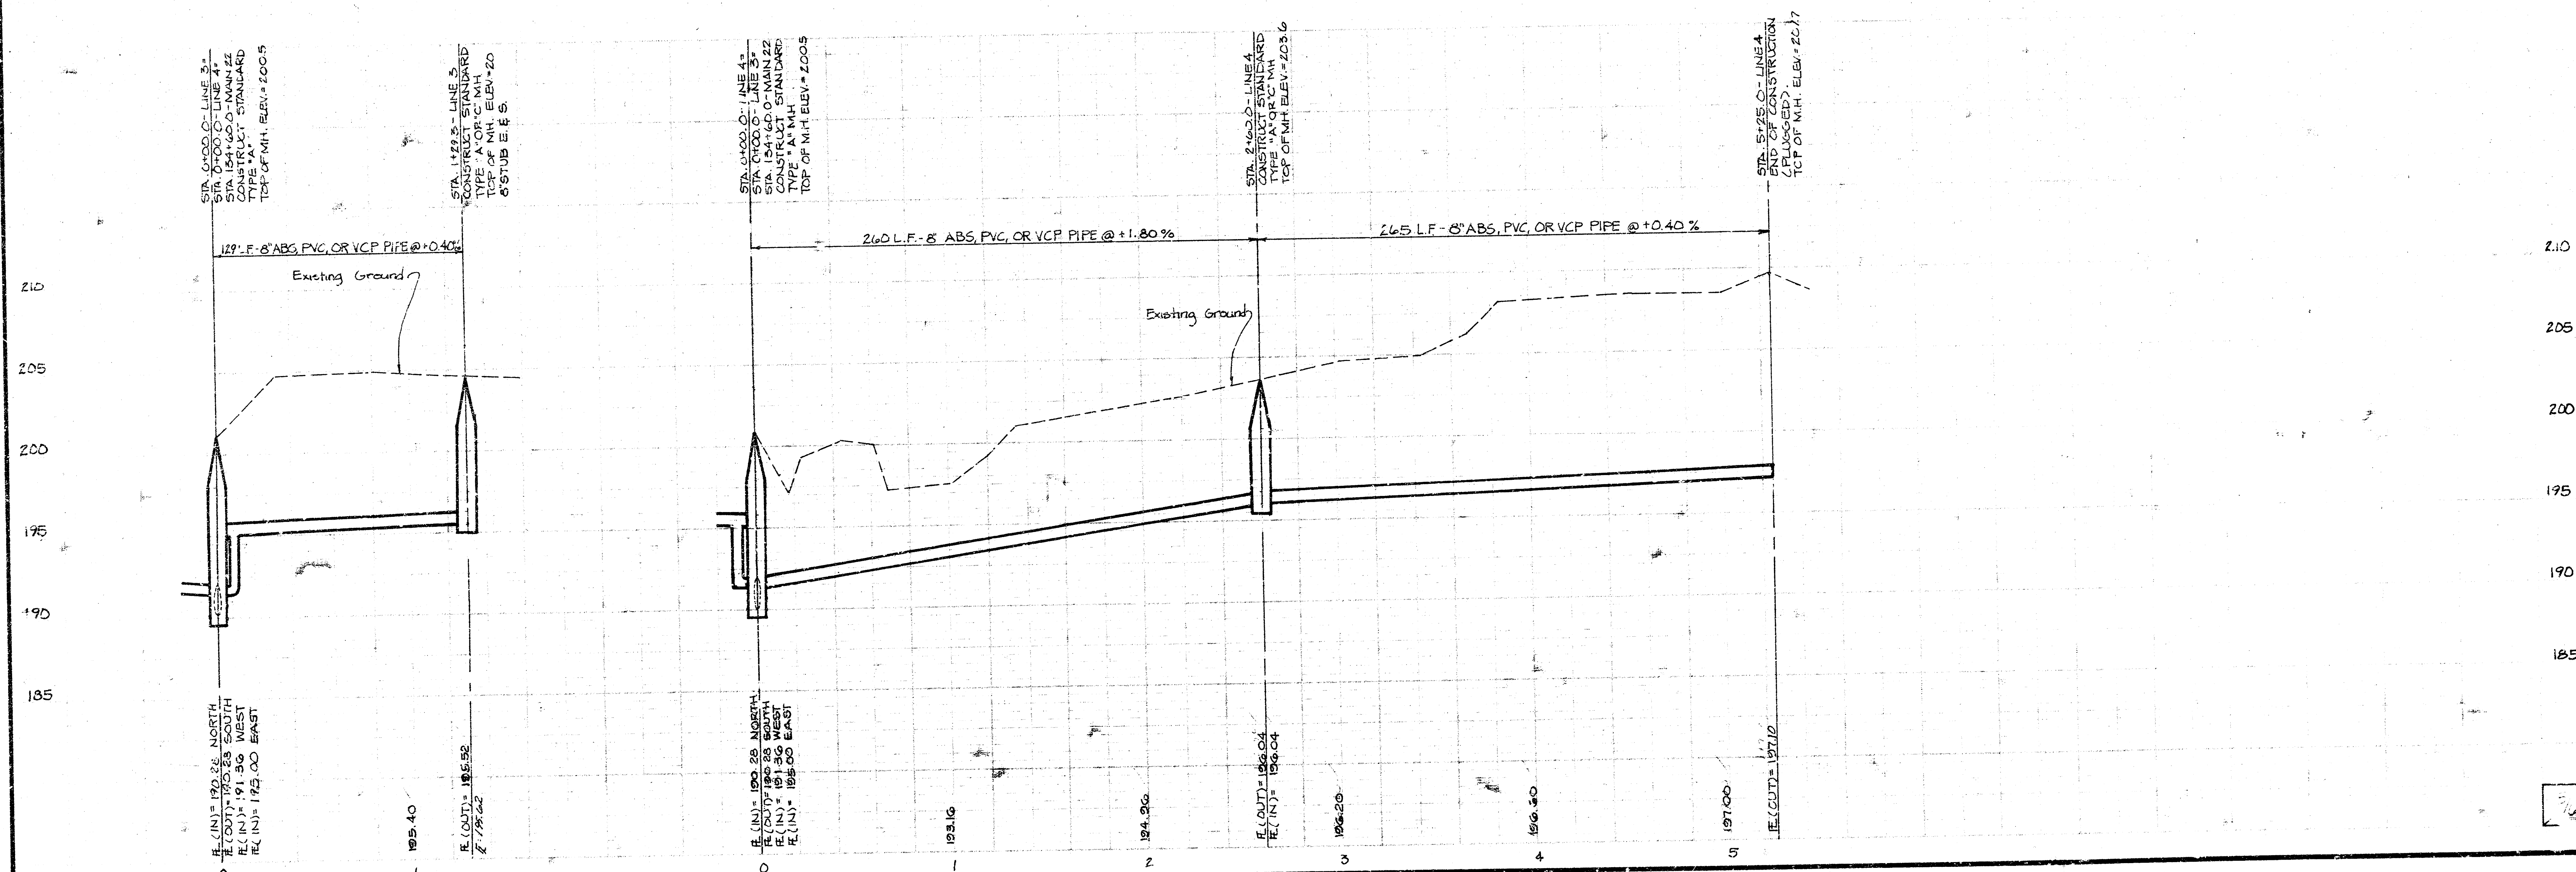


MAIN EXTENSION, MAIN 22, W.I.S.
468-76-245 80971 000-000-001

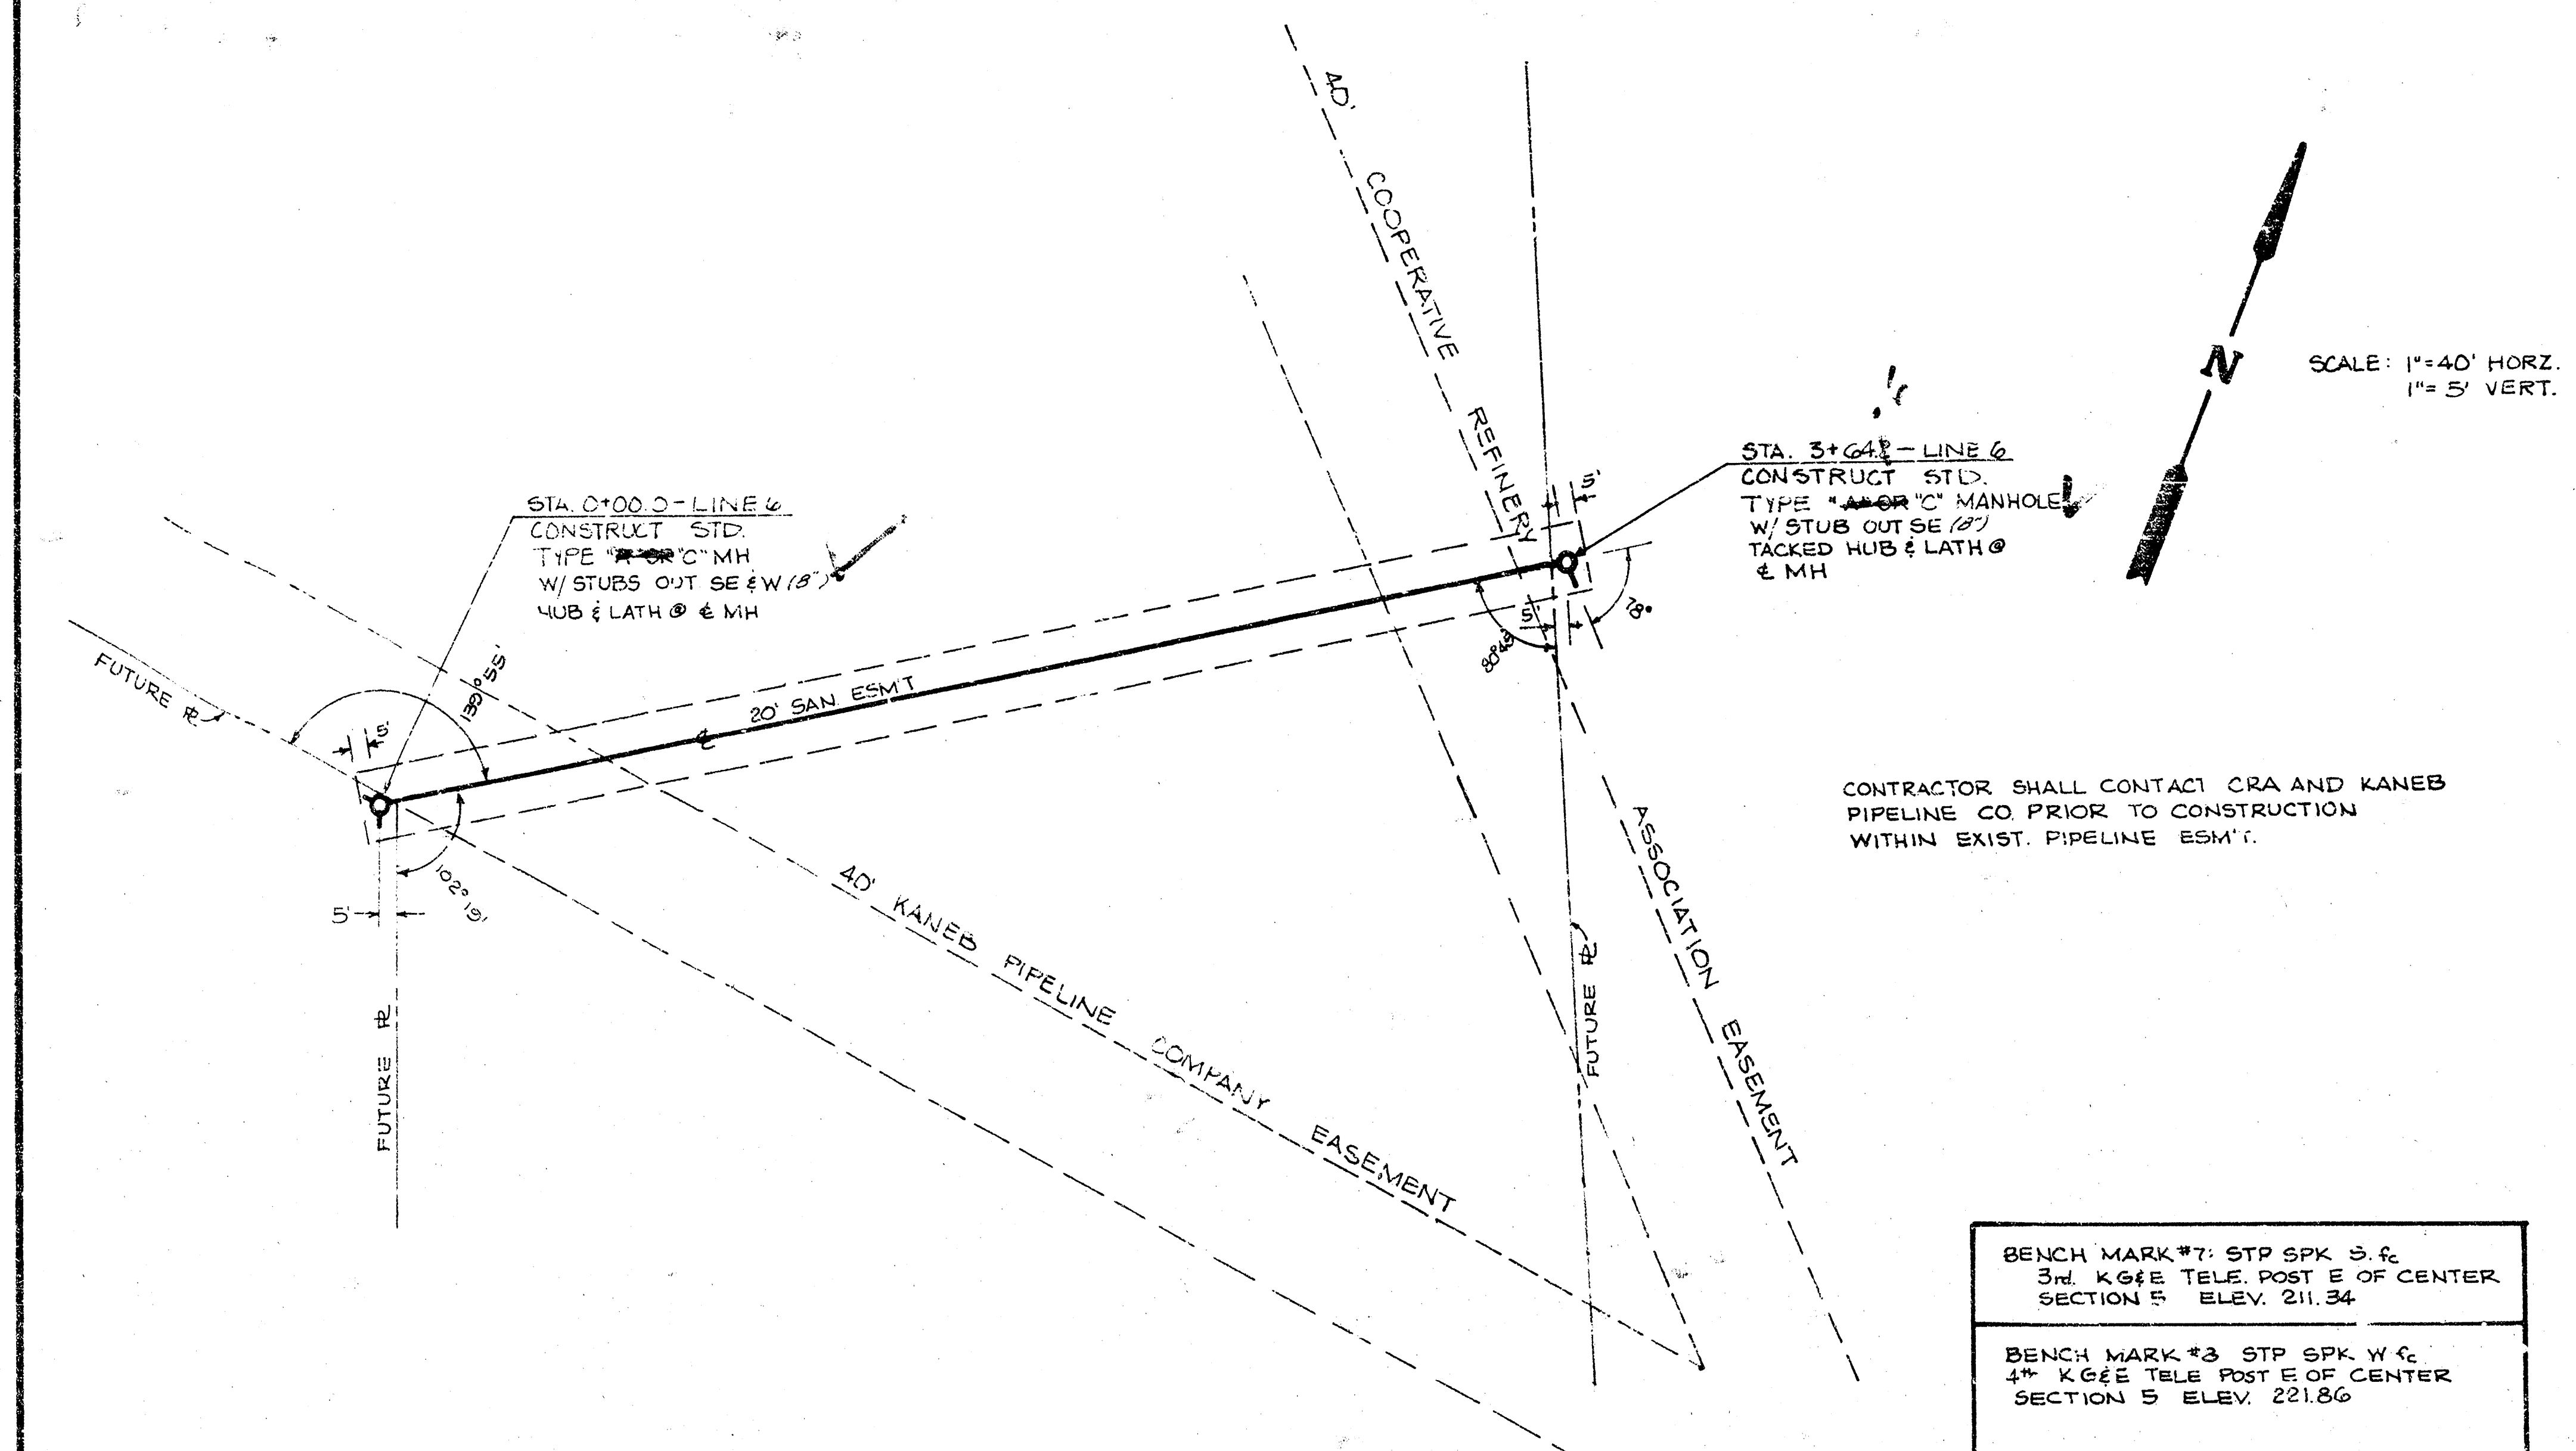

BENCH MARK #1: STP SPK S & S
3rd K&E TELE POST E OF CENTER
SECTION 5 ELEV. 211.34

BENCH MARK #3: STP SPK W & C
4th K&E TELE POST E OF CENTER
SECTION 5 ELEV. 221.86

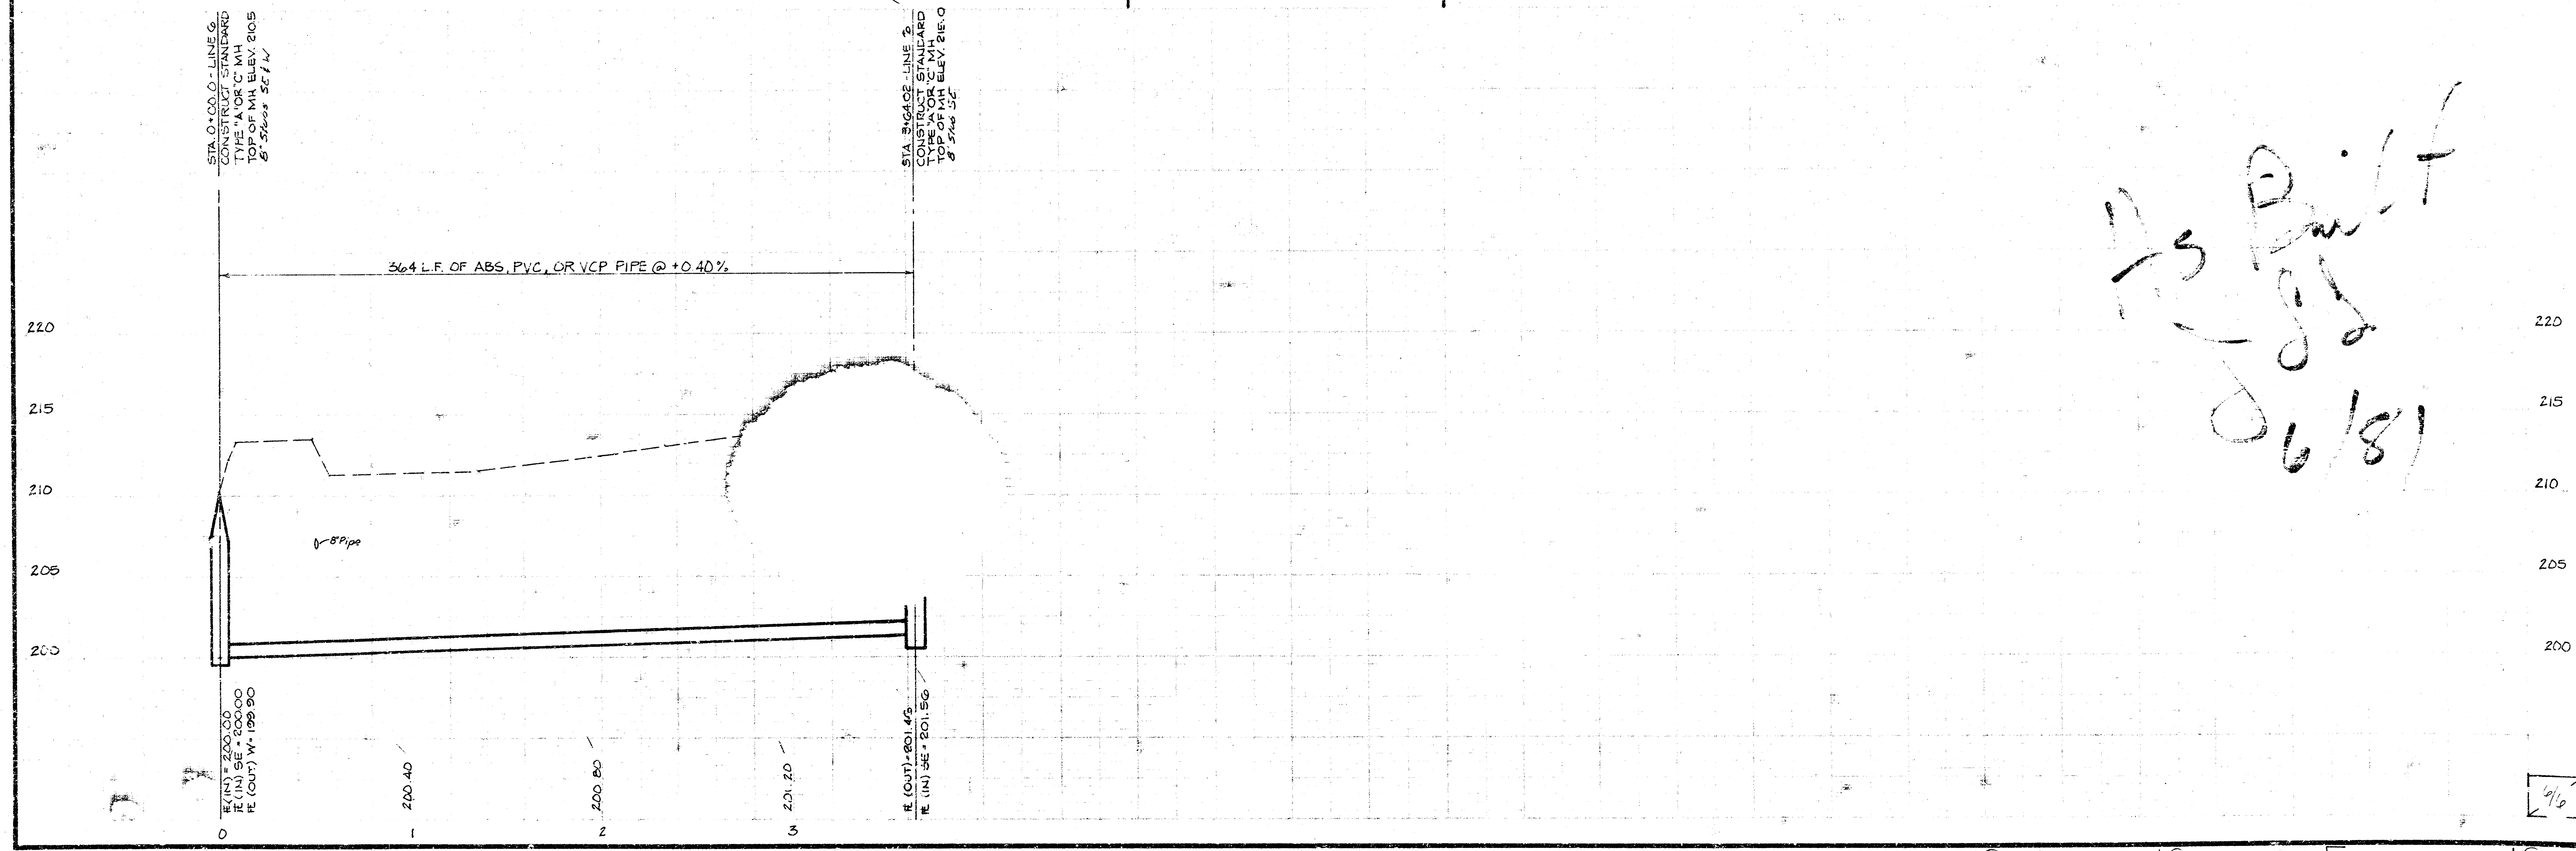

As Built
6/81

4/6