


LATERAL 17, MAIN 22, W.I.S.


PROJECT NO.

468-76-245-81180-000-000-001

CITY OF WICHITA, KANSAS
R.W. BRUGGMAN, CITY ENGINEER

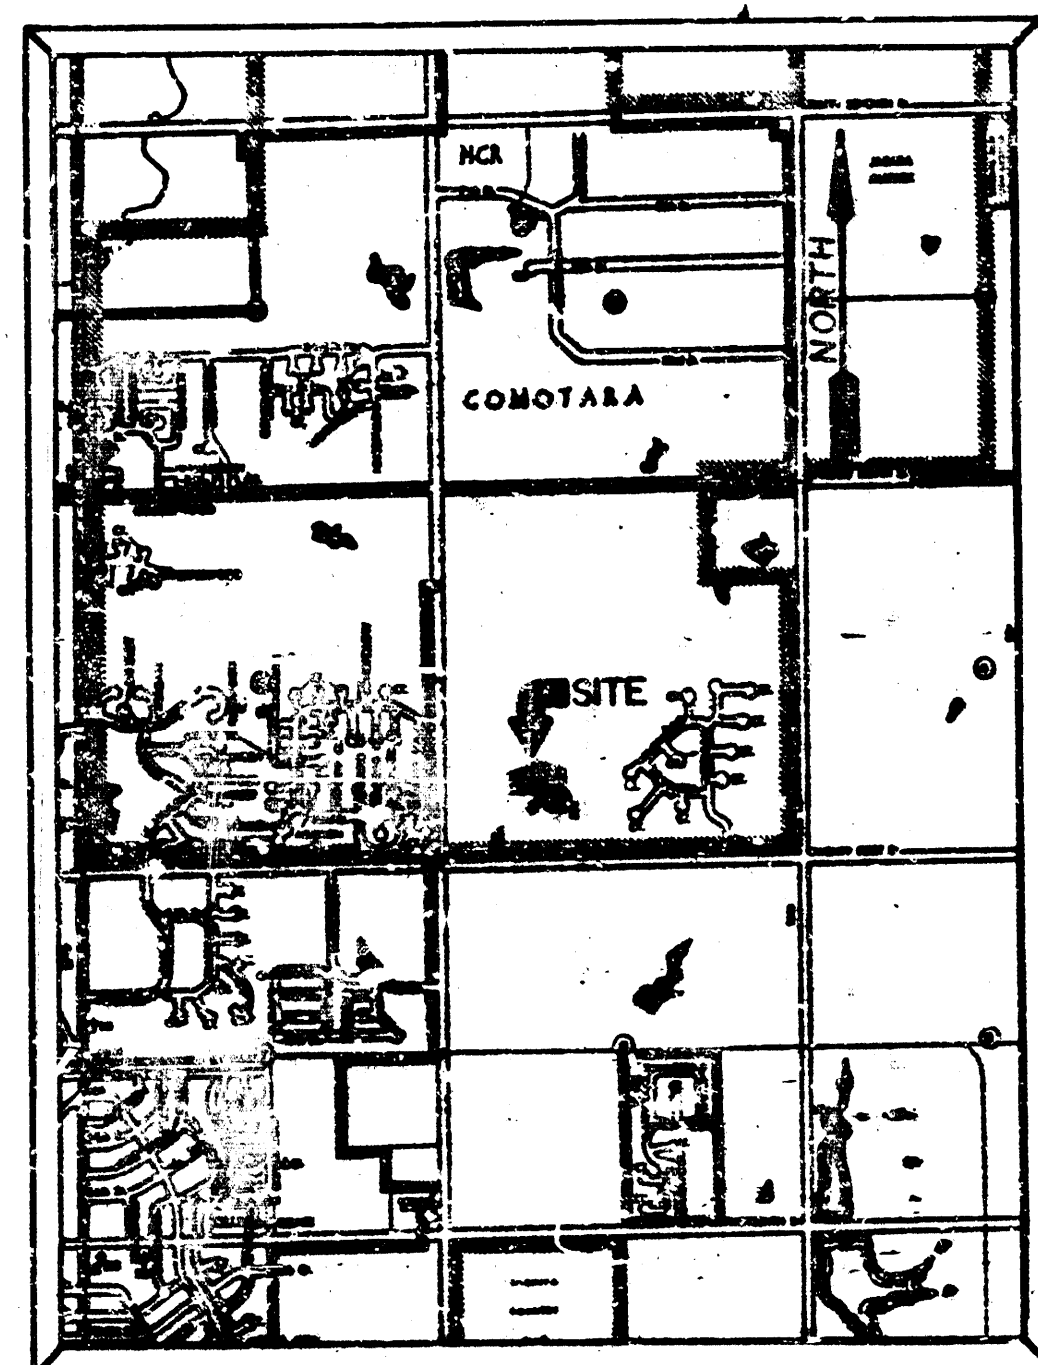

VICINITY MAP

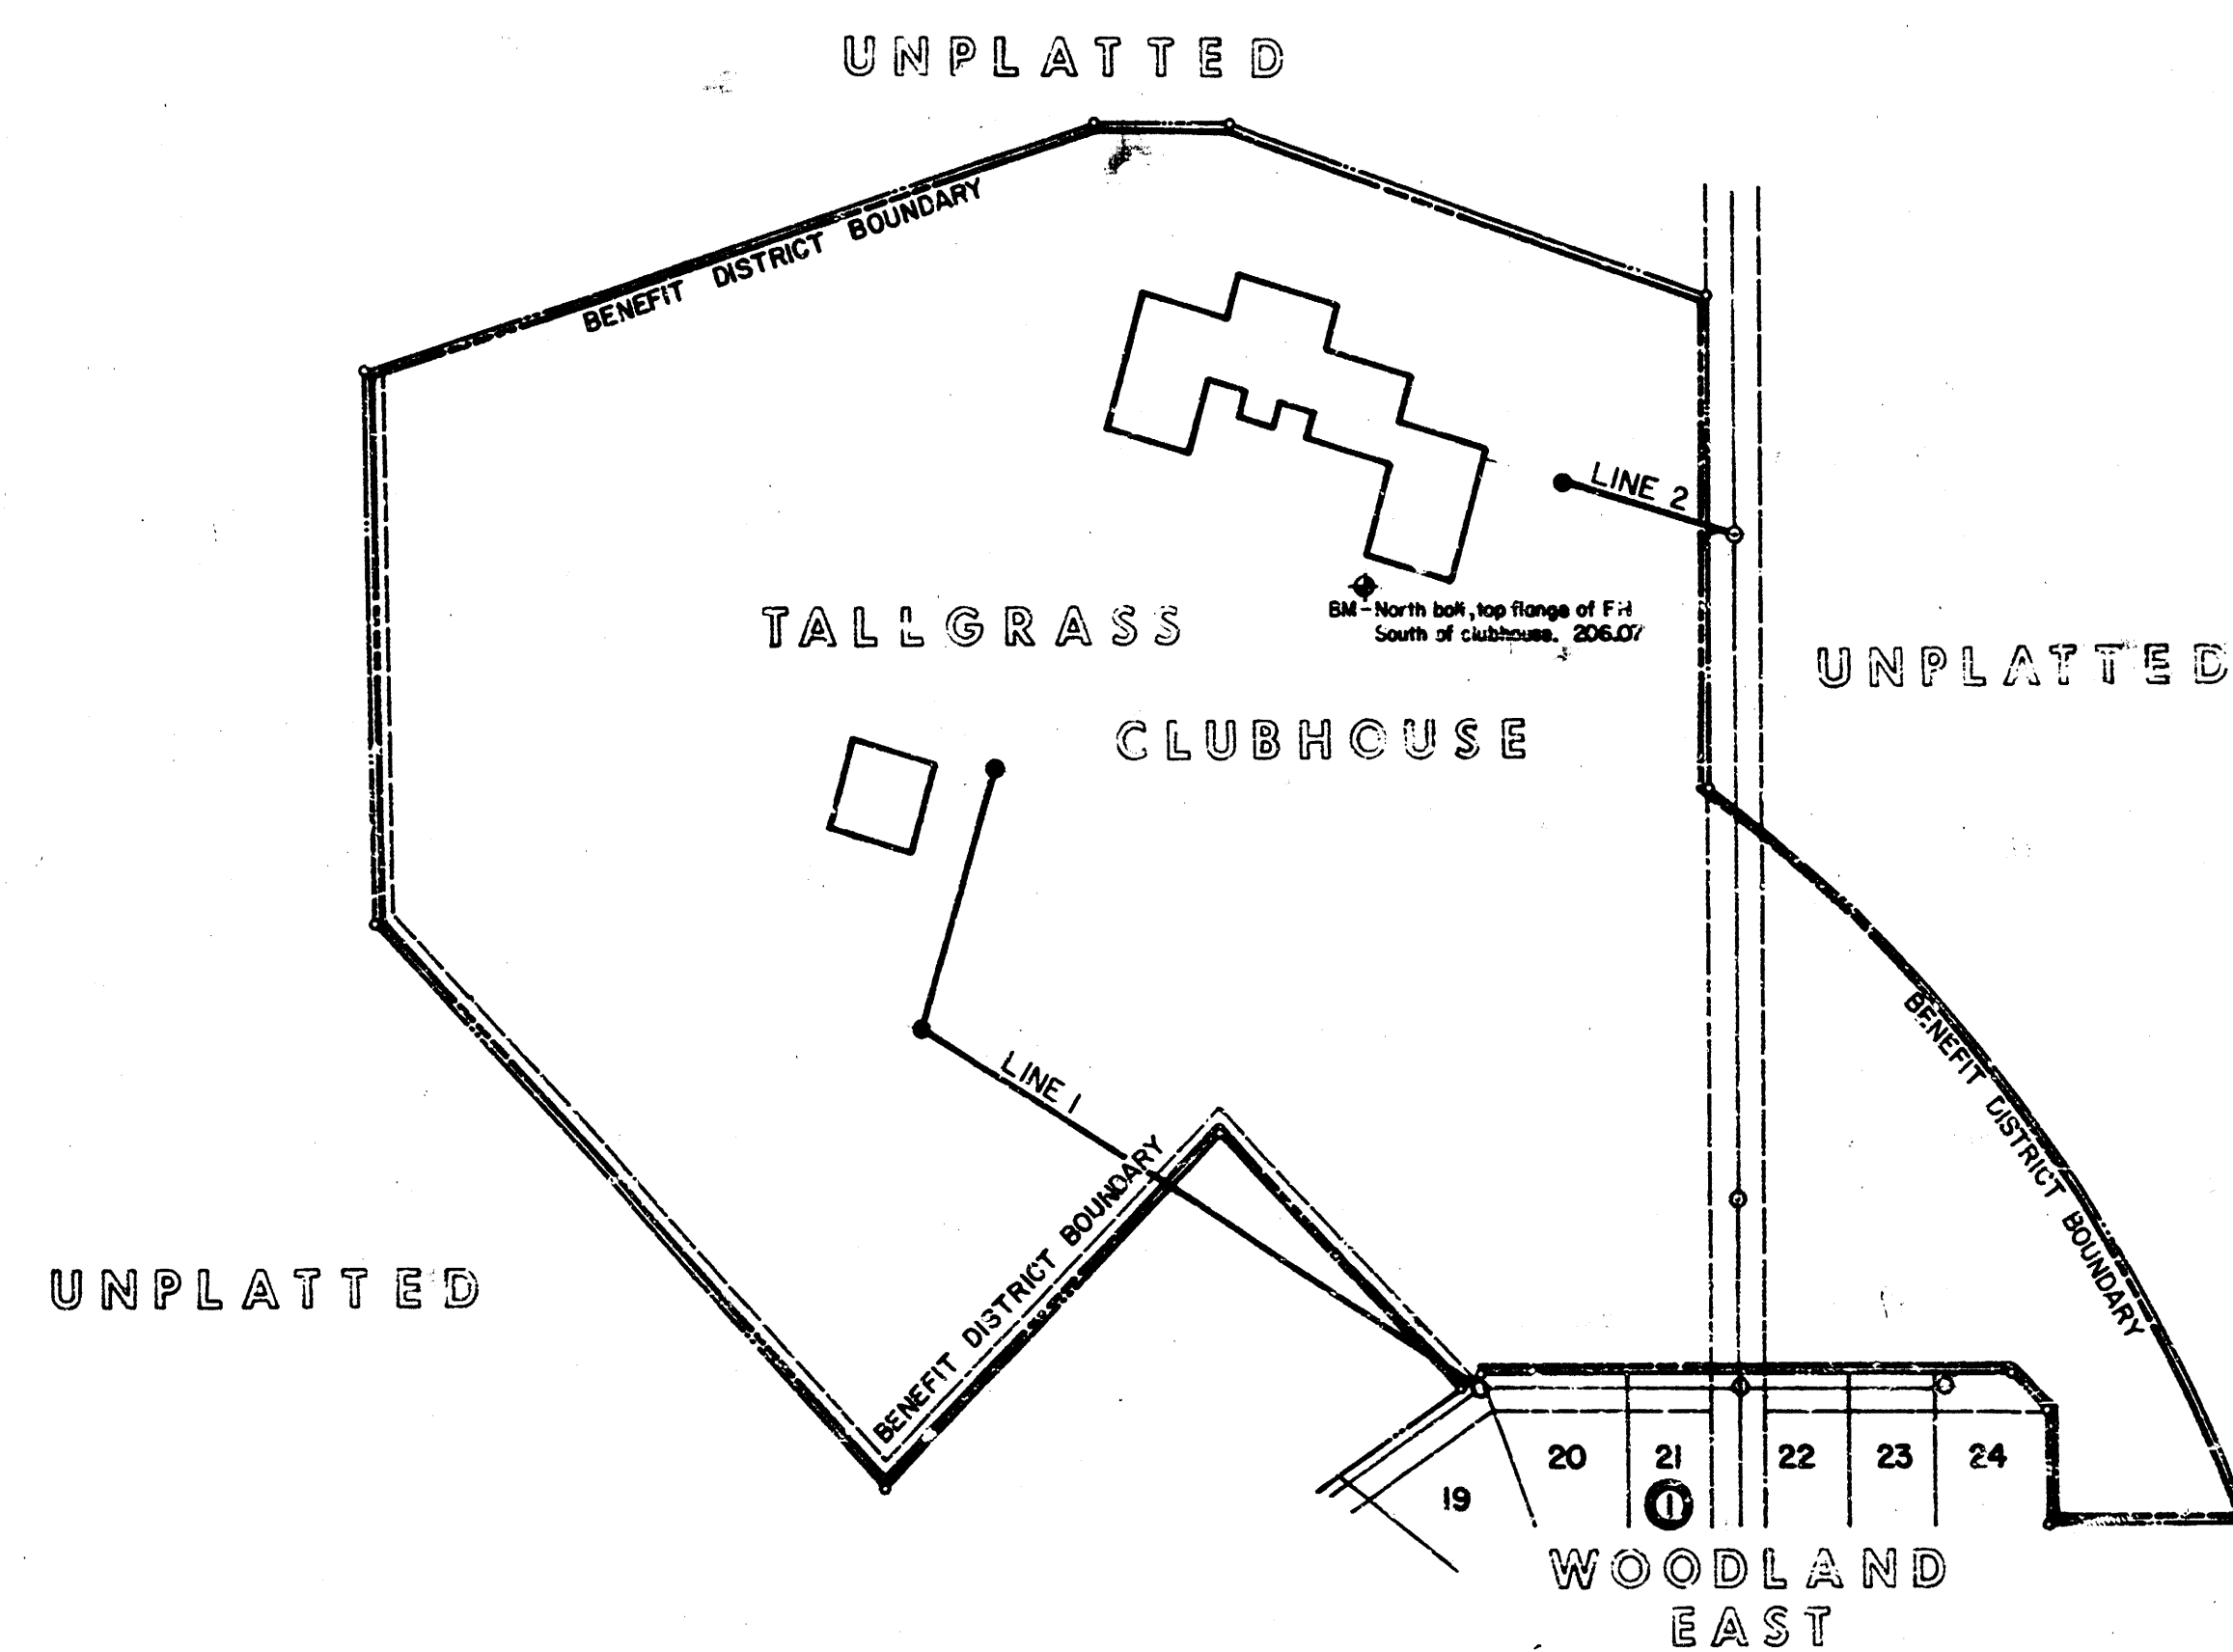

As Built
5-11
9-82

INDEX TO DRAWINGS

SHEET NO.	DESCRIPTION
1.	TITLE SHEET
2.	PLAN & PROFILE
3.	RISER DETAILS
4&5.	FLATS


NOTES

- Riser pipe shall be installed to serve individual lots or tracts in conjunction with new sanitary sewer construction, unless otherwise ordered by the Engineer, because of ground water, unstable soil or unusually deep construction. Riser locations shall be as approved by the property owner with the concurrence of the Engineer. Installation of risers on sewers because of unusual depth will be required when the sewer is deeper than twelve feet (12'). The Contractor will be required to file written documentation with the Engineer in a form approved by the Engineer indicating the locations where risers are to be installed as requested by the property owner or his authorized representative. Riser pipe construction shall conform to the requirements as shown on the standard riser detail sheet.
- The contractor shall be responsible for preserving property irons. The contractor shall be required to re-establish any property irons which are damaged or destroyed by his construction operations. Such irons shall be re-established by a licensed land surveyor or a licensed professional engineer in accordance with state laws.



April 6, 1982 - Revised location Line 1



Van Doren Hazard Stallings
Architects-Engineers-Planners
Topeka-Wichita-Minneapolis-Kansas City

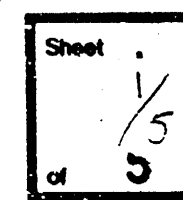

LATERAL 17, MAIN 22, W.I.S.
PROJECT NO.
468-76-245-81180-000-000-001

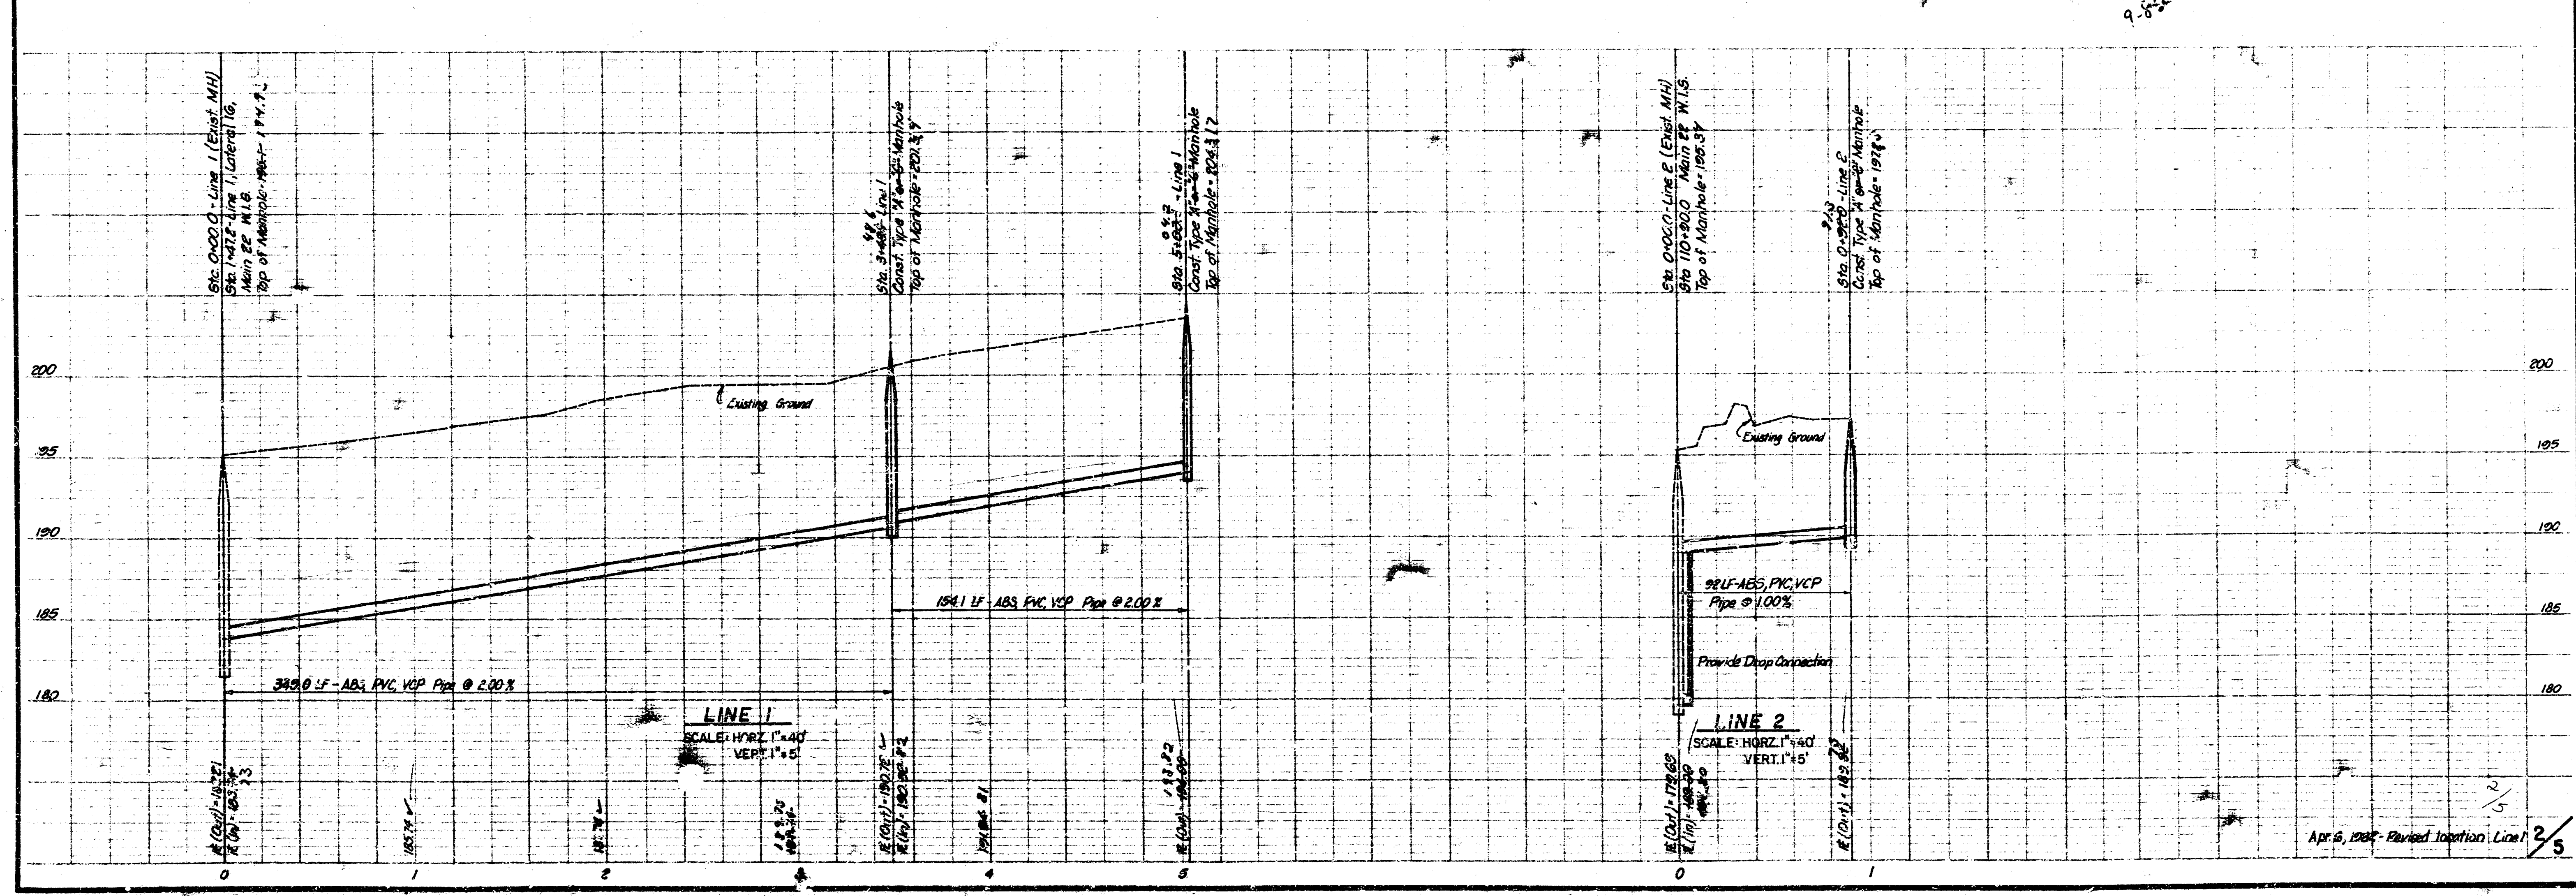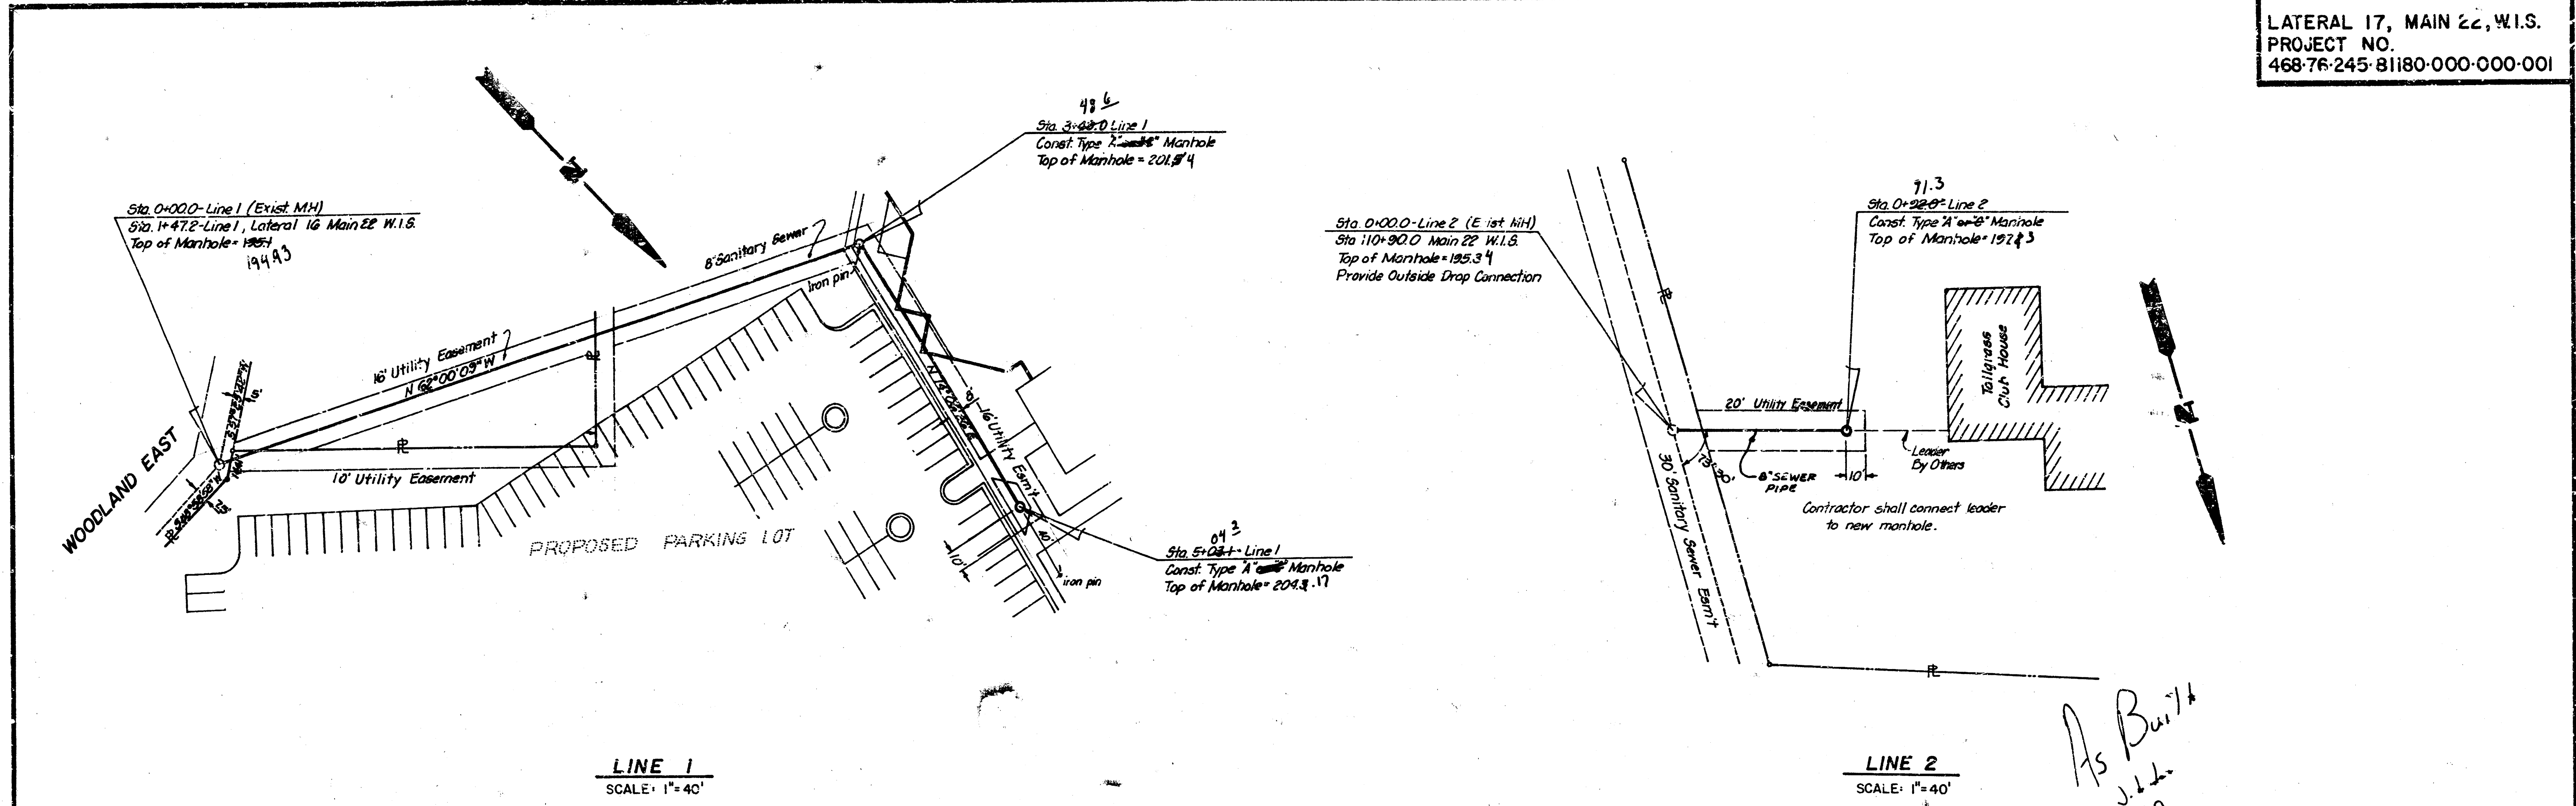

Apr. 8, 1987 - Revised Station Line 1

FILMED FROM THE...

CITY OF WICHITA, KANSAS



NOTE:
TOP OF 4" OR 6" RISER PIPE TO BE
EXTENDED TO AN ELEVATION OF 1 ft.
MINIMUM ABOVE THE WATER TABLE
ELEVATION, WHEN WATER EXISTS,
OR TO AN ELEVATION SUITABLE FOR
PROVIDING SERVICE TO THE LOT TO
BE SERVED AND THEN PLUGGED.


REvised APRIL, 1980

CENTRAL NO. 1

[illegible]

ERECTING AND INSTALLING RISERS SHALL BE PAID FOR AT THE UNIT PRICES BID FOR PIPE, 6" PIPE AND REINFORCED CONCRETE ENCASEMENT FOR THE VARIOUS MAIN SEWER LINE SIZES INDICATED, WHICH PRICE SHALL INCLUDE ALL COSTS FOR COMPLETION OF THIS WORK INCLUDING SADDLES, SPANS, CONCRETE, REINFORCING STEEL, CAPS OR PLUGS, AND ALL OTHER NECESSARY MATERIALS OR WORK. CONCRETE ENCASEMENT OF THE RISER PIPE IN THE CASE OF THE SPAN AS SHOWN BY THE DRAWINGS WILL NOT BE PAID FOR DIRECTLY, AND THE COST FOR THIS WORK SHALL BE CONSIDERED AS NECESSARY TO THE OTHER ITEMS OF WORK.

THE PROJECT INSPECTOR SHALL REPORT ON INSPECTOR CARDS THE LOCATION OF ALL RISERS CONSTRUCTED AS MEASURED FROM THE NEAREST MANHOLE. THE DIRECTION OF SERVICE, THE ELEVATION OF THE TOP OF THE RISER AND THE PAY QUANTITIES INVOLVED. THE PROJECT INSPECTOR SHALL ALSO RETURN ON INSPECTOR CARDS THE LOCATION, DIRECTION OF SERVICE, AND SIZE OF ALL STIES INSTALLED IN MANHOLES.


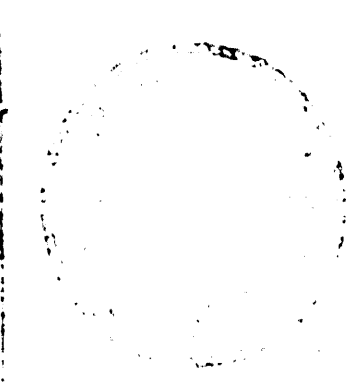


RECEIVED
JAN 10 1968
COUNTY CLERK
MICHIGAN

NOTICE TO THE PUBLIC: This is to certify that the within and foregoing plat of land, containing 11.29 acres, more or less, is a true and correct copy of the original plat on file in the office of the County Clerk of Michigan, and that the same has been duly recorded in the public records of said County, and that the same is now a part of the public records of said County.

NOTICE TO THE PUBLIC: This is to certify that the within and foregoing plat of land, containing 11.29 acres, more or less, is a true and correct copy of the original plat on file in the office of the County Clerk of Michigan, and that the same has been duly recorded in the public records of said County, and that the same is now a part of the public records of said County.

NOTICE TO THE PUBLIC: This is to certify that the within and foregoing plat of land, containing 11.29 acres, more or less, is a true and correct copy of the original plat on file in the office of the County Clerk of Michigan, and that the same has been duly recorded in the public records of said County, and that the same is now a part of the public records of said County.

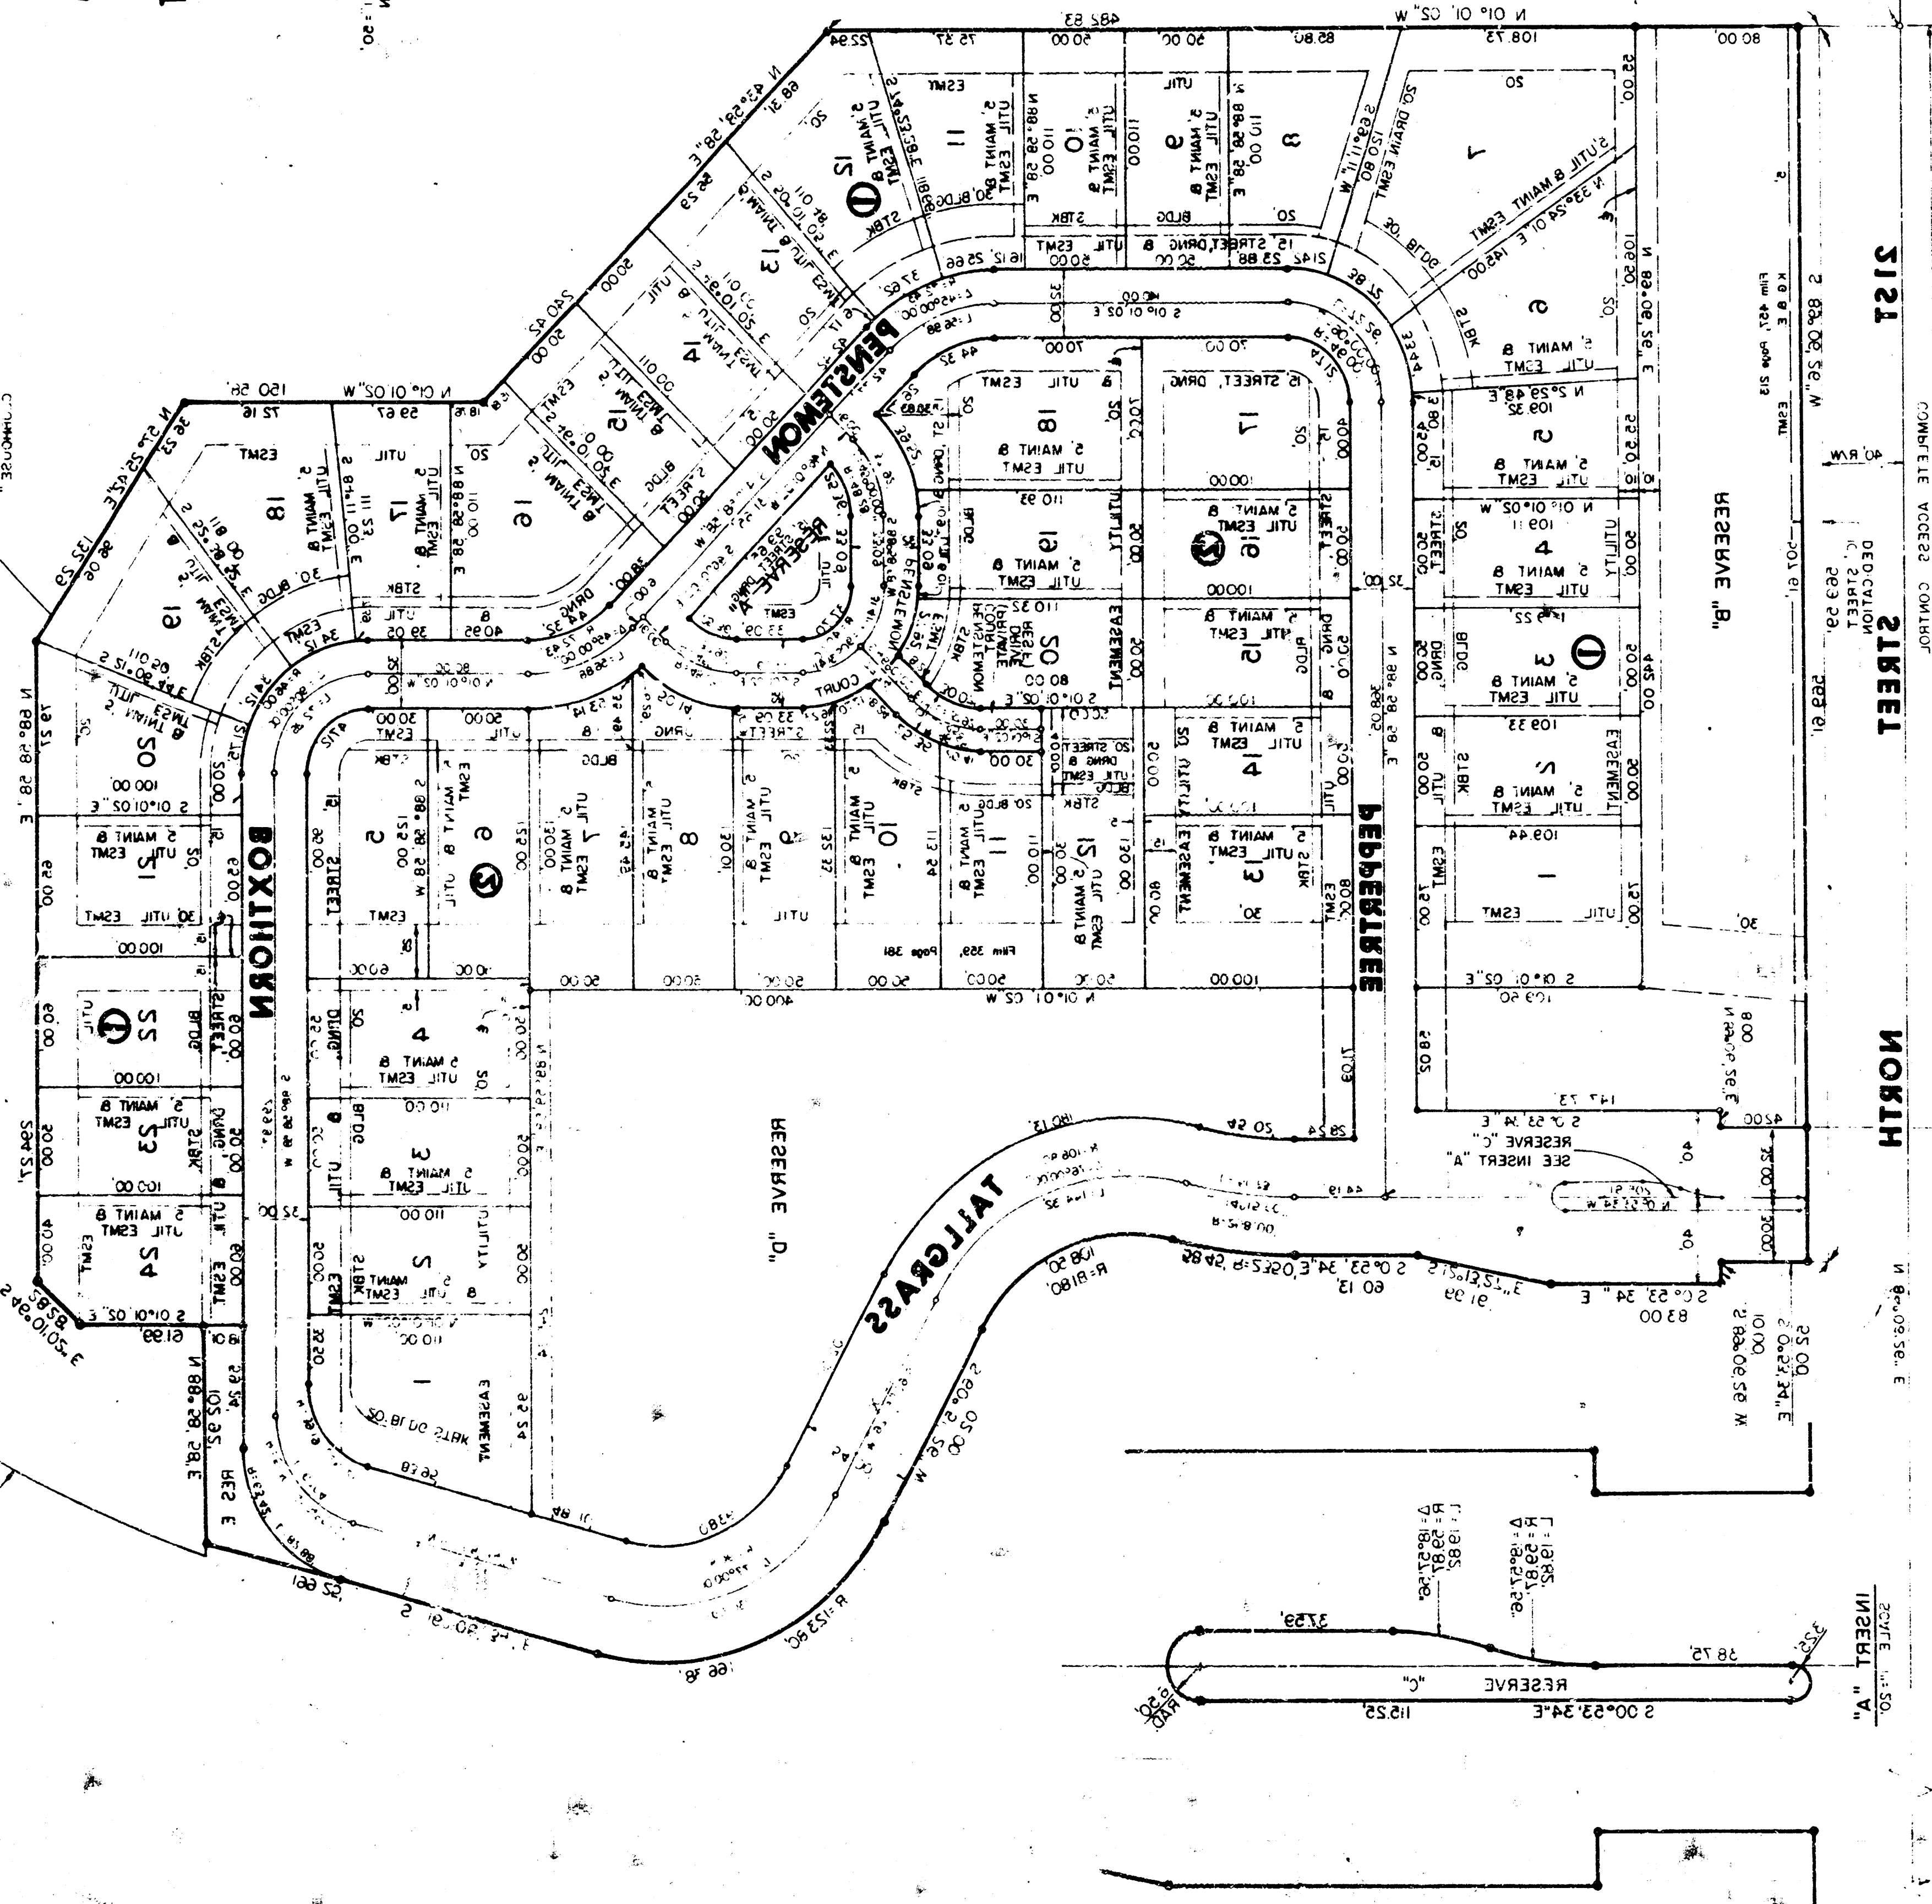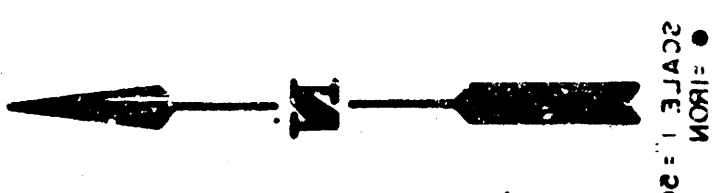

AN ADDITION TO MICHIGAN, SEDGWICK COUNTY, KANSAS
WOODLANDS EAST
FINAL PLAT OF