


# WOODSPRING

## LATERAL 20, MAIN 22, W.I.S.

PROJECT NO.  
468-76-245-81269-000-000-001

CITY OF WICHITA, KANSAS  
R.W. BRUGGEMAN, CITY ENGINEER  
MAY, 1983

CAUTION: High pressure KANER pipeline. Contact  
24 hours prior to excavation. Call Jim Strickland  
at 1-316-262-1408.

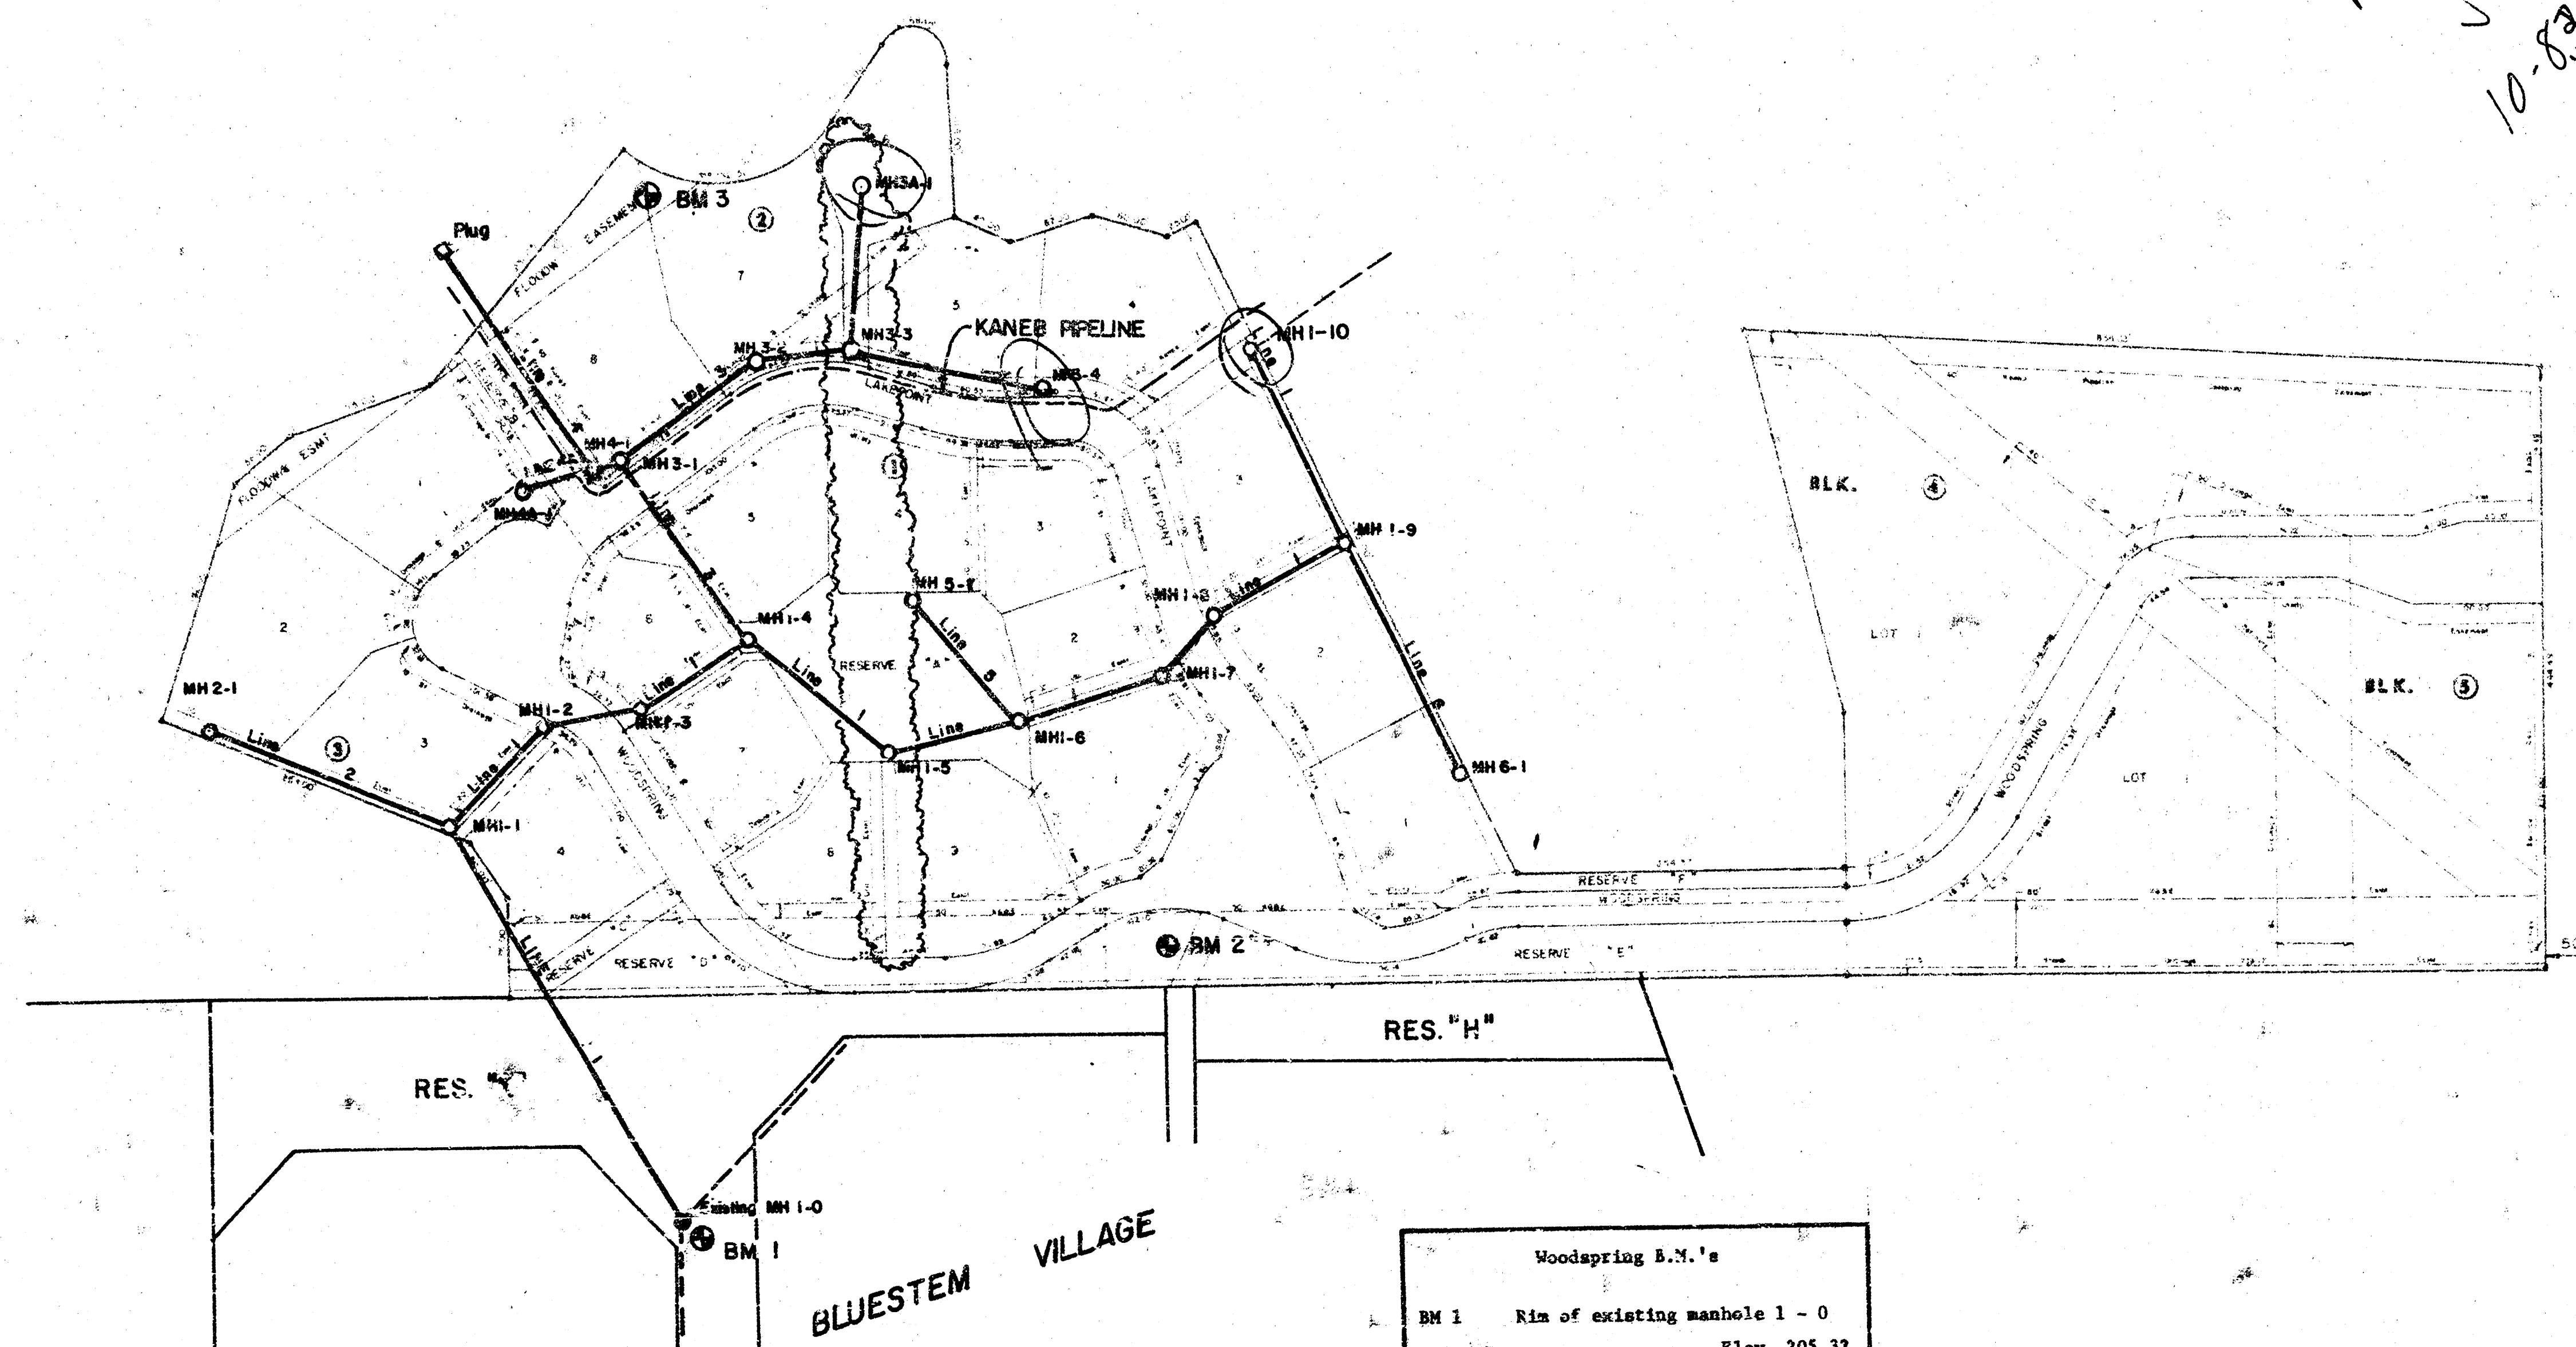

Prior to excavation in Reserve K the contractor shall notify Tallgrass to locate sprinkler lines and to allow time for removal of trees and shrubs. Contact Ken Purg at 681-0243.

The cost of removal and repair of the sprinkler system and all utilities shall be subsidiary to the installation of the sewer lines.



| Woodspring B.M.'s |                                                                |
|-------------------|----------------------------------------------------------------|
| BM 1              | Rim of existing manhole 1 - 0<br>Elev. 205.32                  |
| BM 2              | Spike step in south face of K&E<br>"Y" pole.<br>Elev. 211.32   |
| BM 3              | Square cut on southeast corner<br>of pond dam.<br>Elev. 207.86 |

### INDEX TO DRAWINGS

| SHEET NO. | DESCRIPTION        |
|-----------|--------------------|
| 1         | TITLE SHEET        |
| 2         | LINE 1             |
| 3         | LINE 1             |
| 4         | LINE 2 & 3         |
| 5         | LINE 4, 4A, 5, & 6 |
| 6         | MANHOLE DETAILS    |
| 7         | FINAL PLAT         |

### GENERAL NOTES


- RISER PIPE SHALL BE INSTALLED TO SERVE INDIVIDUAL LOTS OR TRACTS IN CONJUNCTION WITH NEW SANITARY SEWER CONSTRUCTION, UNLESS OTHERWISE ORDERED BY THE ENGINEER, BECAUSE OF GROUND WATER, UNSTABLE SOIL OR UNUSUALLY DEEP CONSTRUCTION. RISER LOCATIONS SHALL BE AS APPROVED BY THE PROPERTY OWNER WITH THE CONCURRENCE OF THE ENGINEER. INSTALLATION OF RISERS OR SEWERS BECAUSE OF UNUSUAL DEPTH WILL BE REQUIRED WHEN THE CENTER IS DEEPER THAN TWELVE FEET (12'). THE CONTRACTOR WILL BE REQUIRED TO FILE WRITTEN DOCUMENTATION WITH THE ENGINEER IN A FORM APPROVED BY THE ENGINEER INDICATING THE LOCATIONS WHERE RISERS ARE TO BE INSTALLED AS REQUESTED BY THE PROPERTY OWNER OR HIS AUTHORIZED REPRESENTATIVE. RISER PIPE CONSTRUCTION SHALL CONFORM TO THE REQUIREMENTS AS SHOWN ON THE STANDARD RISER DETAIL SHEET.
- THE CONTRACTOR SHALL BE RESPONSIBLE FOR PRESERVING PROPERTY IRONS. THE CONTRACTOR SHALL ESTABLISH ANY PROPERTY IRONS WHICH ARE NOT SHOWN ON THE PROPOSAL. SUCH IRONS SHALL BE PRESERVED OR A LICENSED PROFESSIONAL ENGINEER SHALL BE CONSULTED FOR PRESERVING PROPERTY IRONS.
- THE CONTRACTOR SHALL BE RESPONSIBLE FOR PRESERVING PROPERTY IRONS. THE CONTRACTOR SHALL ESTABLISH ANY PROPERTY IRONS WHICH ARE NOT SHOWN ON THE PROPOSAL. SUCH IRONS SHALL BE PRESERVED OR A LICENSED PROFESSIONAL ENGINEER SHALL BE CONSULTED FOR PRESERVING PROPERTY IRONS.

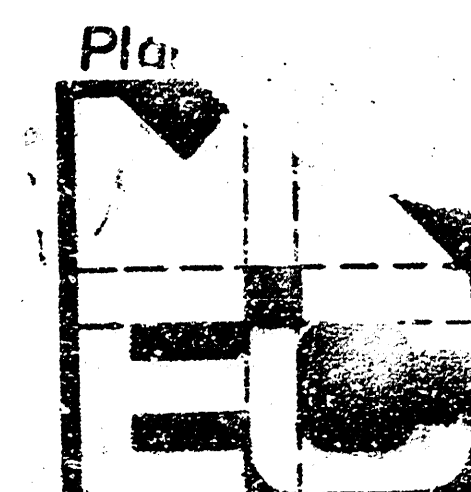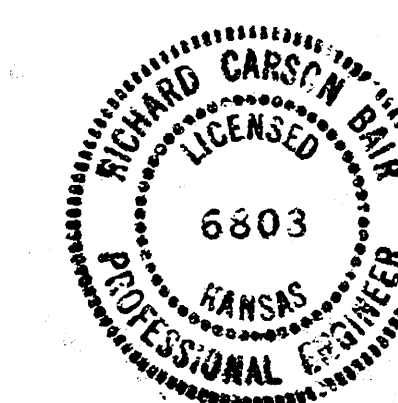


**WOODSPRING  
SANITARY SEWER  
EXTENSIONS**

MID-KANSAS ENGINEERING CONSULTANTS PA  
240 NORTH ROCK ROAD  
SUITE 100  
WICHITA, KANSAS 67206

682-6561

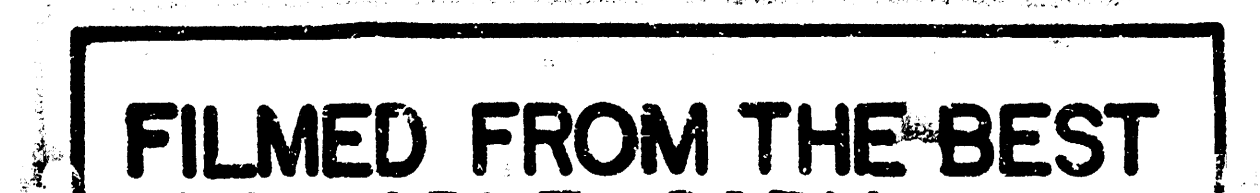


WOODSPRING LAT. 20, MAIN 22, W.I.S.  
PROJECT NO.  
438-76-245-81269-000-000-001

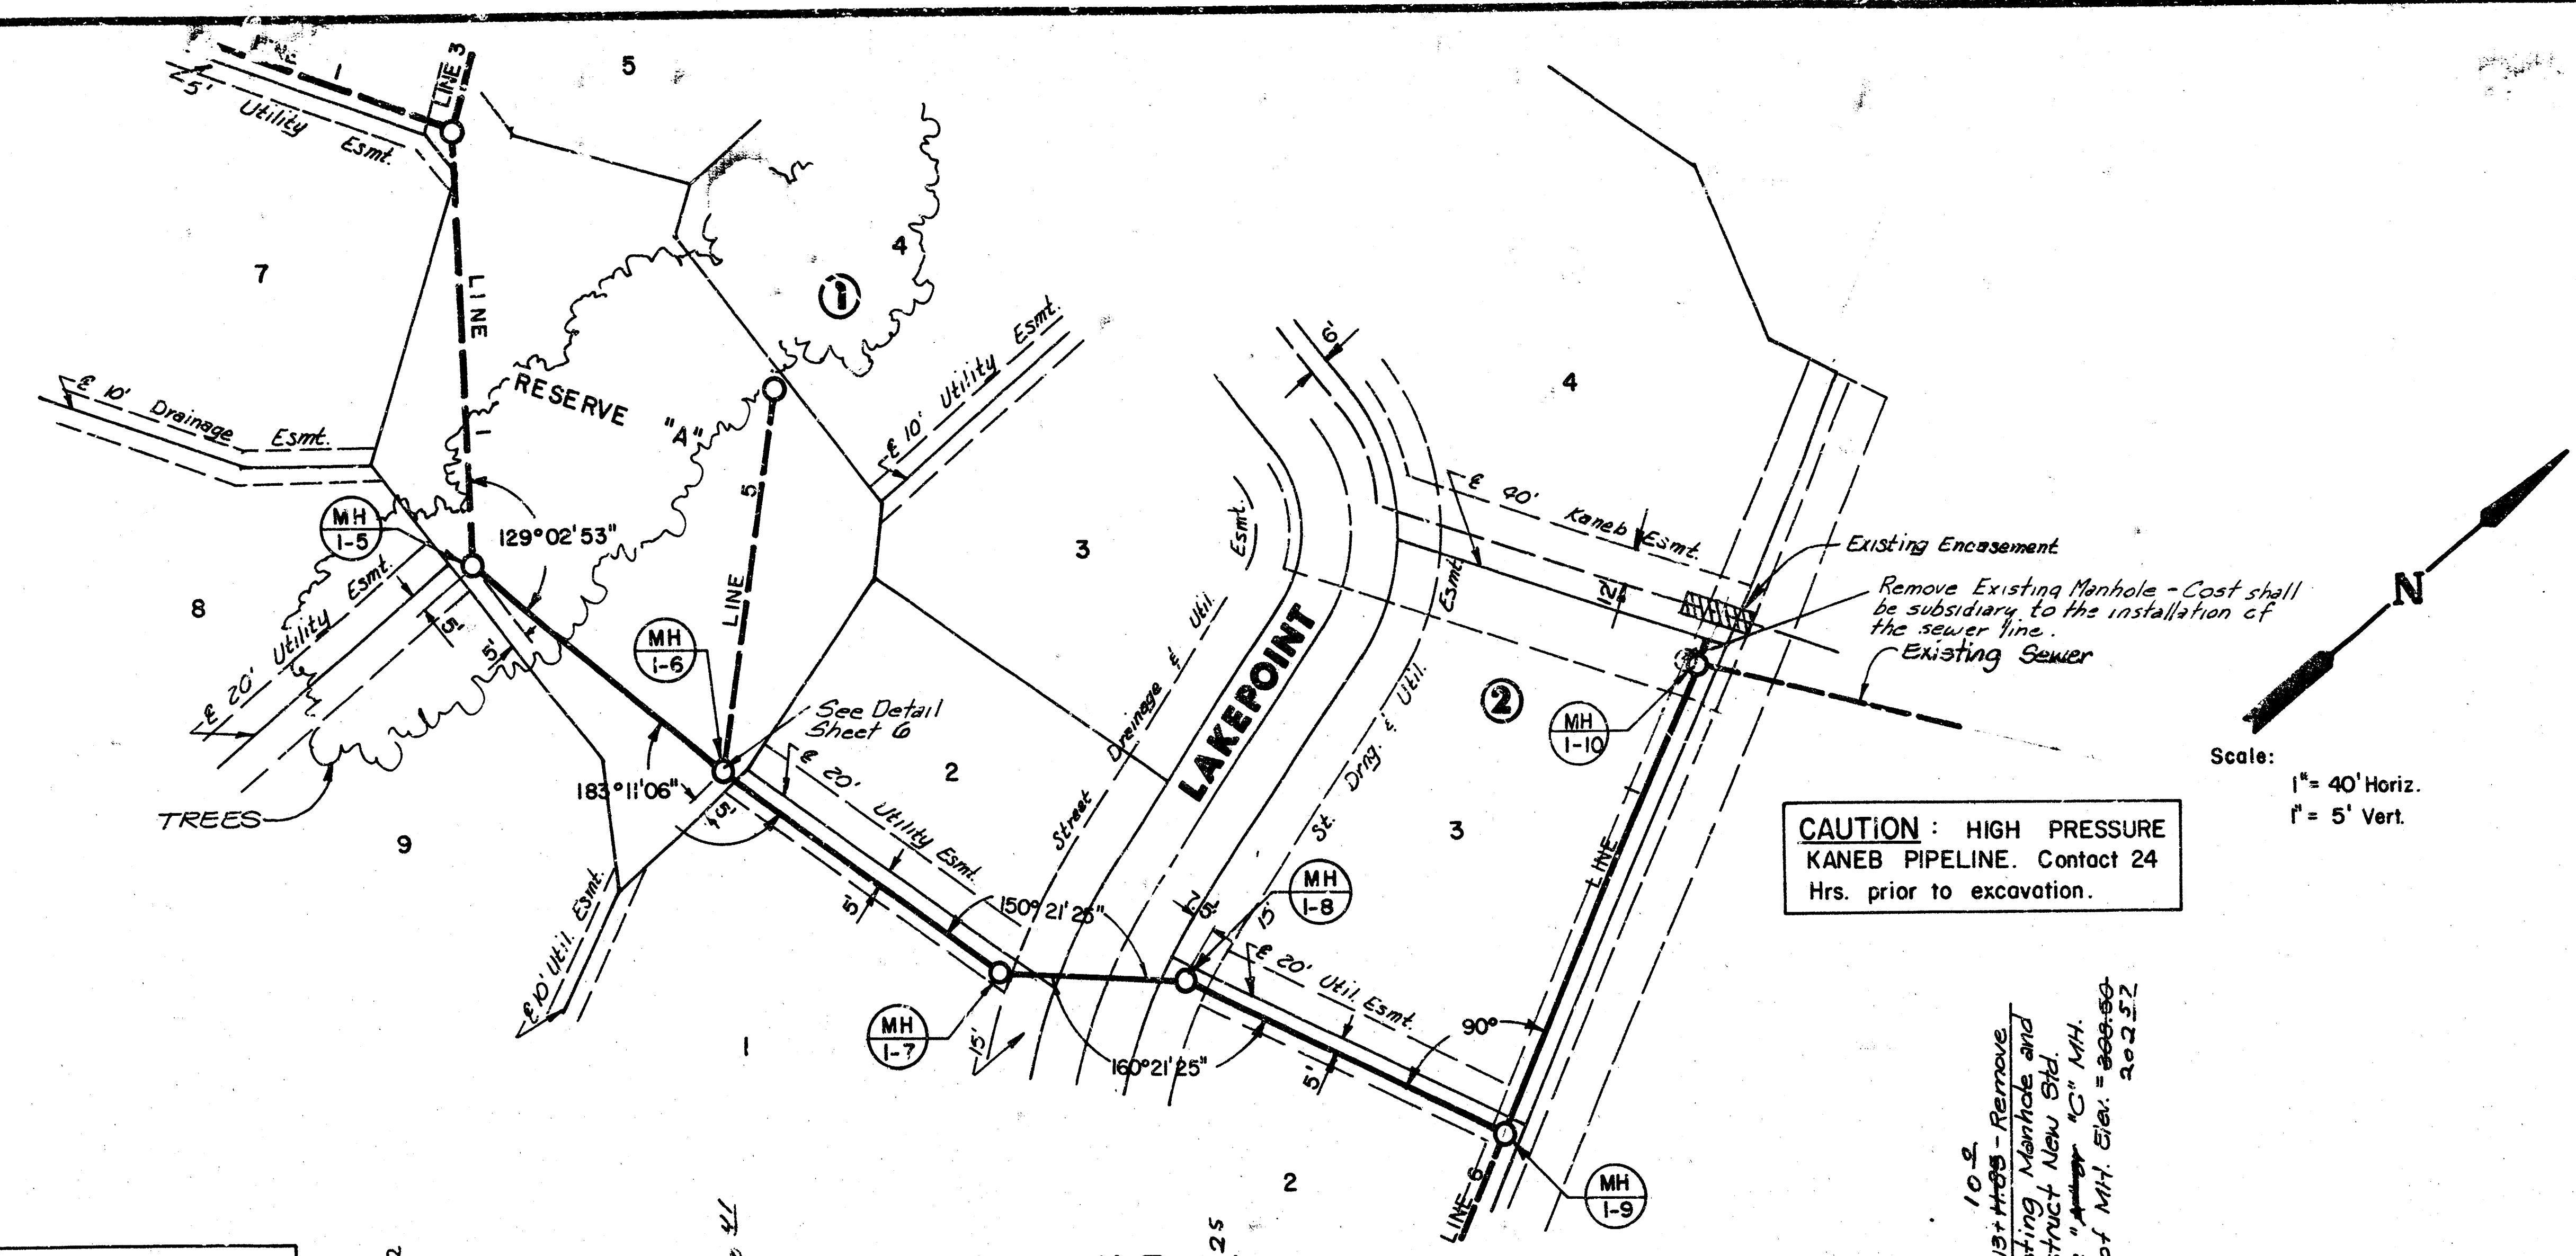

*Is Built  
J.L.  
10-85*

BM 2 Spike step in south face of K&S  
"Y" pole.  
Elev. 211.32


Plan Sheet Revised 8/5/83

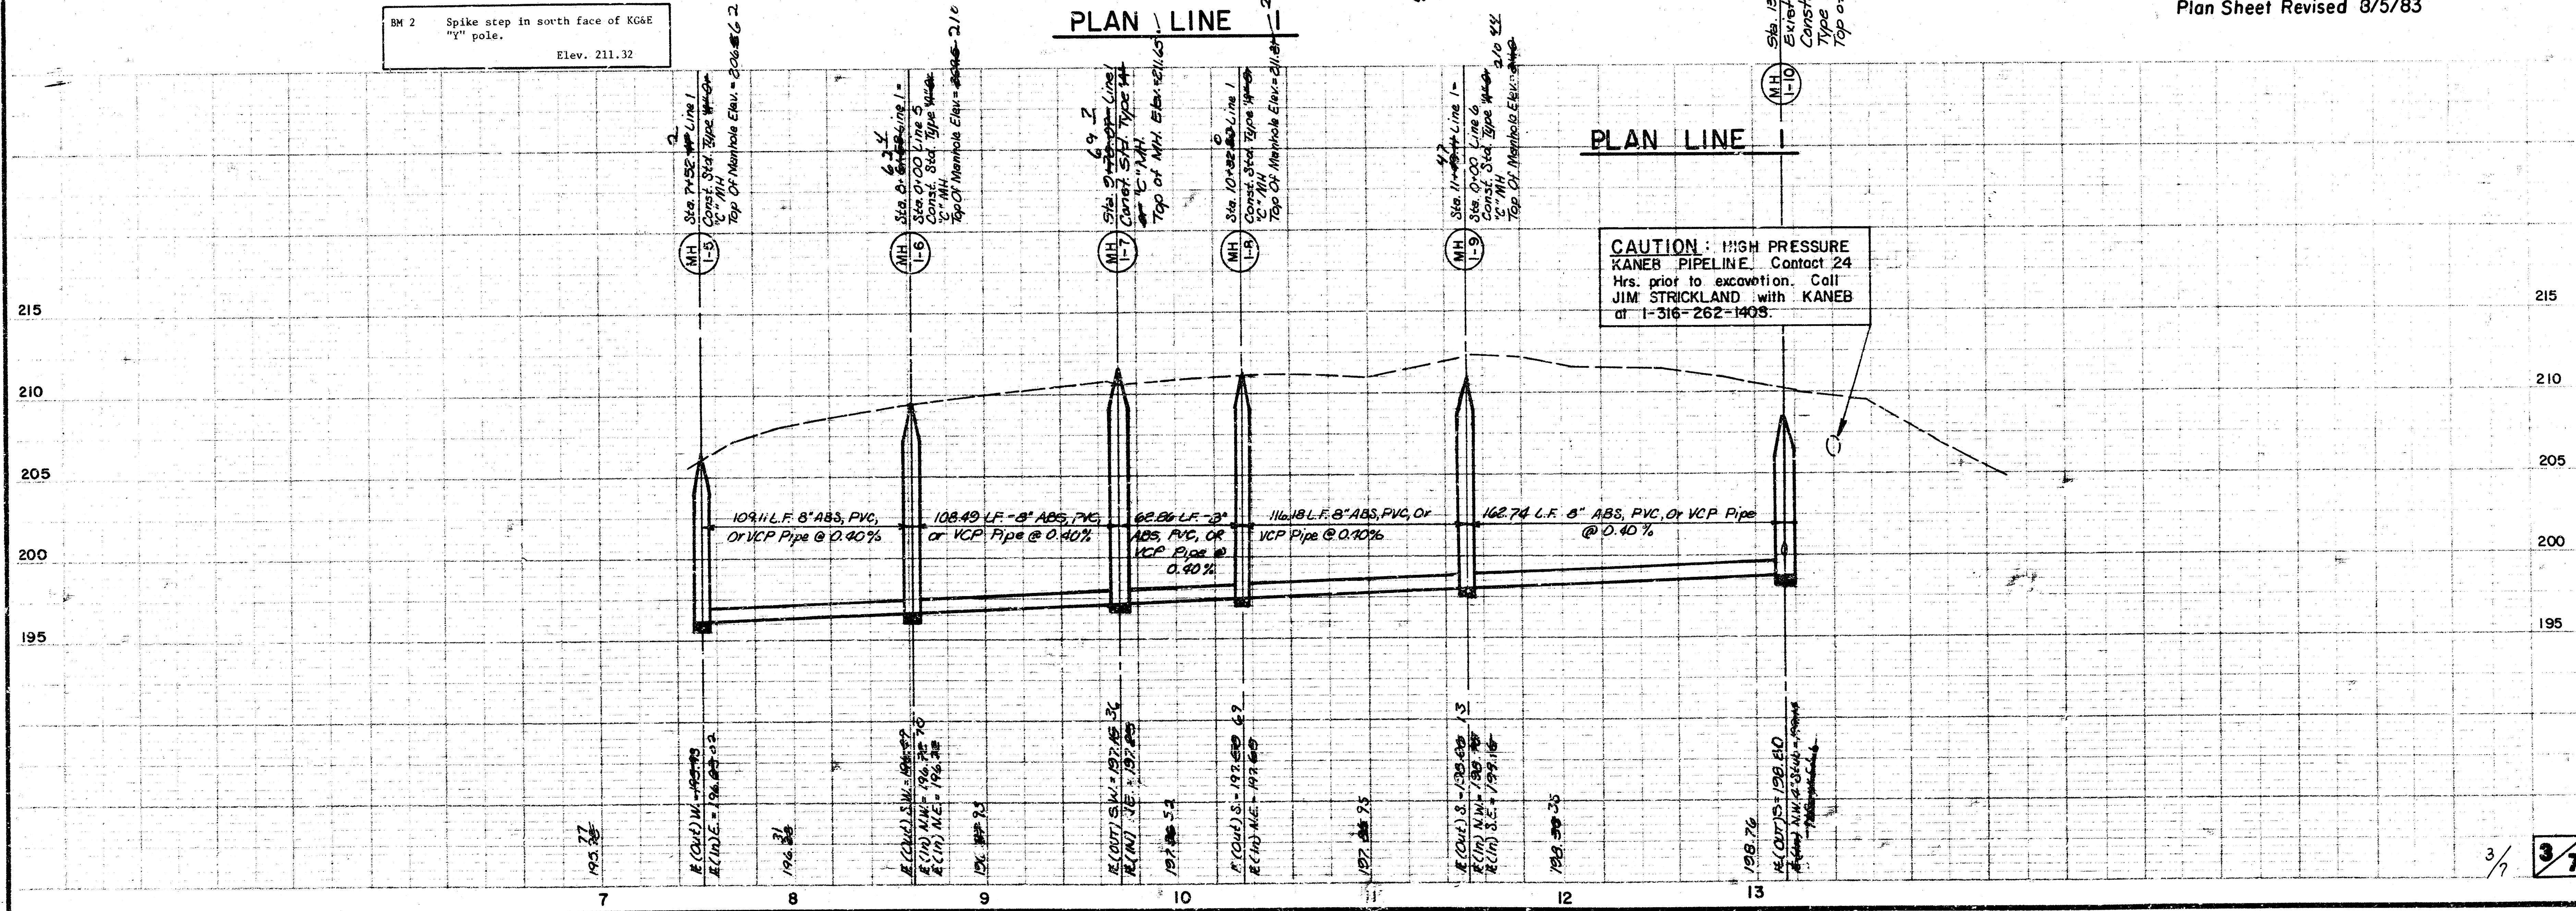


WOODSPRING LAT 20, MAIN 22, W.I.S.  
PROJECT NO,  
468-76-245- 81269 -000-000-001

Plan Sheet Revised 8/5/83

*As Built  
J.L.L.  
10-85*

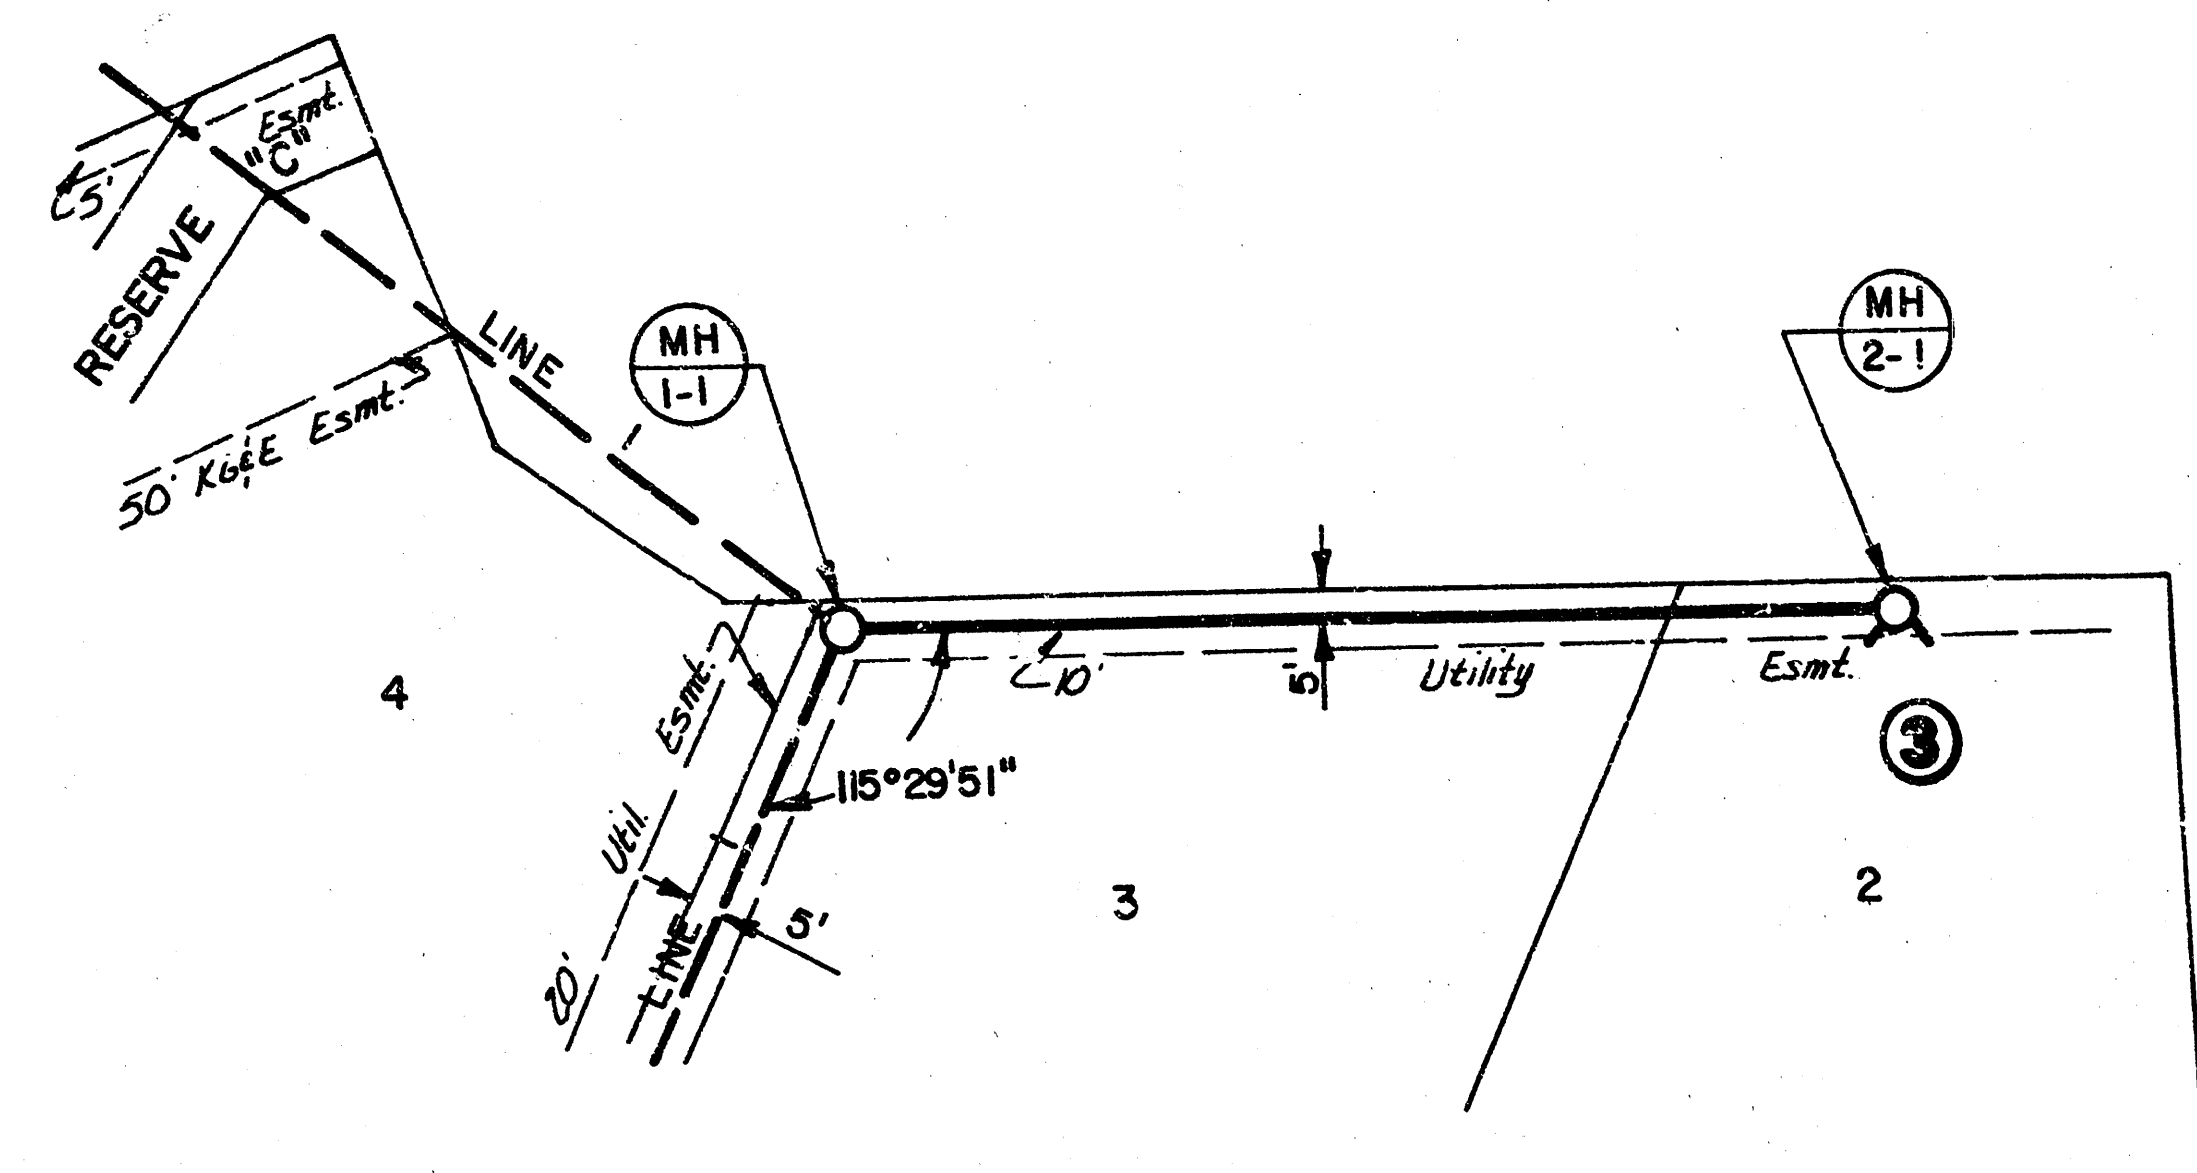


PLAN LINE 2

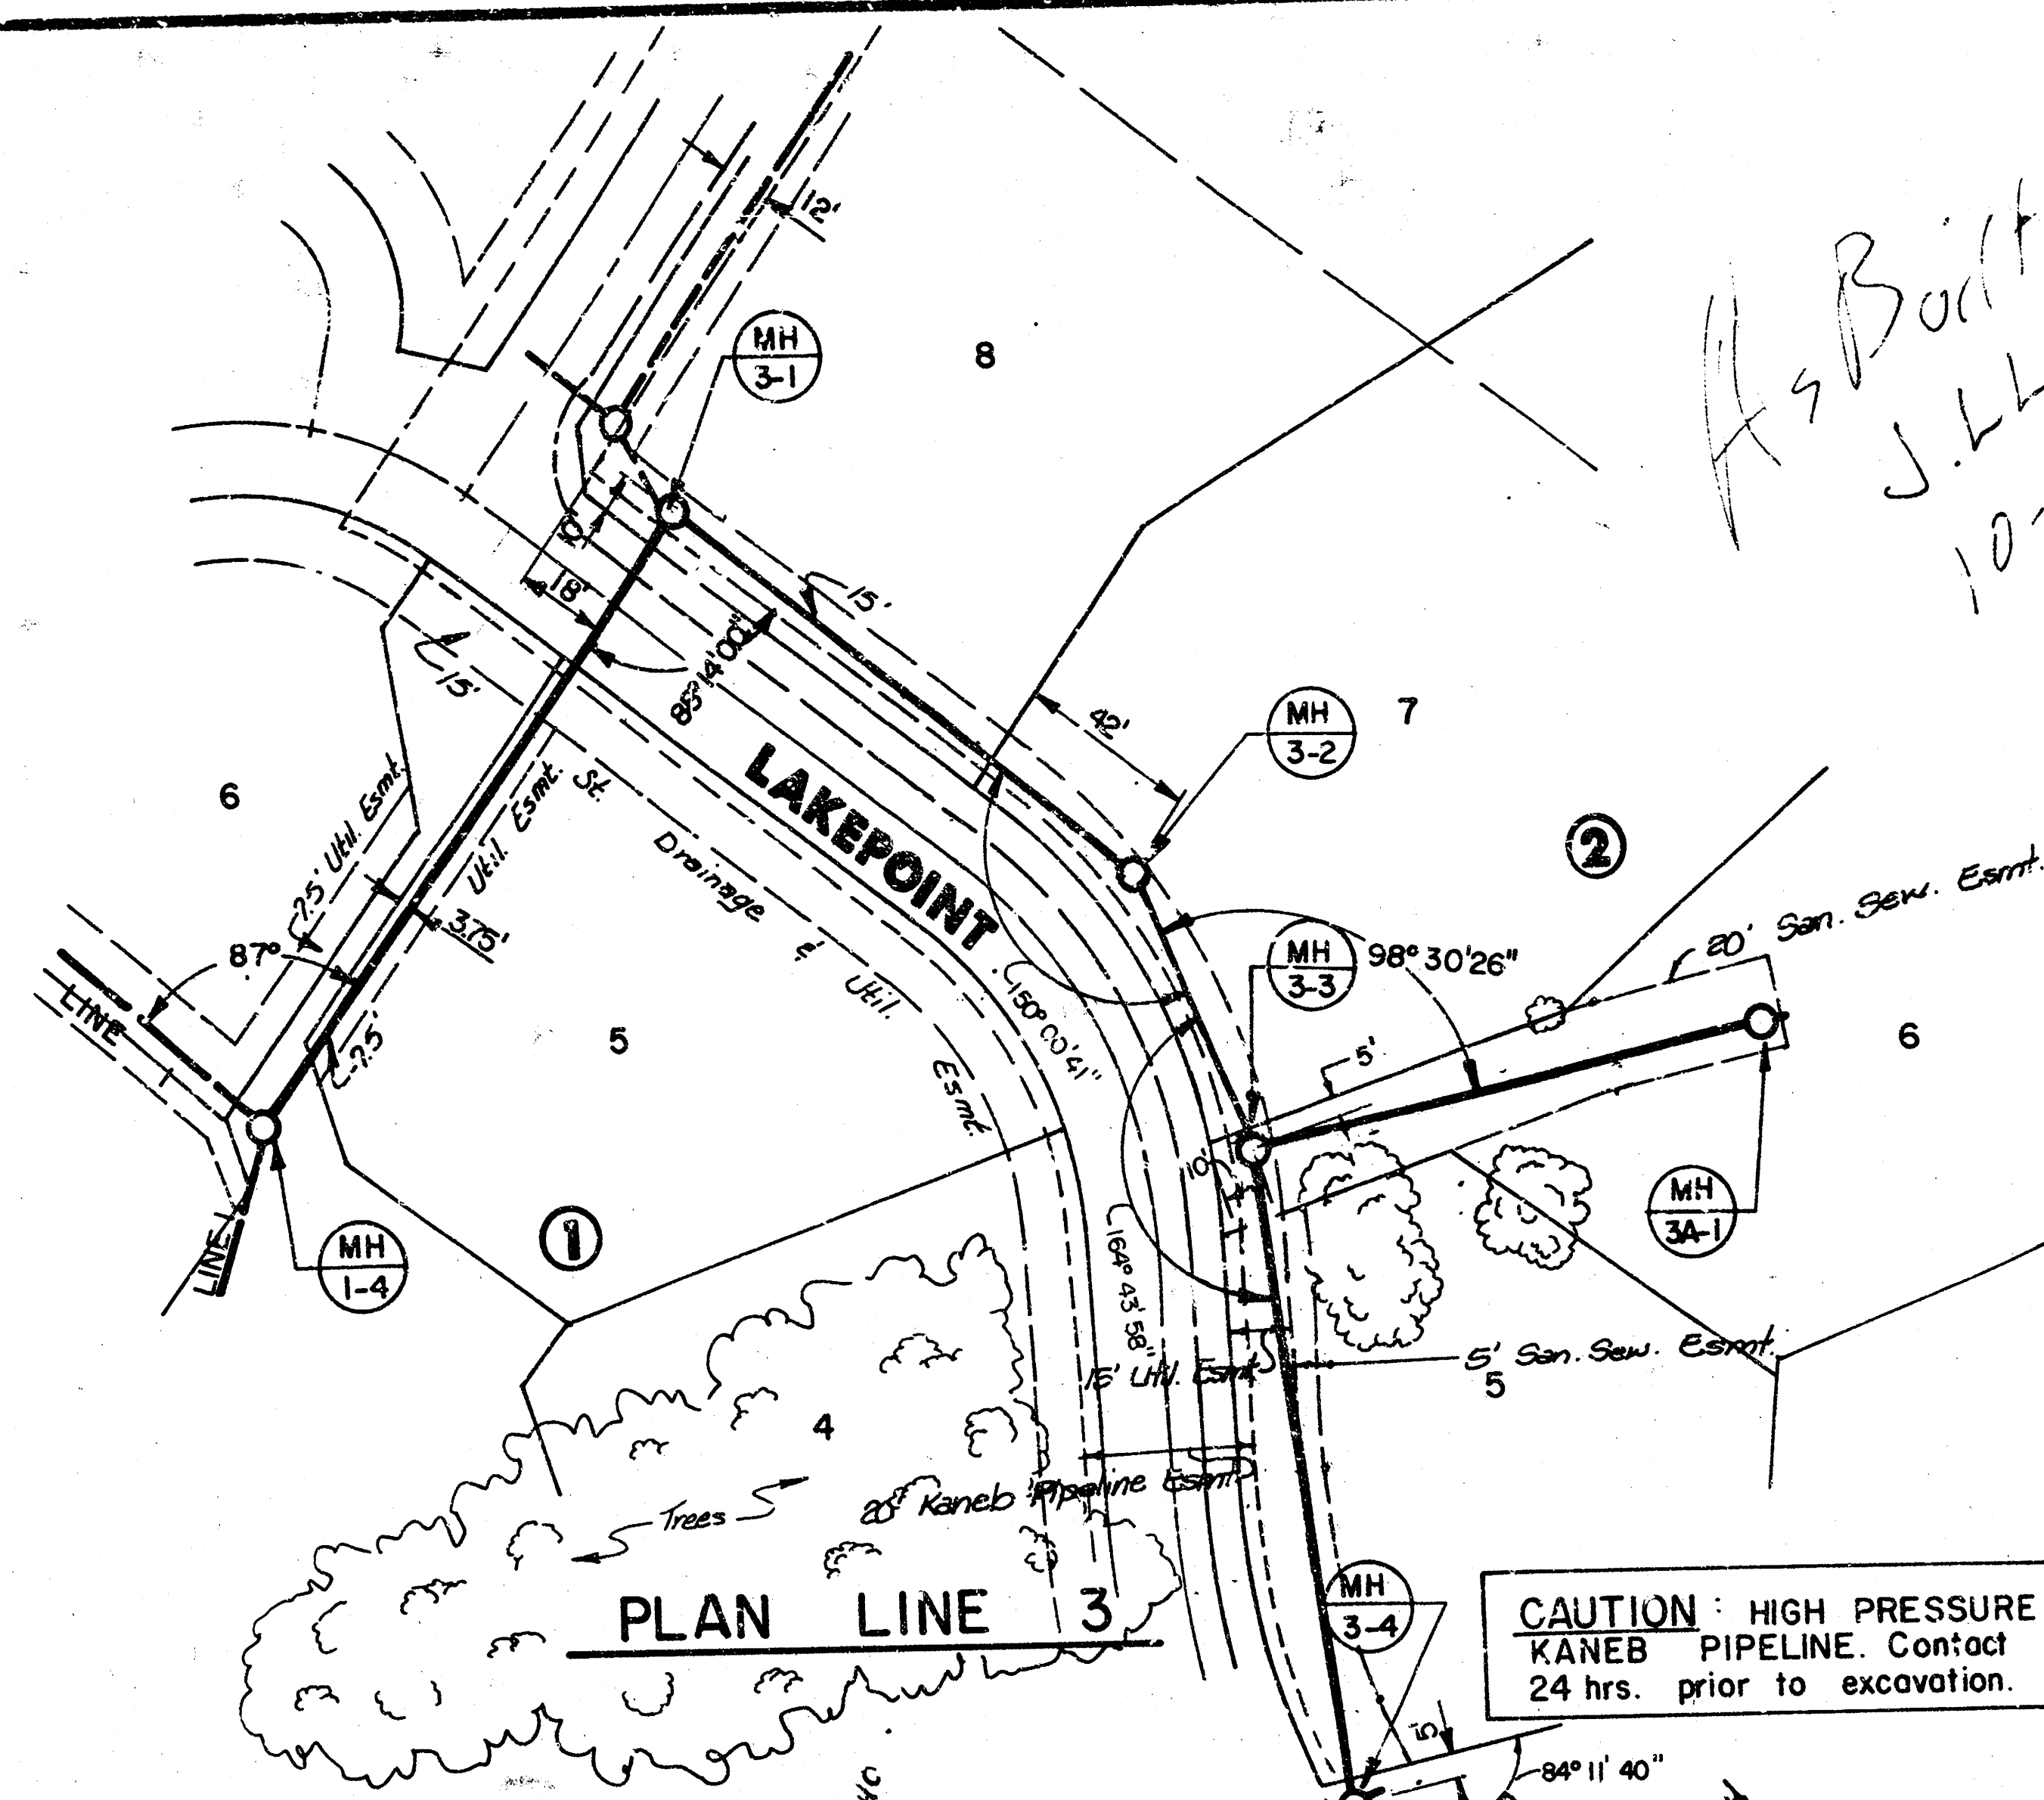

PLAN LINE 3


NOTE: Contractor shall not remove any trees shown on this sheet without the written consent of the City. Any trees removed shall be replaced in size and type.  
Date: 7-20-83

BM 3 Square cut on southeast corner of pond dam.  
Elev. 267.86

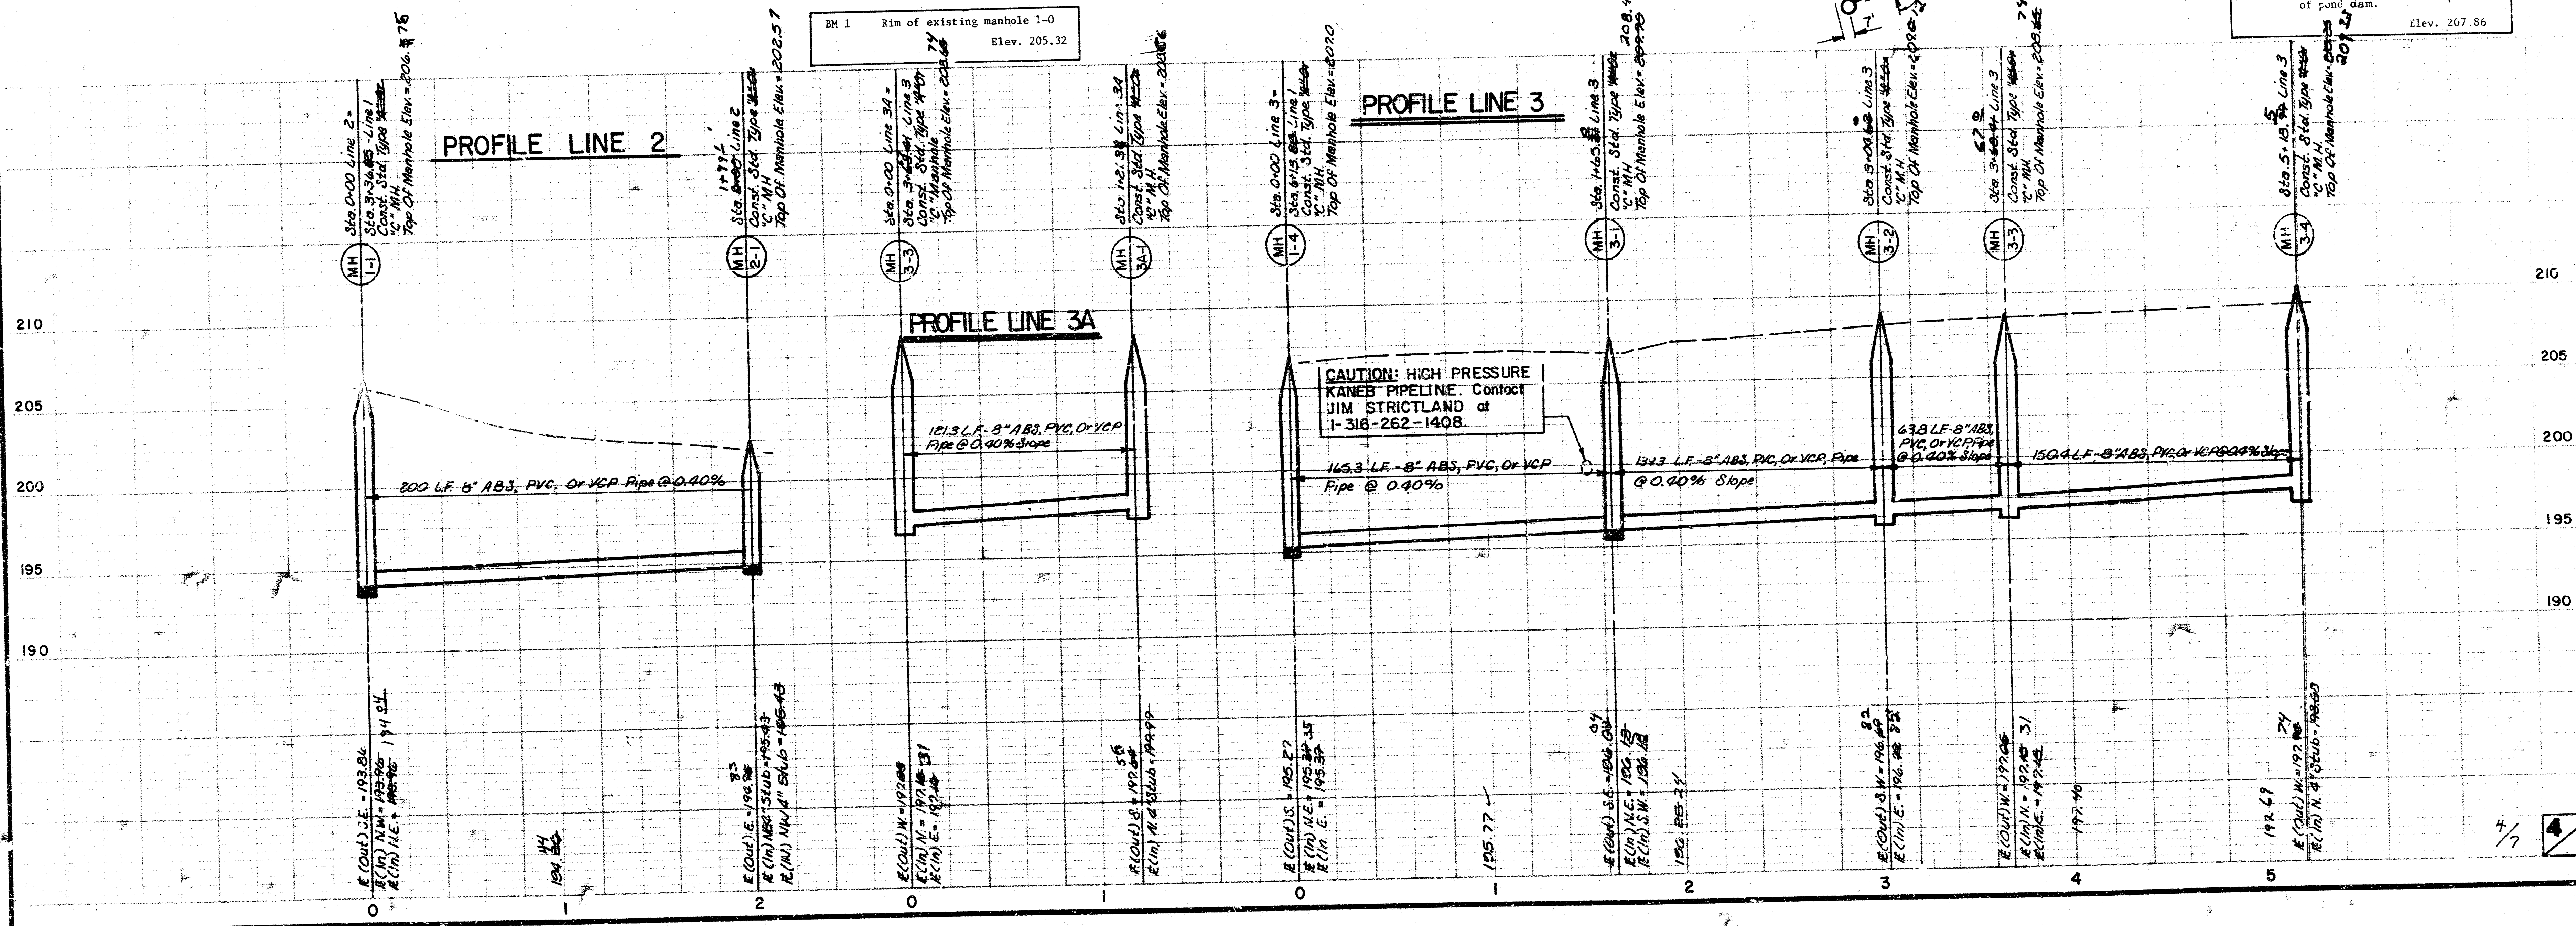

WOODSPRING LAT 20, MAIN 22, W.I.S.  
PROJECT NO.  
468-76-245 - 81263 - 000-000-001


THE CONTRACTOR SHALL EXCAVATE AND BACKFILL FOR THE ENCASEMENT OF THE KANE PIPELINE. THE KANE PIPELINE COMPANY WILL INSTALL THE ENCASEMENT PIPE AROUND THEIR PIPE. CONTRACTOR SHALL BE PAID FOR EXPOSING THE PIPE AND BACKFILL ONLY.

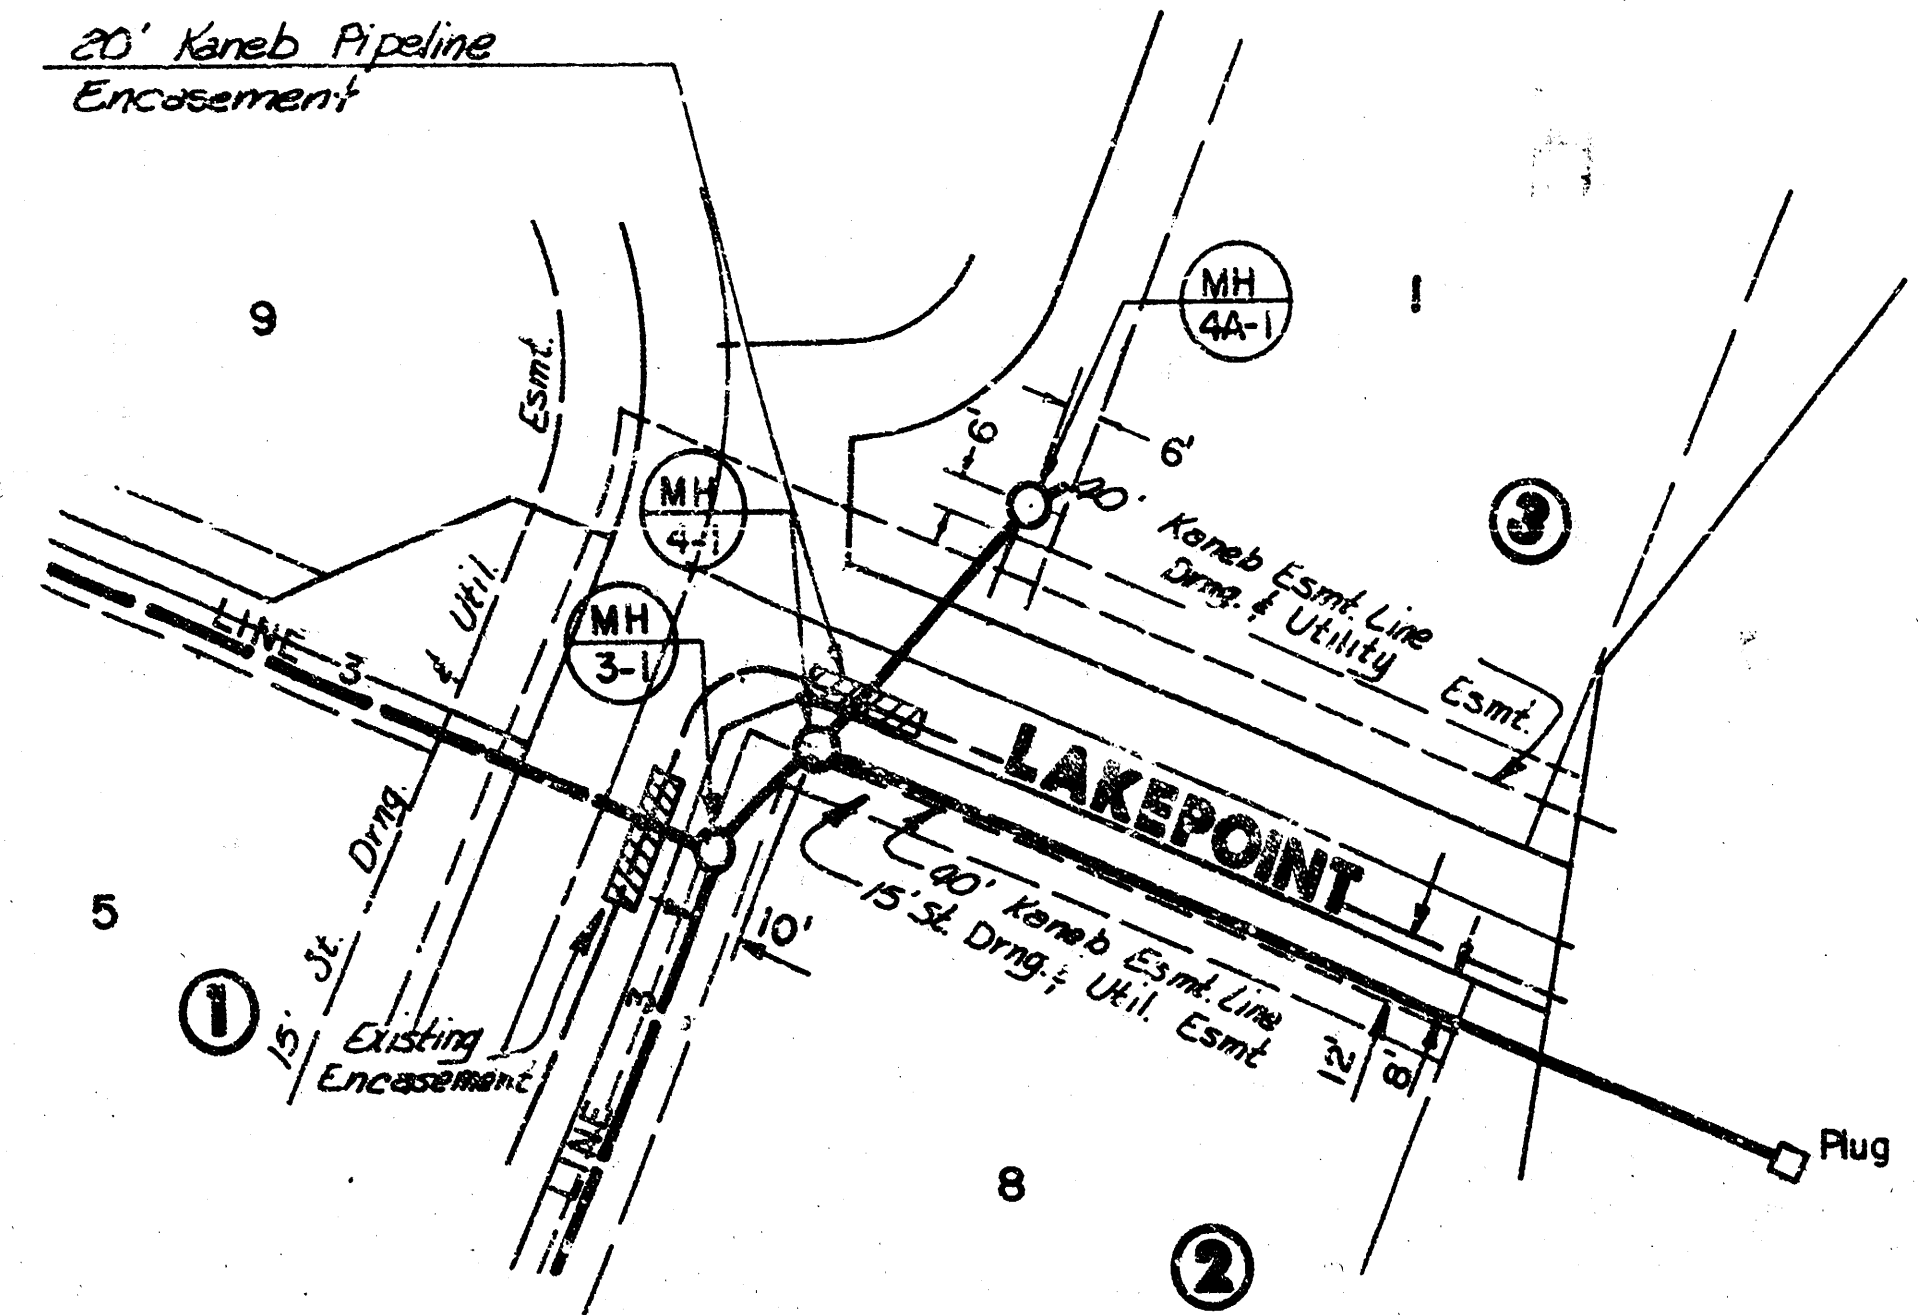


PLAN LINE 4&4A

**CAUTION: HIGH PRESSURE KANE PIPELINE CONTACT 24 HRS PRIOR TO EXCAVATION**


NOTE: Design Water Surface Elev. = 206.70 (100 Yr.)

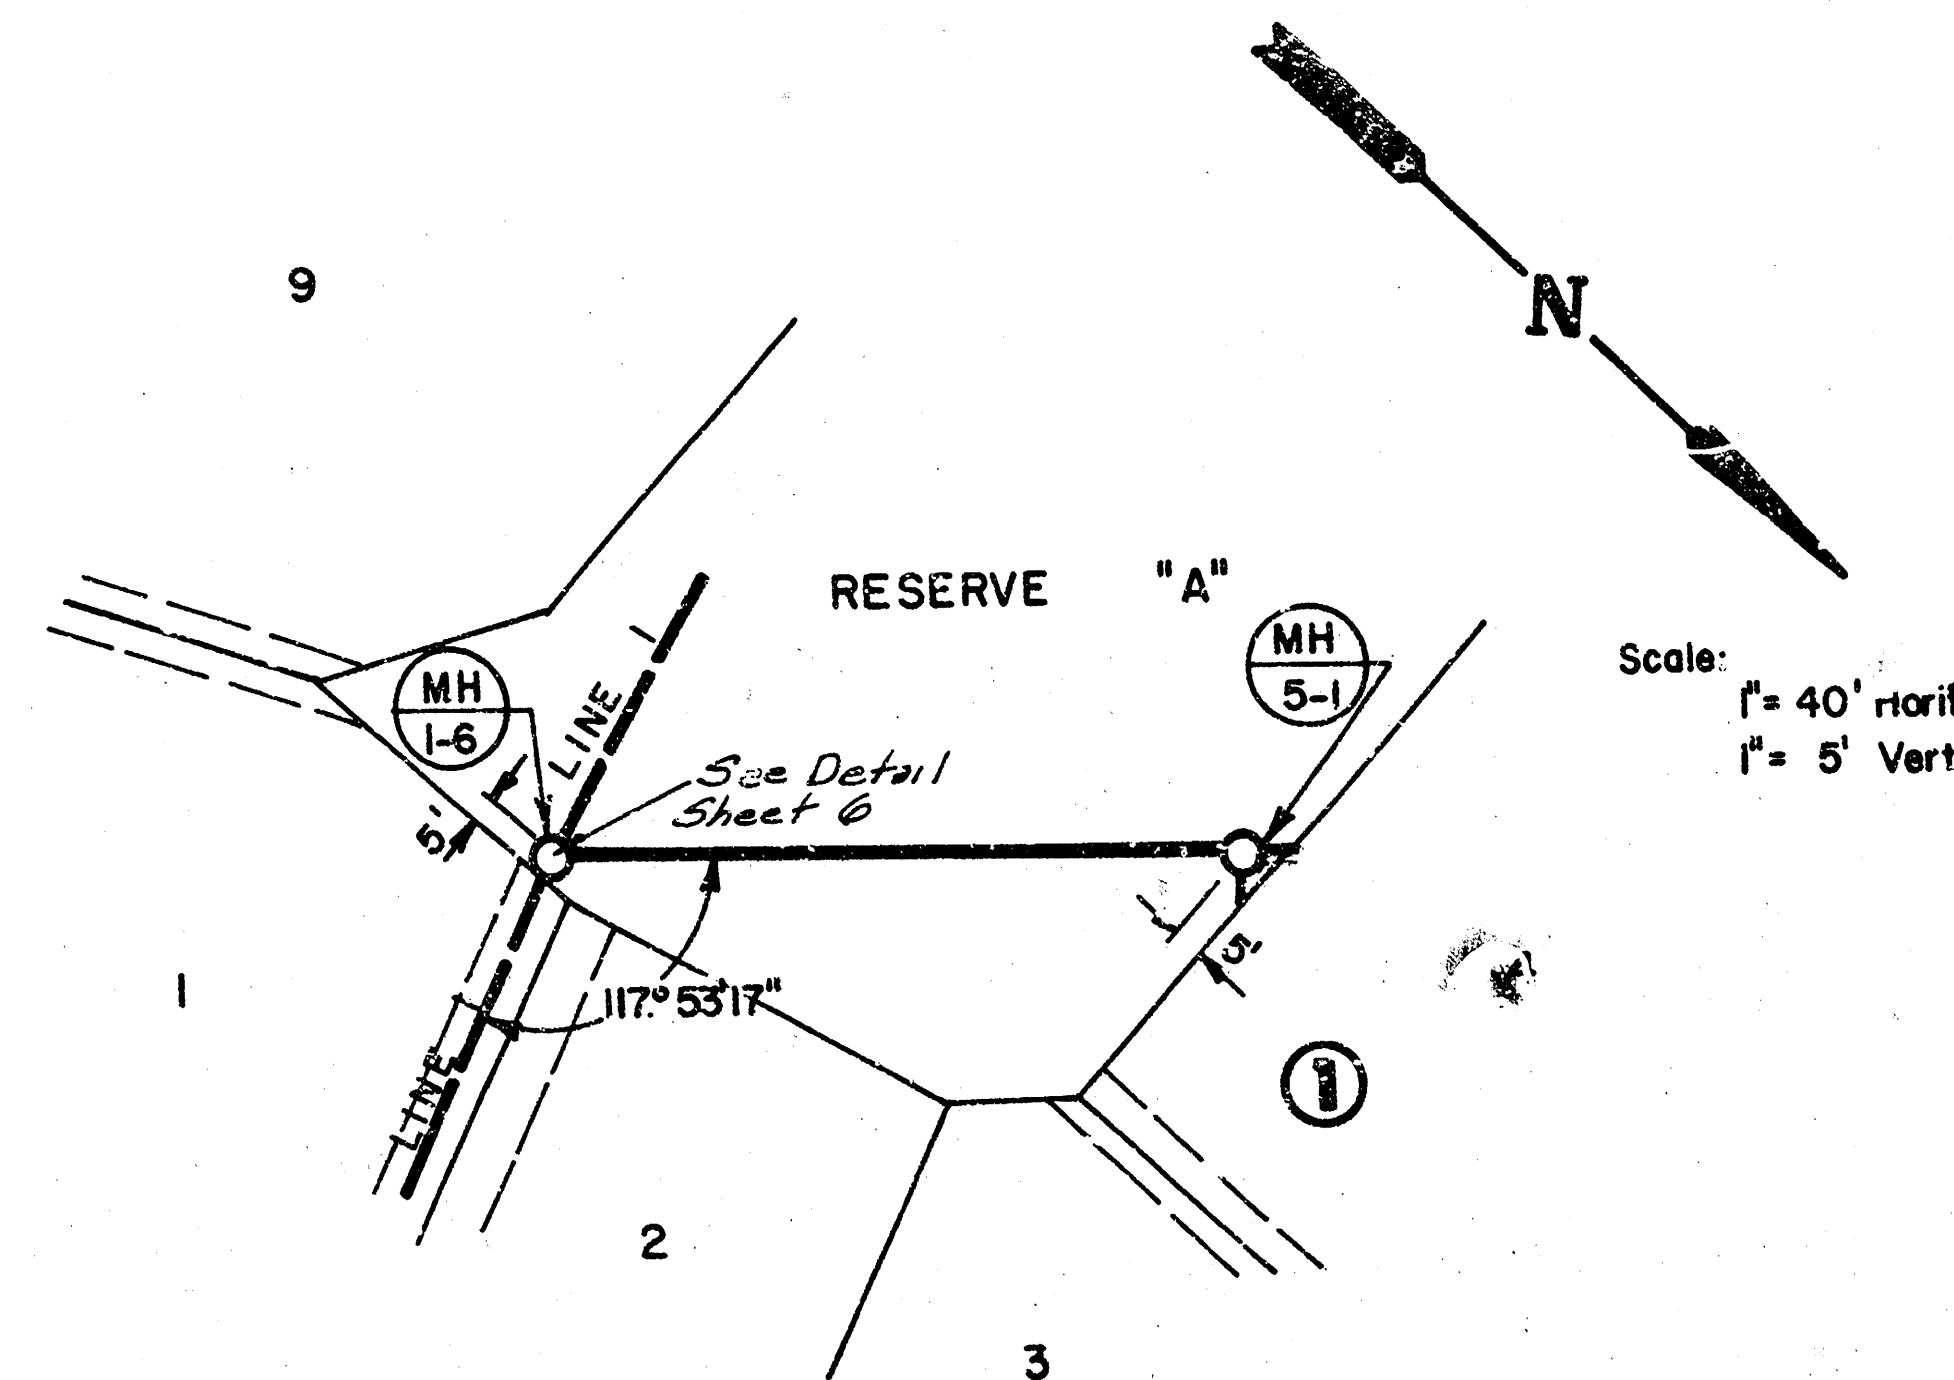


PLAN LINE 5

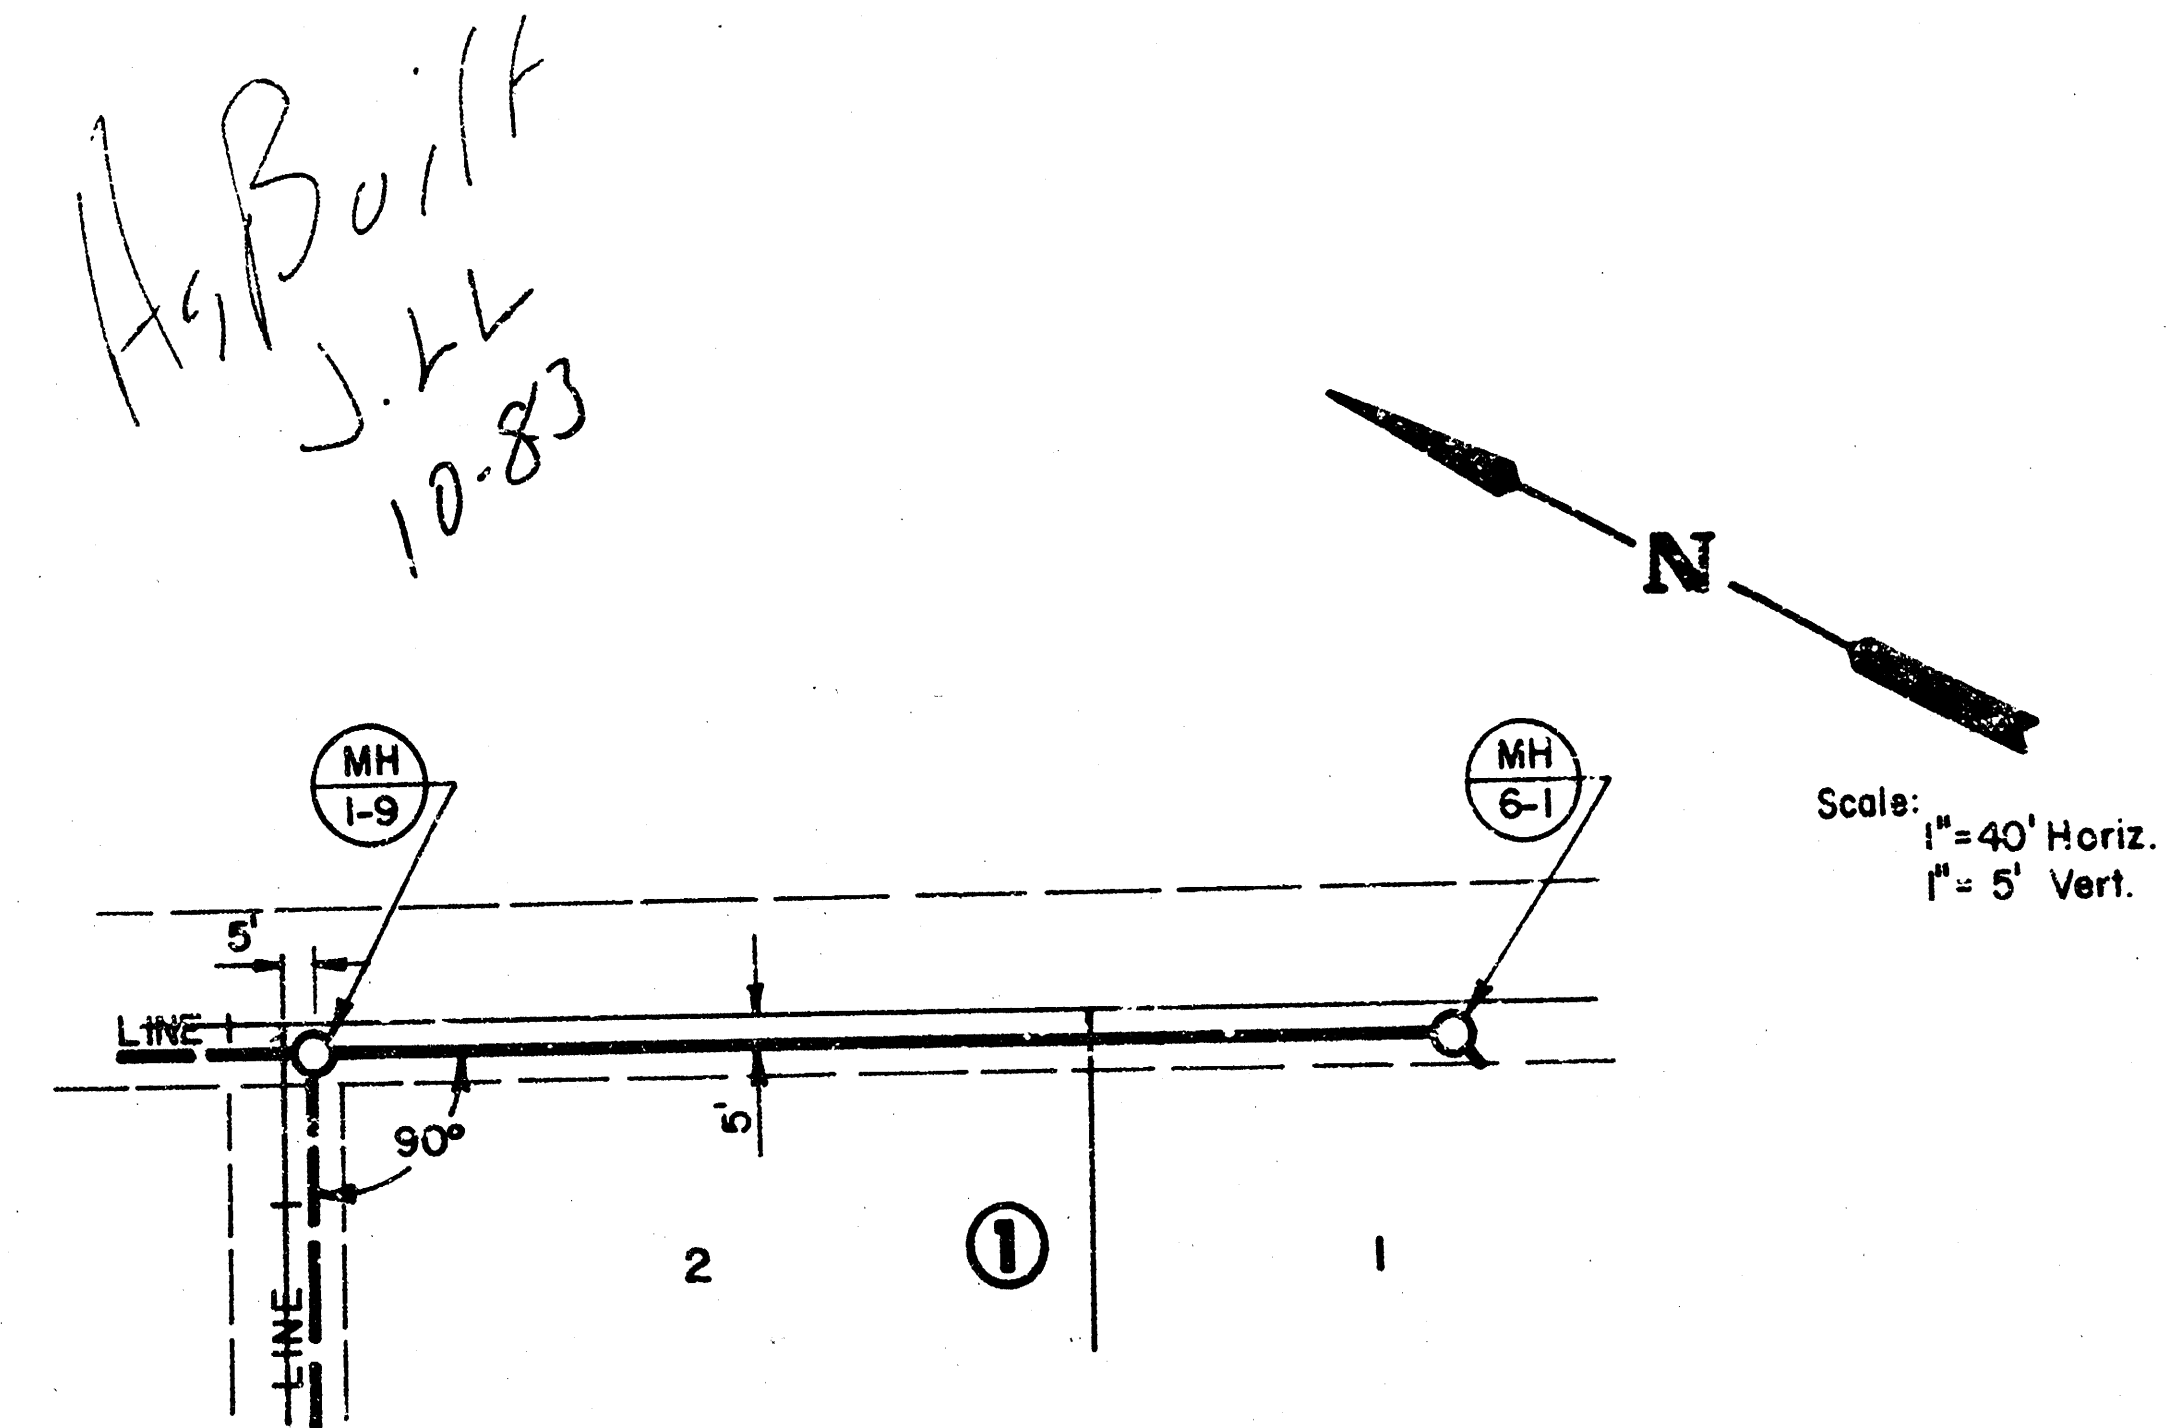

PLAN LINE 6

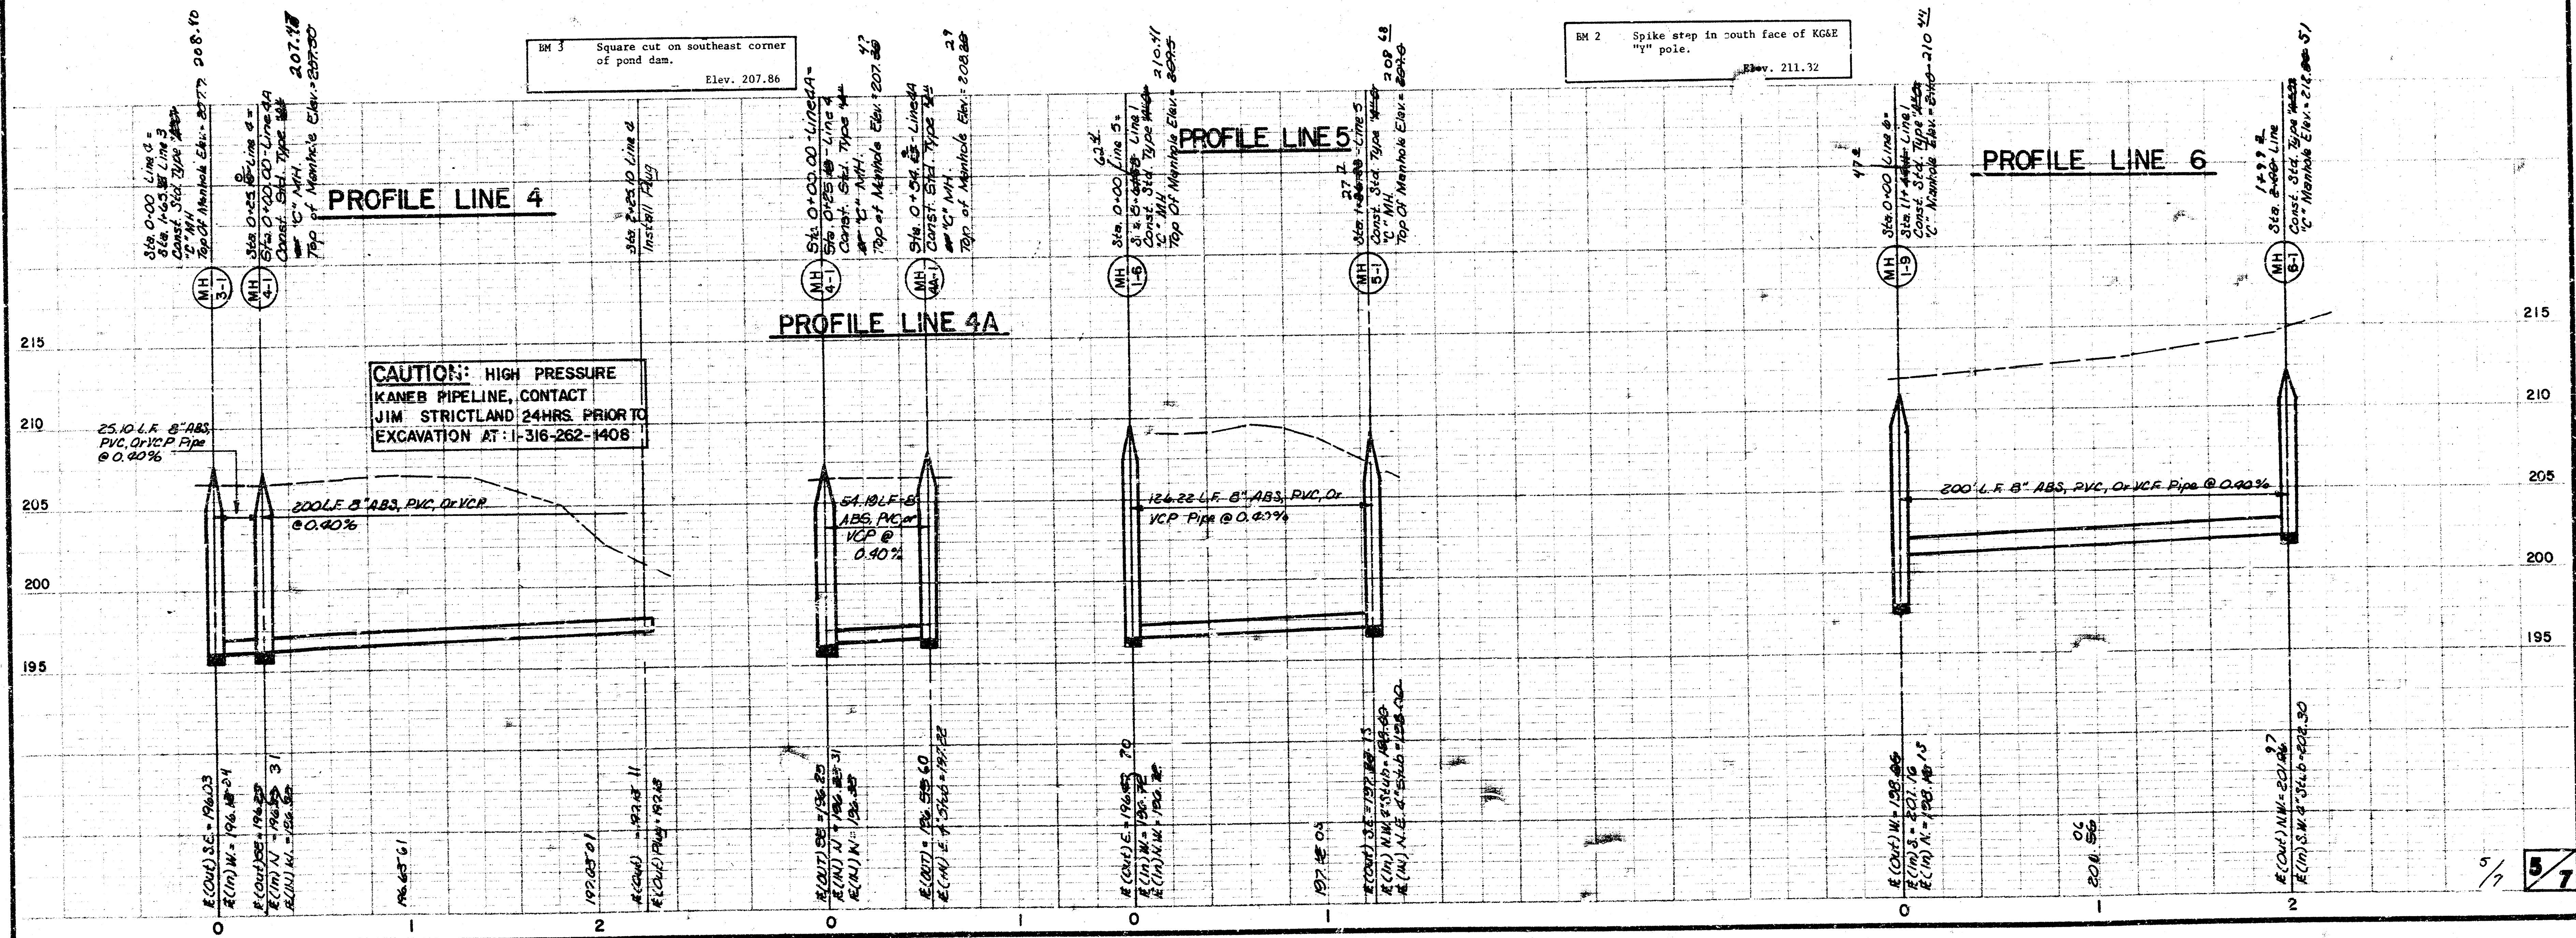

TYPE "A" MANHOLE

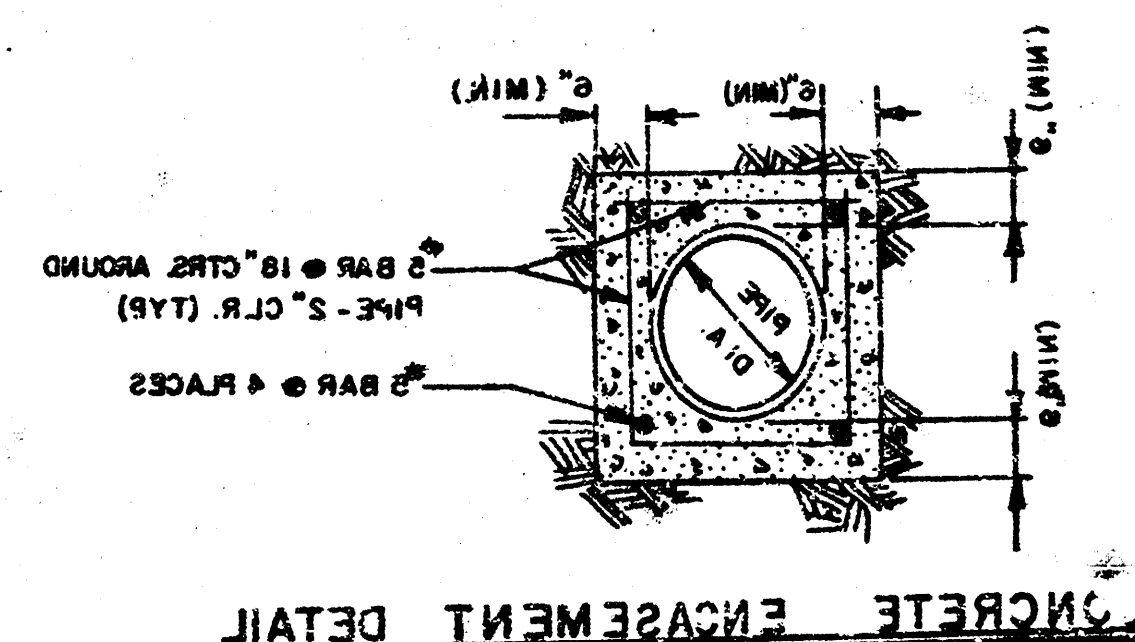

CONCRETE ENCASMENT DETAIL

GROUP DETAIL OF MH 1-6


# WOODSPRING

FINAL PLAN OF

AN ADDITION TO WICHITA, SEDGWICK COUNTY, KANSAS

## CAUTION:

High Pressure KANE PIPELINE.  
Contact S4 Prior To Excavation Call  
Jim Strickland At 1-316-565-1408.

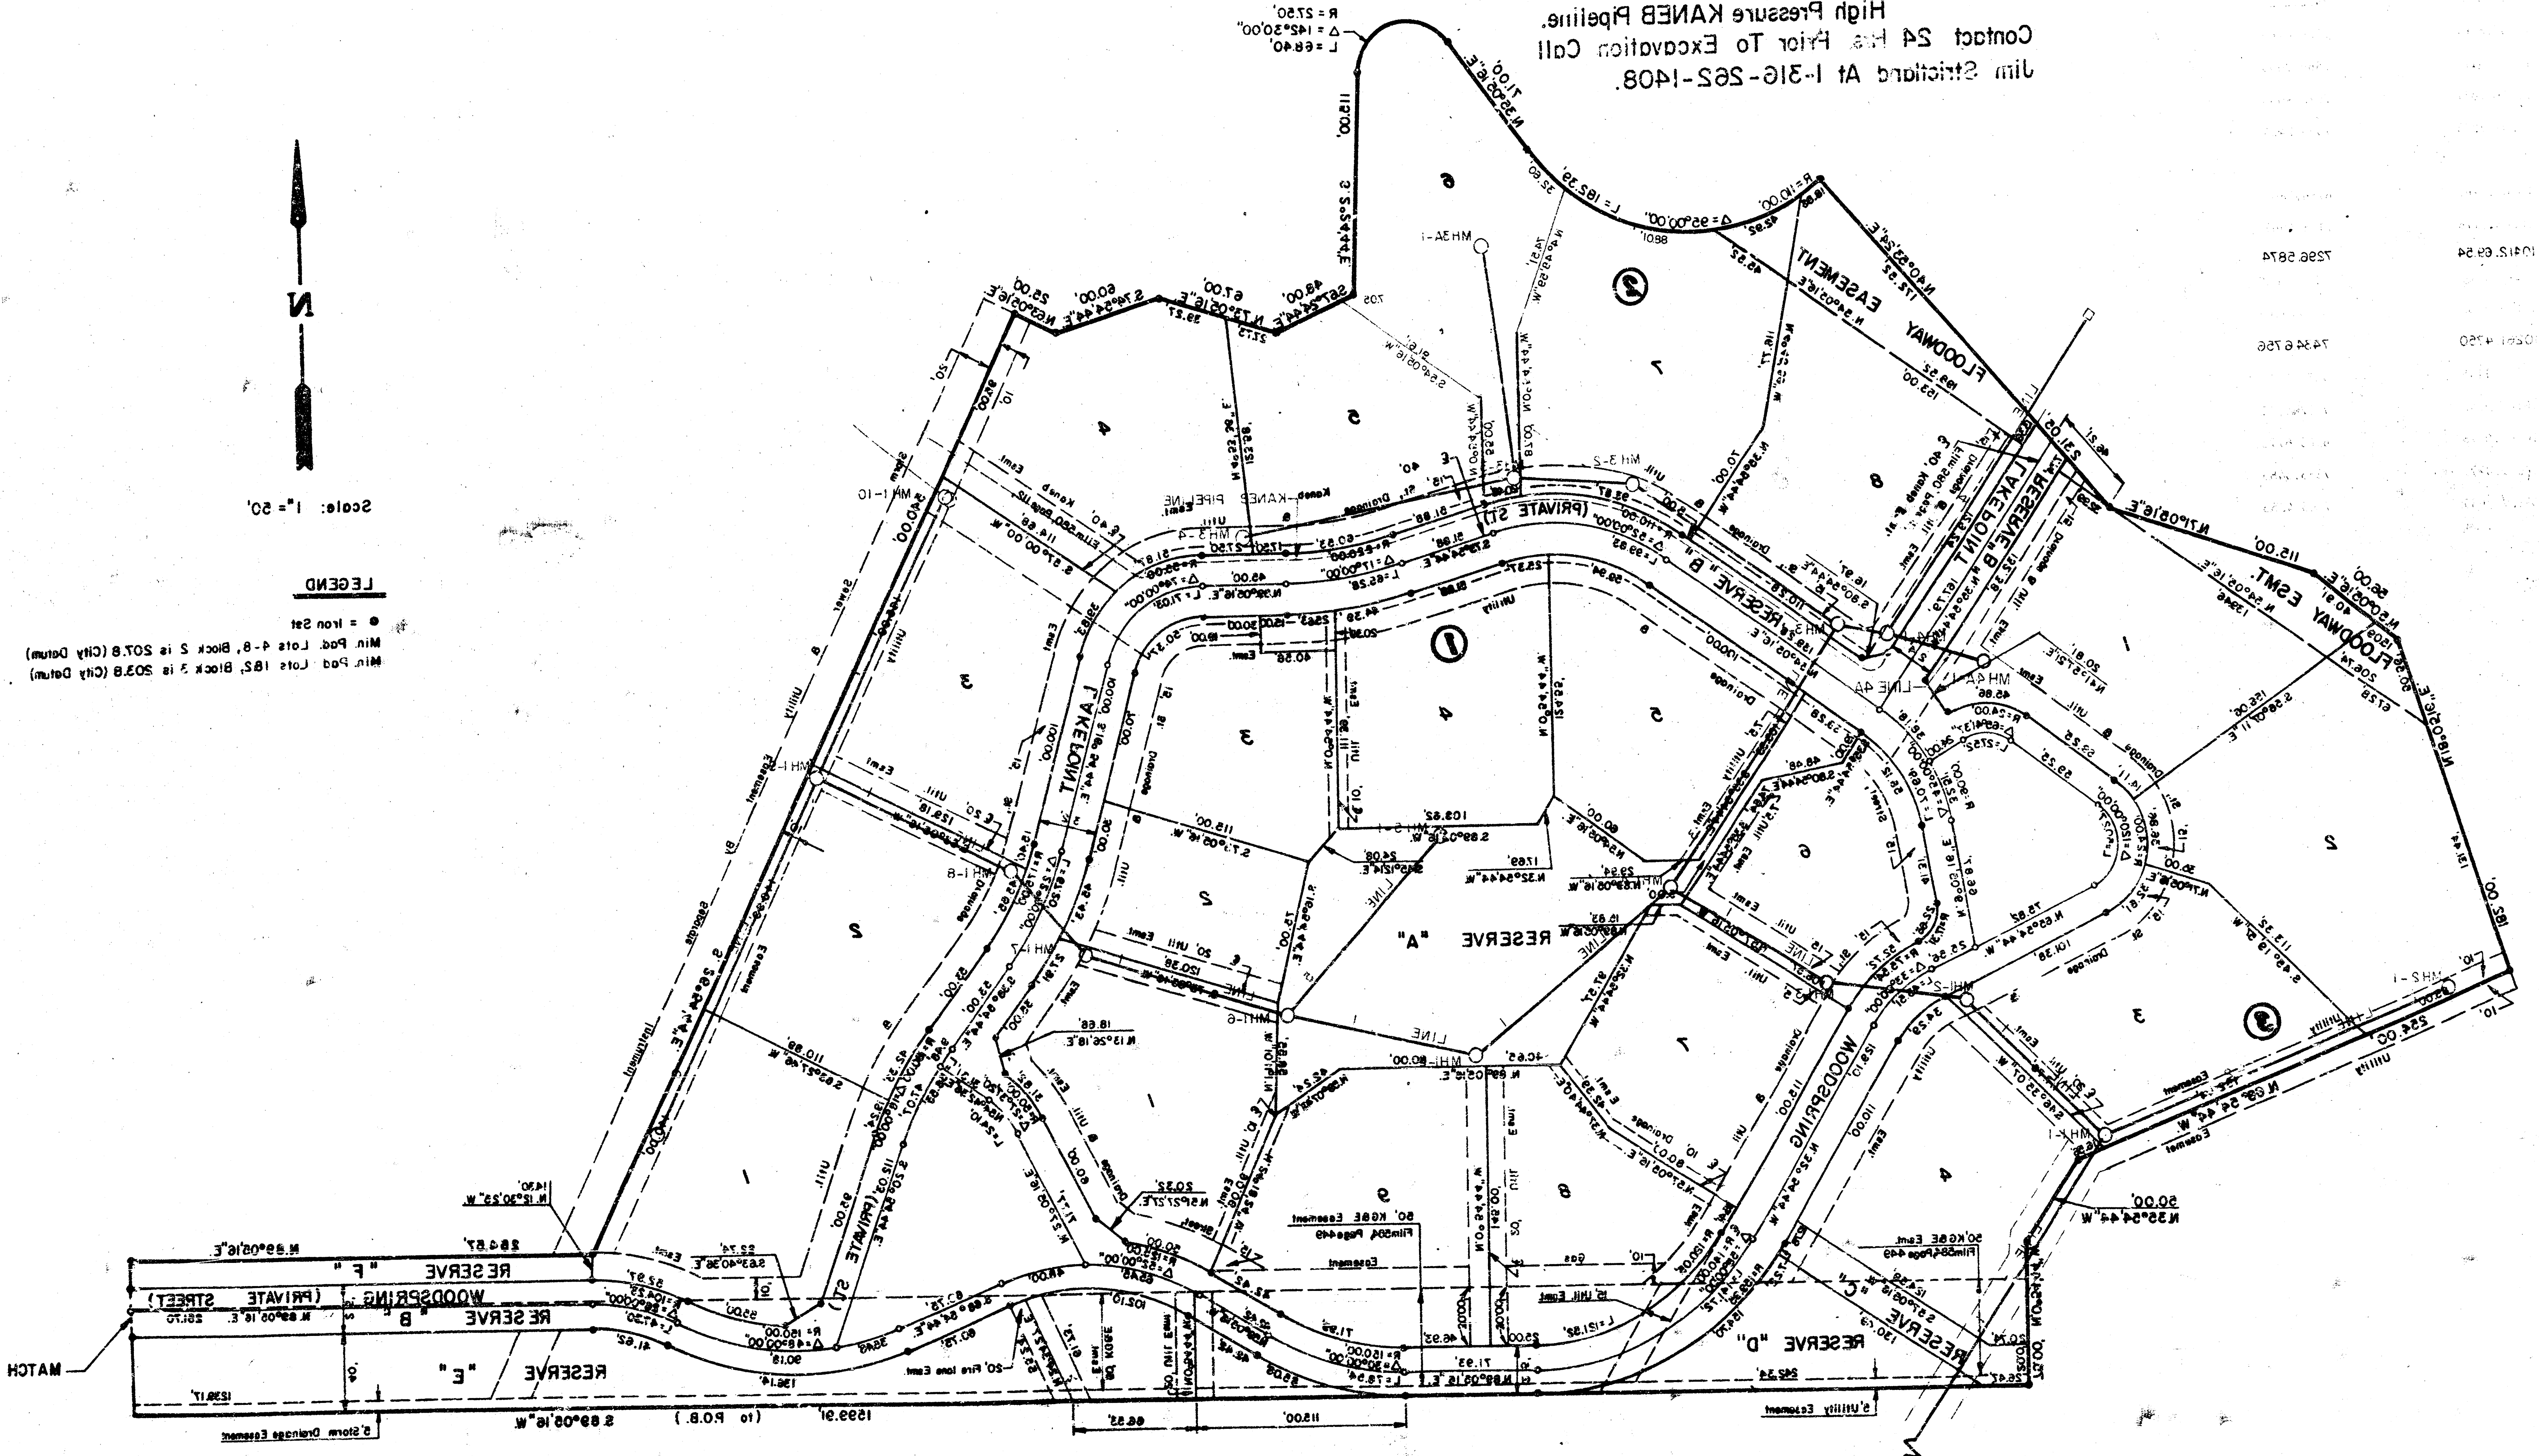

LEGEND  
• = Iron Stake  
Mile Post Route 4-B, Block 5 is 507.8 (City Datum)  
Mile Post Route 1-B, Block 5 is 507.8 (City Datum)

Scale: 1" = 50'

