

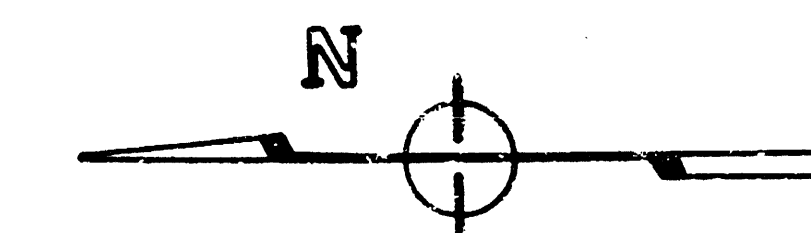


BENCH MARK: CITY DISC @ ROCK ROAD
 & 17TH ST. NORTH 20' E. of E. ROCK
 ROAD & 51' NORTH OF E. R.R. TRACKS
 ELEV. = 122.70 CITY DATUM

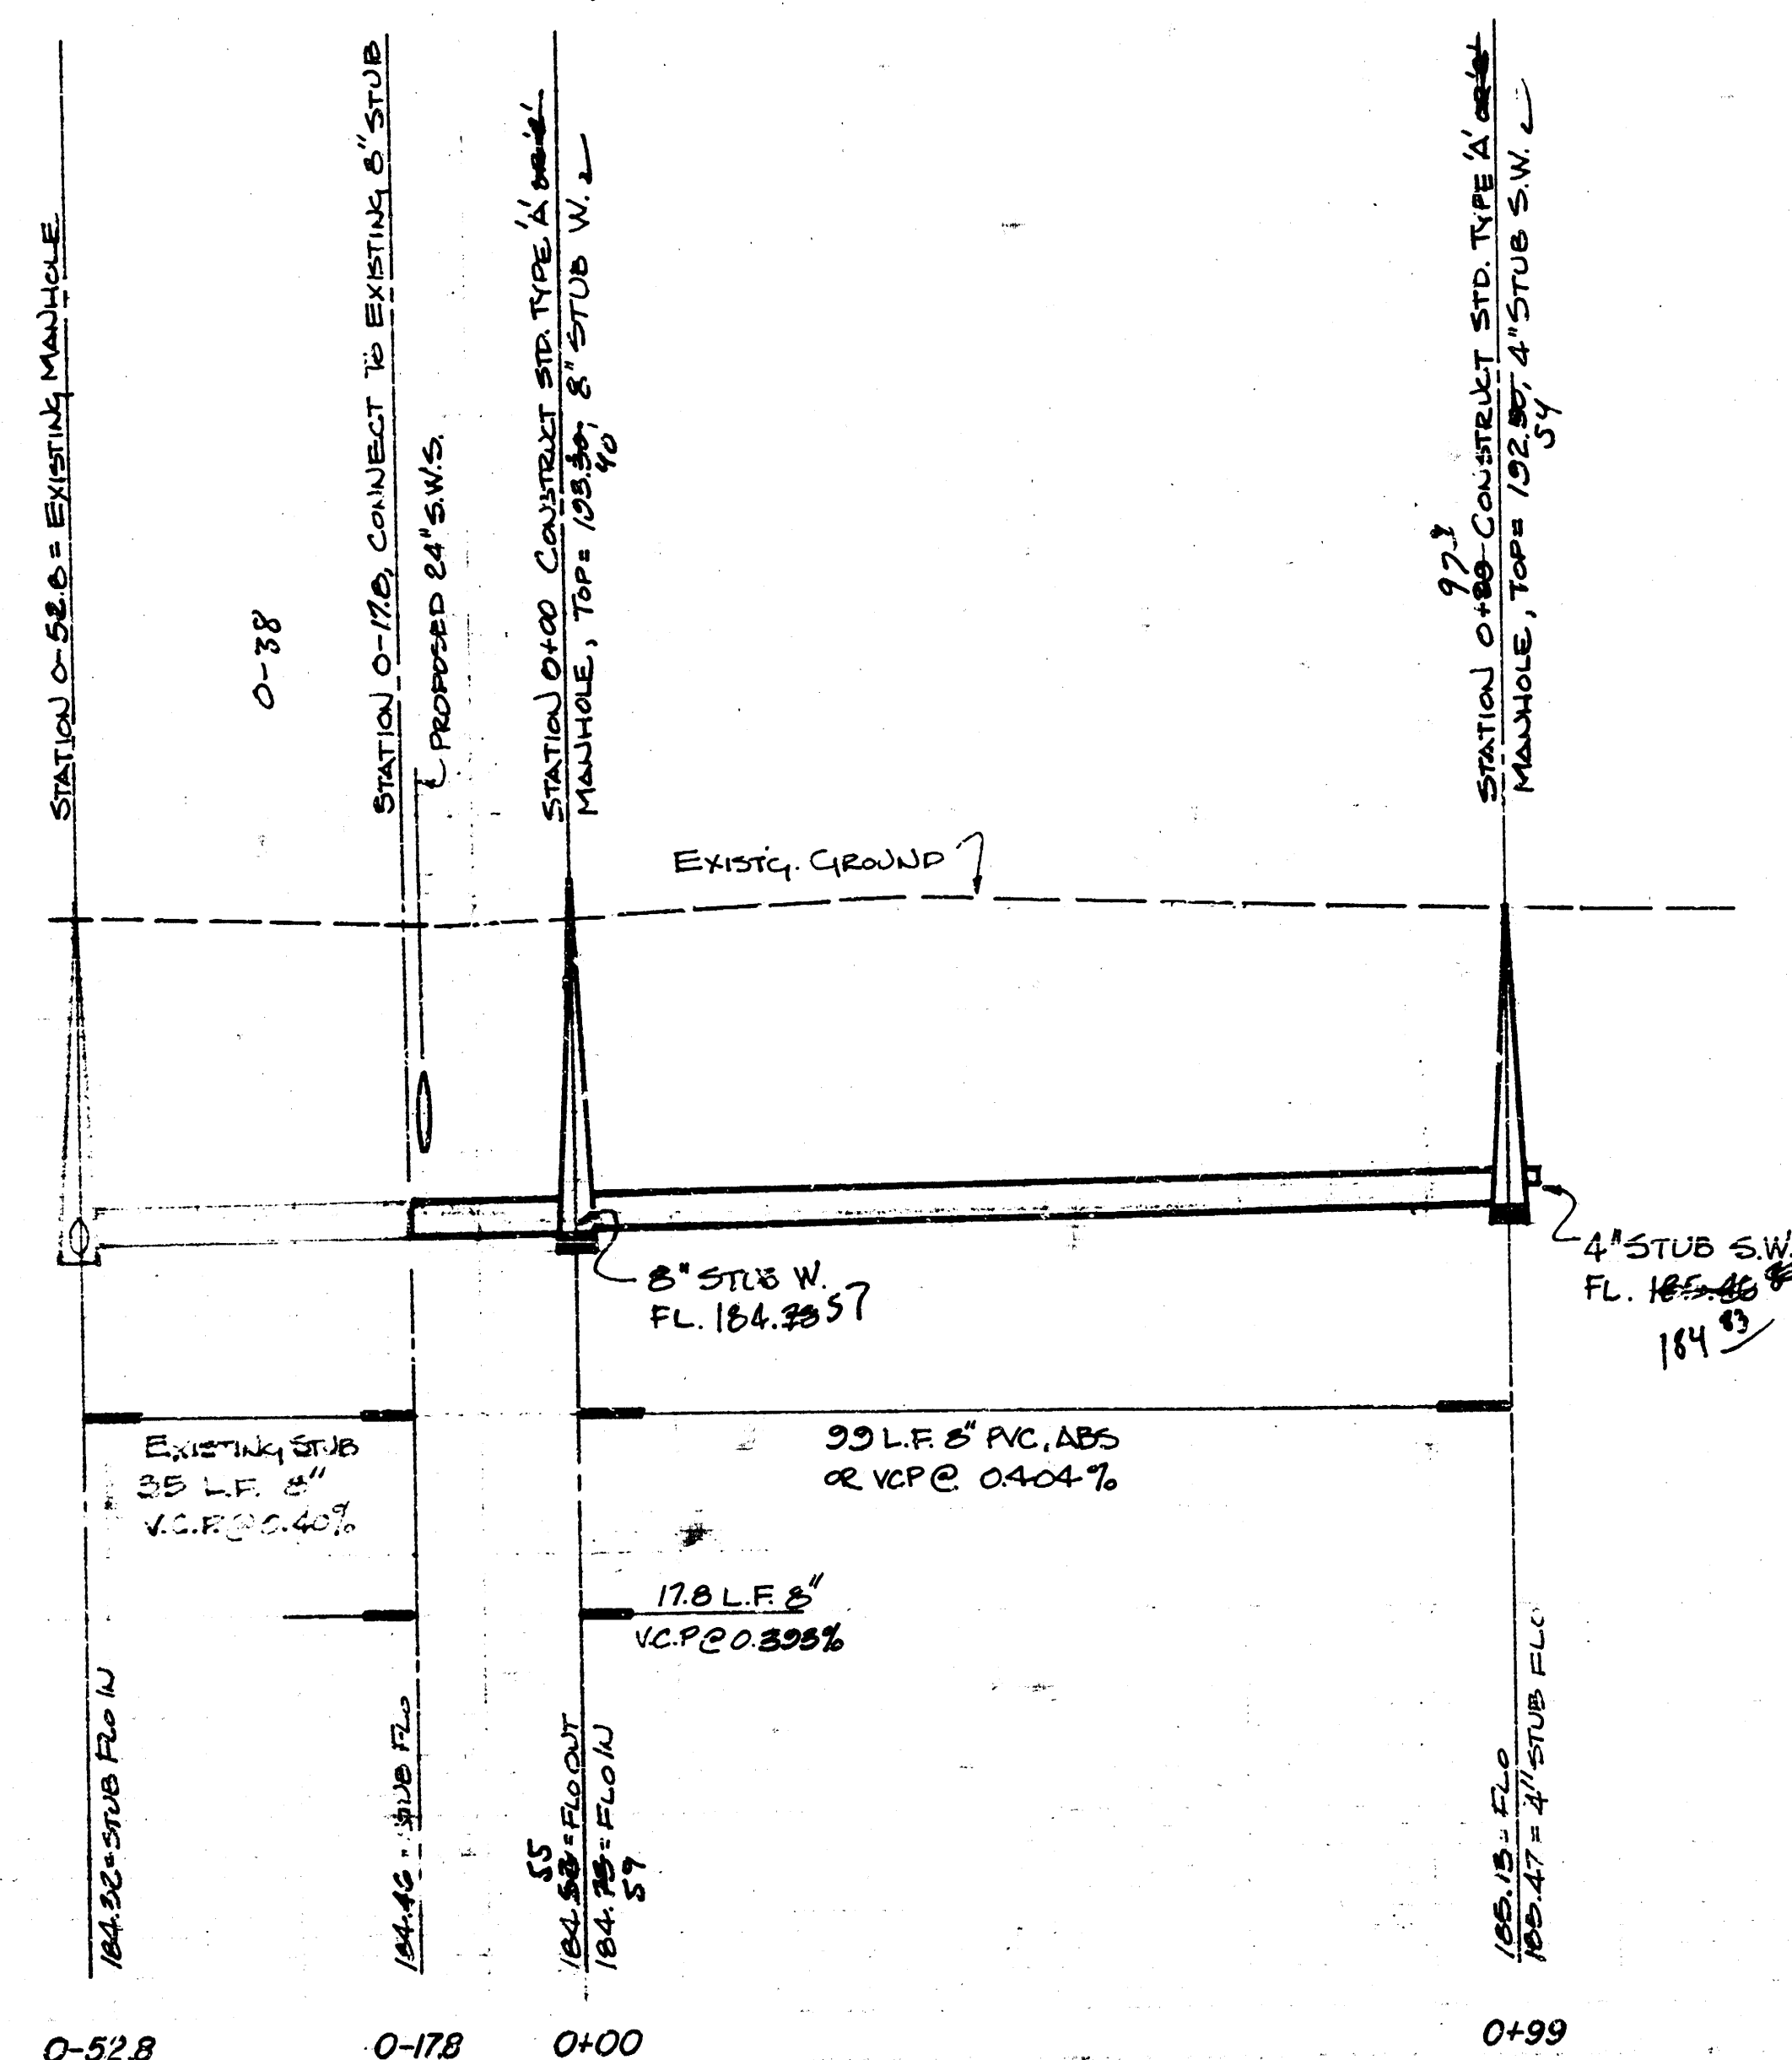

SCALE 1" = 20' HORIZ.
 1" = 5' VERT.

*As Built
 8/82
 7-85*

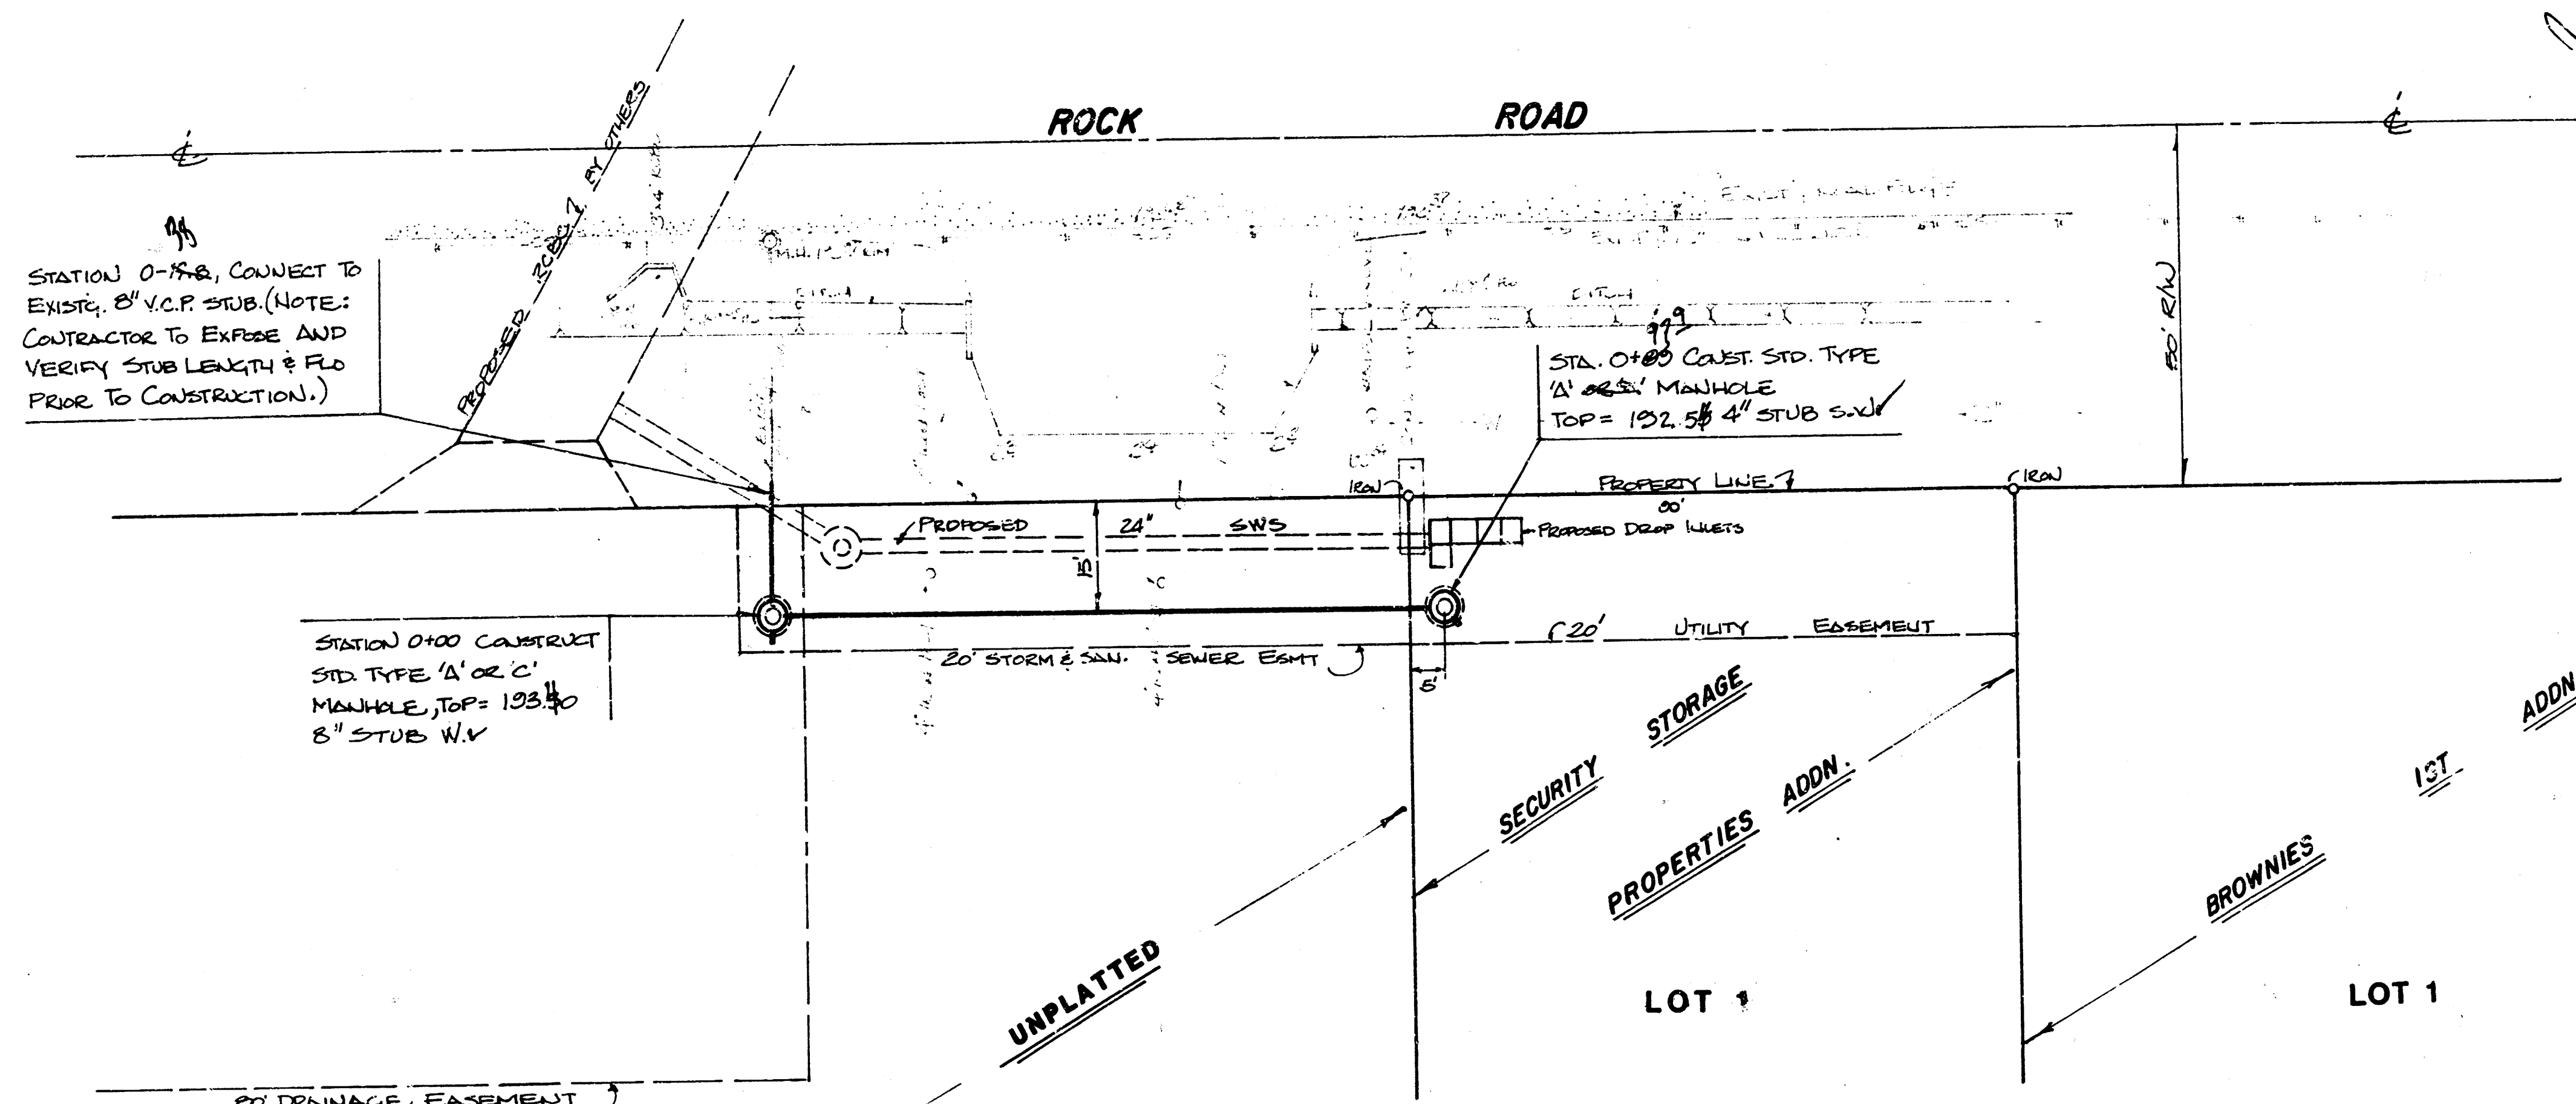

LATERAL 33, MAIN 22, W.I.S.
 TO SERVE LOT 1
 SECURITY STORAGE PROPERTIES ADDITION
 PROJECT NO.
 488-76-245-81363-000-000-001
 CITY OF WICHITA, KS

BAUGHMAN COMPANY, P.A.
 SURVEYING & ENGINEERING
 316/262-7271 • 330 LAURA • WICHITA, KANSAS 67211

FILMED FROM THE BEST
 AVAILABLE COPY.....