


LATERAL 1, MAIN 23, WAR INDUSTRIES SEWER



City of Wichita, Kansas


R. W. BRUGGEMAN: DIRECTOR OF ENGINEERING/CITY ENGINEER

DATE :

PROJECT NO. 468-76-245-80999-000-000-001

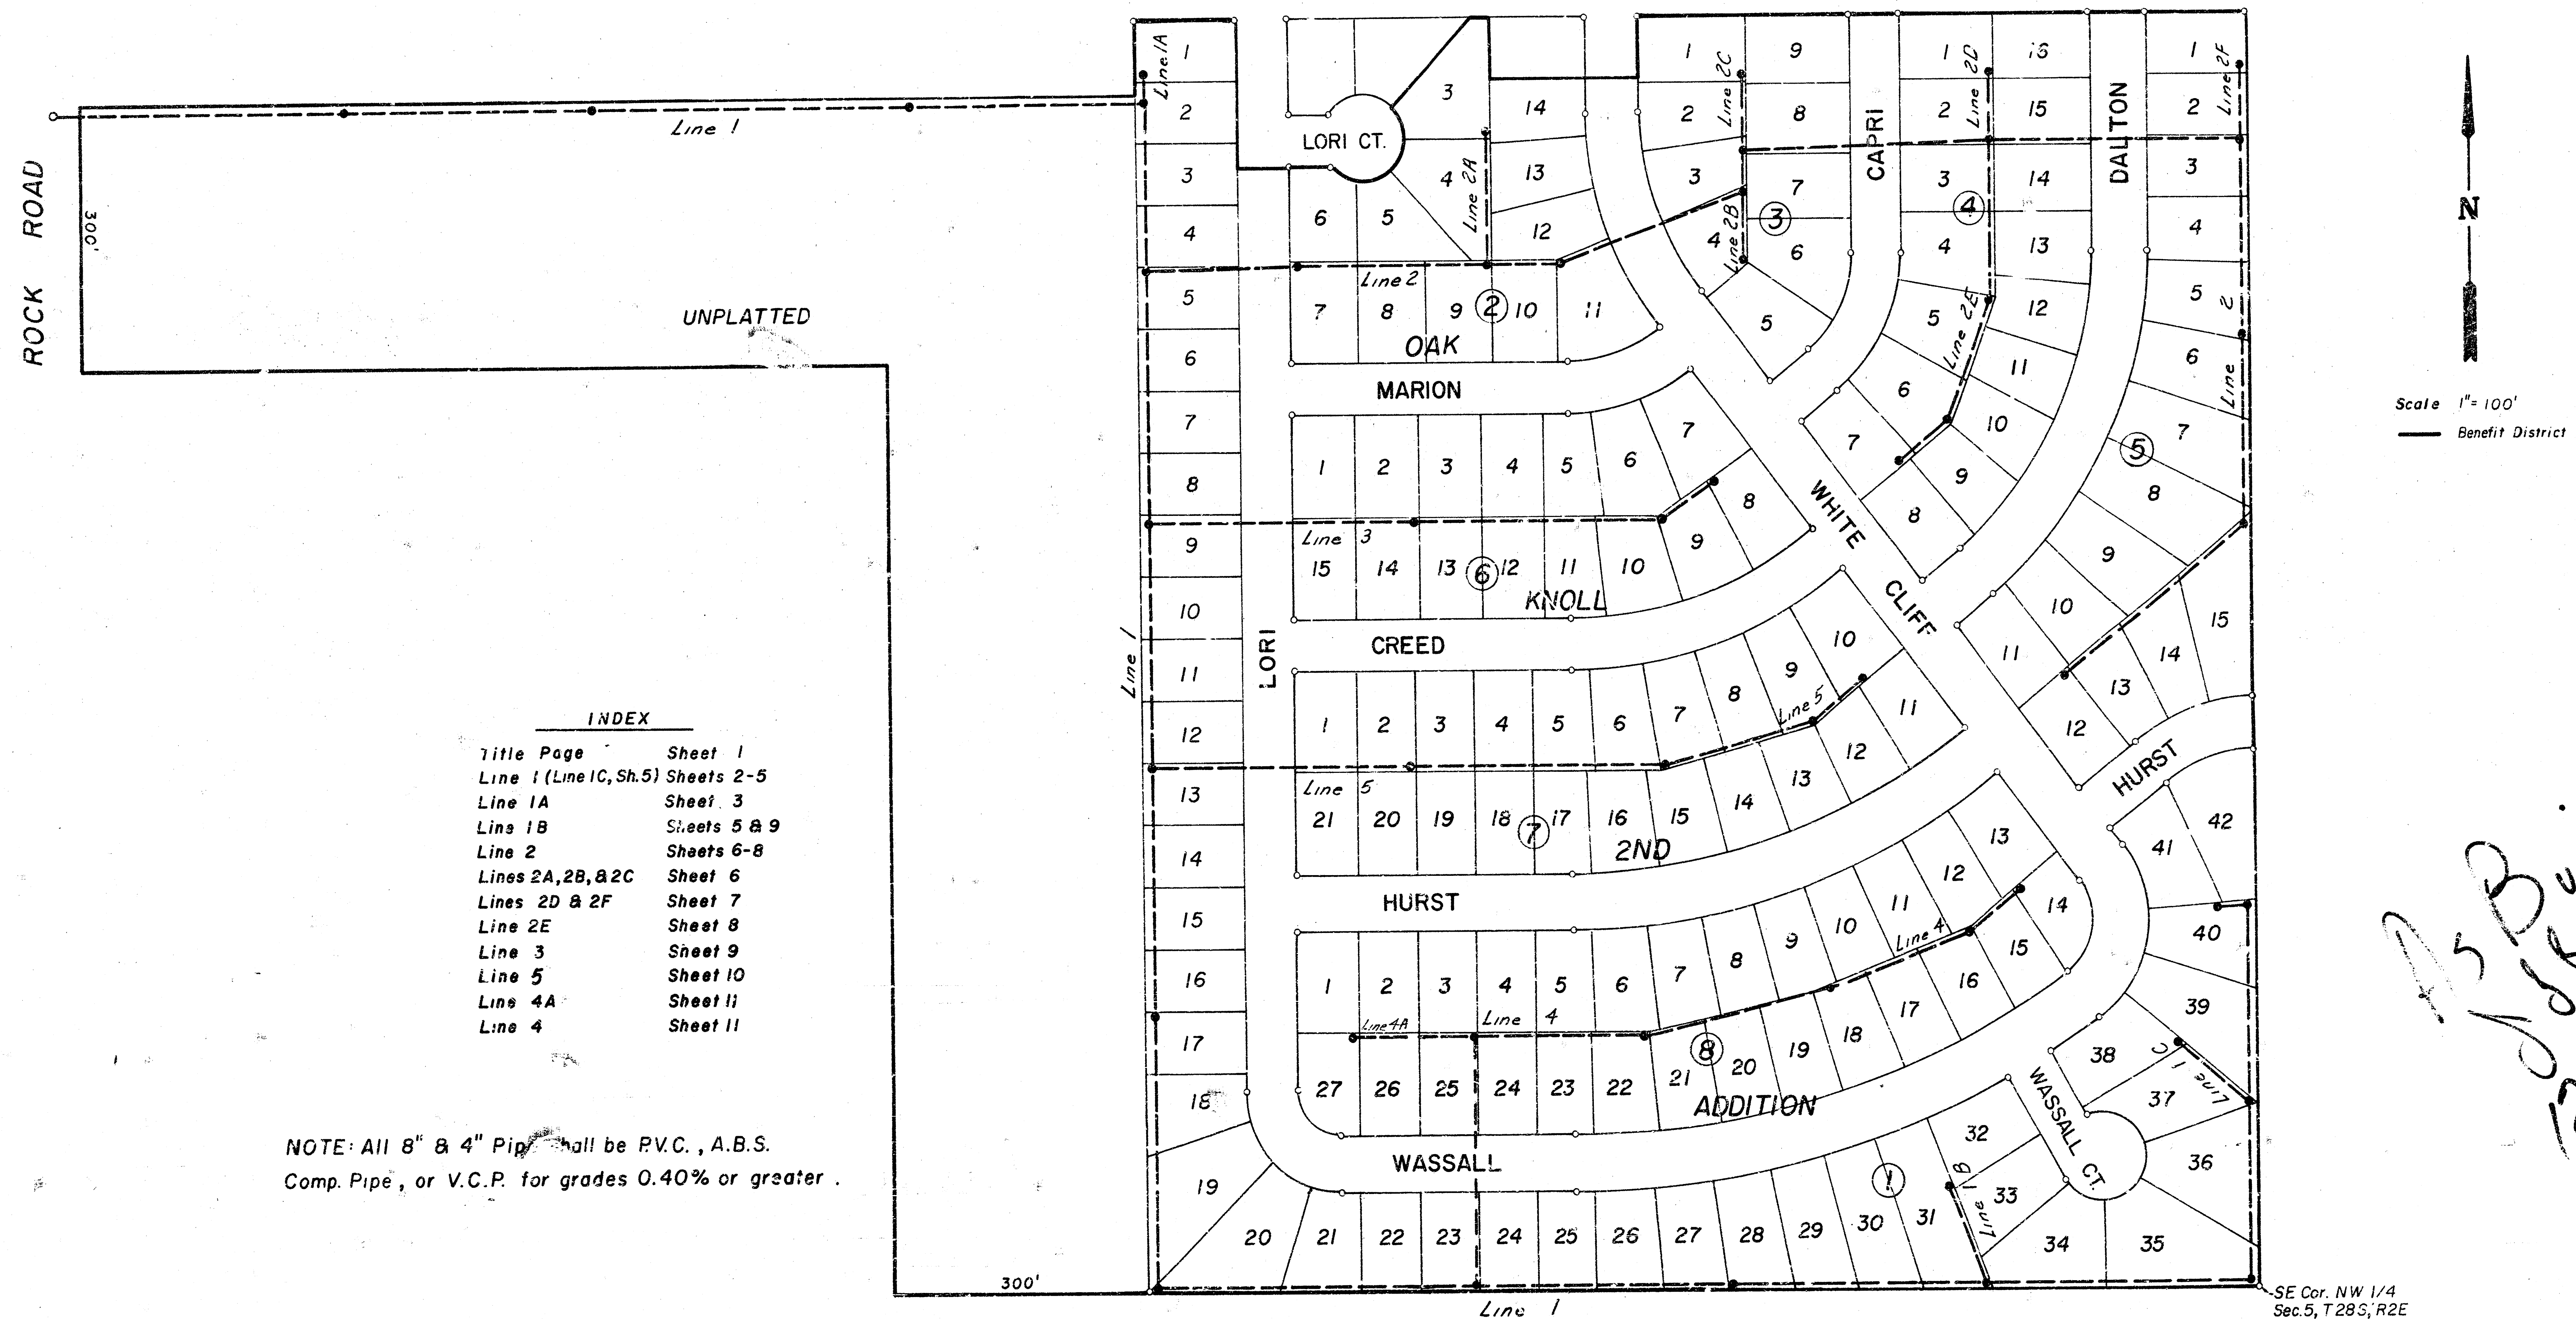

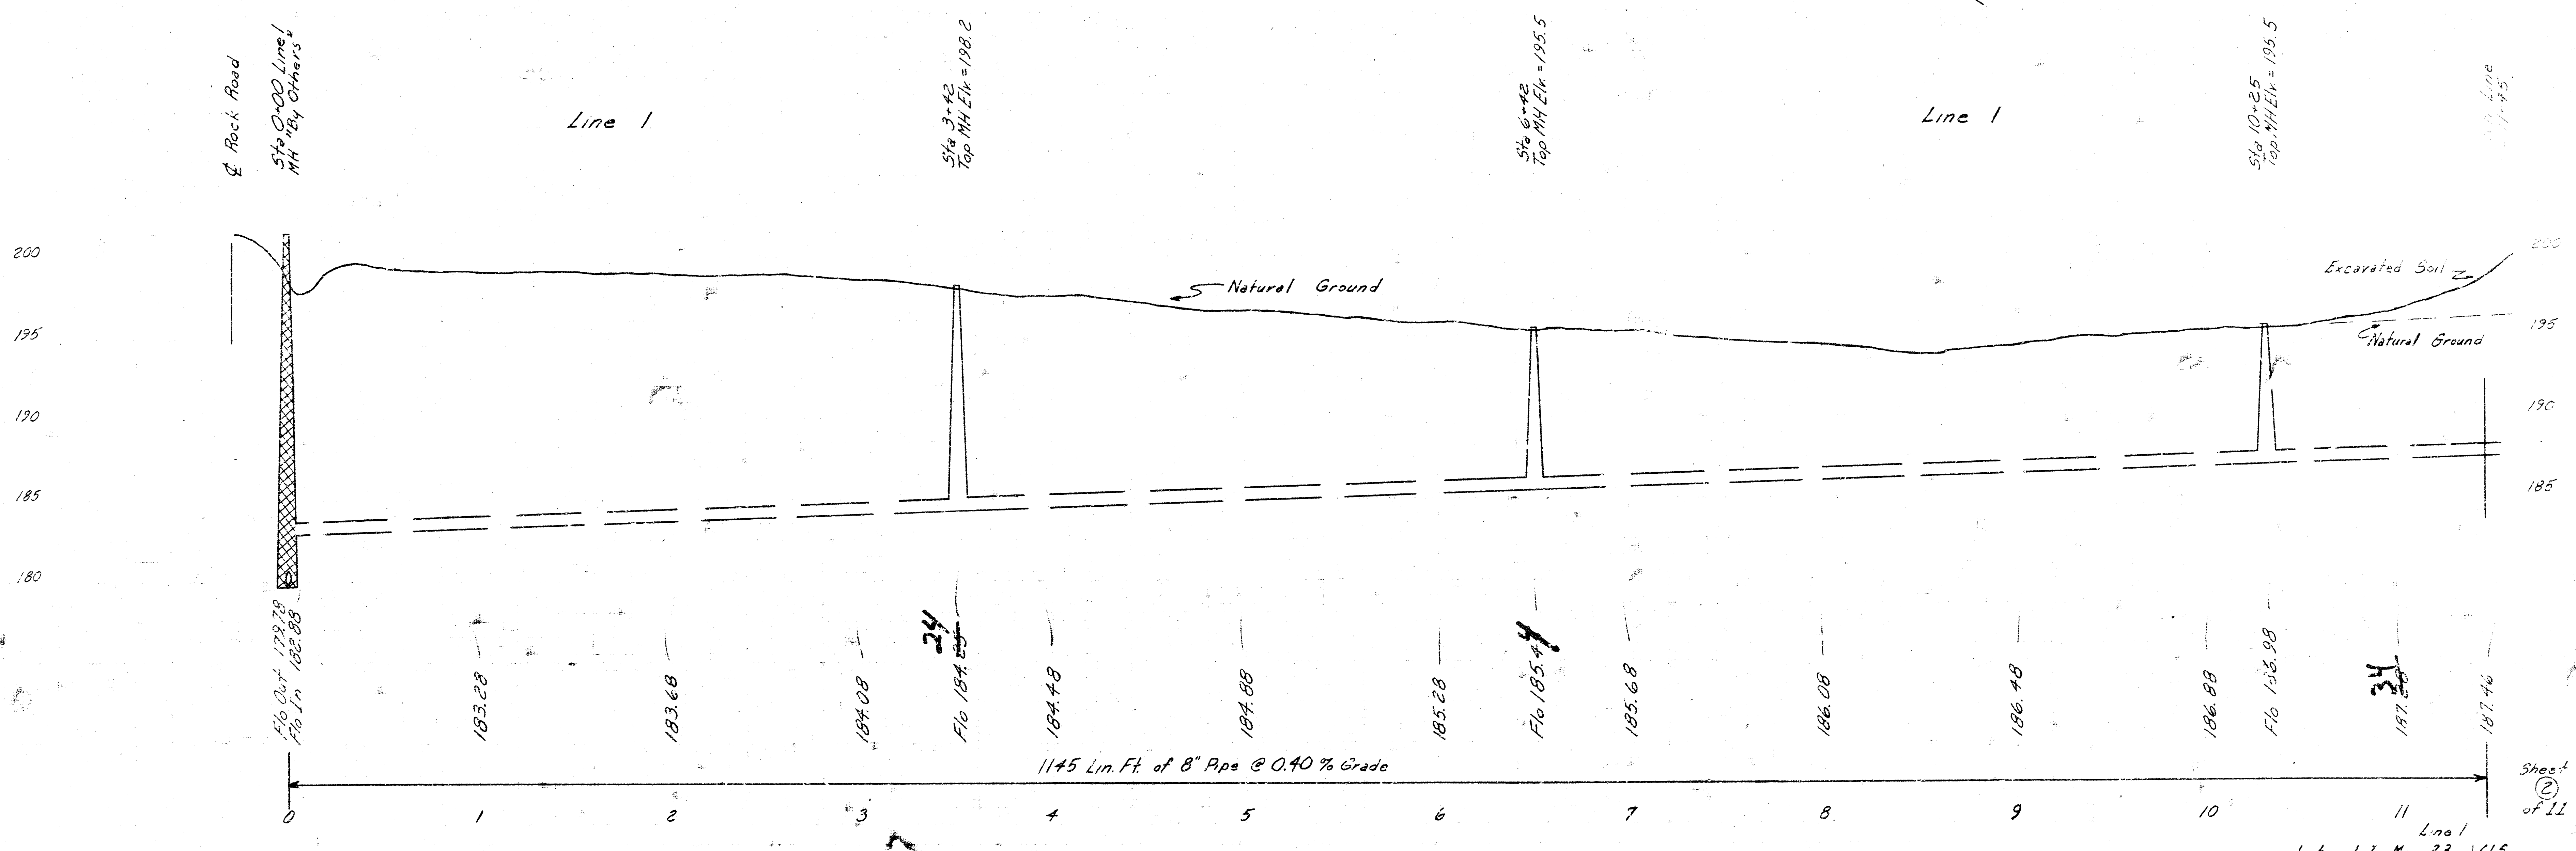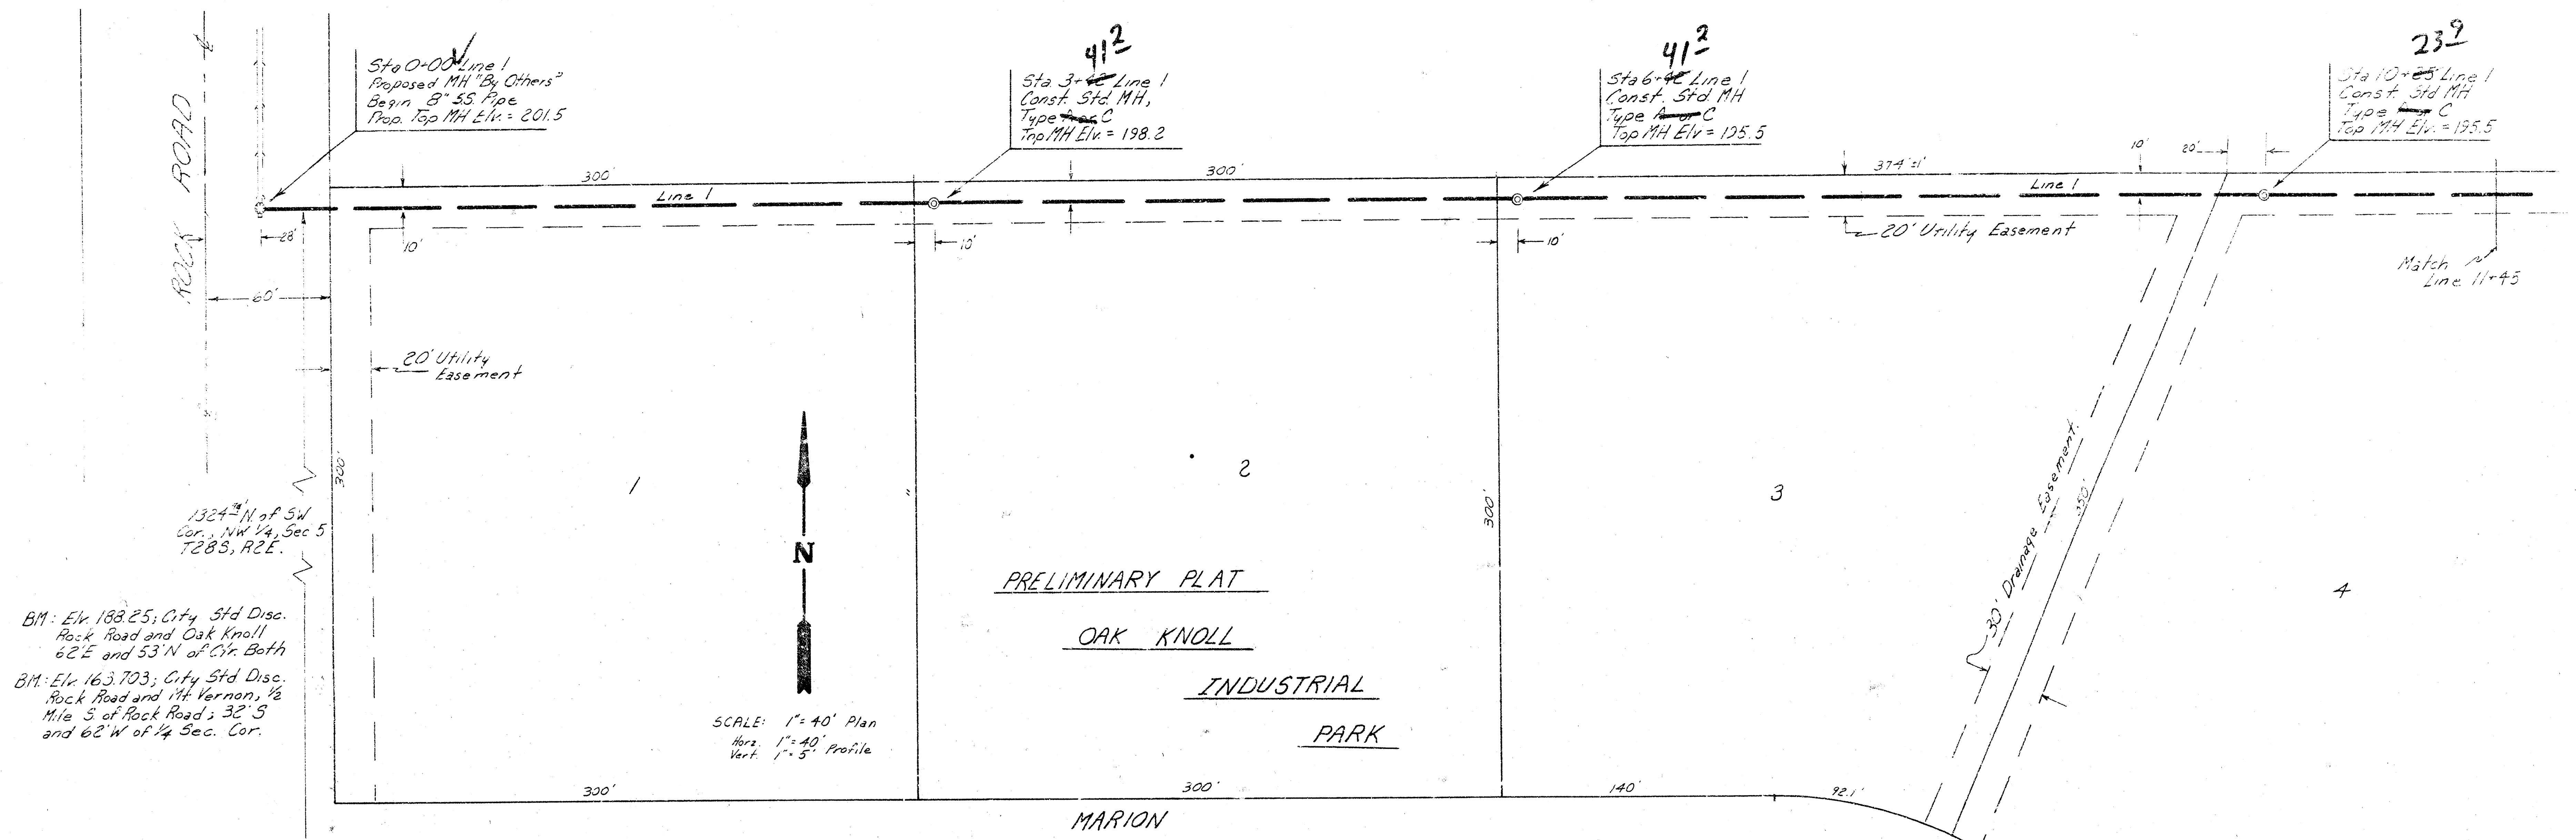


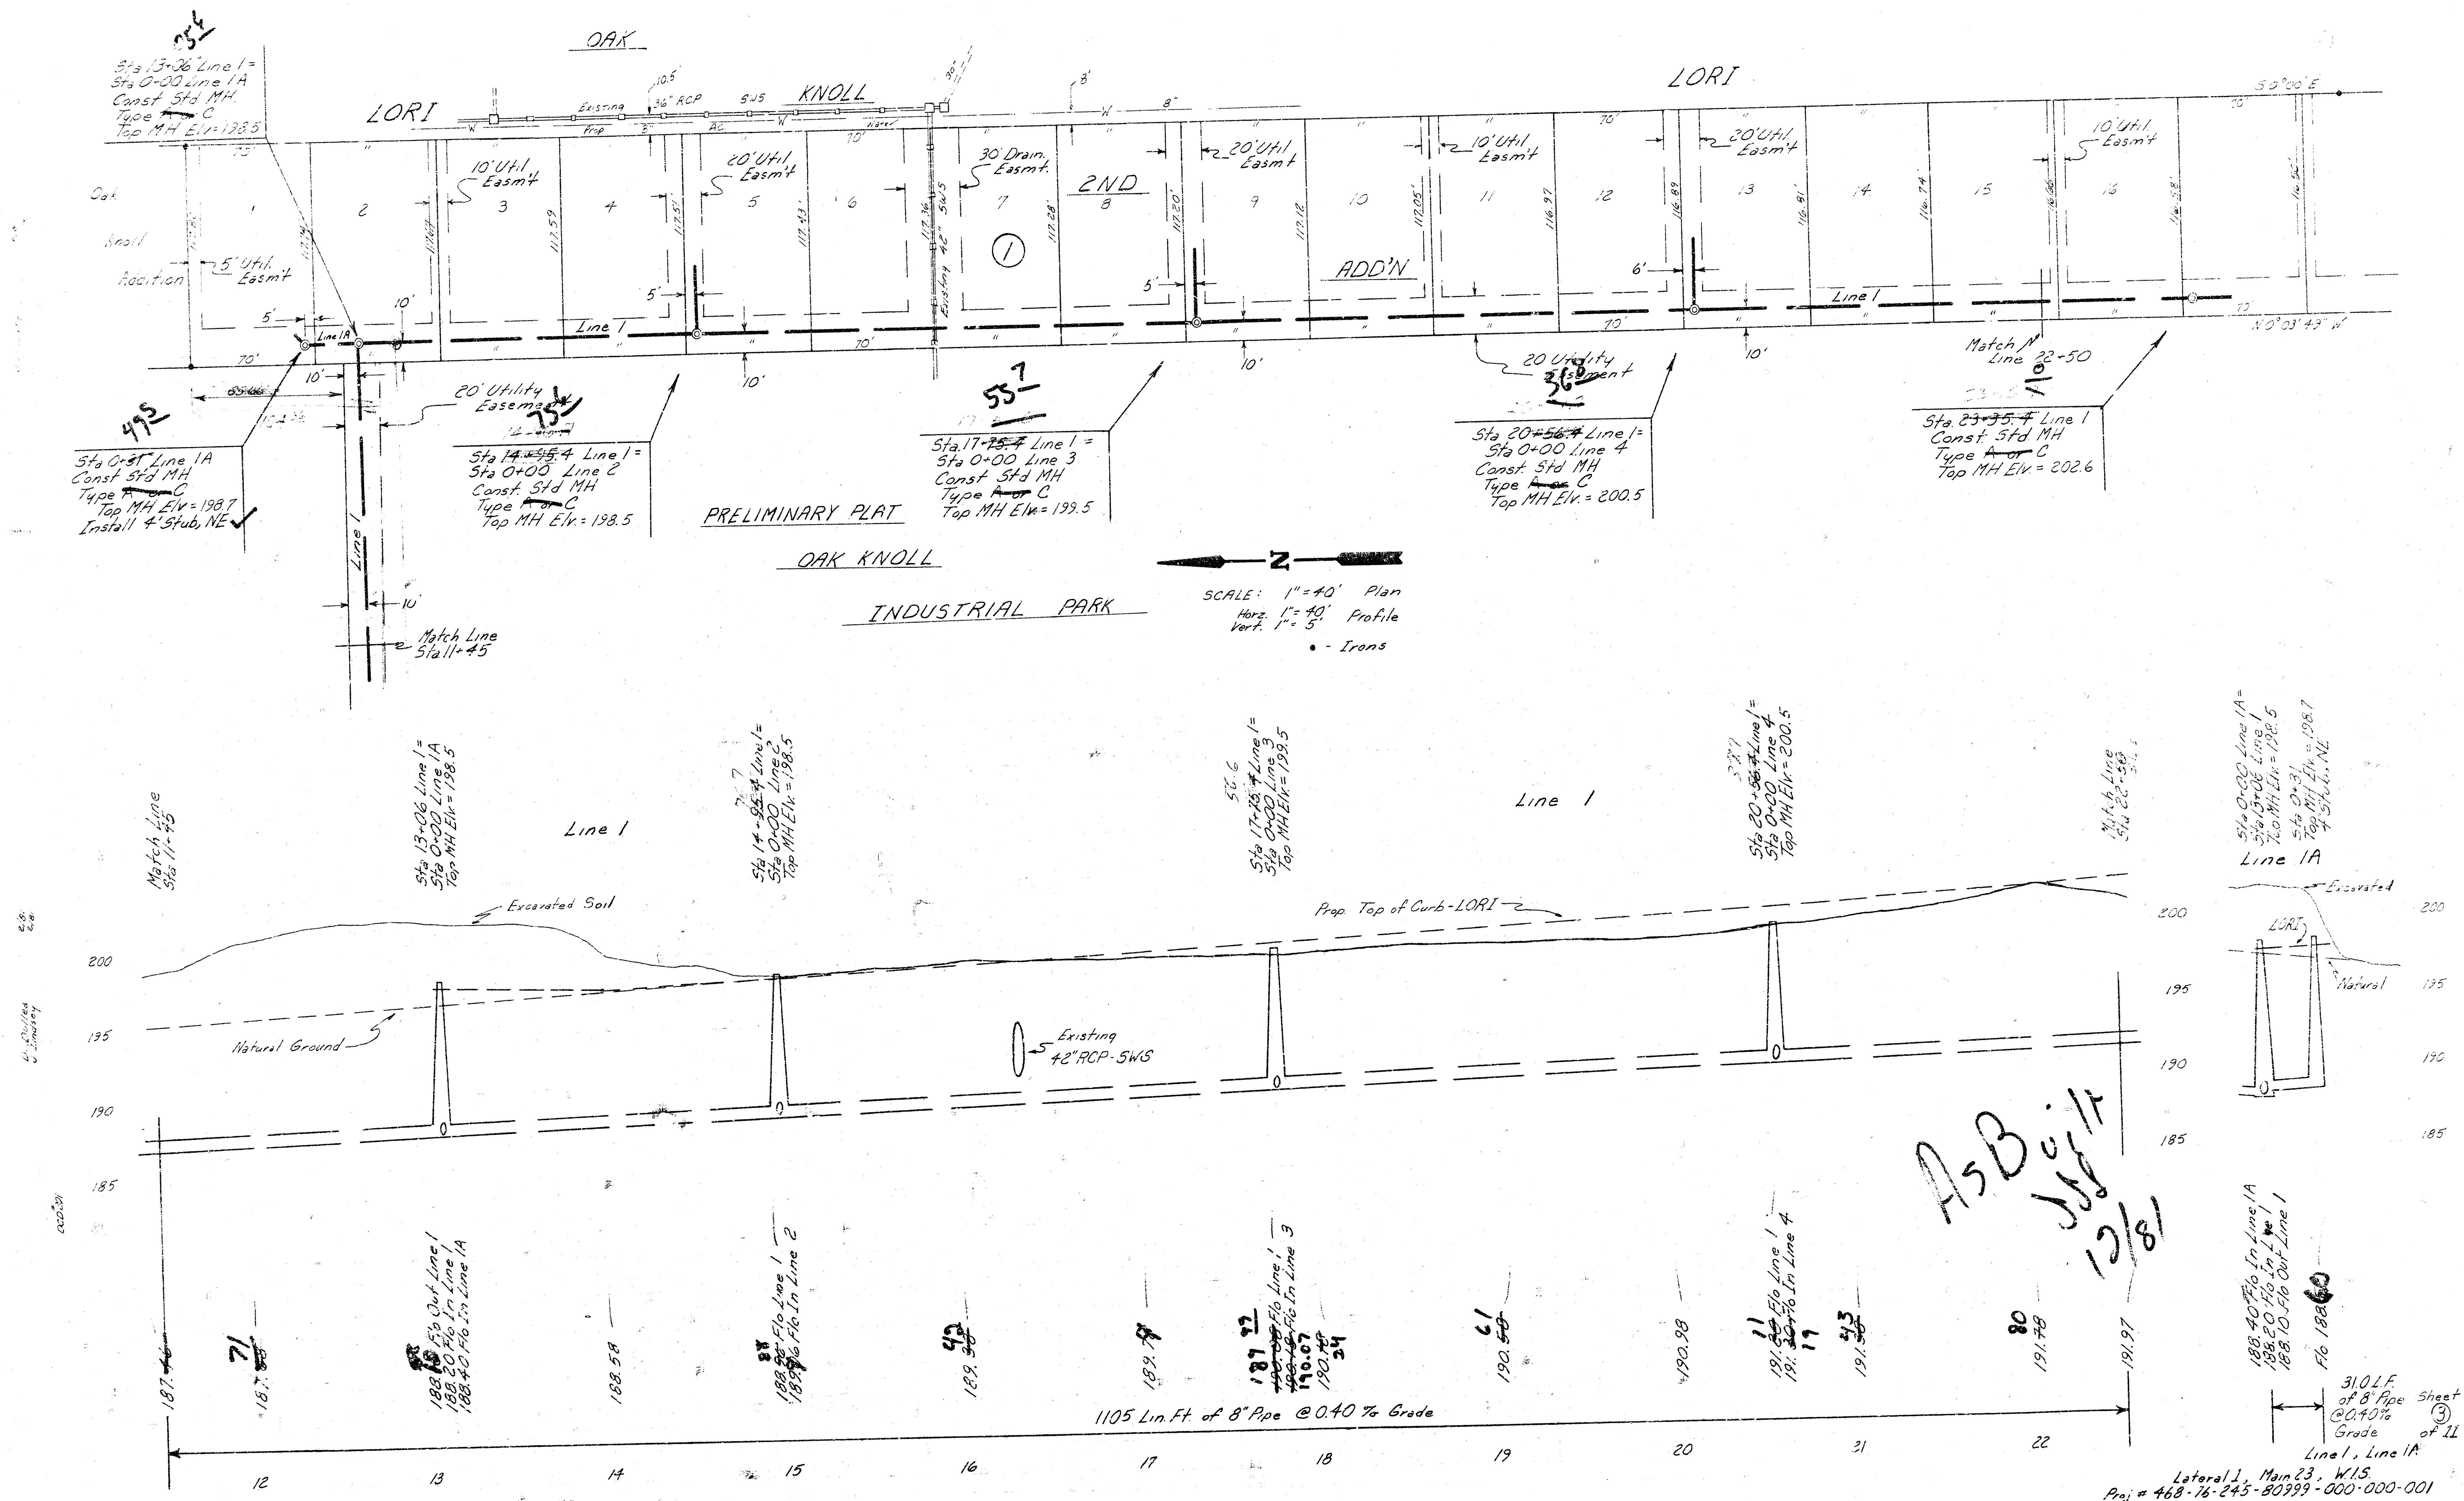


ASBuilt
5/8
12/81



188.40 Flo In Line 1A
188.20 Flo In Line 1
188.10 Flo Out Line 1
Flo 188.60

31.0 L.F.
of 8" Pipe Sheet
@ 0.40% (3)
Grade of 11
Line 1, Line 1A

Lateral 1, Main 23, W.I.S.
Proj # 468-76-245-80999-000-000-001

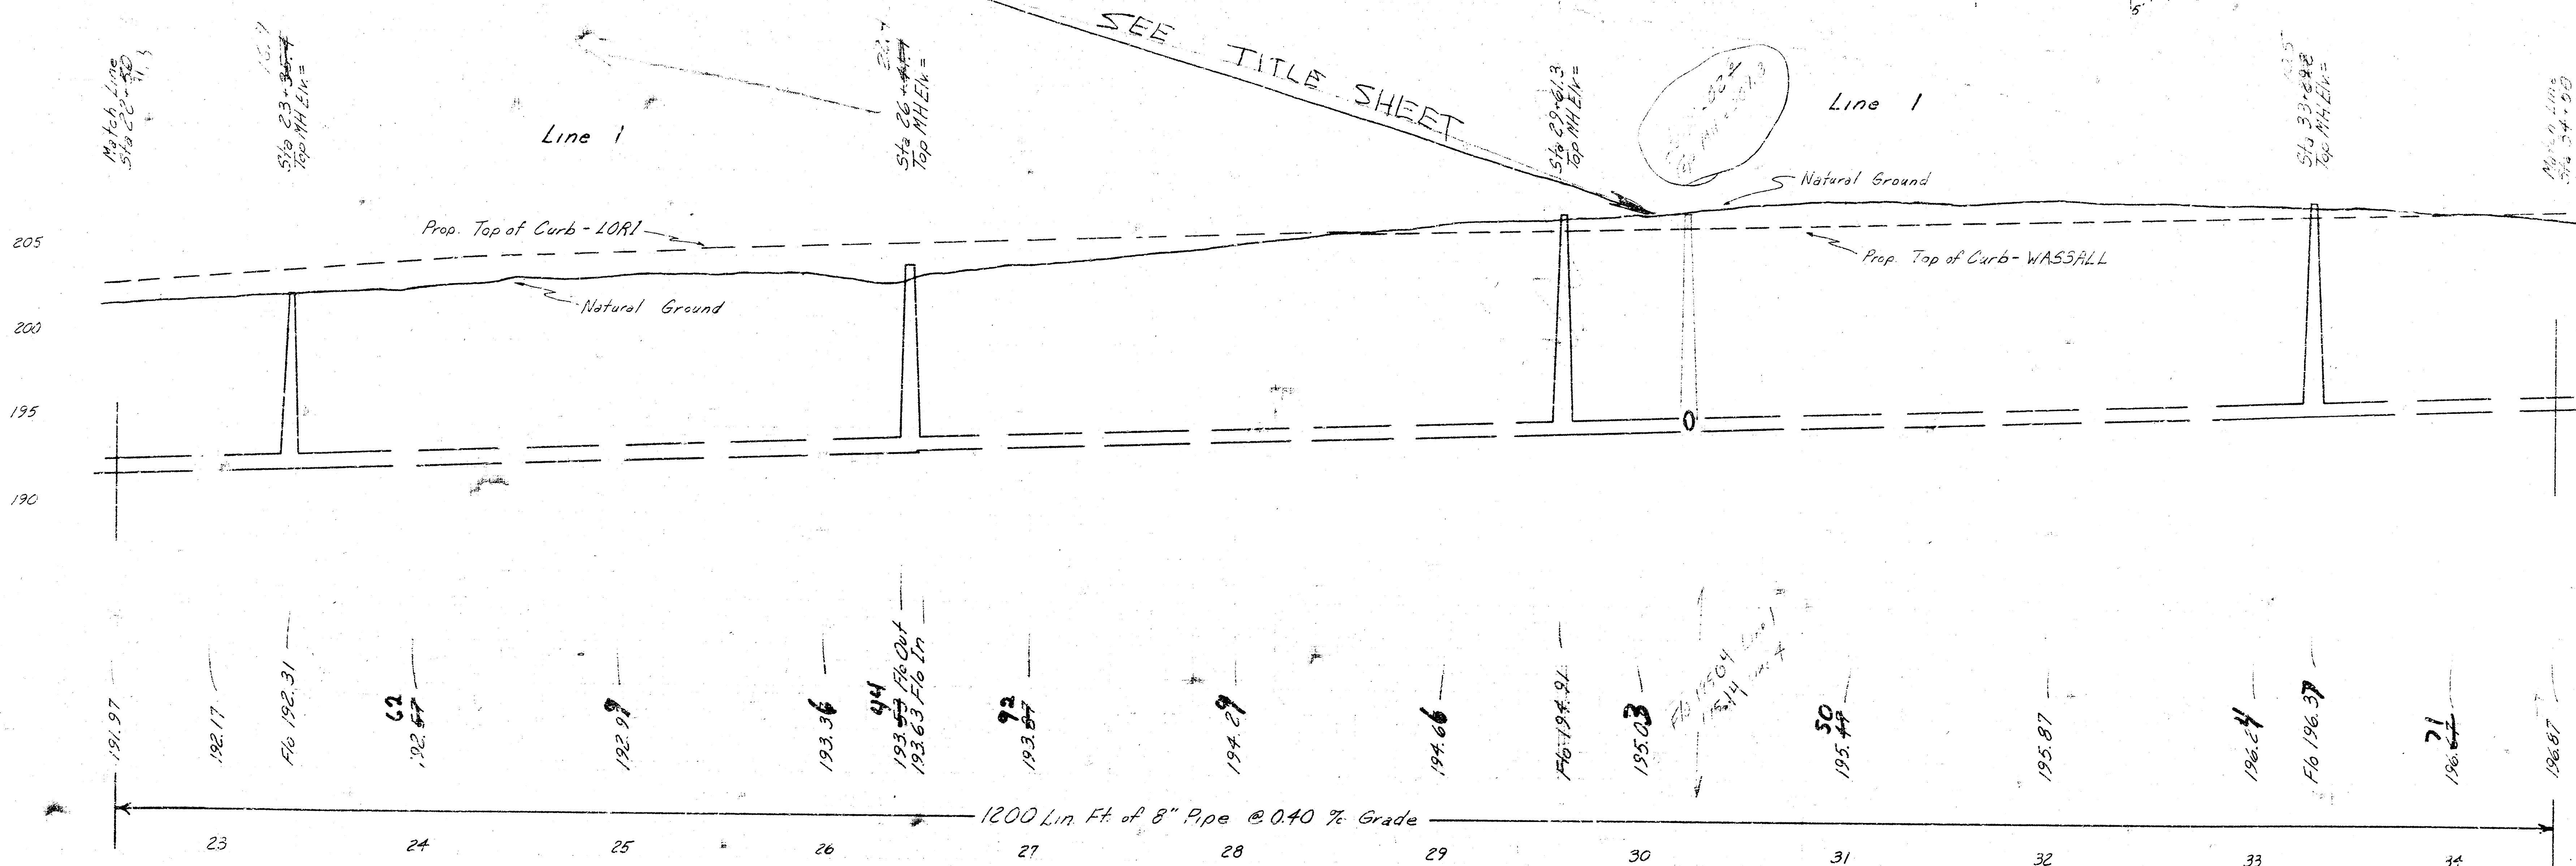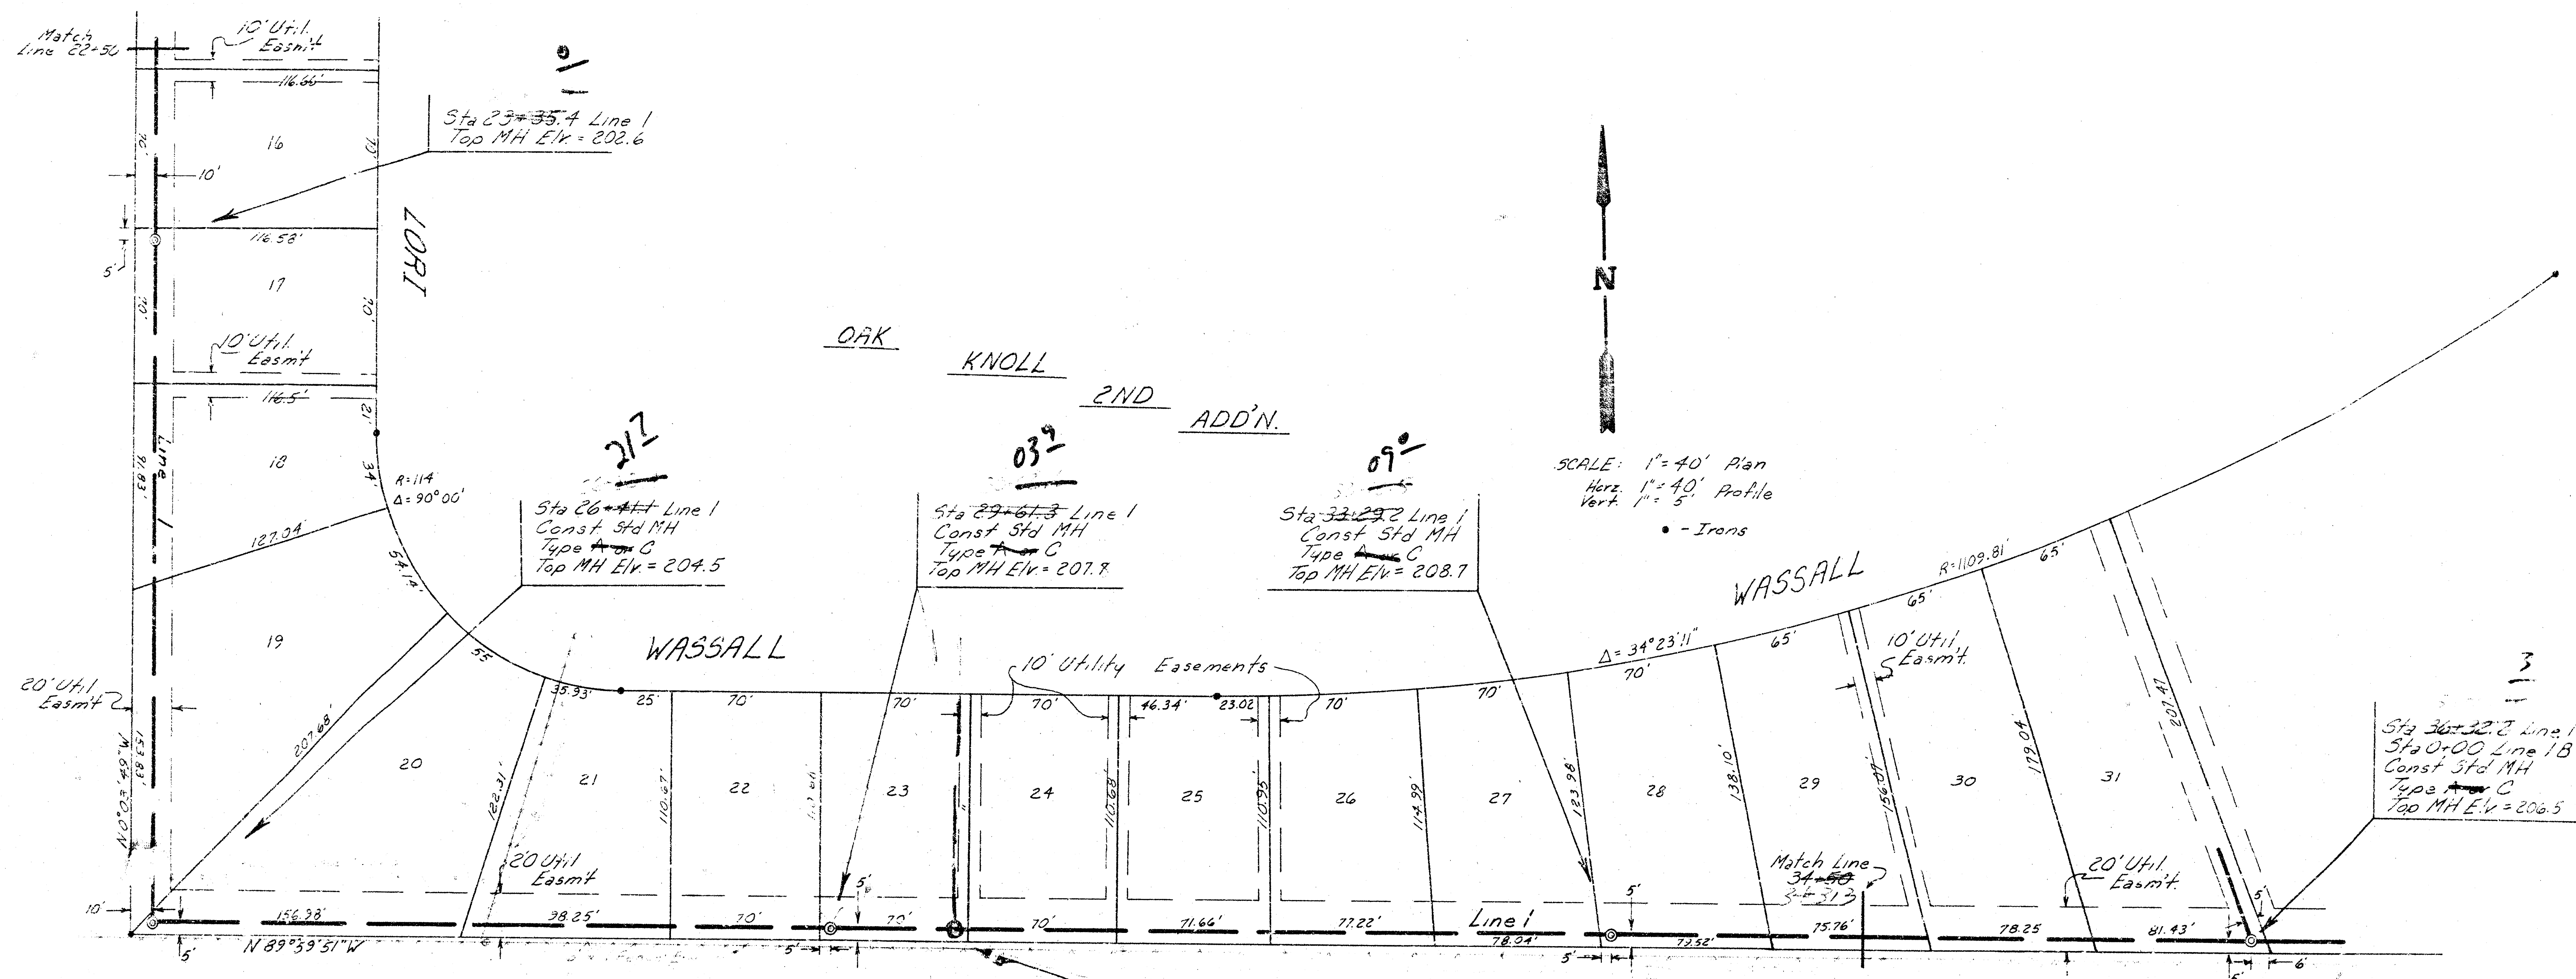


SCALE: 1" = 40' Plan
 Horiz. 1" = 40' Profile
 Vert. 1" = 5' Profile
 • - Irons

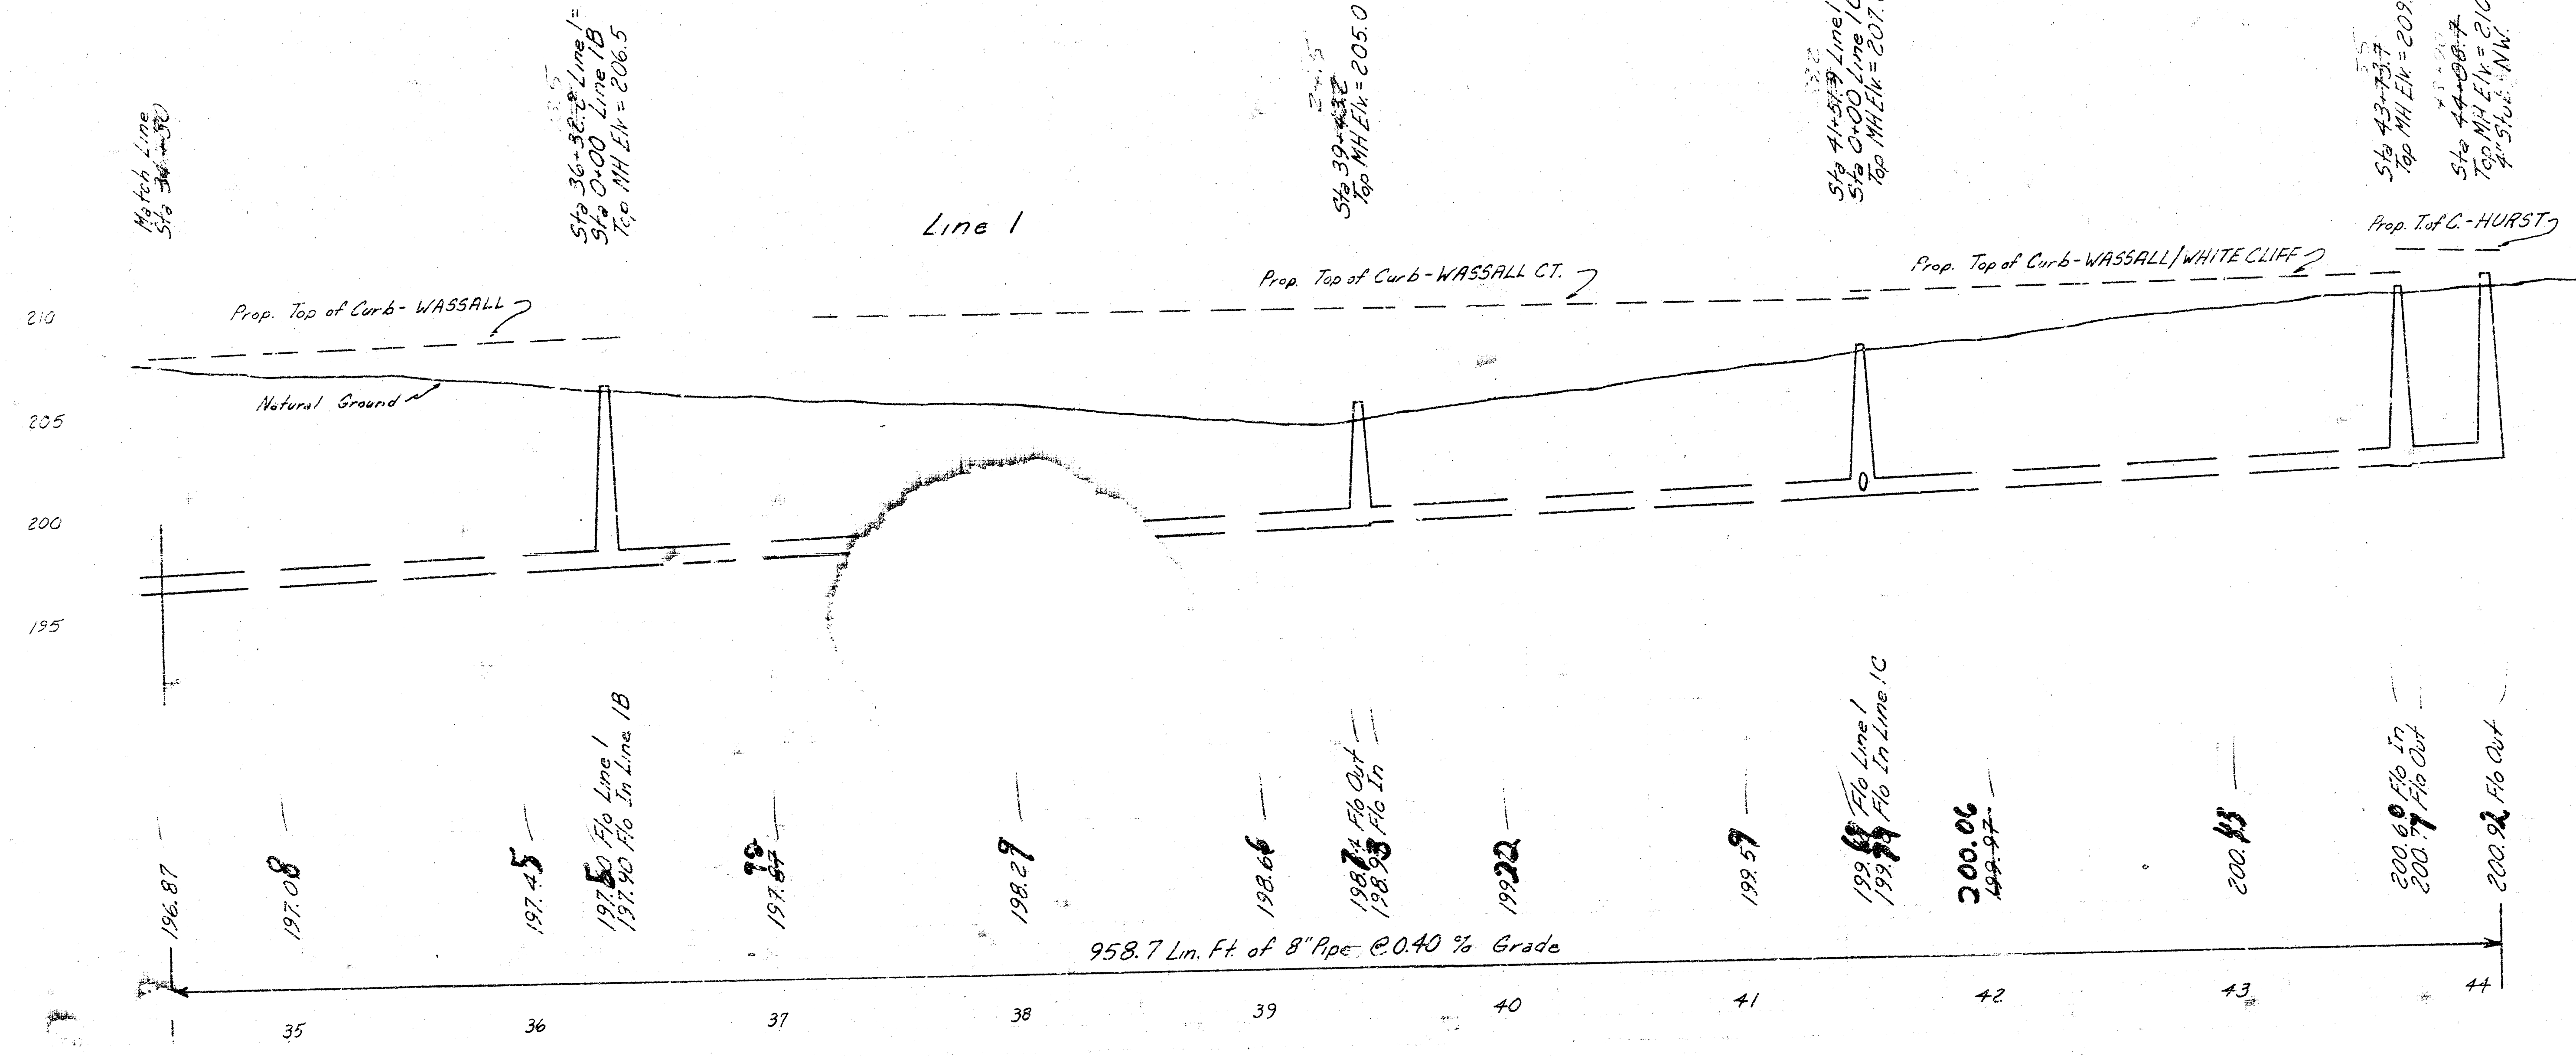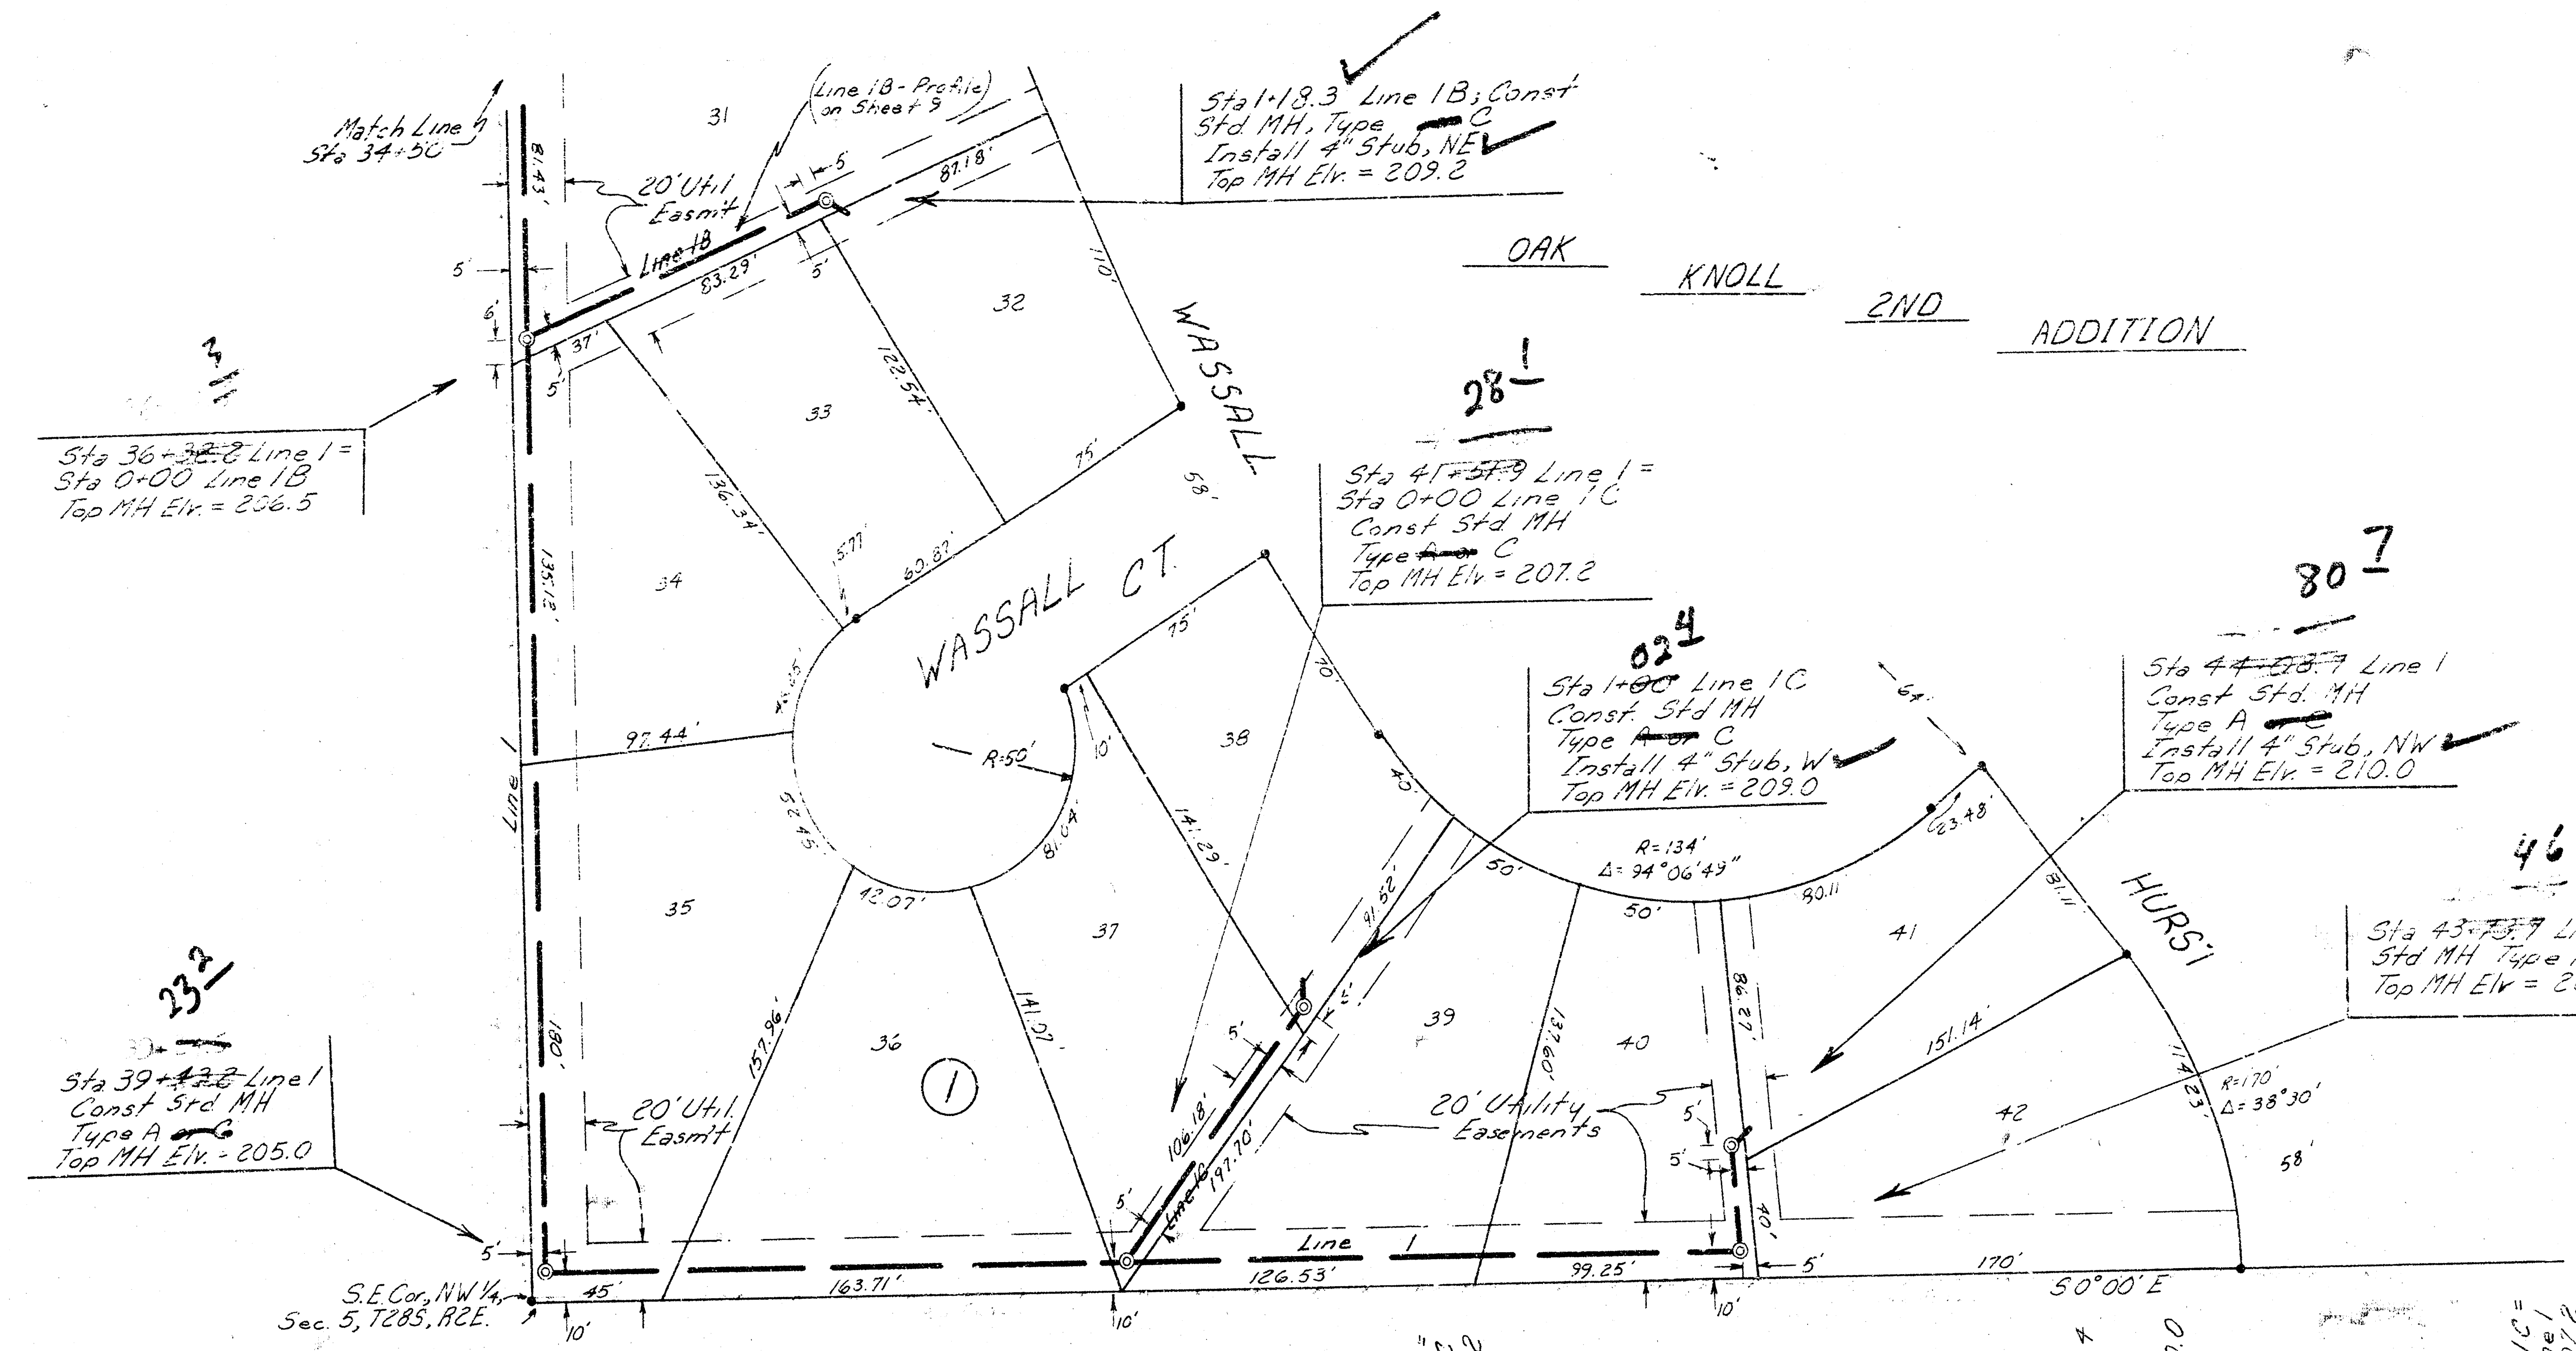


Line 1C
 Prop. Top of Curb - WASSALL CT.
 210
 205
 200
 195
 199.90 Flo In Line 1C
 199.78 Flo In Line 1
 200.21 Flo Out
 100 L.F. of 8" Pipe
 @ 0.40 % Grade
 Line 1, Line 1C
 Lateral 1, Main 23, W.I.S.
 Proj. # 468-16-245-80999-000-000-001
 Sheet 5 of 11

FILMED FROM THE BEST
 AVAILABLE COPY.....

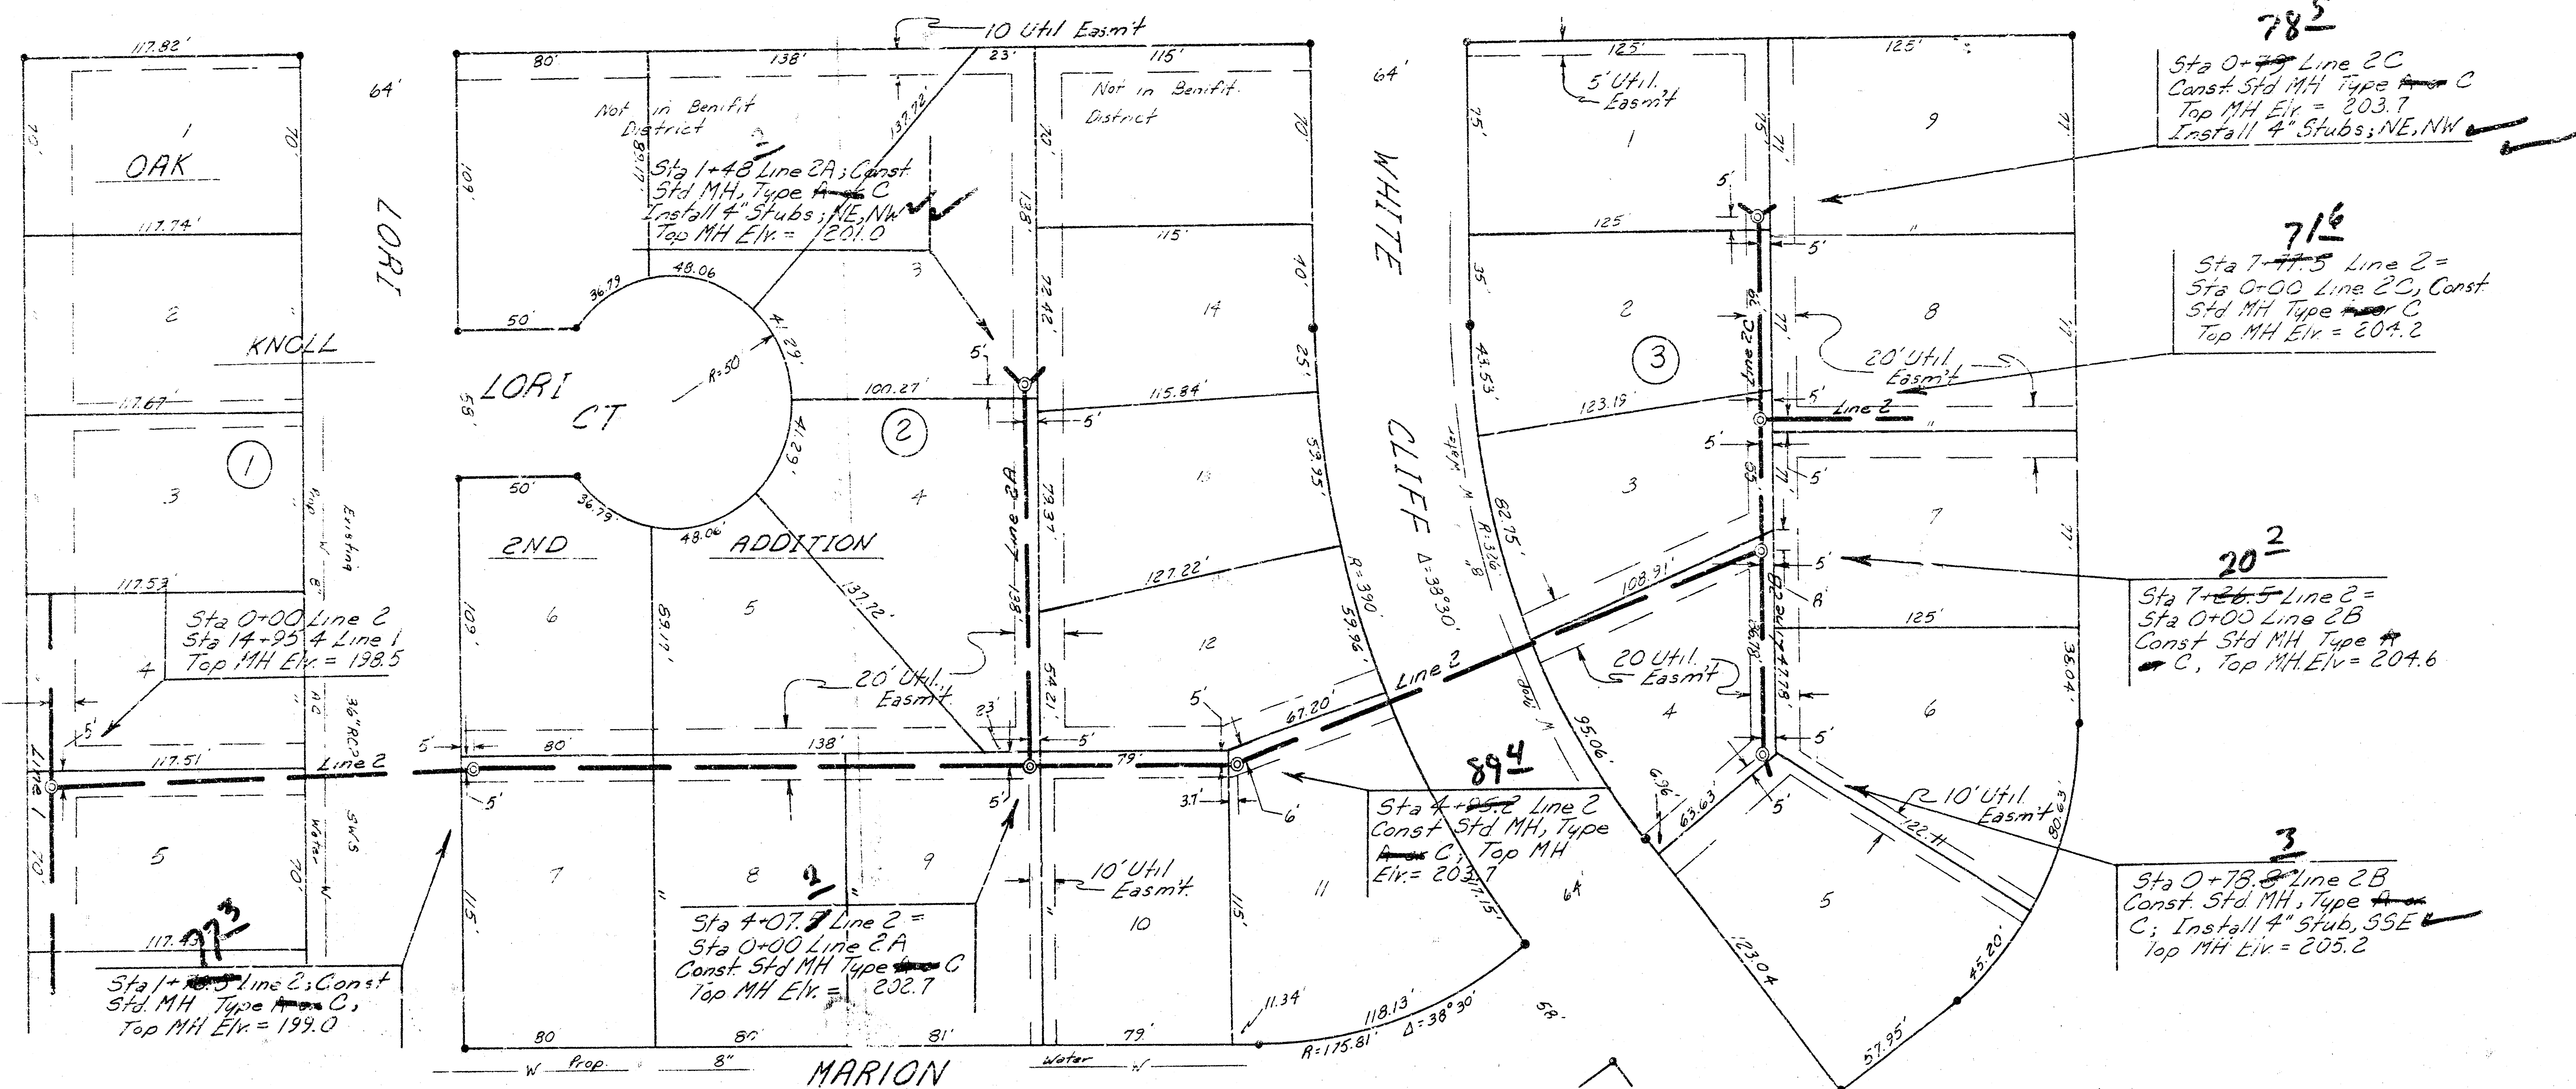


SCALE: 1" = 40' Plan
 1" = 40' Profile
 Vert. 1" = 5'

• - Irons



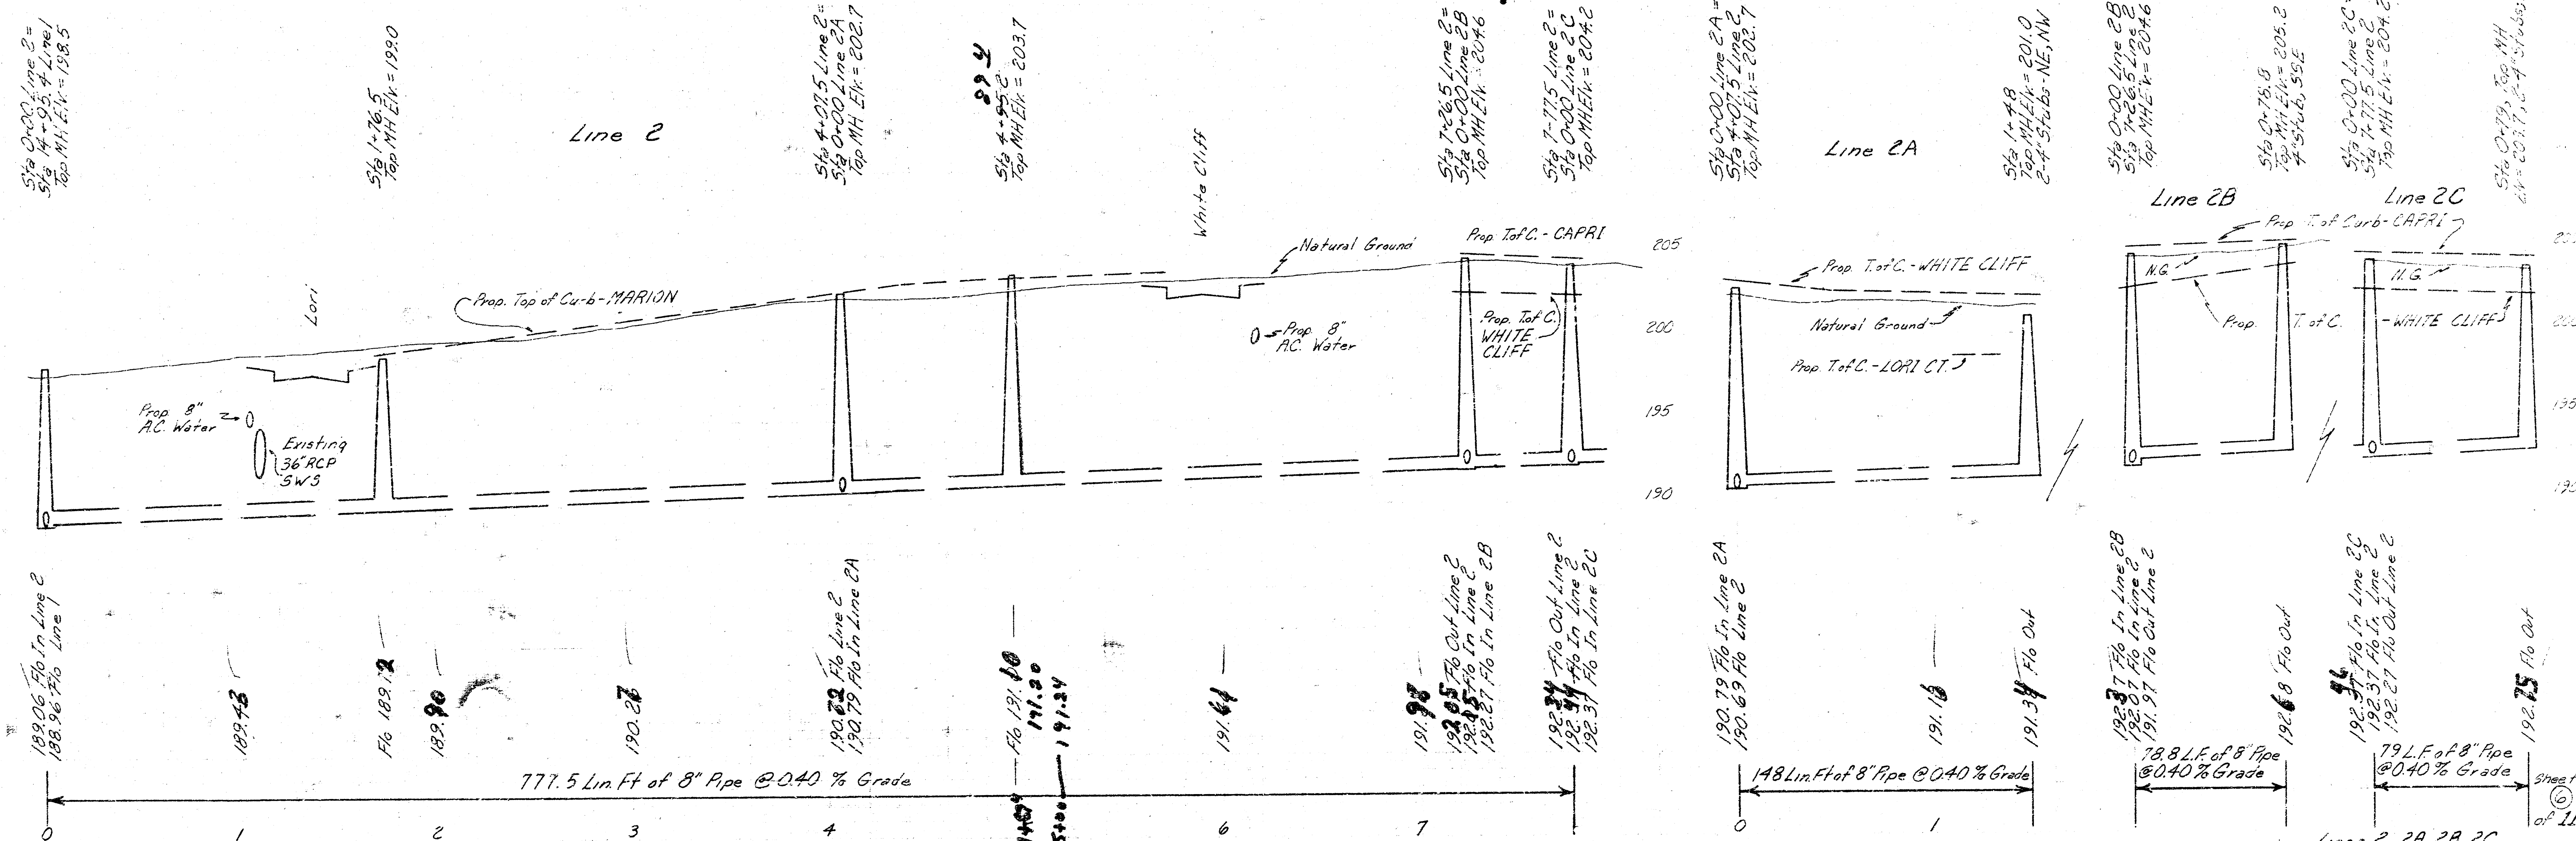


Lines 2, 2A, 2B, 2C.
 Lateral 1, Main 23, W.I.S.
 Proj # 468-76-2+5-000-000-001




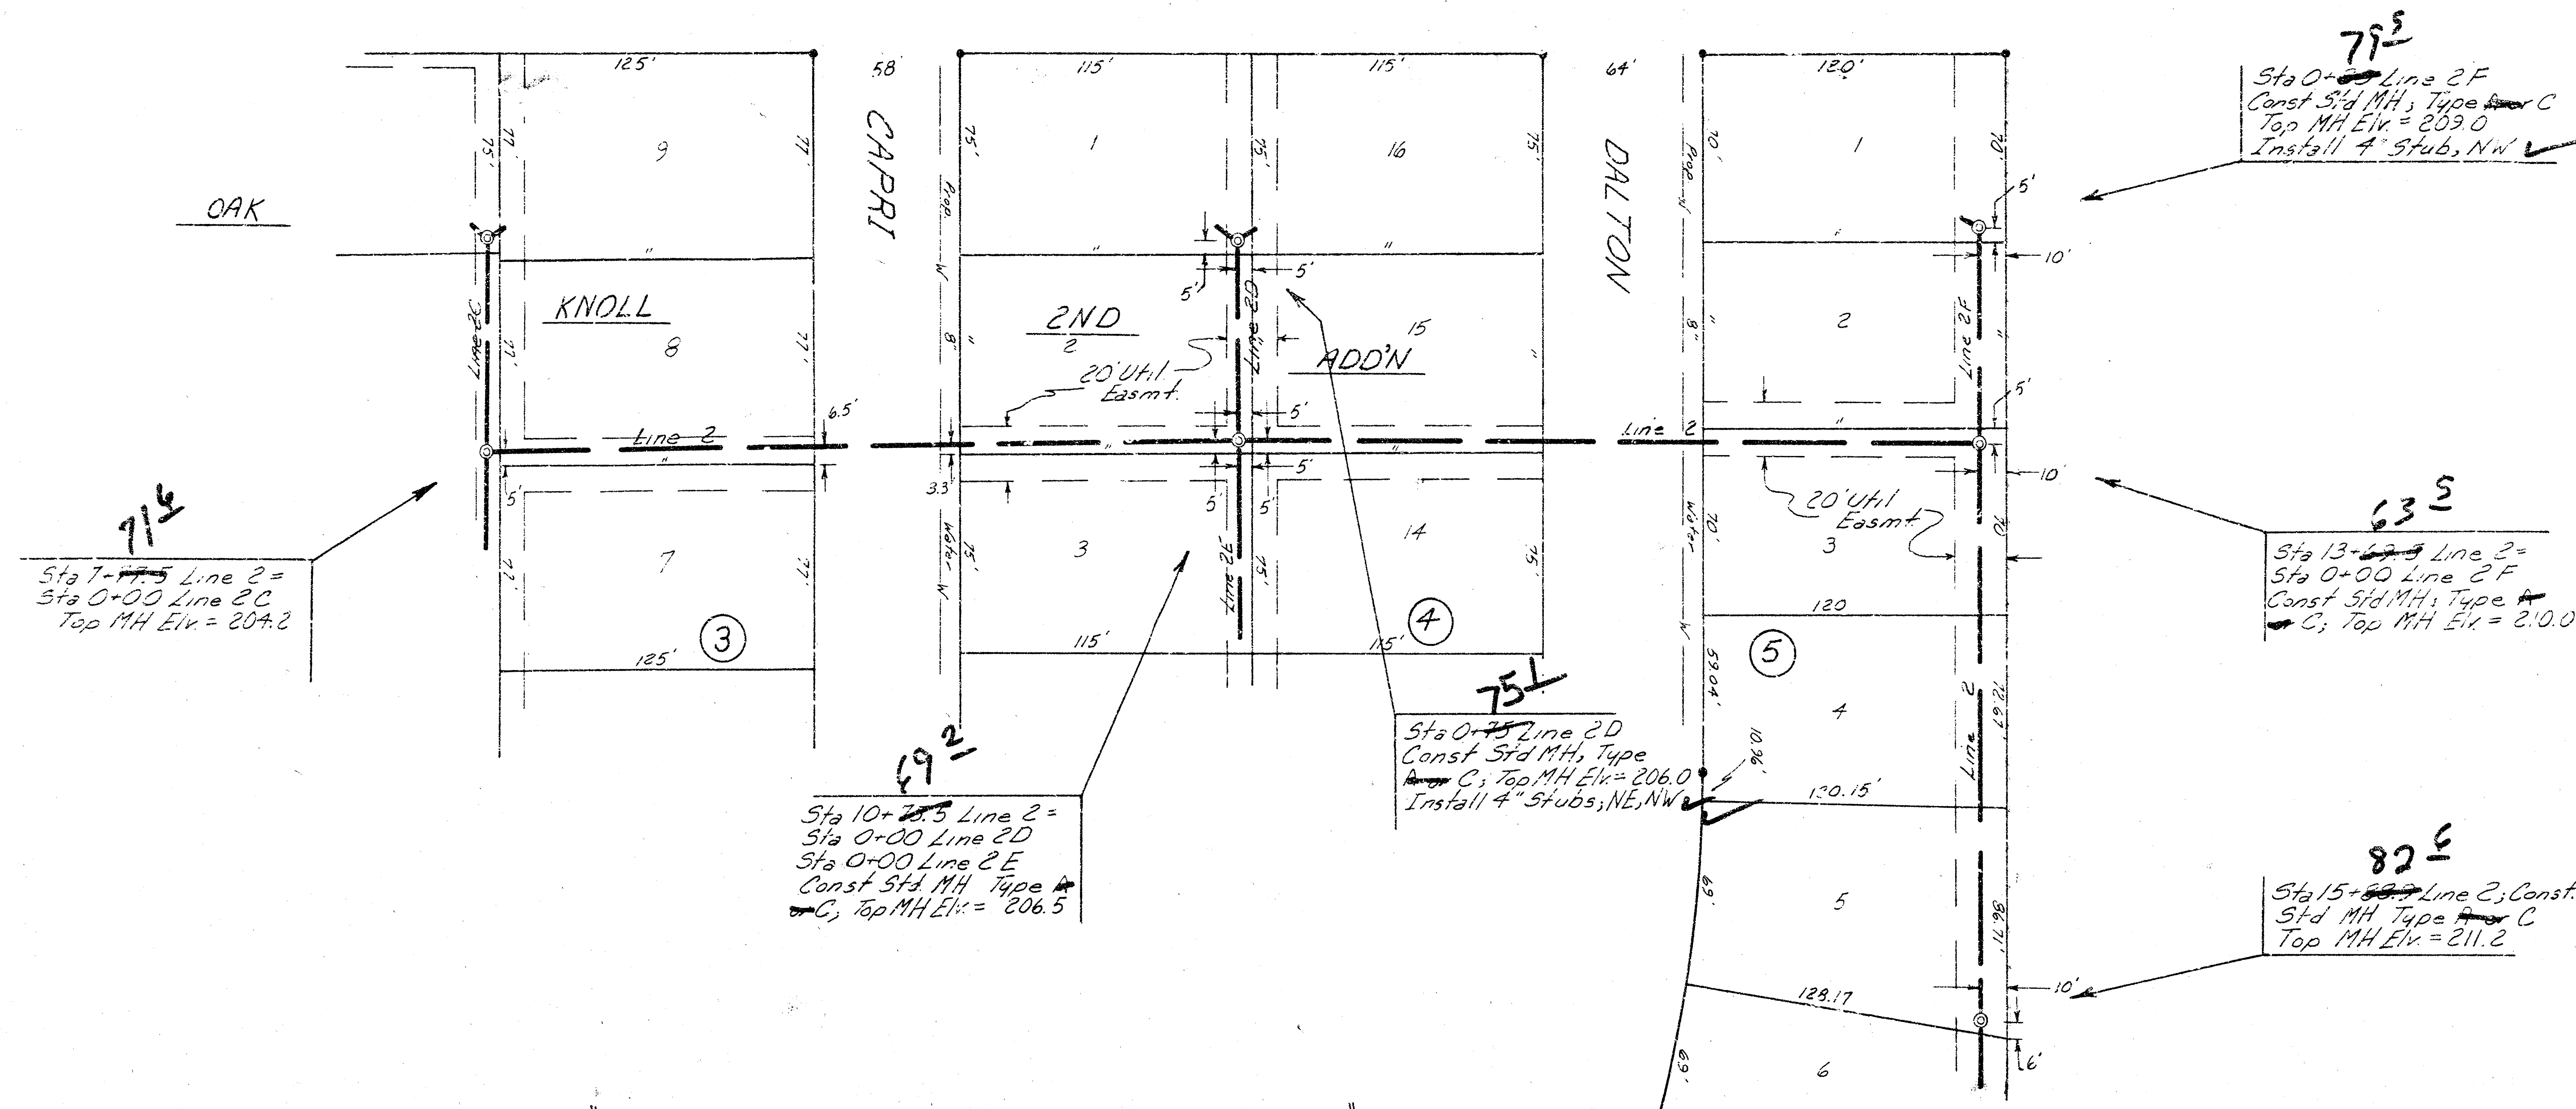


As Built
58
17/51

SCALE: 1" = 40' Plan
 1" = 40' Profile
 1" = 5' Vert.

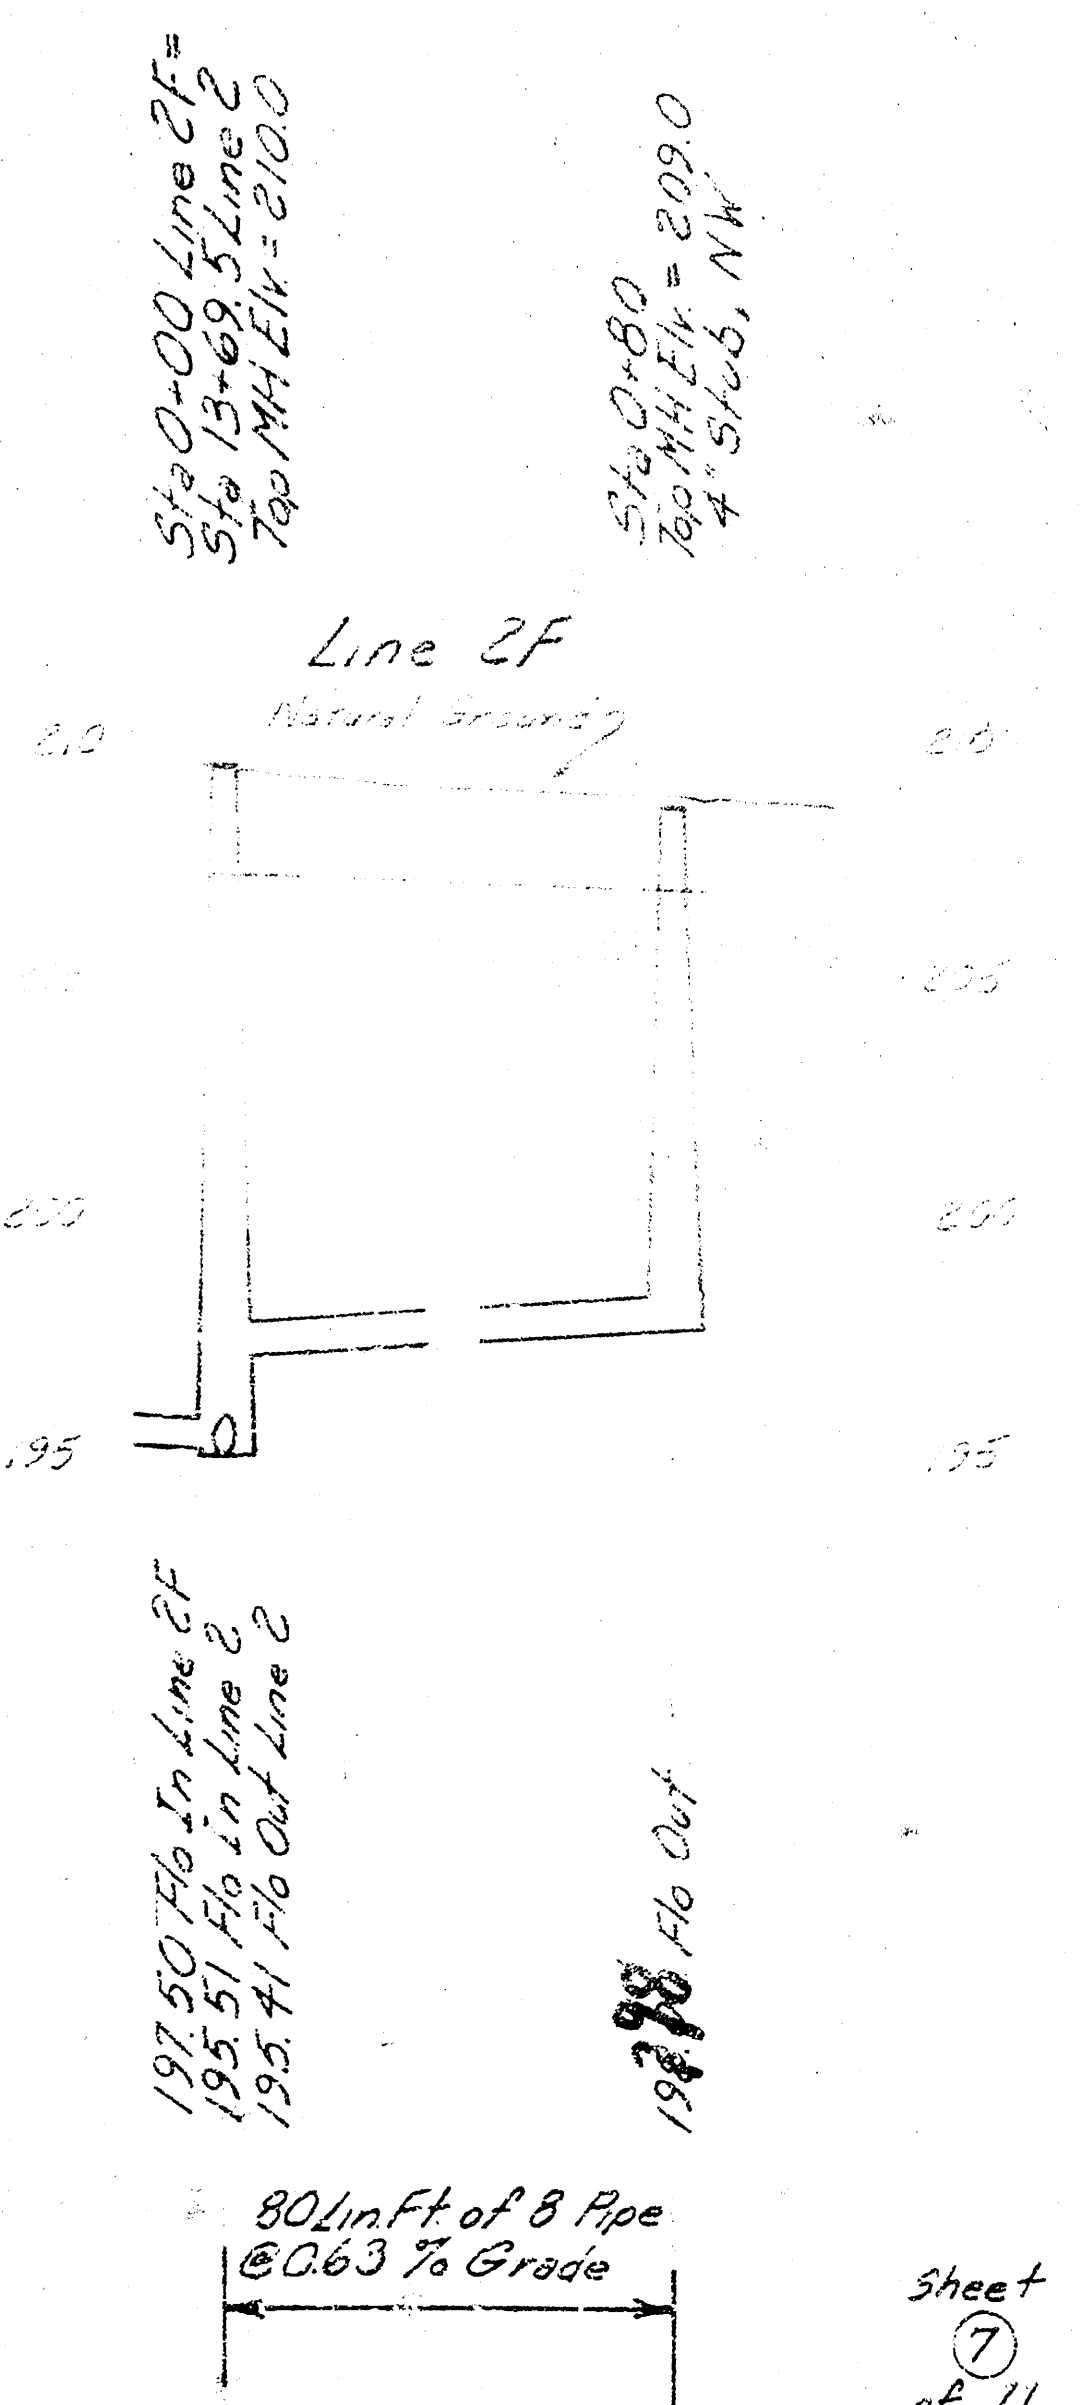
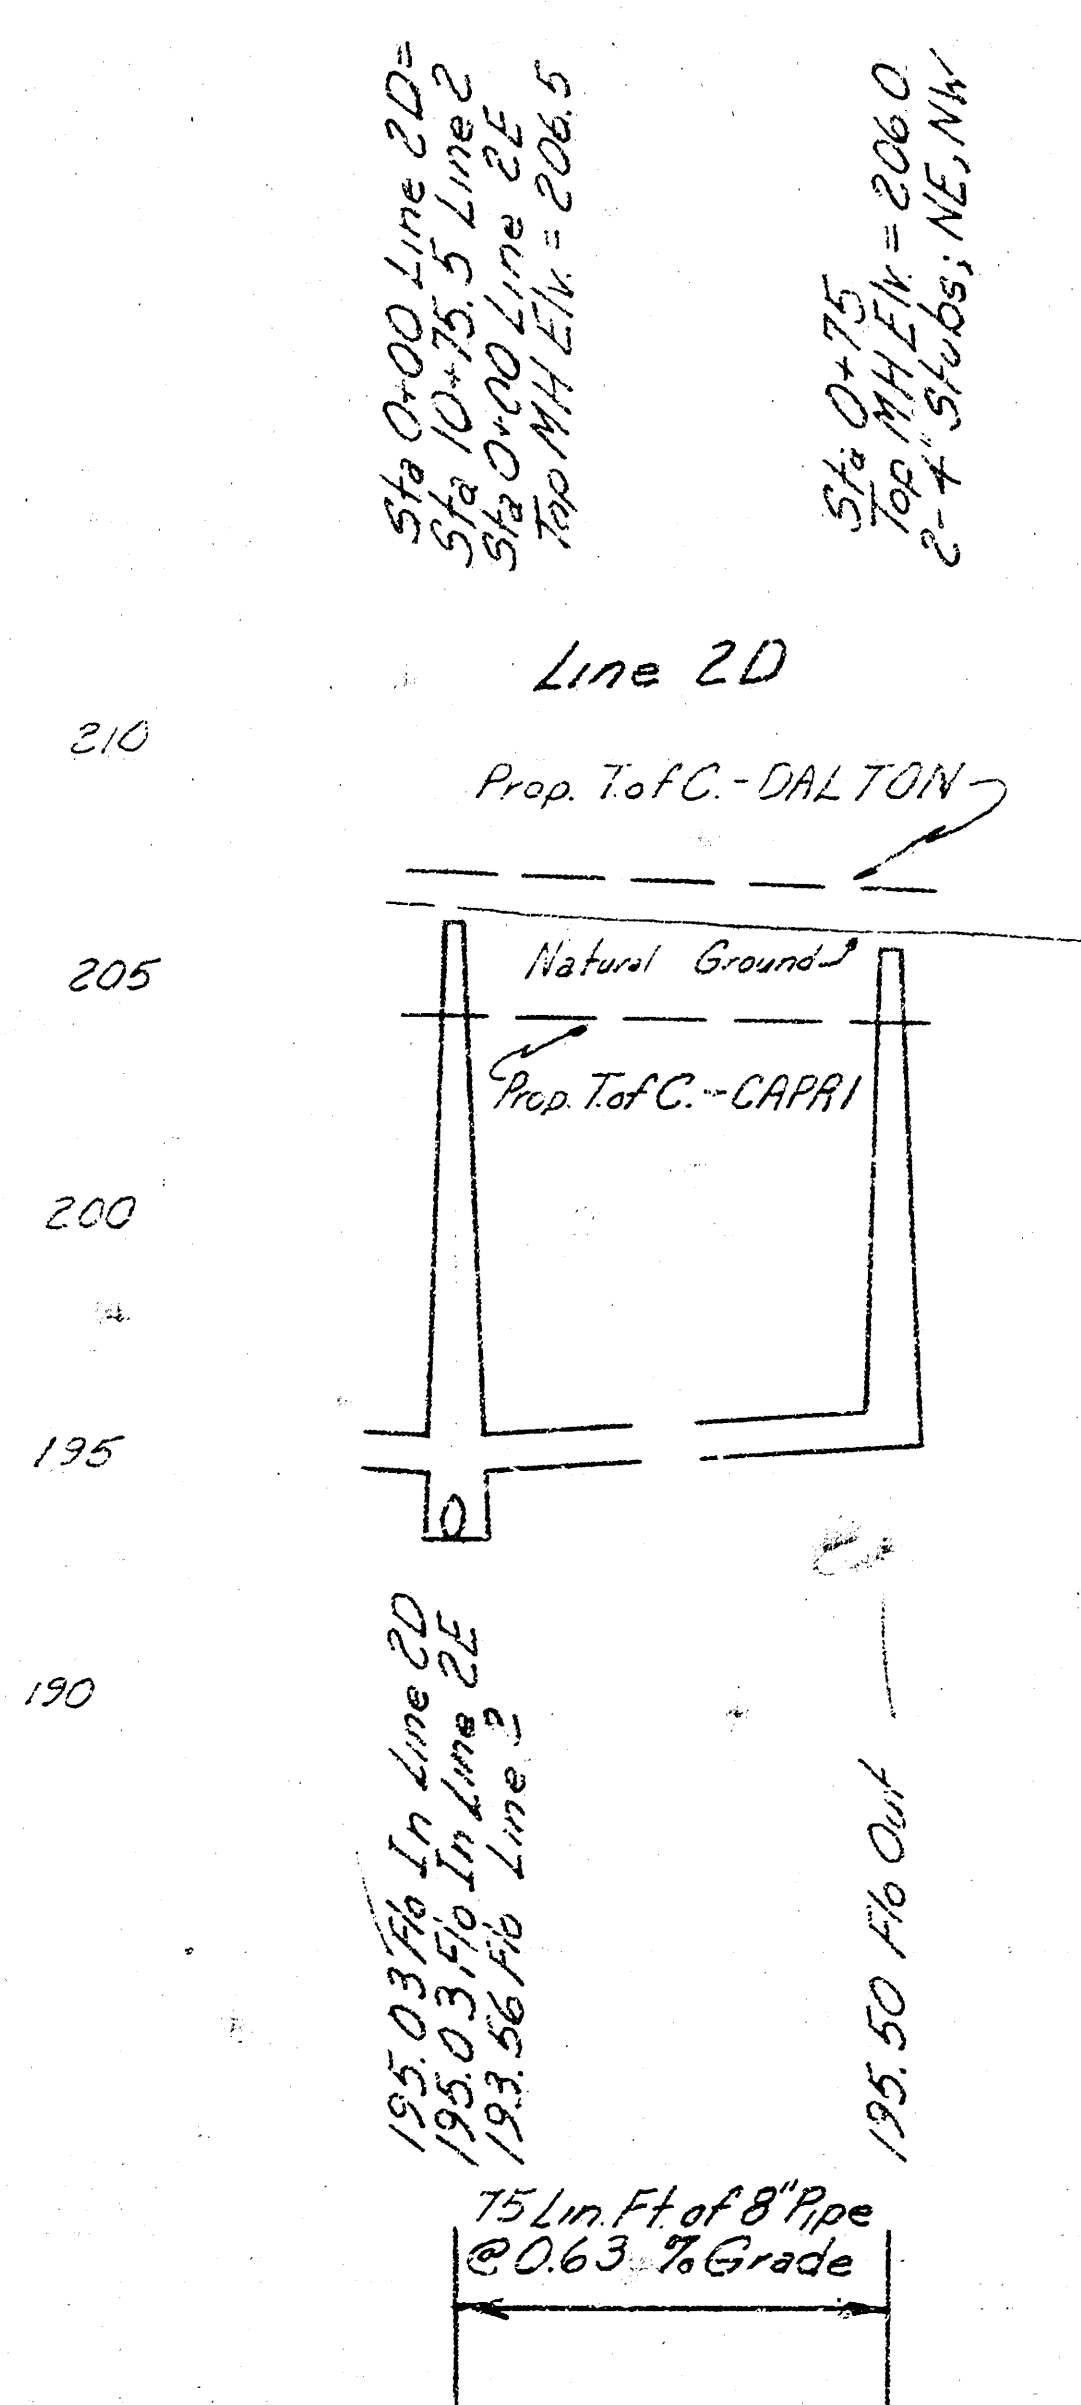
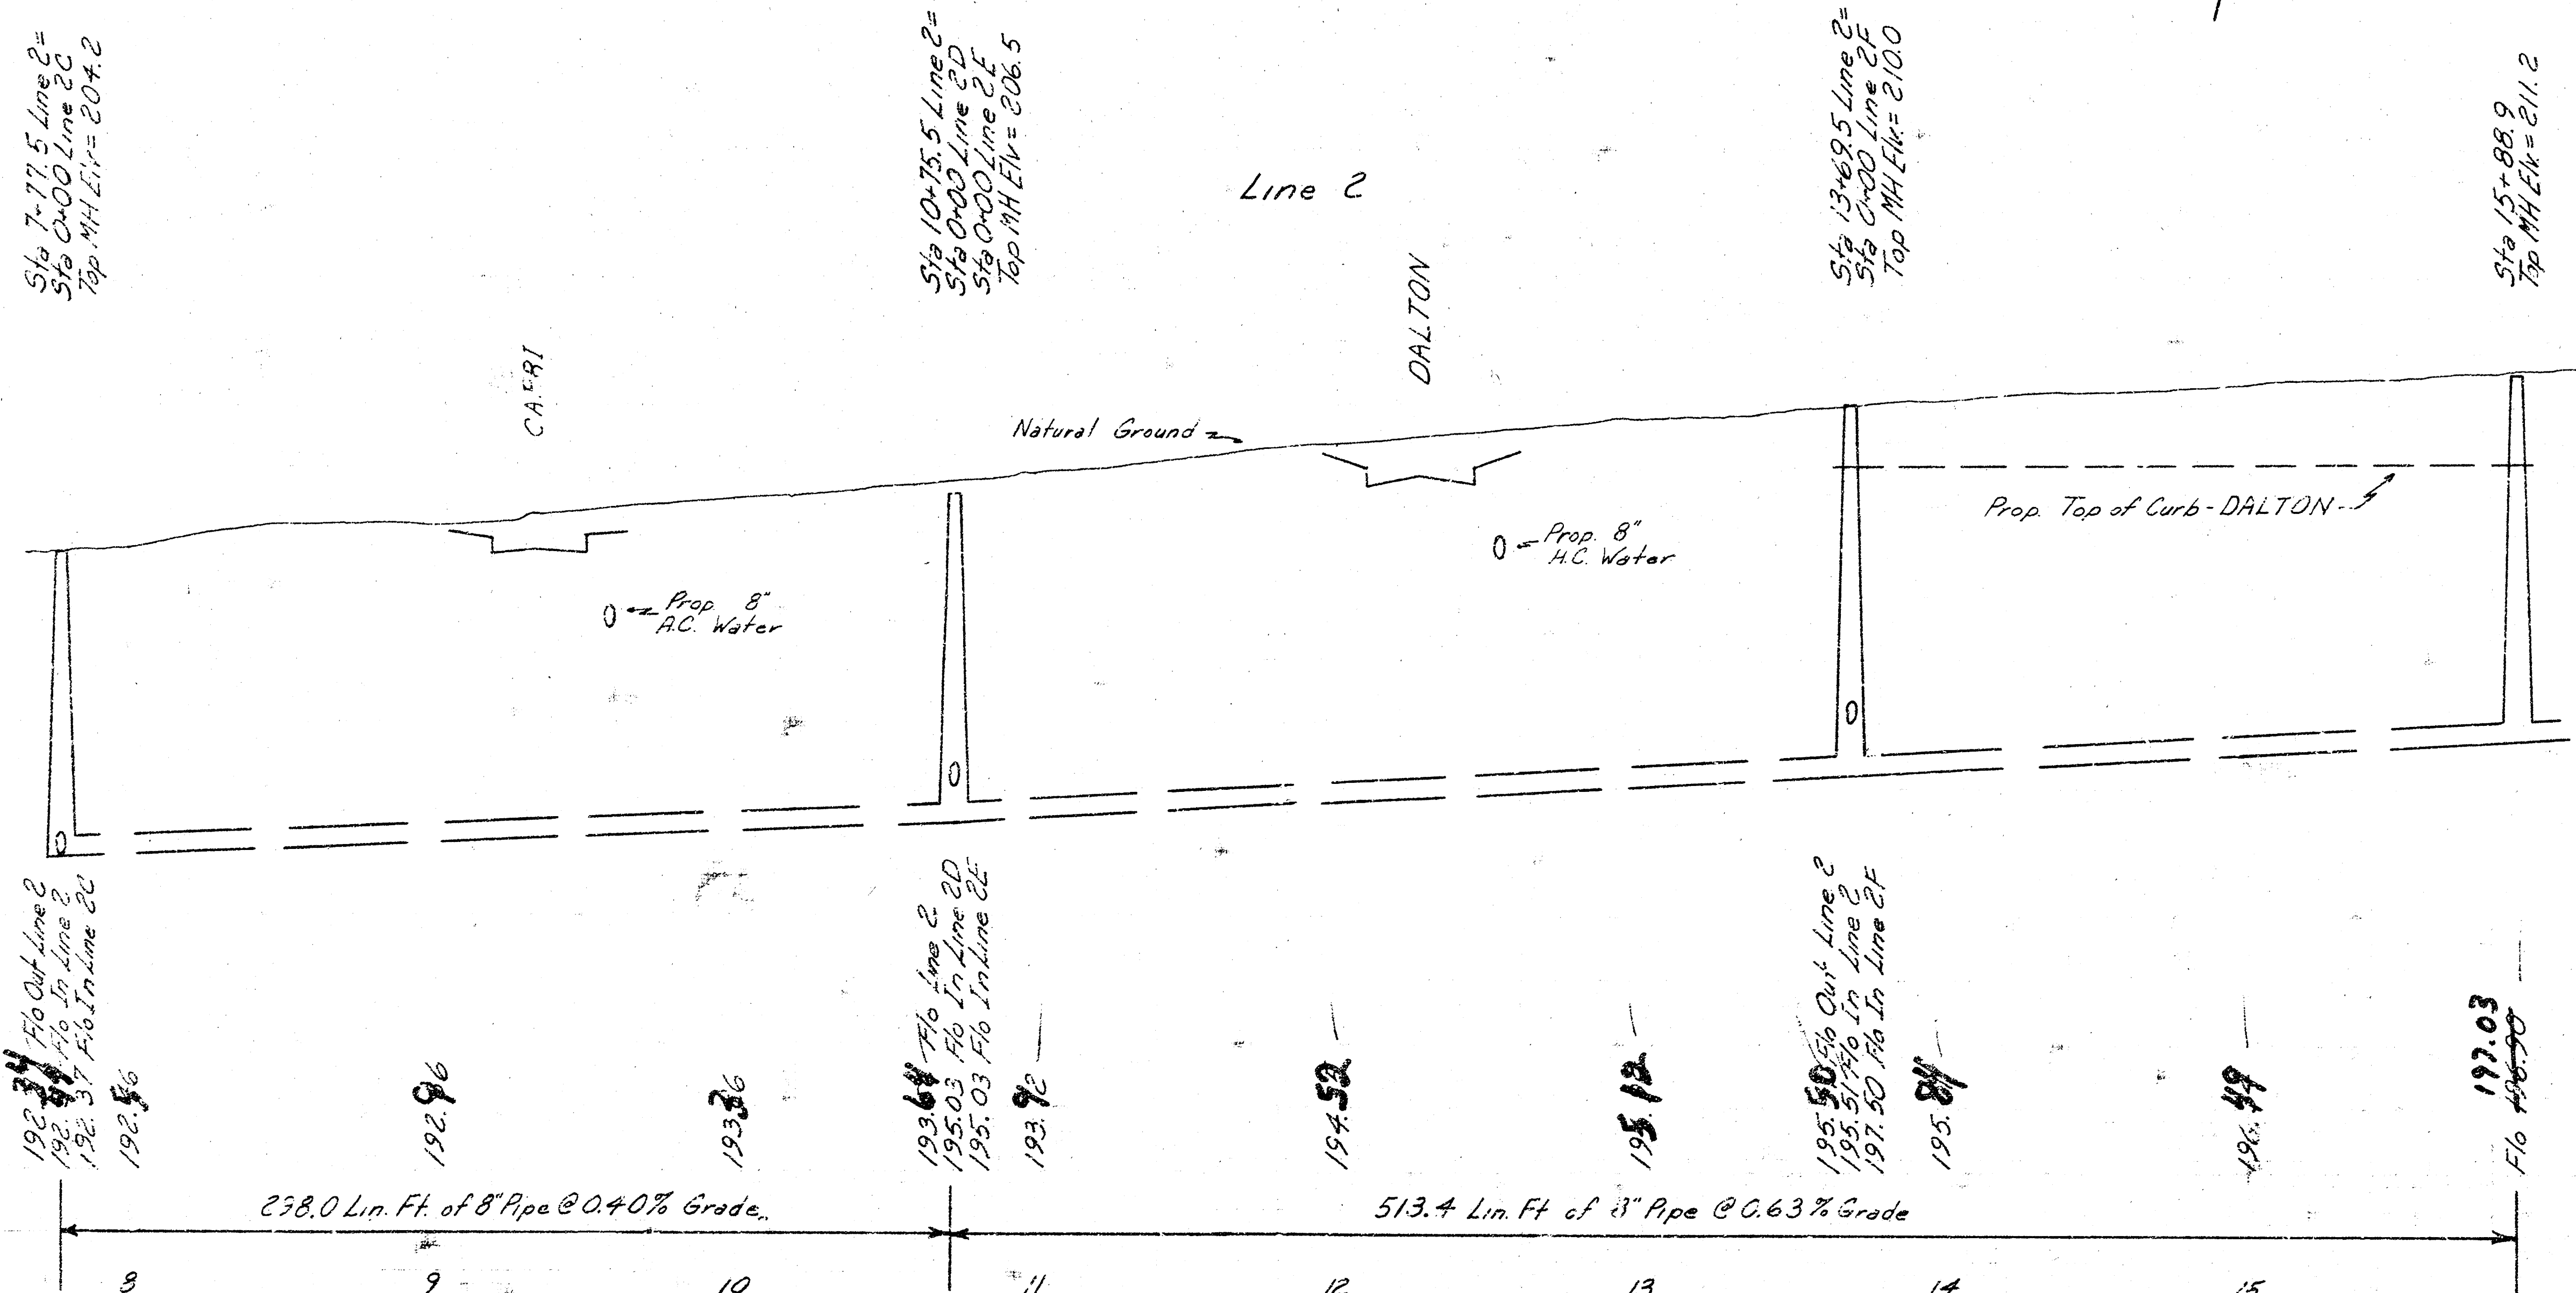


Line 2, Lins 2D, Line 2F
 Lateral 1, Main 23, W15
 Proj # 468-76-245-80999-000-000-00.

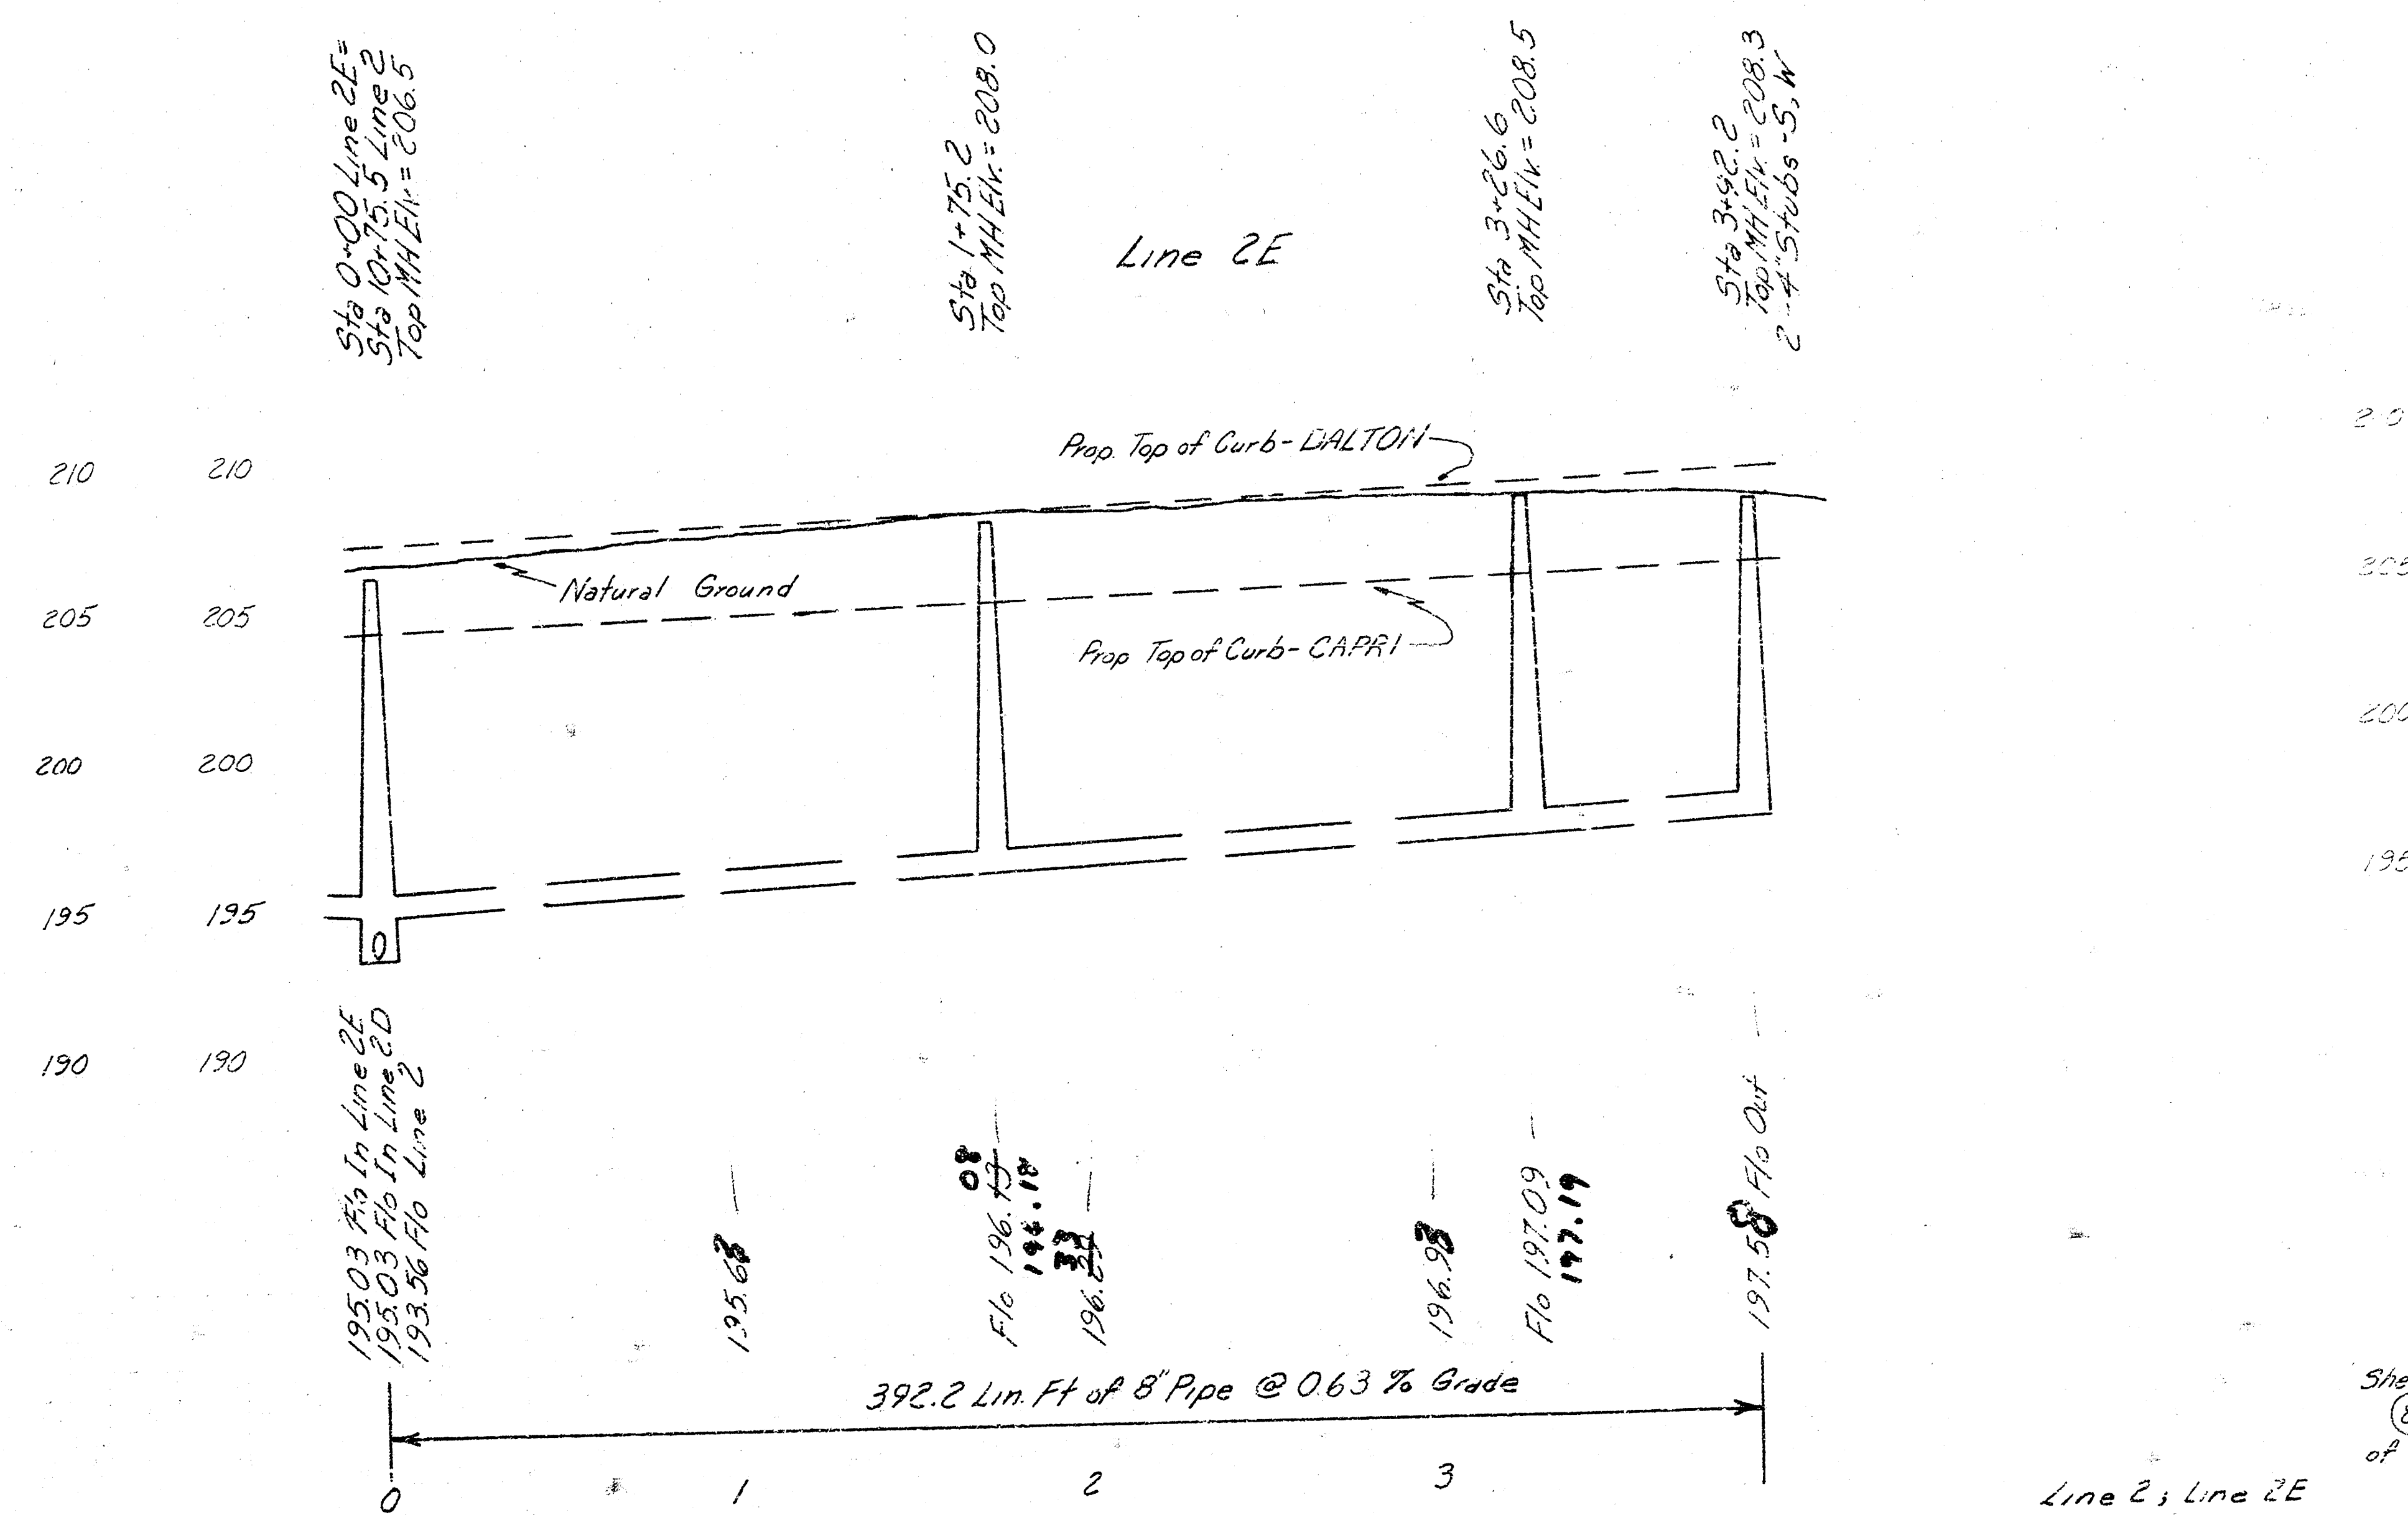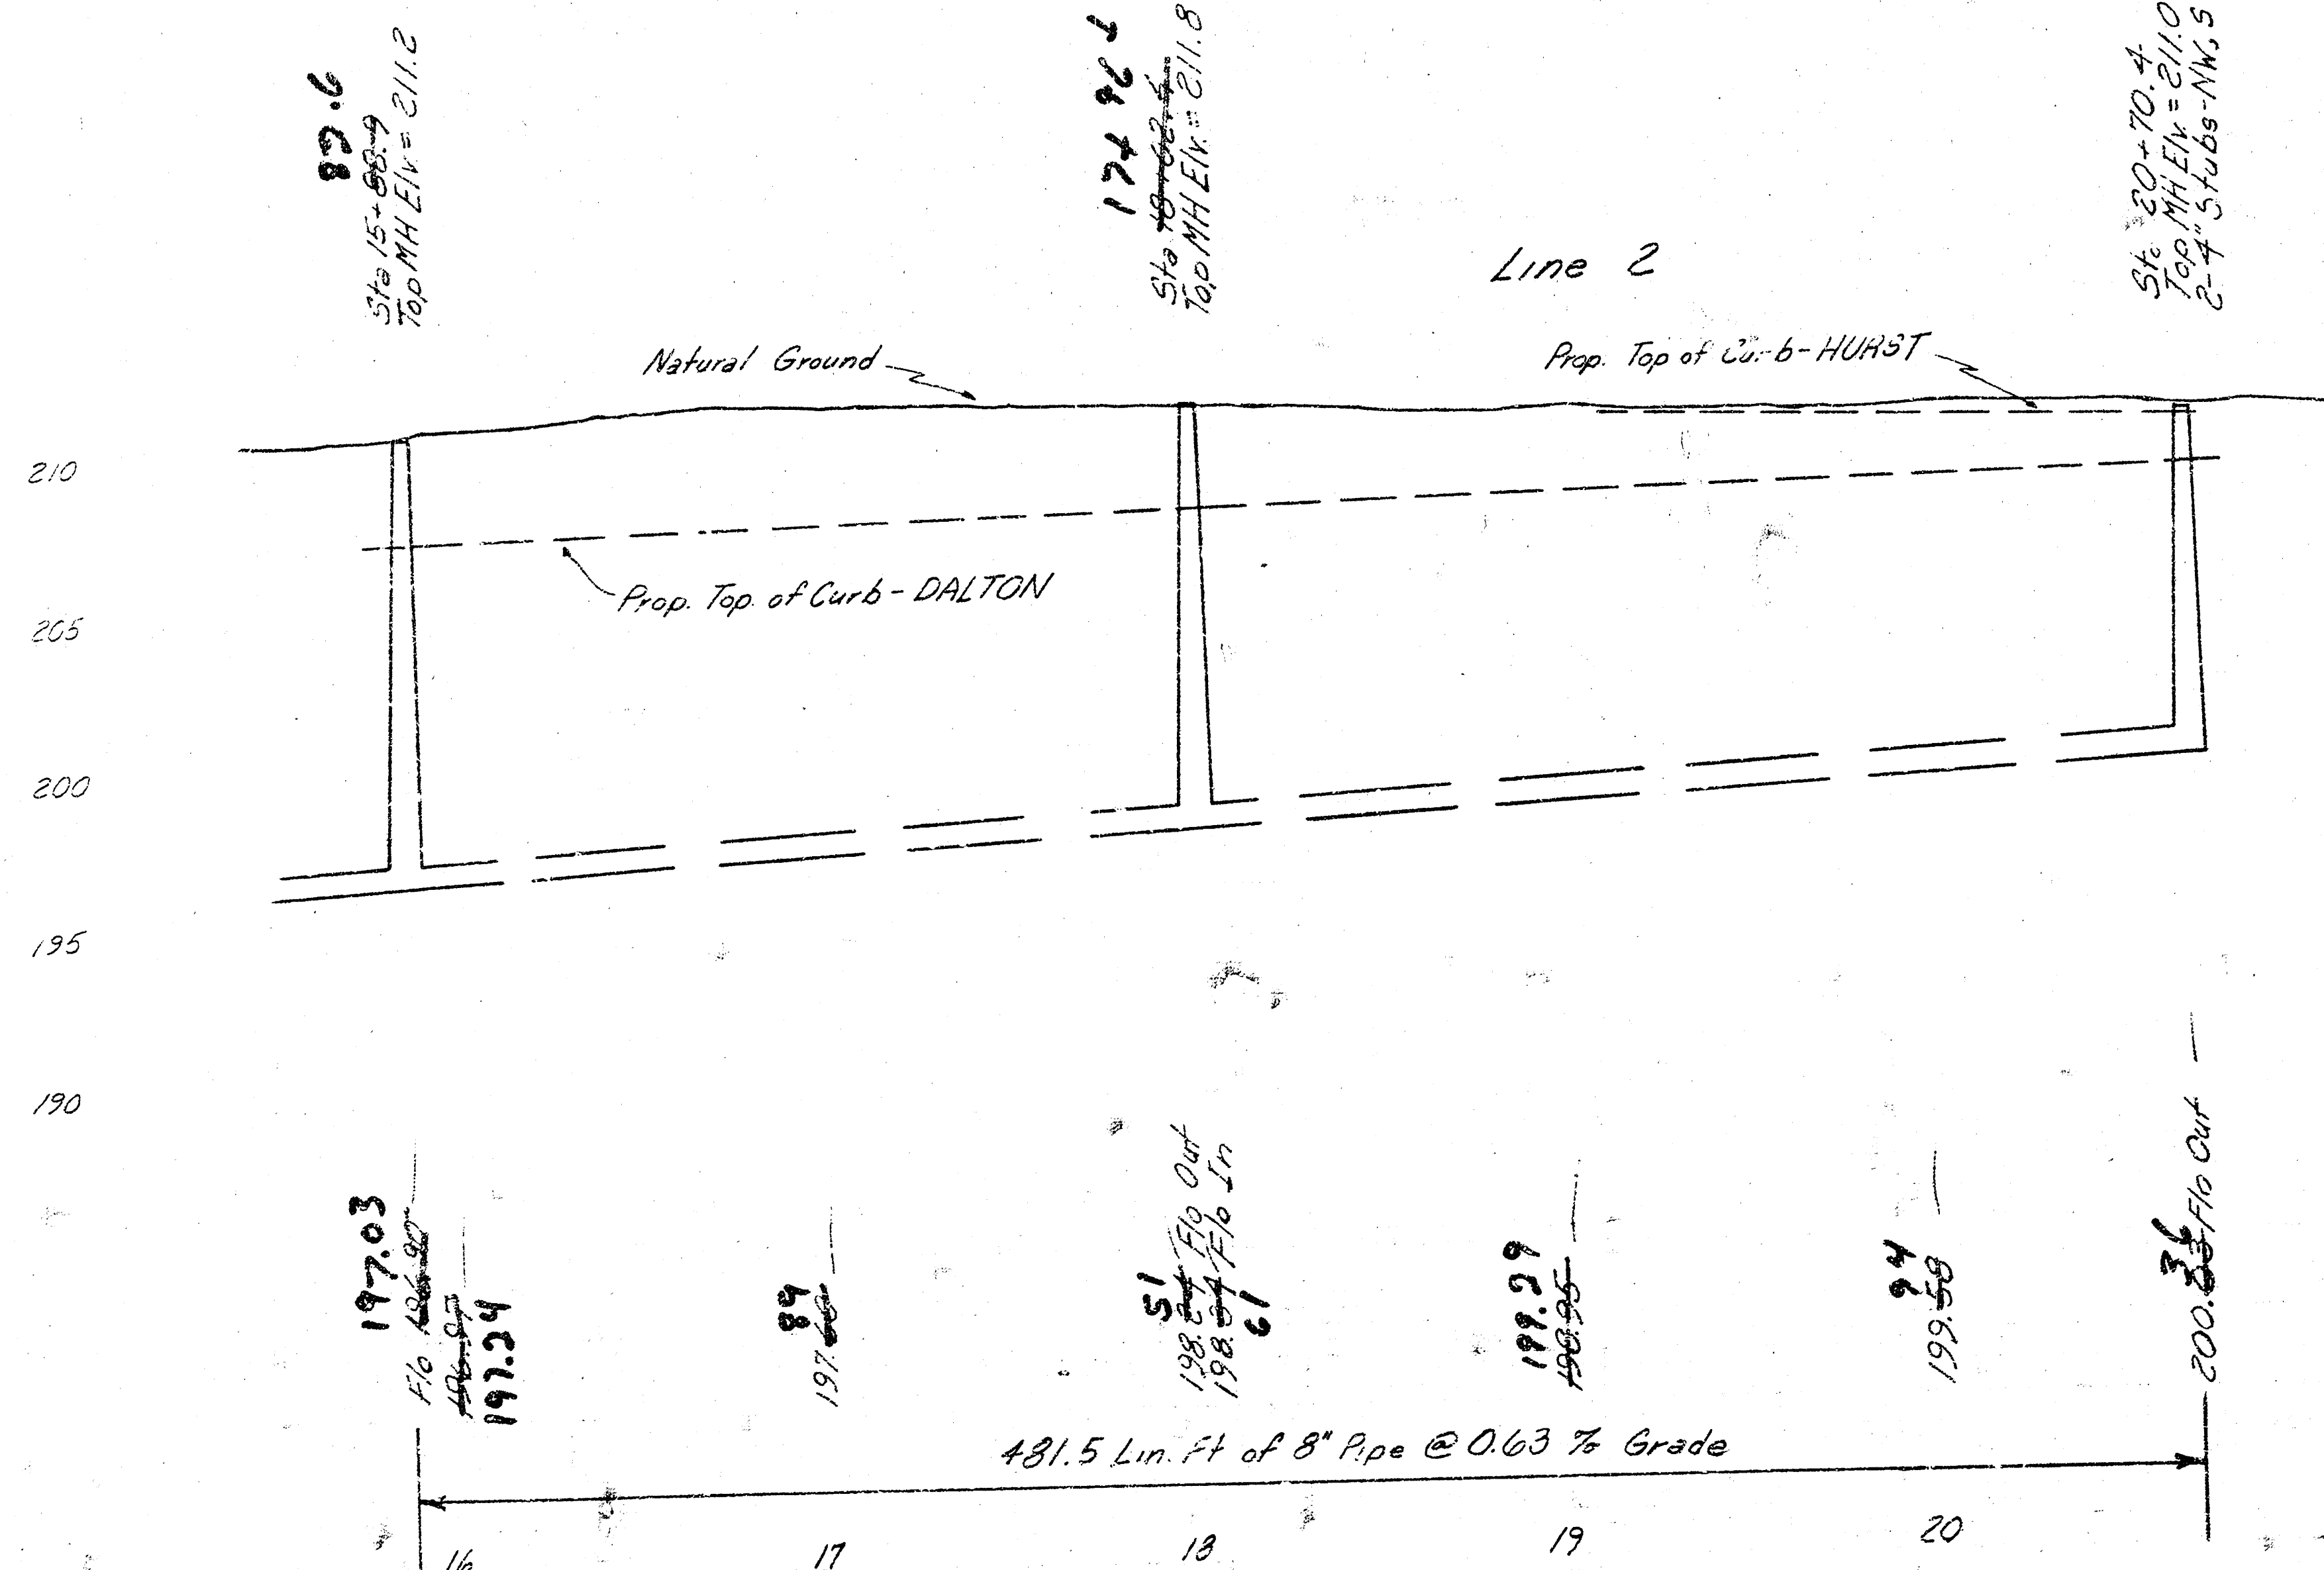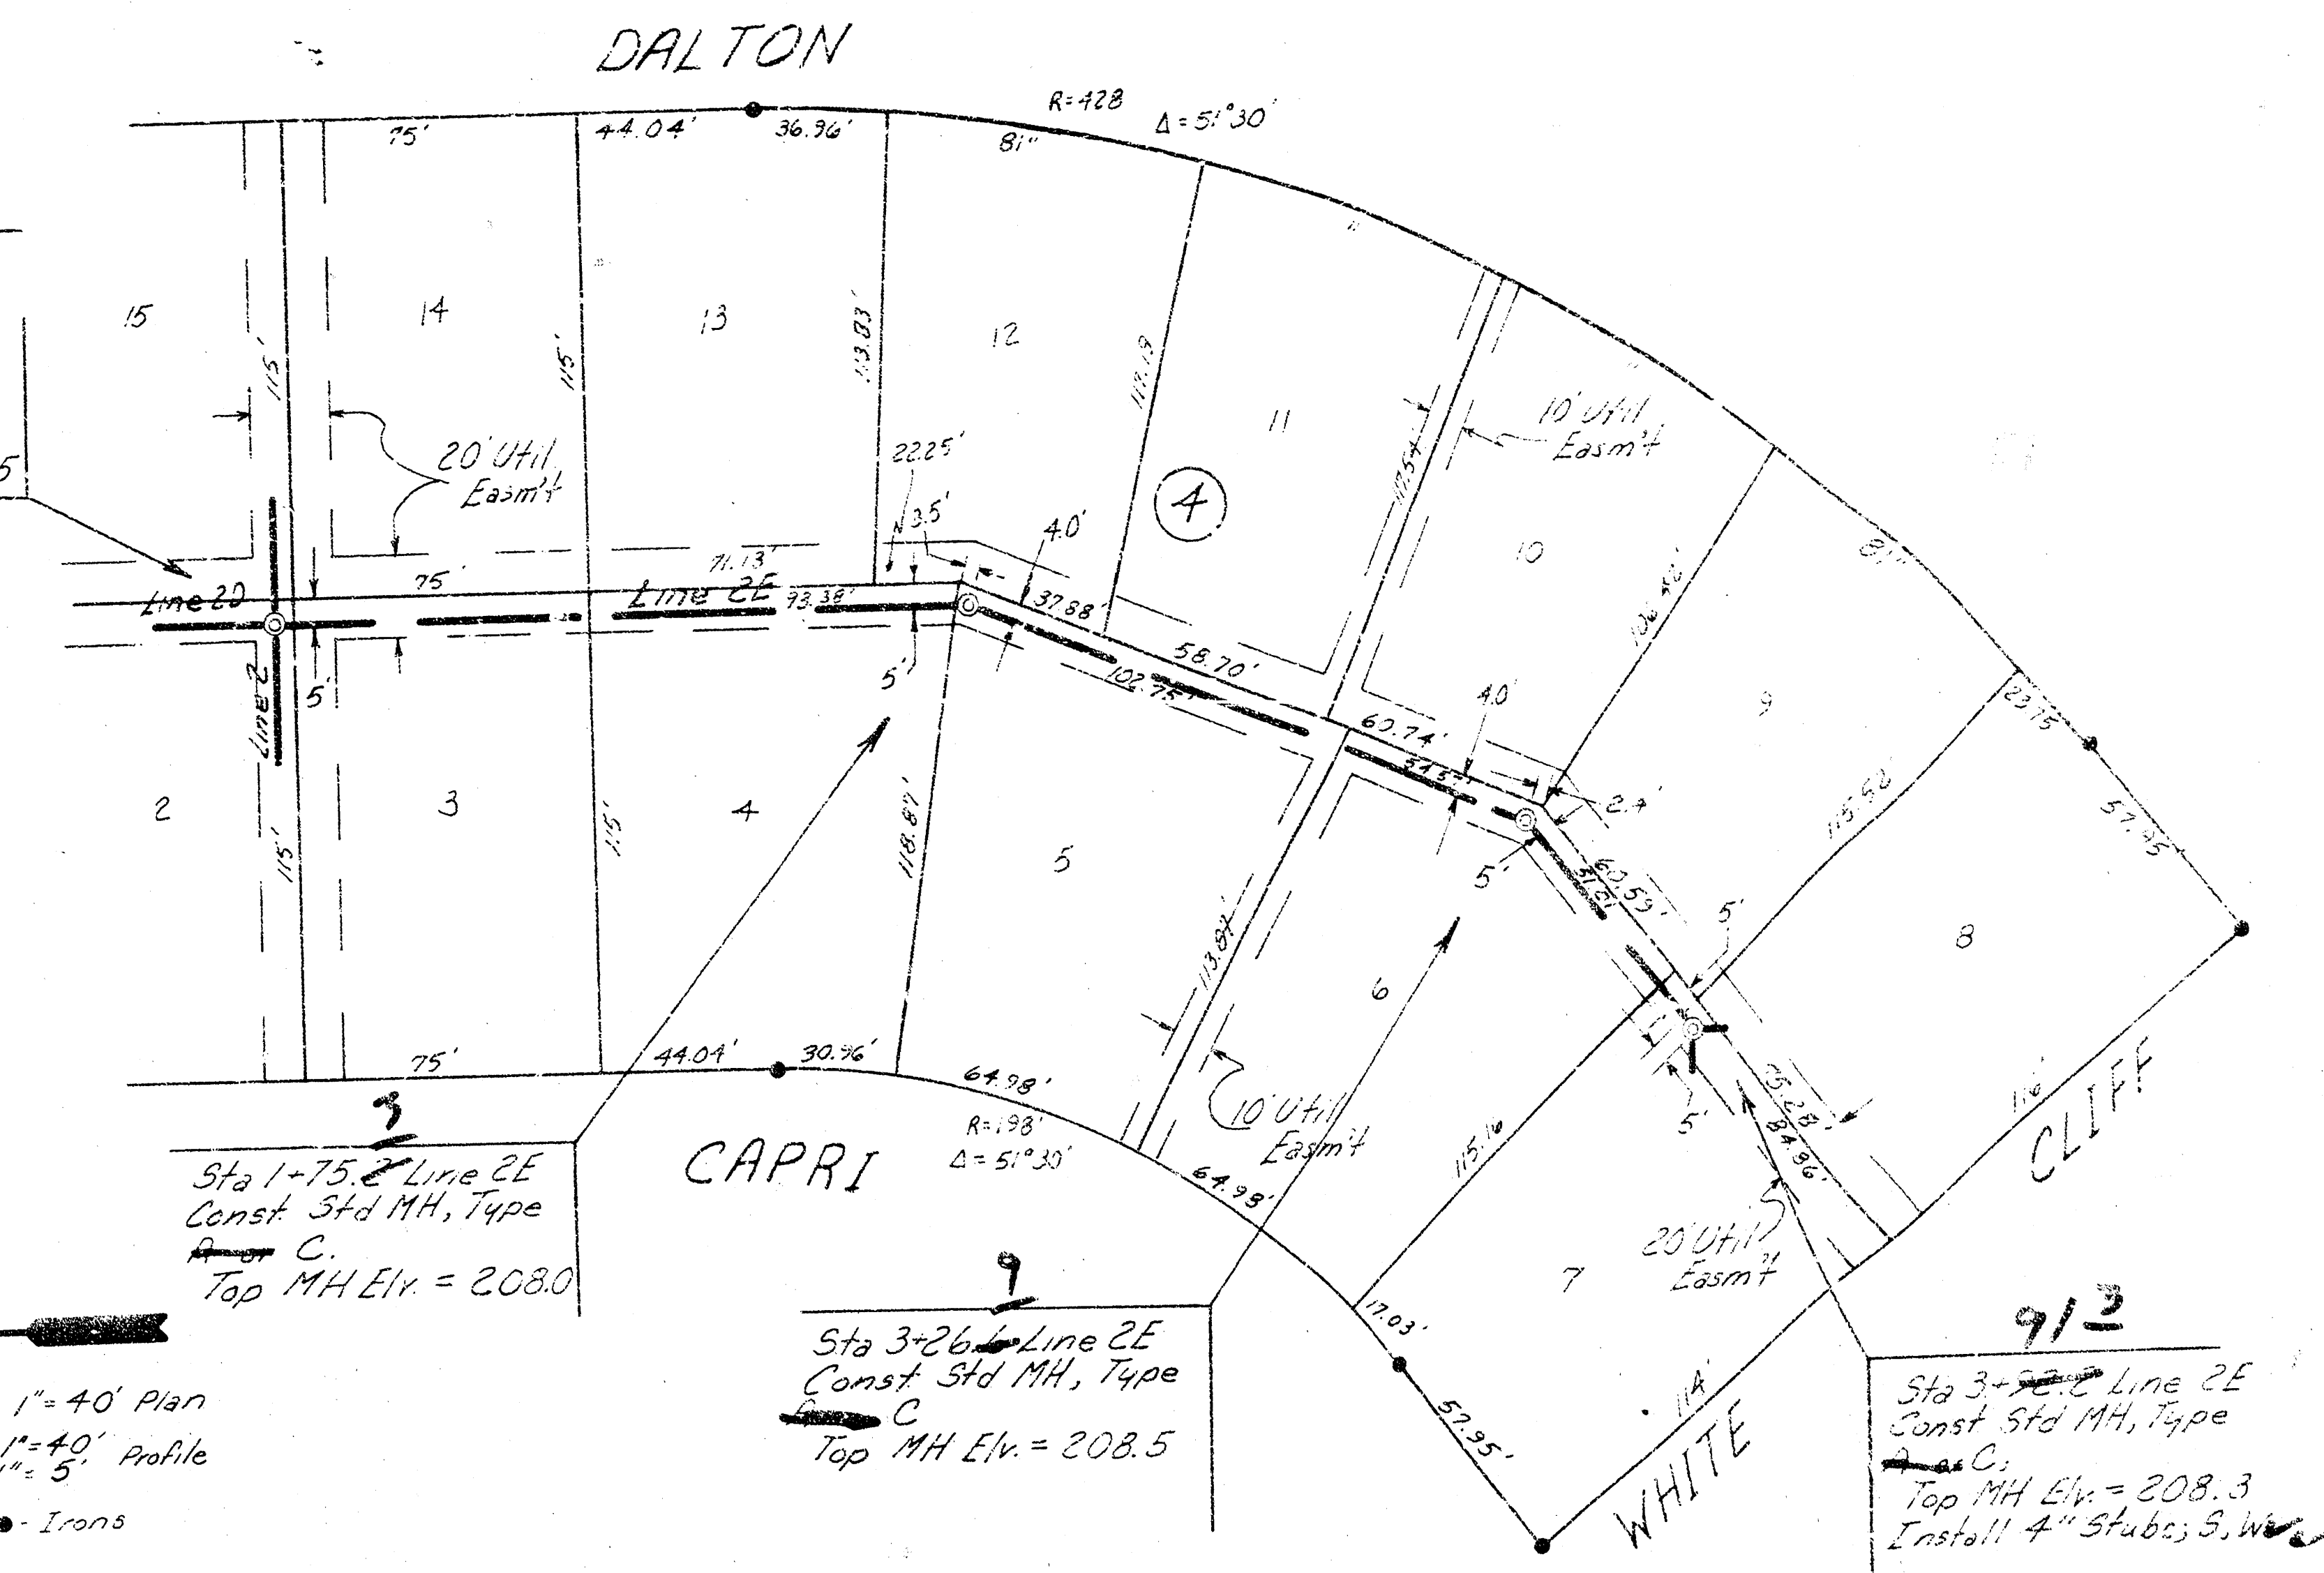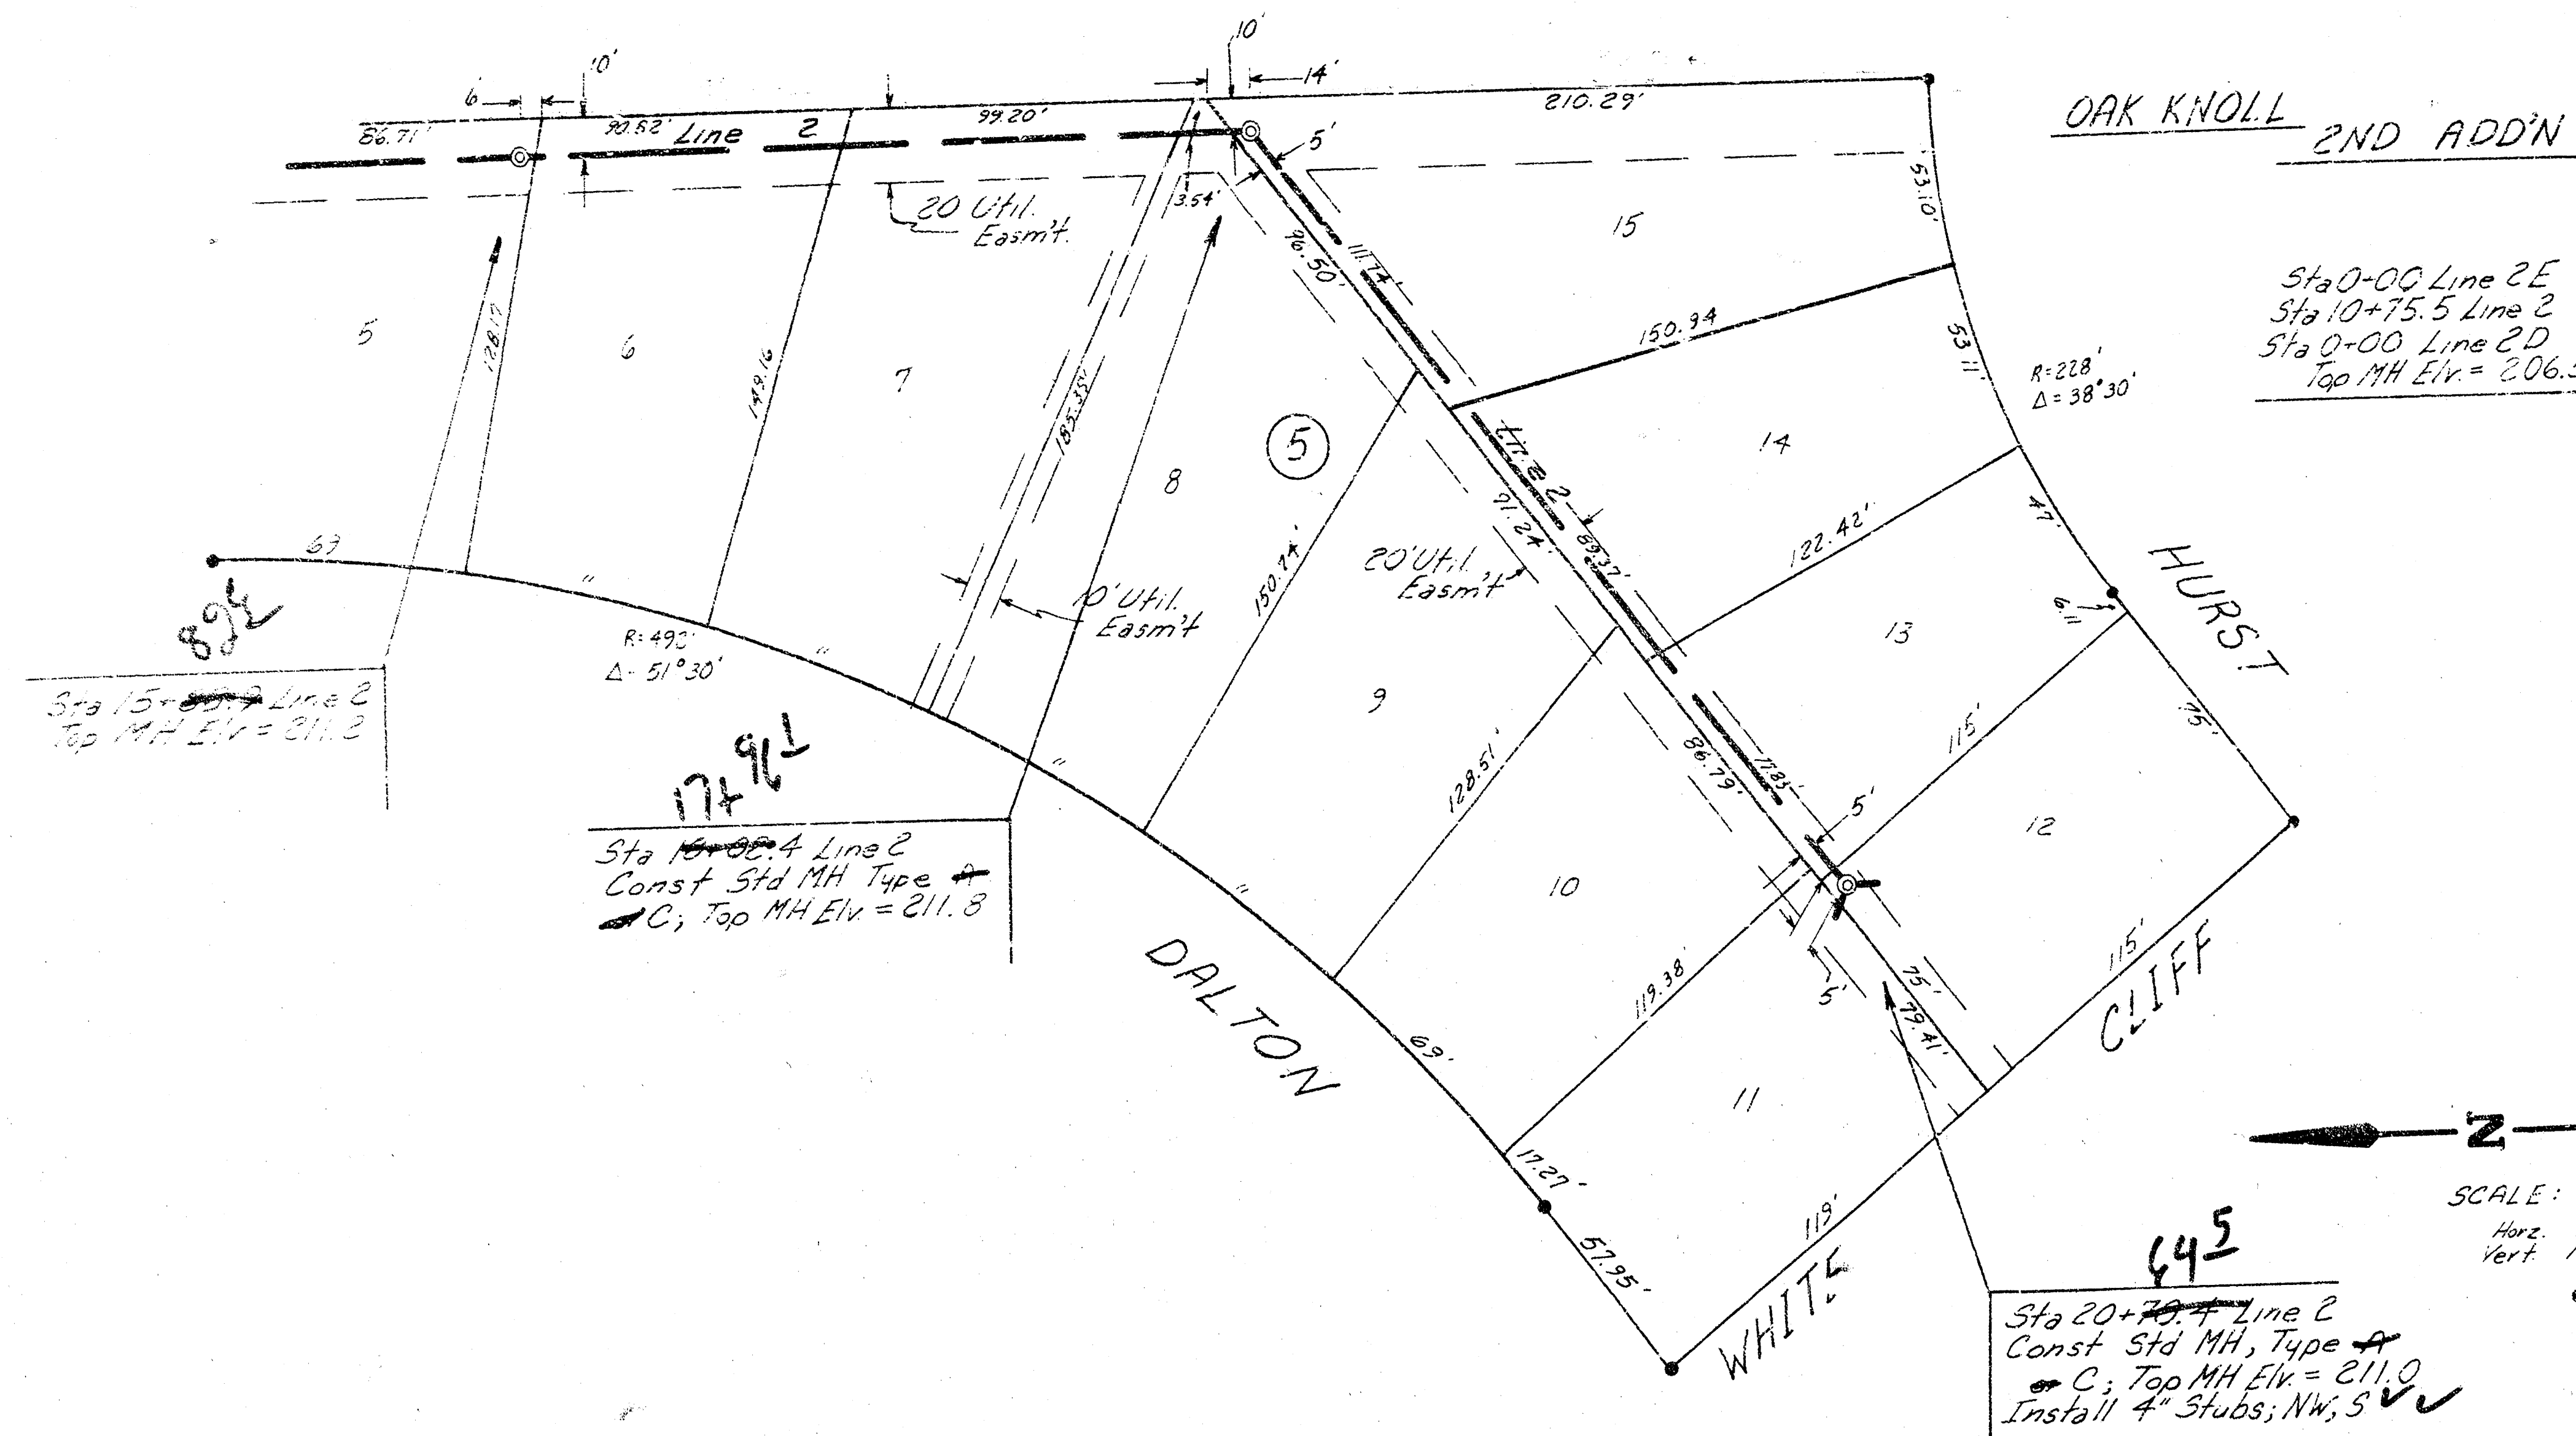

Line 2; Line 2E
Lateral 1, Main 23, W.I.S.
Proj # 468-76-245-80999-000-000-001

FILMED FROM THE BEST
AVAILABLE COPY

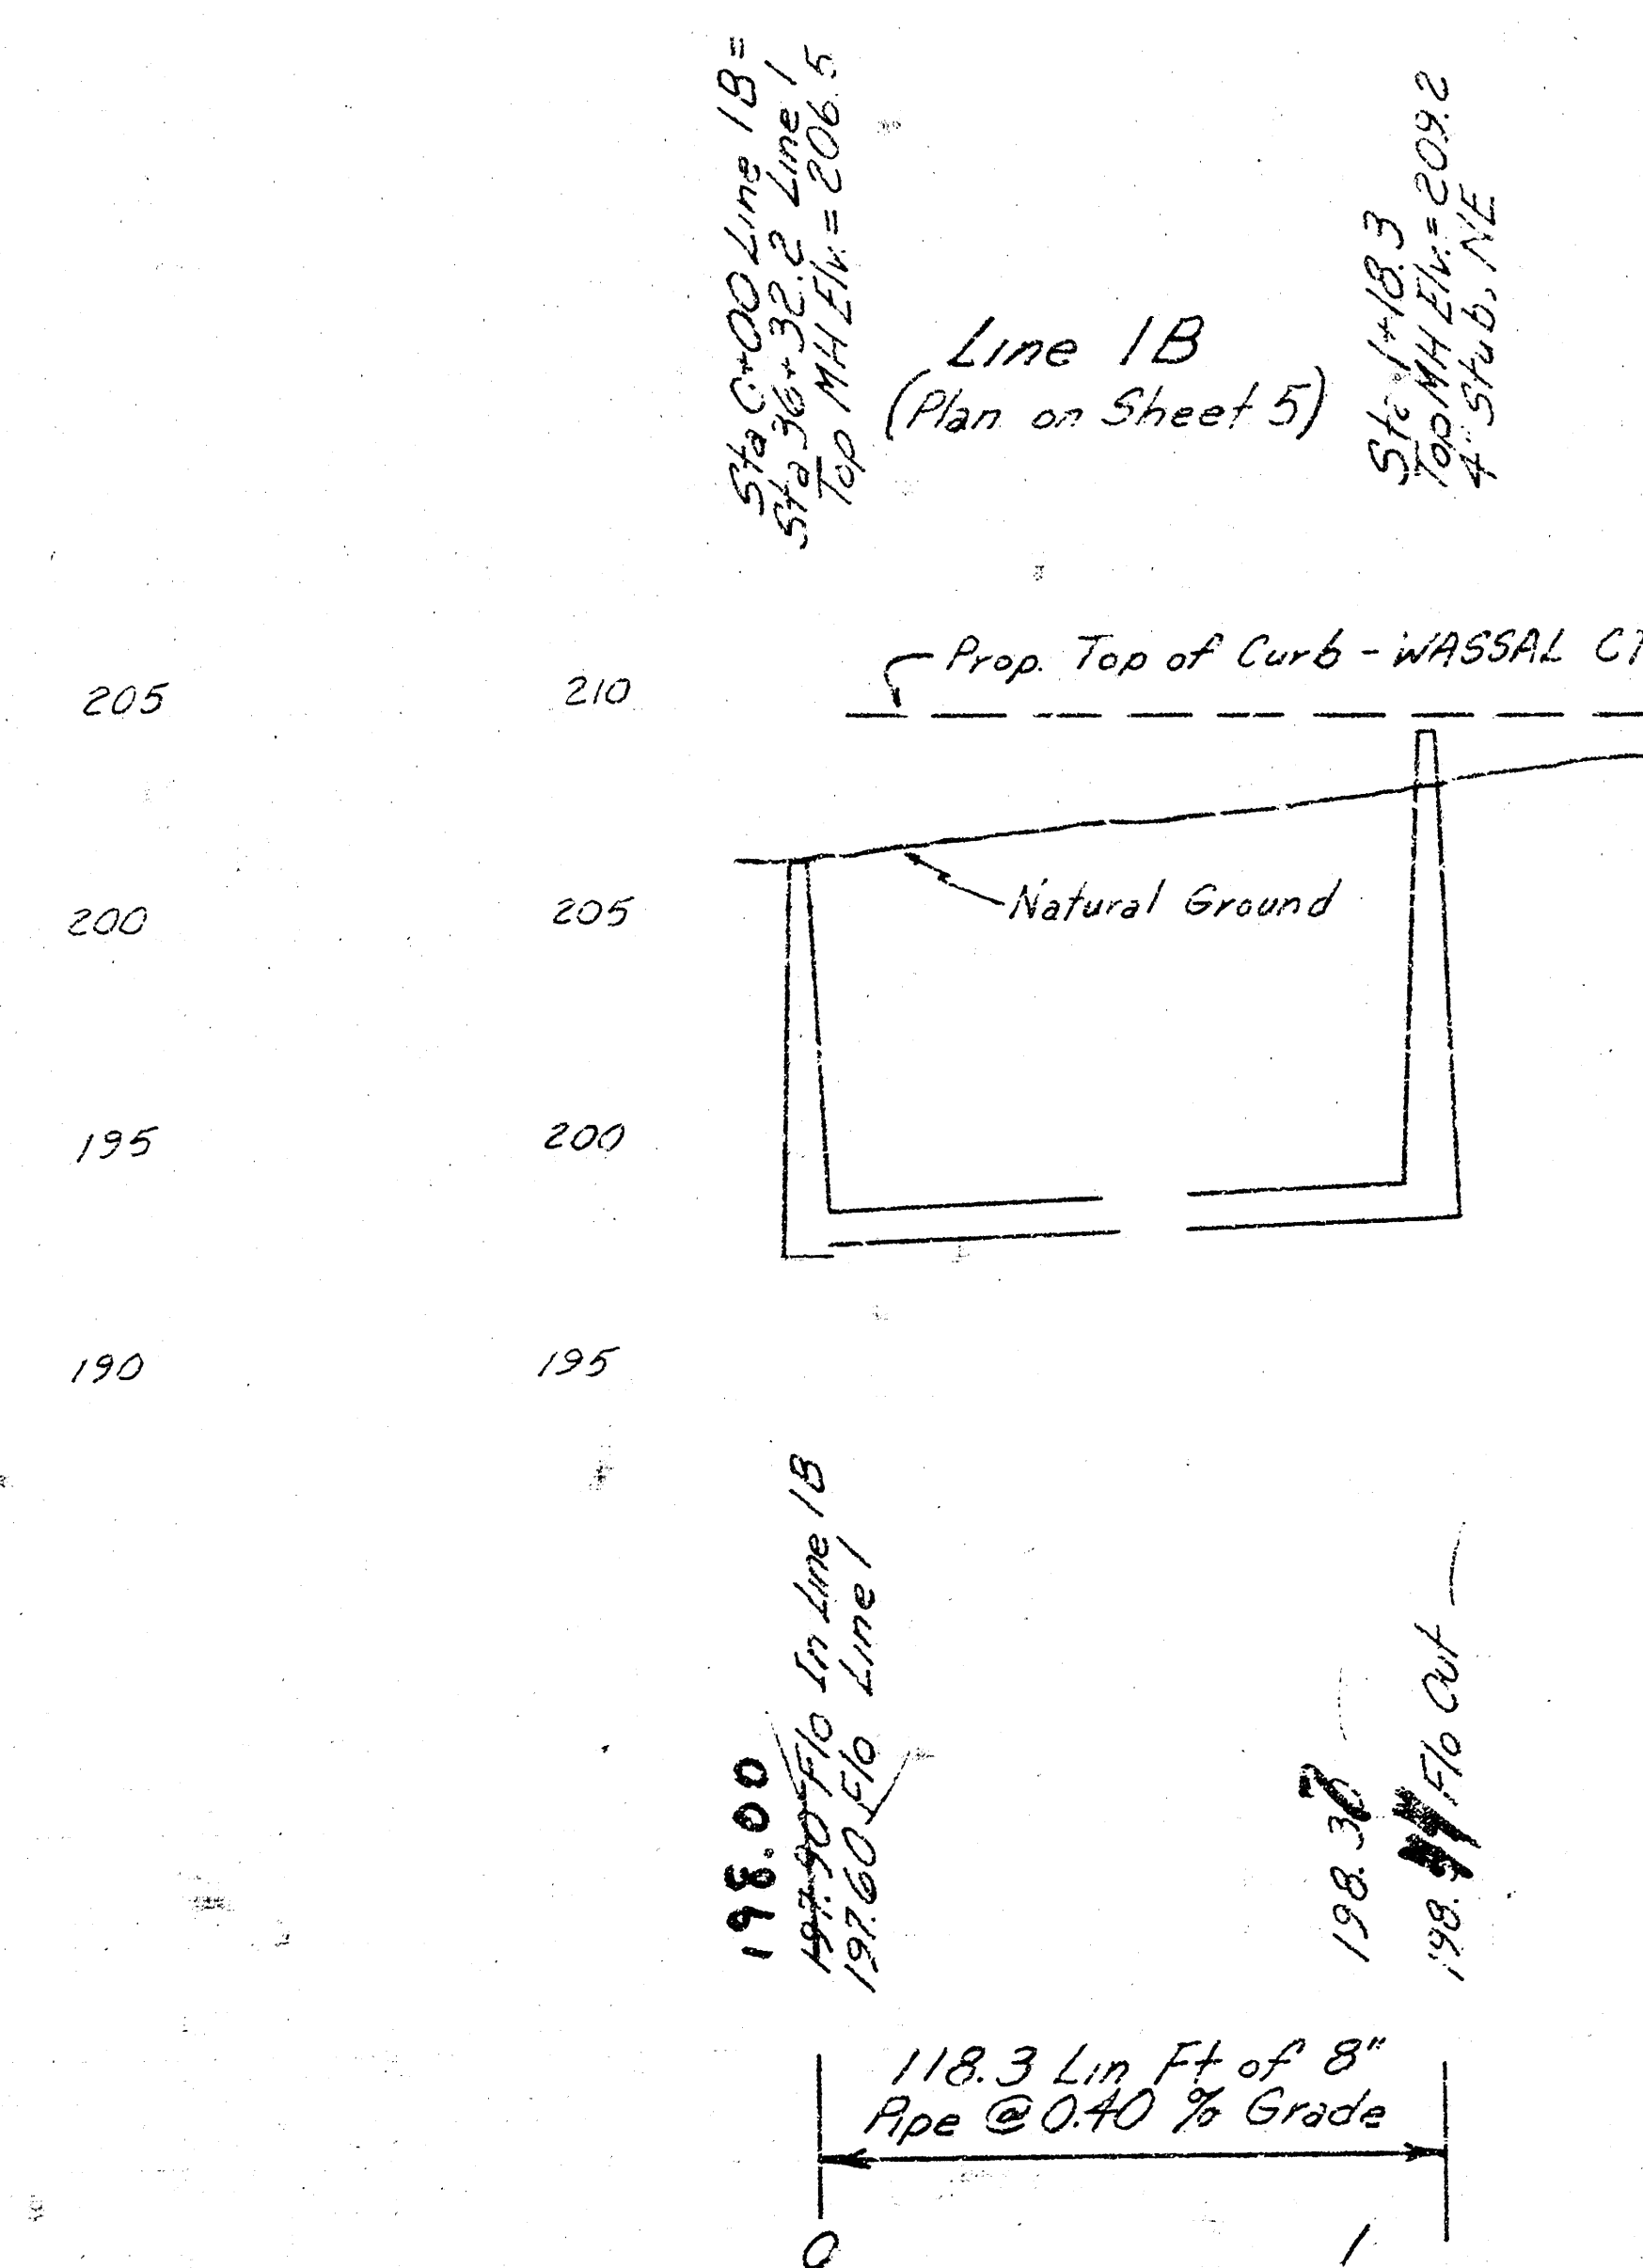
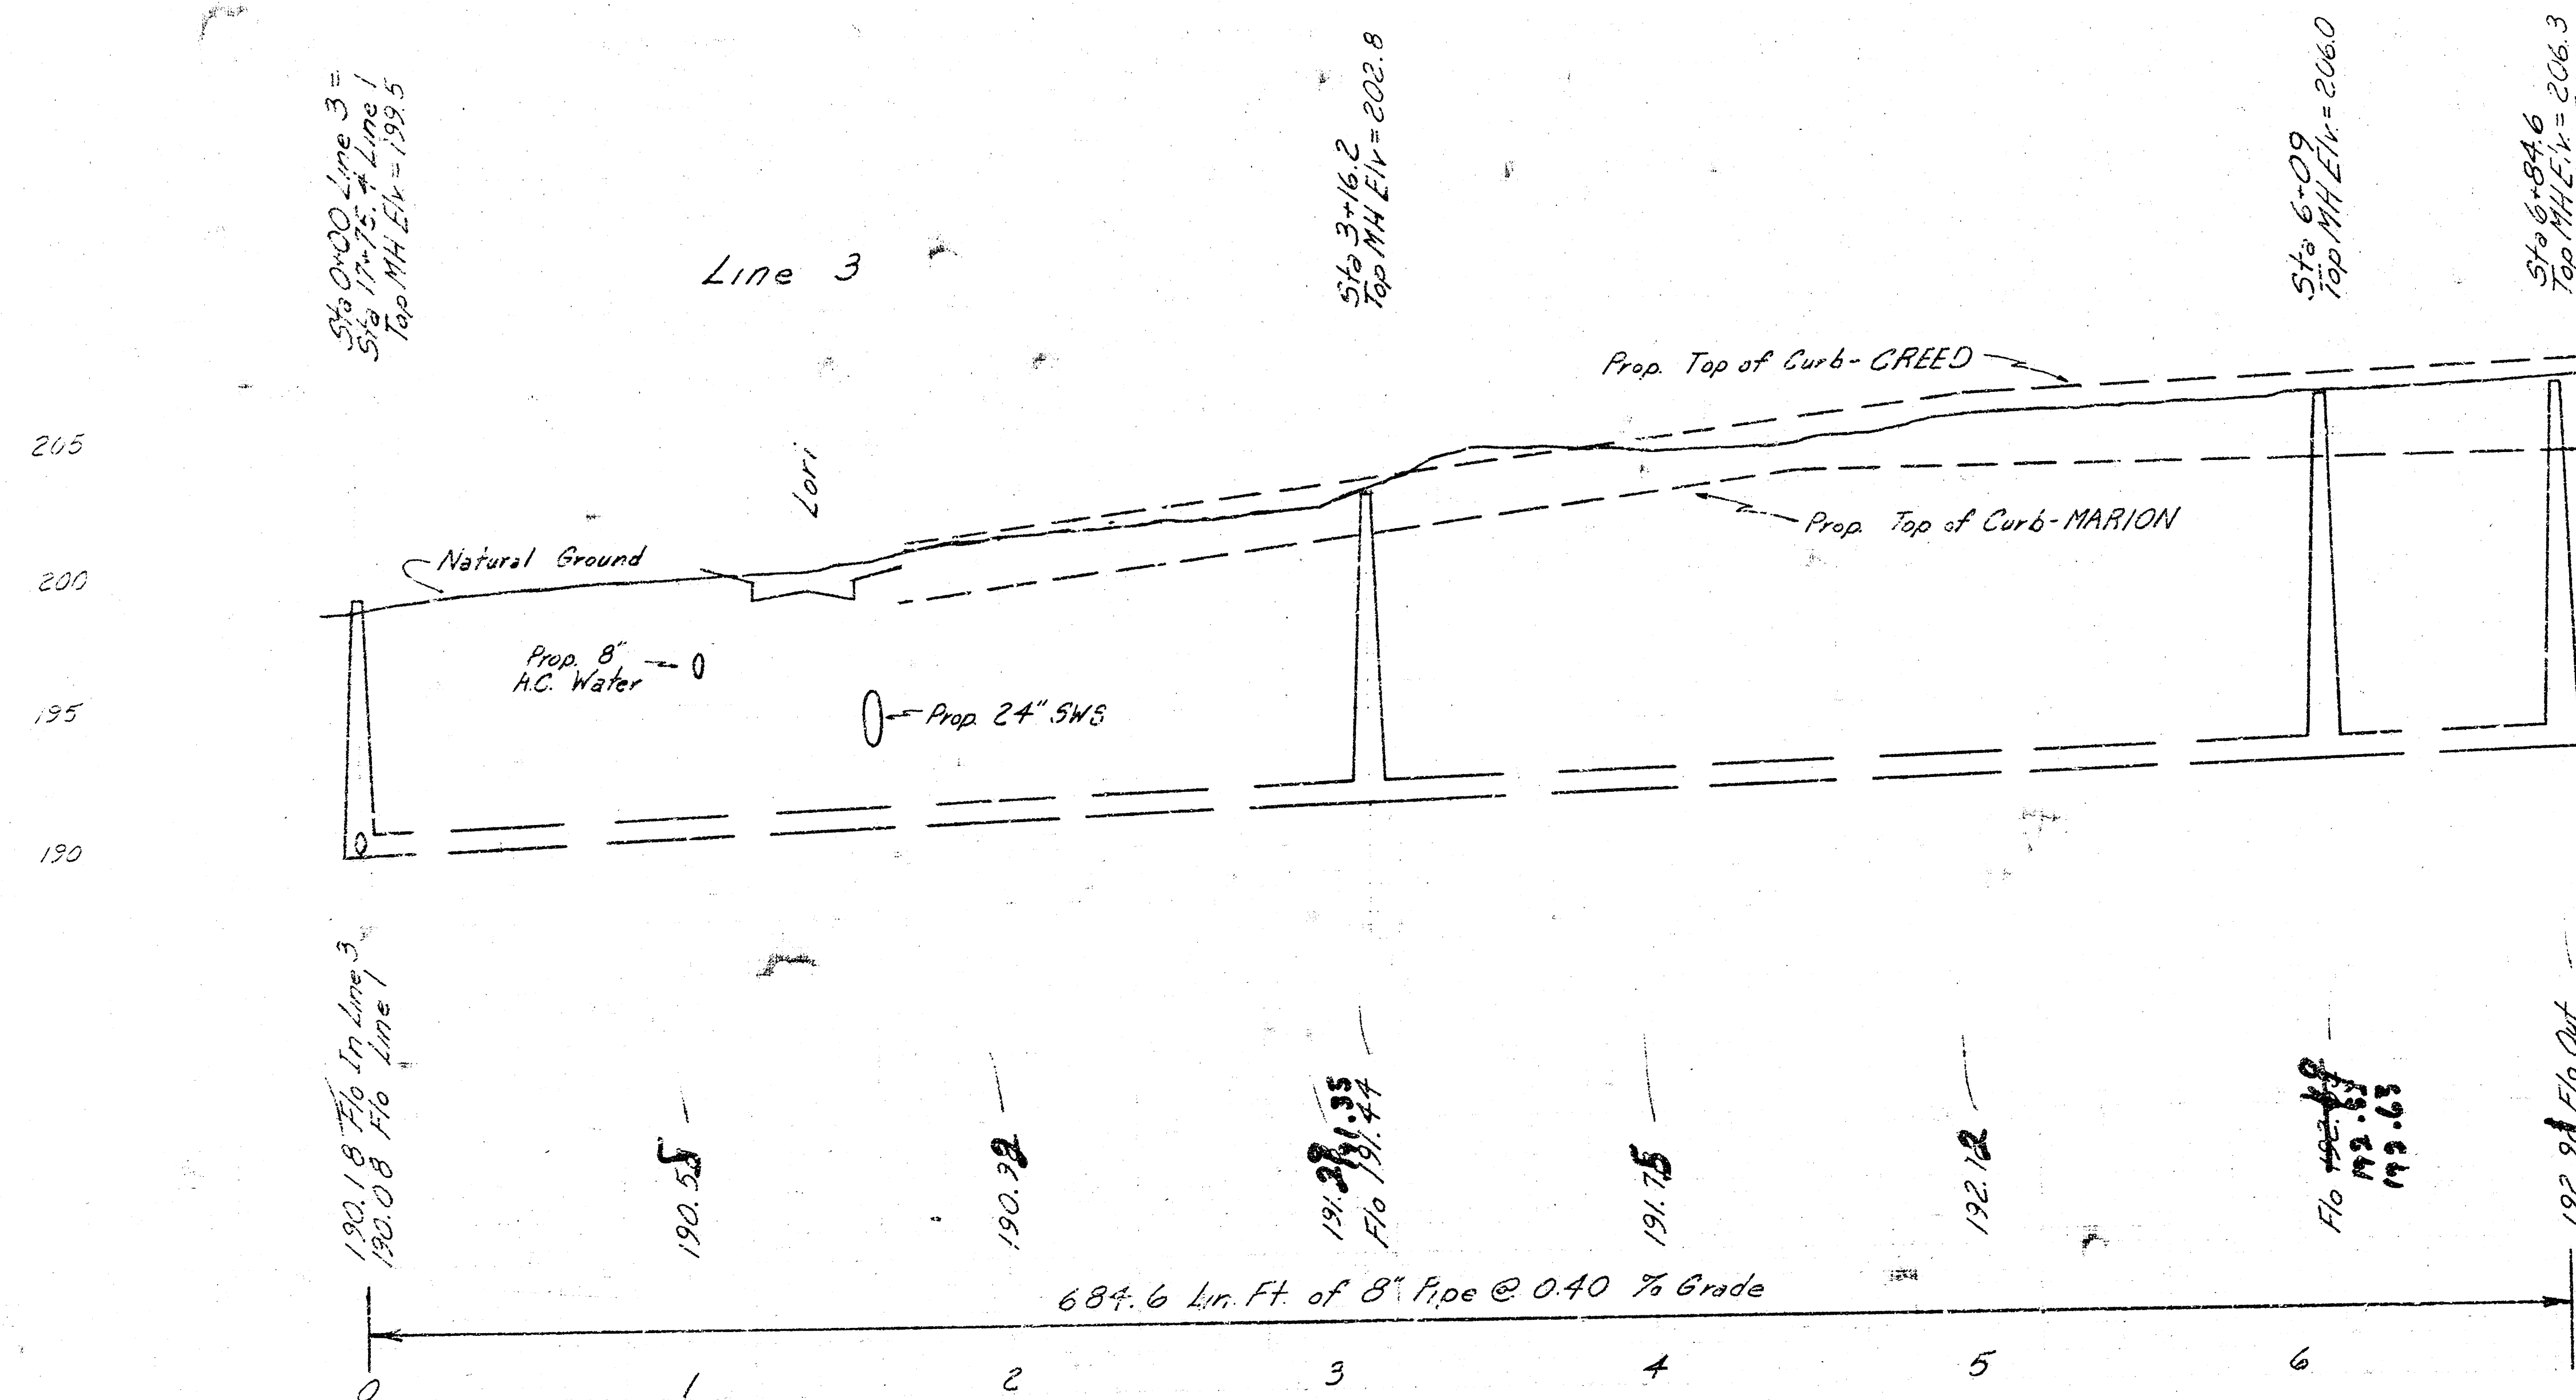
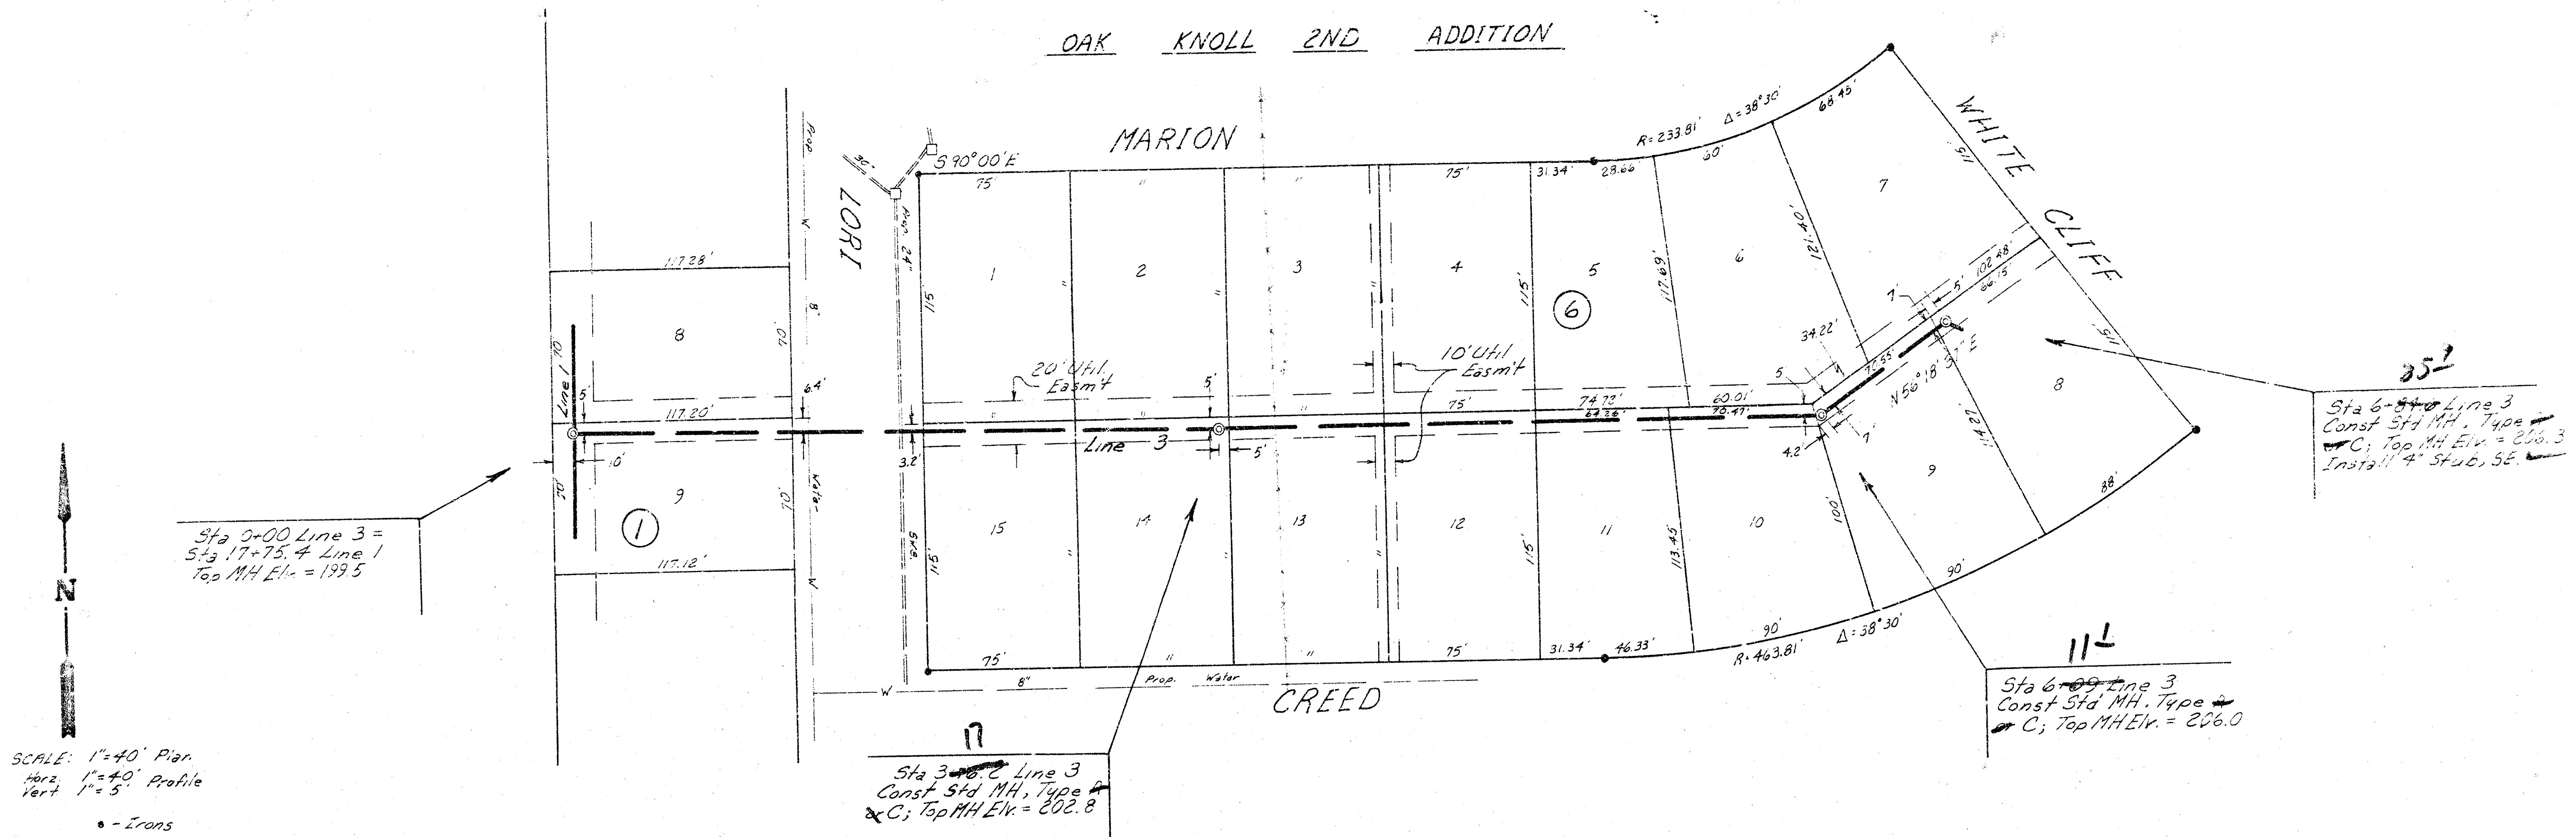


As Built

12/81




Sheet 9 of 11

Line 3, Line 1B
 Lateral 2, Main 23, WIS.
 Proj. # 468-76-245 - 80999-000-000-001

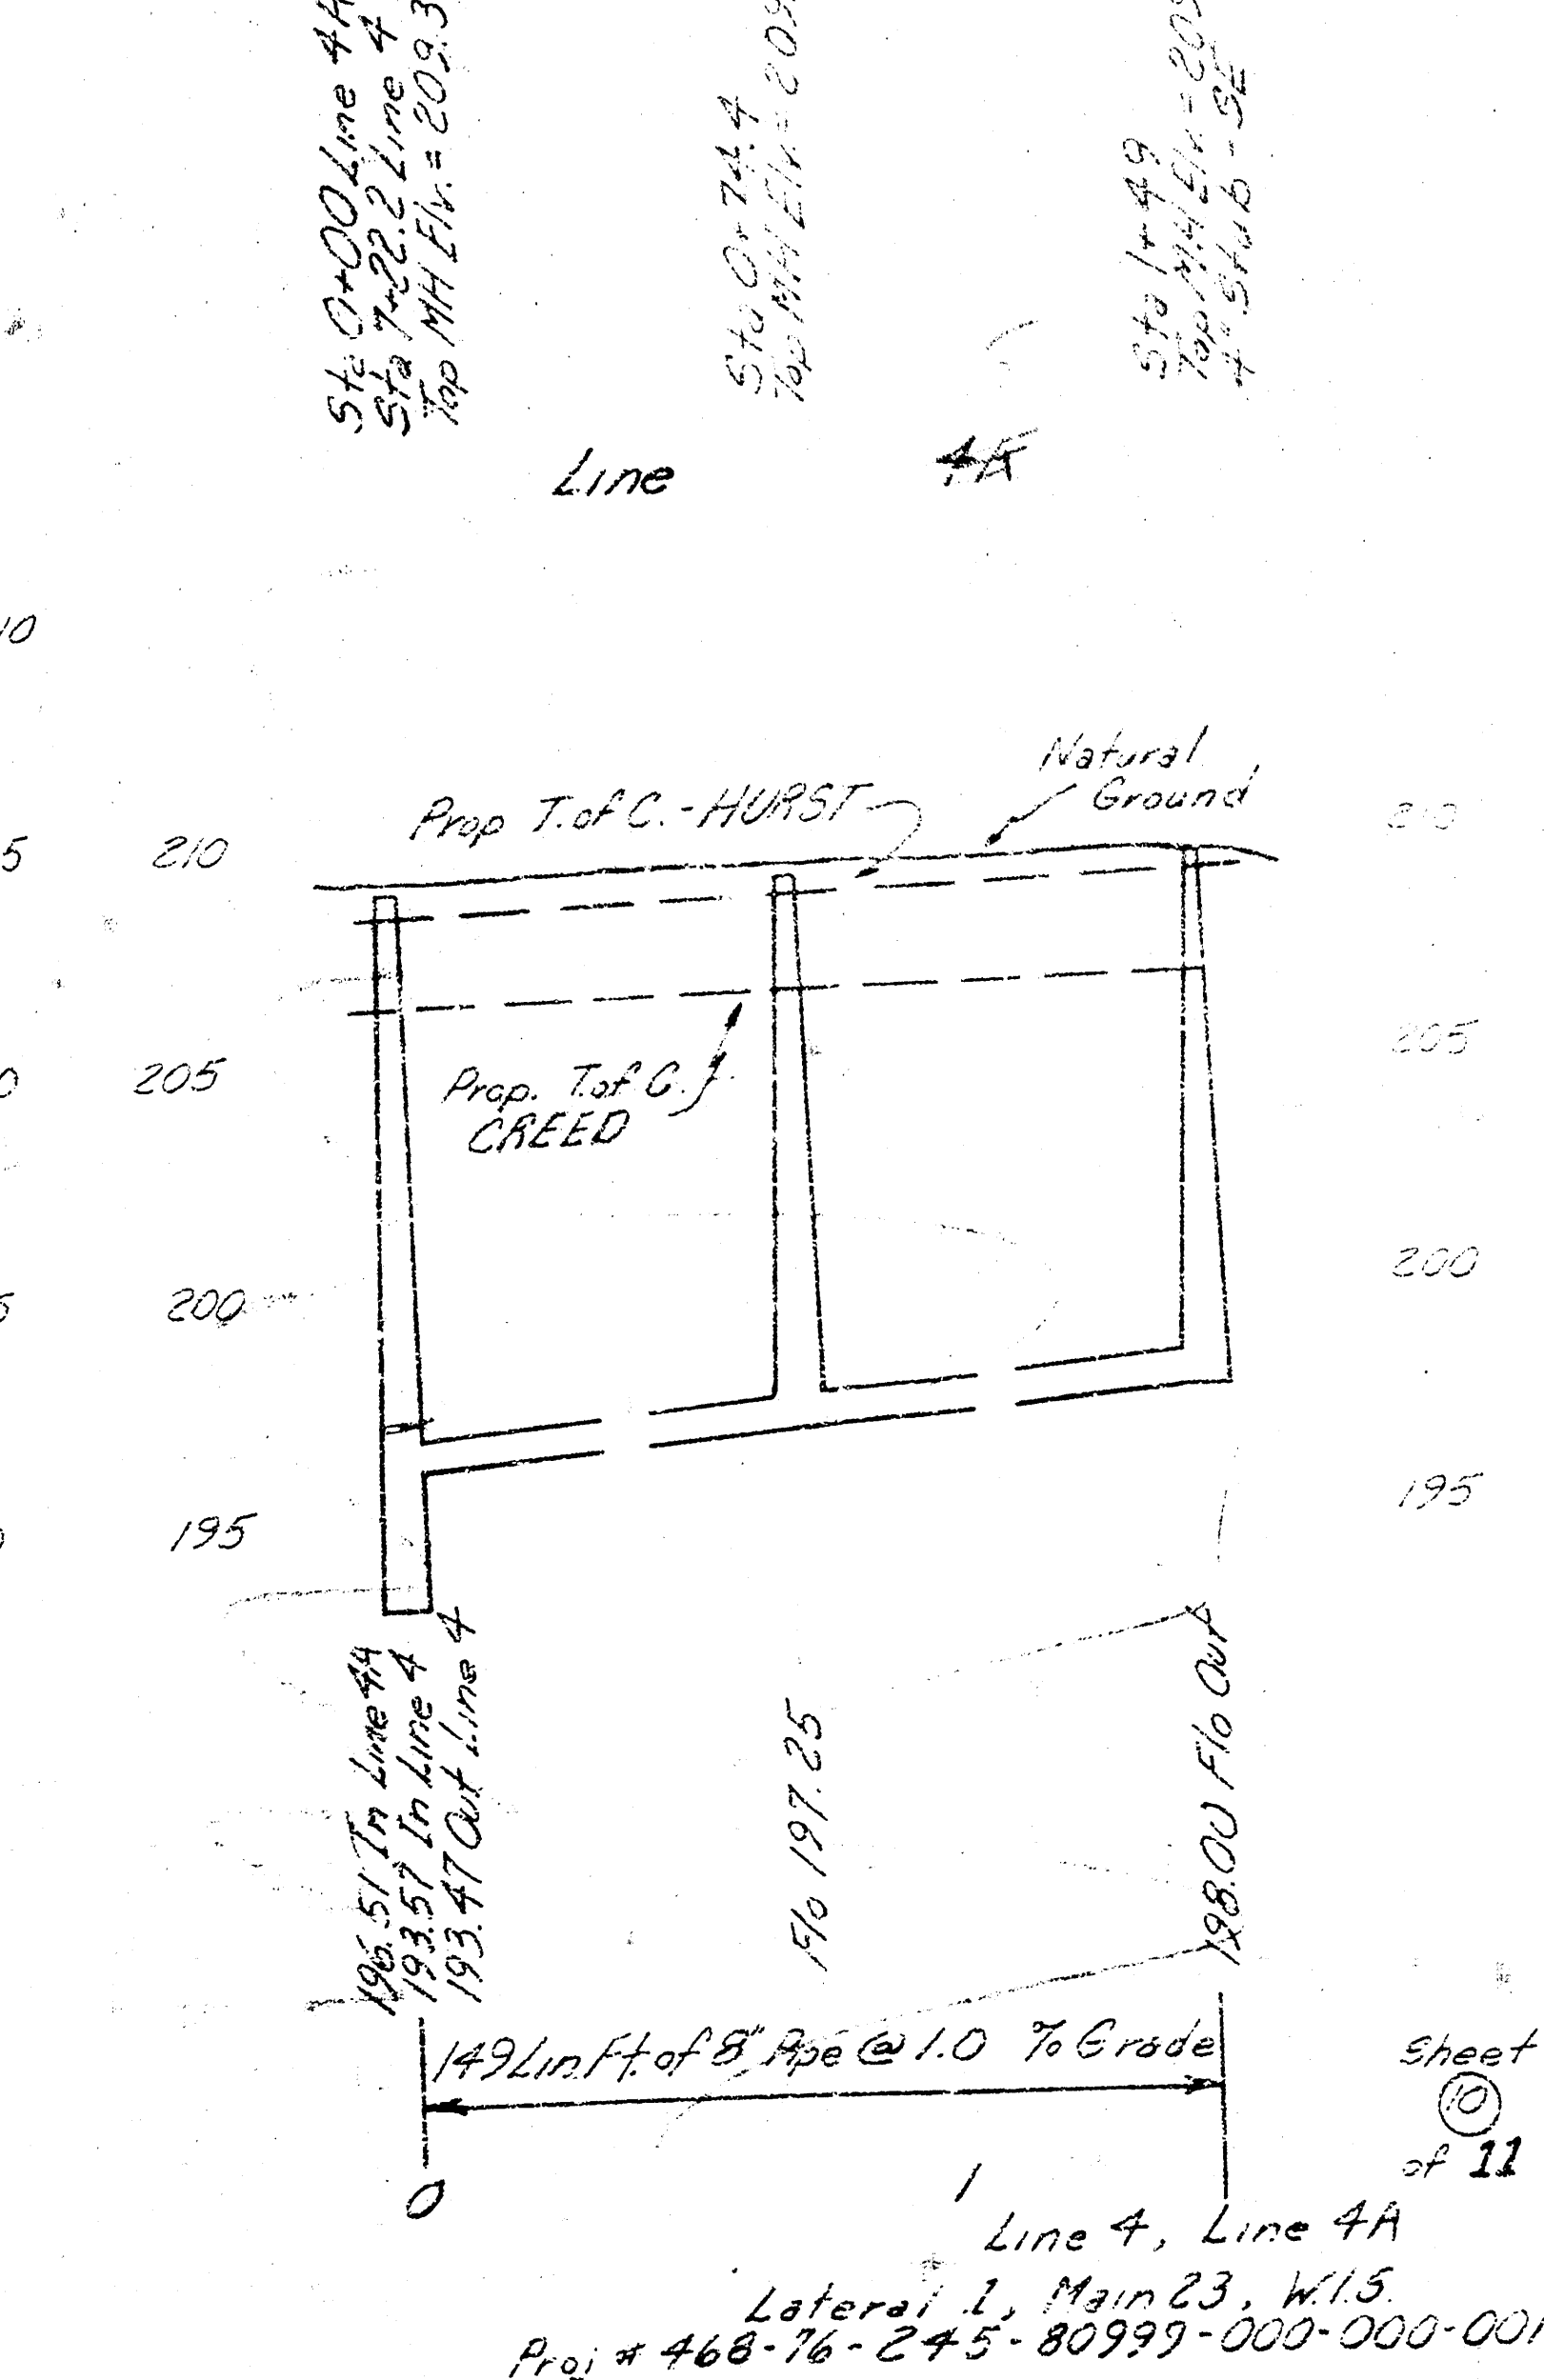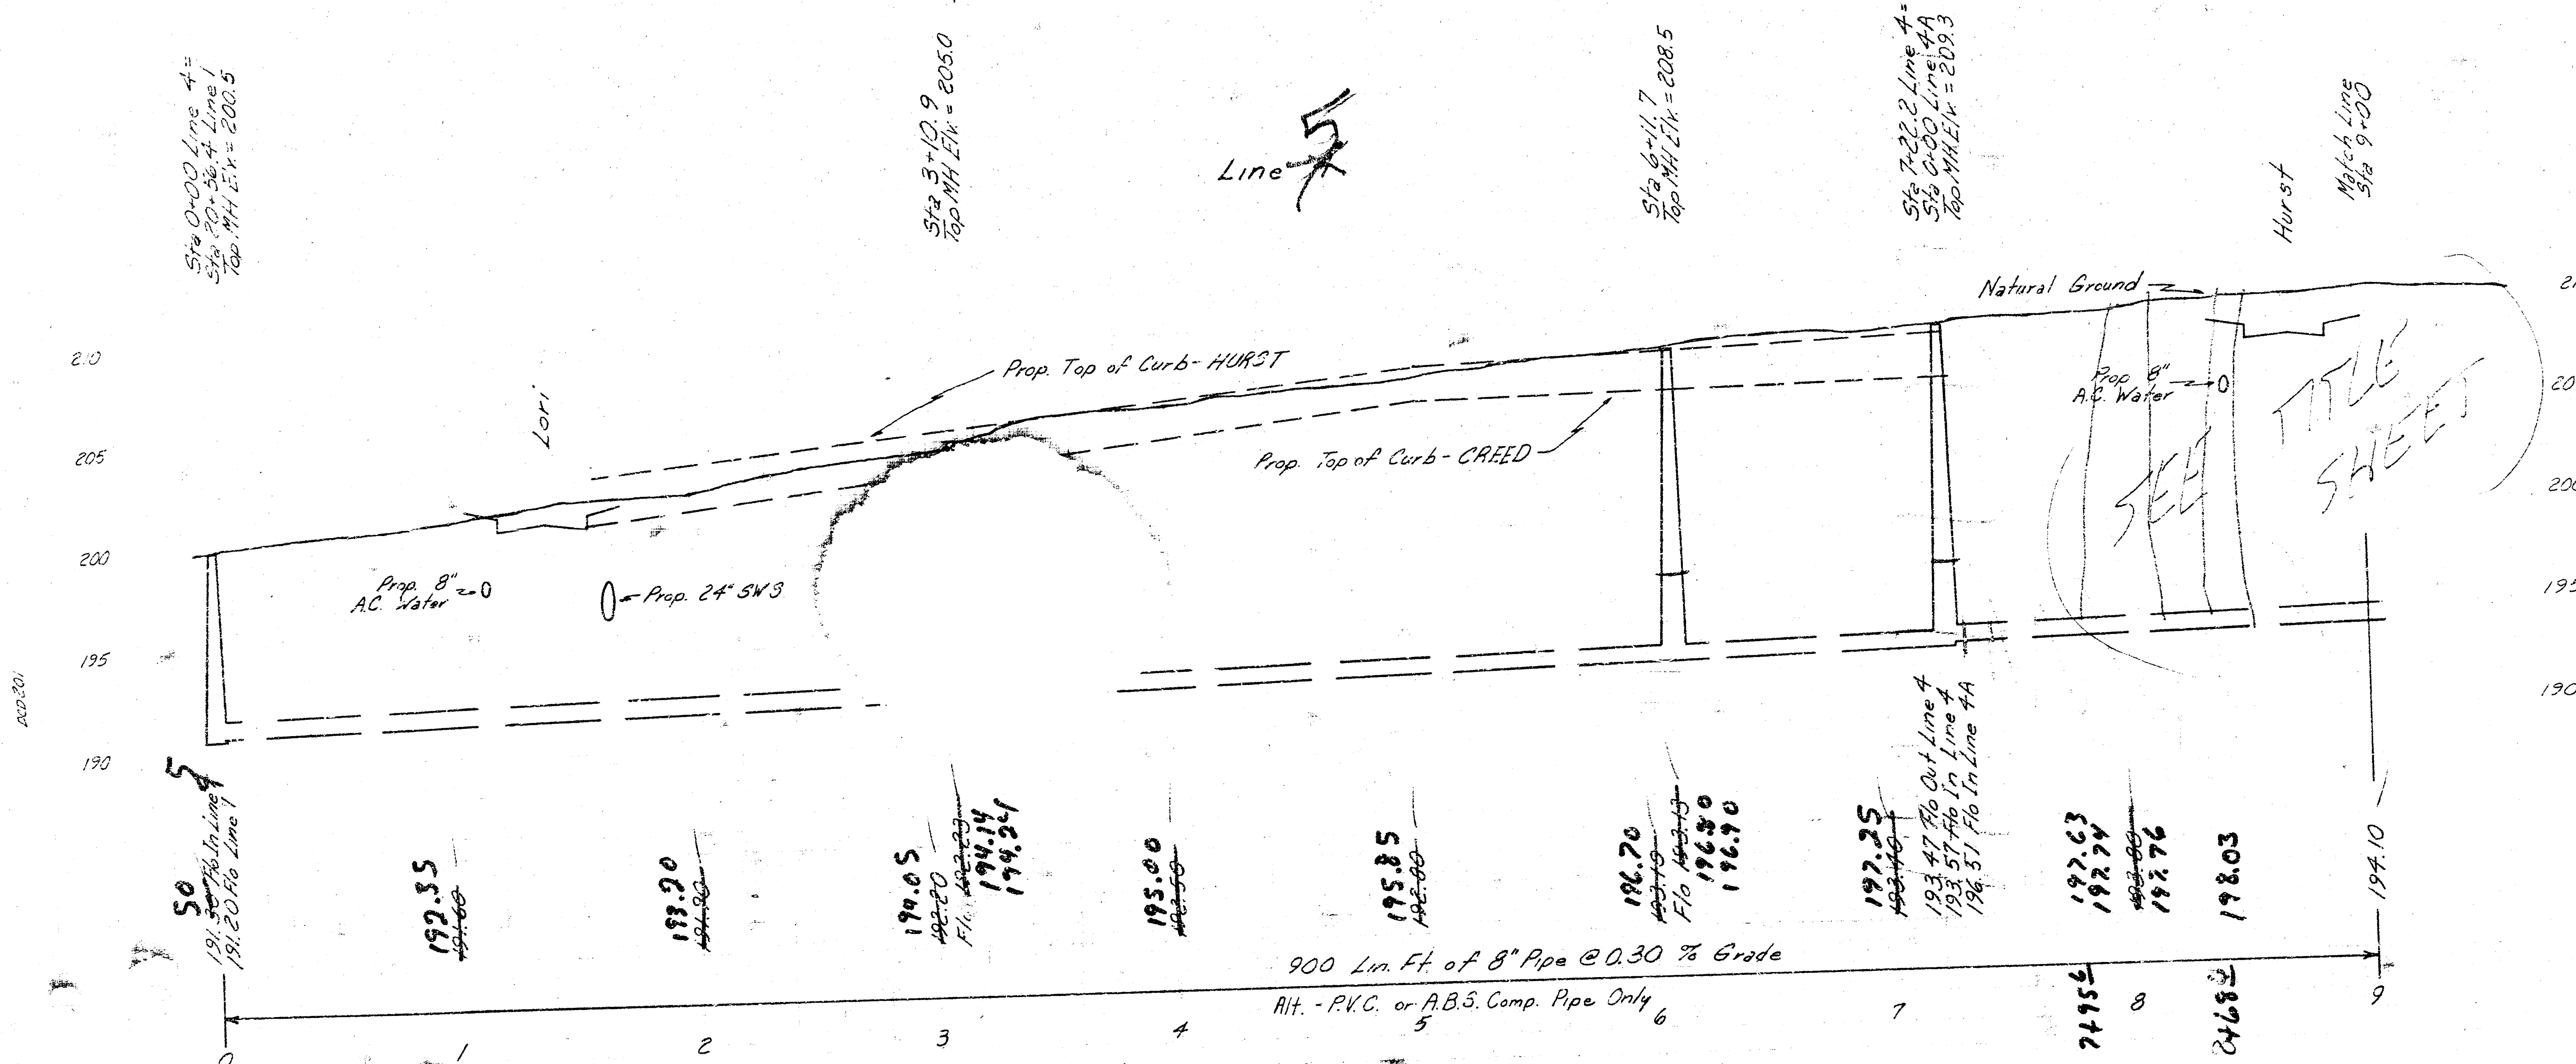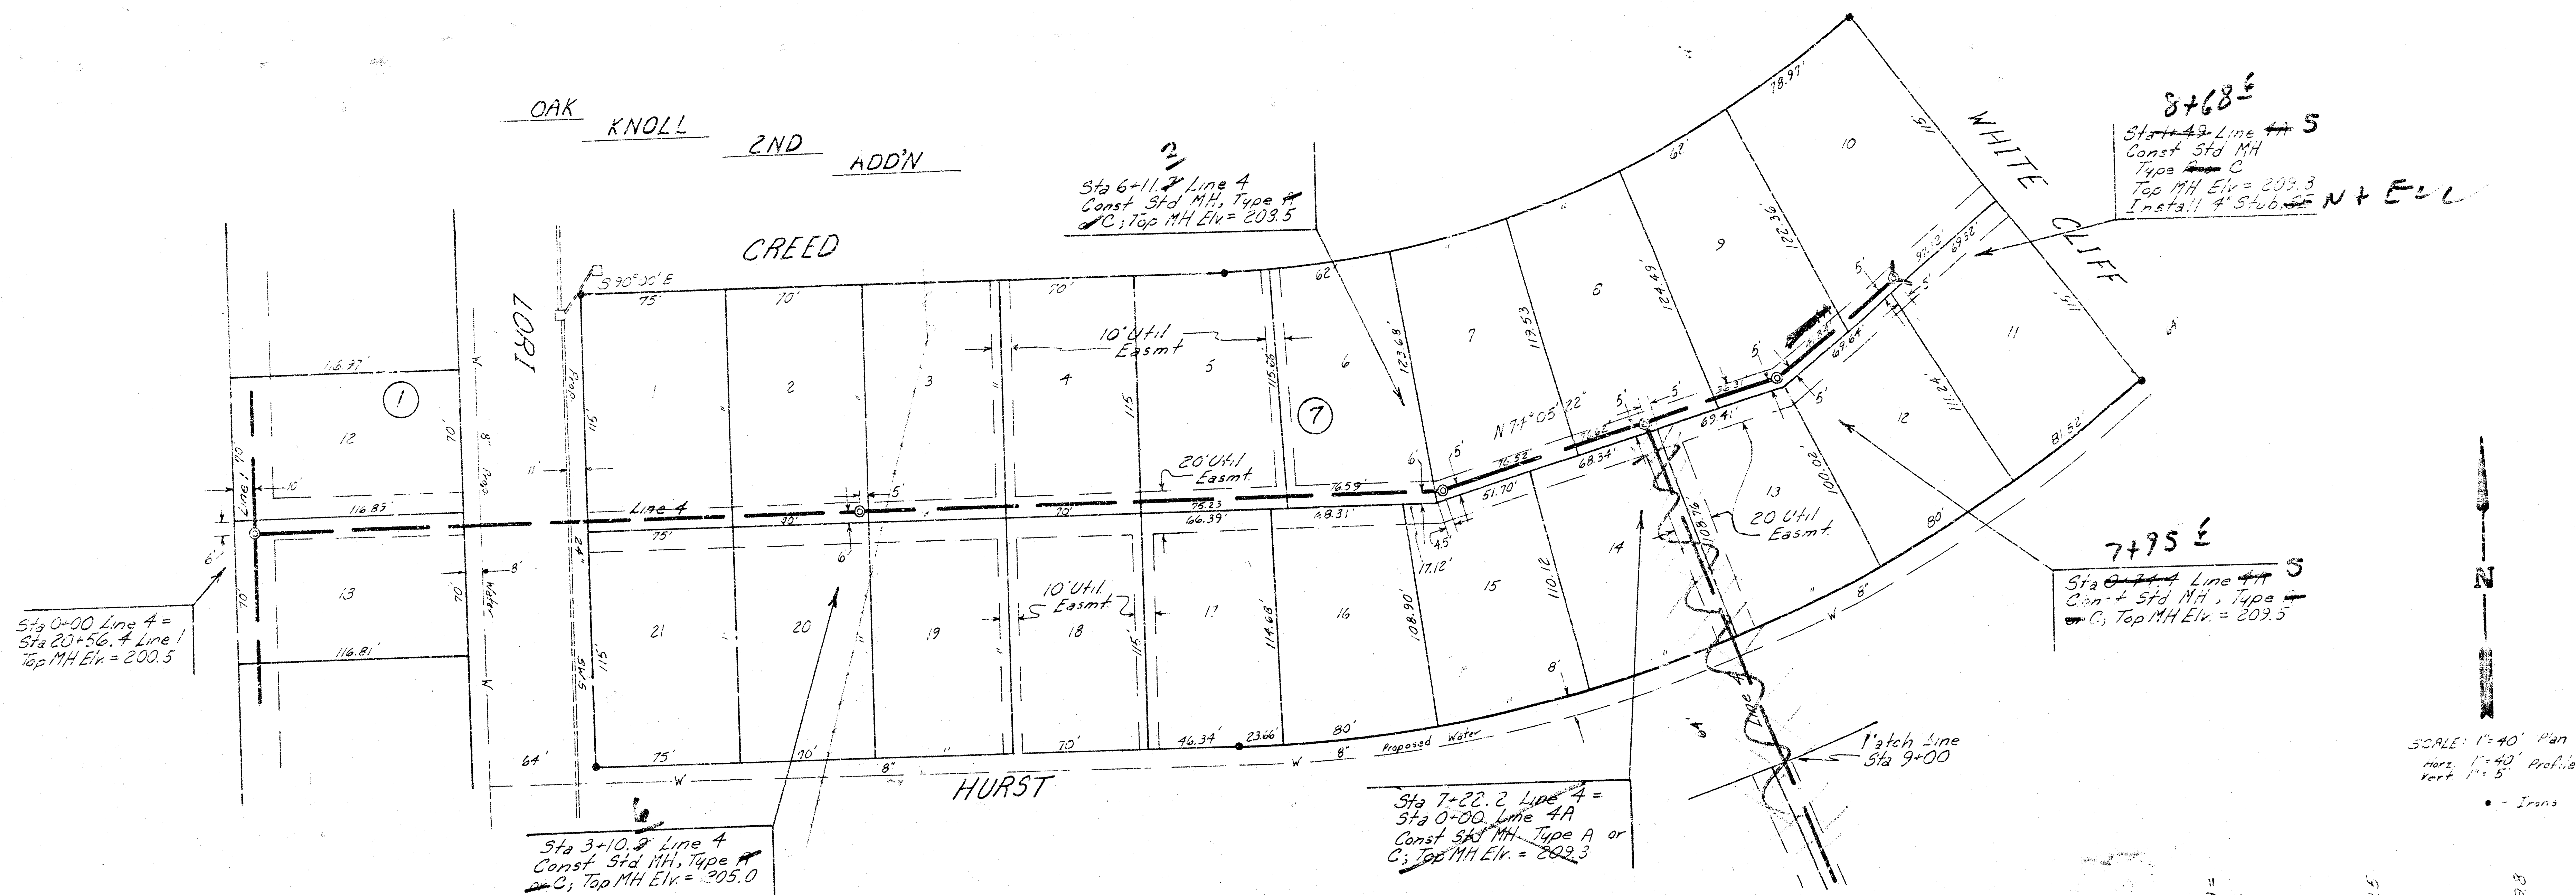

FILMED FROM THE BEST AVAILABLE COPY

OAK KNOLL 2ND ADD'N

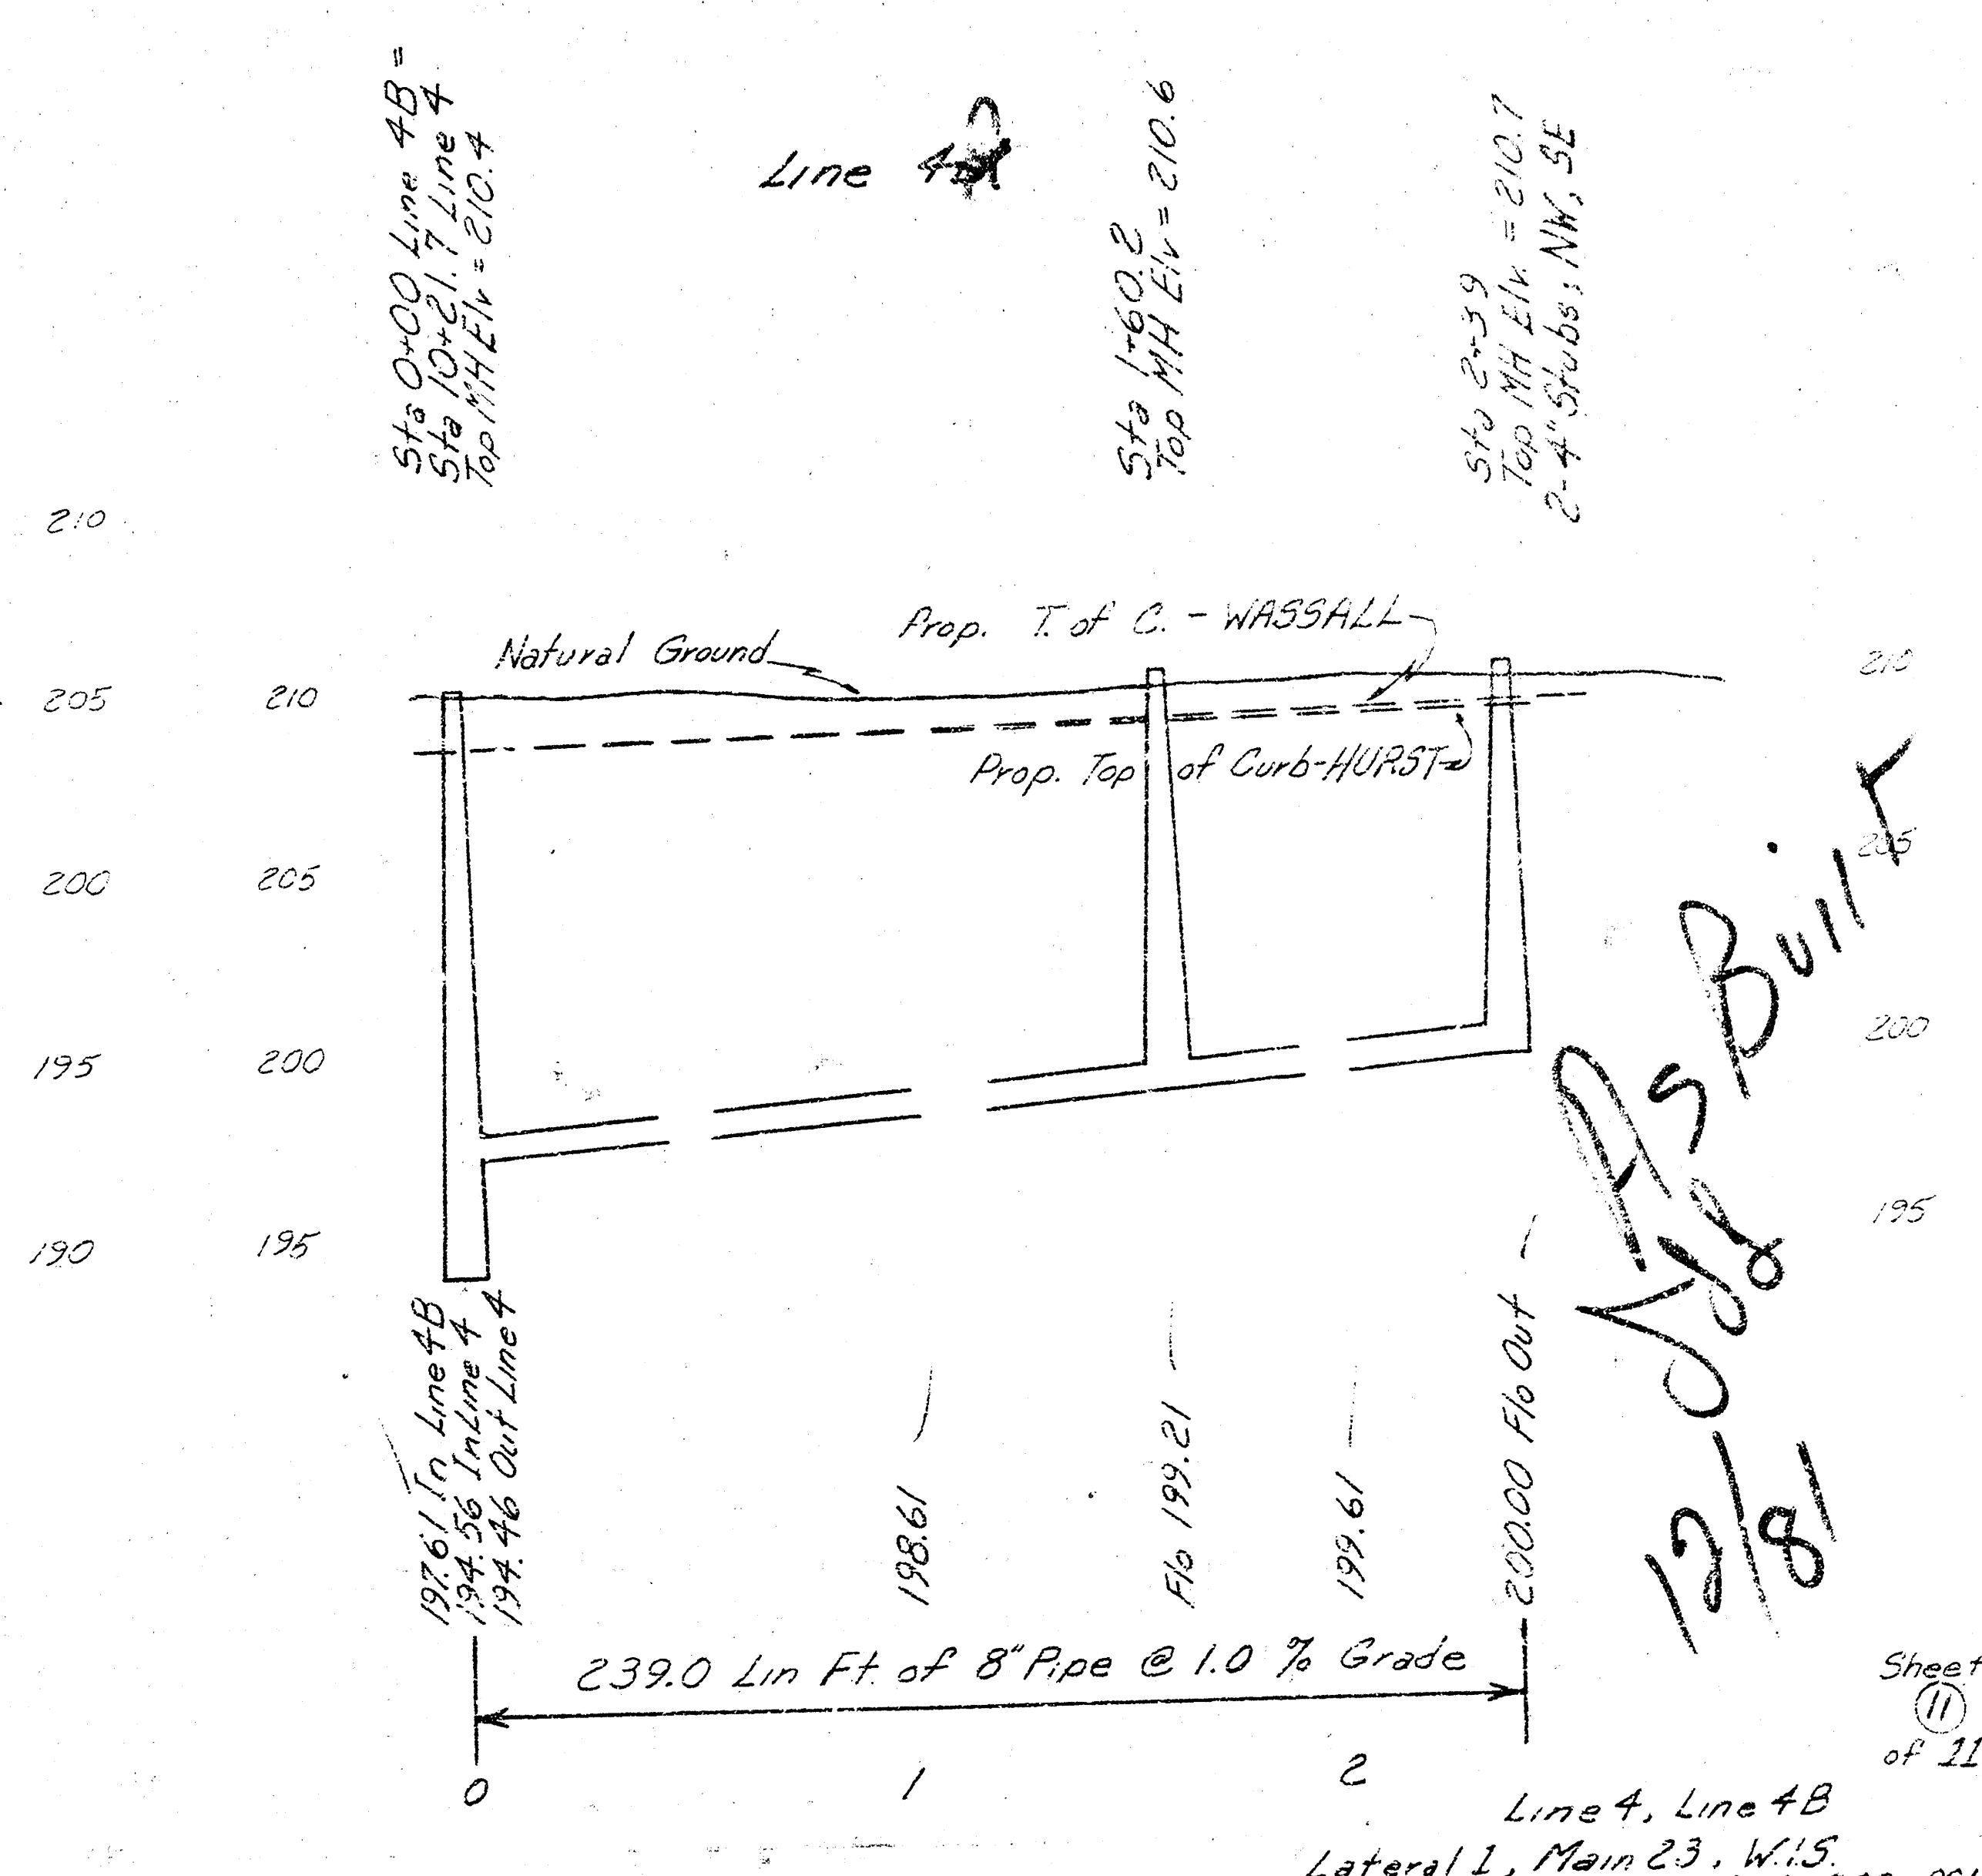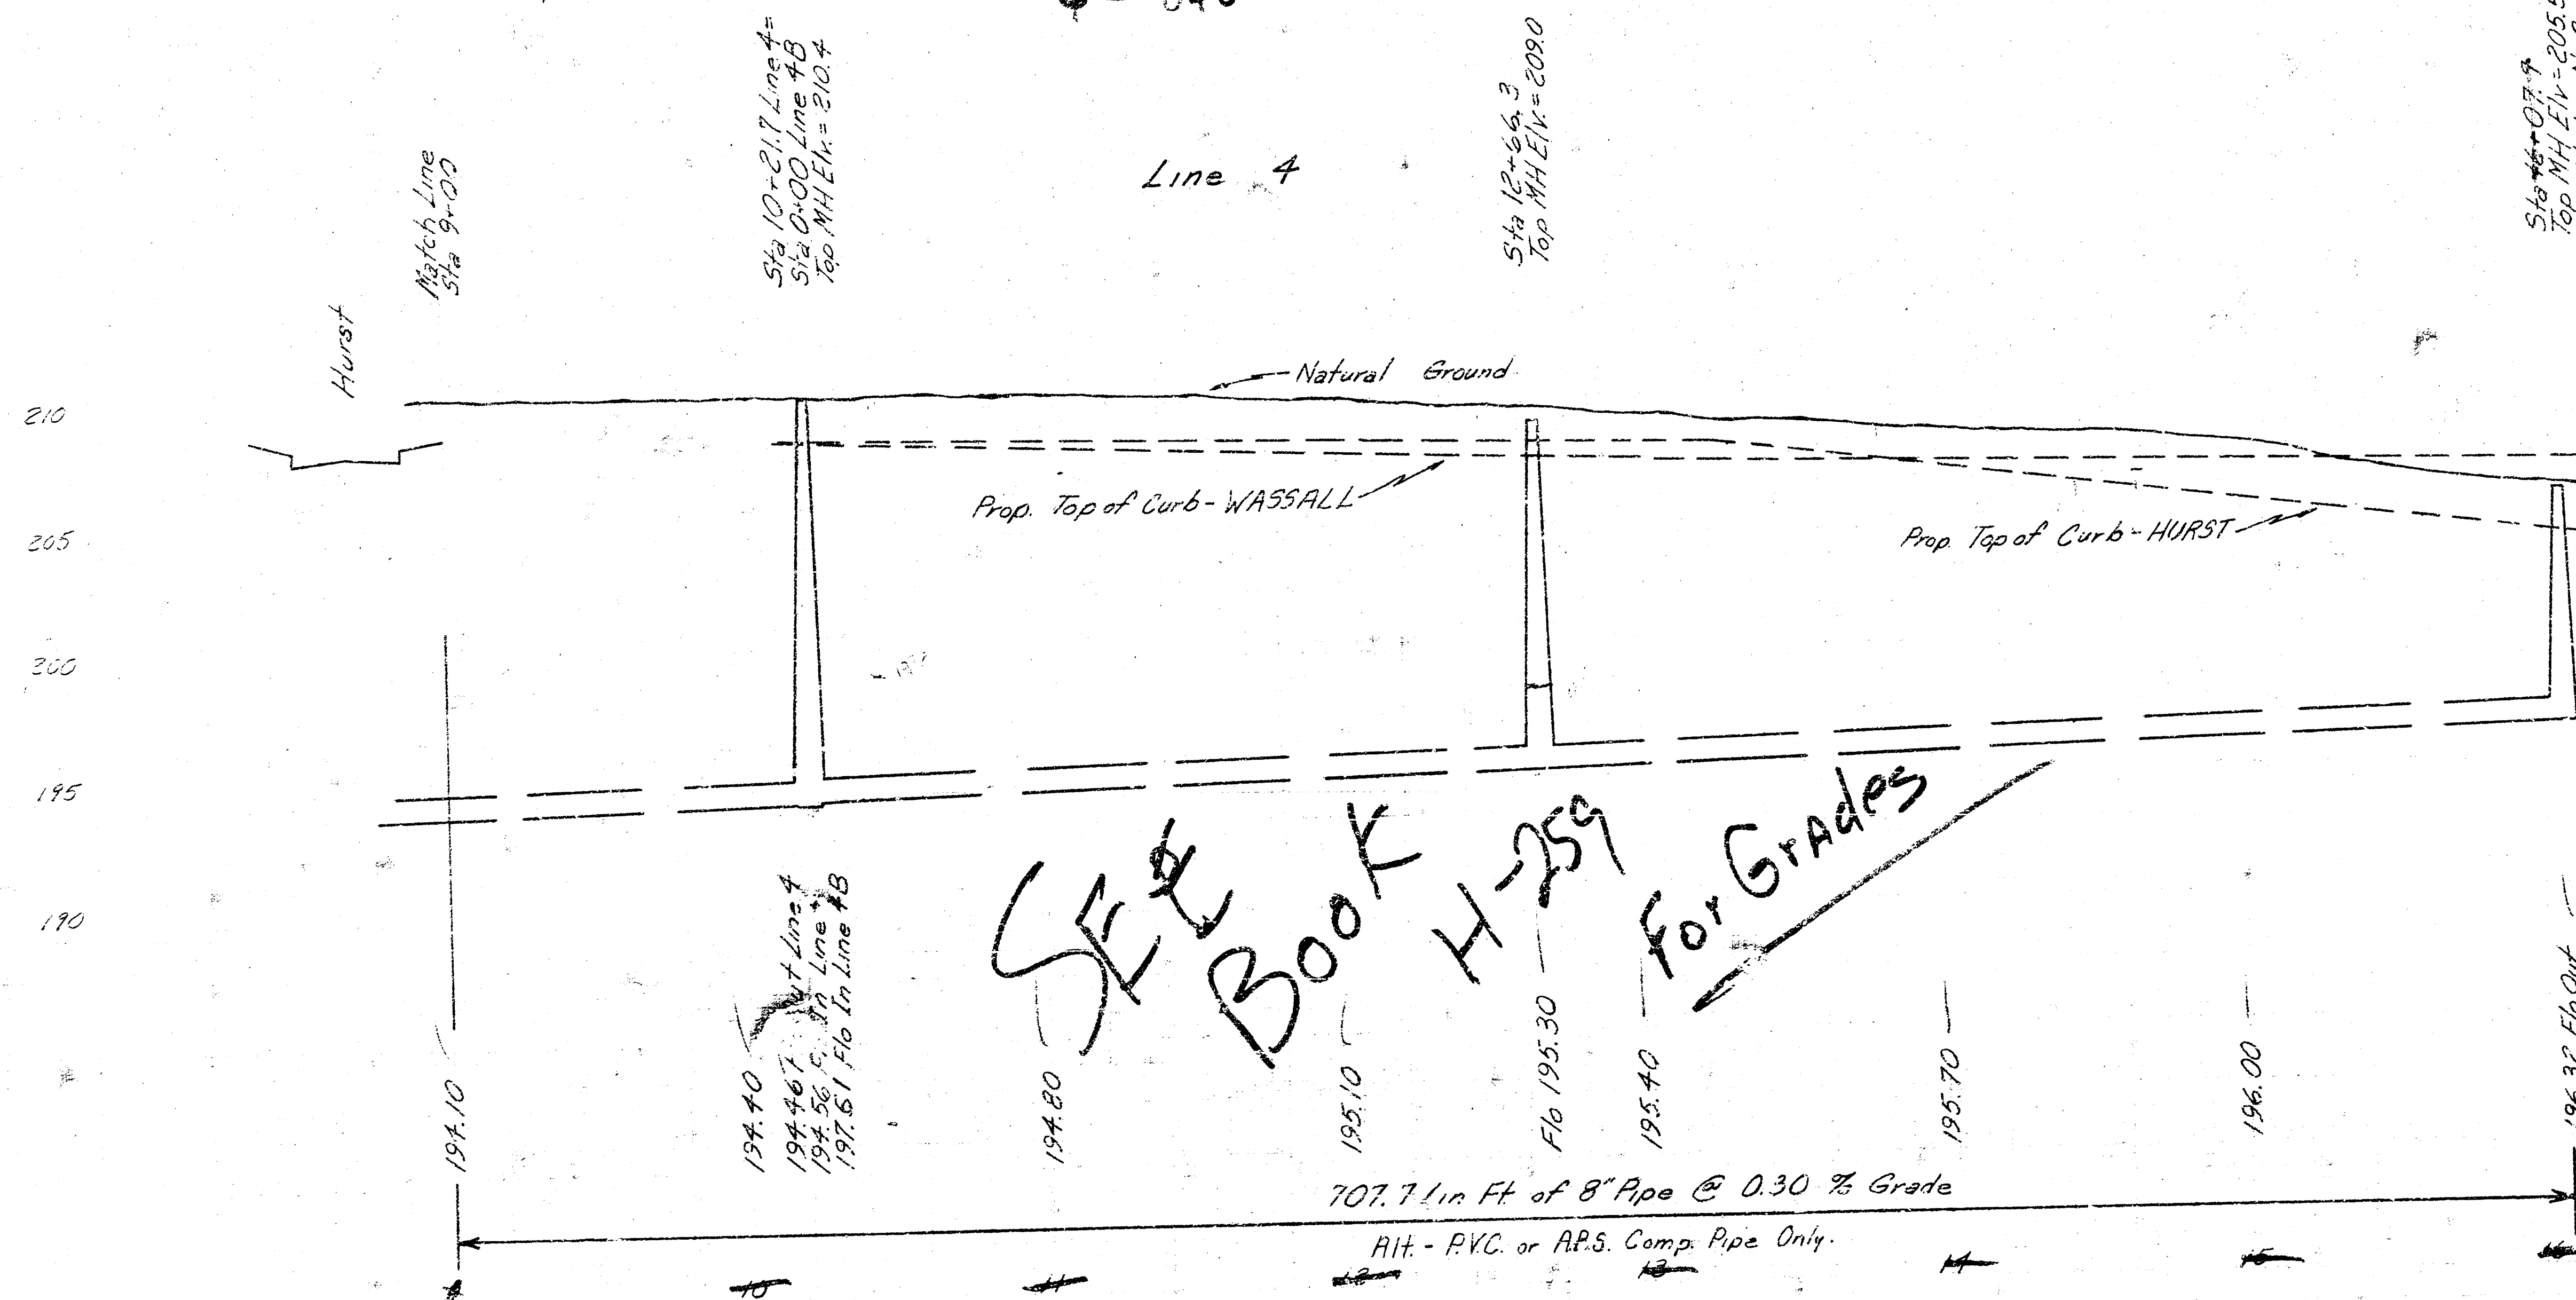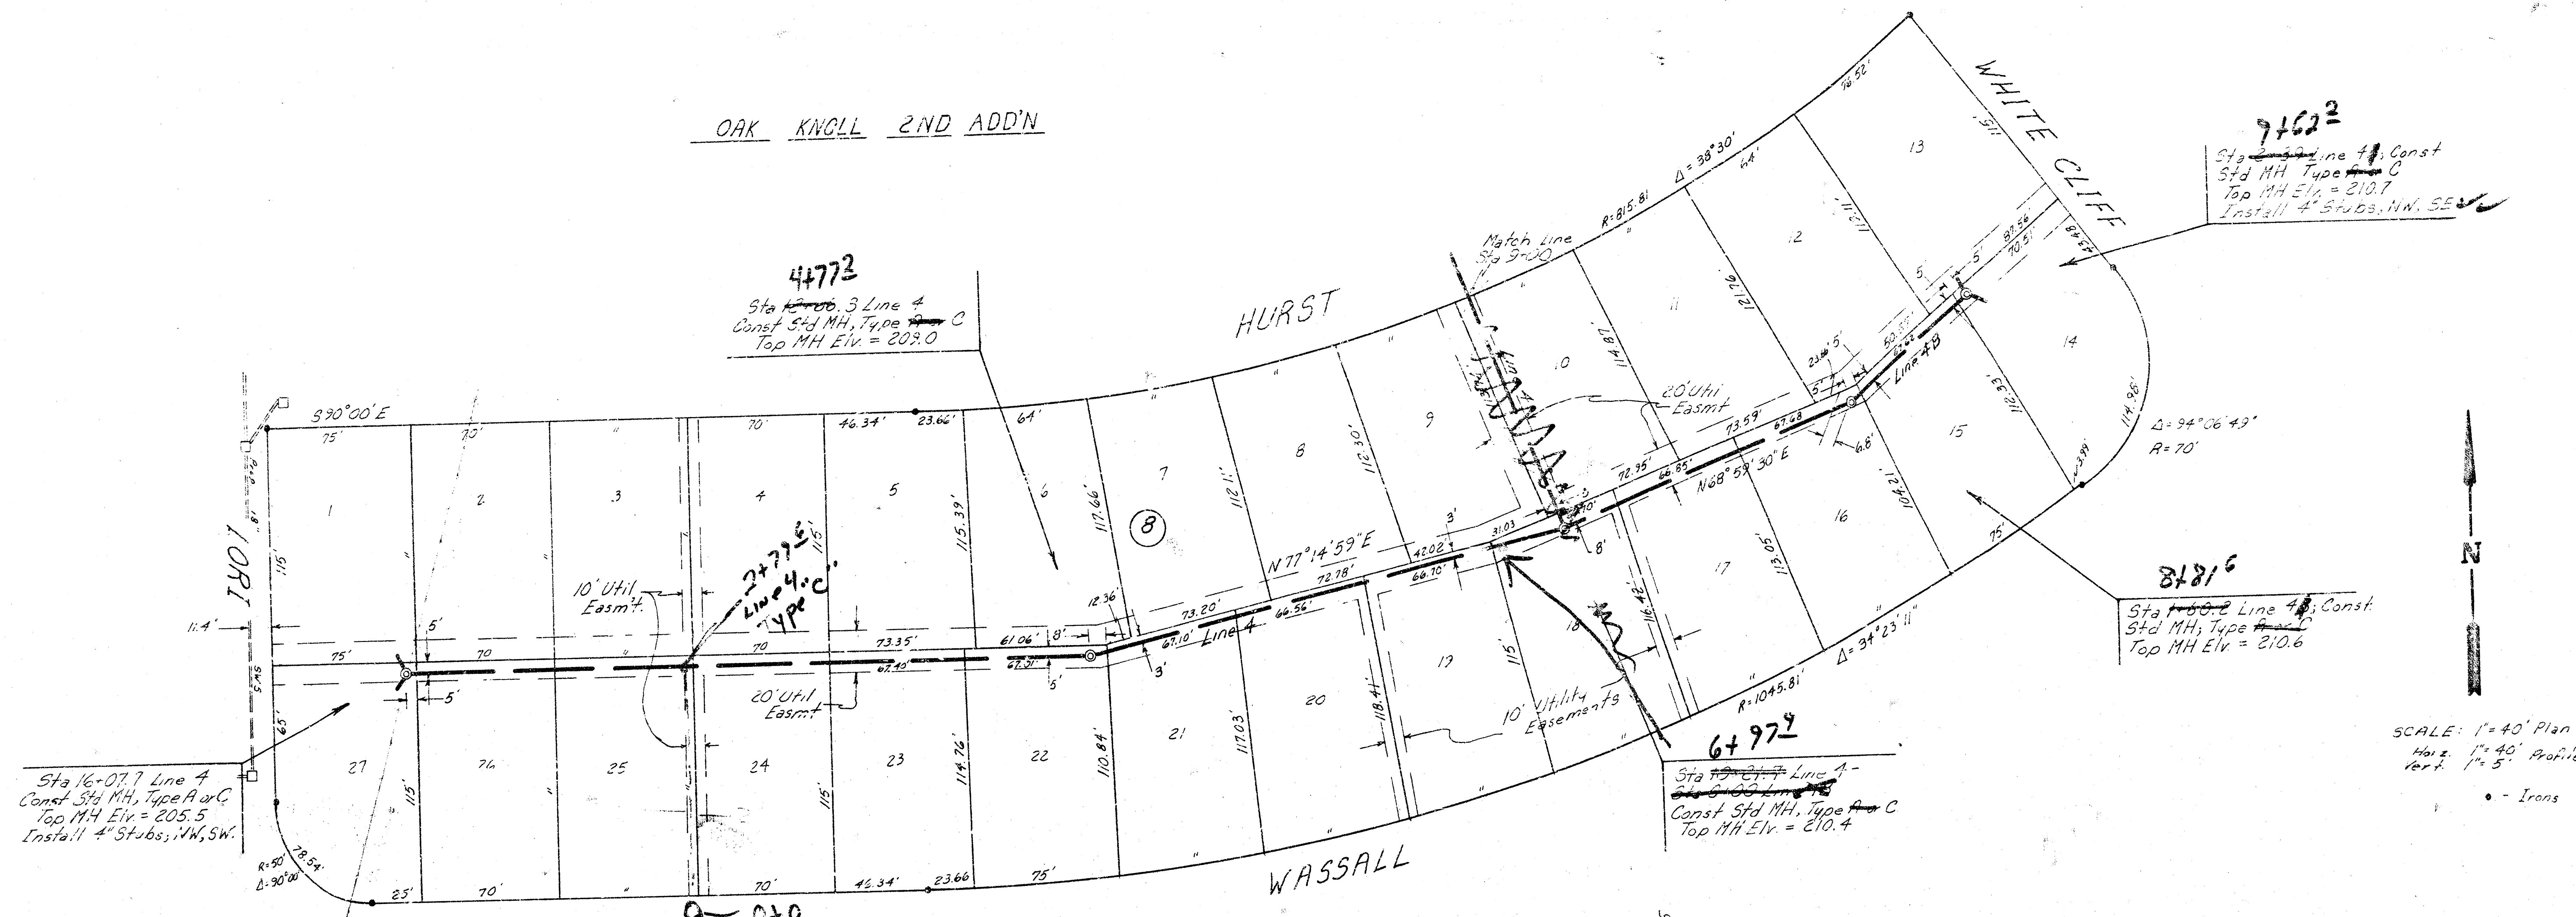

SEE BOOK H-259 For Grades

As Built
12/81

Line 4, Line 4B
Lateral 1, Main 23, W.15.
Proj # 468-76-245-80399-000-000-001