

B. M. 144.12 Top of bolt N. E. cor. concoco sign at S.W. cor. Hillside and Central.
 B. M. 149.64 "a" Top W-ab Hillside @ S. L. Pine extended.
 B. M. 149.19 "a" Top curb S. Ret. S.W. cor. Murdock - Hillside.

NOTE: Bid price of manhole Remove is to include the removable of the top 1/2 of manhole, Plugging of pipes and filling of sand.

NOTE: Remove top 1/2 exist. manhole. Plug Pipes. Fill with sand.

NOTE: Exist. K.G.E. Underground Conduit.

NOTE: Remove top 1/2 exist. manhole. Plug Pipes. Fill with sand.

NOTE: Plug Pipe South

Plan Scale 1" = 40' Horiz.
 Profile Scale 1" = 5' Vert.

NOTE: Replace Asphalt
 Sta. 0+00.0
 Exist. manhole
 Plug Pipe West.

NOTE: Remove Pavement. Replace with Asphalt.

NOTE: Replace pavement where manholes are abandoned.




NOTE: THIS PROJECT SHALL BE COORDINATED WITH CONSTRUCTION OF WESLEY MEDICAL CENTER PARKING GARAGE SUCH THAT PINE AND MURDOCK WILL NOT BE CLOSED AT THE SAME TIME AND SUCH THAT CONSTRUCTION OF THE SEWER ACROSS PINE WILL NOT OCCUR WHILE PINE IS CLOSED FOR CONSTRUCTION OF TUNNEL IN CONNECTION WITH PARKING GARAGE.

WESLEY MEDICAL CENTER
 THIRD ADDITION

NOTE: Plug Pipe Southeast.

Sta. 6+80.4
 Exist. manhole
 Exist. 10" Stub west
 Plug Pipe W. NW.

Sta. 6+98.1
 Exist. M.H.
 Exist. 10" Stub West
 Plug pipe W. NW.

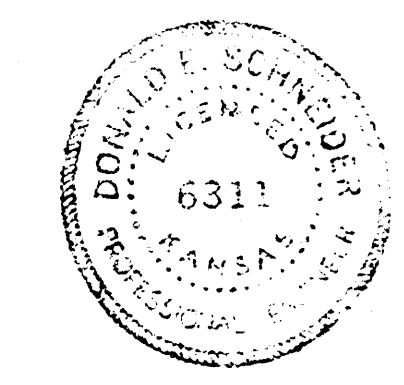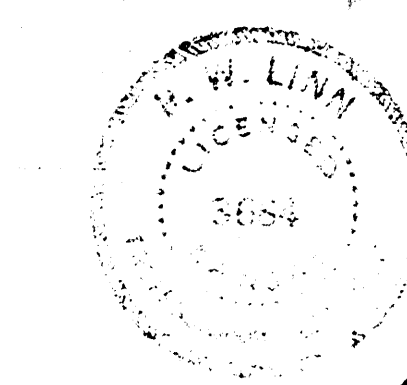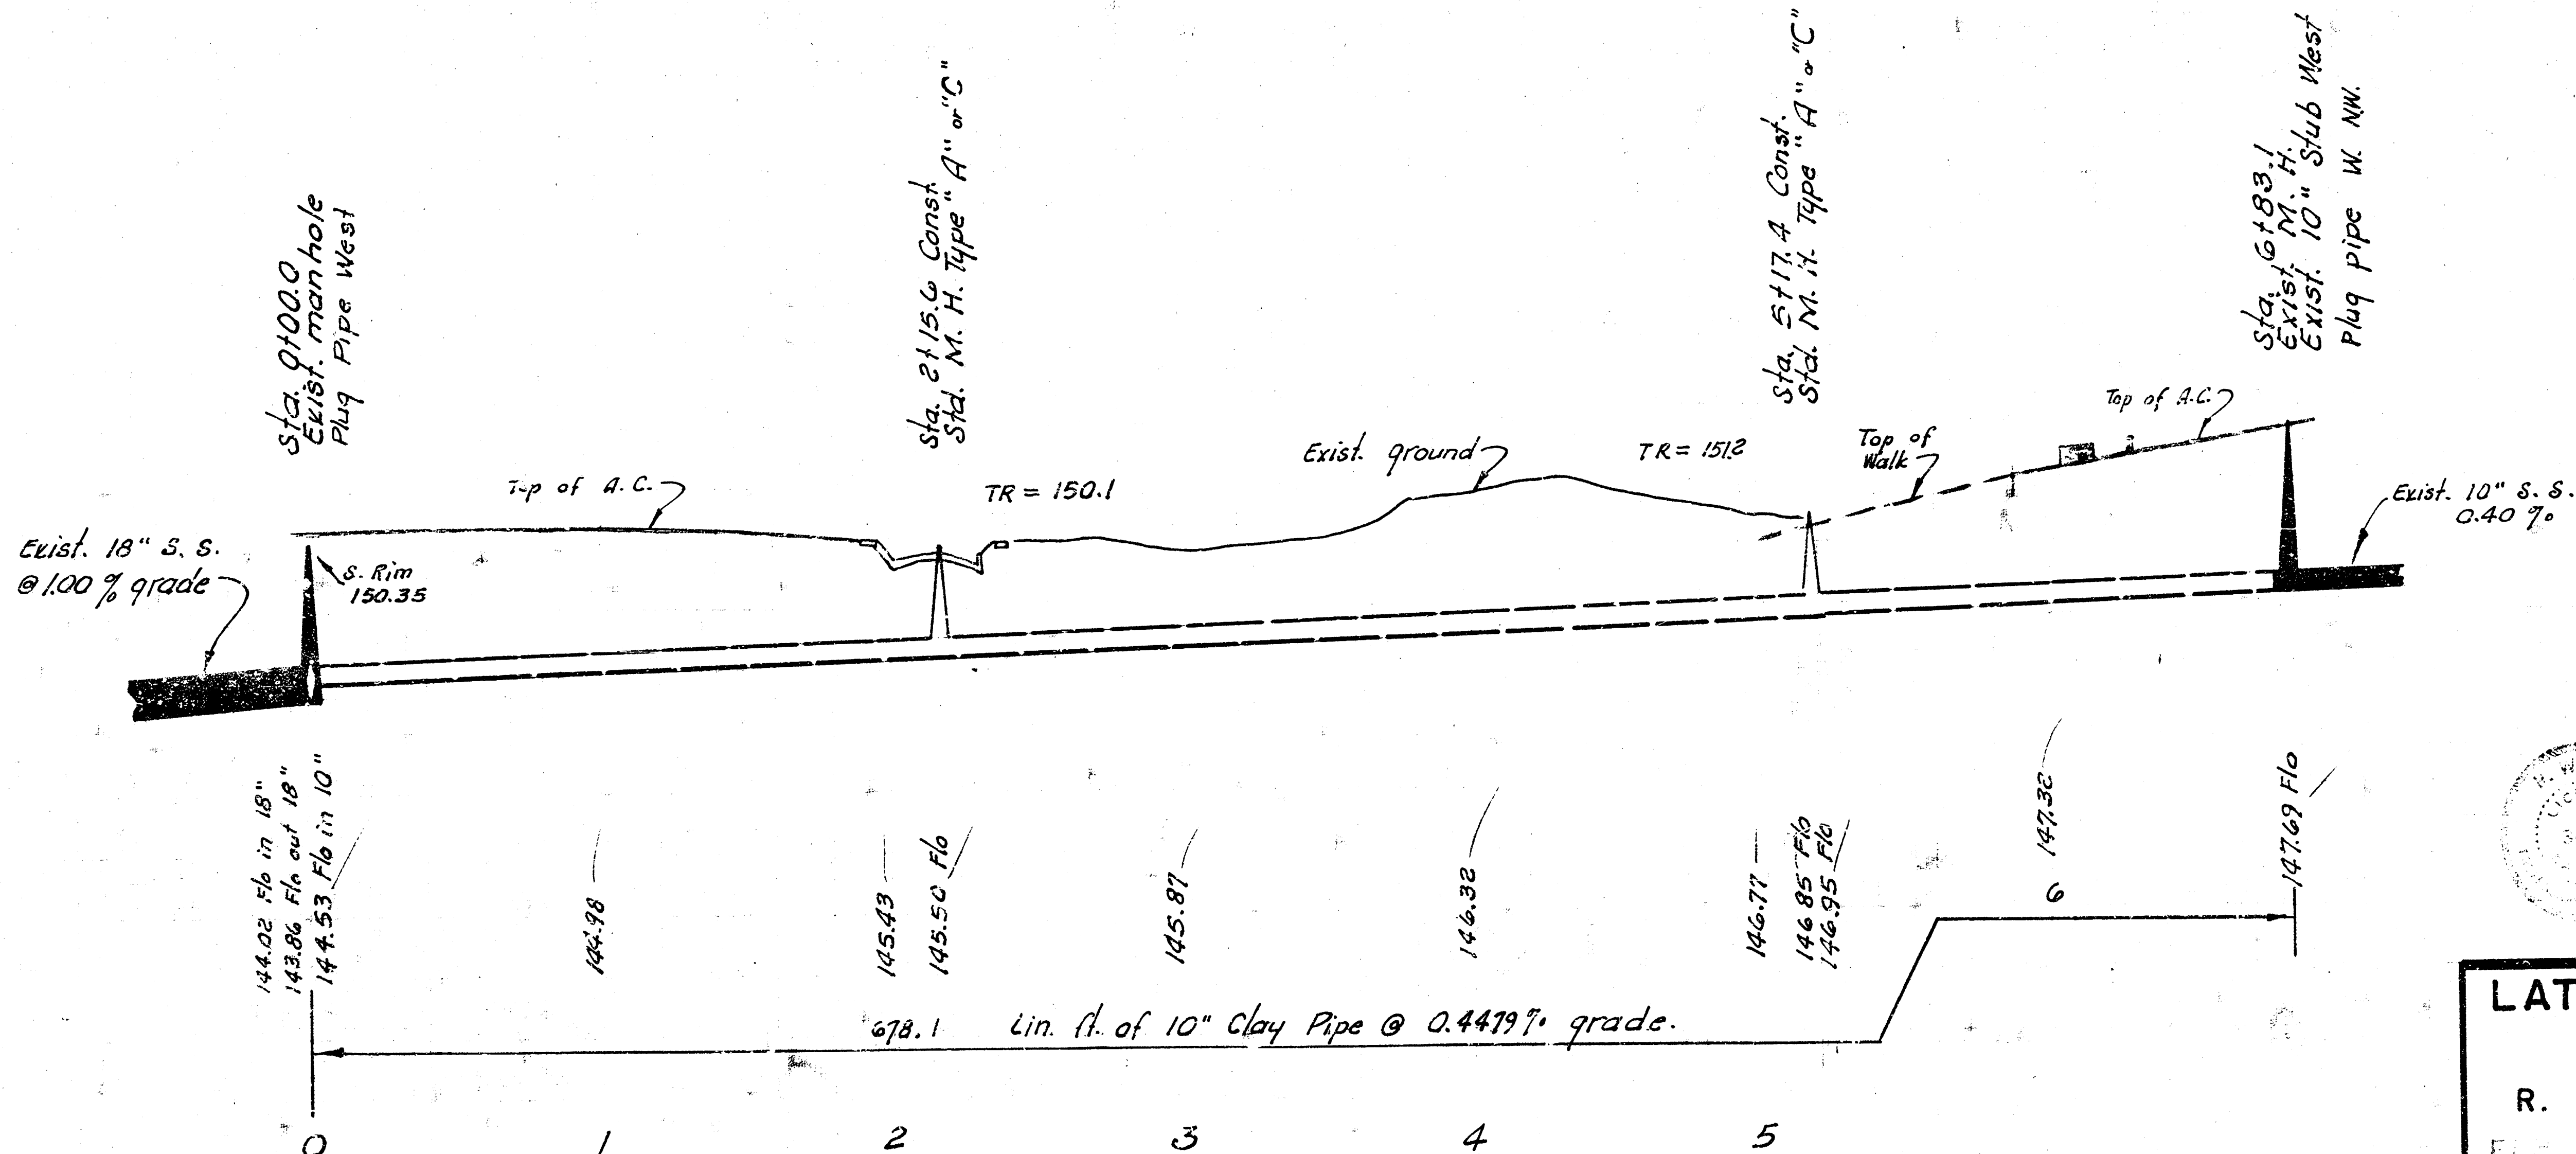

As Built 10-15-75
LAT. 2, WESLEY INTERCEPTER SEWER
 CITY OF WICHITA, KANSAS
 R. W. LINN — CITY ENGINEER
 1975 PROJECT NO. DBKL 5740 82