


DATE	
BY	
CHECKED	
APPROVED	
NO.	

DATE	
BY	
CHECKED	
APPROVED	
NO.	

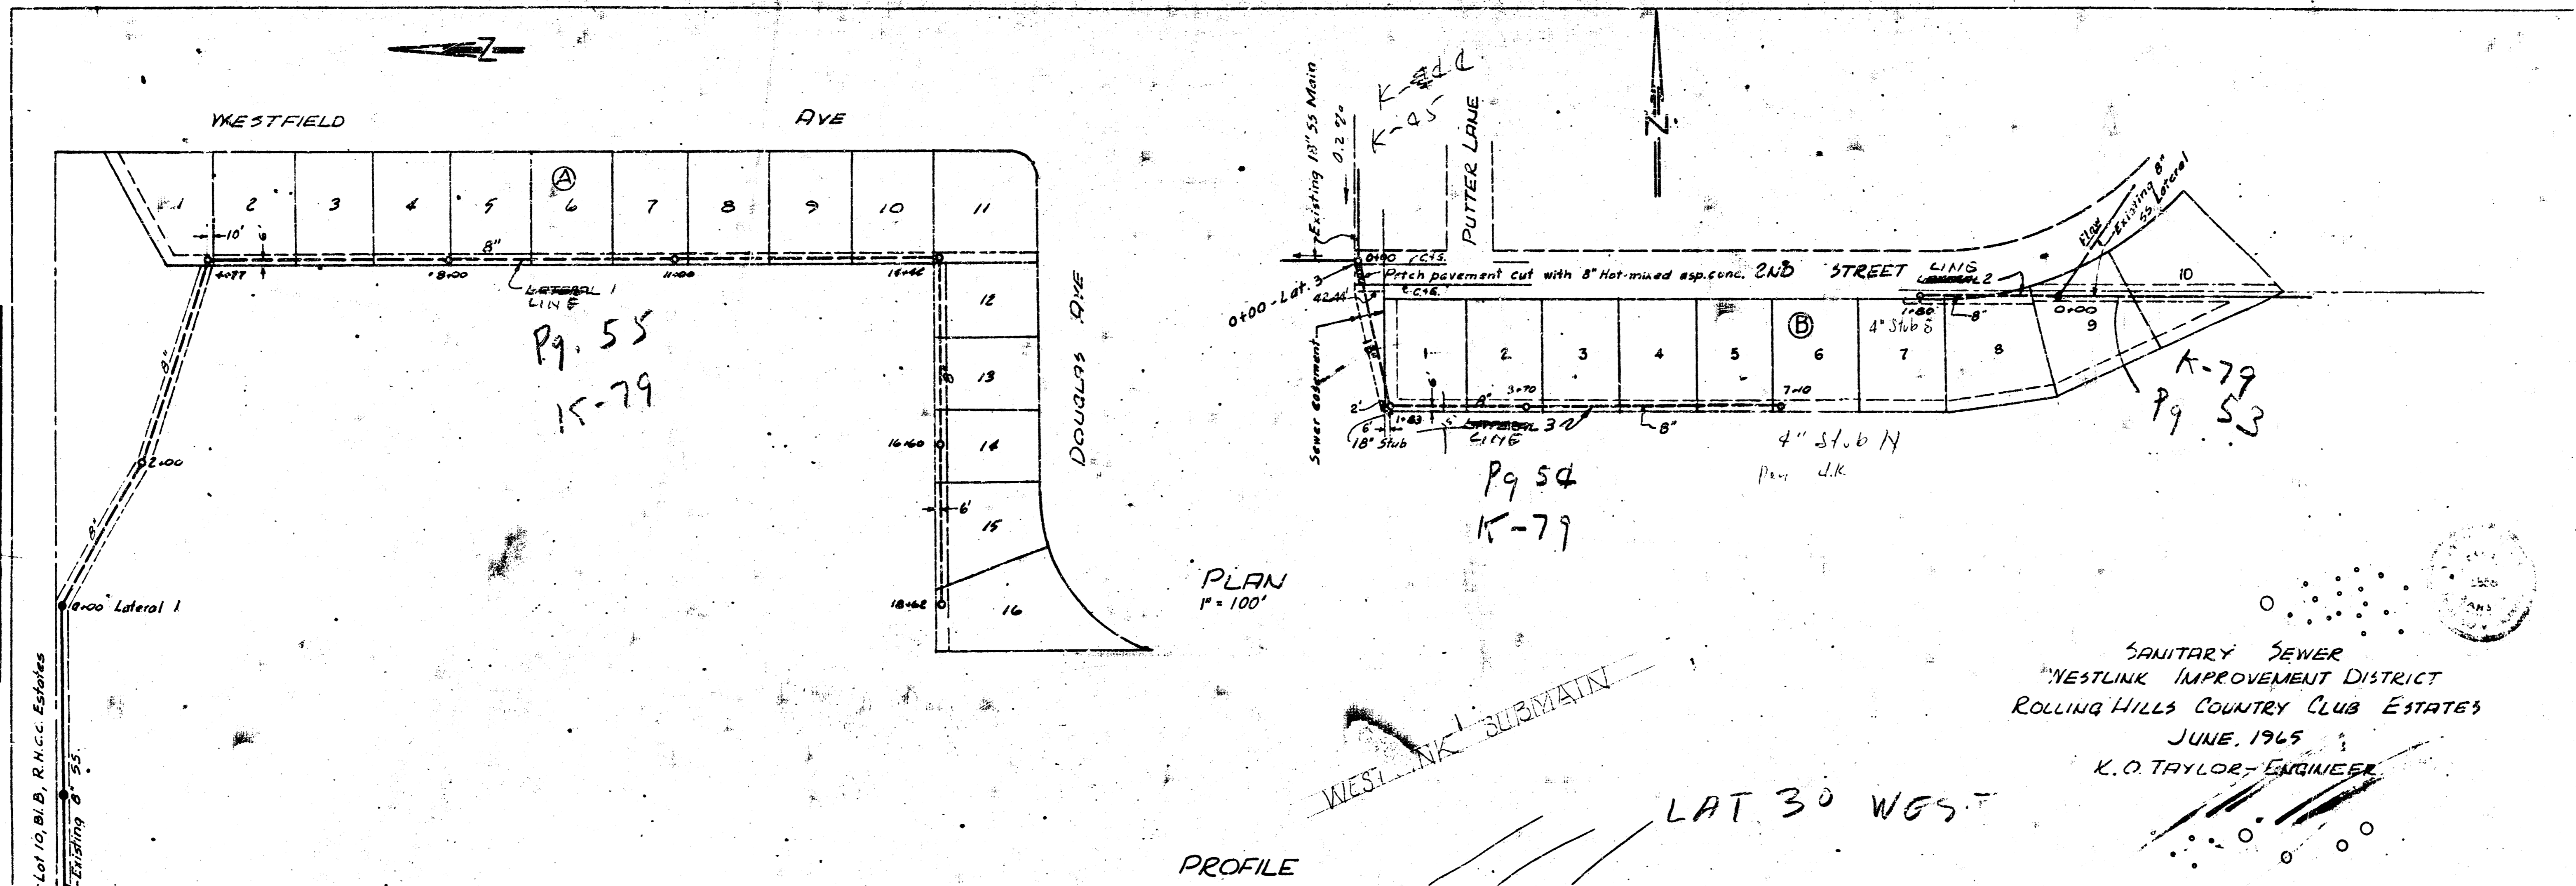

PROFILE

WEST WINK SUBMAIN
LAT 30 WEST

SANITARY SEWER
WESTLINK IMPROVEMENT DISTRICT
ROLLING HILLS COUNTRY CLUB ESTATES
JUNE, 1965
K.O. TAYLOR, ENGINEER

