

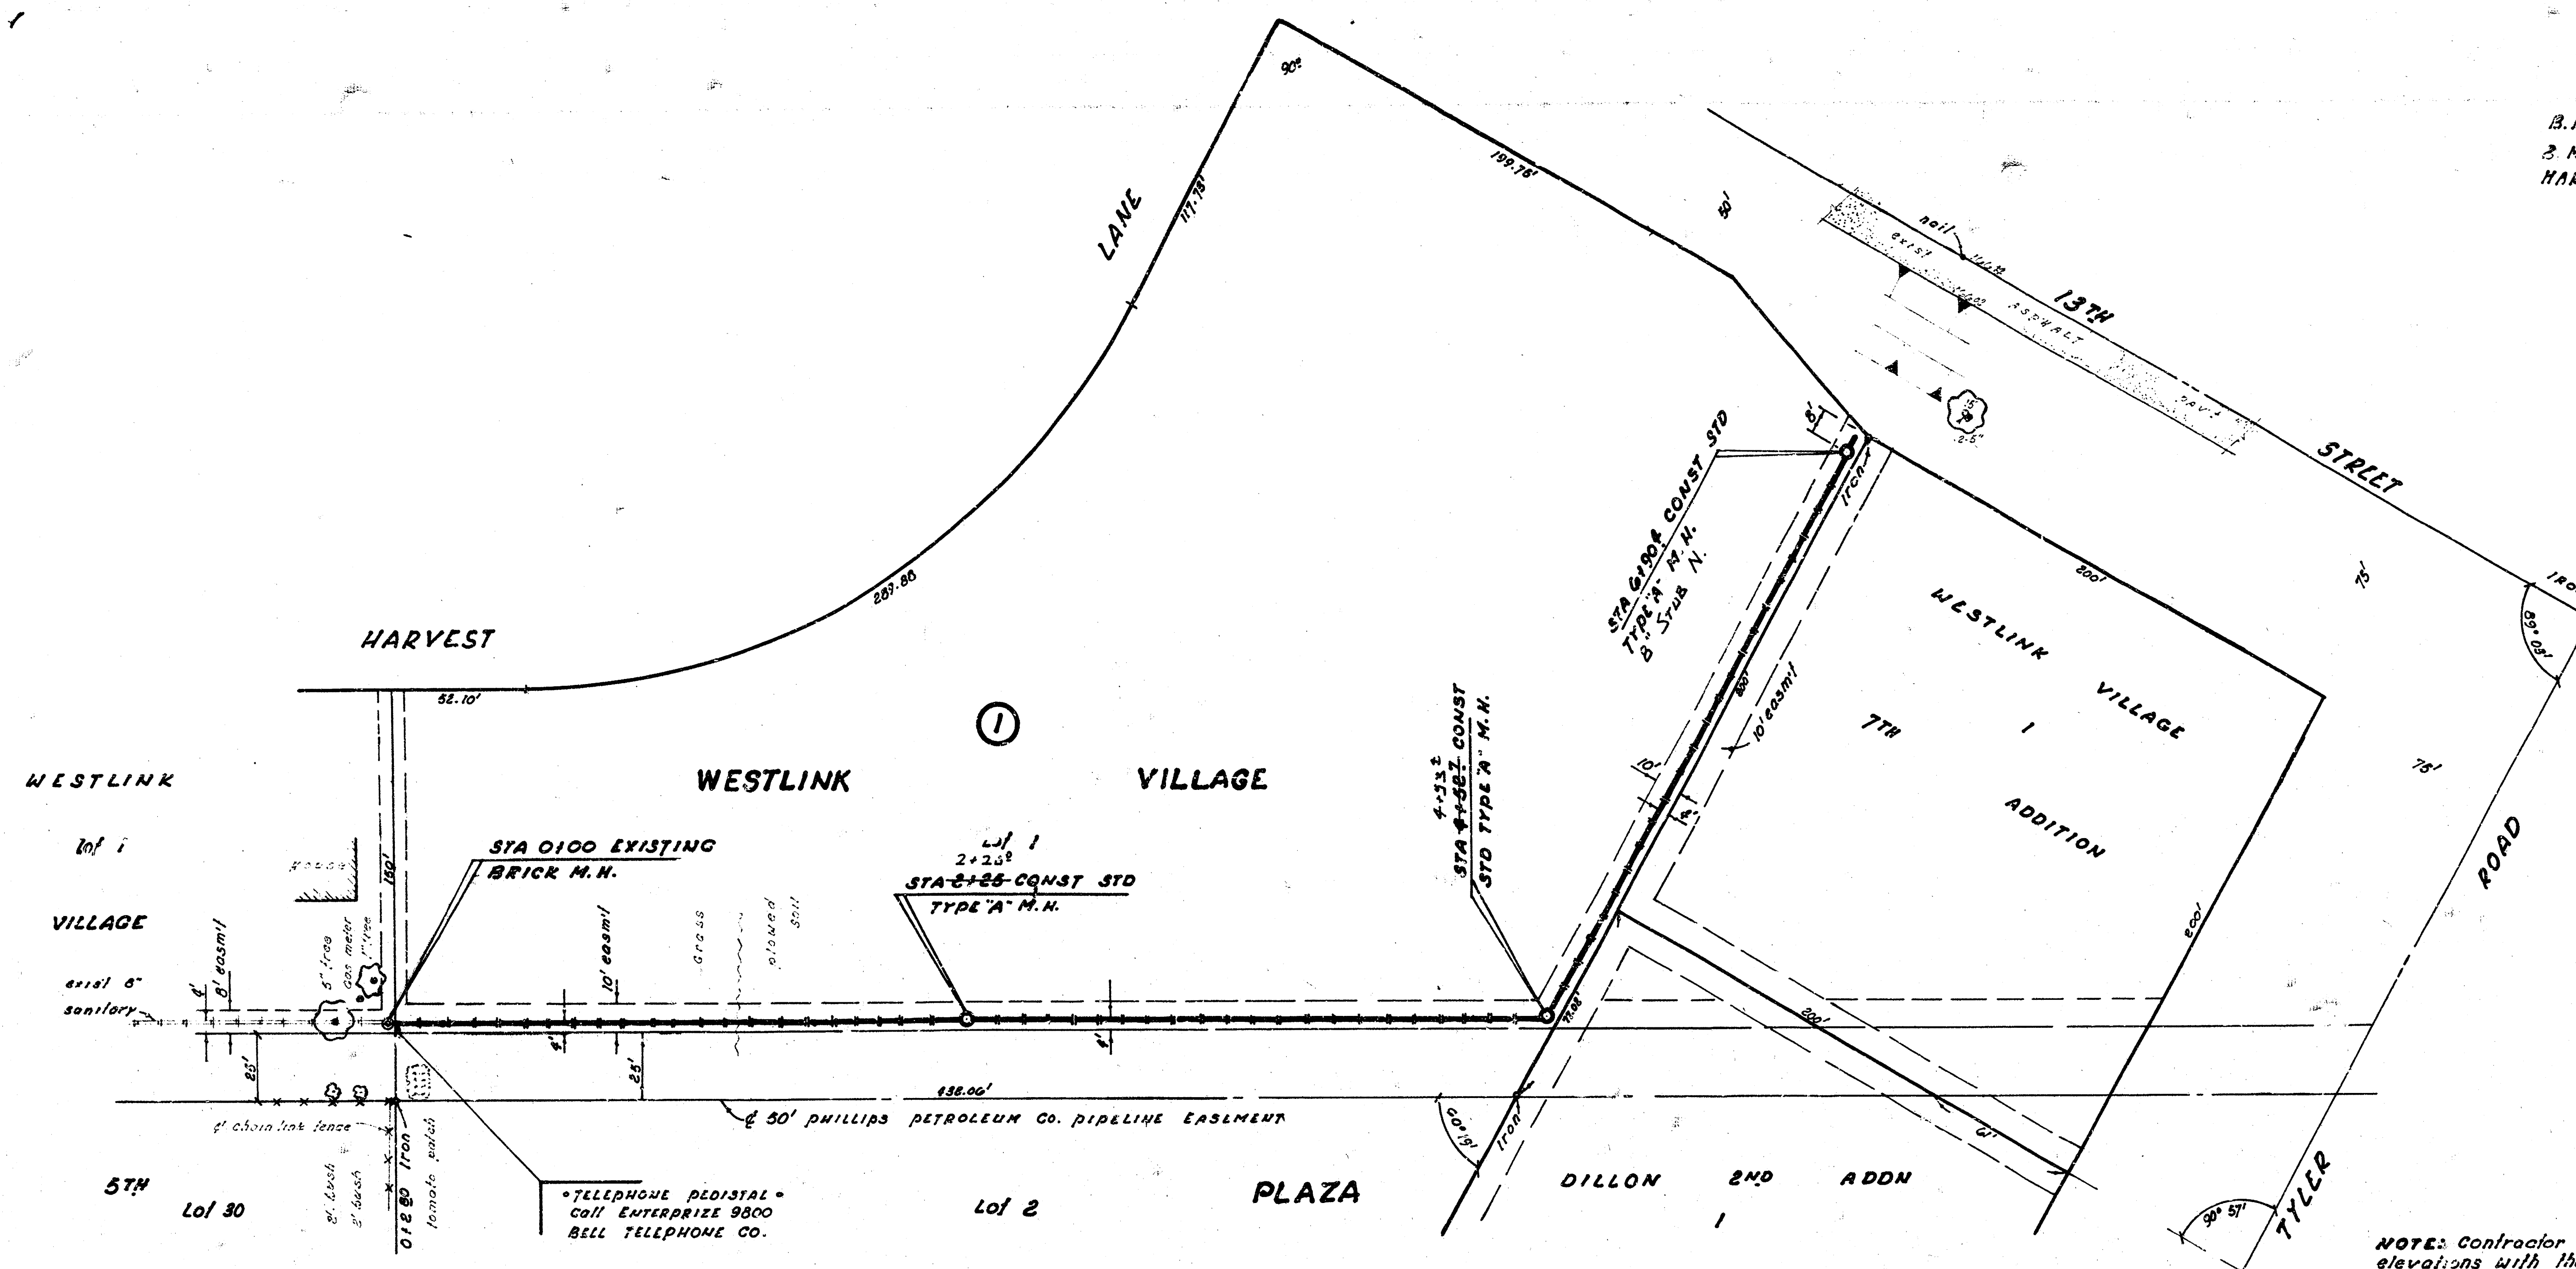
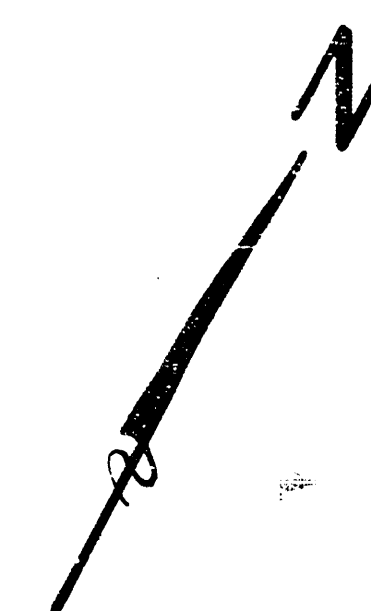


B.M. 16787 STANDARD N.E. TYLER ROAD & 13TH STREET.
 3 M. 16005 "X" IN MID KANSAS. 41' CONC DRIVE NORTH, N.E. COR
 HARVEST LANE & HARVEST CT. Opposite House #8991 HARVEST LN.

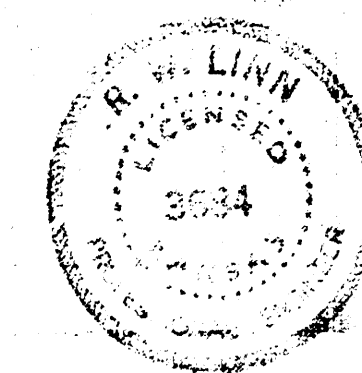

PLAN SCALE 1" = 40'
 PROFILE 1" = 5' VERT
 1" = 80' HORIZ.

NOTE: Contractor is to verify top of manhole elevations with the developer.

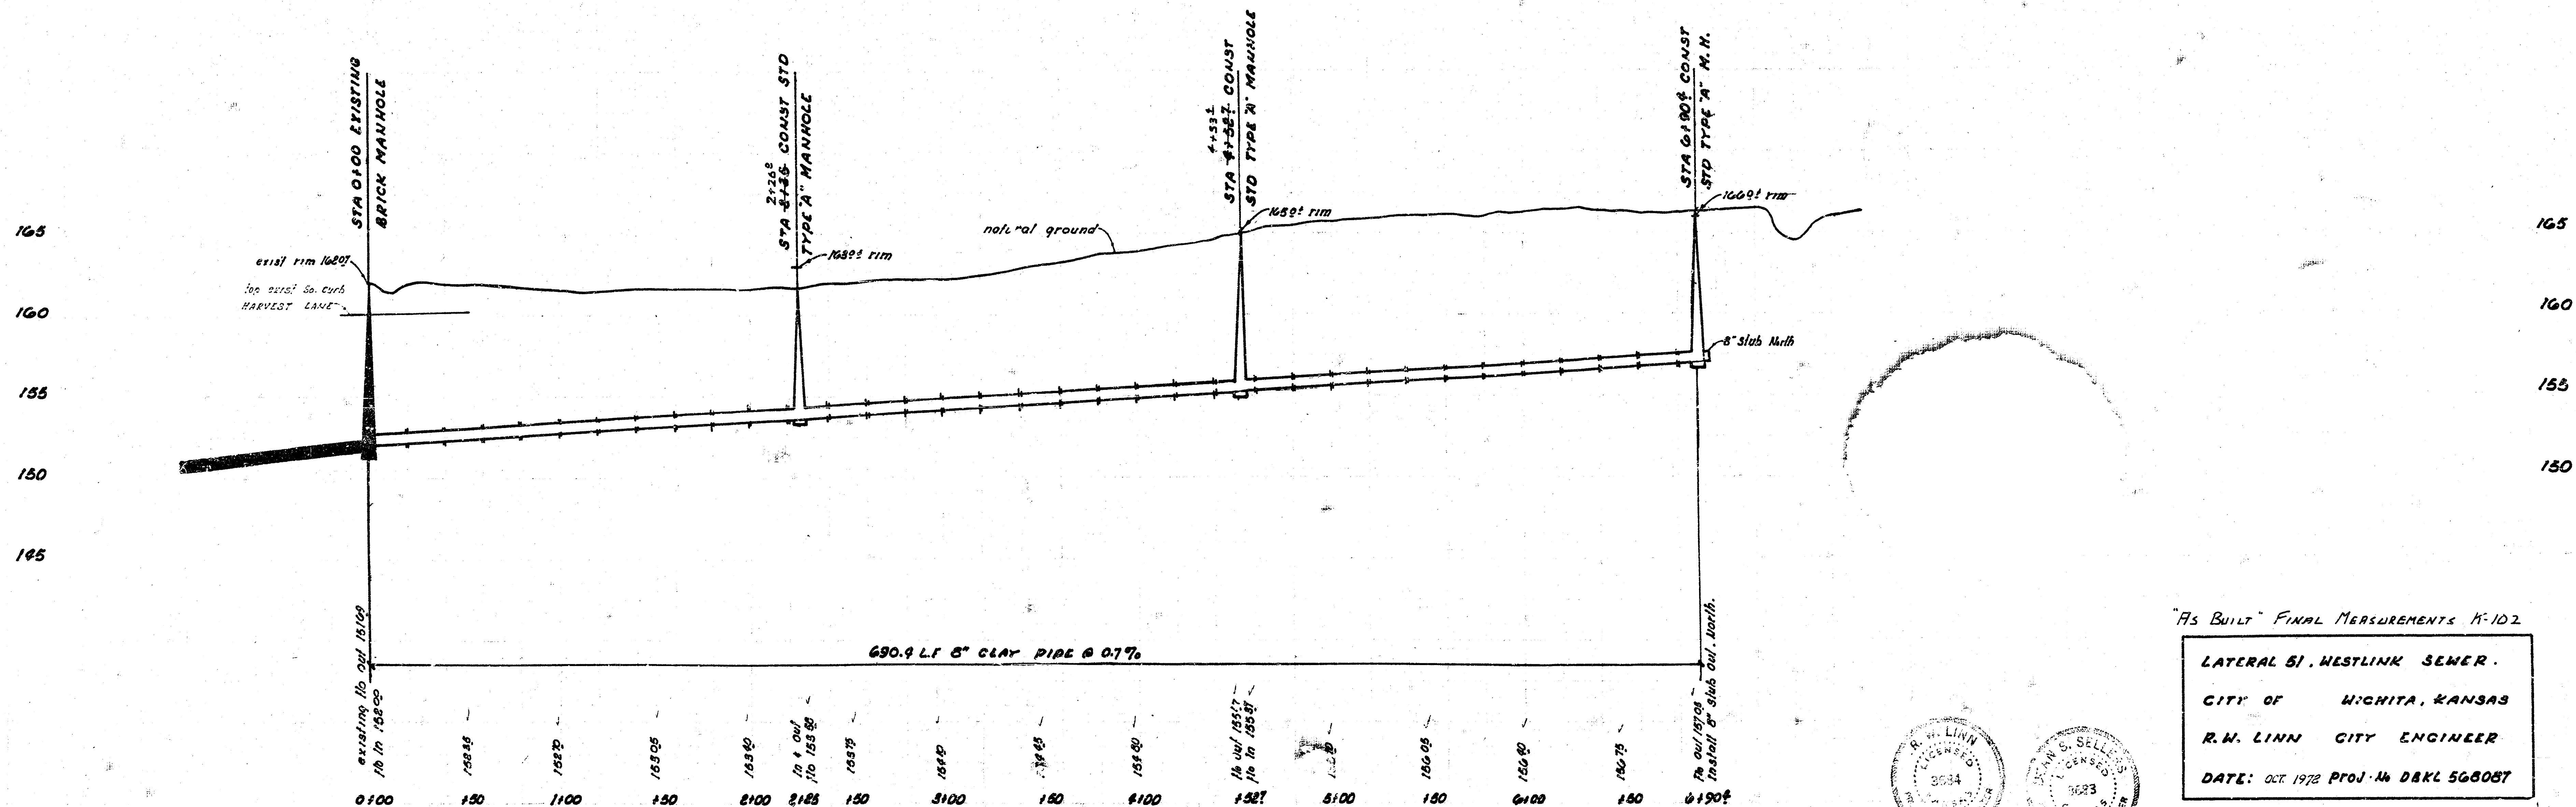

"As Built" Final Measurements N-102

LATERAL 51, WESTLINK SEWER.
 CITY OF WICHITA, KANSAS
 R.W. LINN CITY ENGINEER
 DATE: OCT. 1972 PROJ. No. DKL 568087

FIL MED FROM THE BEST