


B.M. 16797 STANDARD N.E. CORNER 13TH STREET AND TYLER ROAD.
B.M. 16095 "K" IN MID KANSAS QTR 1' CONC WALK N. North East Cor HARVEST COURT
and HARVEST LAKE opposite 1/4 391 HARVEST LAKE.

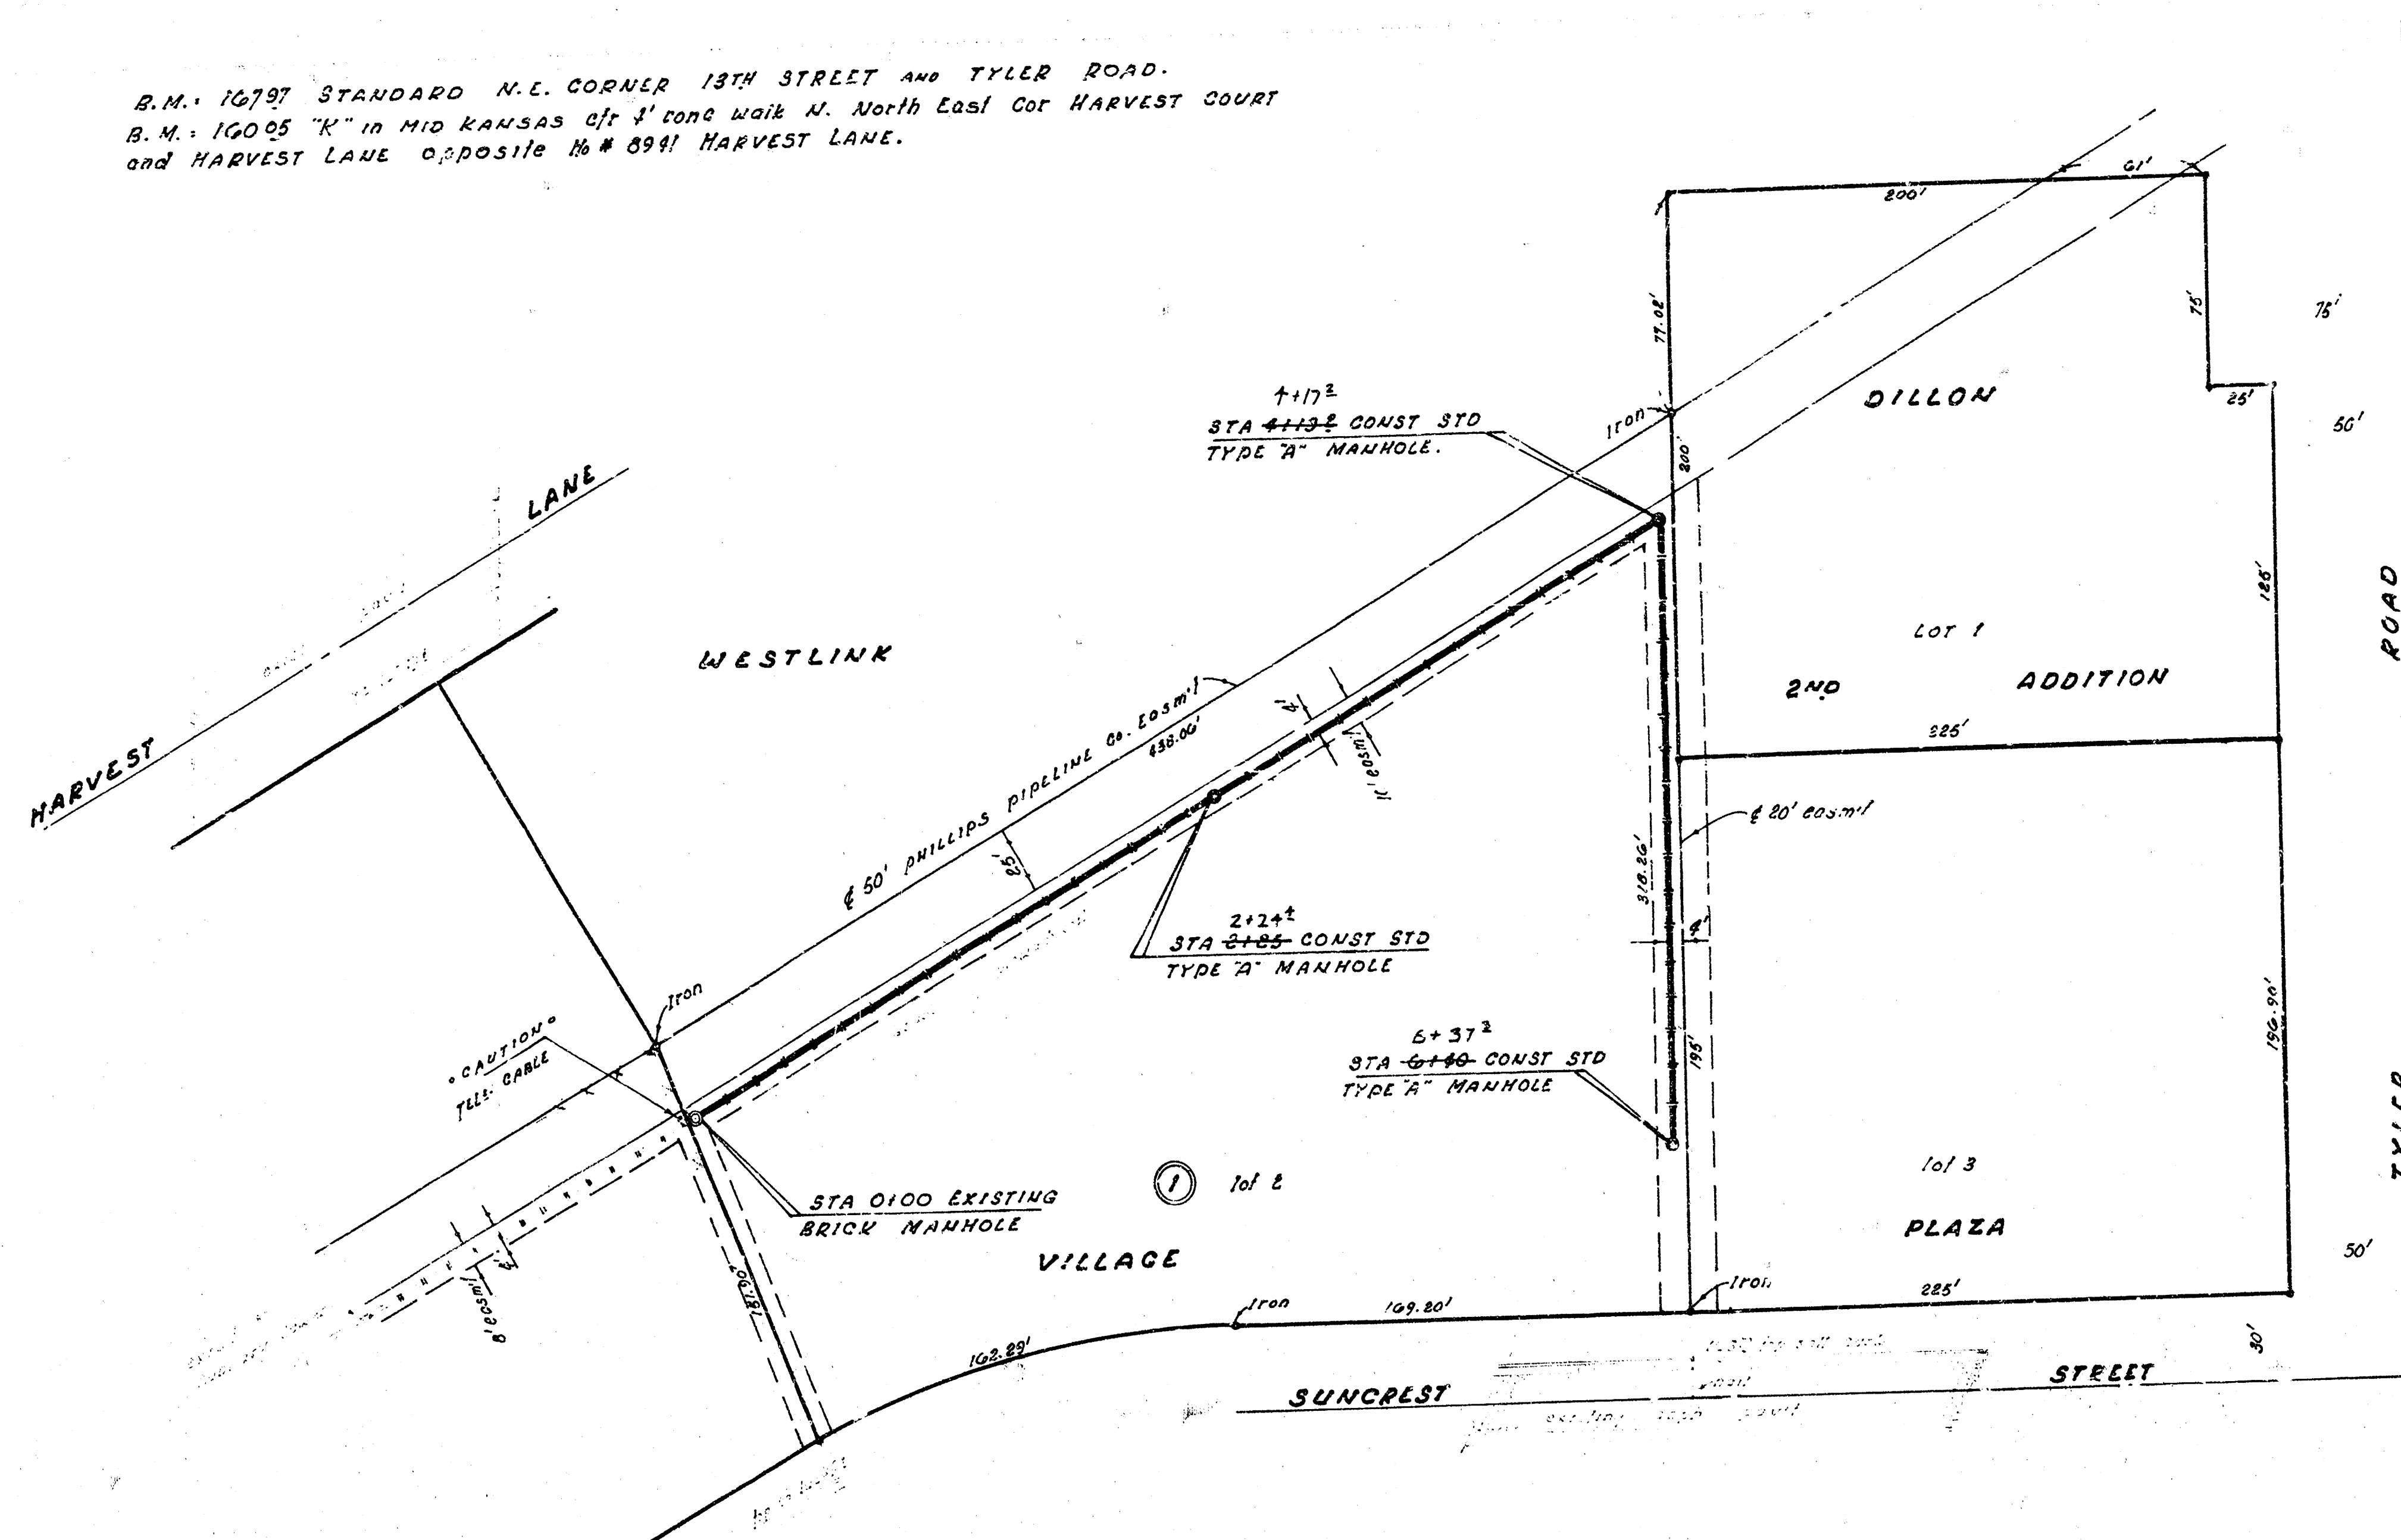


NOTE: Contractor is to verify top of manhole elevations with developer.

PLAN SCALE 1"=50'
PROFILE 1"=5' VERT
1"=90' HORIZ



165
160
155
150

165
160
155
150

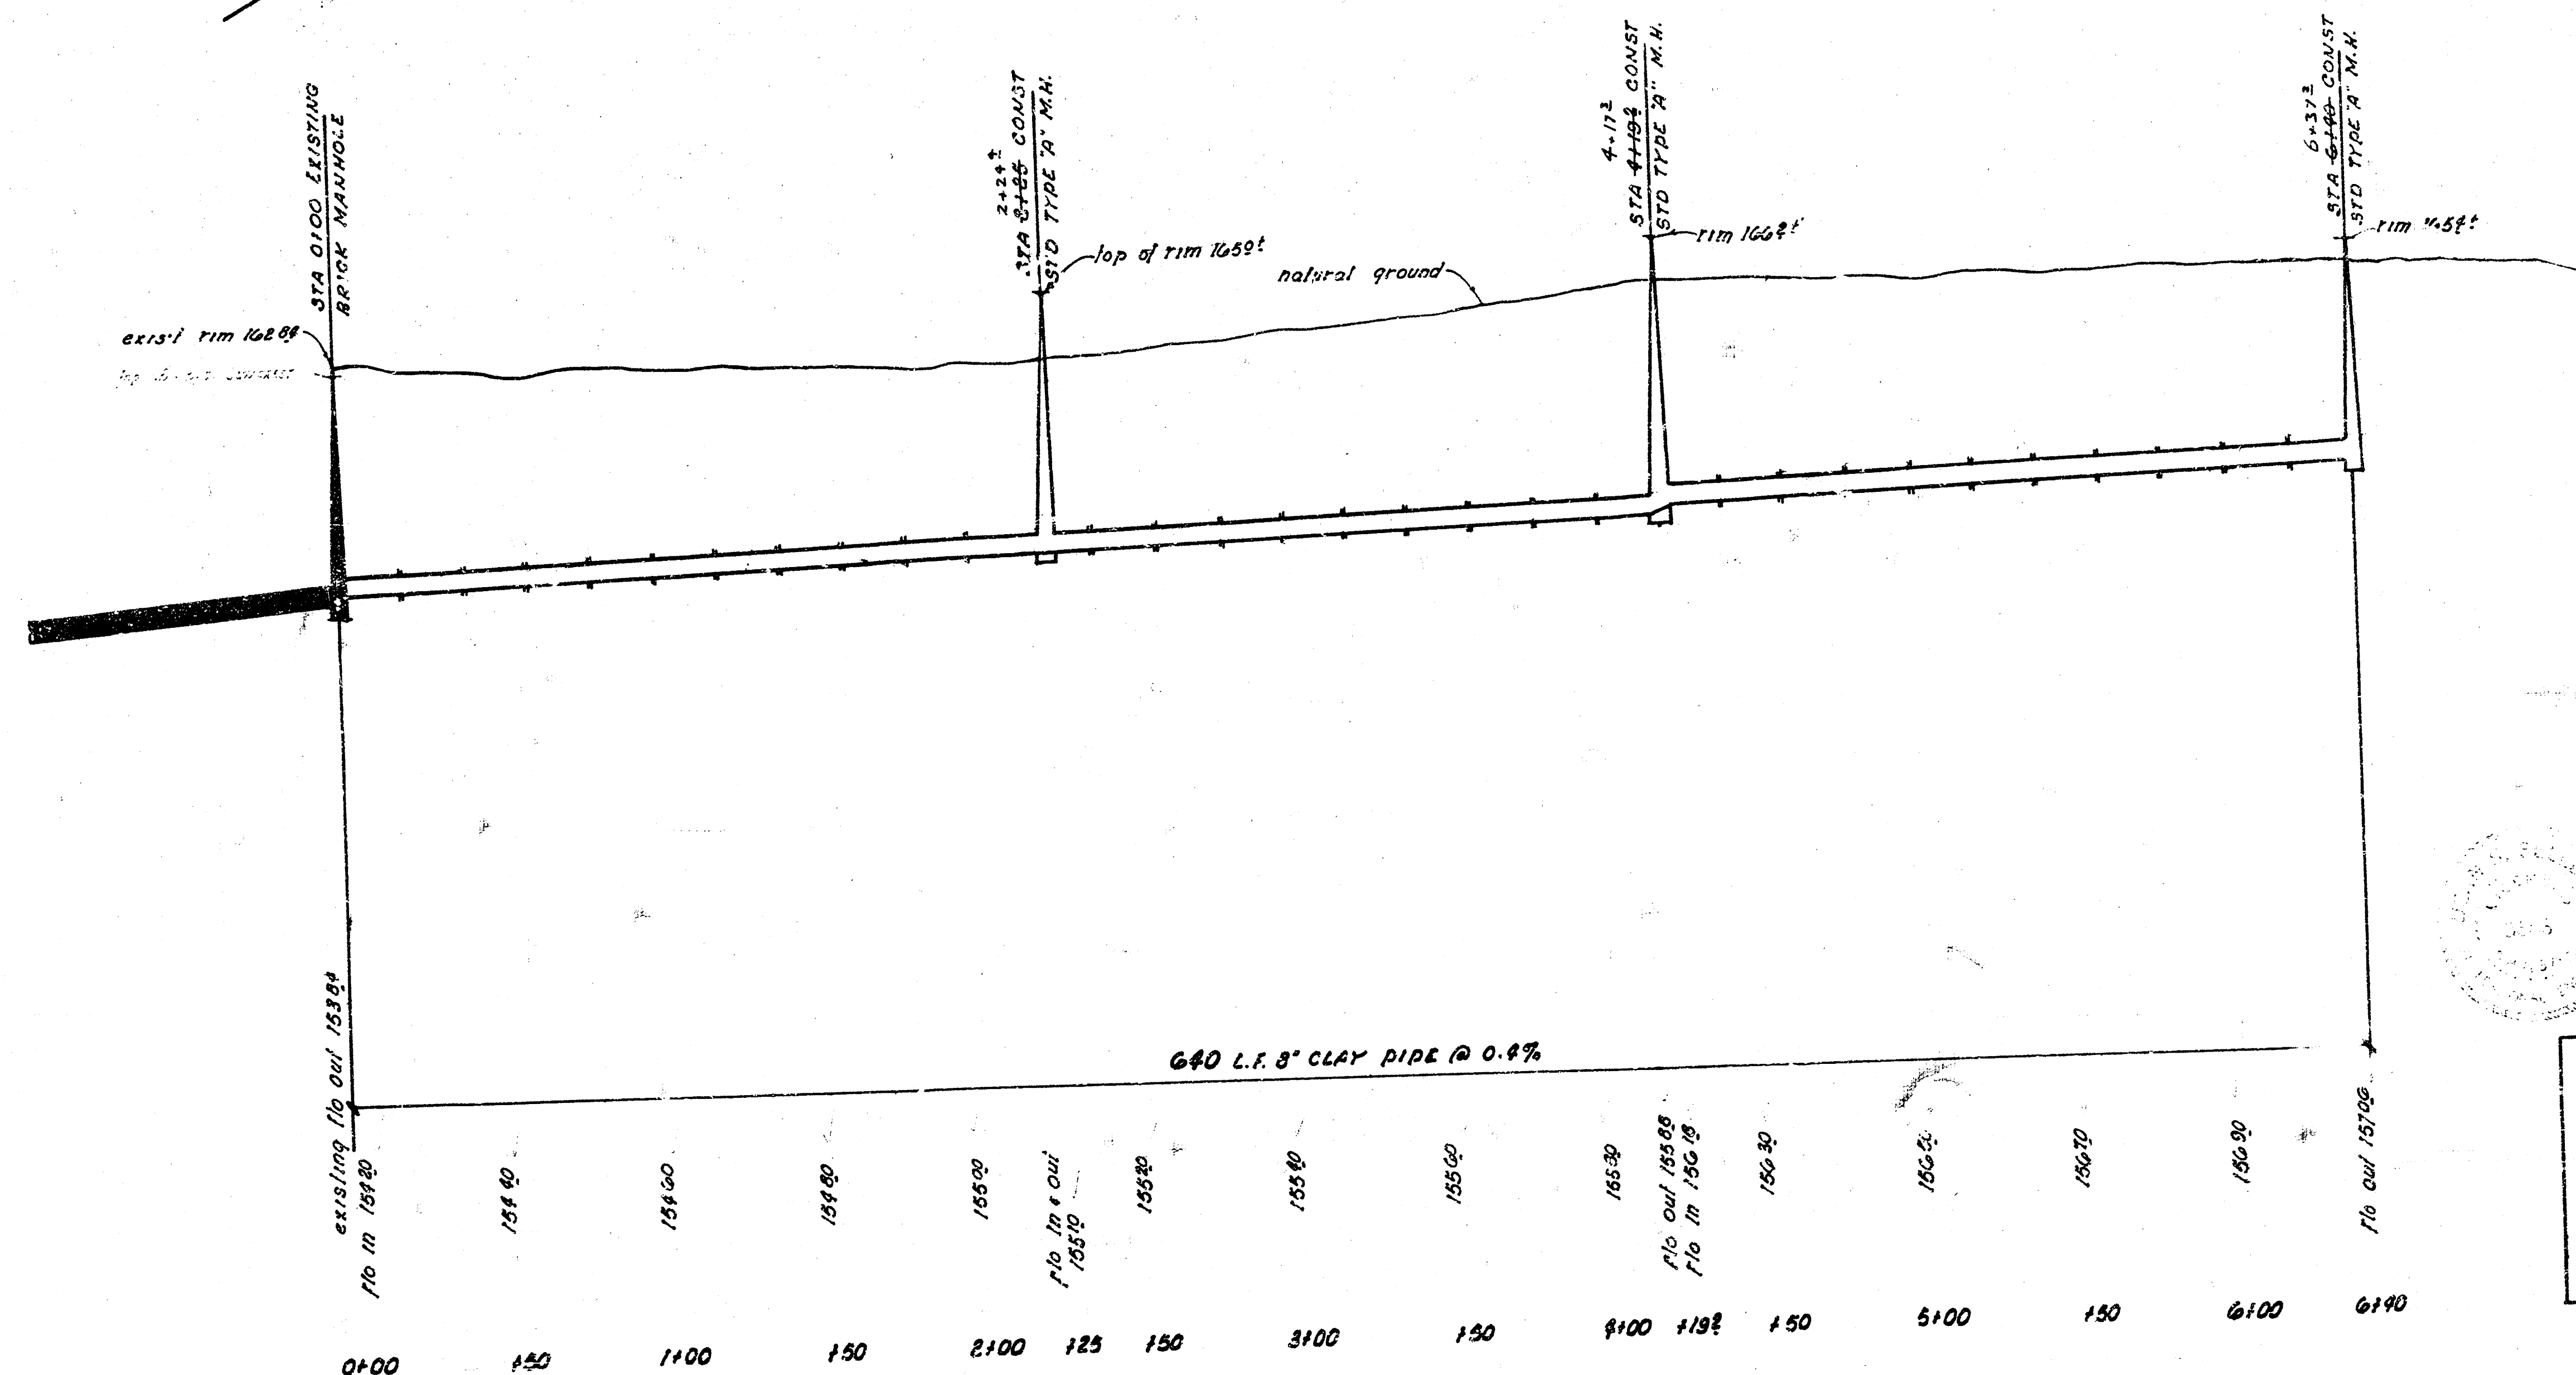

As BUILT FINAL
MEASUREMENTS K-102

LATERAL 52, WESTLINK SEWER
CITY OF WICHITA, KANSAS
R.W. LINN CITY ENGINEER
DATE OCT. 1972 PROJ. NO. DBKL 563069