



B.M. 132.19 City Std. School Street & Ridge Road, 49.0' W. & 34.0' S. of E. both.
B.M. 130.00 11' on top N. - cb. School Street at E.L. Sandplum.

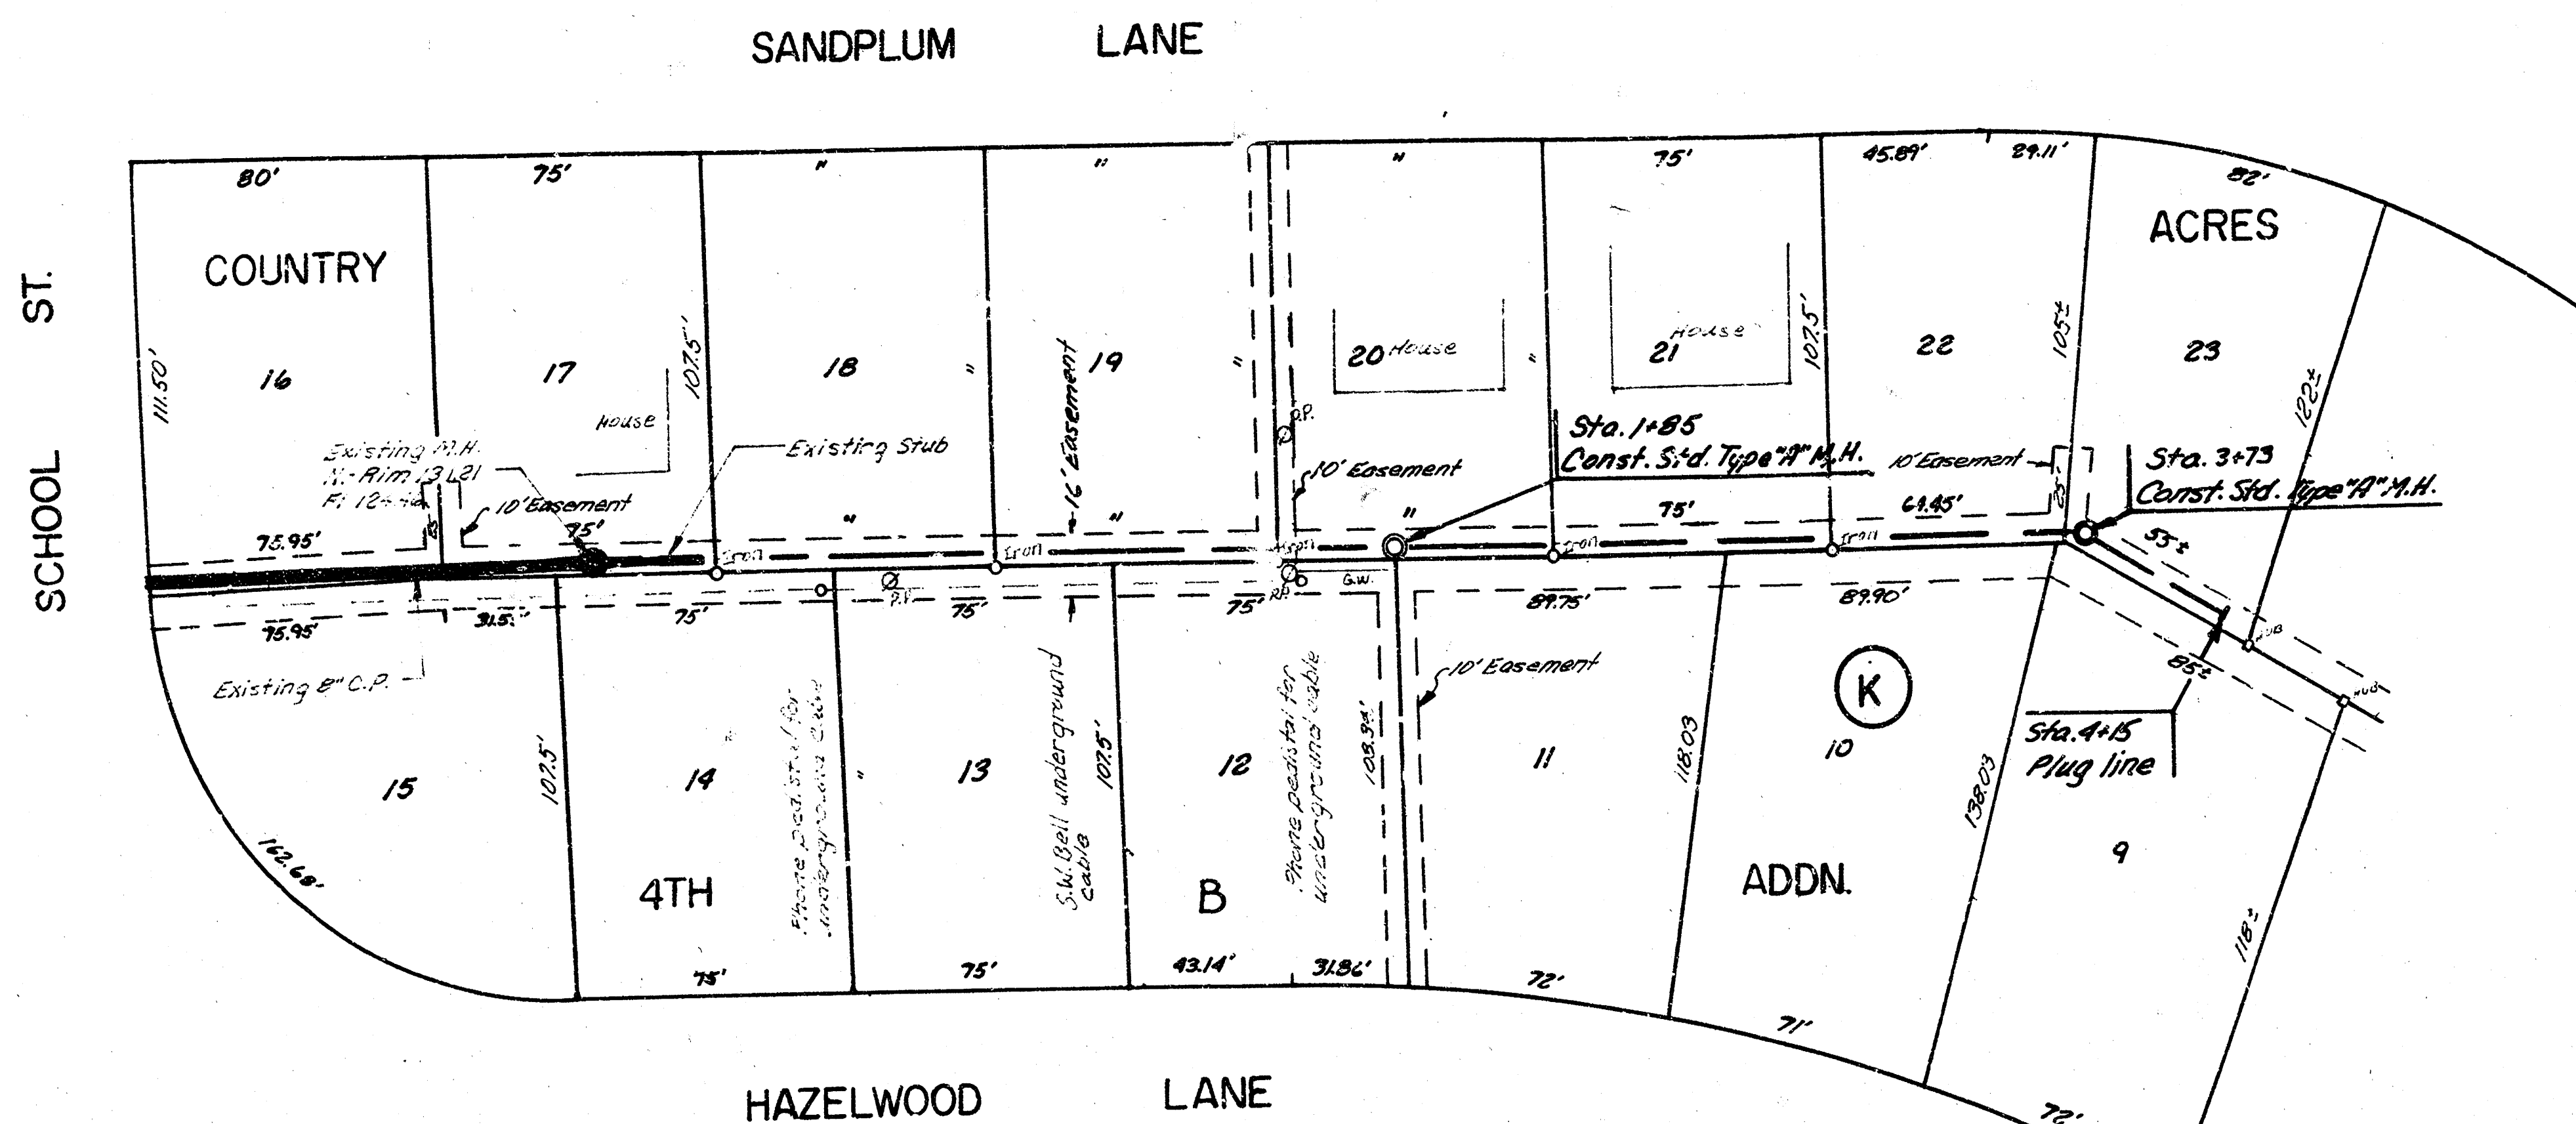


Note: Contractor shall excavate around stub so Engineer can check stub's flow elevation.

Note: Manhole at Sta. 1+85 shall be constructed to a minimum elevation of 131.4. Manhole at Sta. 3+73 shall be constructed to a minimum elevation of 132.2. For exact elevations of these manholes, contractor shall contact the developer of the land.

CAUTION
UNDERGROUND UTILITIES
Please check with K G & E or Southwestern Bell Telephone Co. for Location

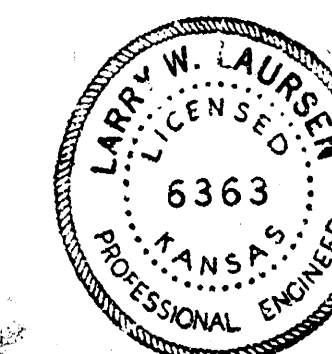

Plan Scale 1" = 40'
Profile Scale 1" = 40'
Profile Scale Van 1" = 5'

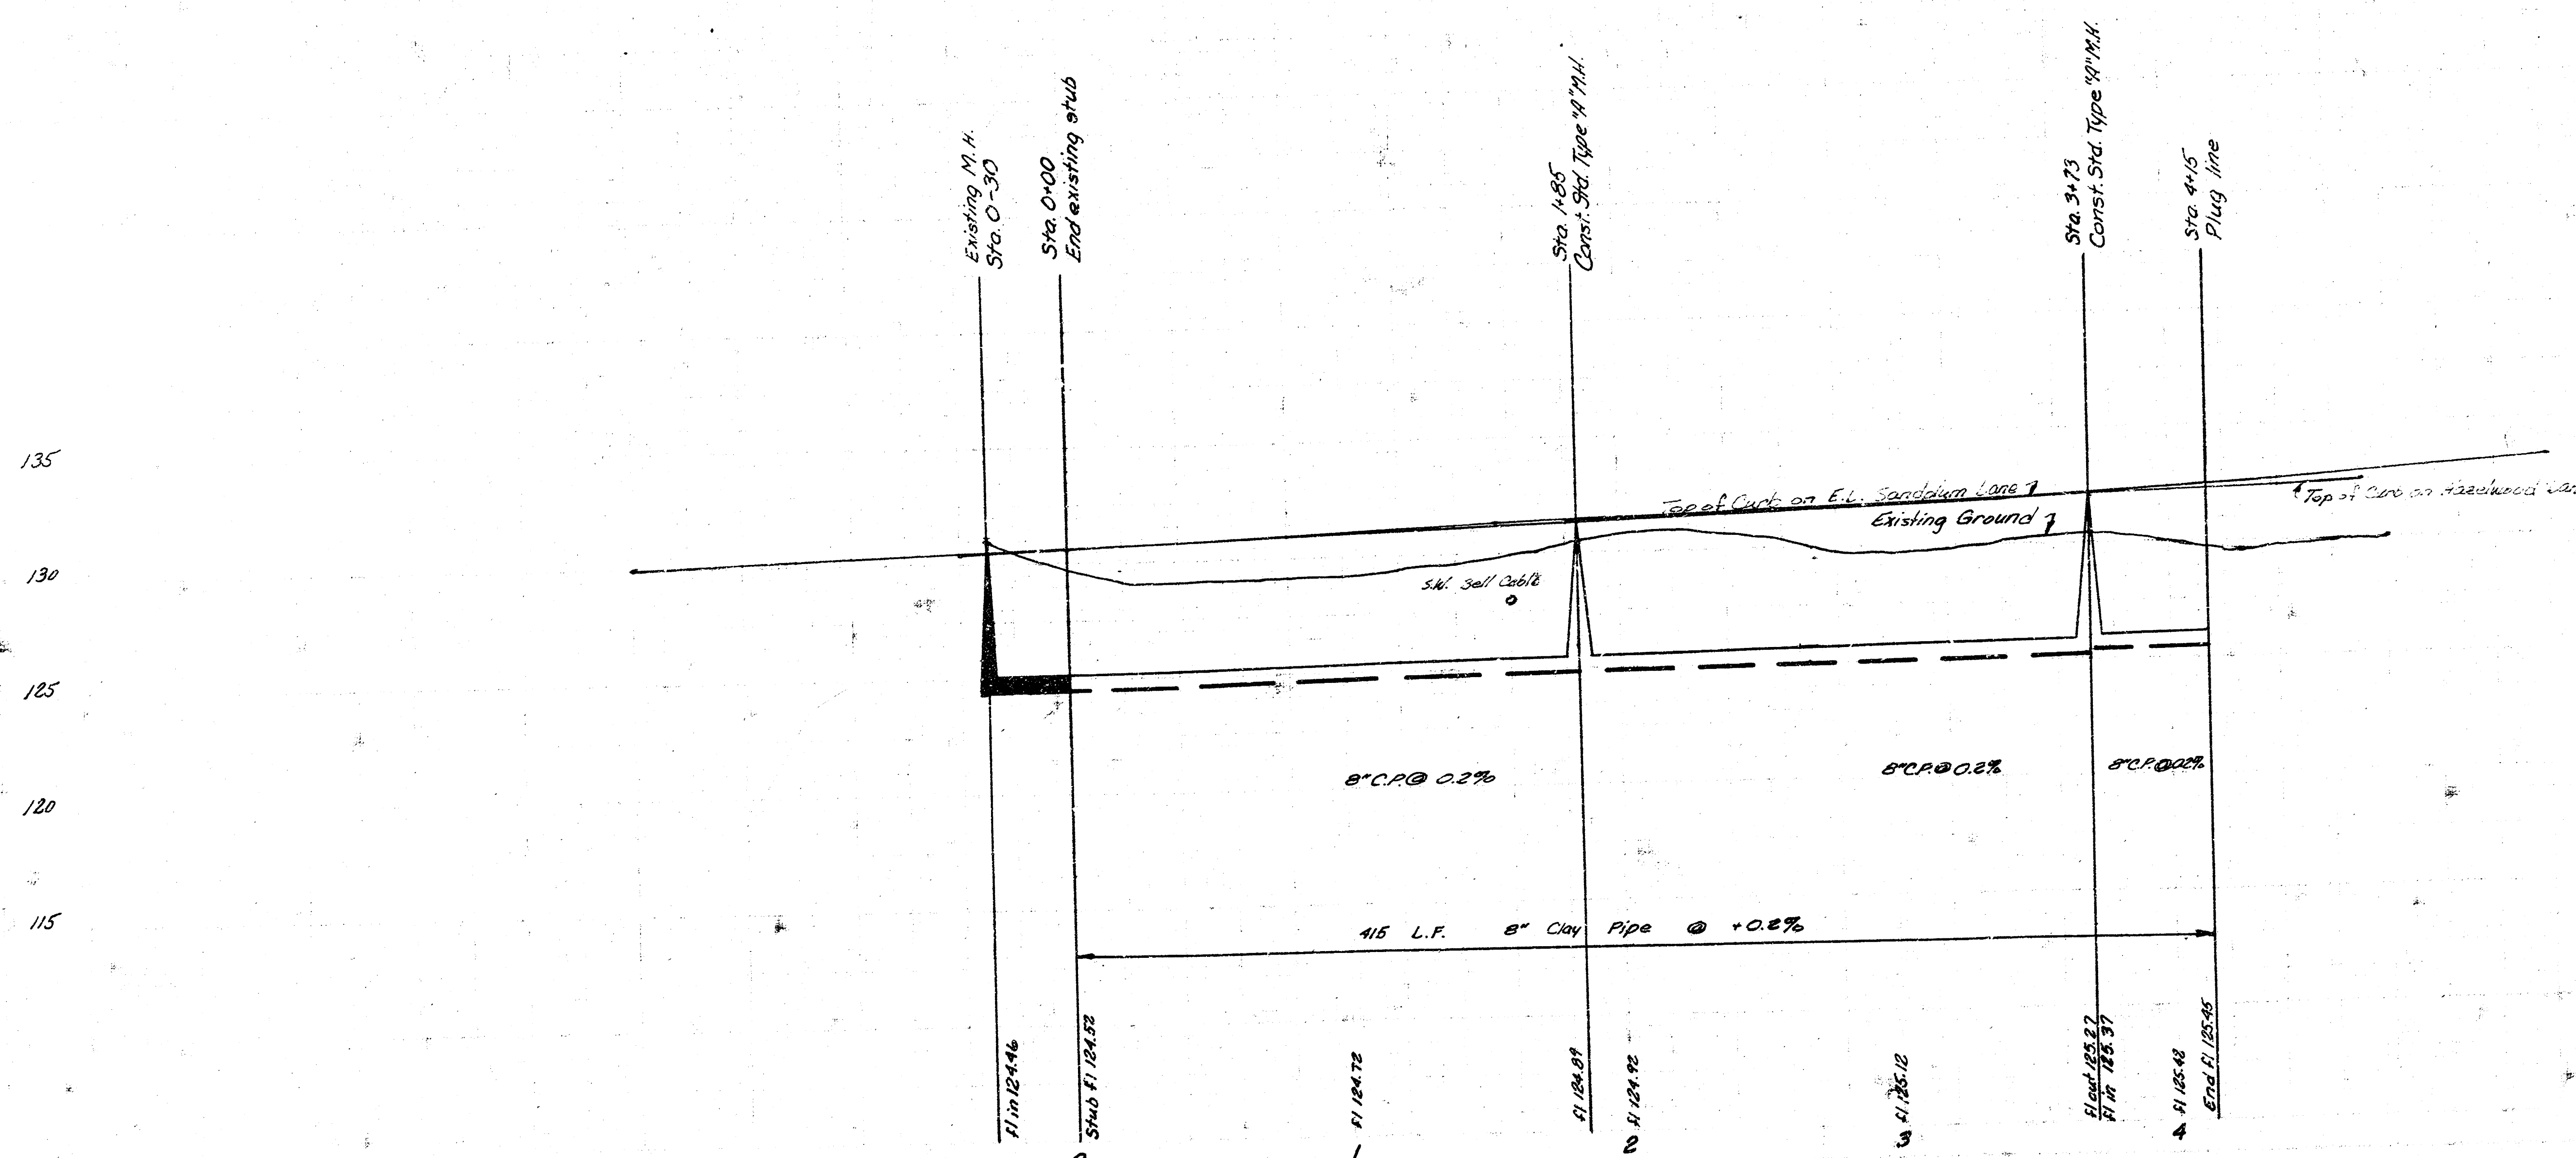

As Built
Aug 12

LAT. 54 WESTLINK SEWER
R.W. LINN CITY ENGINEER
CITY OF WICHITA, KS.
PR. NO. DBKL572026 DATE 7-72

FILMED FROM THE BEST AVAILABLE COPY