
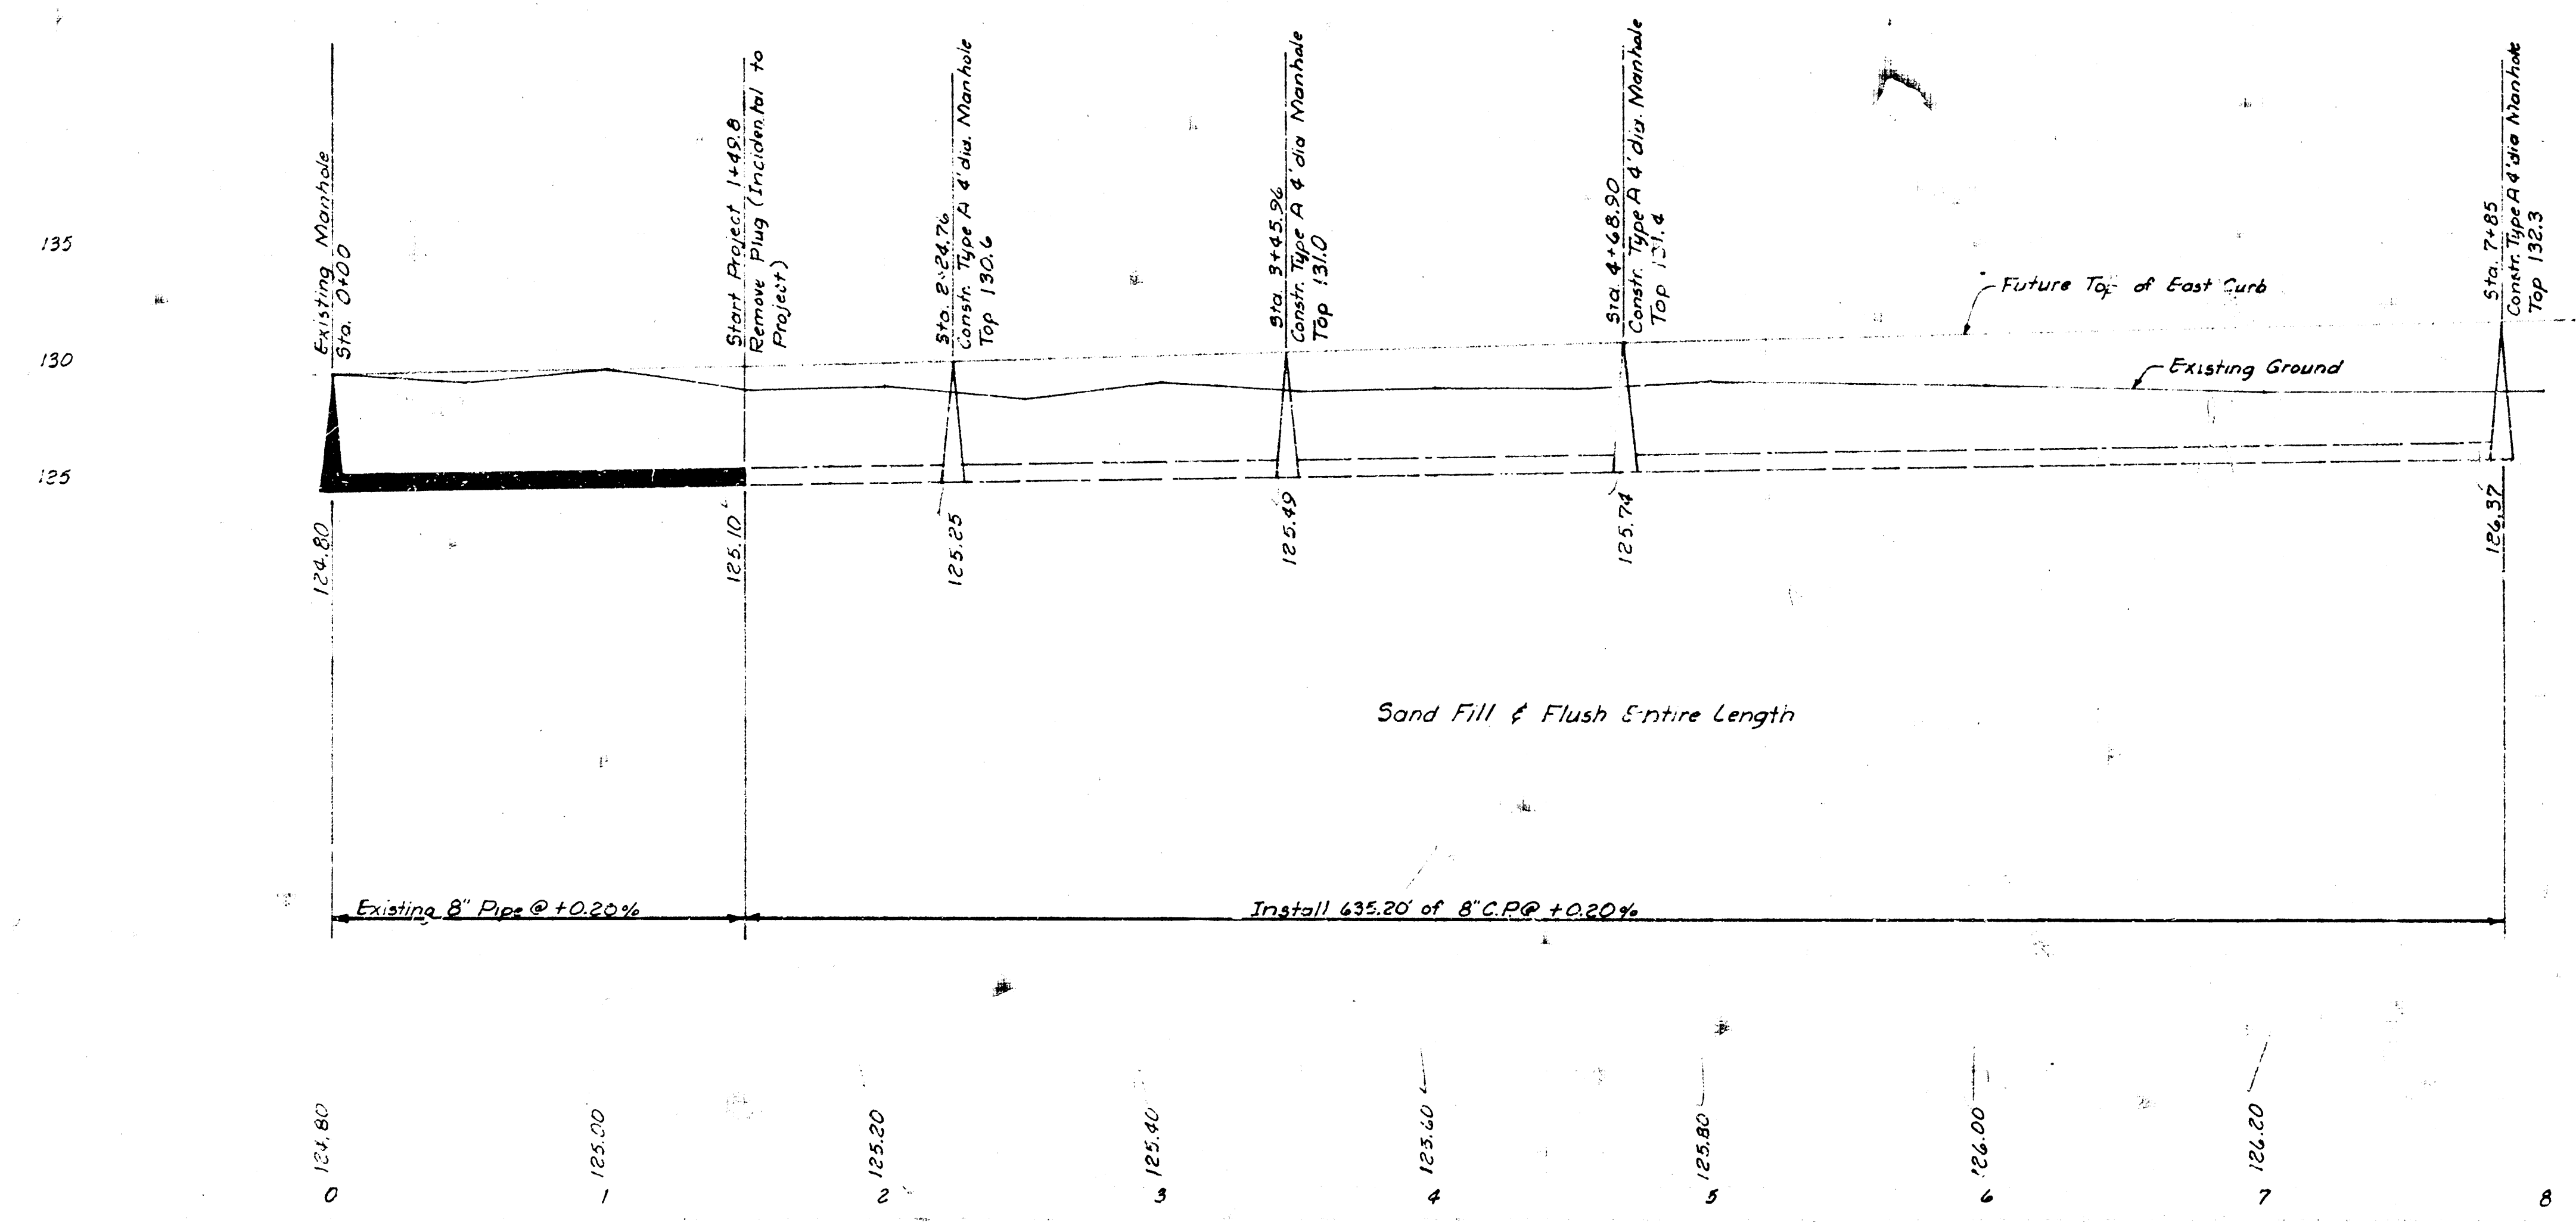


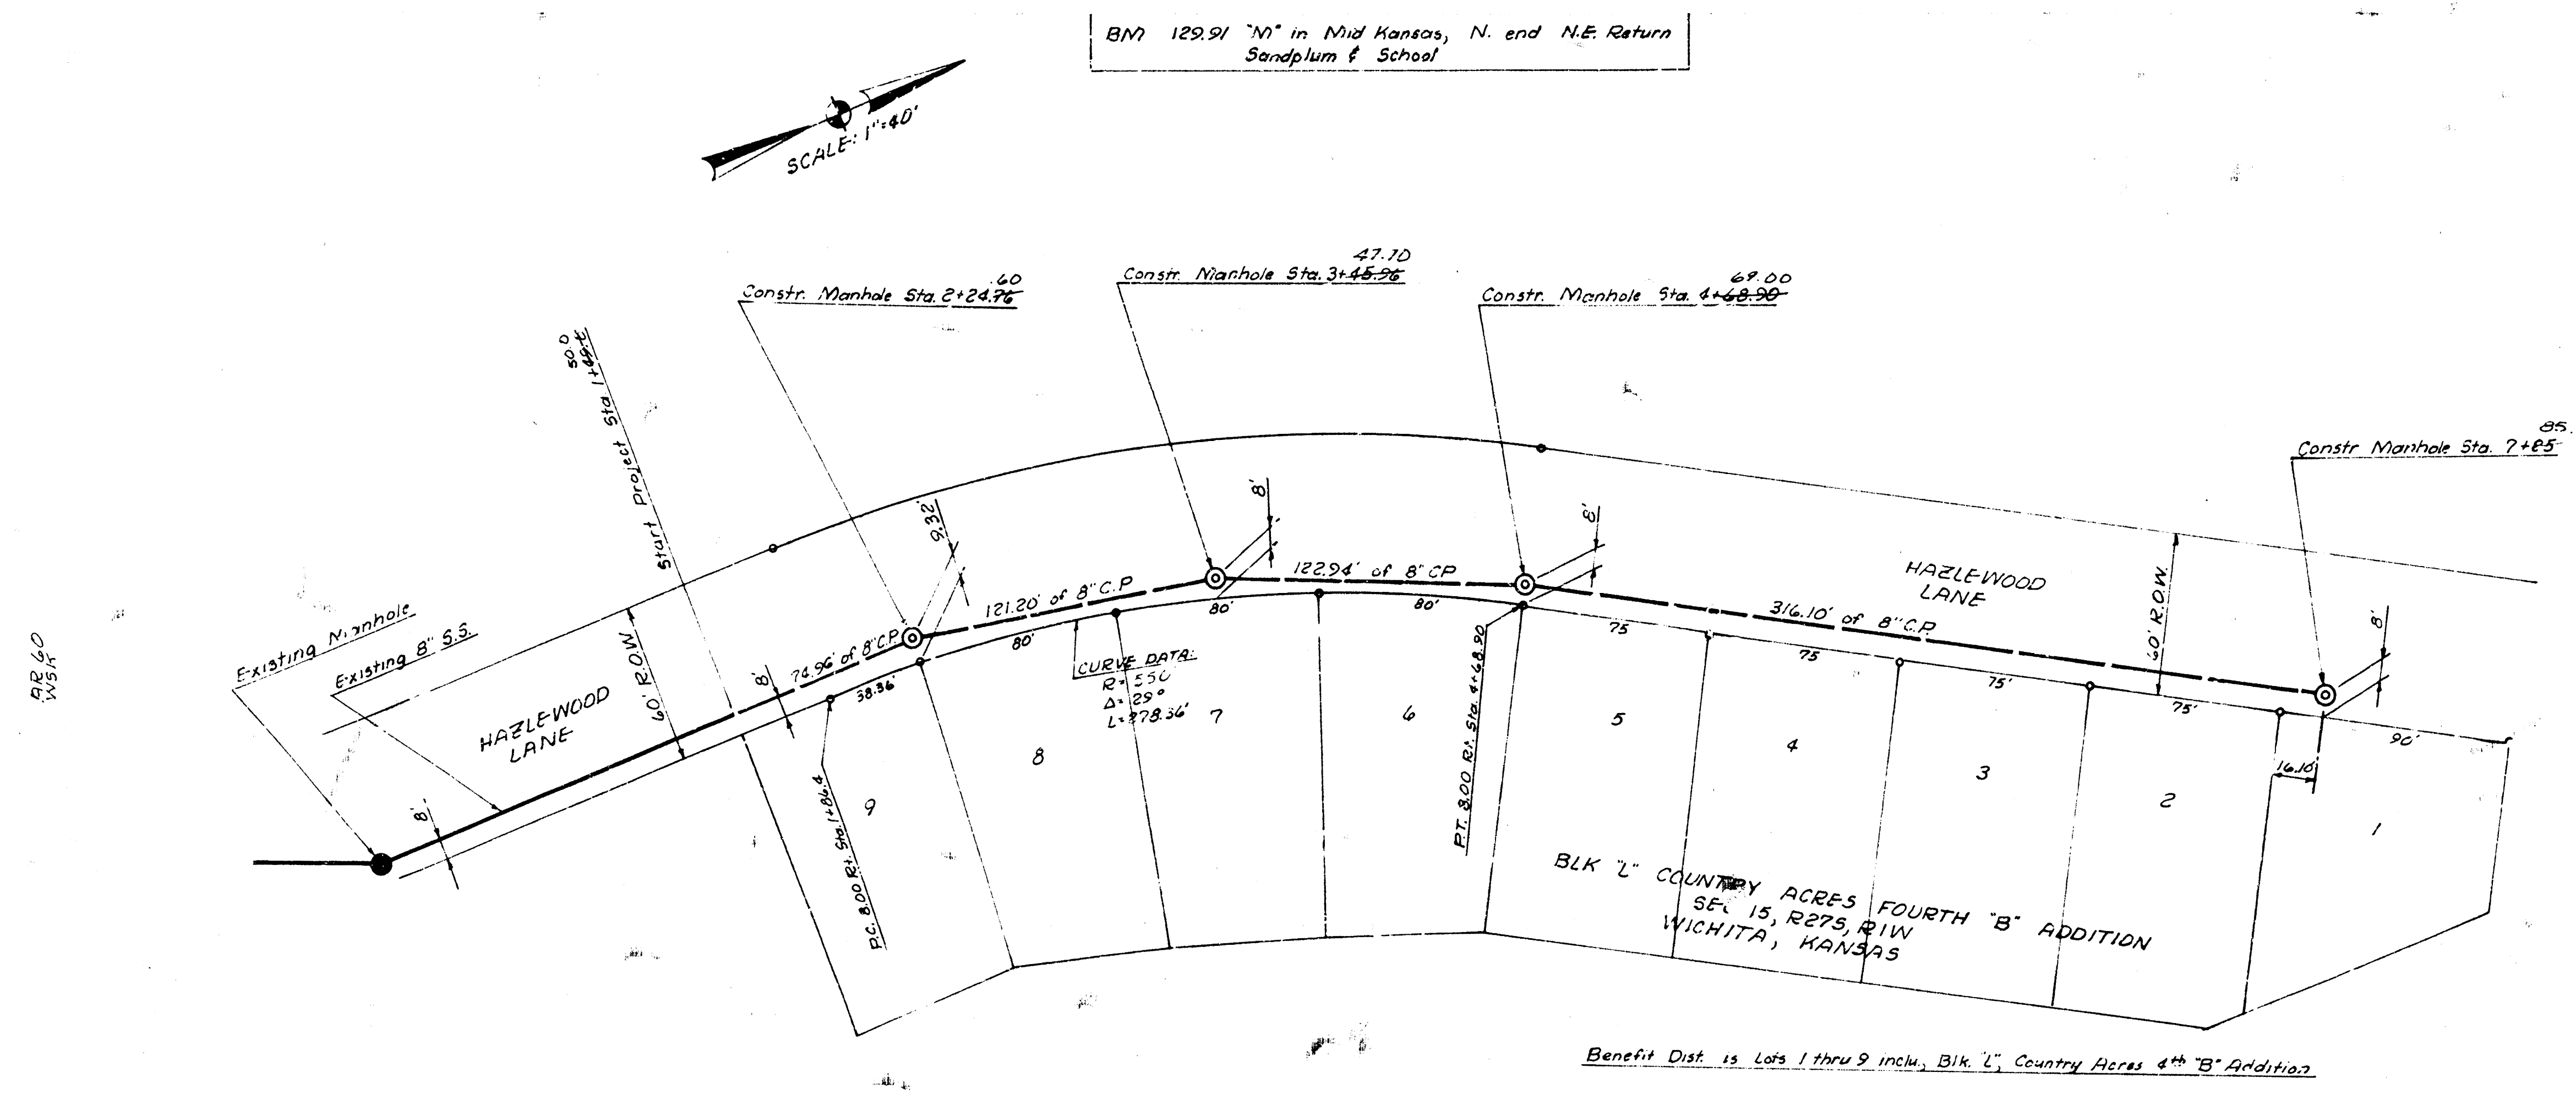

FINAL MEAS. "AS BUILT"

LAT 61, WESTLINK SEWER

CITY OF WICHITA, KANSAS

R. W. LINN, City Engineer

Project No. DBK 574023

DATE: _____

Sheet 1 of 1