



B.M. 15315 R.R. SPK. W-FACE PP 2' E. OF BACK OF CB. HOLLAND & APPROX.
 25' N. OF N.L. 13TH ST. N.
 B.M. 15619 CITY STD., 42.3' E. & 44' N. OF CTR. LINE 13TH ST. N. &
 COUNTRY ACRES AVE
 B.M. 15767 NW COR. CONC. PORCH HO. NO. 1210 EMERSON
 B.M. 15947 NW COR. CONC. PORCH HO. NO. 7825 PONDEROSA

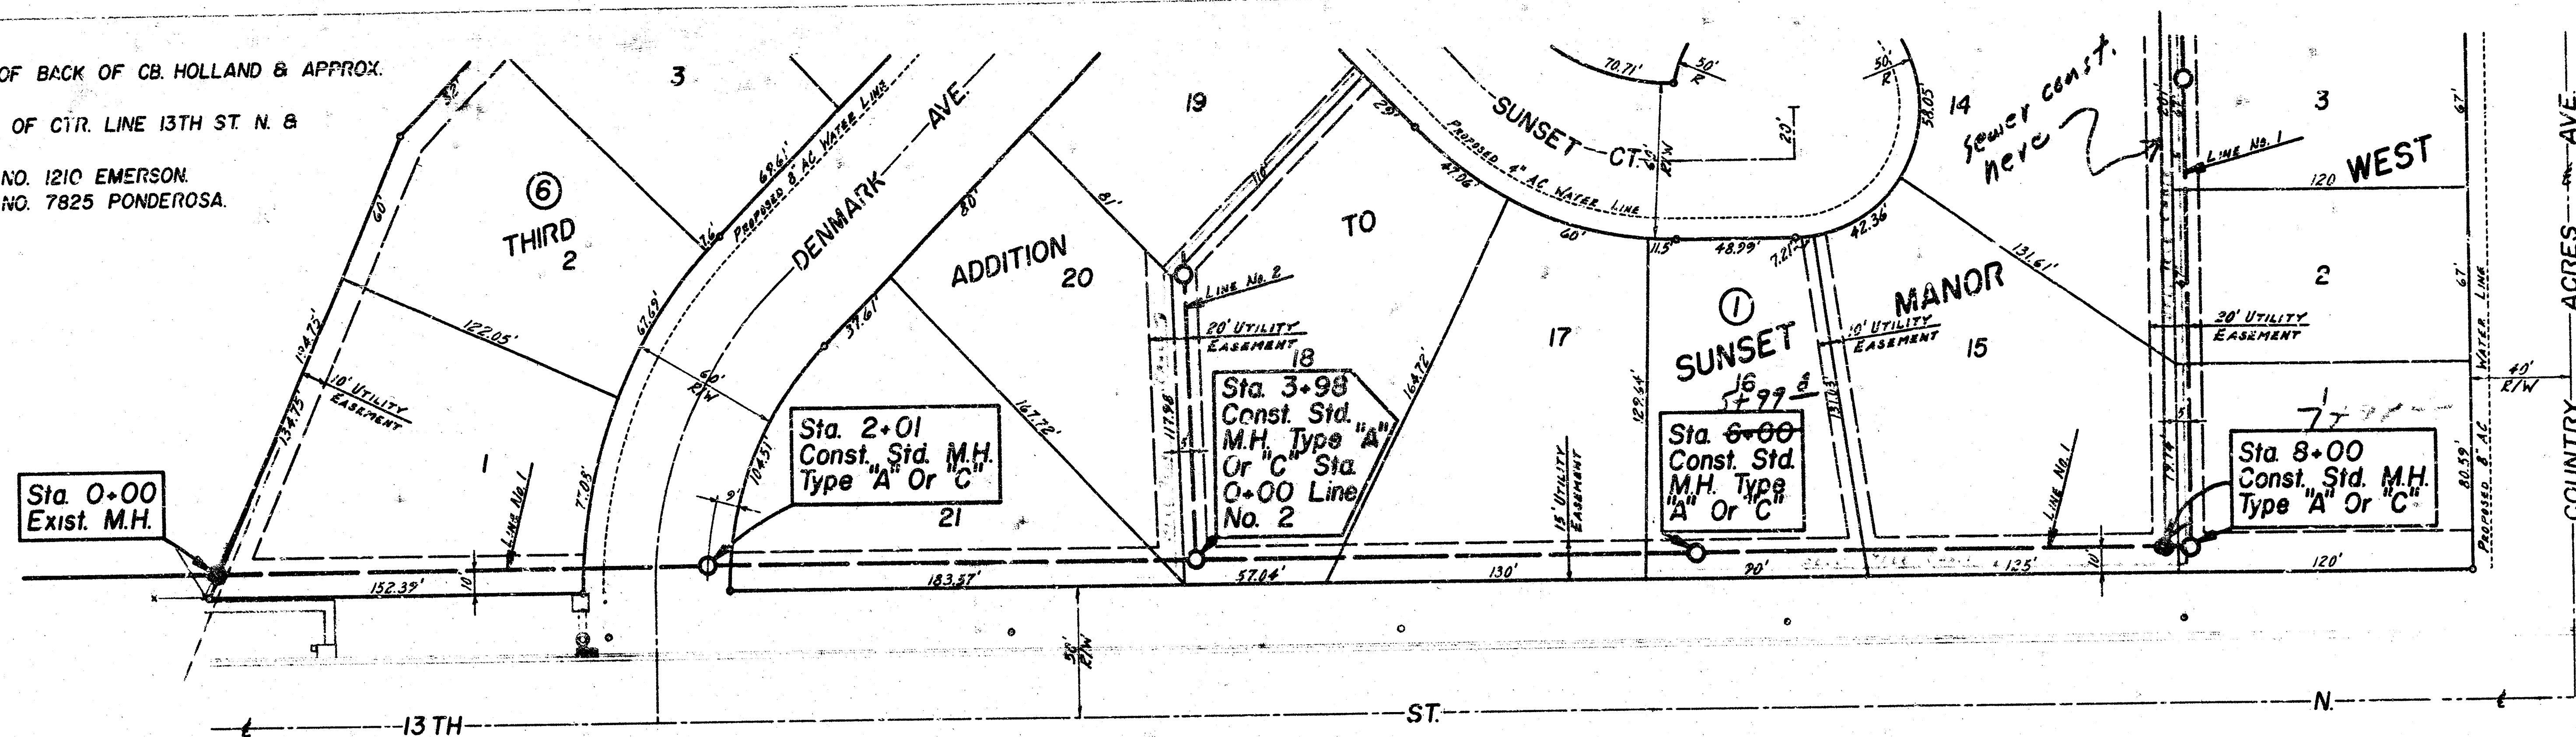

SCALE =
 PLAN 1" = 40'
 PROFILE 1" = 40' HOR.
 1" = 5' VERT

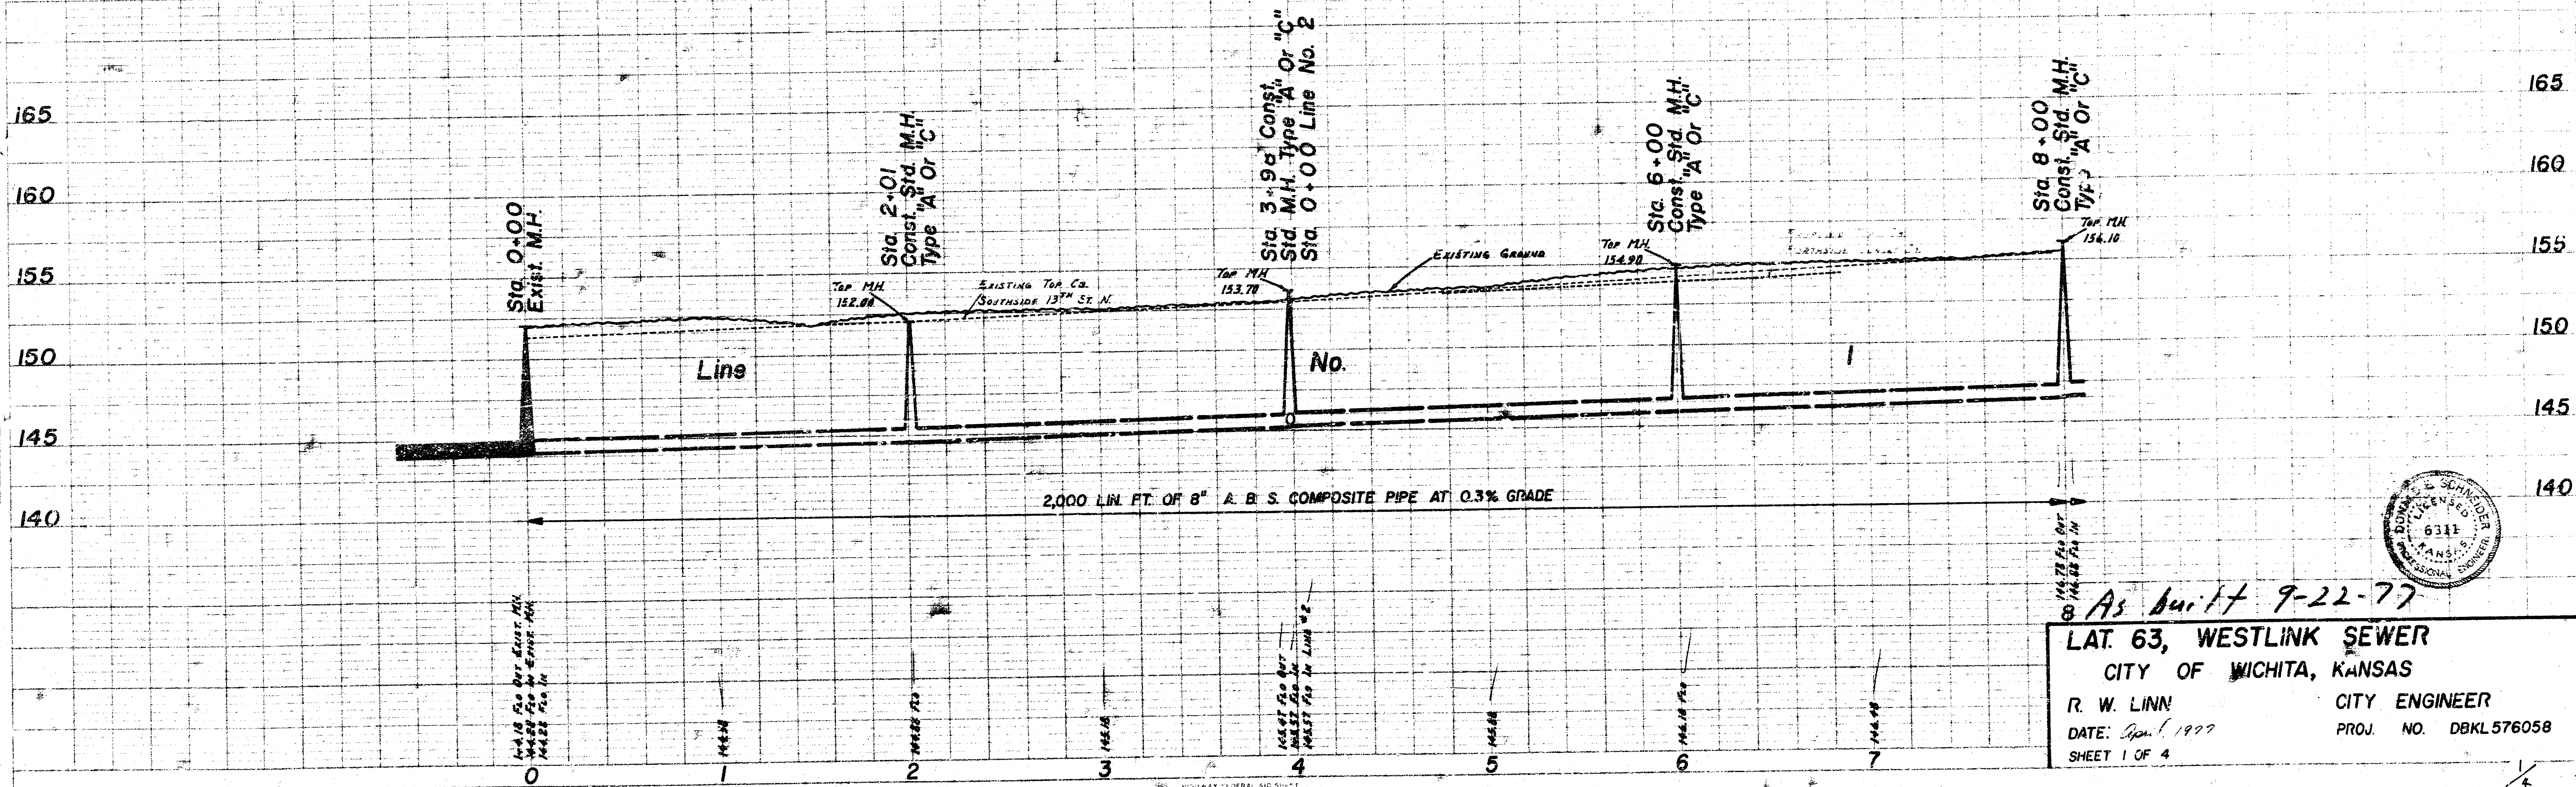

As built 9-22-77

LAT. 63, WESTLINK SEWER
 CITY OF WICHITA, KANSAS

R. W. LINN

CITY ENGINEER


DATE: Sept. 1, 1977

PROJ. NO. DBKL576058


SHEET 1 OF 4

PLATE SINGLE PLAN AND PROFILE FULL LINE
 WELDING NATIONAL TRADING POST
 CHICAGO, ILLINOIS PRINTED IN U.S.A.

B.M. 15315 R.R. SPK. W-FACE PP. 2' E. OF BACK OF CB.
HOLLAND & APPROX. 25' N. OF N.L. 13TH ST. N.
B.M. 15619 CITY STD., 423' E. & 44' N. OF CTR. LINE 13TH
ST. N. & COUNTRY ACRES AVE.
B.M. 15767 NW COR. CONC. PORCH HO. NO. 1210 EMERSON.
B.M. 15947 NW COR. CONC. PORCH HO. NO. 7825 PONDEROSA.


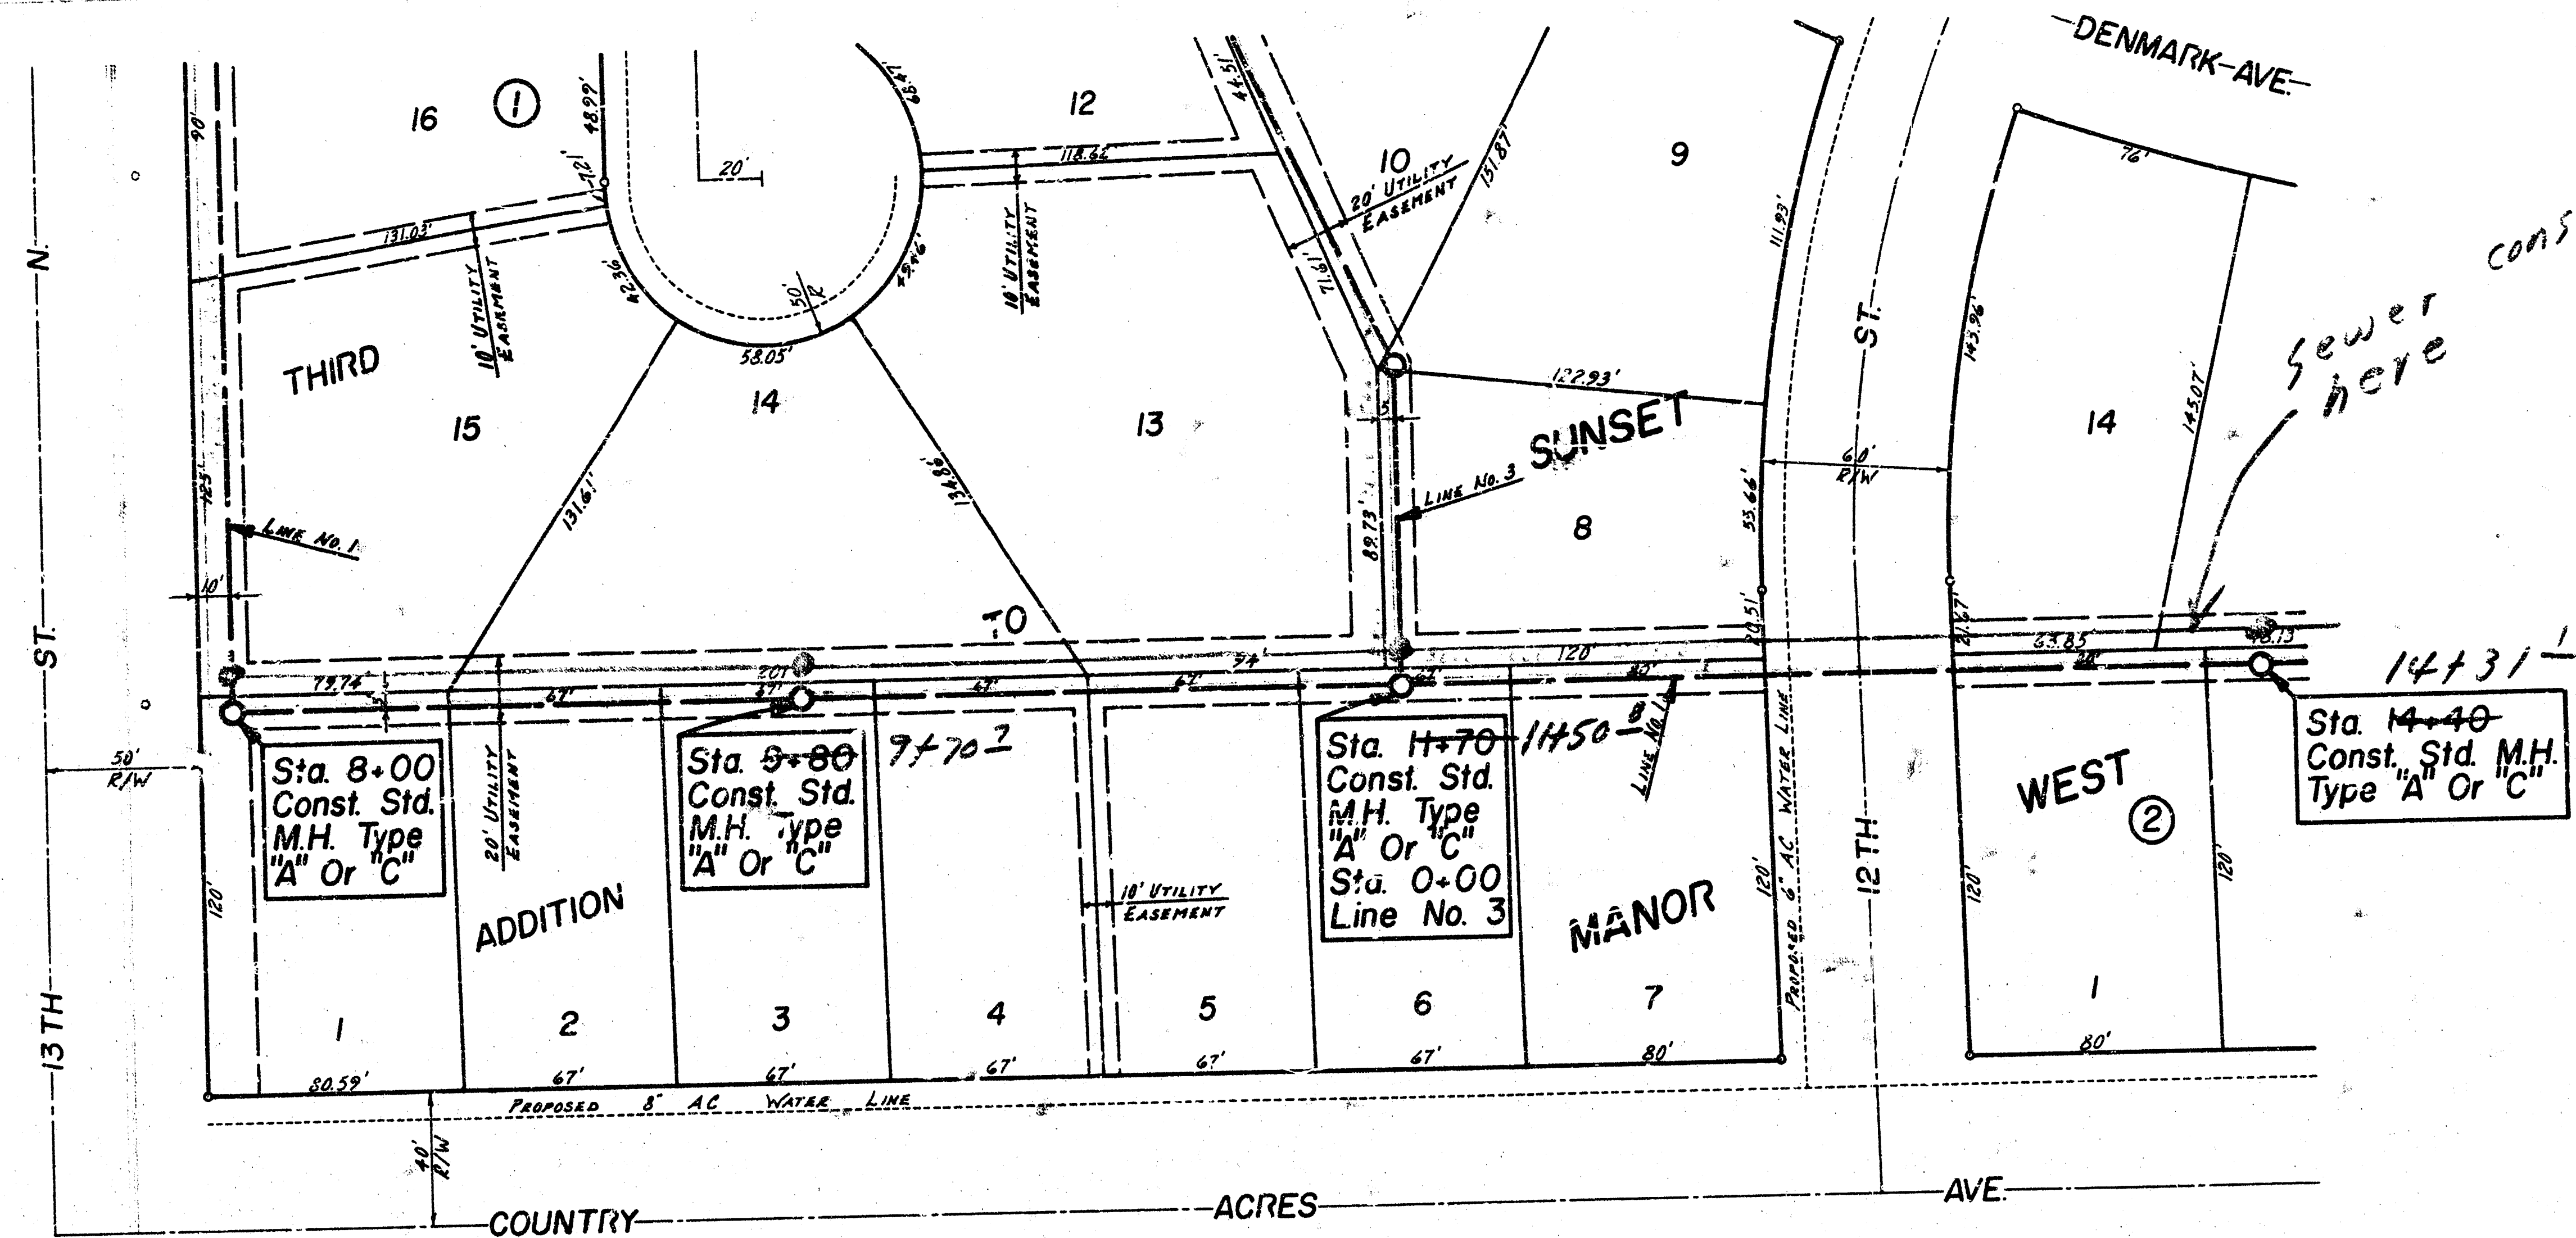


SCALE =
PLAN 1" = 40'
PROFILE 1" = 40' HCR.
1" = 5' VERT.

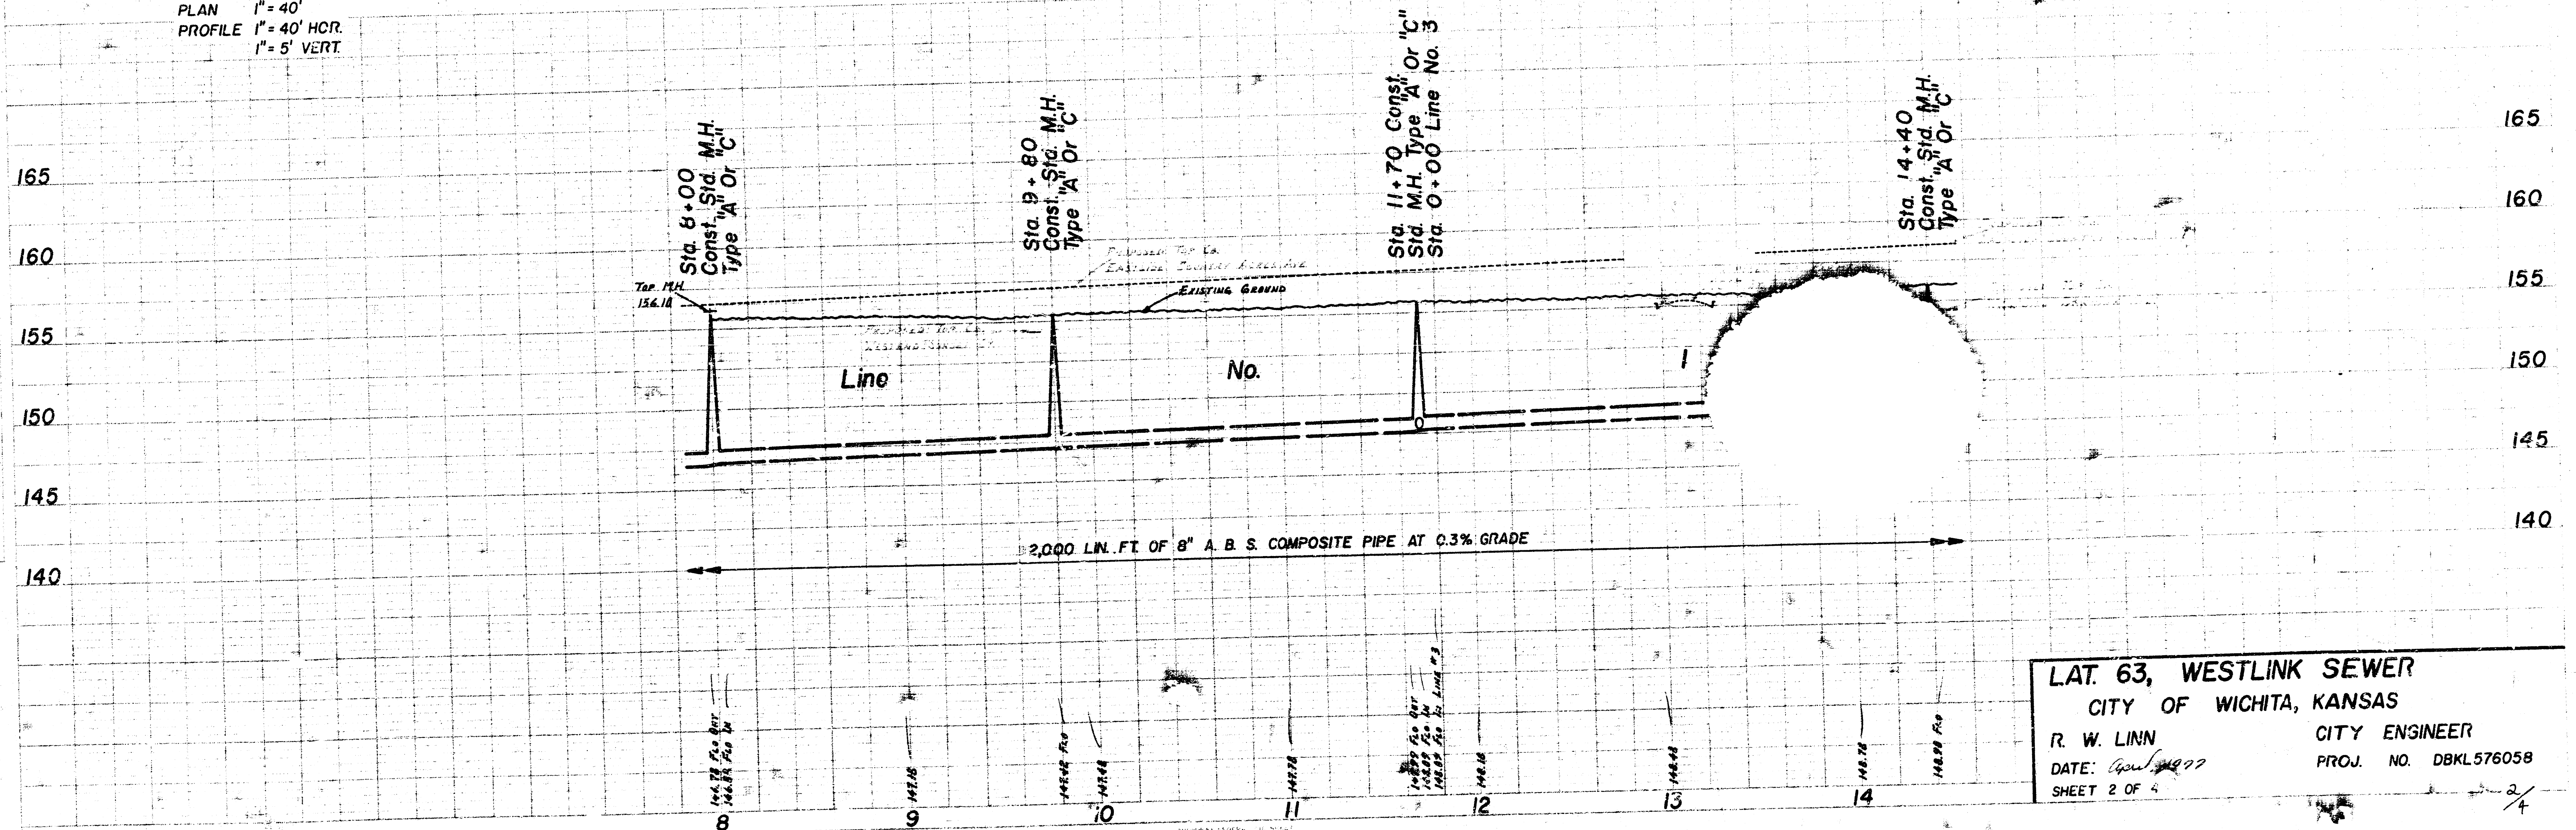


LAT. 63, WESTLINK SEWER
CITY OF WICHITA, KANSAS
R. W. LINN
DATE: April 1997
SHEET 2 OF 4
CITY ENGINEER
PROJ. NO. DBKL576058





B.M. 15315 R.R. S.F.K. W-FACE PP. 2' E. OF BACK OF CB.
HOLLAND & APPROX. 25' N. OF N.L. 13TH ST. N.
B.M. 15619 CITY STD., 42.3' E. & 44' N. OF CTR. LINE 13TH
ST. N. & COUNTRY ACRES AVE.
B.M. 15767 NW COR. CONC. PORCH HO. NO. 1210 EMERSON.
B.M. 15947 NW COR. CONC. PORCH HO. NO. 7825 PONDEROSA.

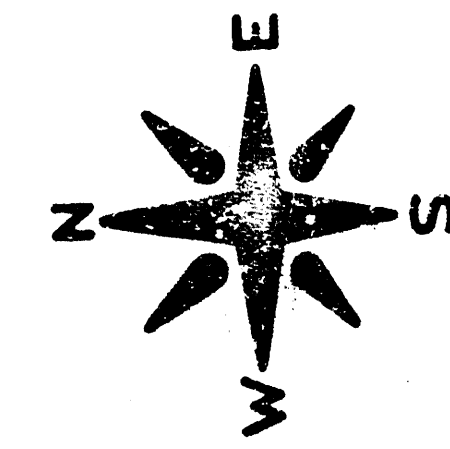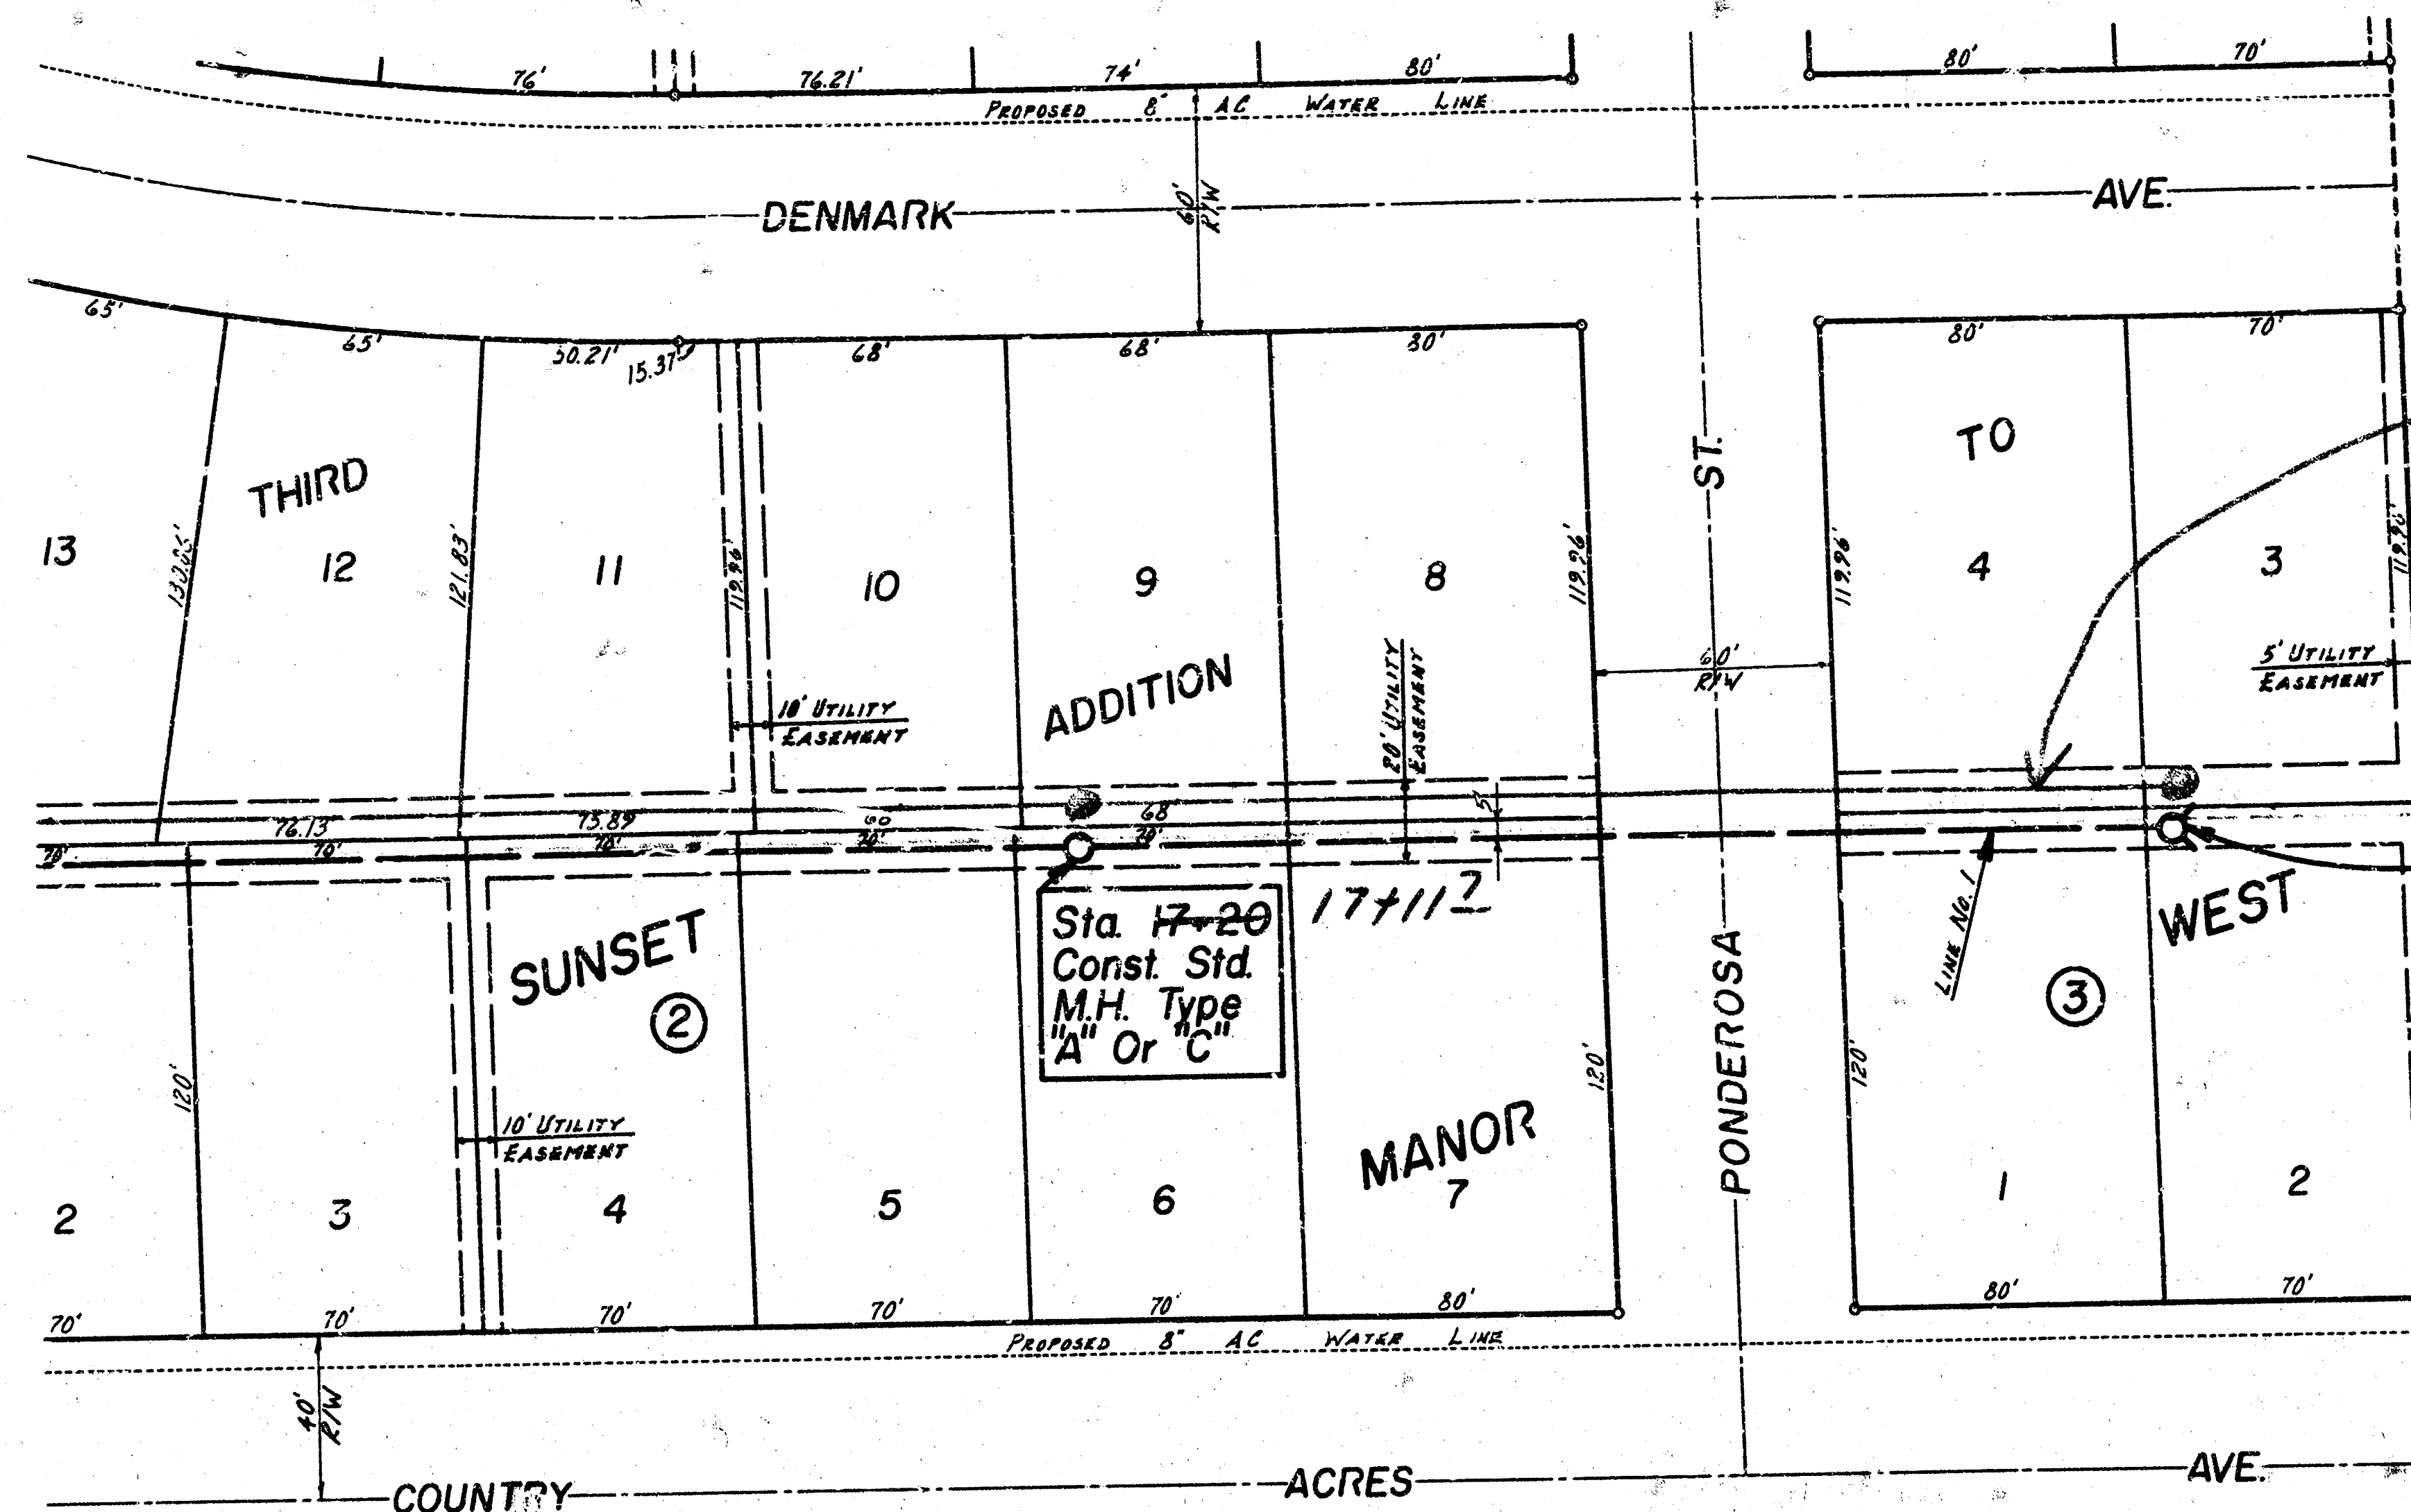

SCALE =
PLAN 1" = 40'
PROFILE 1" = 40' HOR.
1" = 5' VERT.

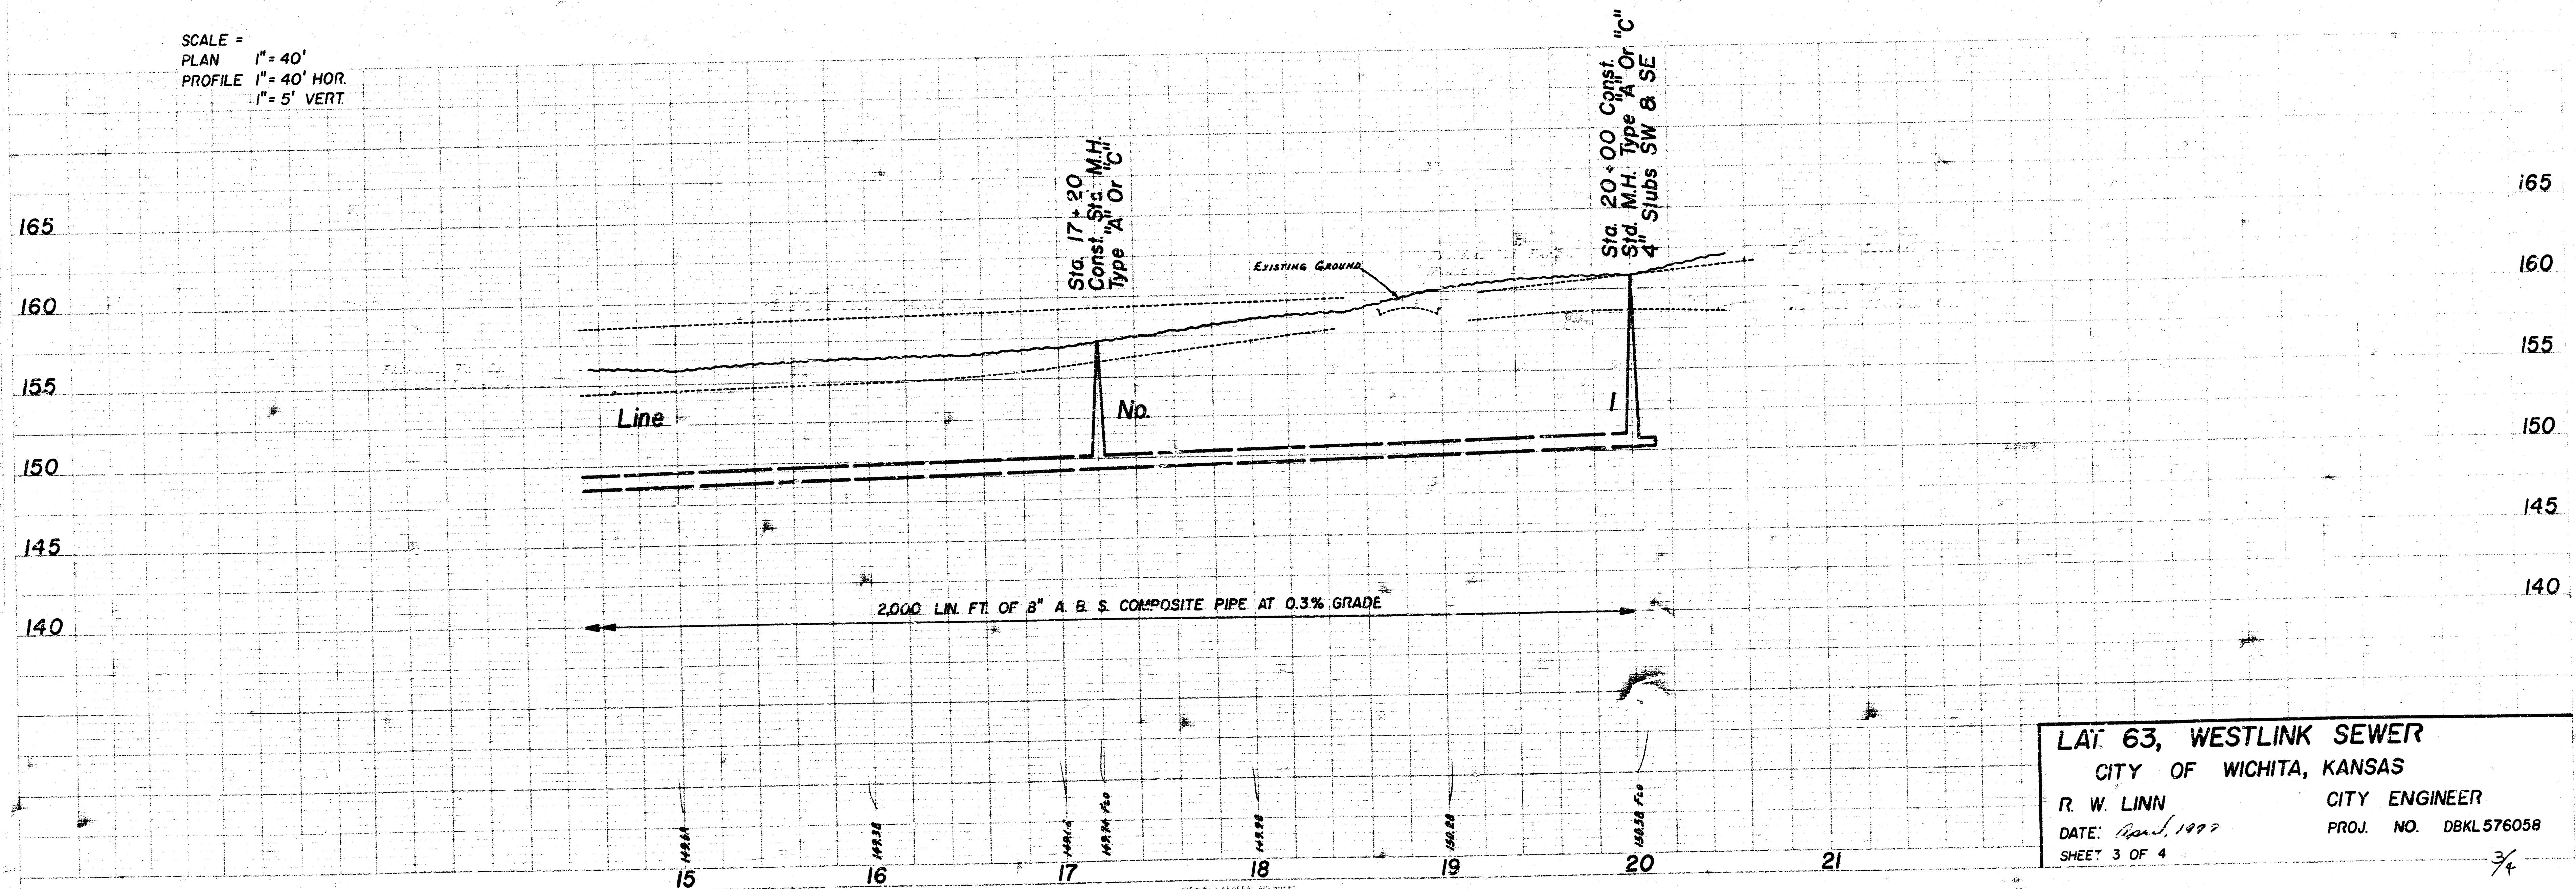

LAT. 63, WESTLINK SEWER
CITY OF WICHITA, KANSAS
R. W. LINN CITY ENGINEER
DATE: Jan. 1992 PROJ. NO. DBKL576058
SHEET 3 OF 4

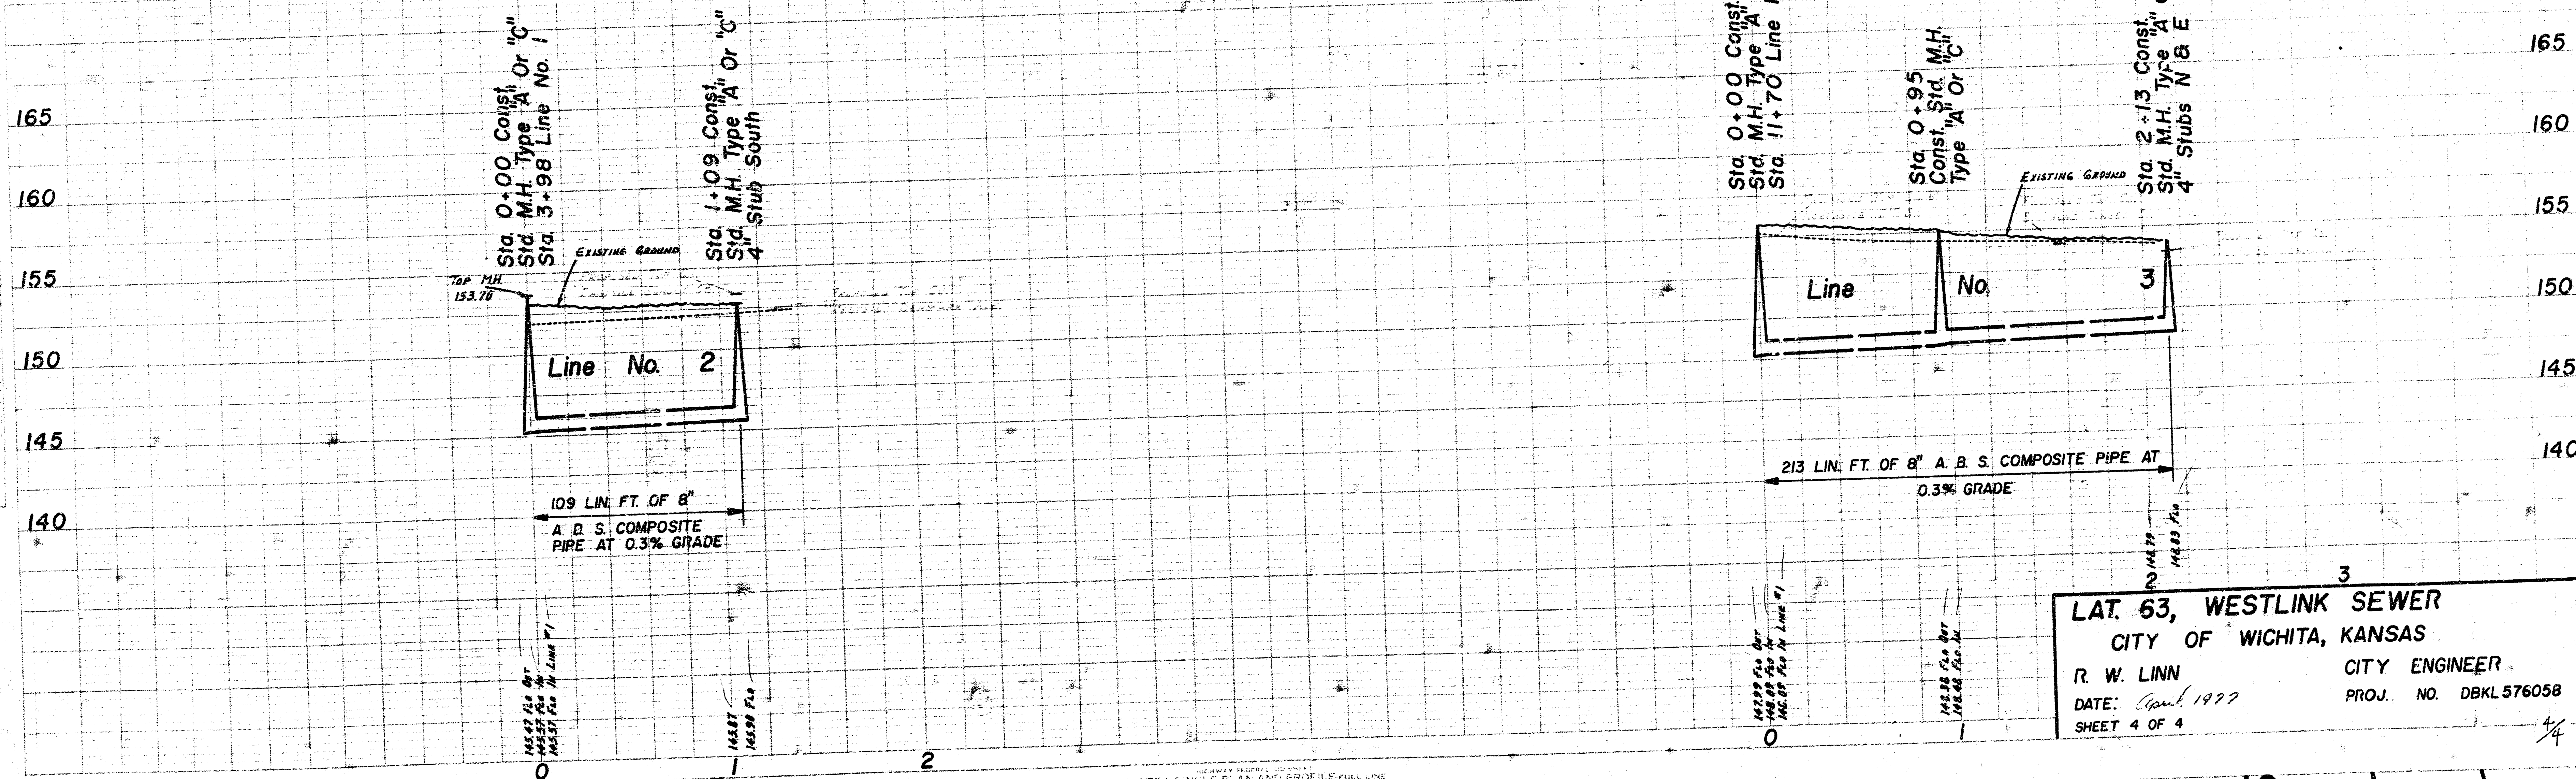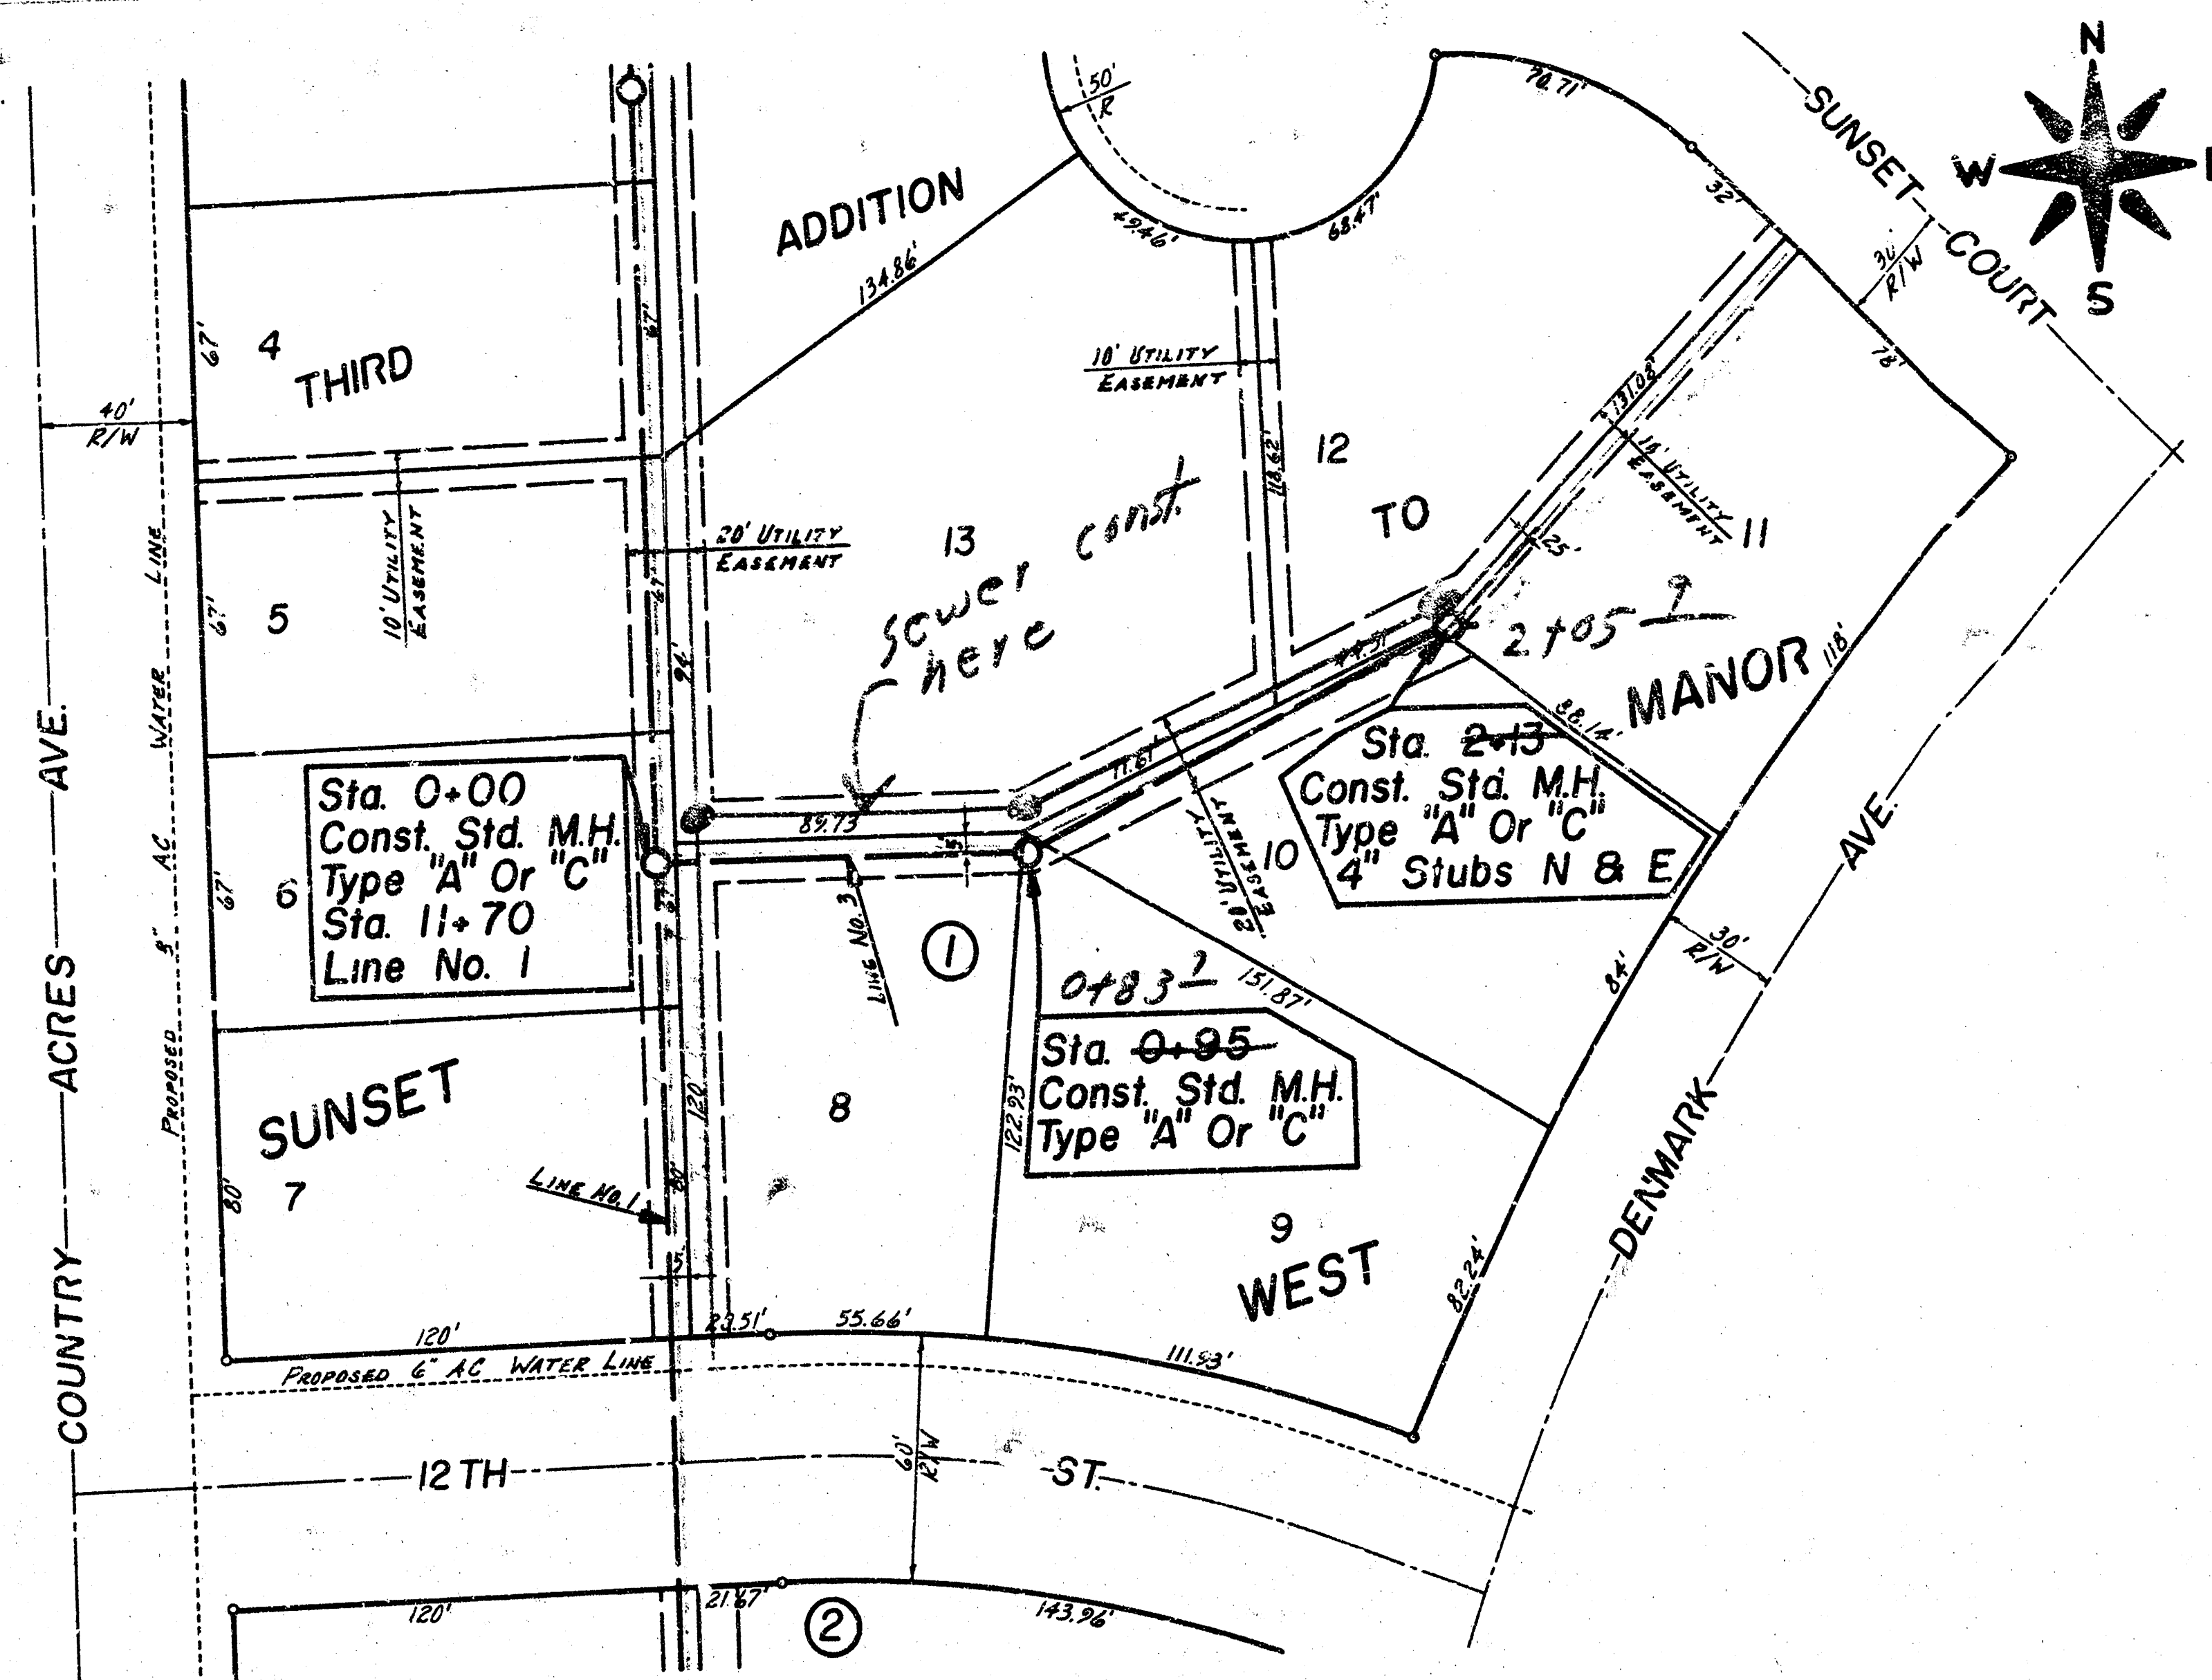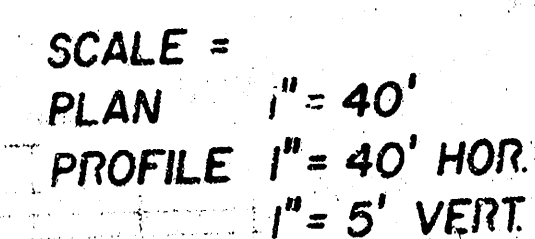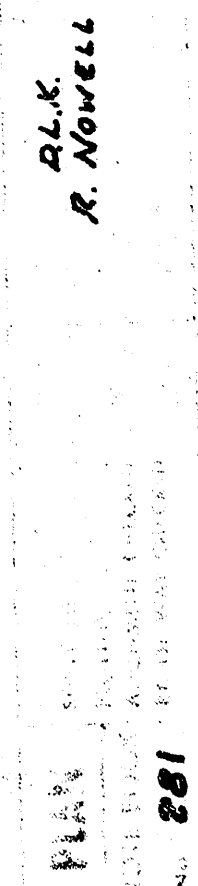

LAT. 63, WESTLINK SEWER
CITY OF WICHITA, KANSAS
R. W. LINN
DATE: *April 1992*
SHEET 4 OF 4
CITY ENGINEER
PROJ. NO. DBKL 57605B