


LAT 66 WESTLINK SEWER

CITY OF WICHITA

R.W.BRUGGEMAN - CITY ENGINEER

PROJECT NO. 468-76-245-80991-000-000-001

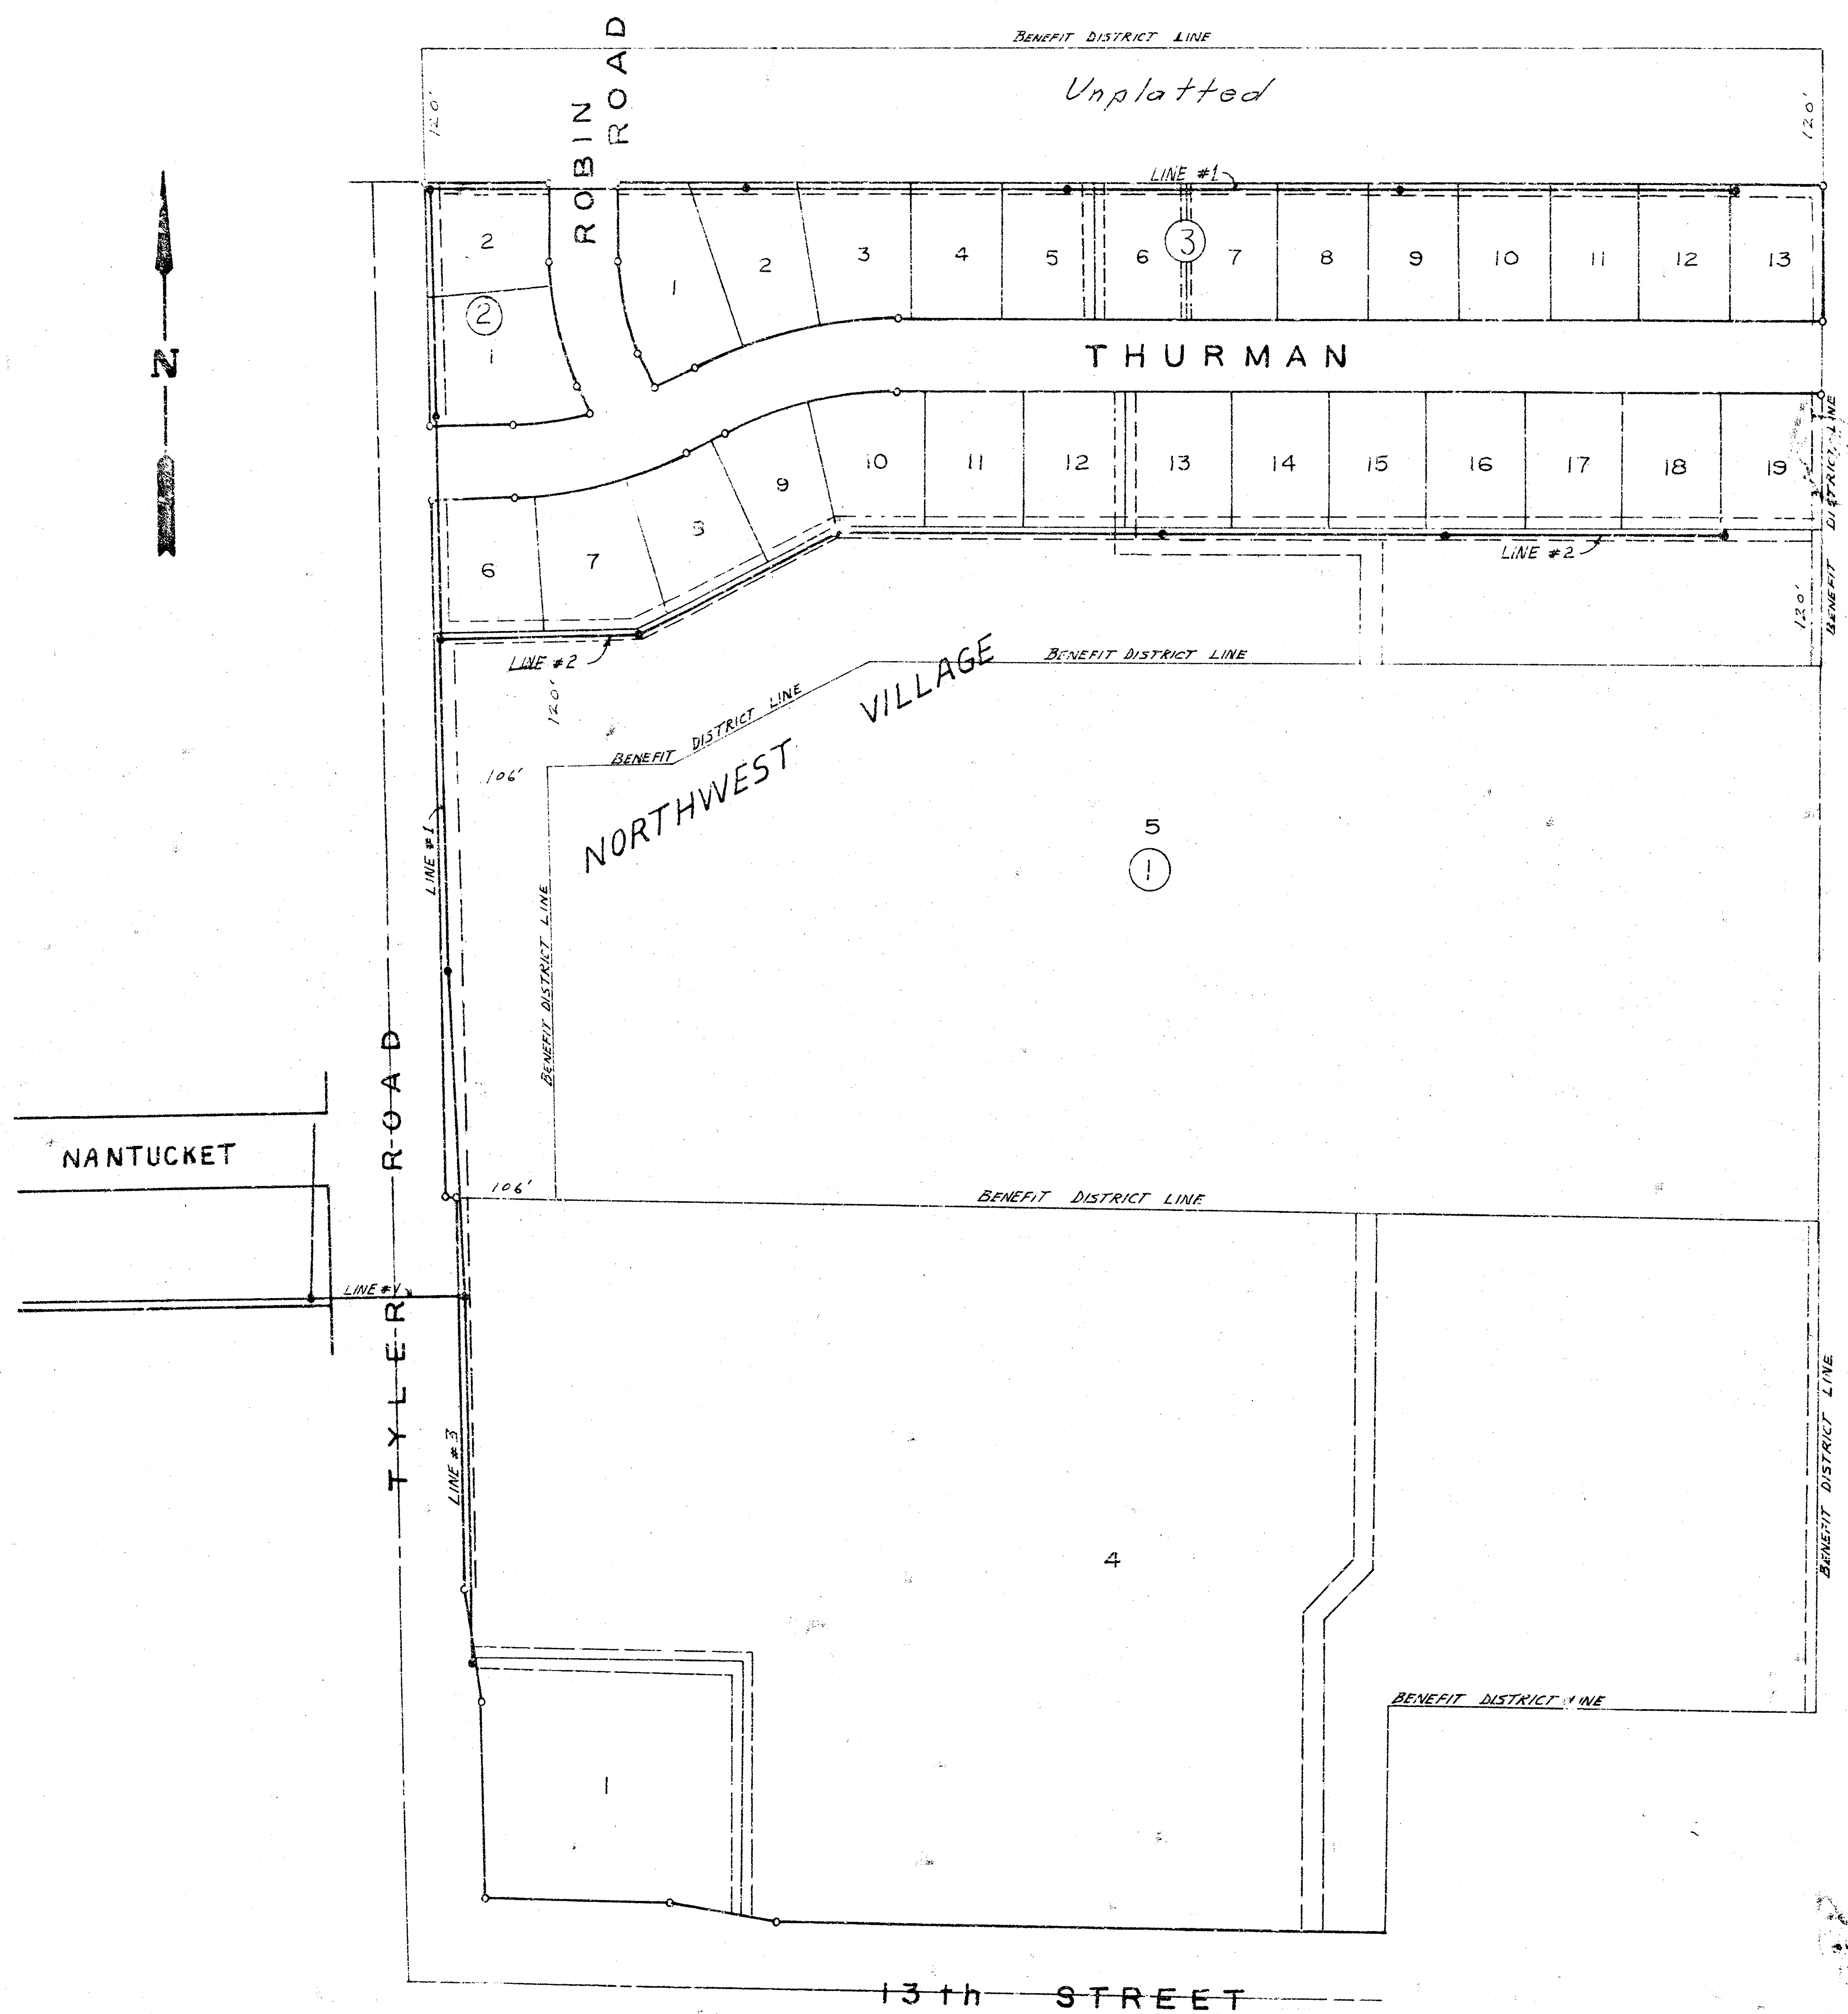


LINE #1	SHEETS	2-3
LINE #2	SHEETS	4-5
LINE #3	SHEET	5

As Built
5/81
JLL




CAUTION
UNDERGROUND
UTILITIES

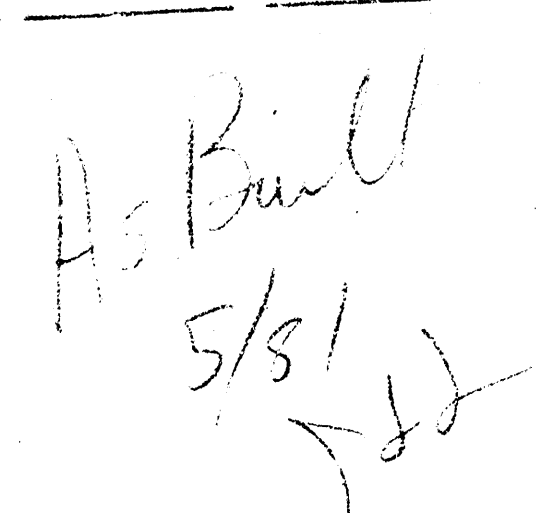


FILMED FROM THE BEST
AVAILABLE COPY.....

SCALE PLAN 1" = 40'
 PROFILE 1" = 40' VERT
 1" = 5' VERT

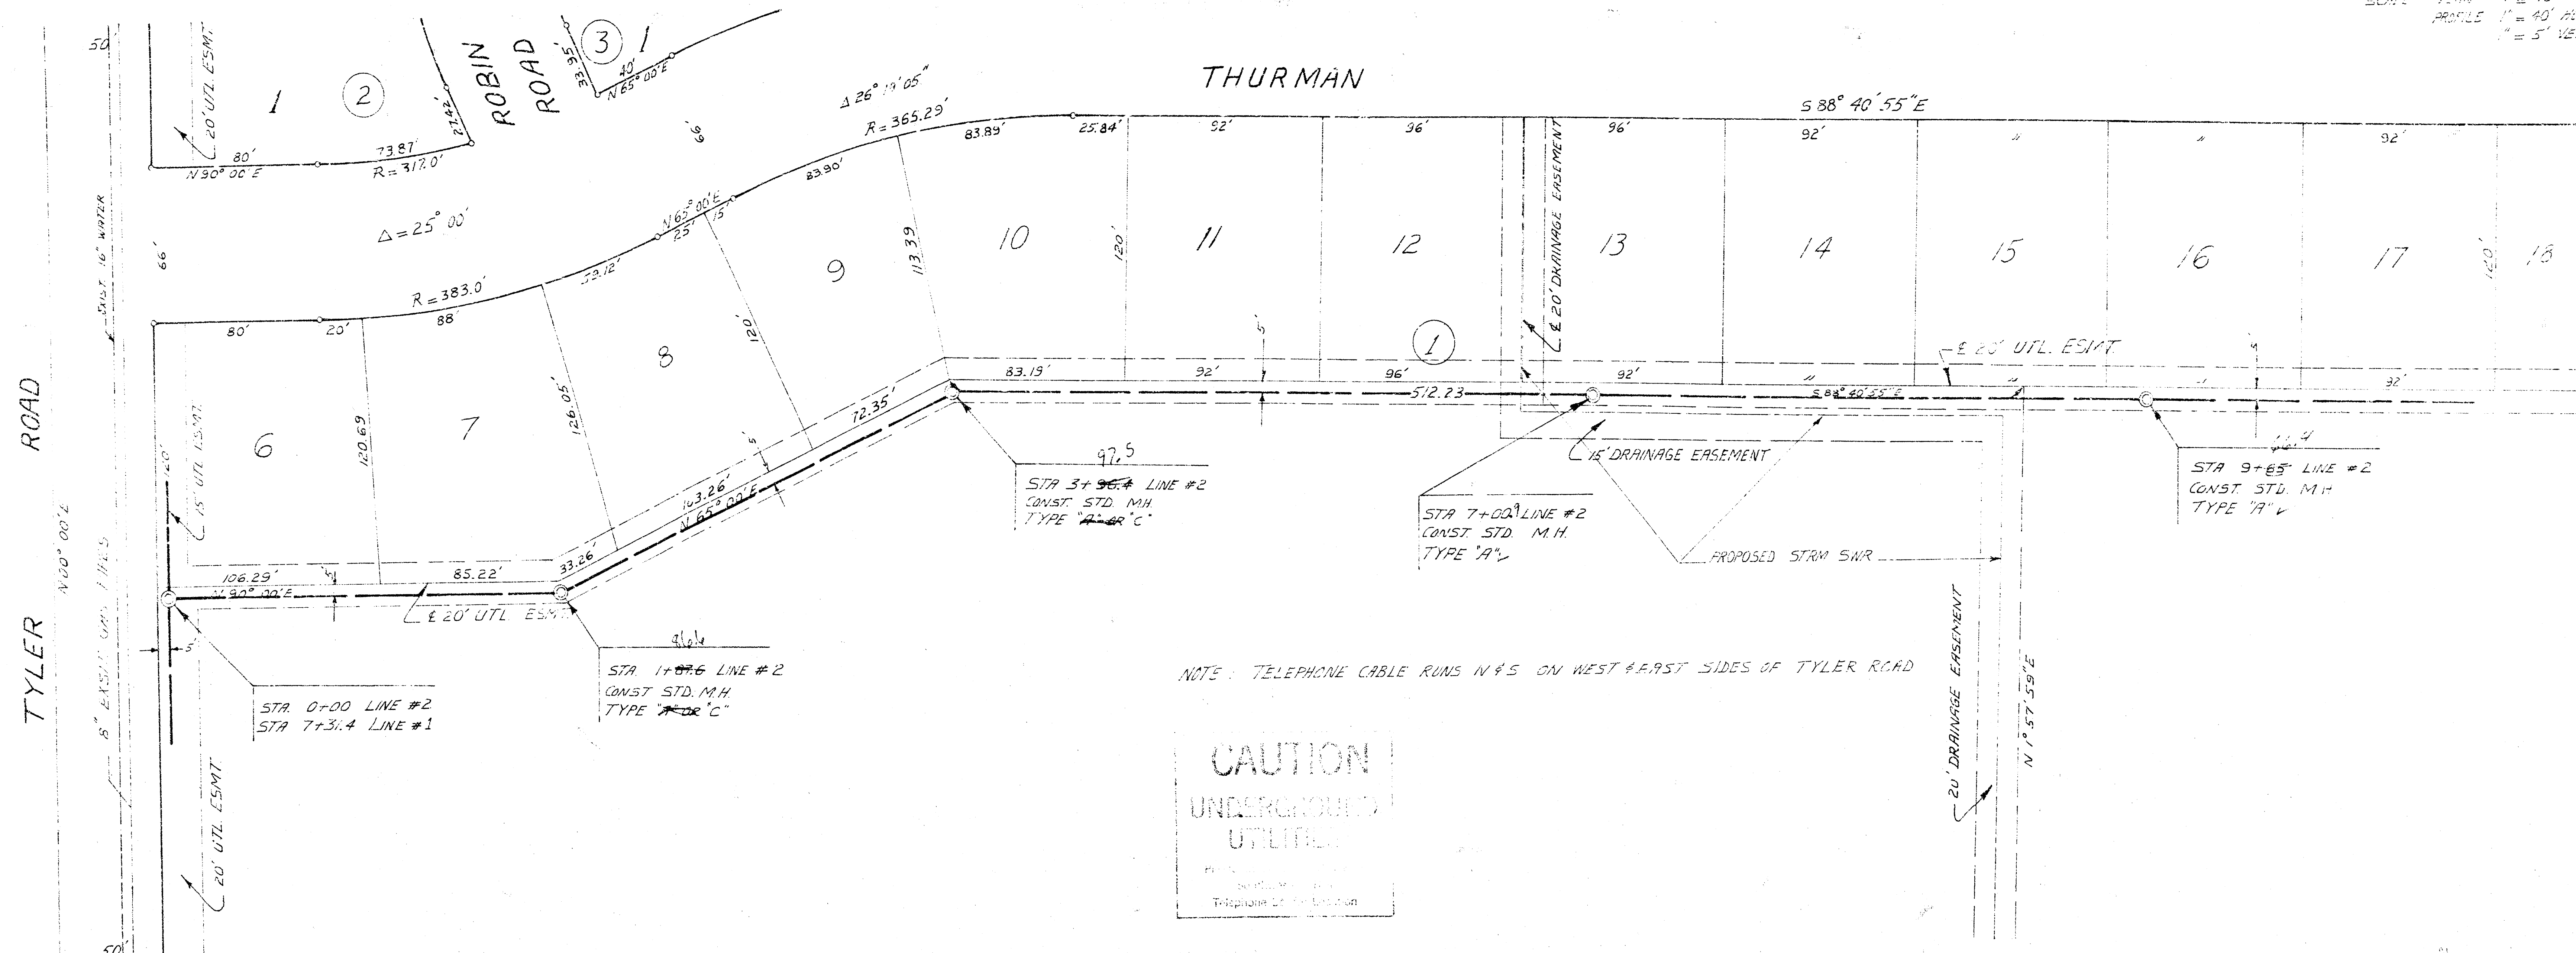

CAUTION
 UNDERGROUND
 UTILITIES

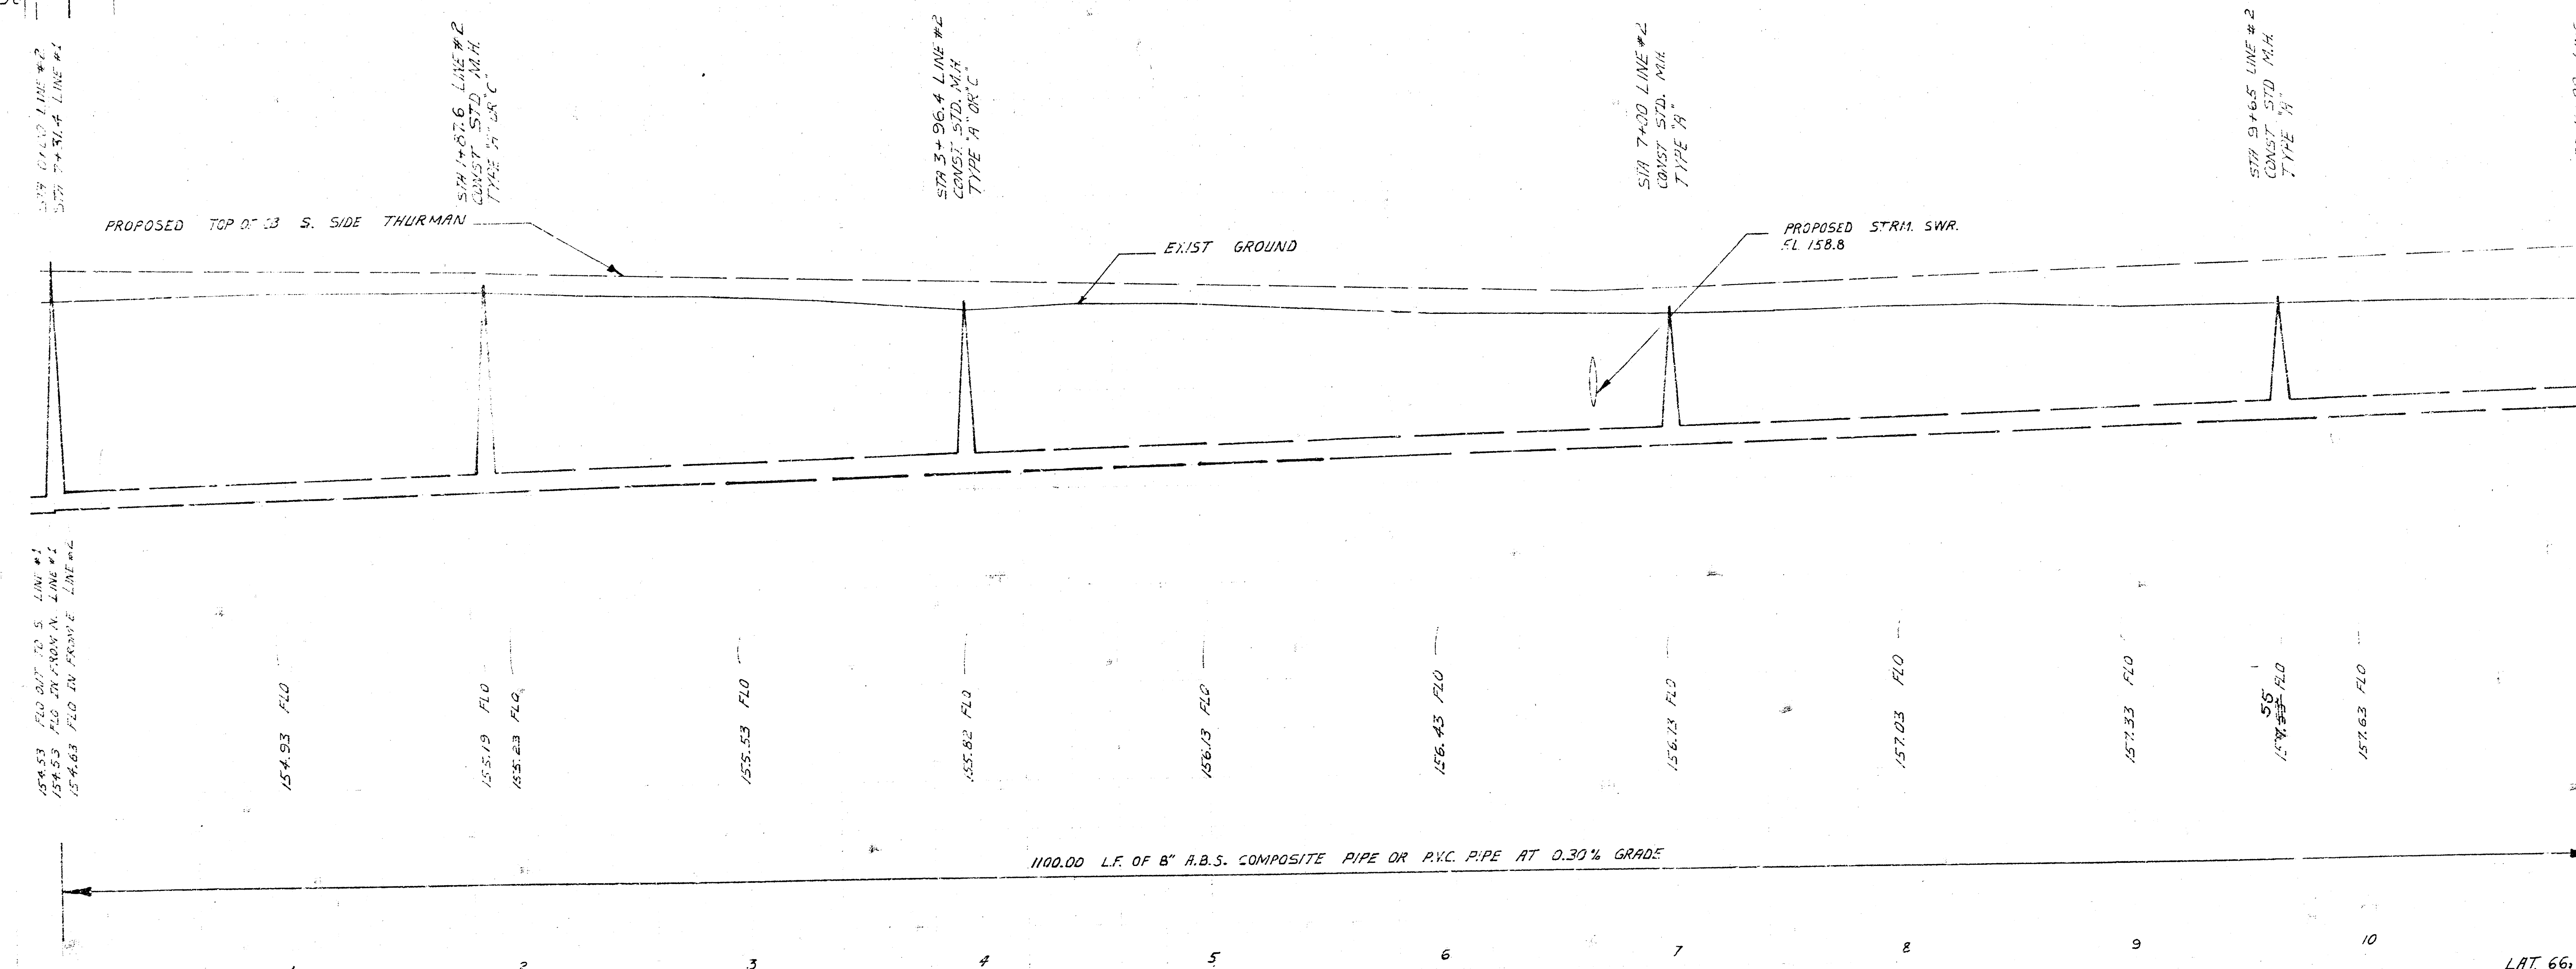

As Built
 5/8/1
 JJB







LAT. 66, WESTLINK SEWER
 PROJ. NO. 468.76.245.80991.000.000.007

FILMED FROM THE BEST
 AVAILABLE COPY

D. KESSLER OCT, 80

D.K. 3

• **ت**

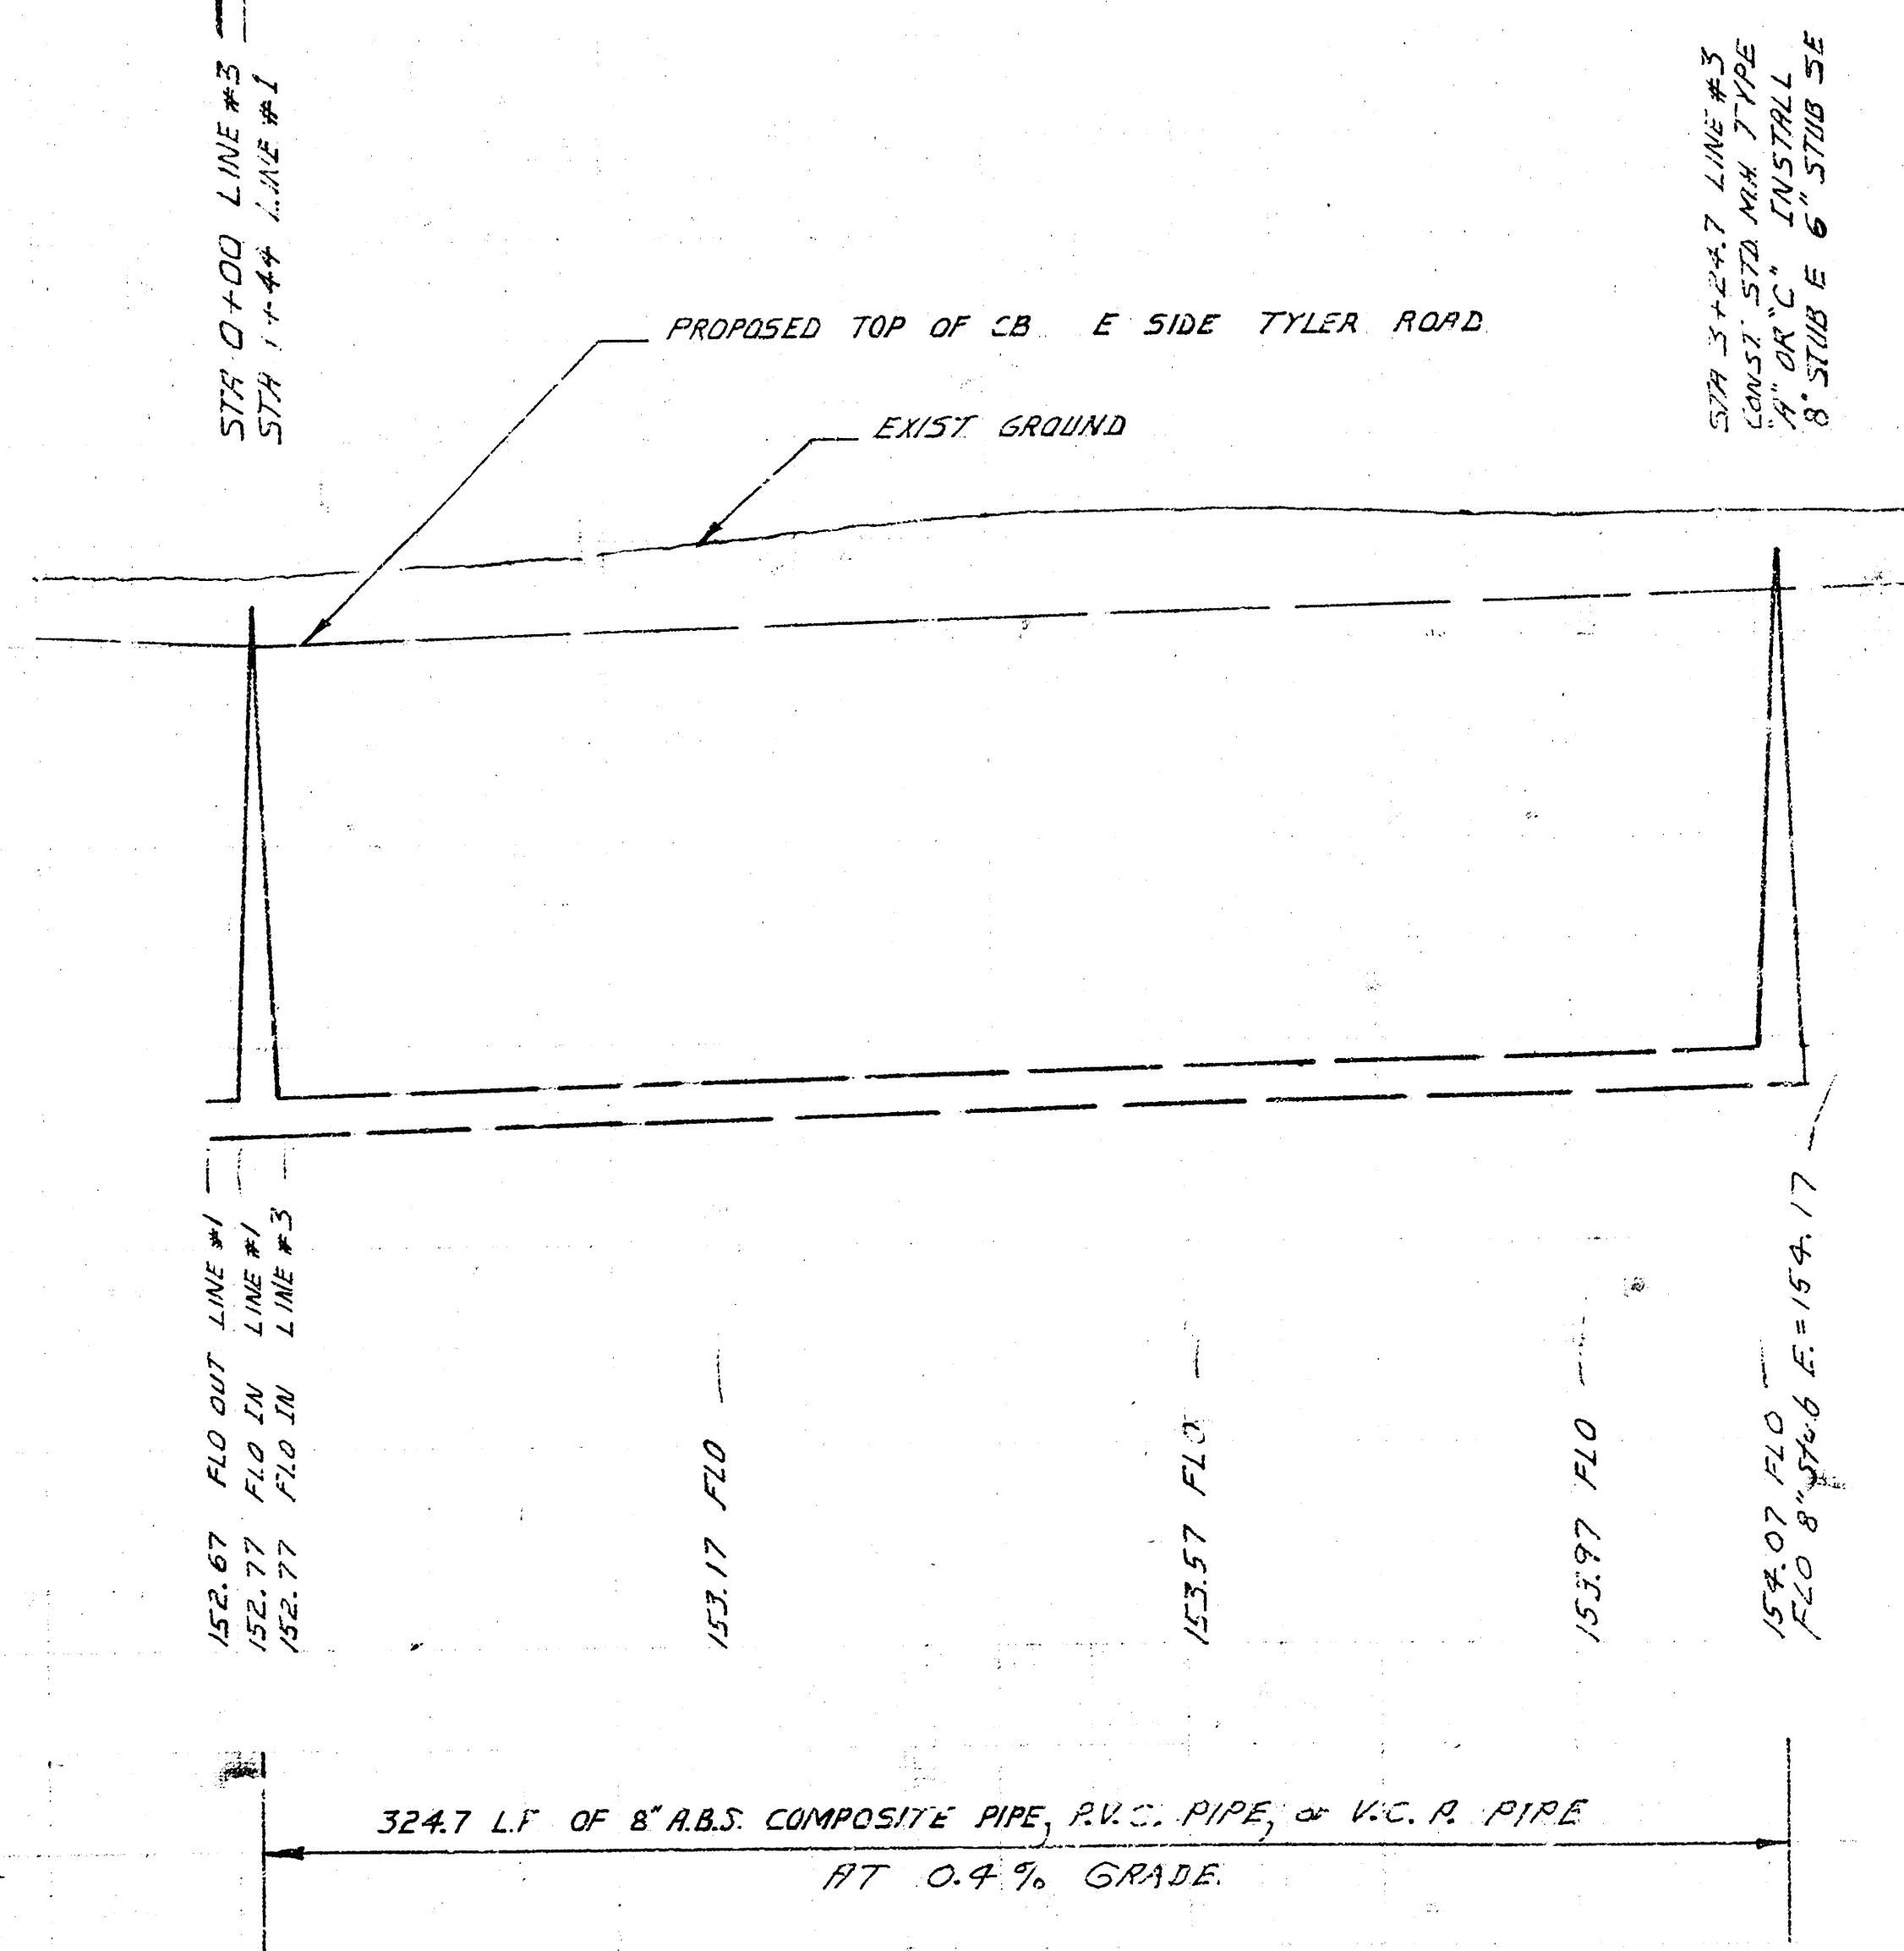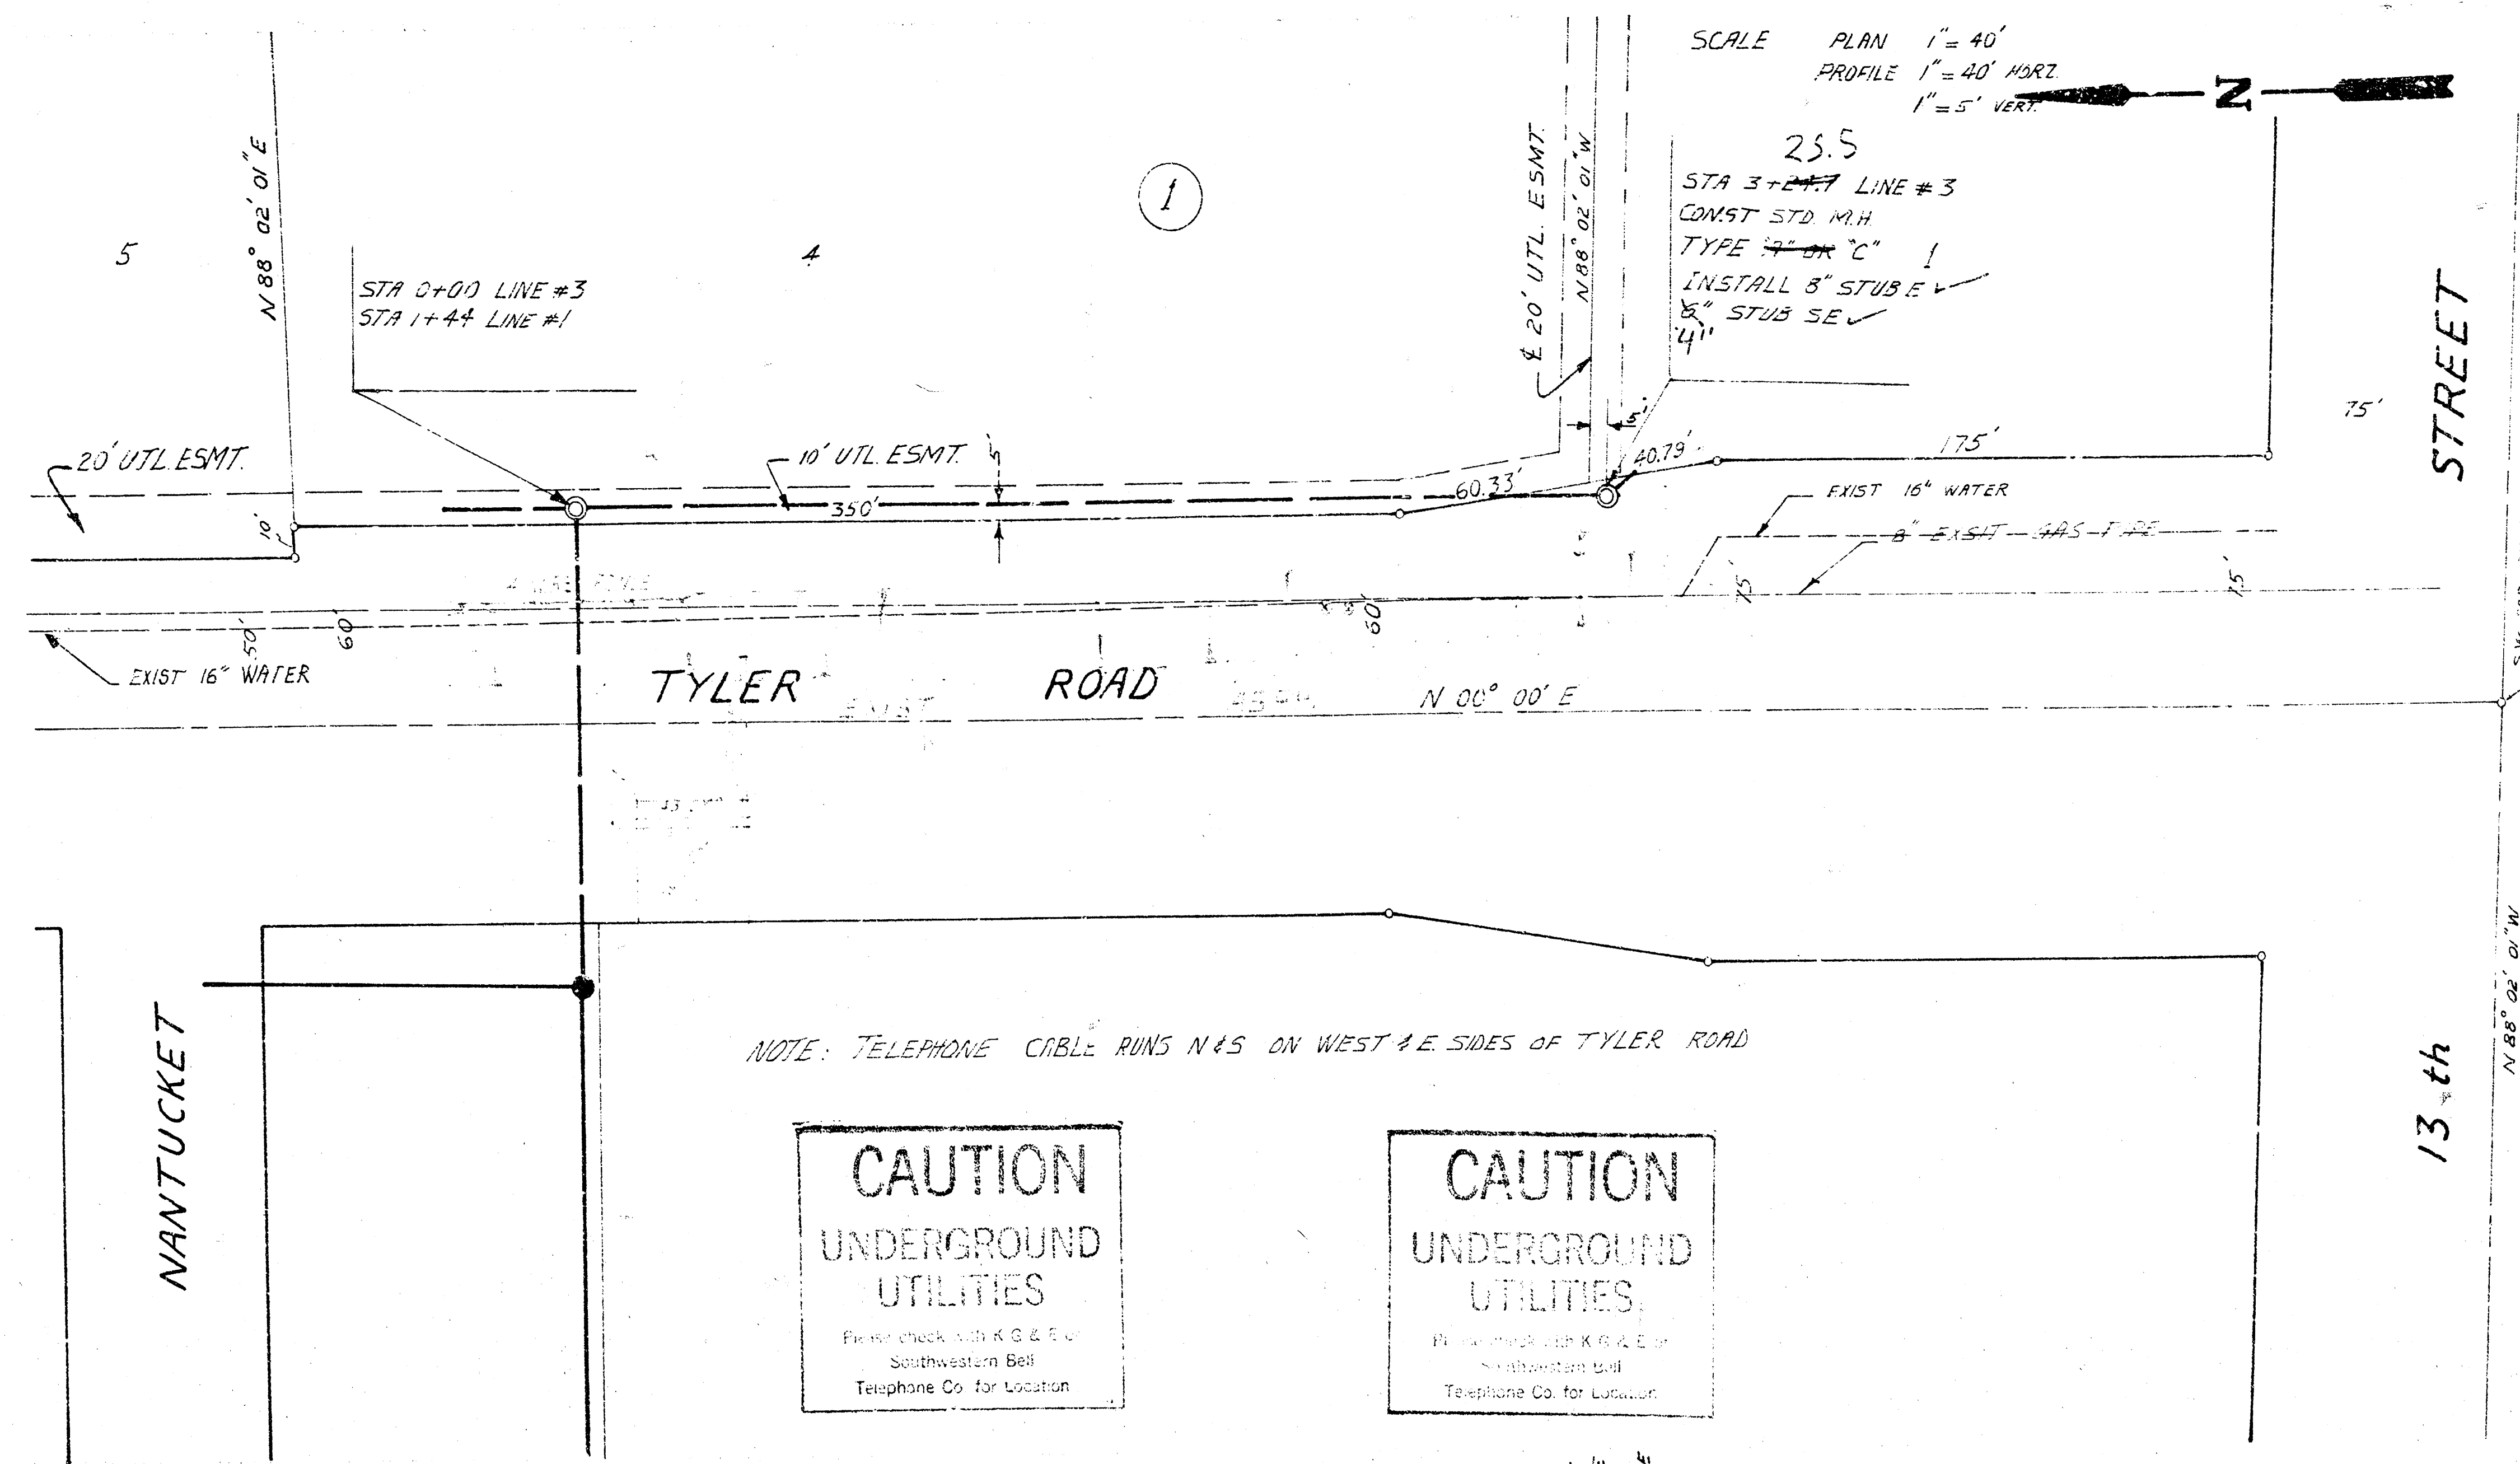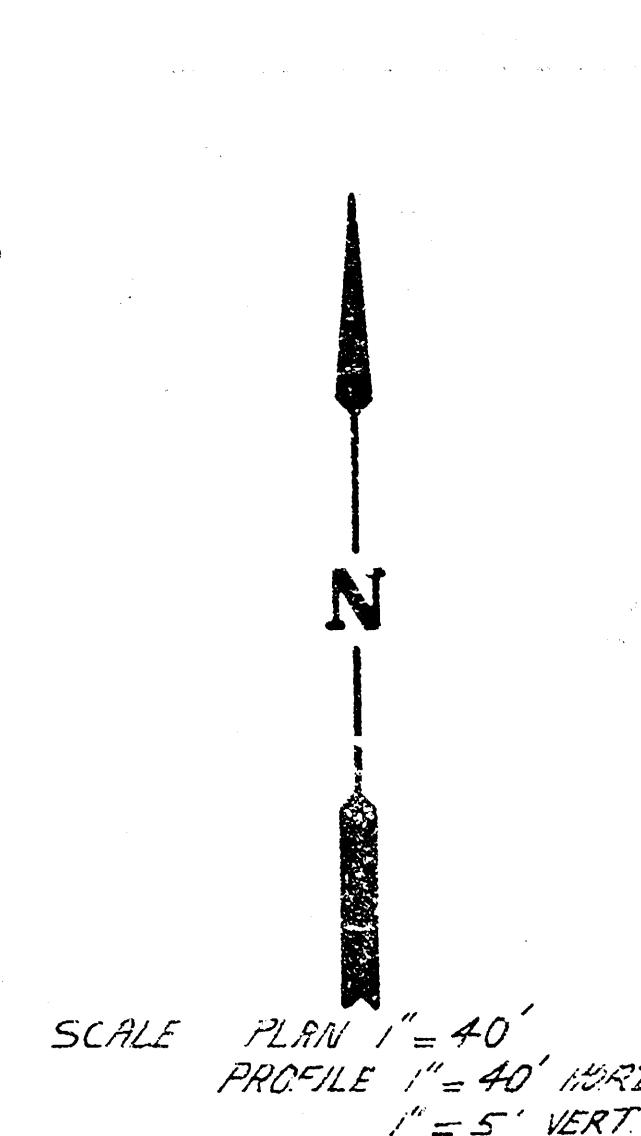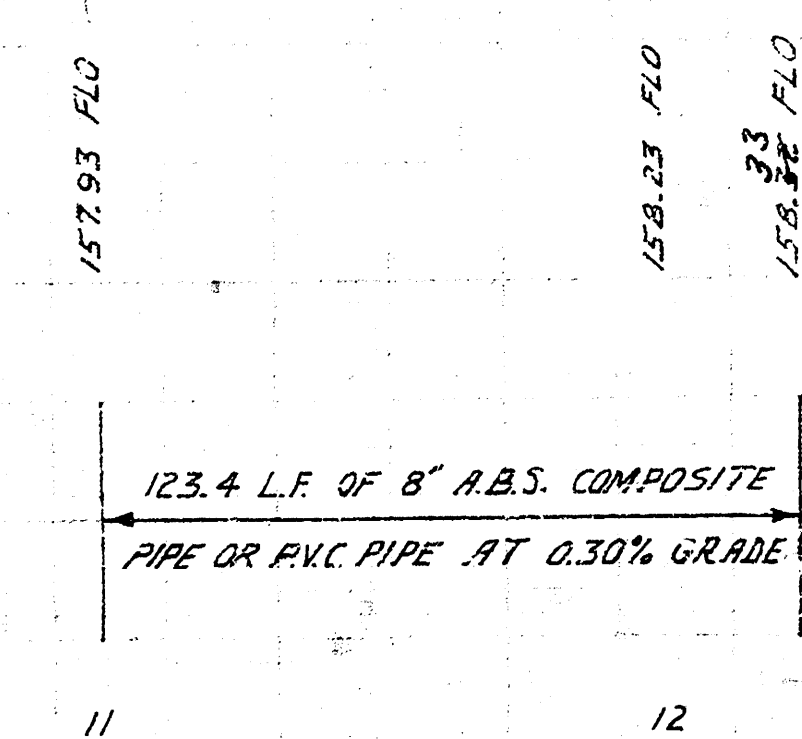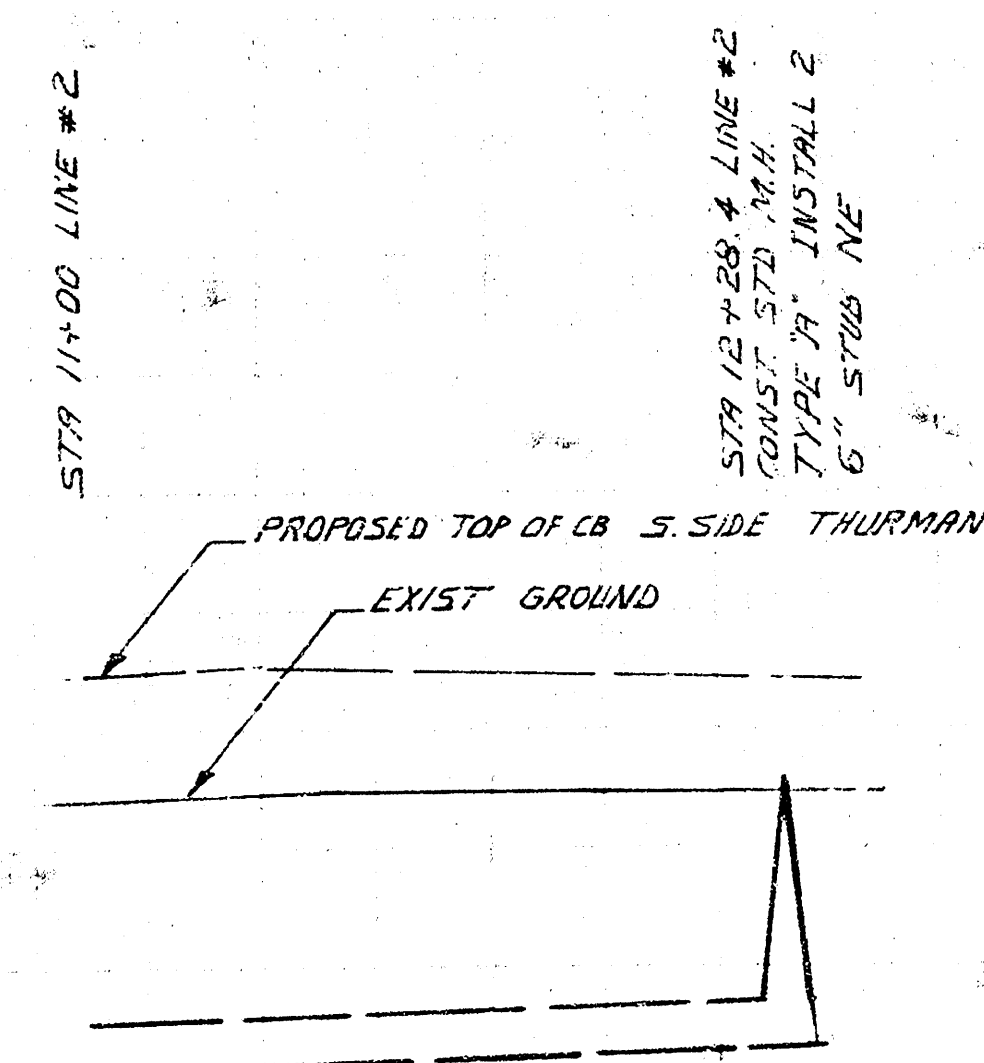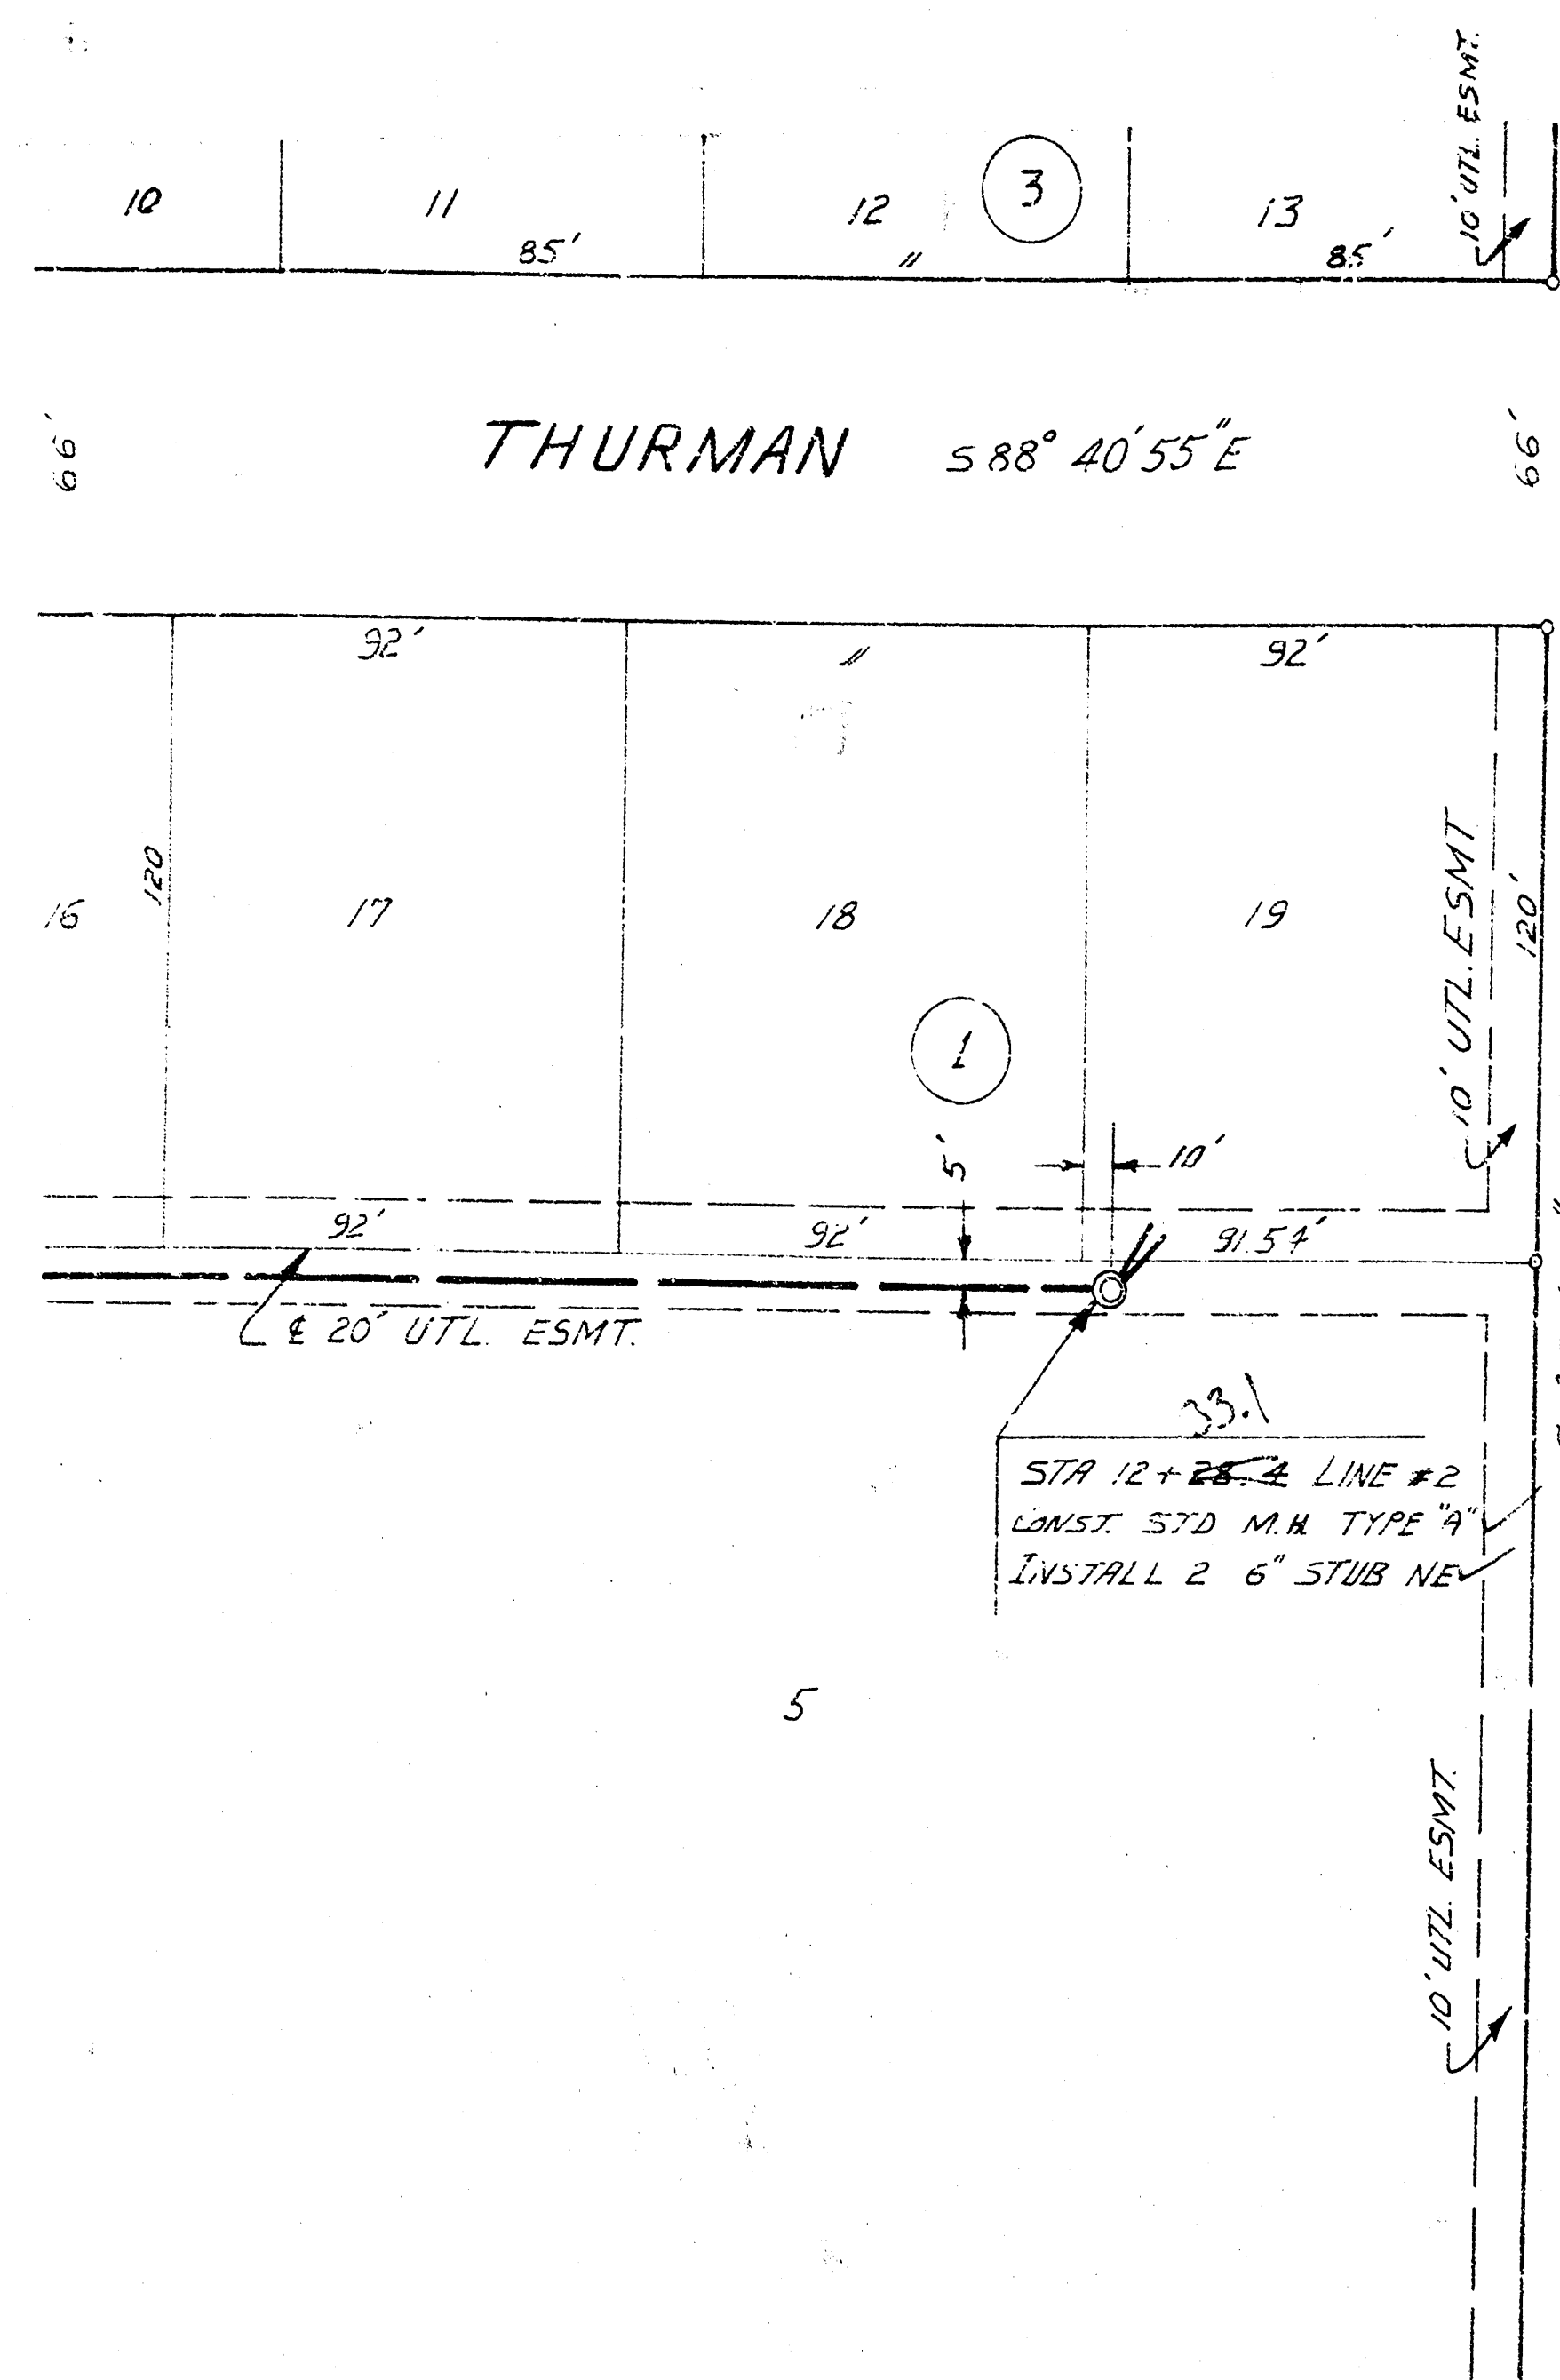

As Built
5/8/88
JFL

LAT. 66, WESTLINK SEWER
PROJ. NO. 468-76-245-80991-000-000-007

FILMED FROM THE BEST
AVAILABLE COPY