


CONSTRUCTION PLANS FOR
LATERAL 89
OF THE
WESTLINK SEWER

THE CITY OF WICHITA,
SEDGWICK COUNTY, KANSAS

INDEX OF SHEETS

SHEET NO. 1 TITLE SHEET
SHEET NO. 2 KEY MAP & PLAT
SHEET NO. 3-6 PLANS & PROFILES

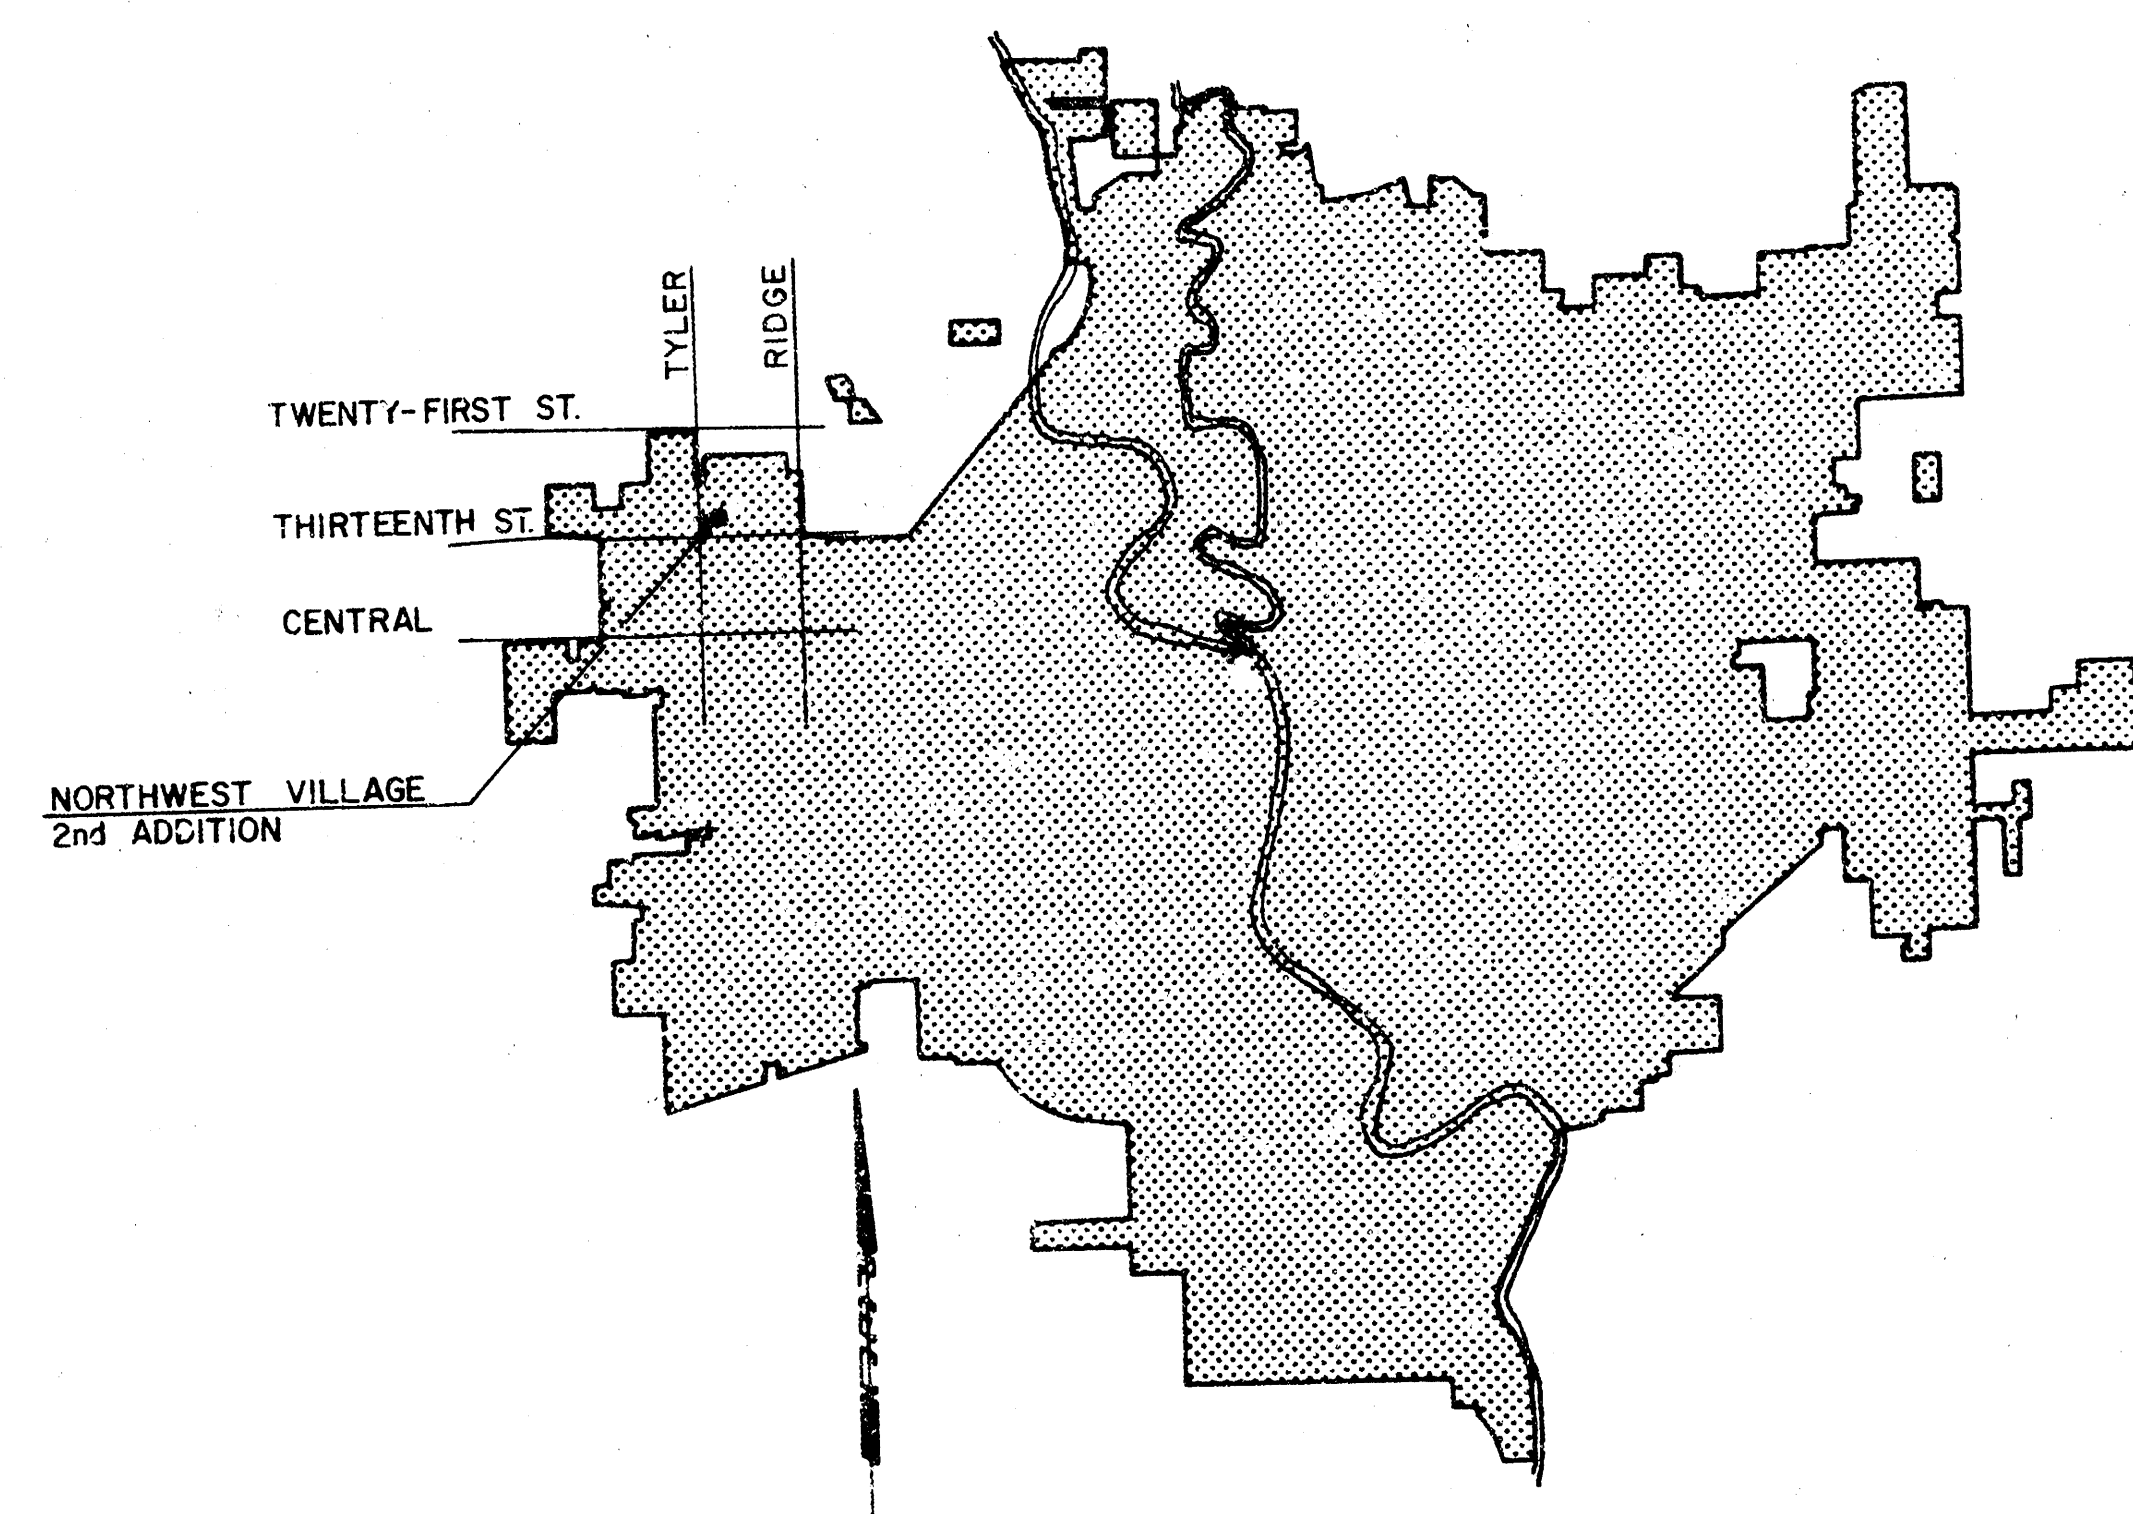

LOCATION MAP


CITY OF WICHITA PROJECT NO. 468-76-245-81119-000-000-001

MAY 1981

PLANS PREPARED BY

PROFESSIONAL ENGINEERING CONSULTANTS, P.A.
ENGINEERS
WICHITA, KANSAS

Handwritten: J. S. Bault
1/82

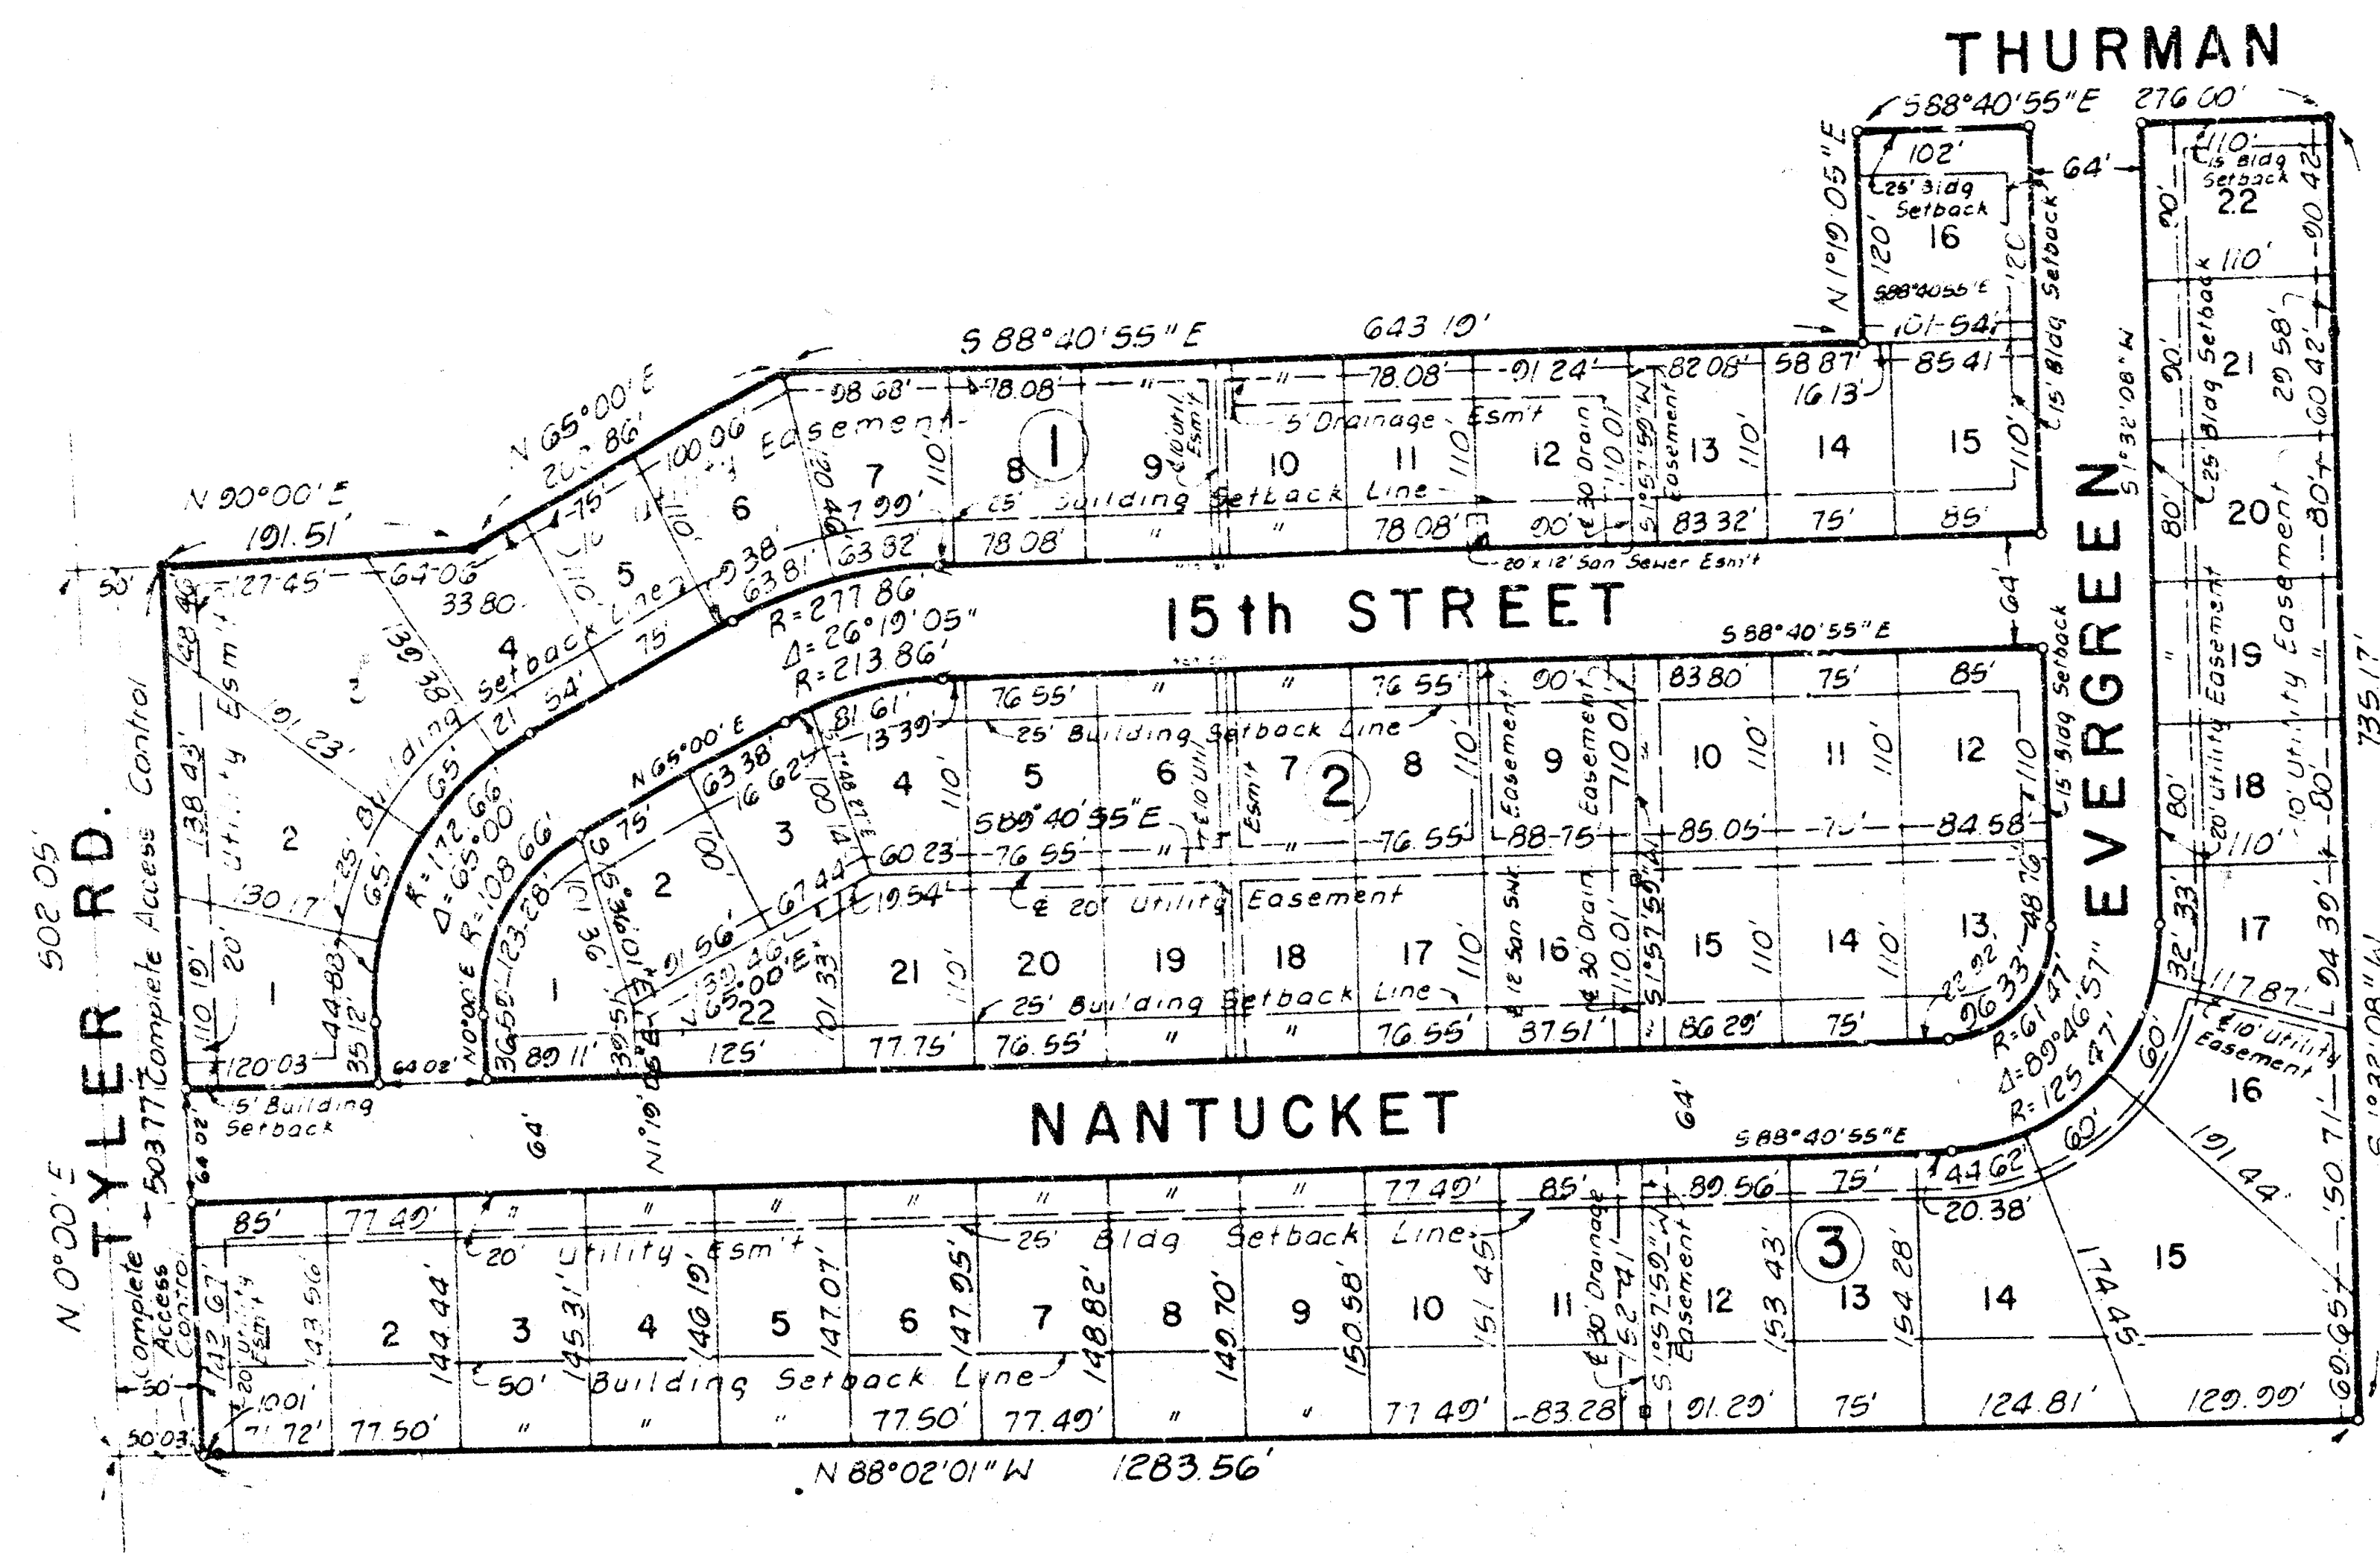

NORTHWEST VILLAGE 2nd ADDITION TO WICHITA, SEDGWICK COUNTY KANSAS

A REPLAT OF LOTS 5, 17, 18, & 19, BLK 1 NORTHWEST VILLAGE, WICHITA, SEDGWICK COUNTY, KANSAS

13th STREET

Sub Cor. SH 1/4, Sec 9, T27S,
R1W of the 6th PM.


Scale: 1" = 100'

• = Existing Iron
○ = Proposed Iron

SEWER LINE SCHEDULE	
LINE NO.	SHEET NO.
1	384
2	485
3	5
4	6

BENCH MARKS


BM - NW COR. 4"x4" CONC. PAD. W/C.O.W. MH BEHIND CB ON NW COR. OF TYLER AND 13TH ST. N. ELEV.=167.55
TBM - MH RIM NEAR SW COR. LOT 1, BLK. 1 NORTHWEST VILLAGE 2ND ADDITION. ELEV.=167.05

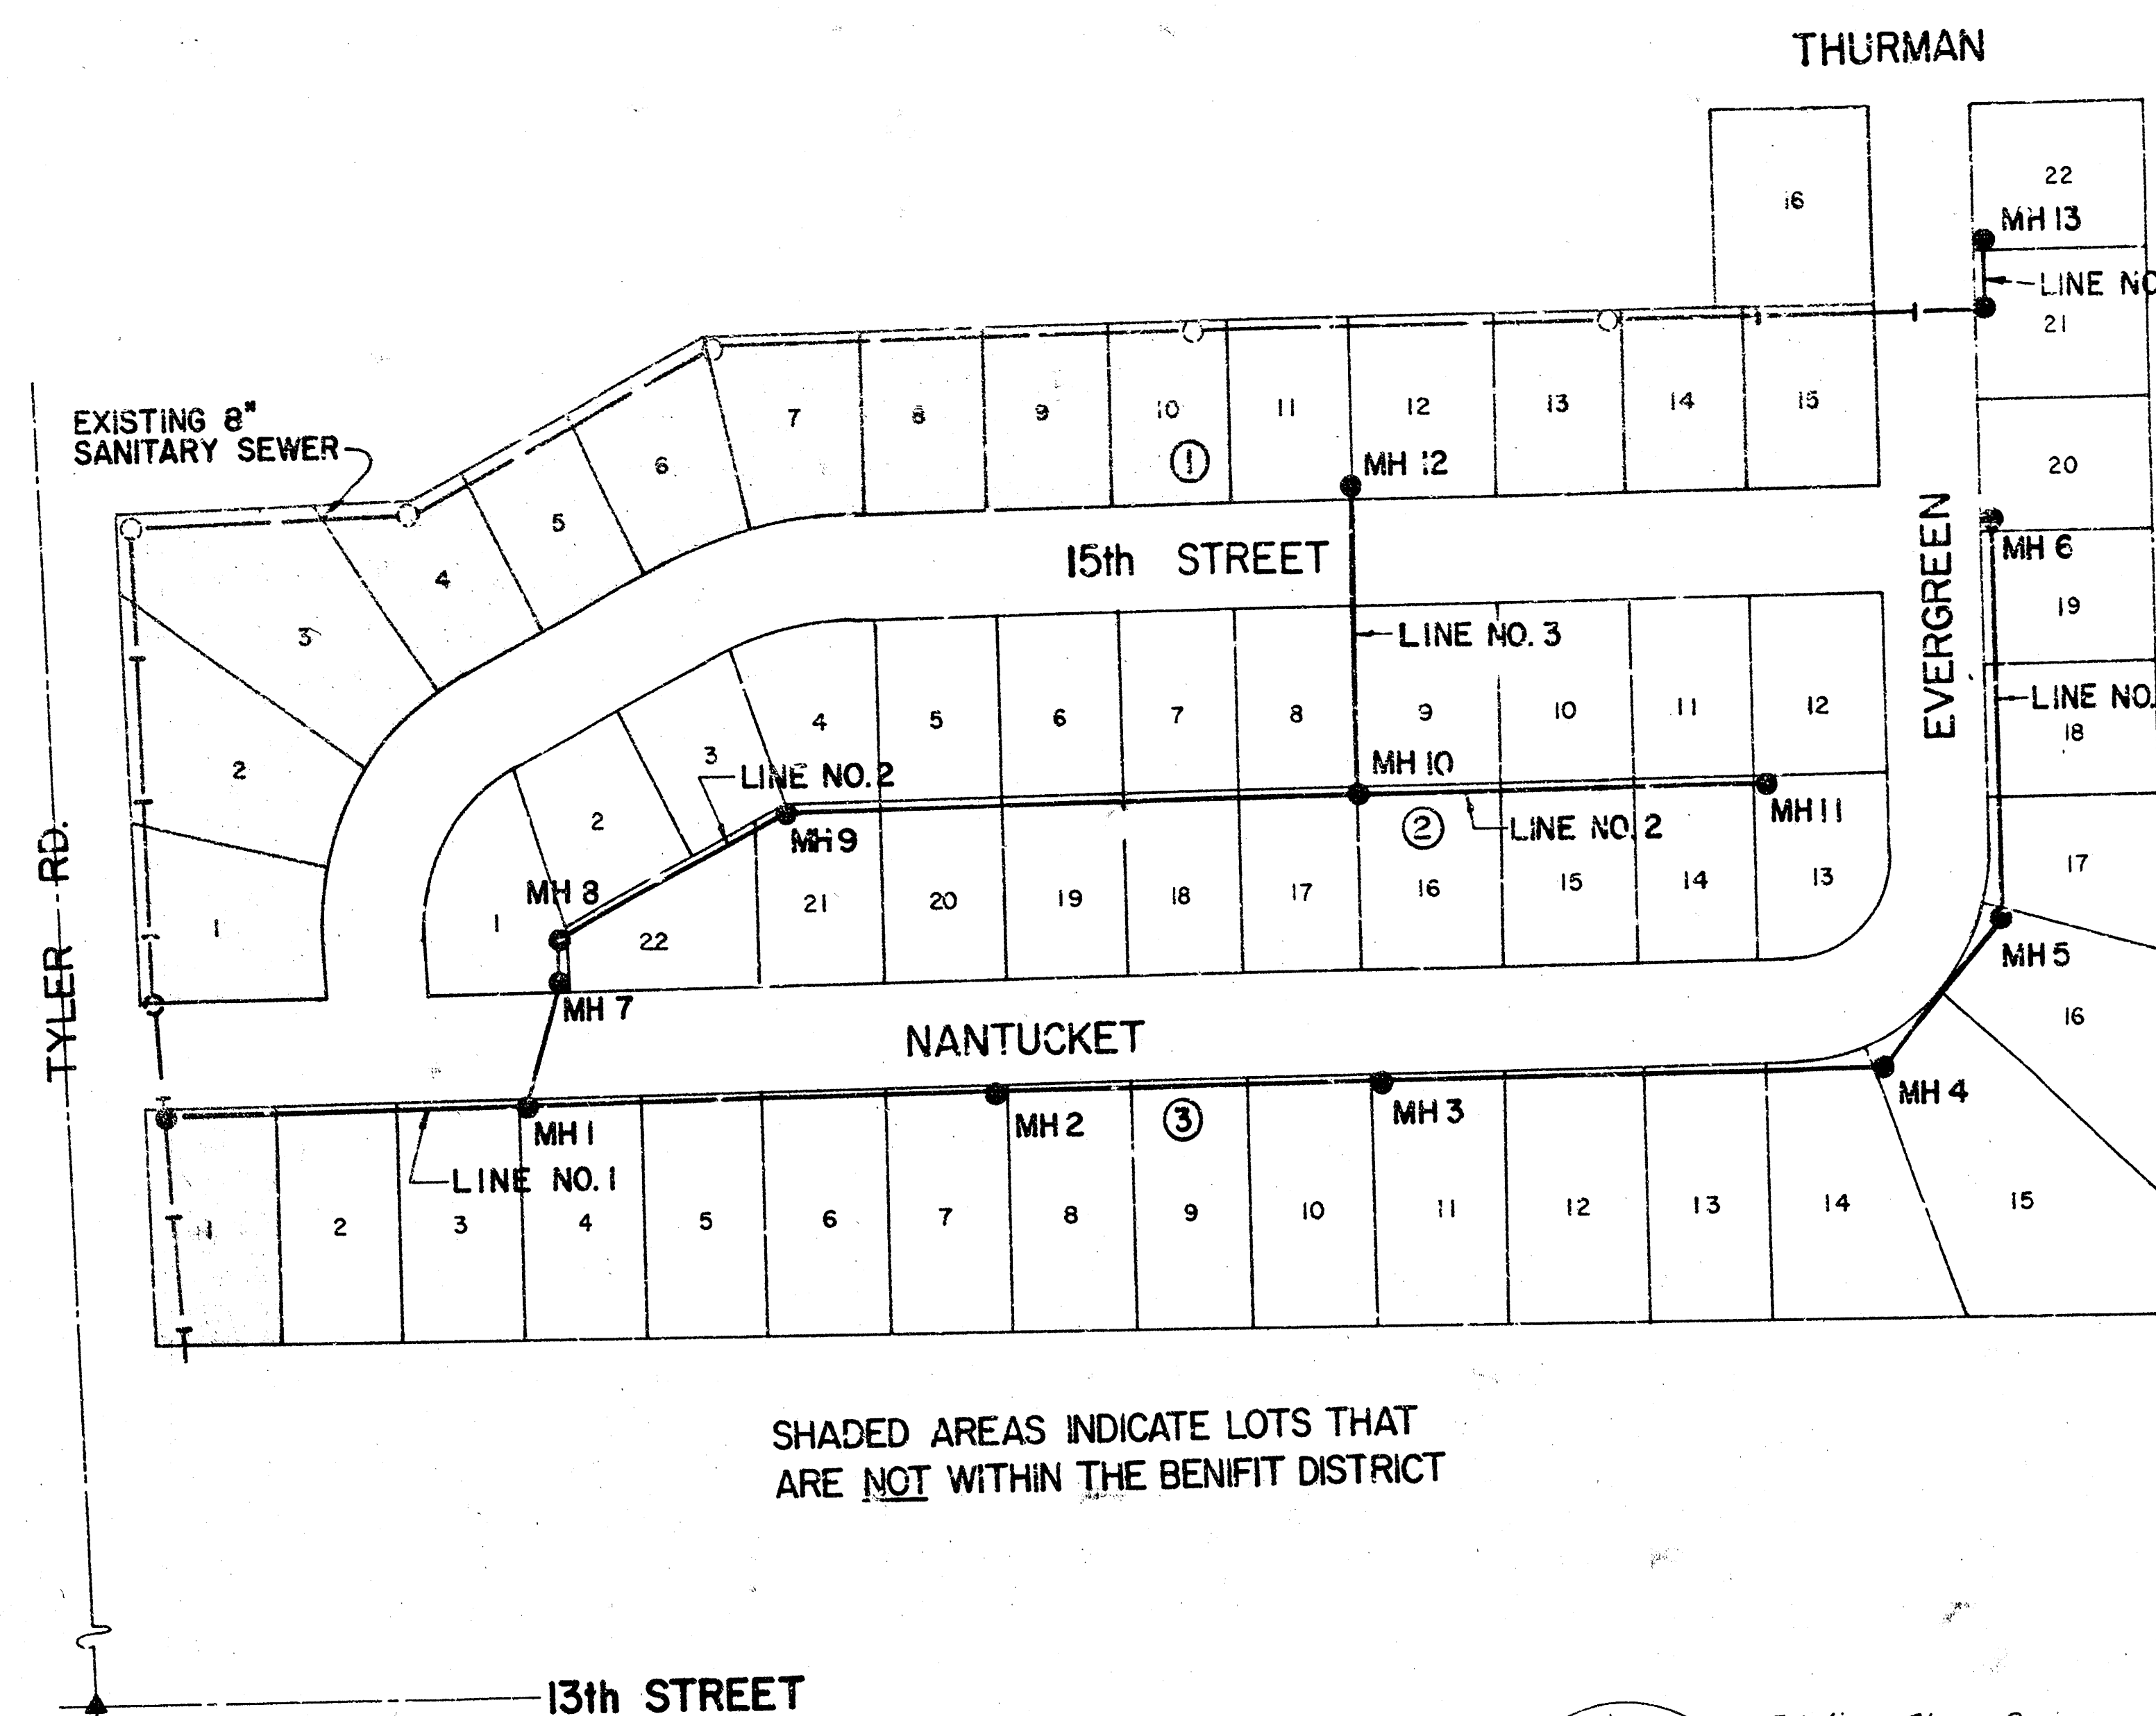

SHADED AREAS INDICATE LOTS THAT ARE NOT WITHIN THE BENEFIT DISTRICT




GENERAL NOTES

1. PRESERVATION OF PROPERTY IRONS. THE CONTRACTOR SHALL BE RESPONSIBLE FOR PRESERVING PROPERTY IRONS. THE CONTRACTOR SHALL BE REQUIRED TO RE-ESTABLISH ANY PROPERTY IRONS WHICH ARE DAMAGED OR DESTROYED BY HIS CONSTRUCTION OPERATIONS. SUCH IRONS SHALL BE RE-ESTABLISHED BY A LICENSED LAND SURVEYOR OR A LICENSED PROFESSIONAL ENGINEER IN ACCORDANCE WITH APPLICABLE STATE LAWS.
2. PRIOR TO BEGINNING CONSTRUCTION, THE CONTRACTOR SHALL VERIFY THE HORIZONTAL AND VERTICAL LOCATION OF THE EXISTING 8" SANITARY SEWER AT THE BEGINNING OF LINE NO. 1. IF ANY DISCREPANCIES ARE FOUND REGARDING FIELD LOCATIONS AND PLAN LOCATIONS IN THESE AREAS, THE CONTRACTOR SHALL CONTACT THE ENGINEER FOR THE NECESSARY FIELD ADJUSTMENT CALCULATIONS PRIOR TO PROCEEDING.
3. ALL CONSTRUCTION AND MATERIALS TO COMPLY WITH CITY OF WICHITA SPECIFICATIONS AND STANDARDS.
4. SEWER LINES TO BE INSPECTED BY THE DEPARTMENT OF PUBLIC WORKS ENGINEERING DIVISION.
5. AT LEAST 48 HOURS PRIOR TO BEGINNING EXCAVATION (EXCLUDING WEEKENDS AND HOLIDAYS), THE CONTRACTOR SHALL CONTACT THE UTILITY LOCATION SERVICE "KAN-U-DIG-IT" AT (316)267-2889 TO REQUEST THE FOLLOWING UTILITY COMPANIES TO LOCATE ANY EXISTING LINES WITHIN THE PROJECT AREA: GAS SERVICE COMPANY, K.G.S.E., SOUTHWESTERN BELL TELEPHONE COMPANY, AND THE WICHITA WATER DEPARTMENT.
6. EXCESS EXCAVATED MATERIAL AND OTHER DEBRIS SHALL BE WASTED AS DIRECTED BY THE ENGINEER.
7. ALL PROPERTY IRONS DISTURBED BY THE CONTRACTOR SHALL BE RESET AT THE CONTRACTOR'S EXPENSE AS DIRECTED BY THE ENGINEER.
8. THE CONTRACTOR SHALL BE RESPONSIBLE FOR MAINTAINING CONTINUOUS FLOW OF SEWAGE THROUGH THE EXISTING SEWERS DURING CONSTRUCTION. THE CONTRACTOR'S PROPOSED METHOD FOR MAINTAINING SEWAGE FLOW SHALL BE APPROVED BY THE ENGINEER. ANY COST OF MAINTAINING FLOW OF SEWAGE DURING CONSTRUCTION WILL NOT BE PAID FOR DIRECTLY BUT SHALL BE CONSIDERED SUBSIDIARY TO THE OTHER ITEMS OF WORK.
9. ALL ELEVATIONS SHOWN ARE CITY OF WICHITA DATUM. (USGS-1187.4+ CITY DATUM)

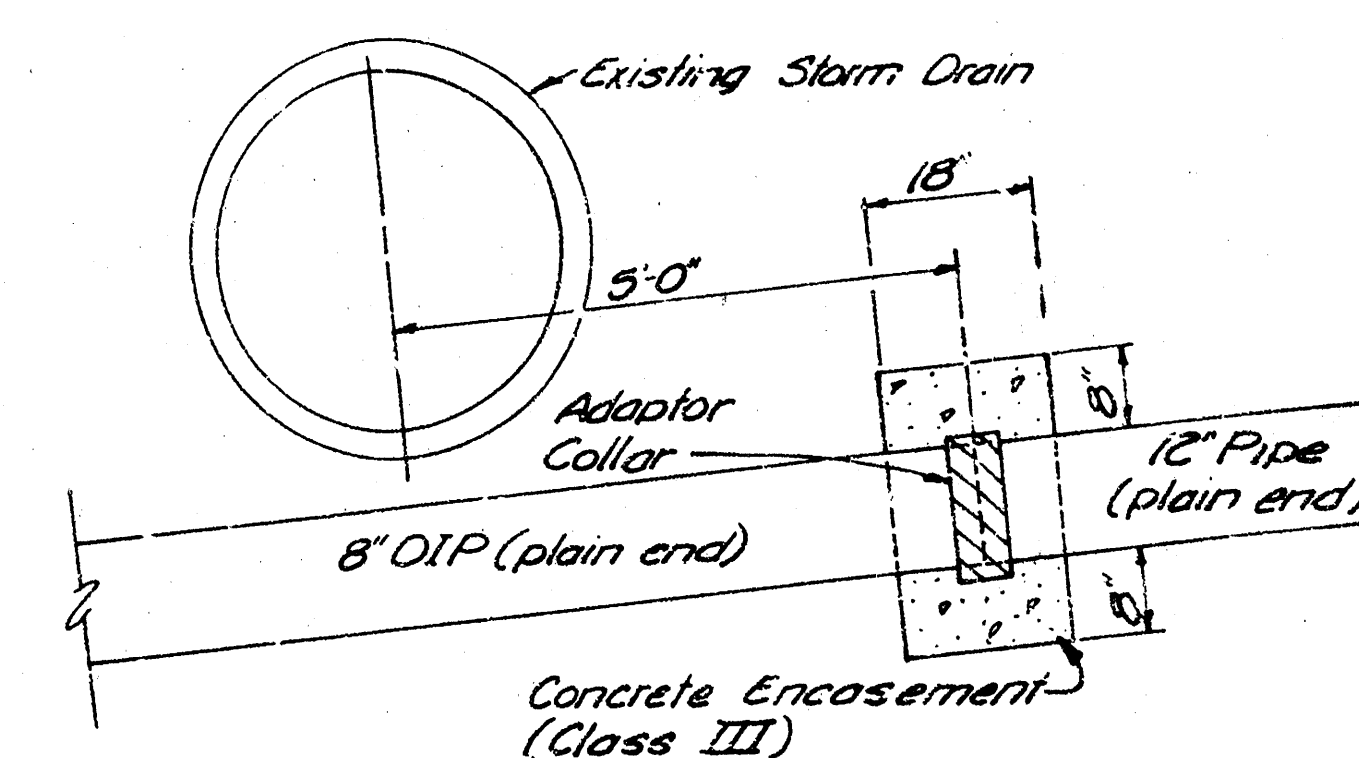



8" DIP TO 8" PIPE DETAIL

	Revision		By	Date	
	CITY OF WICHITA, KANSAS LATERAL 69 WESTLINK SEWER				
	KEY MAP AND FINAL PLAT NORTHWEST VILLAGE 2nd ADDITION C.O.W. PROJECT NO. 468-76-249-37-119-000-000-001				
	PROFESSIONAL ENGINEERING CONSULTANTS, P.A. ENGINEERS WICHITA, KANSAS				
Designed by	MDS	Job No.	34-B-1126	Sht.	4 of 6
Drawn by	GD, CL	Date	May 1981		


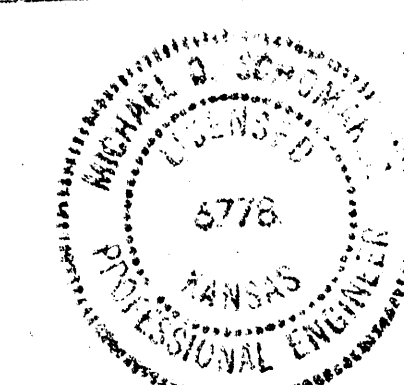
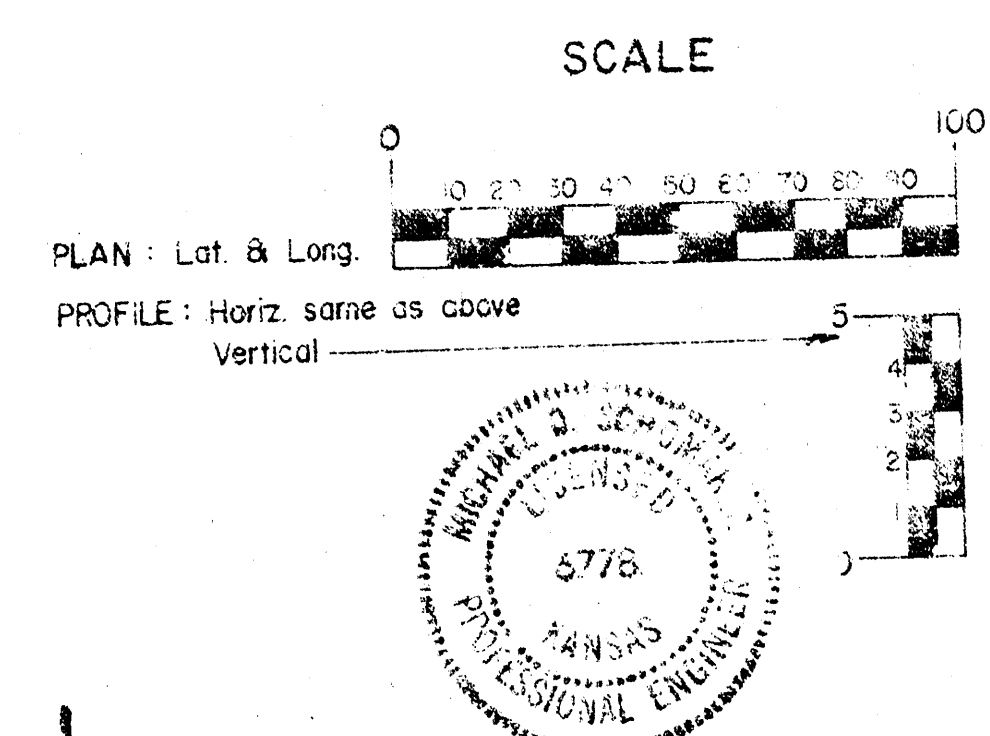
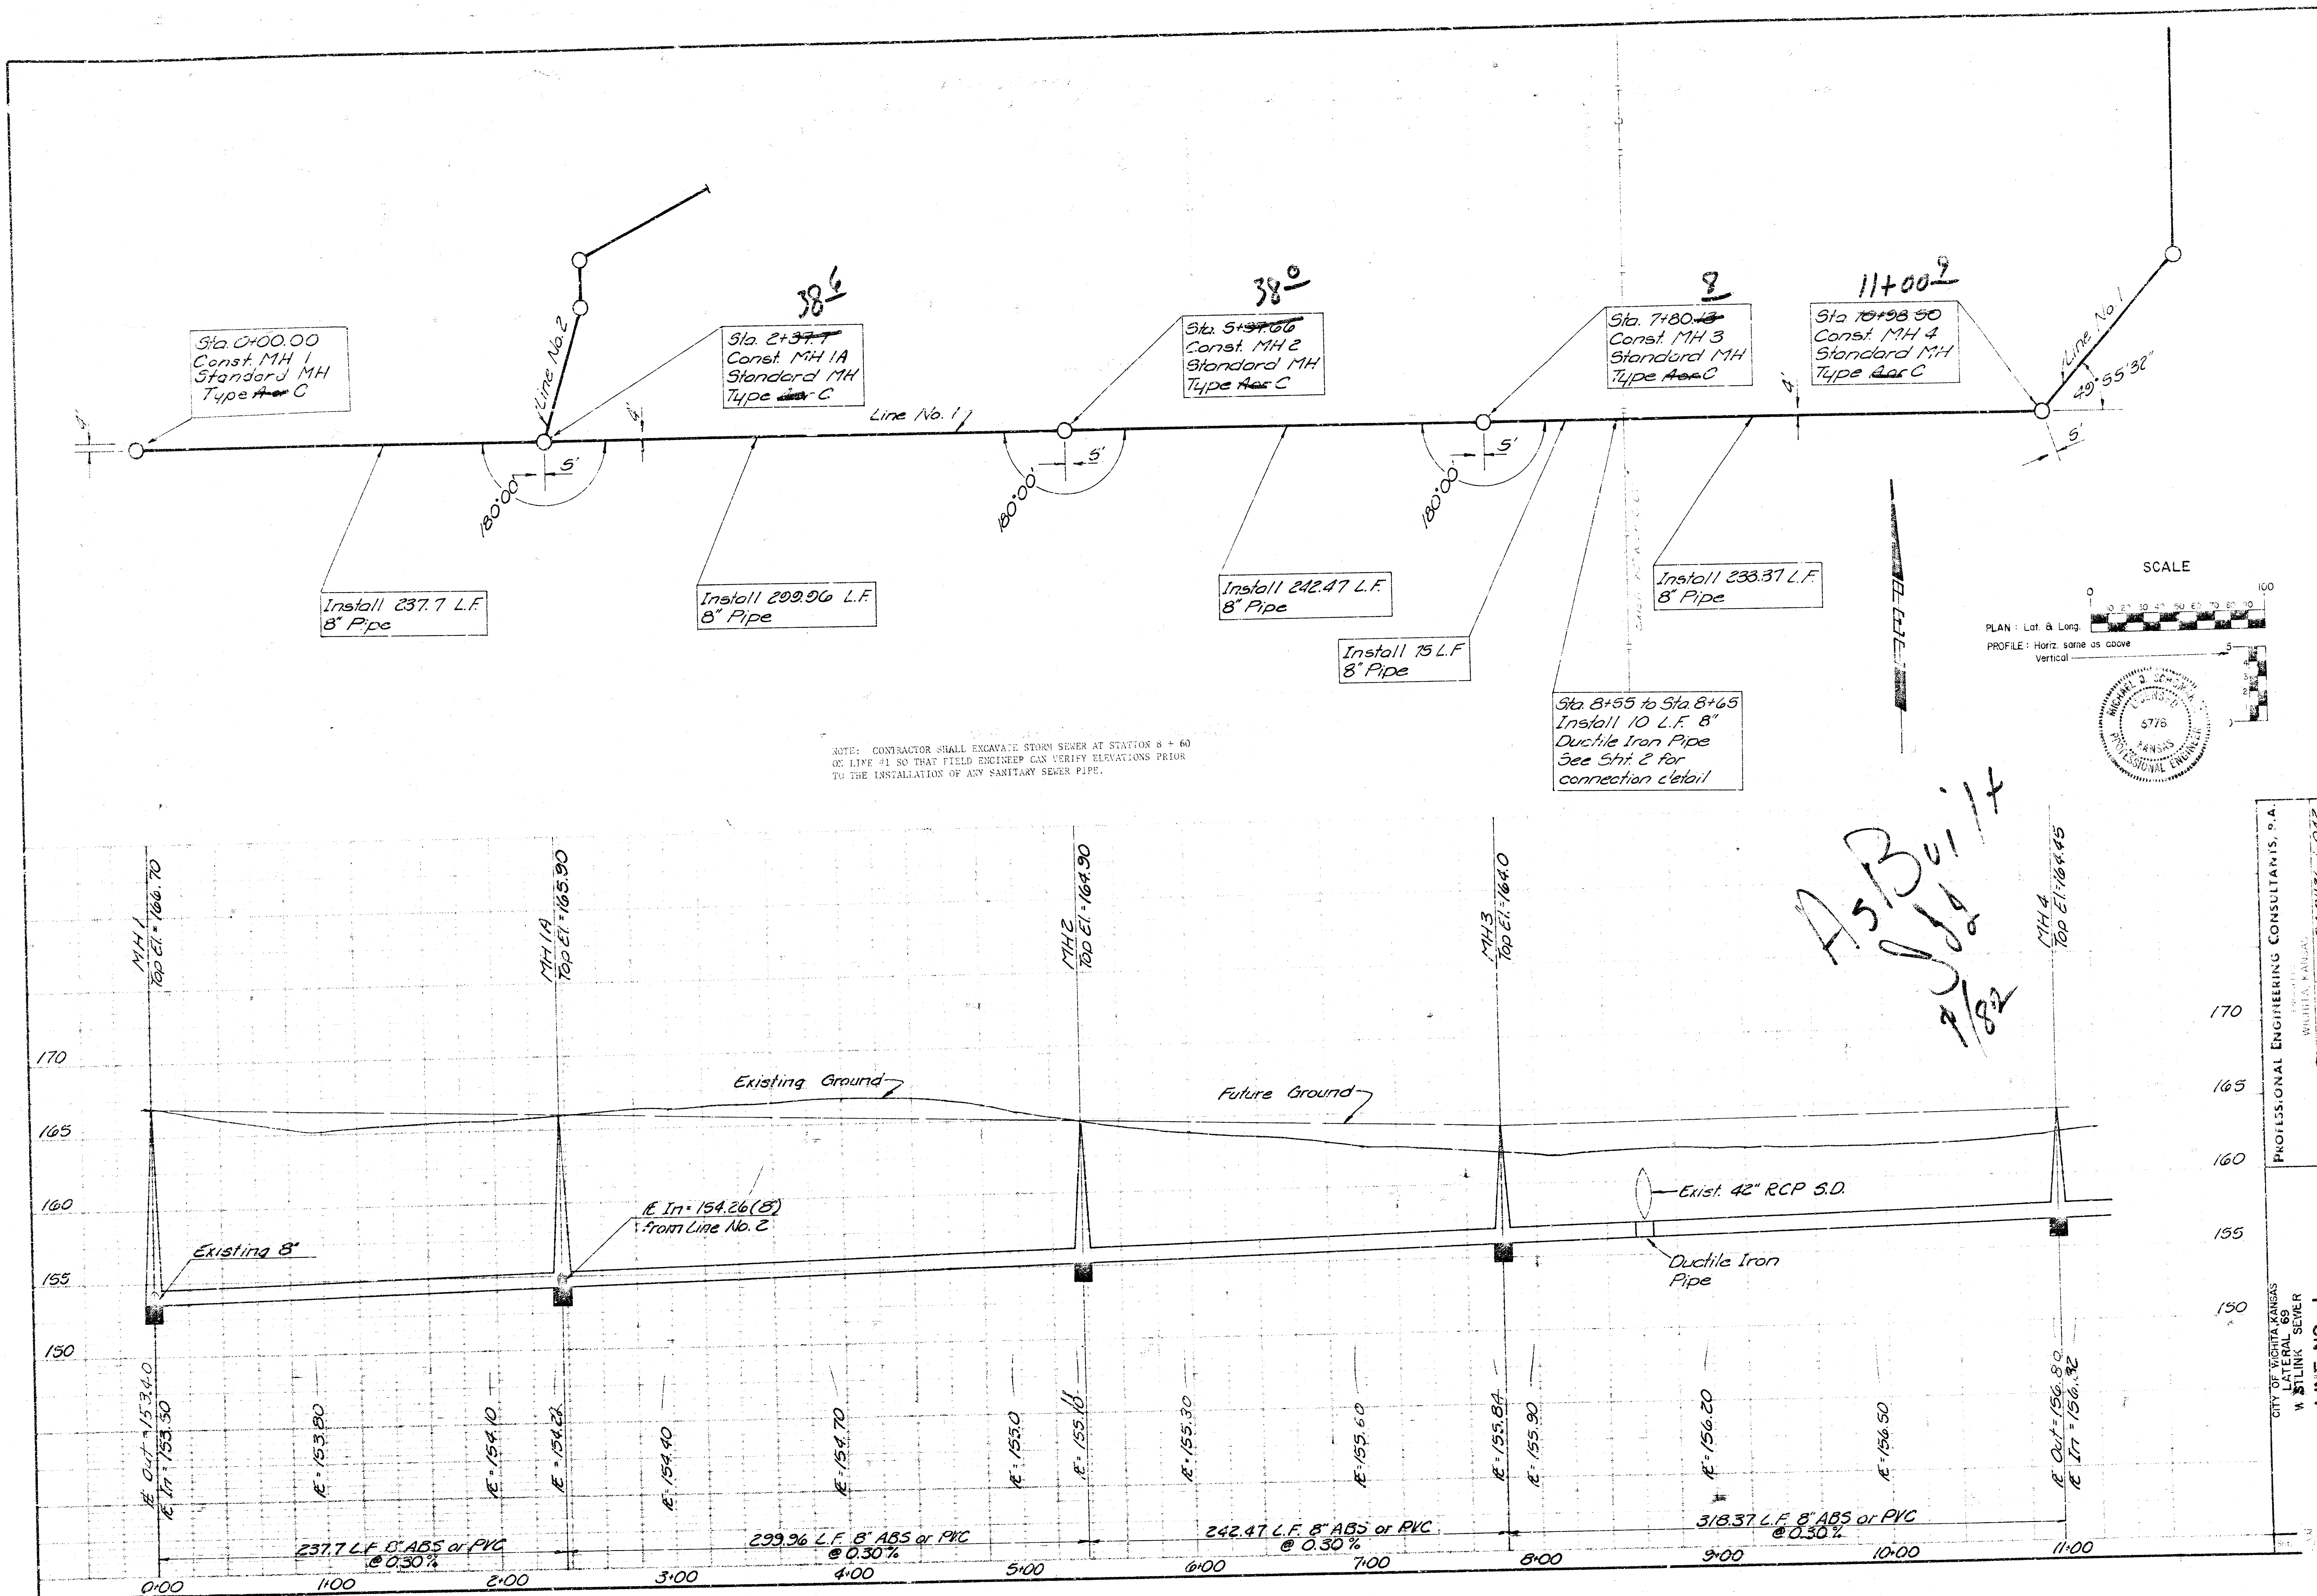


CITY OF VICTORIA KANSAS
LATERAL 69
W. SYLWIK SEWER
LINE NO. 1
NORTHWEST VILLAGE 2nd ADDITION
C.O.P. PROJECT NO. 1991-01-000-001-001


PROFESSIONAL ENGINEERING CONSULTANTS, P.A.
WILLIAM K. KARPAS
No. 5718
Date: May 1991

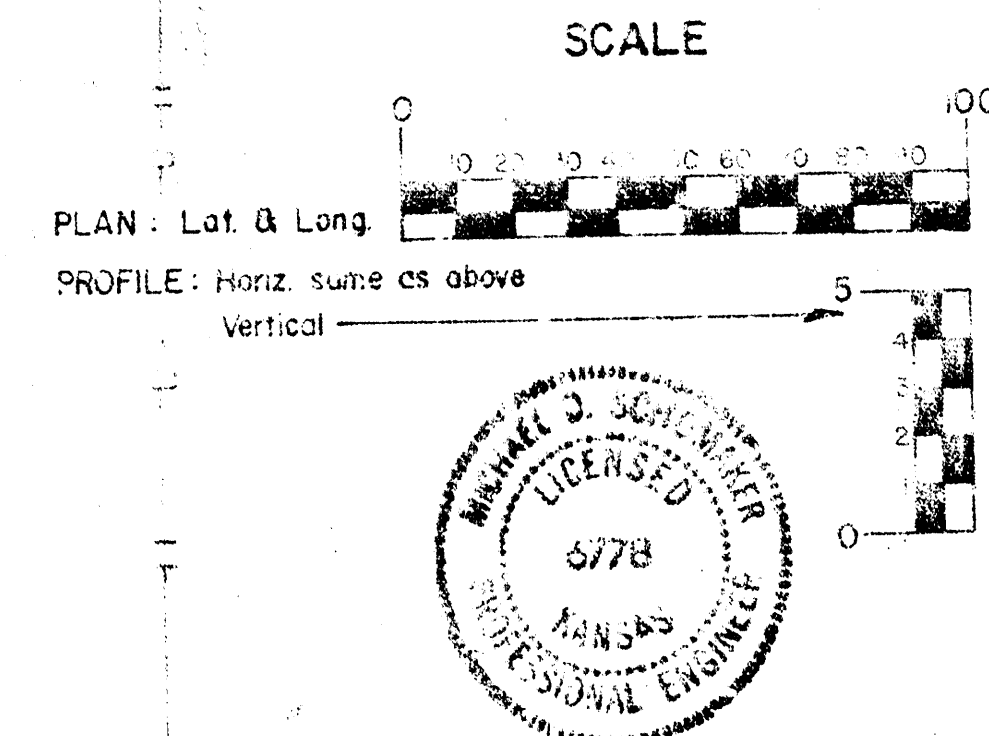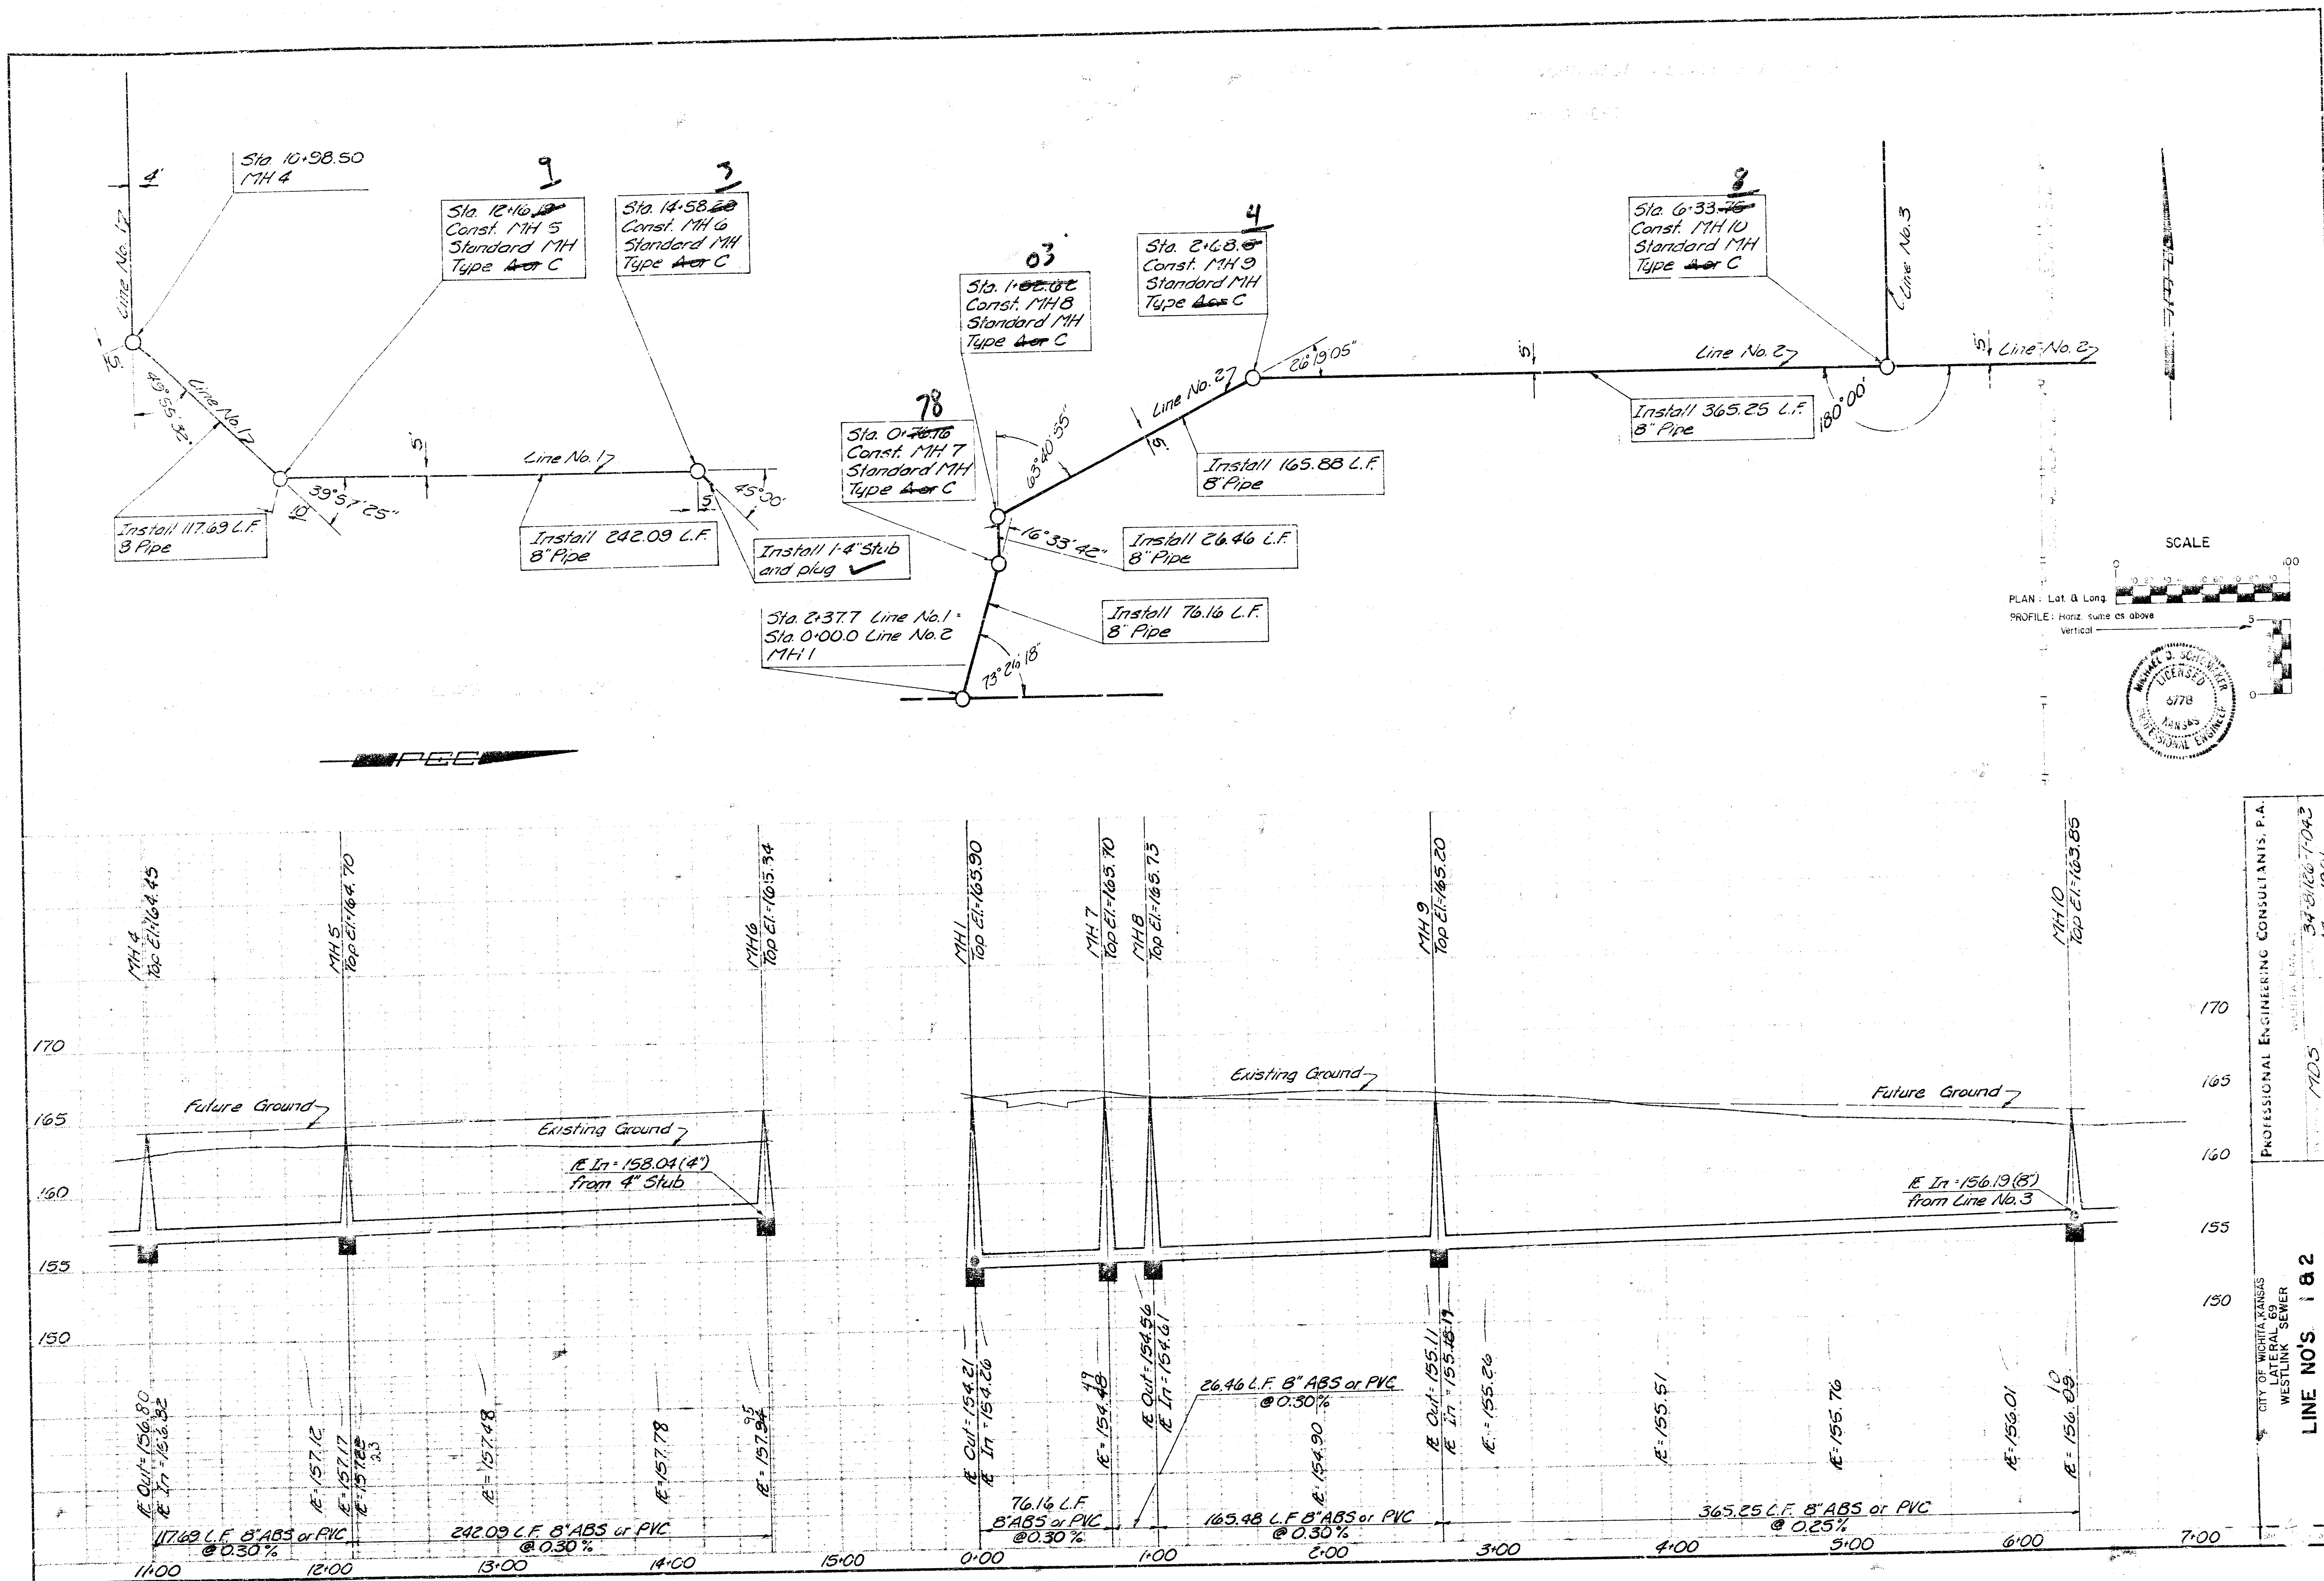

PROFESSIONAL ENGINEERING CONSULTANTS, P.A.
CITY OF WICHITA KANSAS
NORTHWEST VILLAGE 2nd ADDITION
C.O.F.W. PROJECT NO. 462-76-244-81119-000-000-001
LINE NO'S. 1 & 2
34-B106-1042
MD-5
3D
May 1961

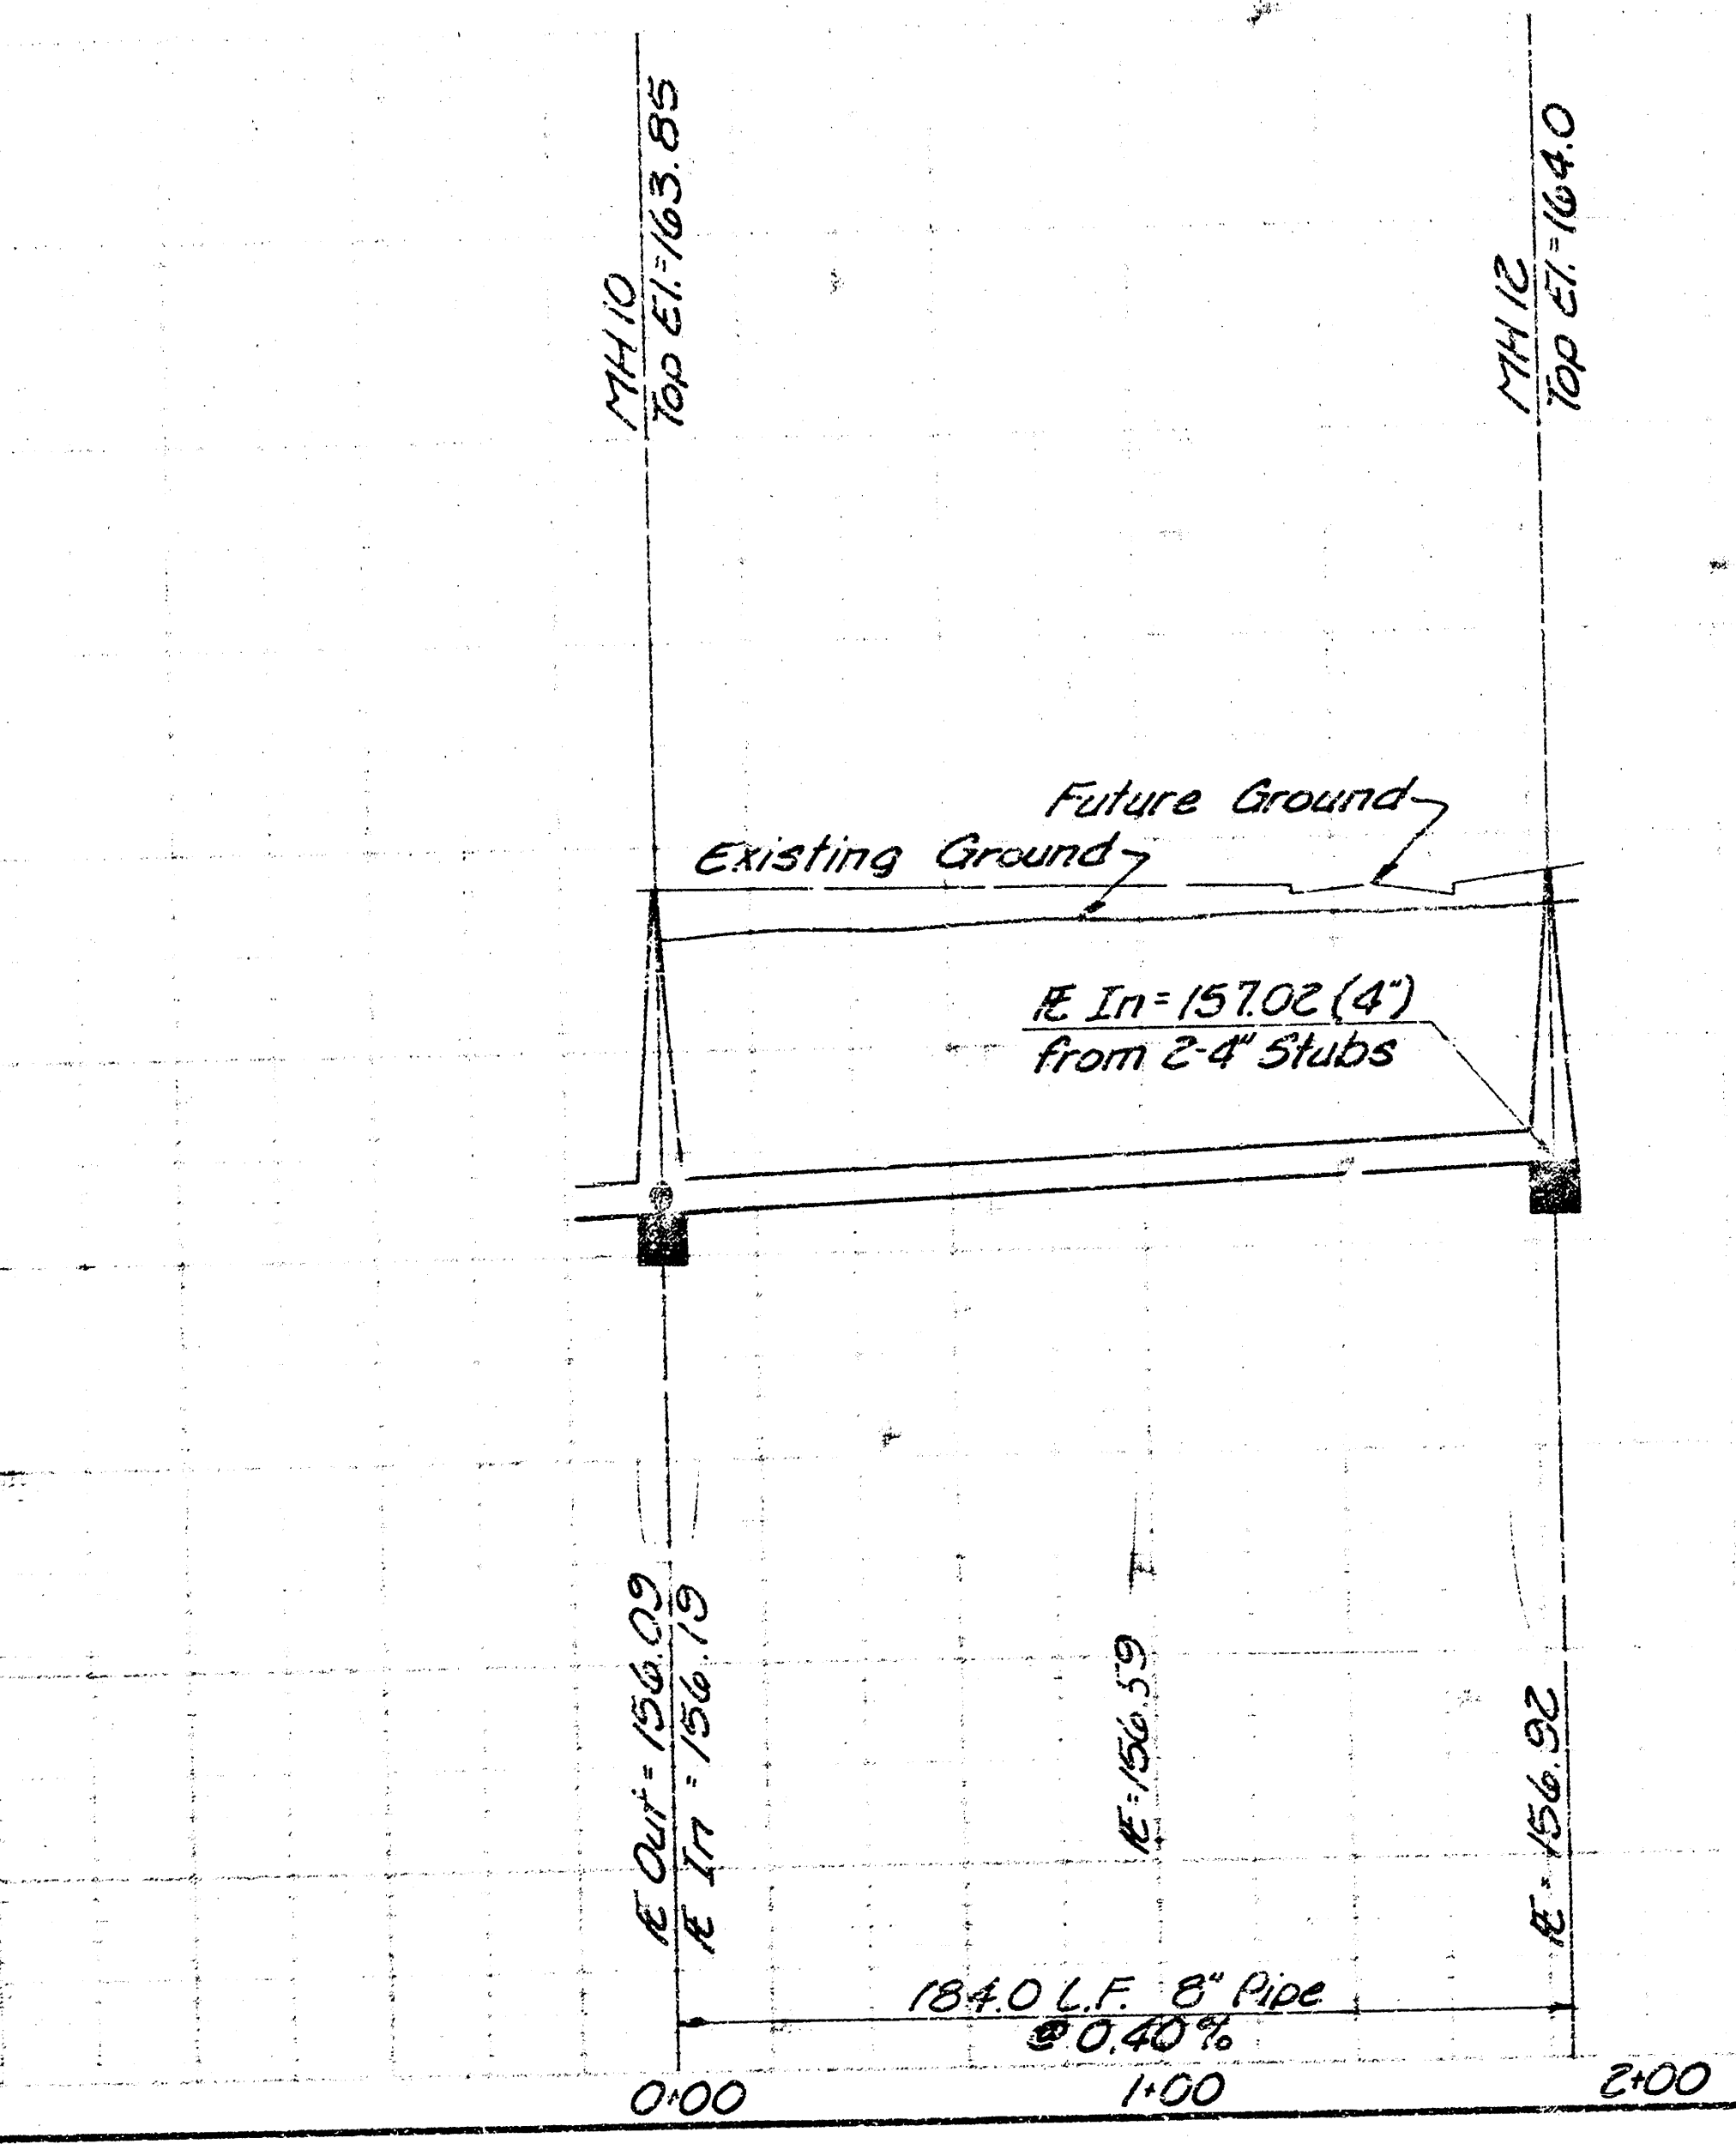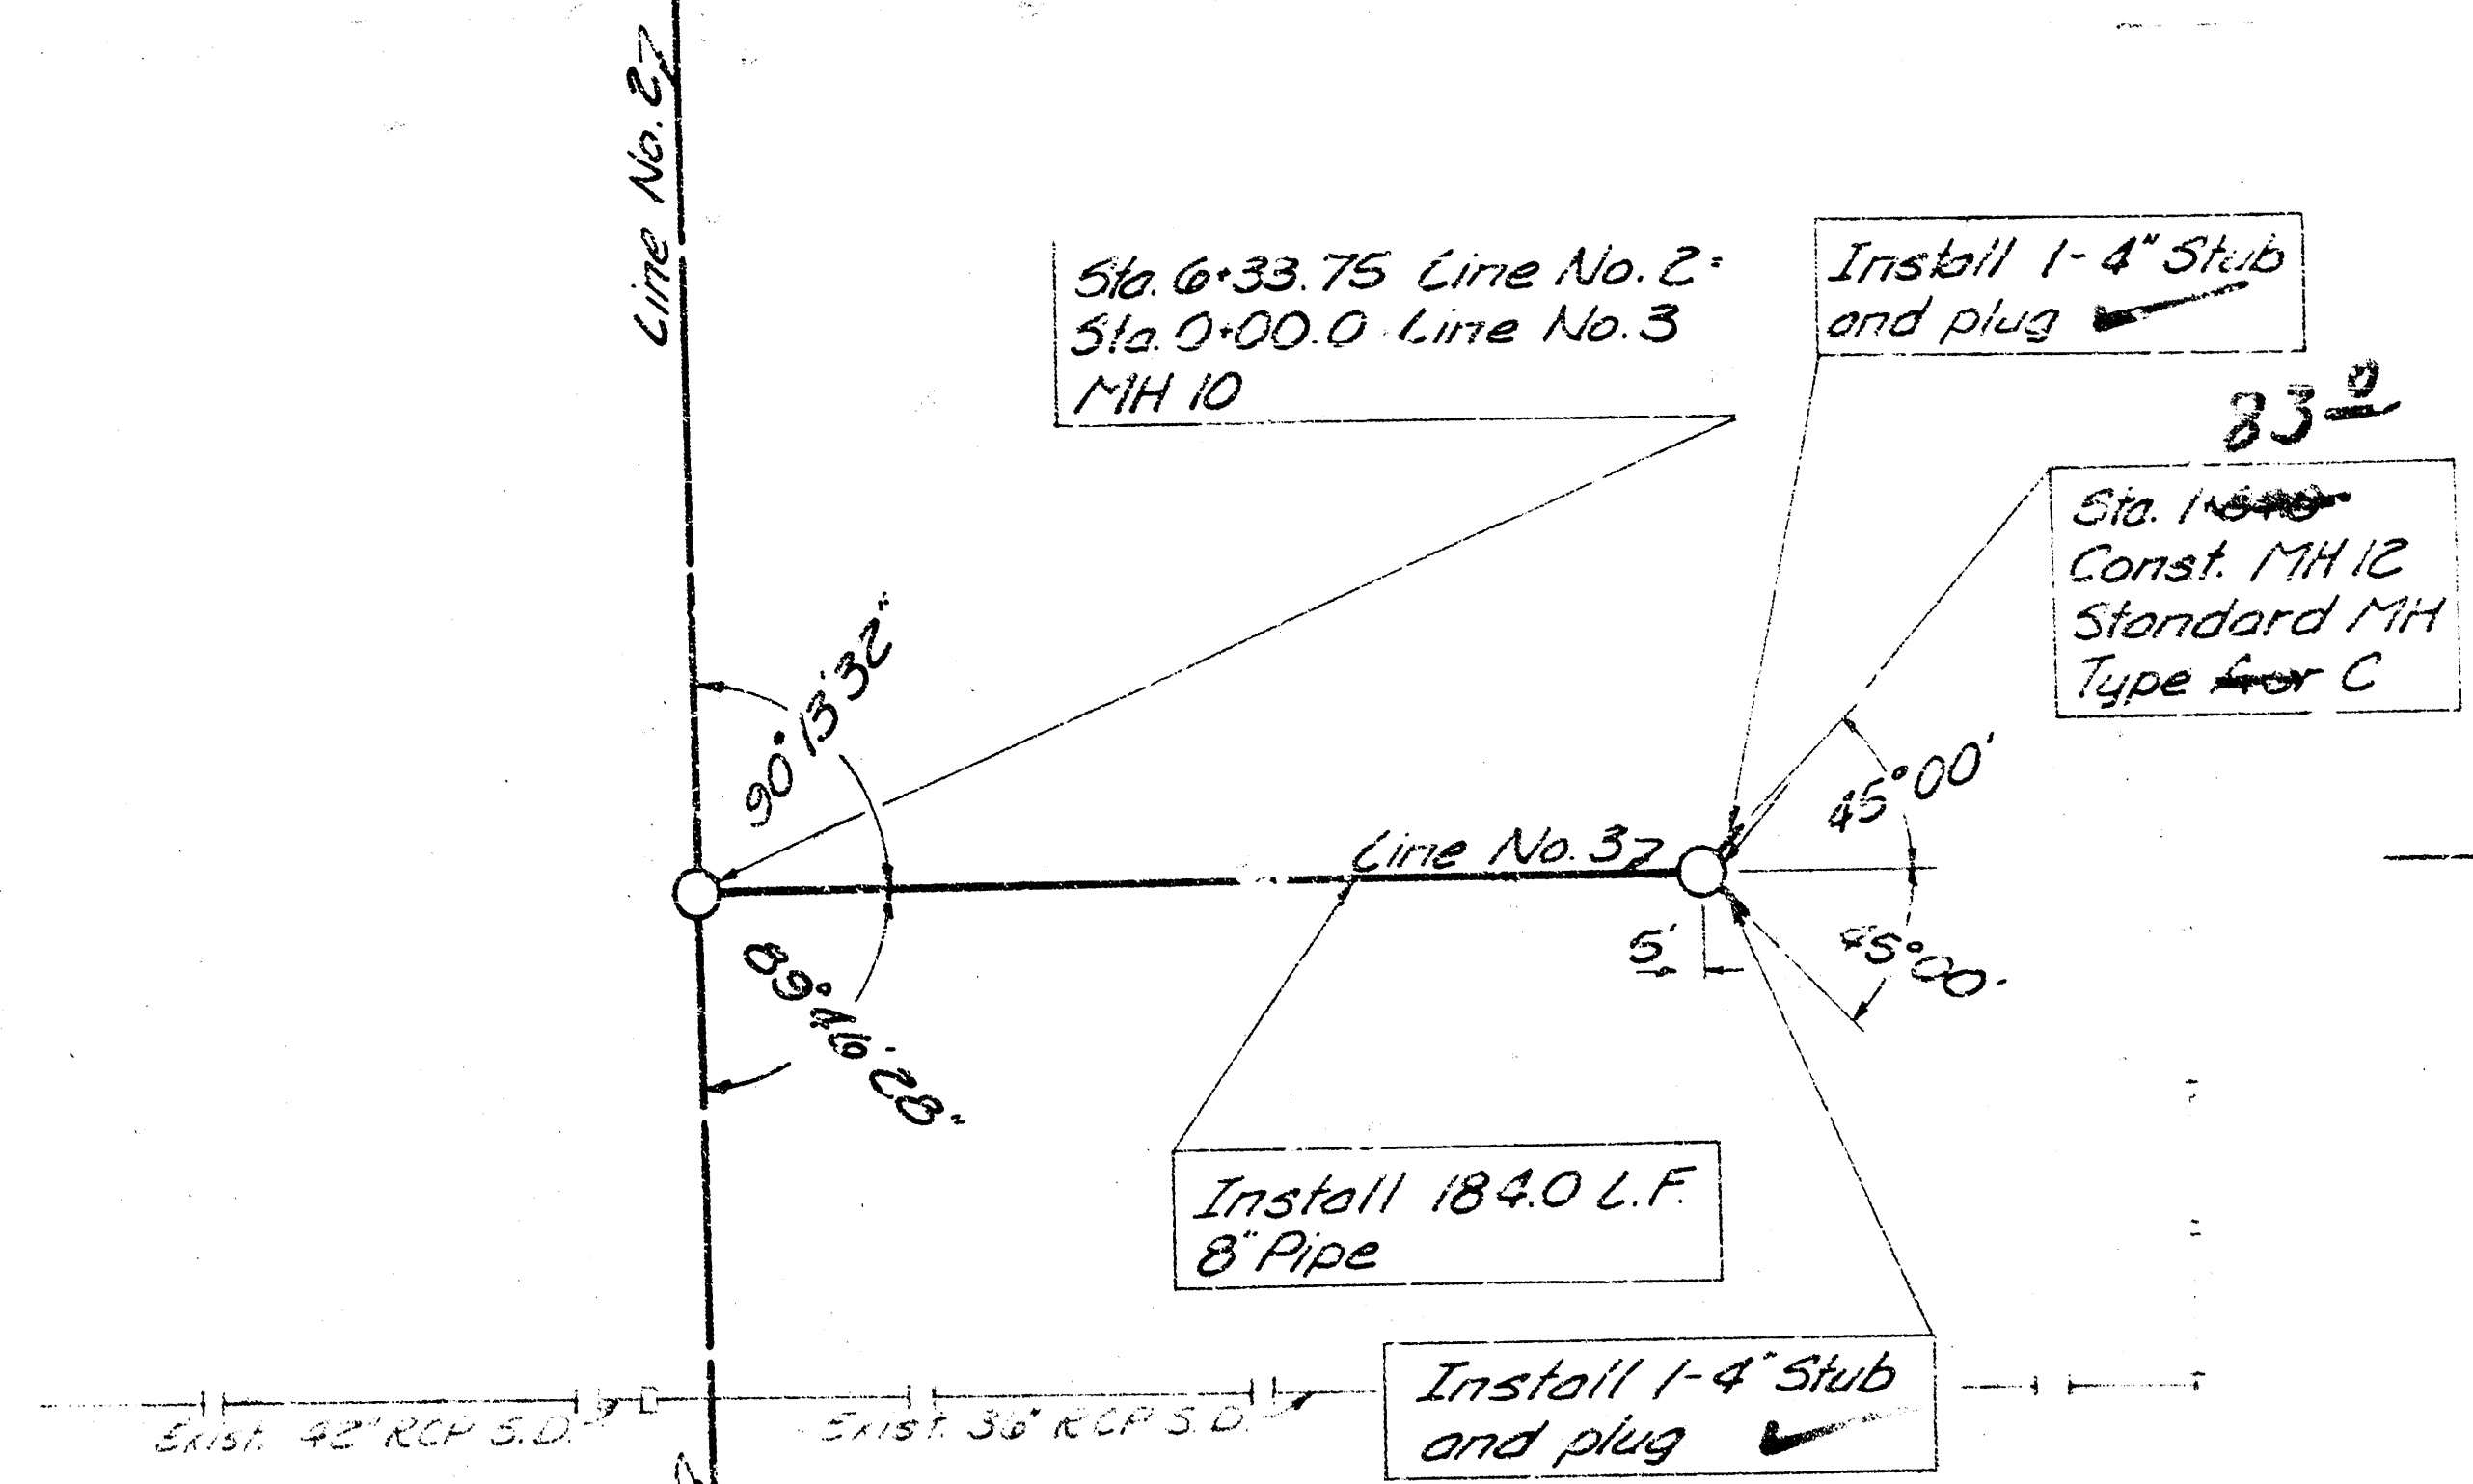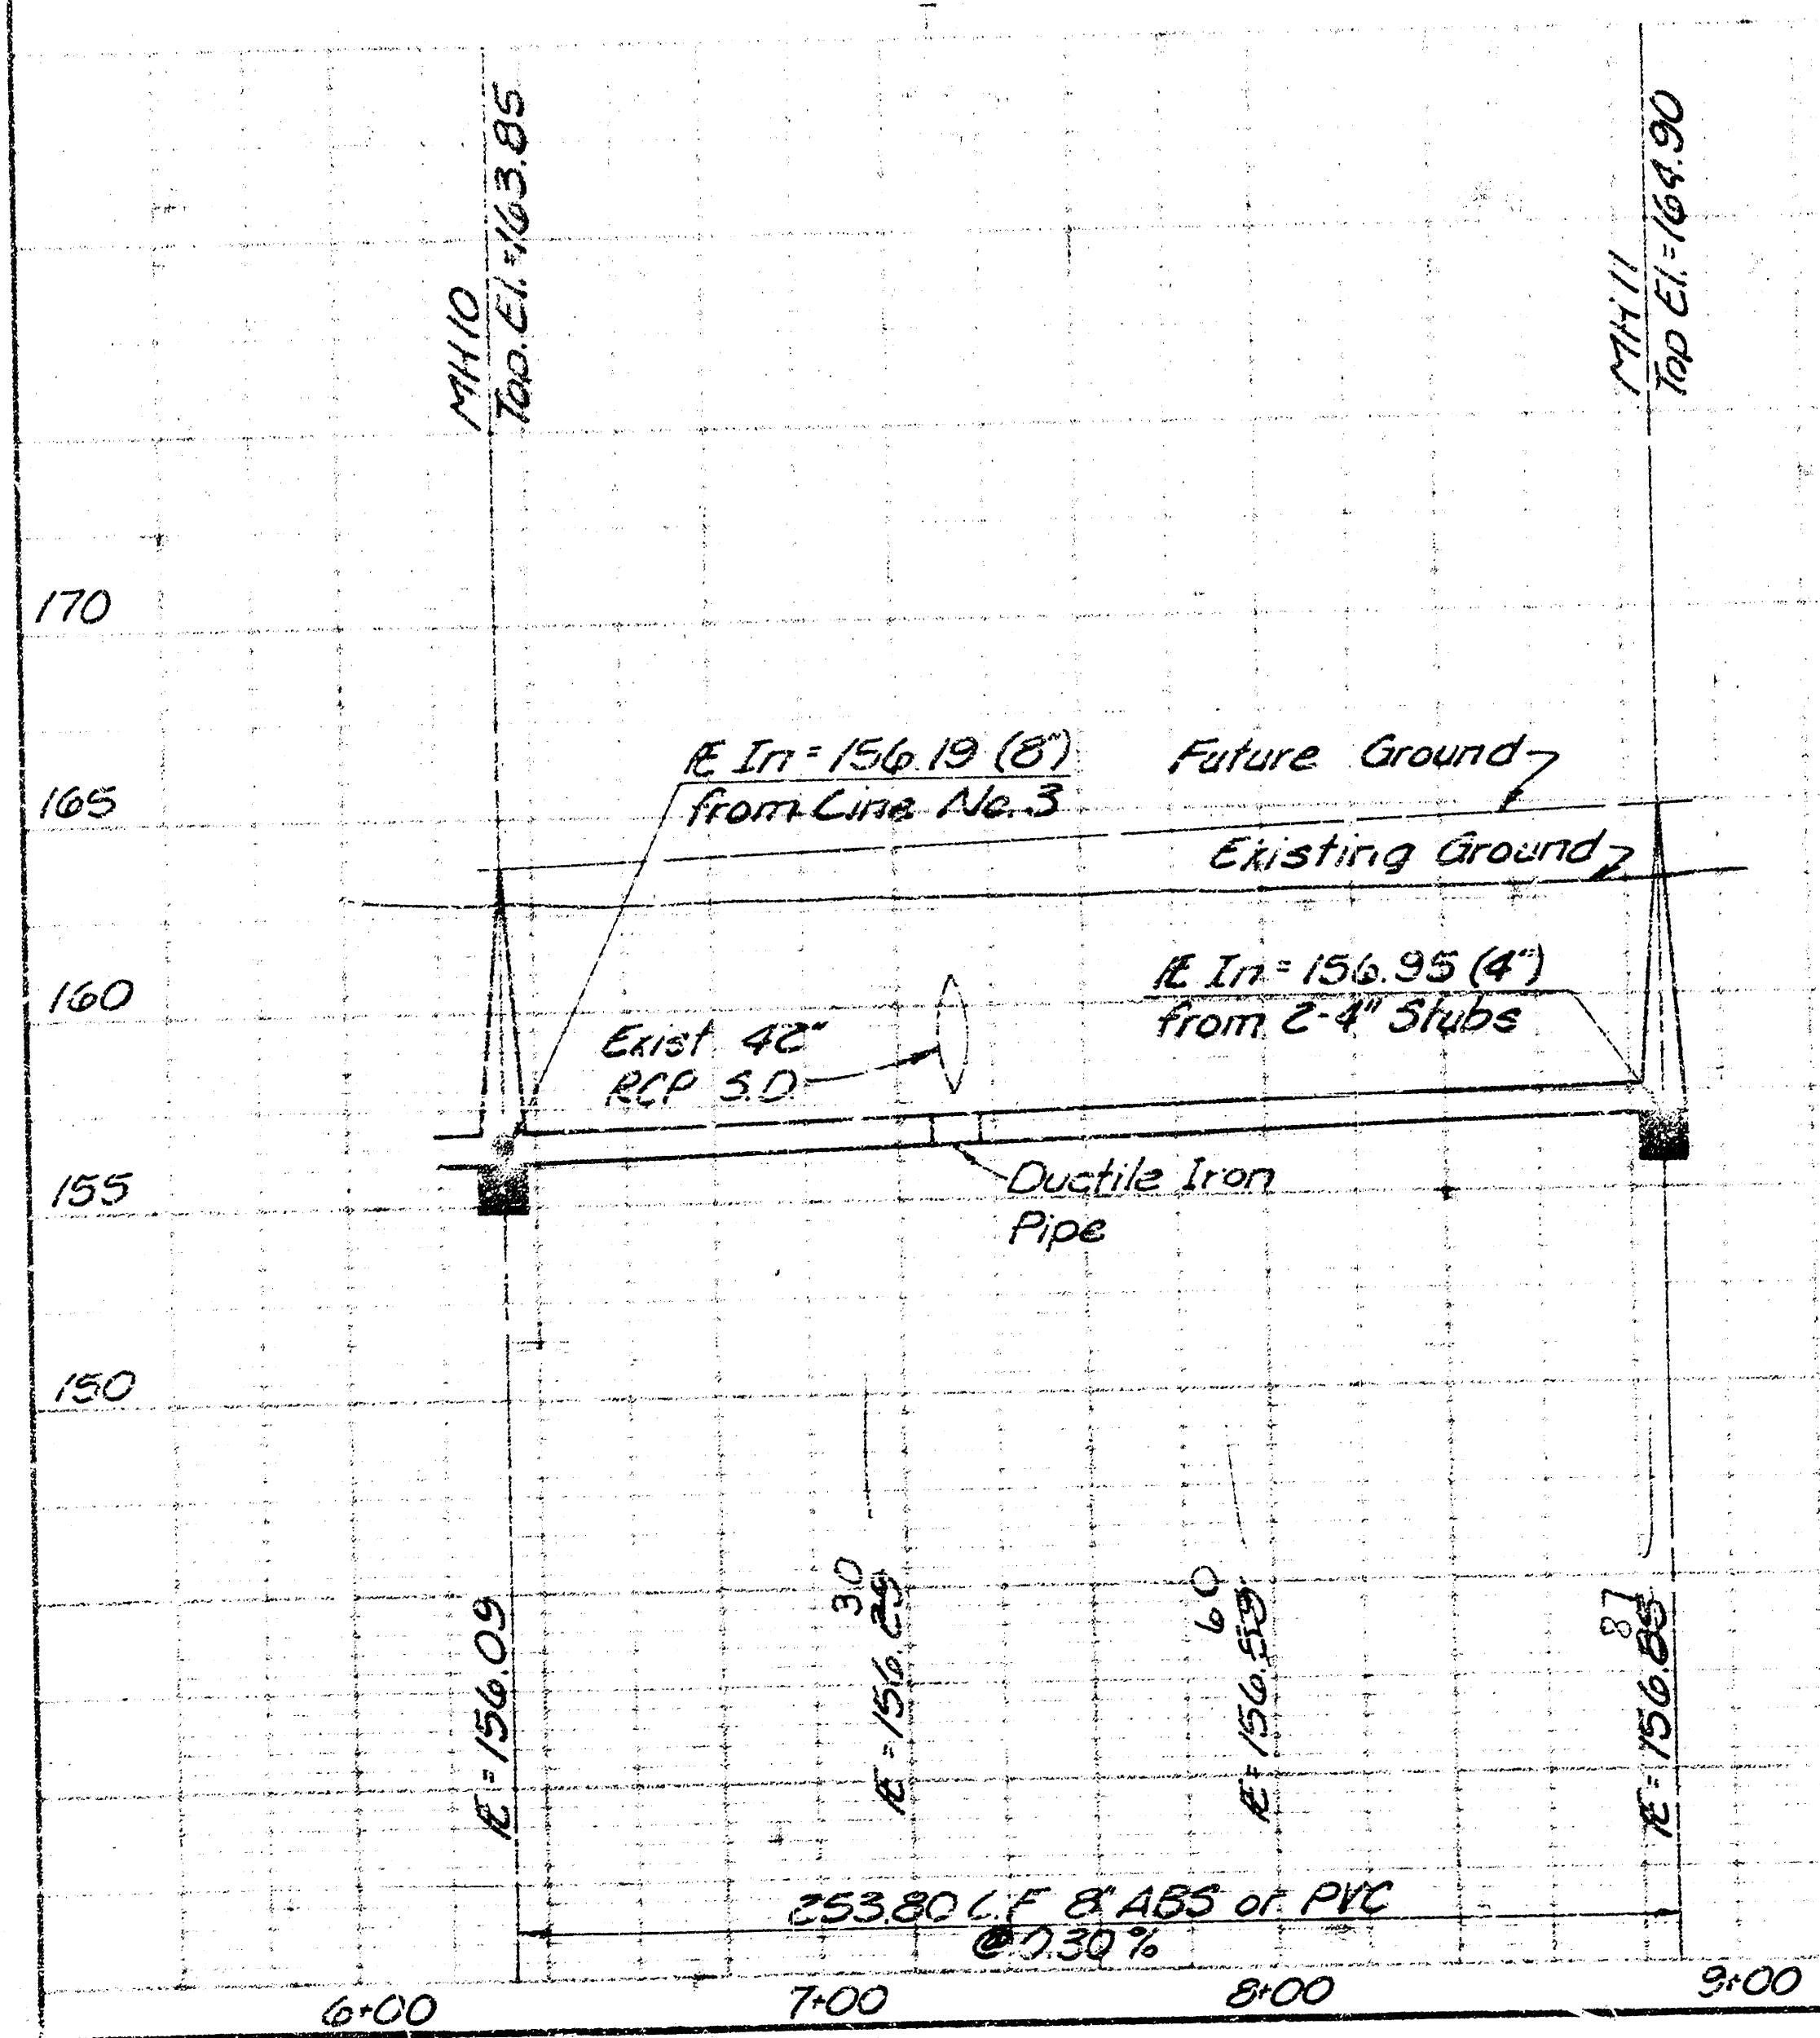
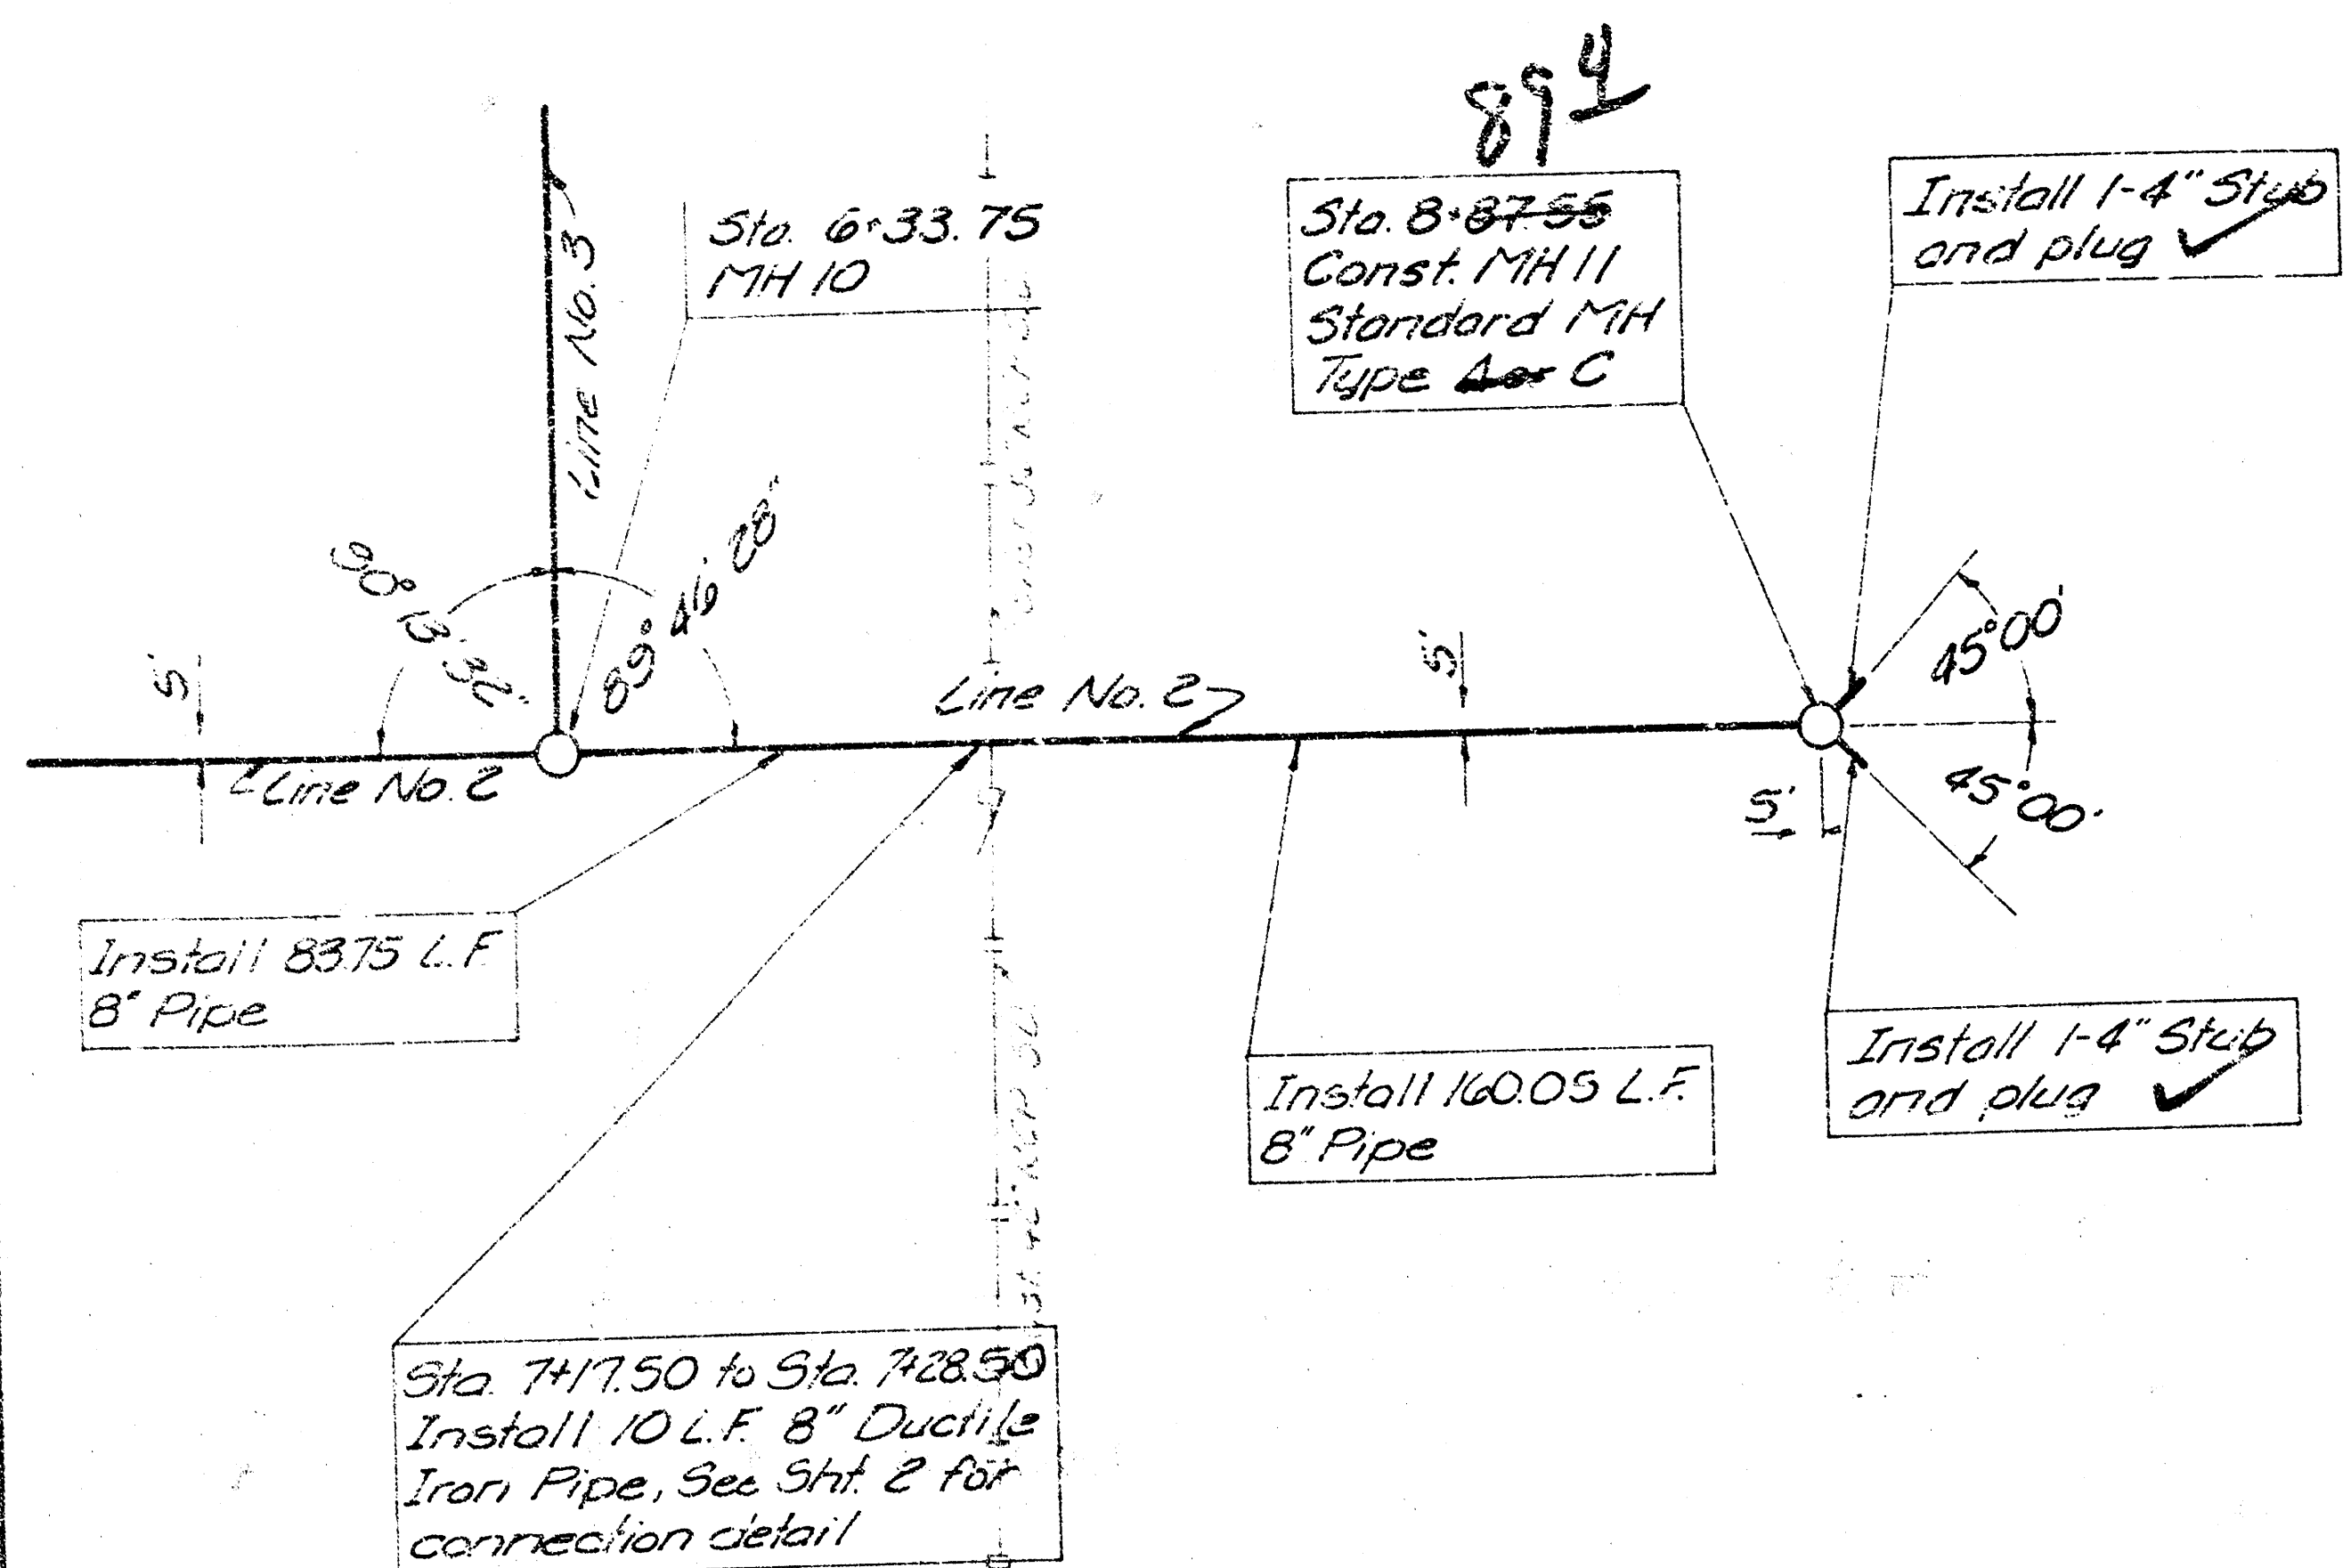


As Built
1/80

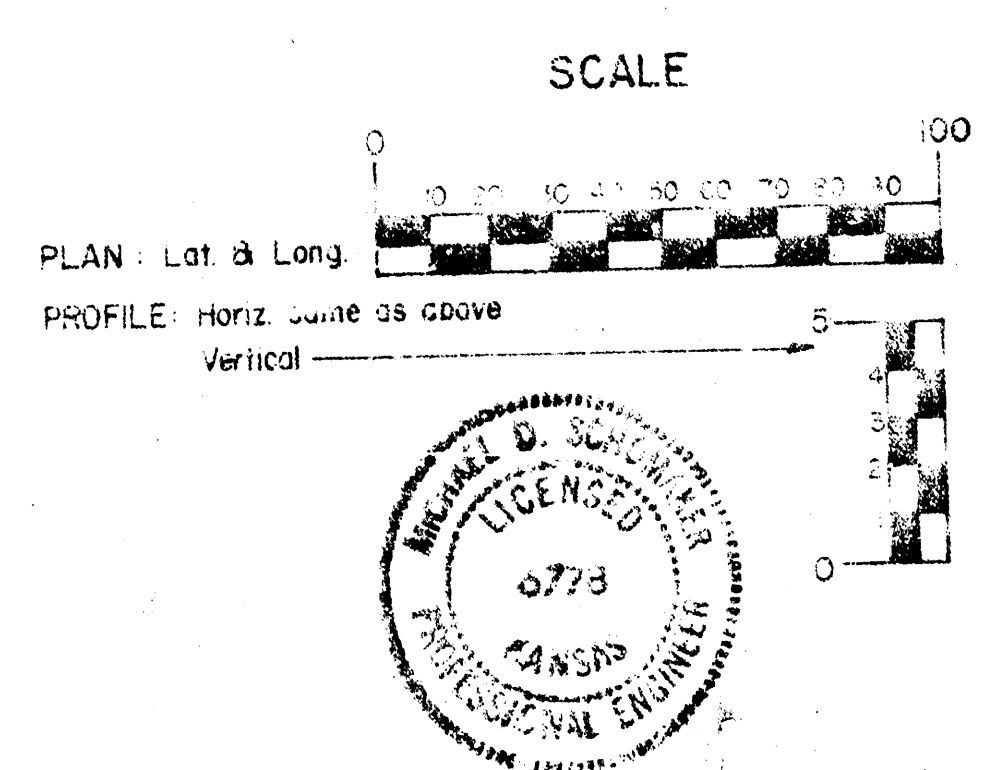

CITY OF WEST KANSAS
LATERAL 69
WESTLINK SEWER
LINE NOS. 2 & 3
NORTHWEST VILLAGE 2nd ADDITION
C.O.F.W. PROJECT NO. 485-76-245-411-9-000-100-001

PROFESSIONAL ENGINEERING CONSULTANTS, P.A.
MDS
GD
34 8/126 1-04C
1 May 1991

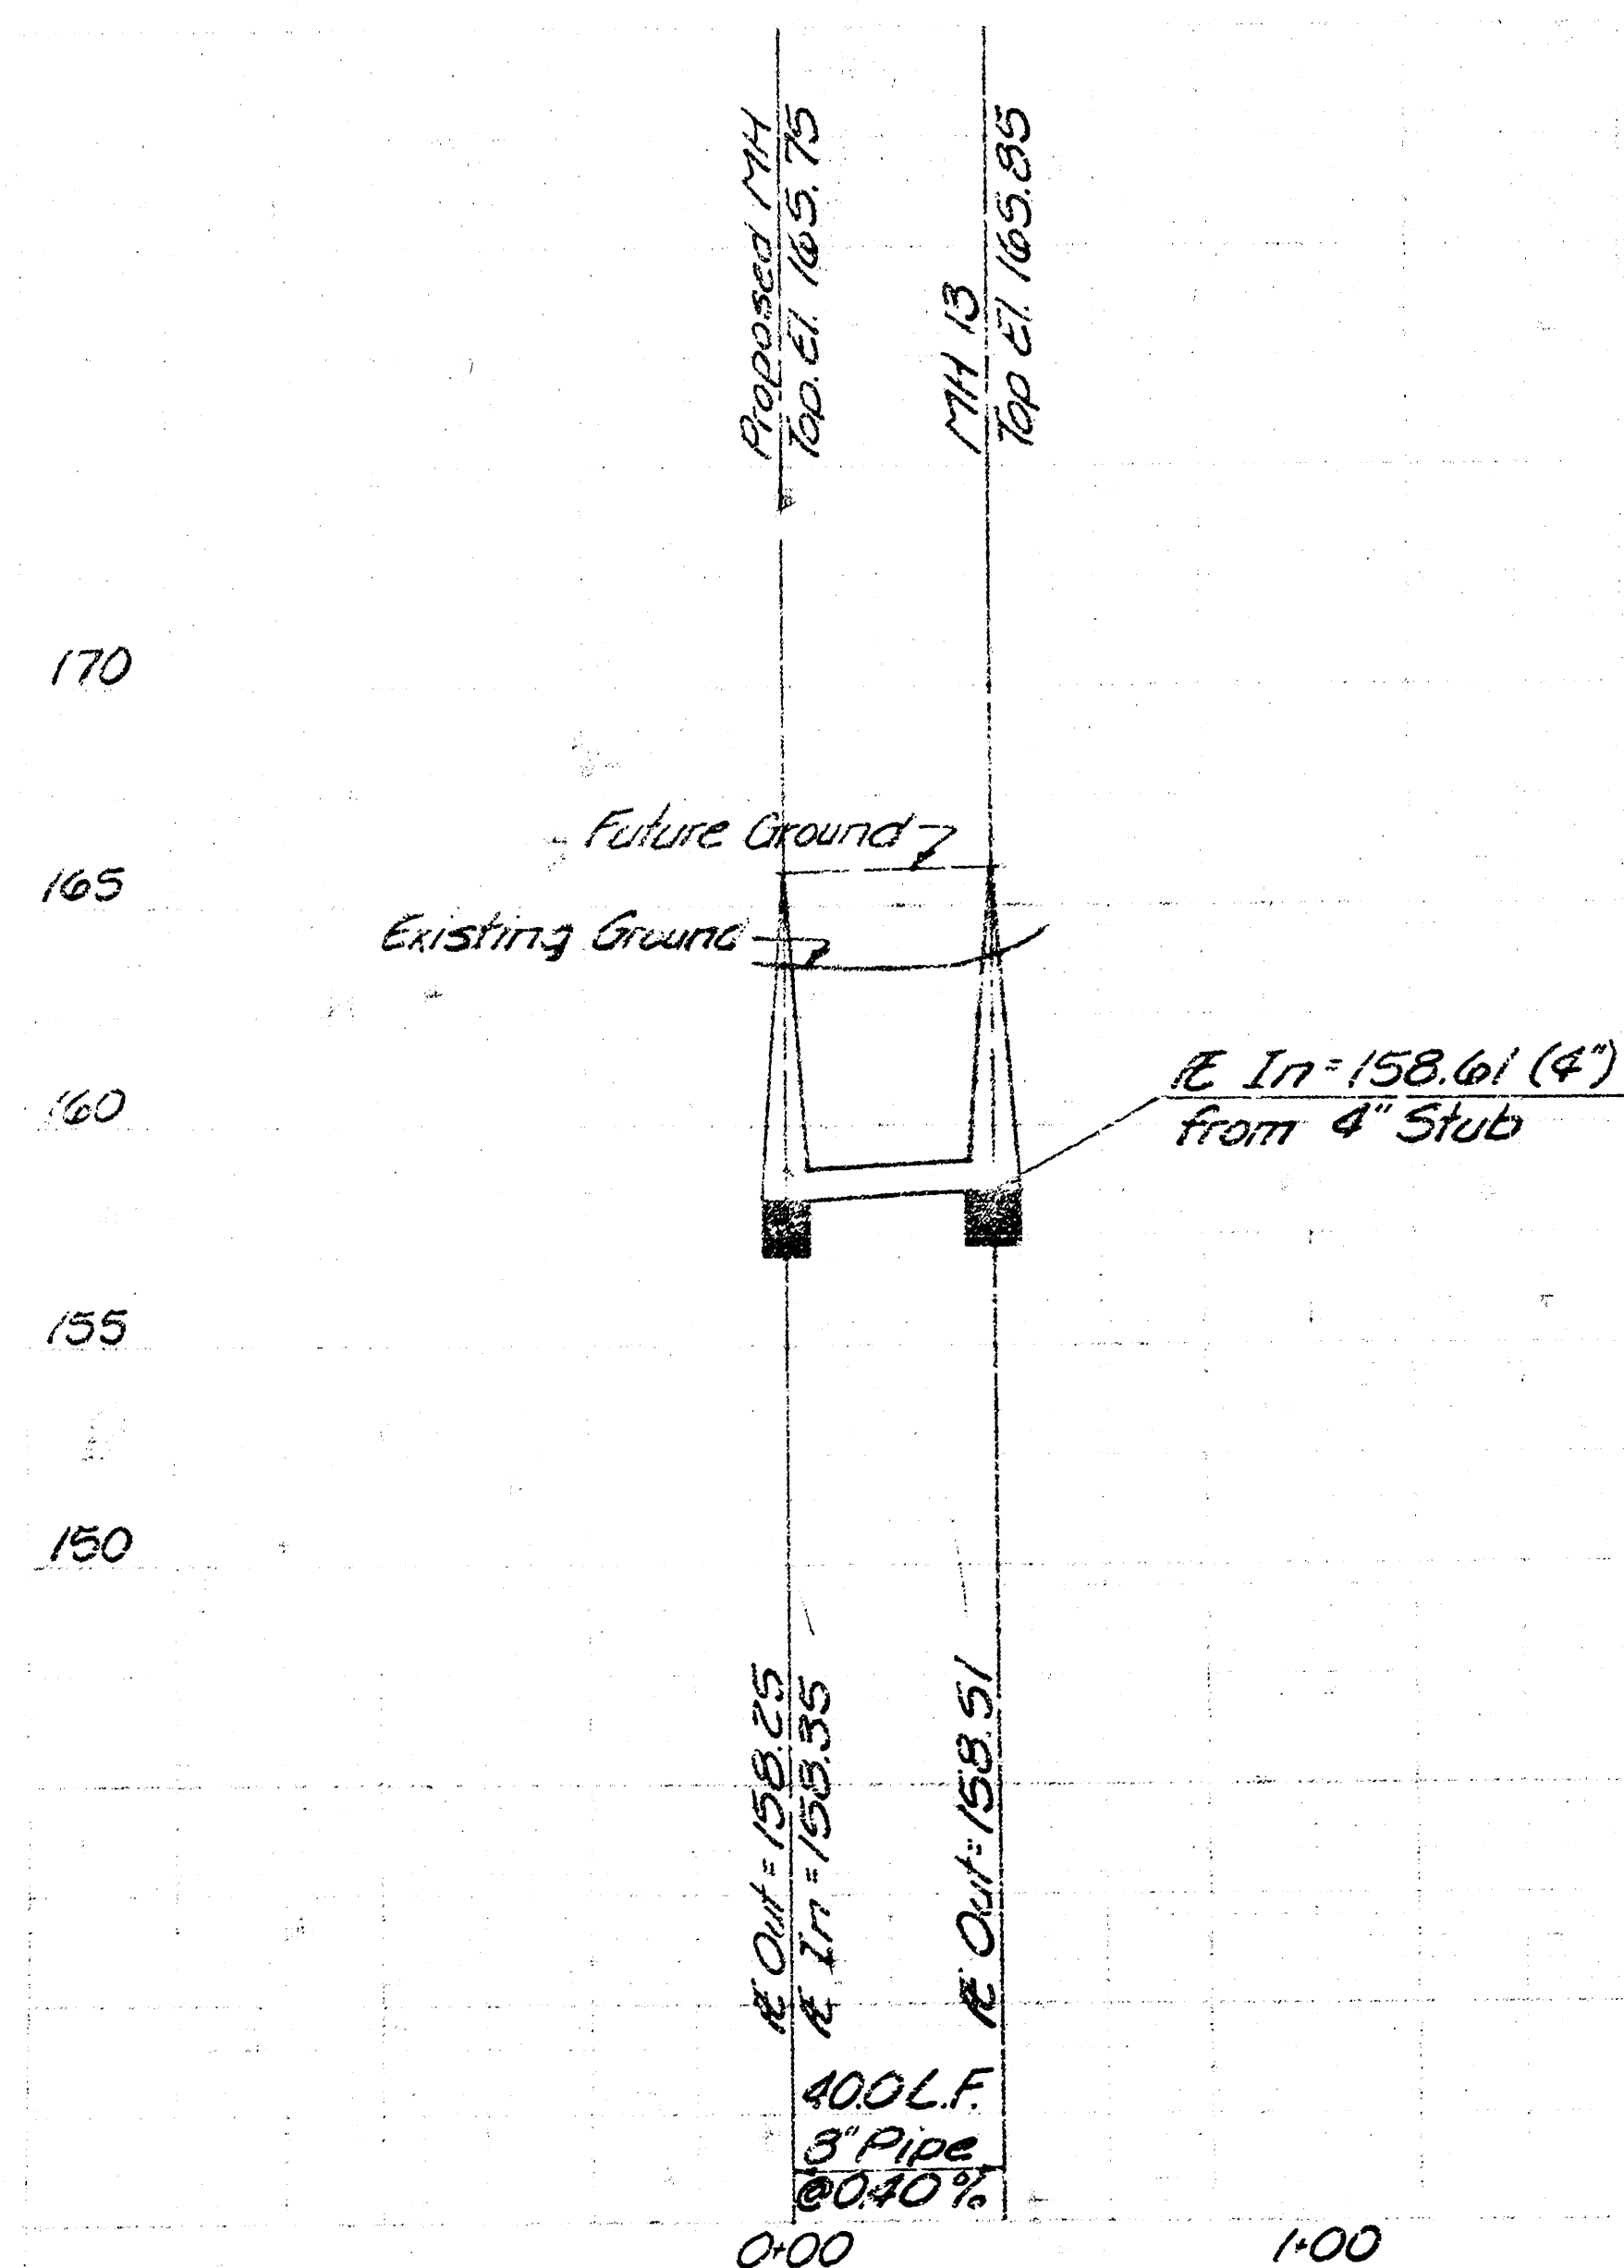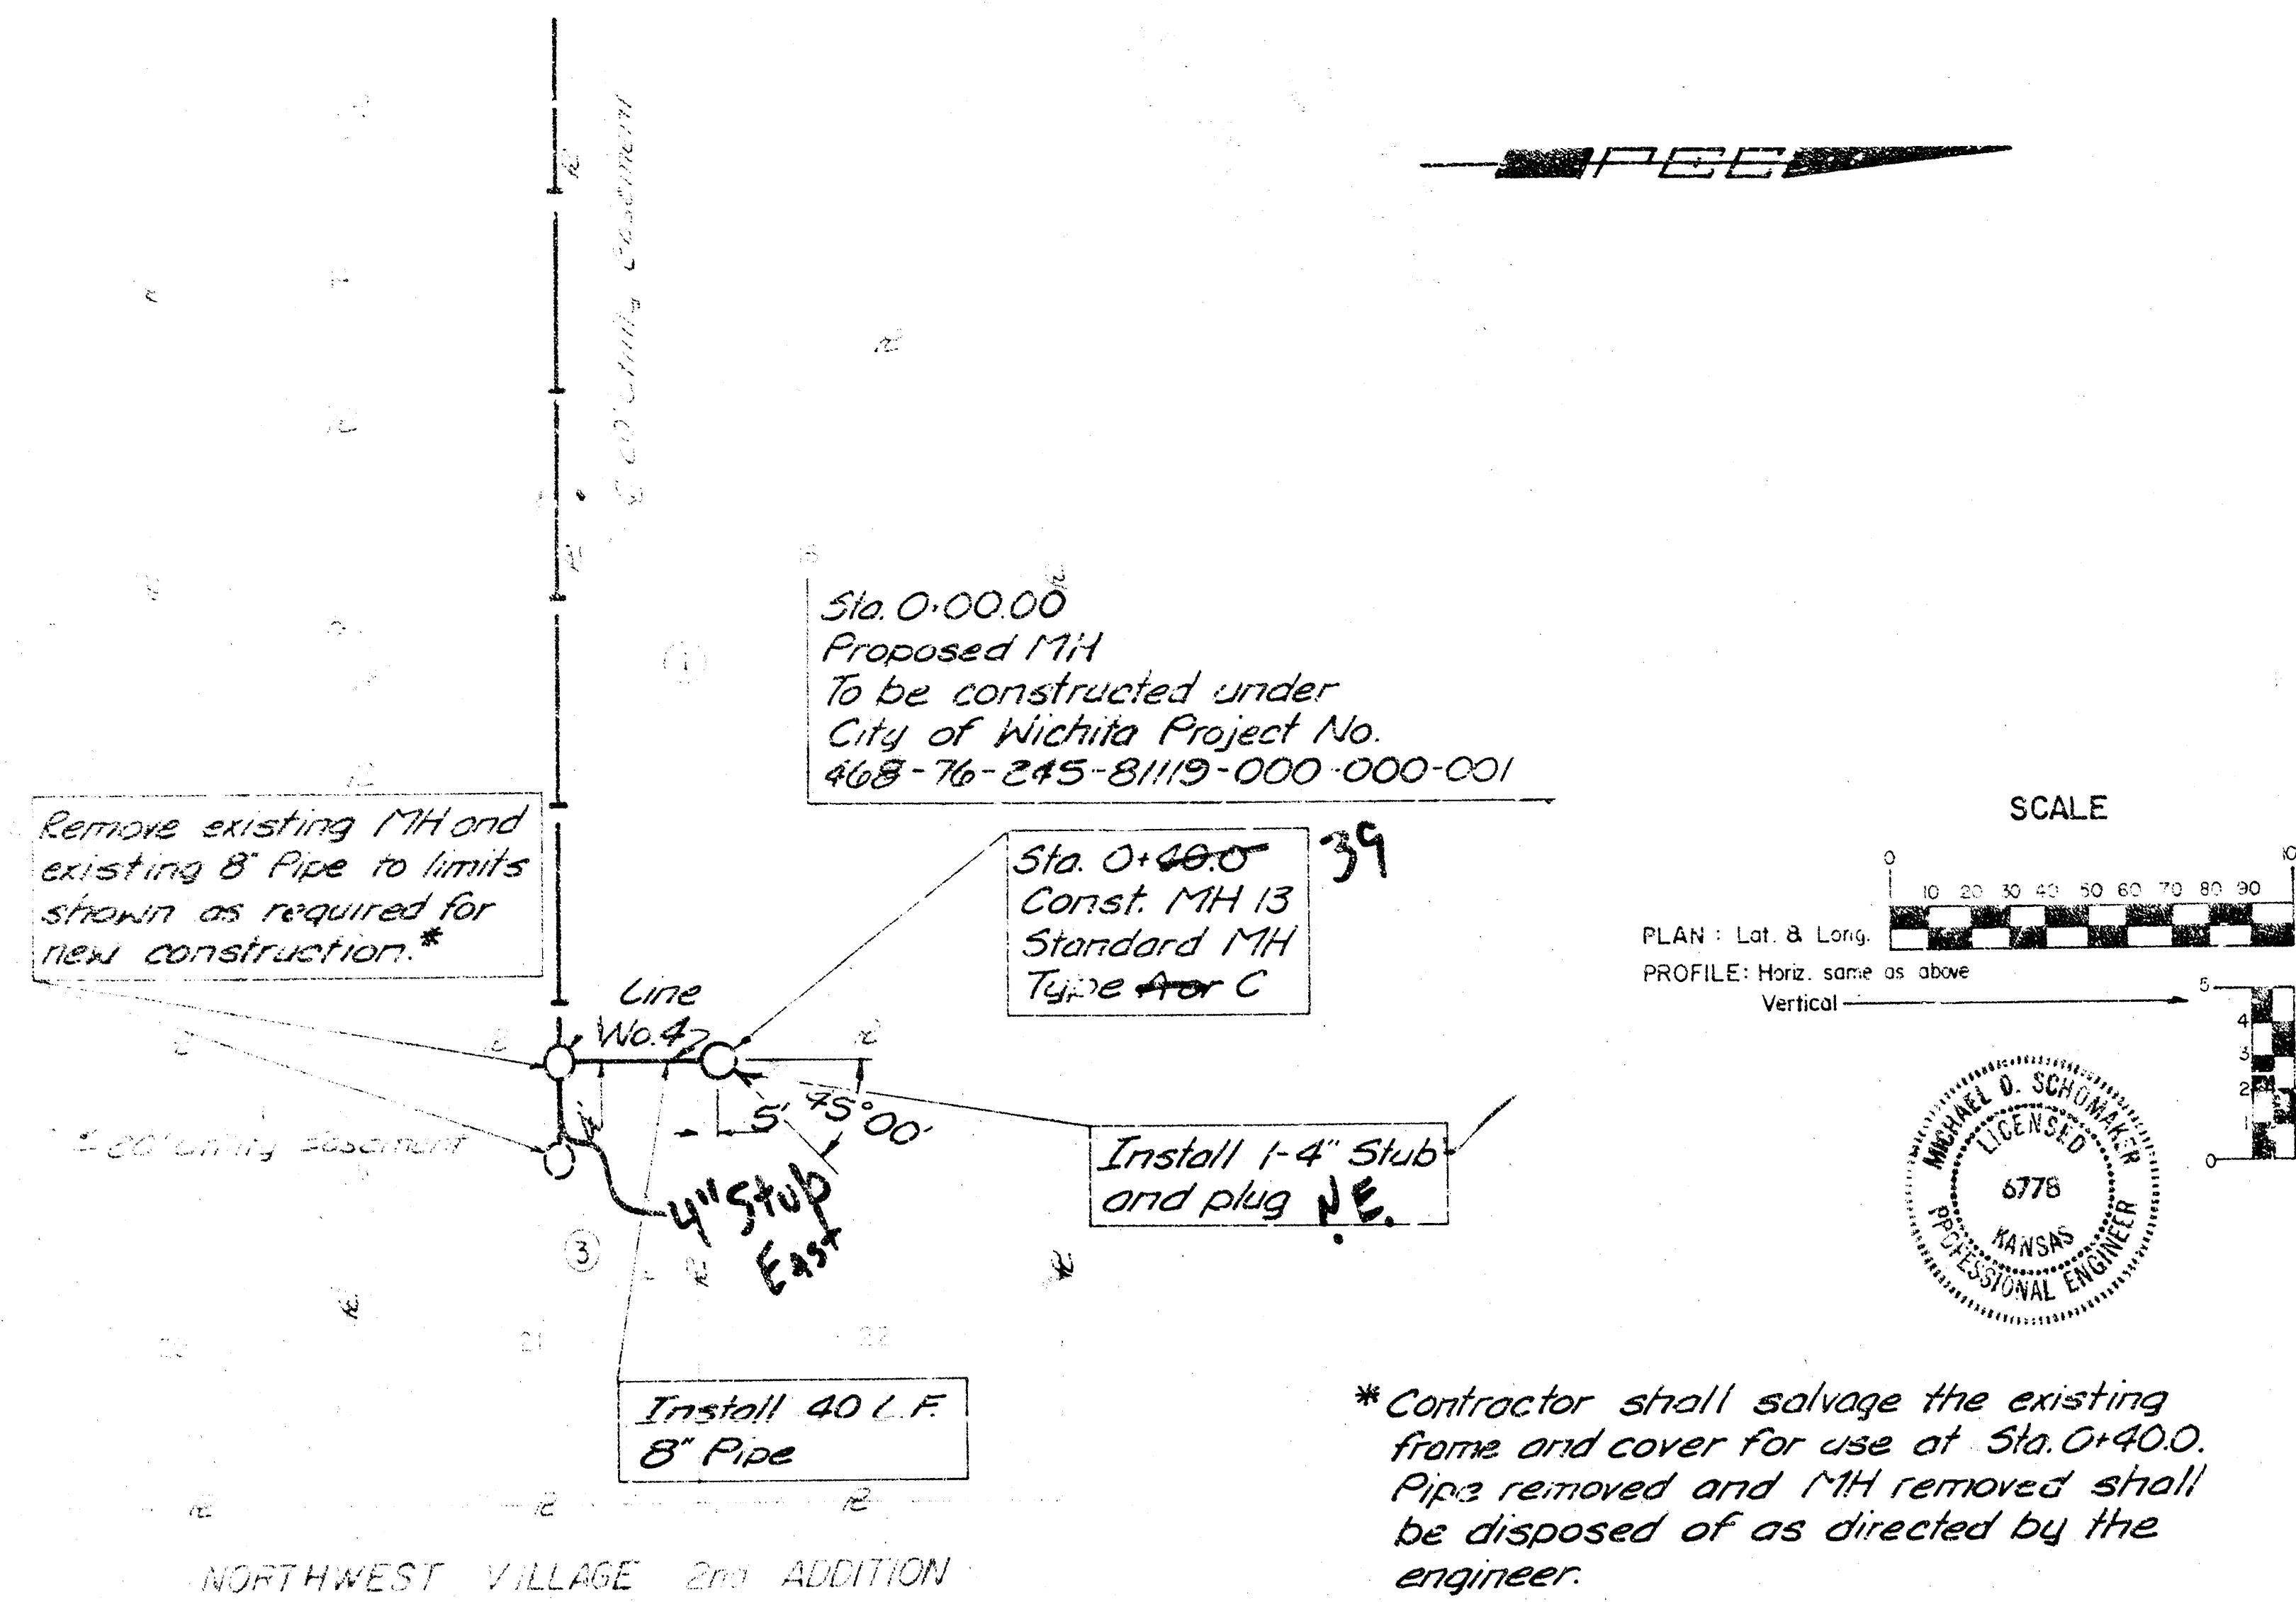

As Built
1/1/82
JLL

CITY OF WICHITA, KANSAS LATERAL 69 WESTLINK SEWER	PROFESSIONAL ENGINEER/CONSULTANT, P.A.
LINE NO. 4	34-8111-1-042 1704, 1981
NORTHWEST VILLAGE 2nd ADDITION C.O.F.W. PROJECT NO. 468-76-245-8119-000-000-001	MOS GO