


SCALE PLAN 1" = 40'
PROFILE 1" = 40' HORIZ.
1" = 5' VERT.

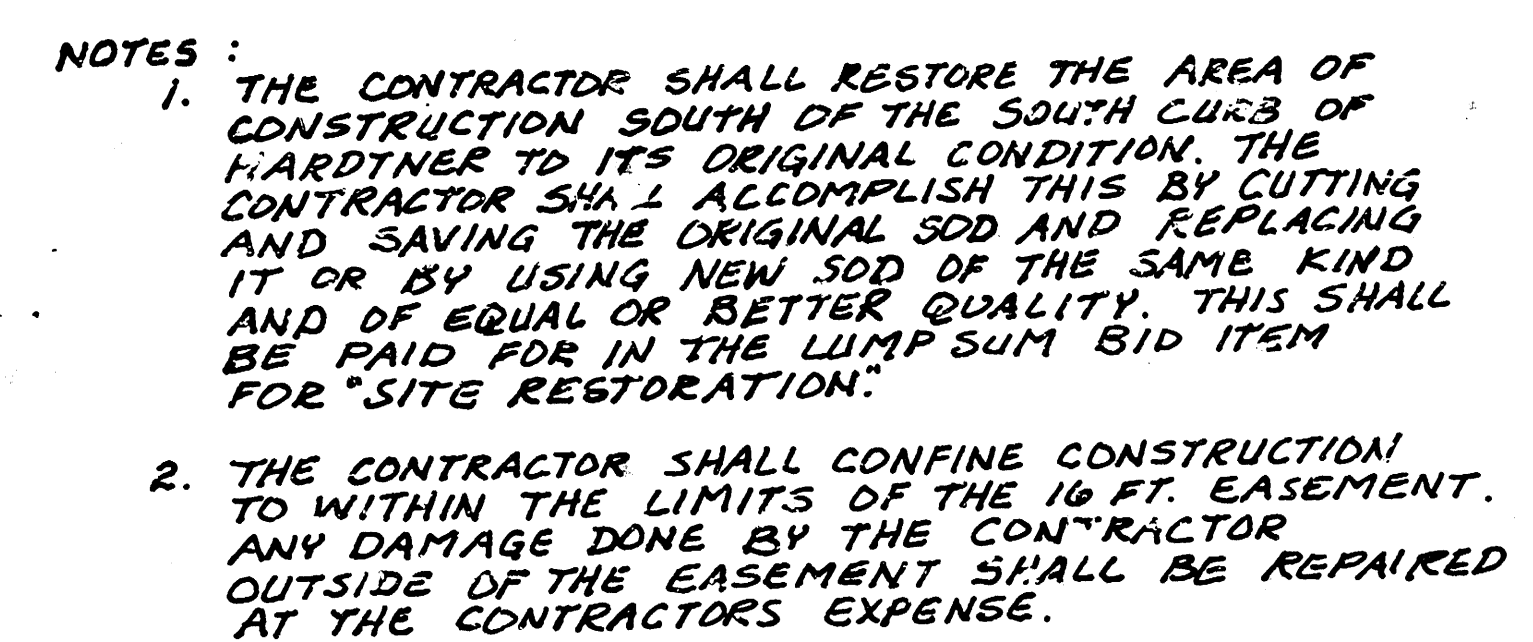


As Built
J.L.L.
12-83

NOTES (CONT.):

3. CONTRACTOR WILL BE REQUIRED TO GIVE PROPERTY OWNERS AND/OR TENANTS OF LOTS 1 & 9 8" & 8" ROLLING HILLS 5' ADDN. A MINIMUM ADVANCE NOTICE OF 48 HOURS PRIOR TO STARTING CONSTRUCTION.
4. SAW JOINT FOR PAVEMENT REMOVED SHALL BE INCIDENTAL TO THE PROJECT.
5. COST FOR 8" PIPE REMOVAL SHALL BE INCLUDED IN BID ITEM FOR 18 INCH PIPE.
6. THE PAYMENT FOR PAVEMENT REMOVED AND RECONSTRUCTED SHALL BE ON A LINEAR FOOT BASIS AS MEASURED ALONG THE CENTER LINE OF THE SEWER AND IS NOT CONTROLLED BY THE AREA OF PAVEMENT REMOVED AND REPLACED.

B.M. 147.65 WESTLINK AND CENTRAL, CITY STD DISC.
TOP NORTH HANDRAIL AT EAST END R.C.B.

B.M. 141.51 "D" SE CORNER OF PAMELA AND HARDTNER
ON TOP CURB IN MIDDLE OF STREET RADIUS.

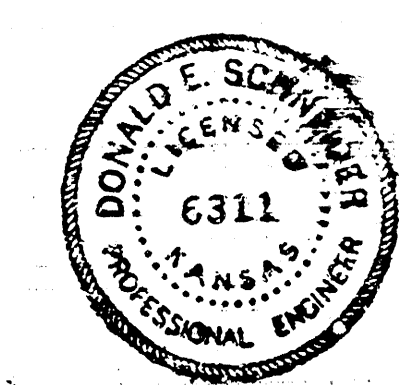

PROJECT DESCRIPTION	
LATERAL 70, WESTLINK SEWER	
PROJECT NUMBER	
468-76-245-81222-000-000-001	
BOOK NO. DW V-13	APPROVED BY
DRAWN BY LOM15	DATE REVISED
CITY OF WICHITA	
DEPARTMENT OF ENGINEERING	
M. E. LINDBAK - CITY ENGINEER	
SCALE	

FILMED FROM THE BEST
AVAILABLE COPY