


# LATERAL 72 WESTLINK SEWER

Project no. 468-76-245-81277-000-000-001

CITY OF WICHITA, KANSAS  
MIKE LINDEBAK CITY ENGINEER

As Built  
J.L.L.  
984

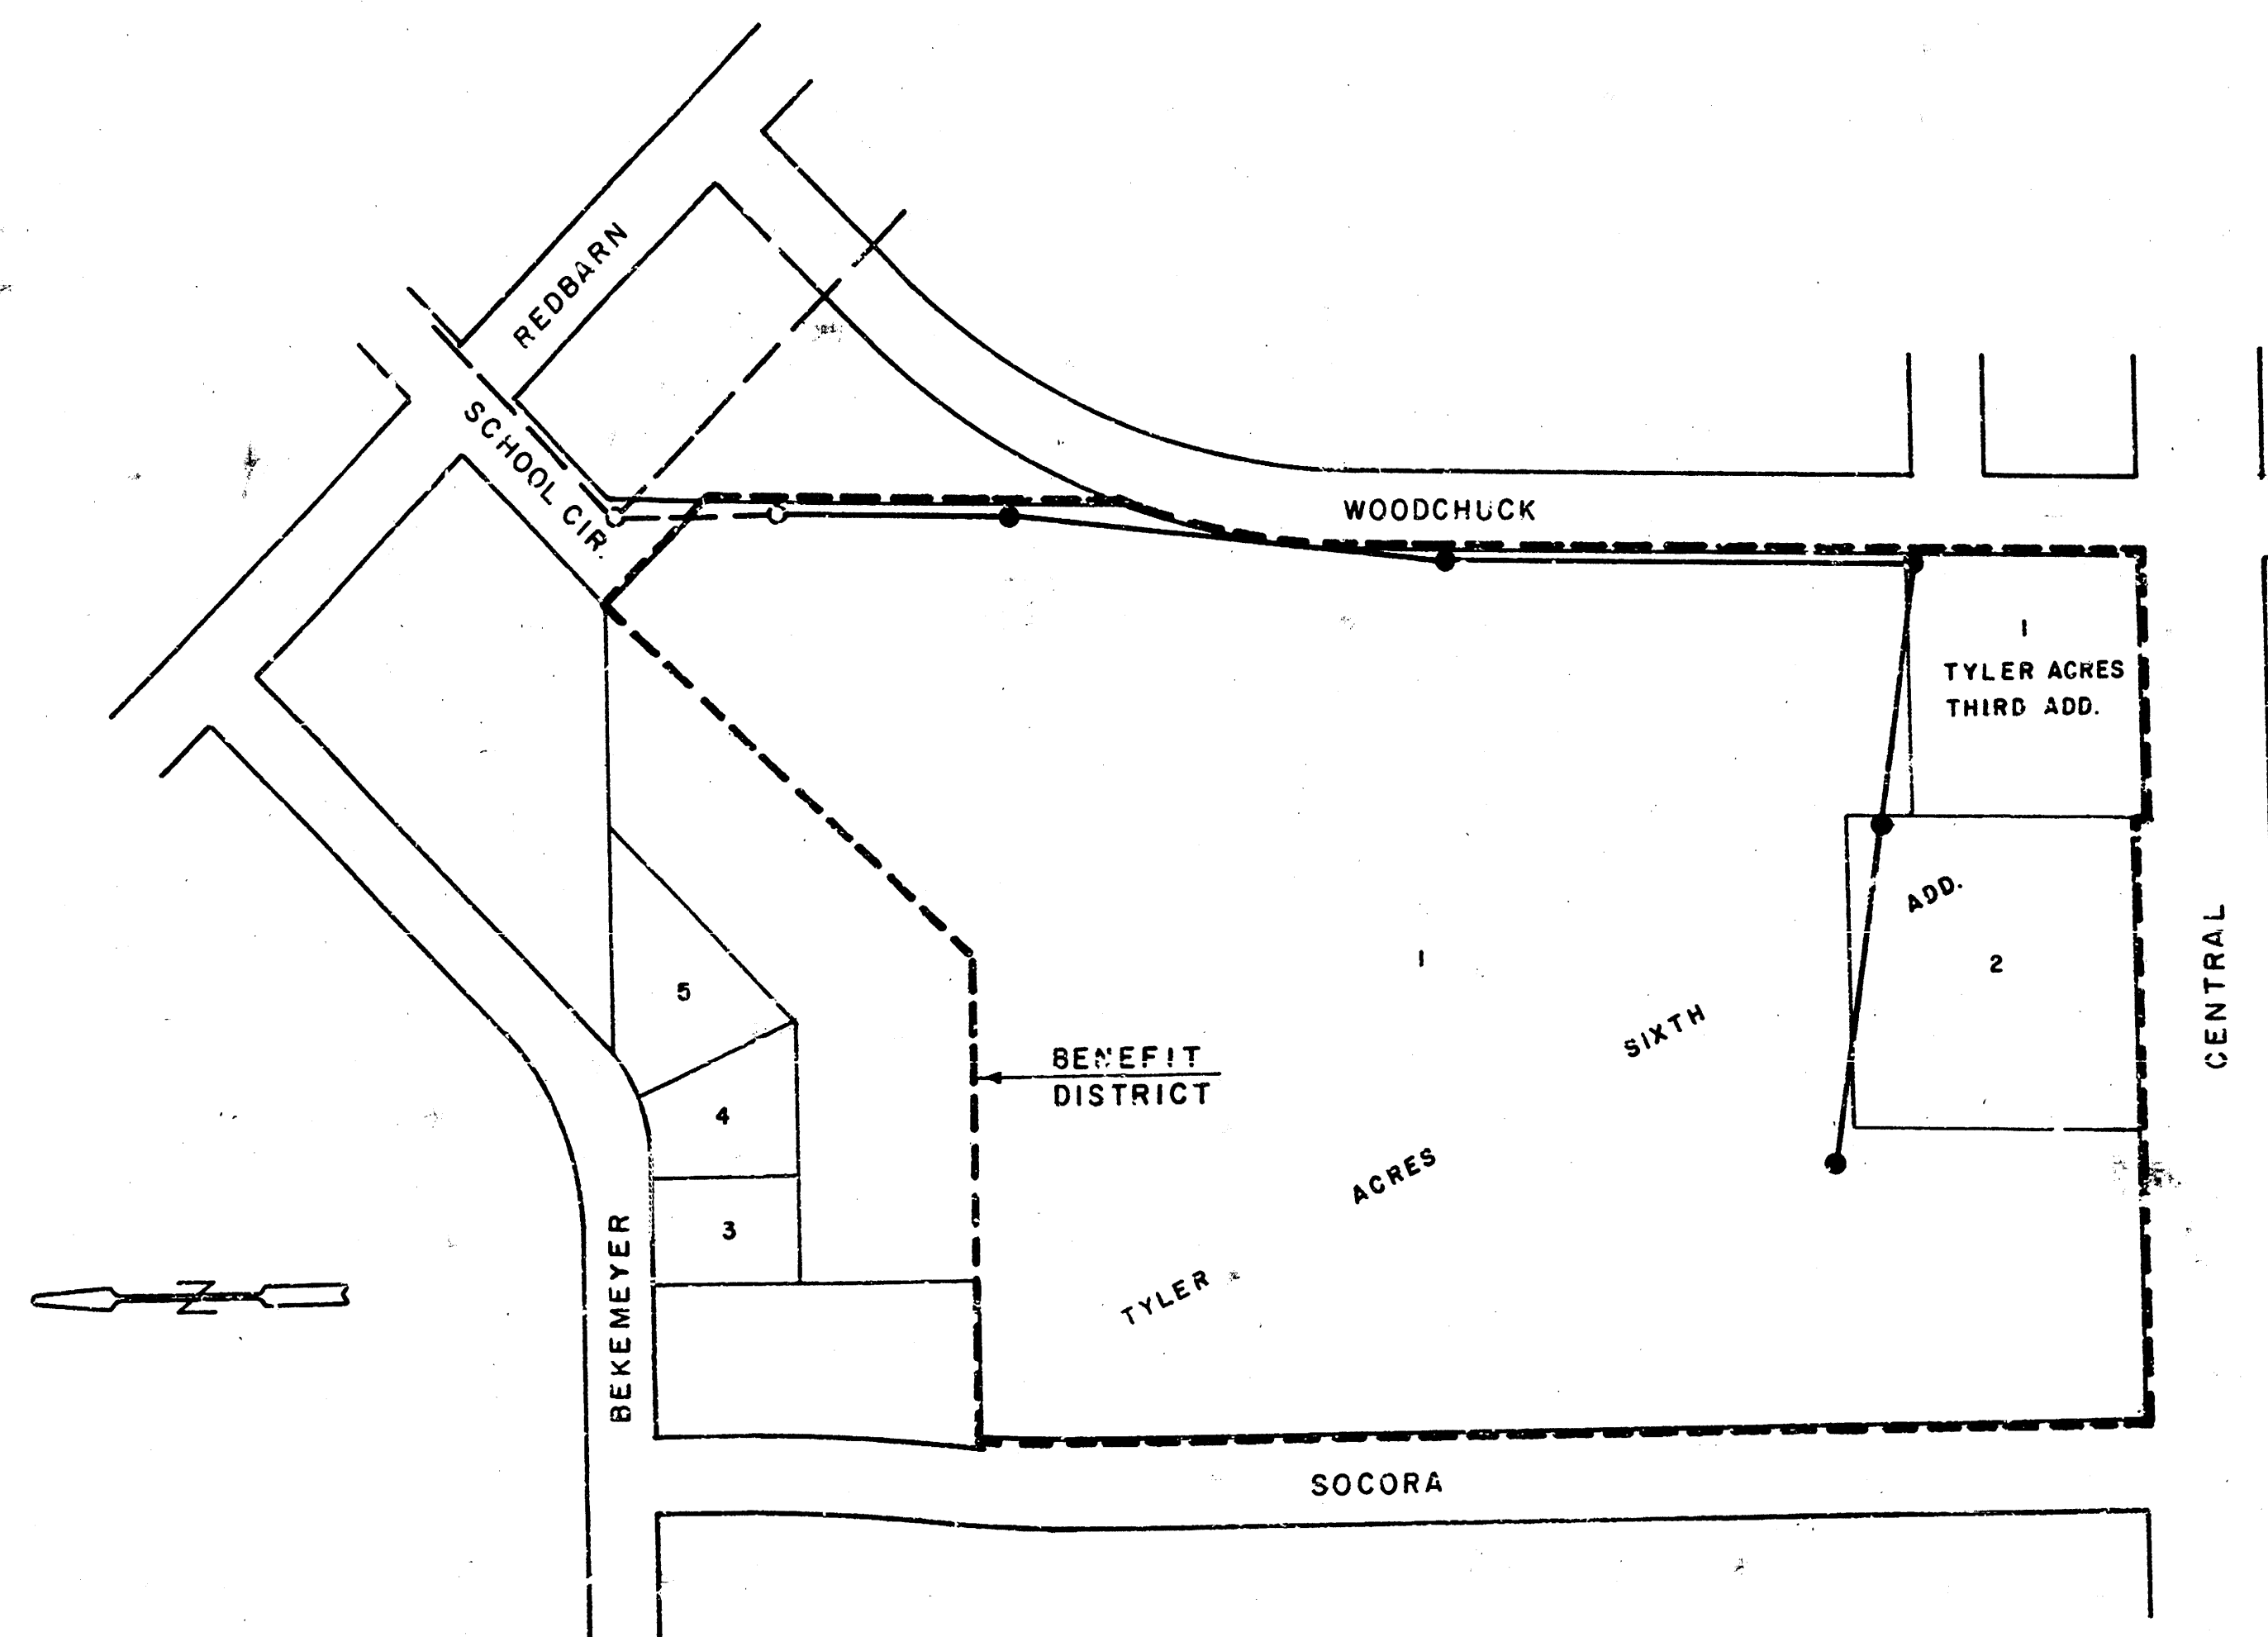

LOCATION MAP



April 24.




**BAUGHMAN COMPANY, P.A.**  
SURVEYING & ENGINEERING  
316/262-7271 • 330 LAURA • WICHITA, KANSAS 67211

SH. 1 OF 3


1/3

Scale: Hor. 1" = 40'  
Ver. 1" = 5'

As Built  
J.L.L.  
9-84

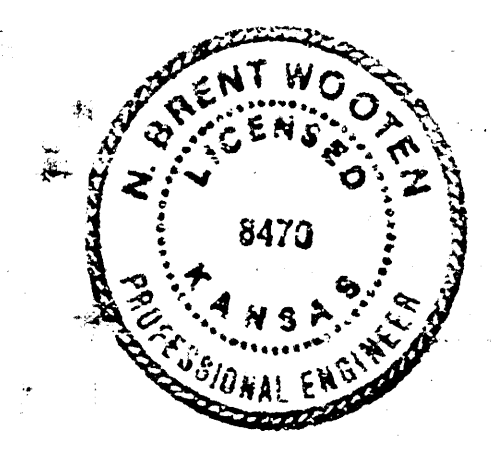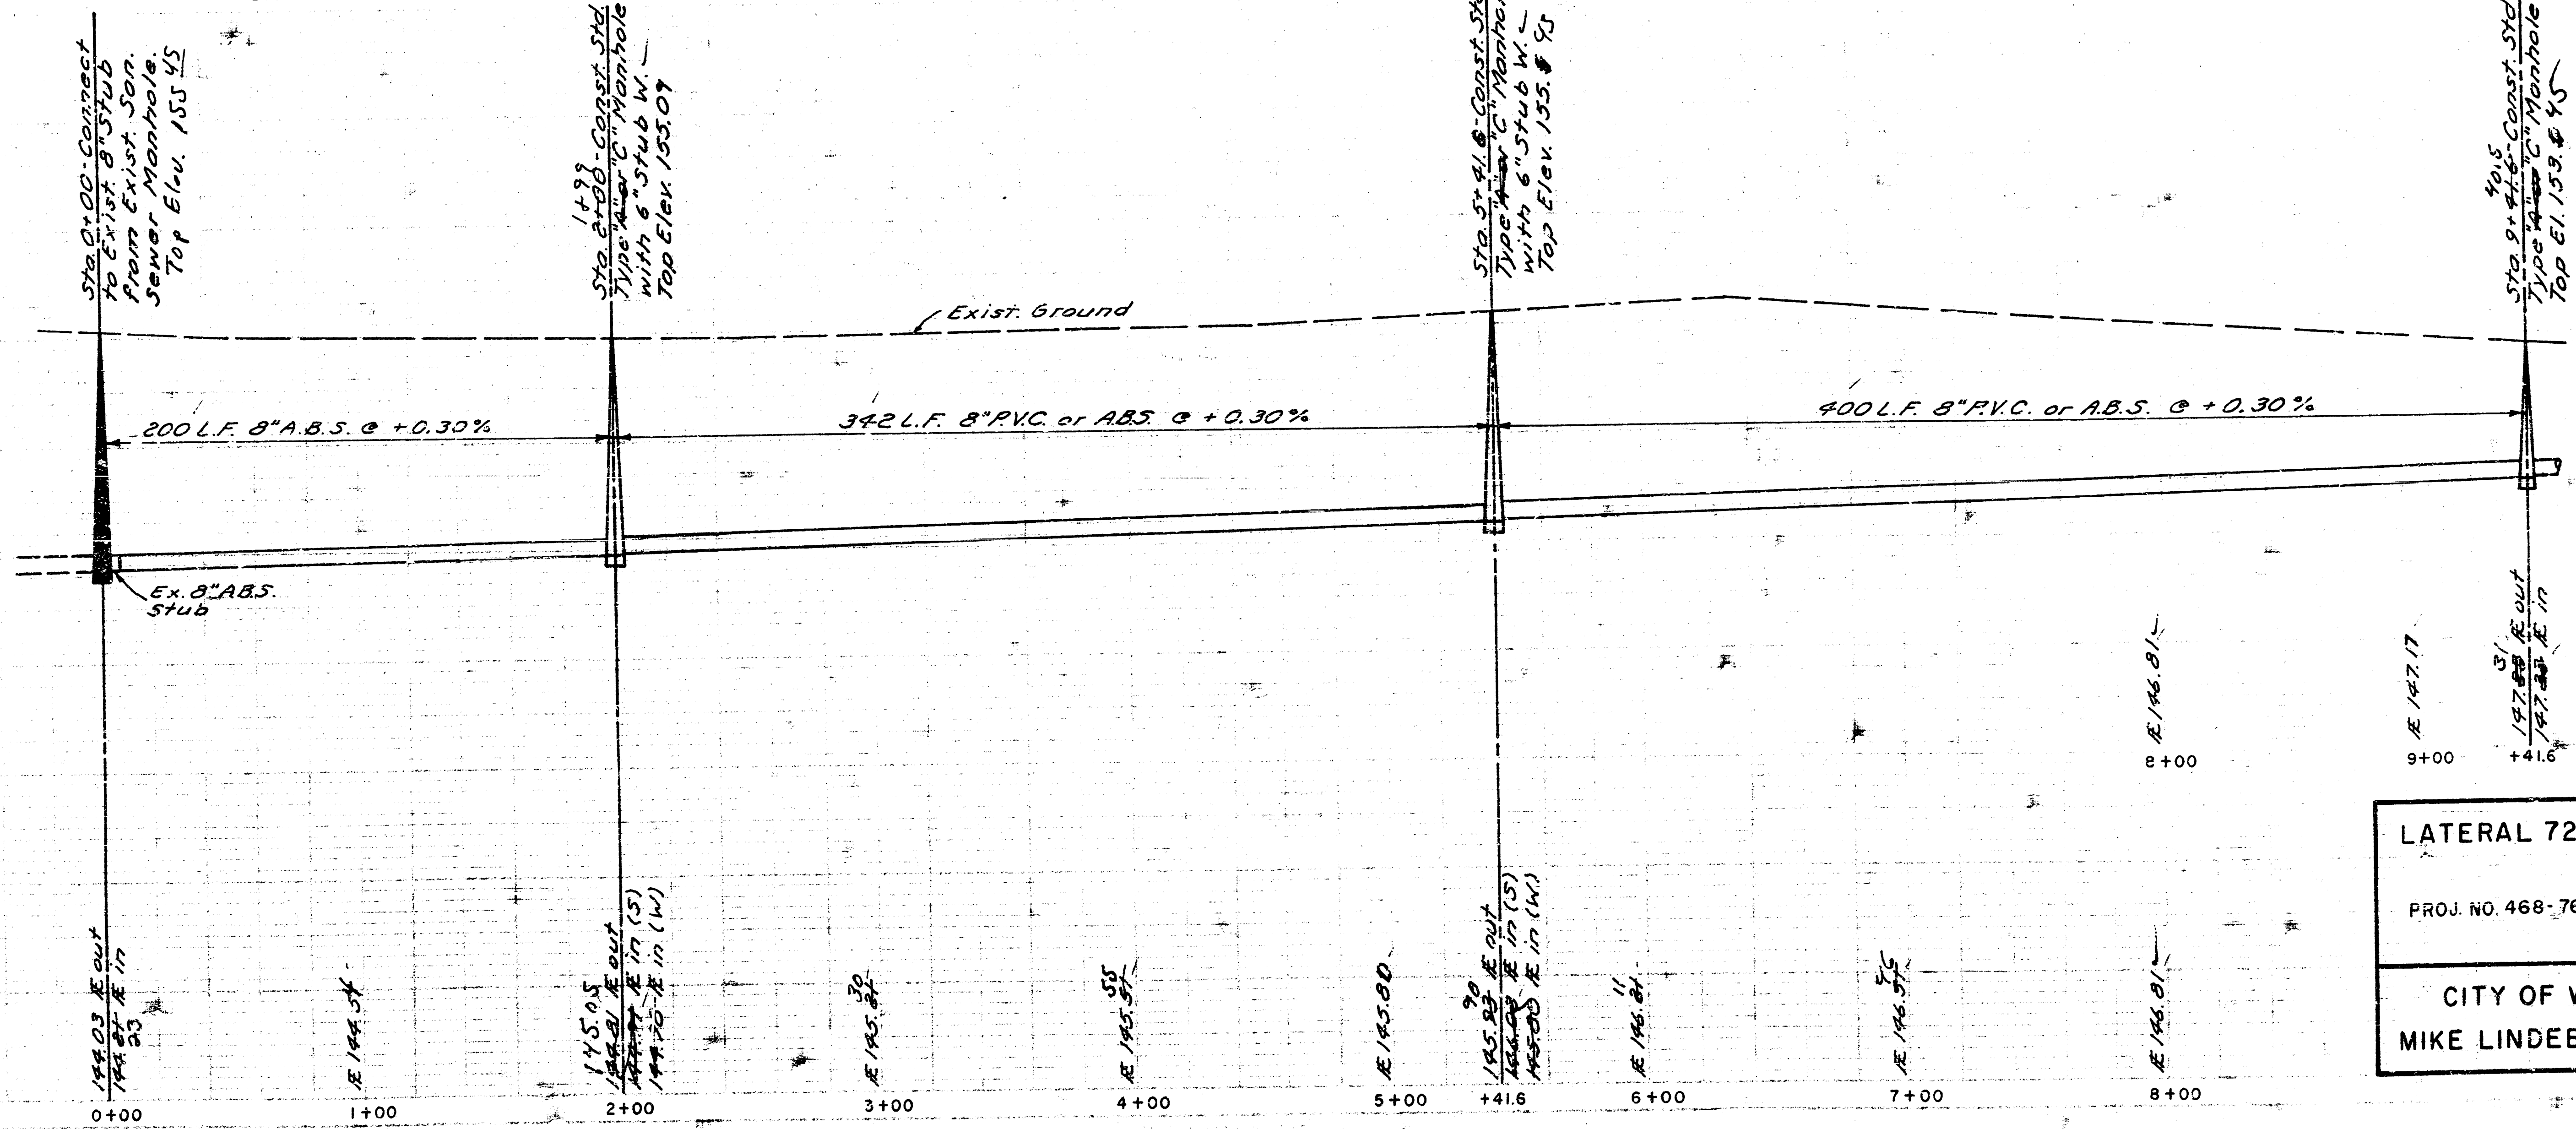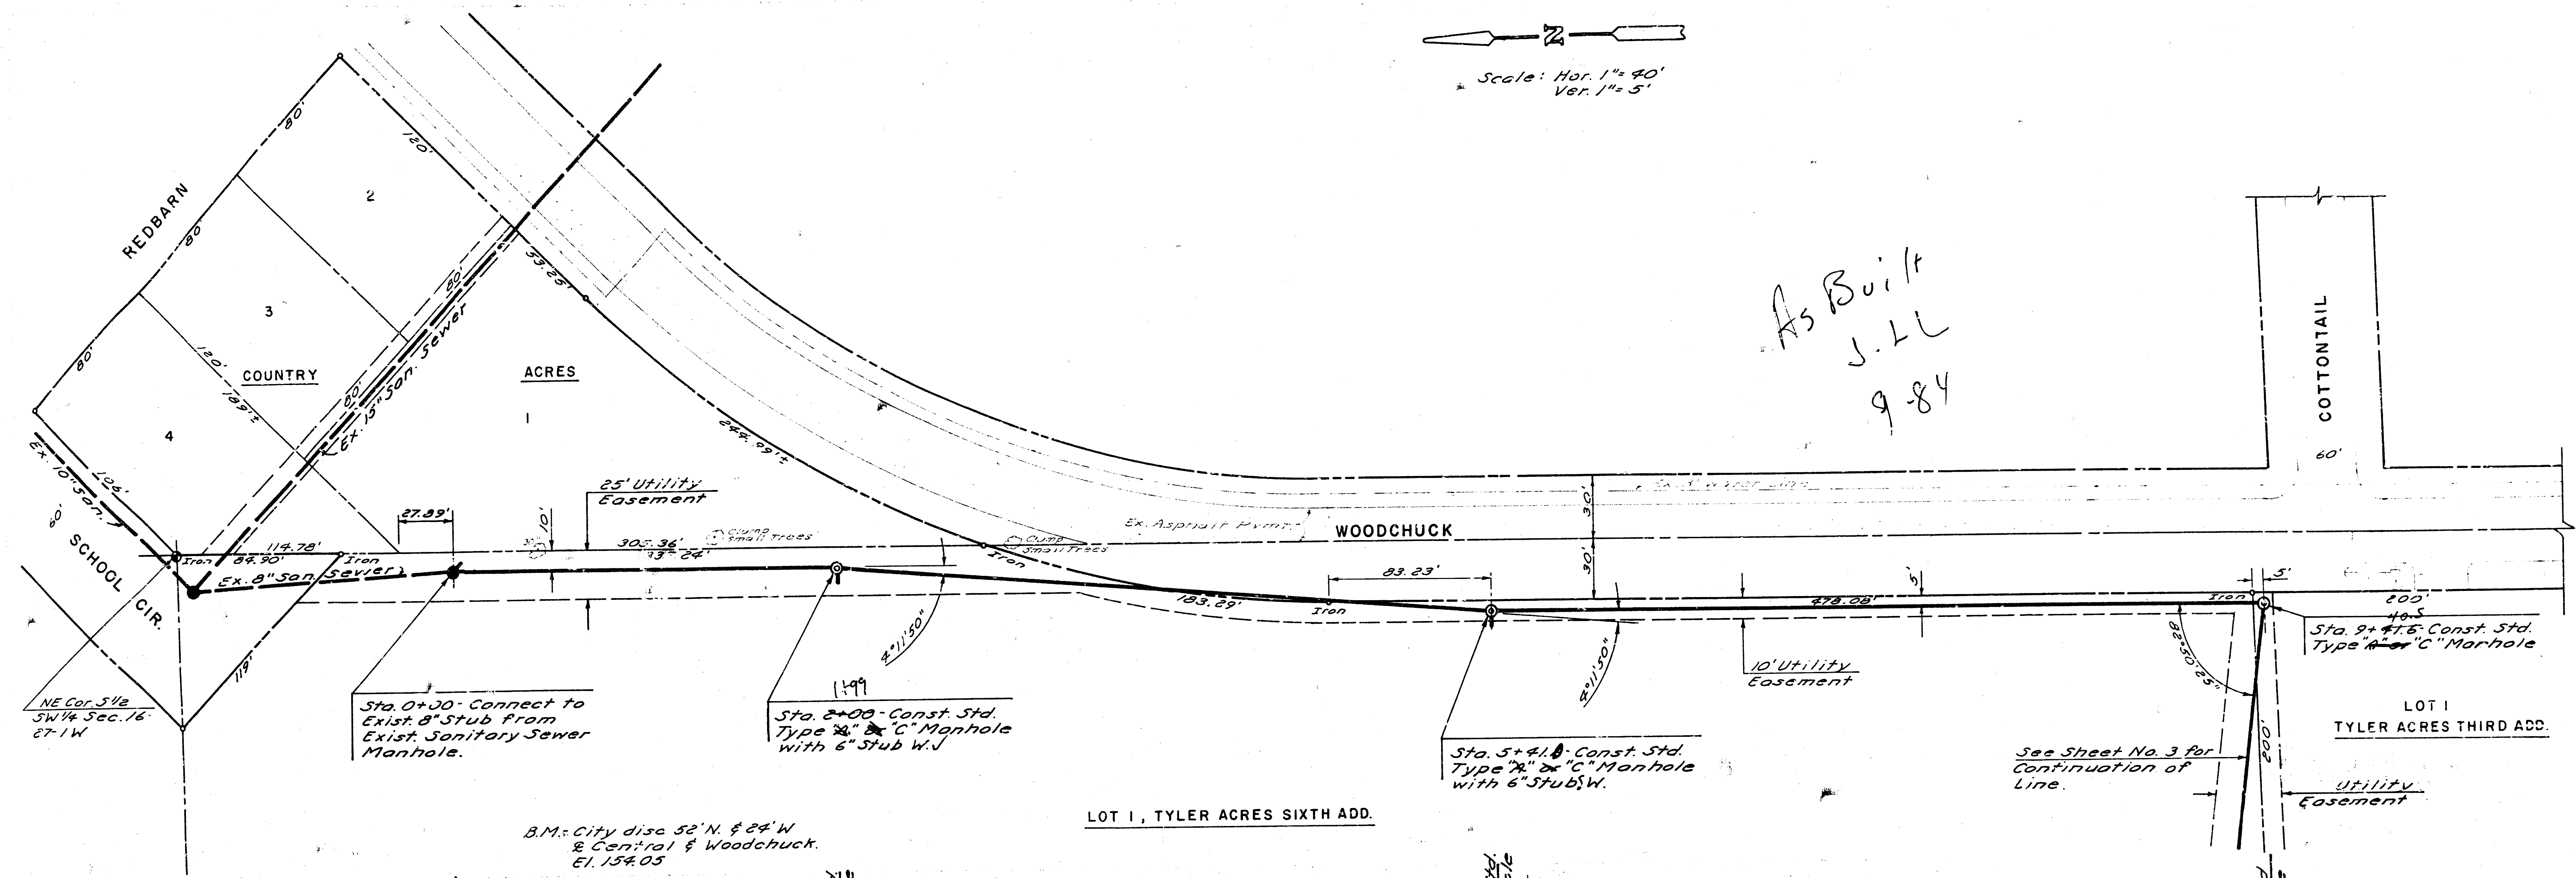


**LATERAL 72- WESTLINK SEWER**  
PROJ. NO. 468-76-245-81277-000-000-001  
**CITY OF WICHITA, KANSAS**  
**MIKE LINDEBAK CITY ENGINEER**

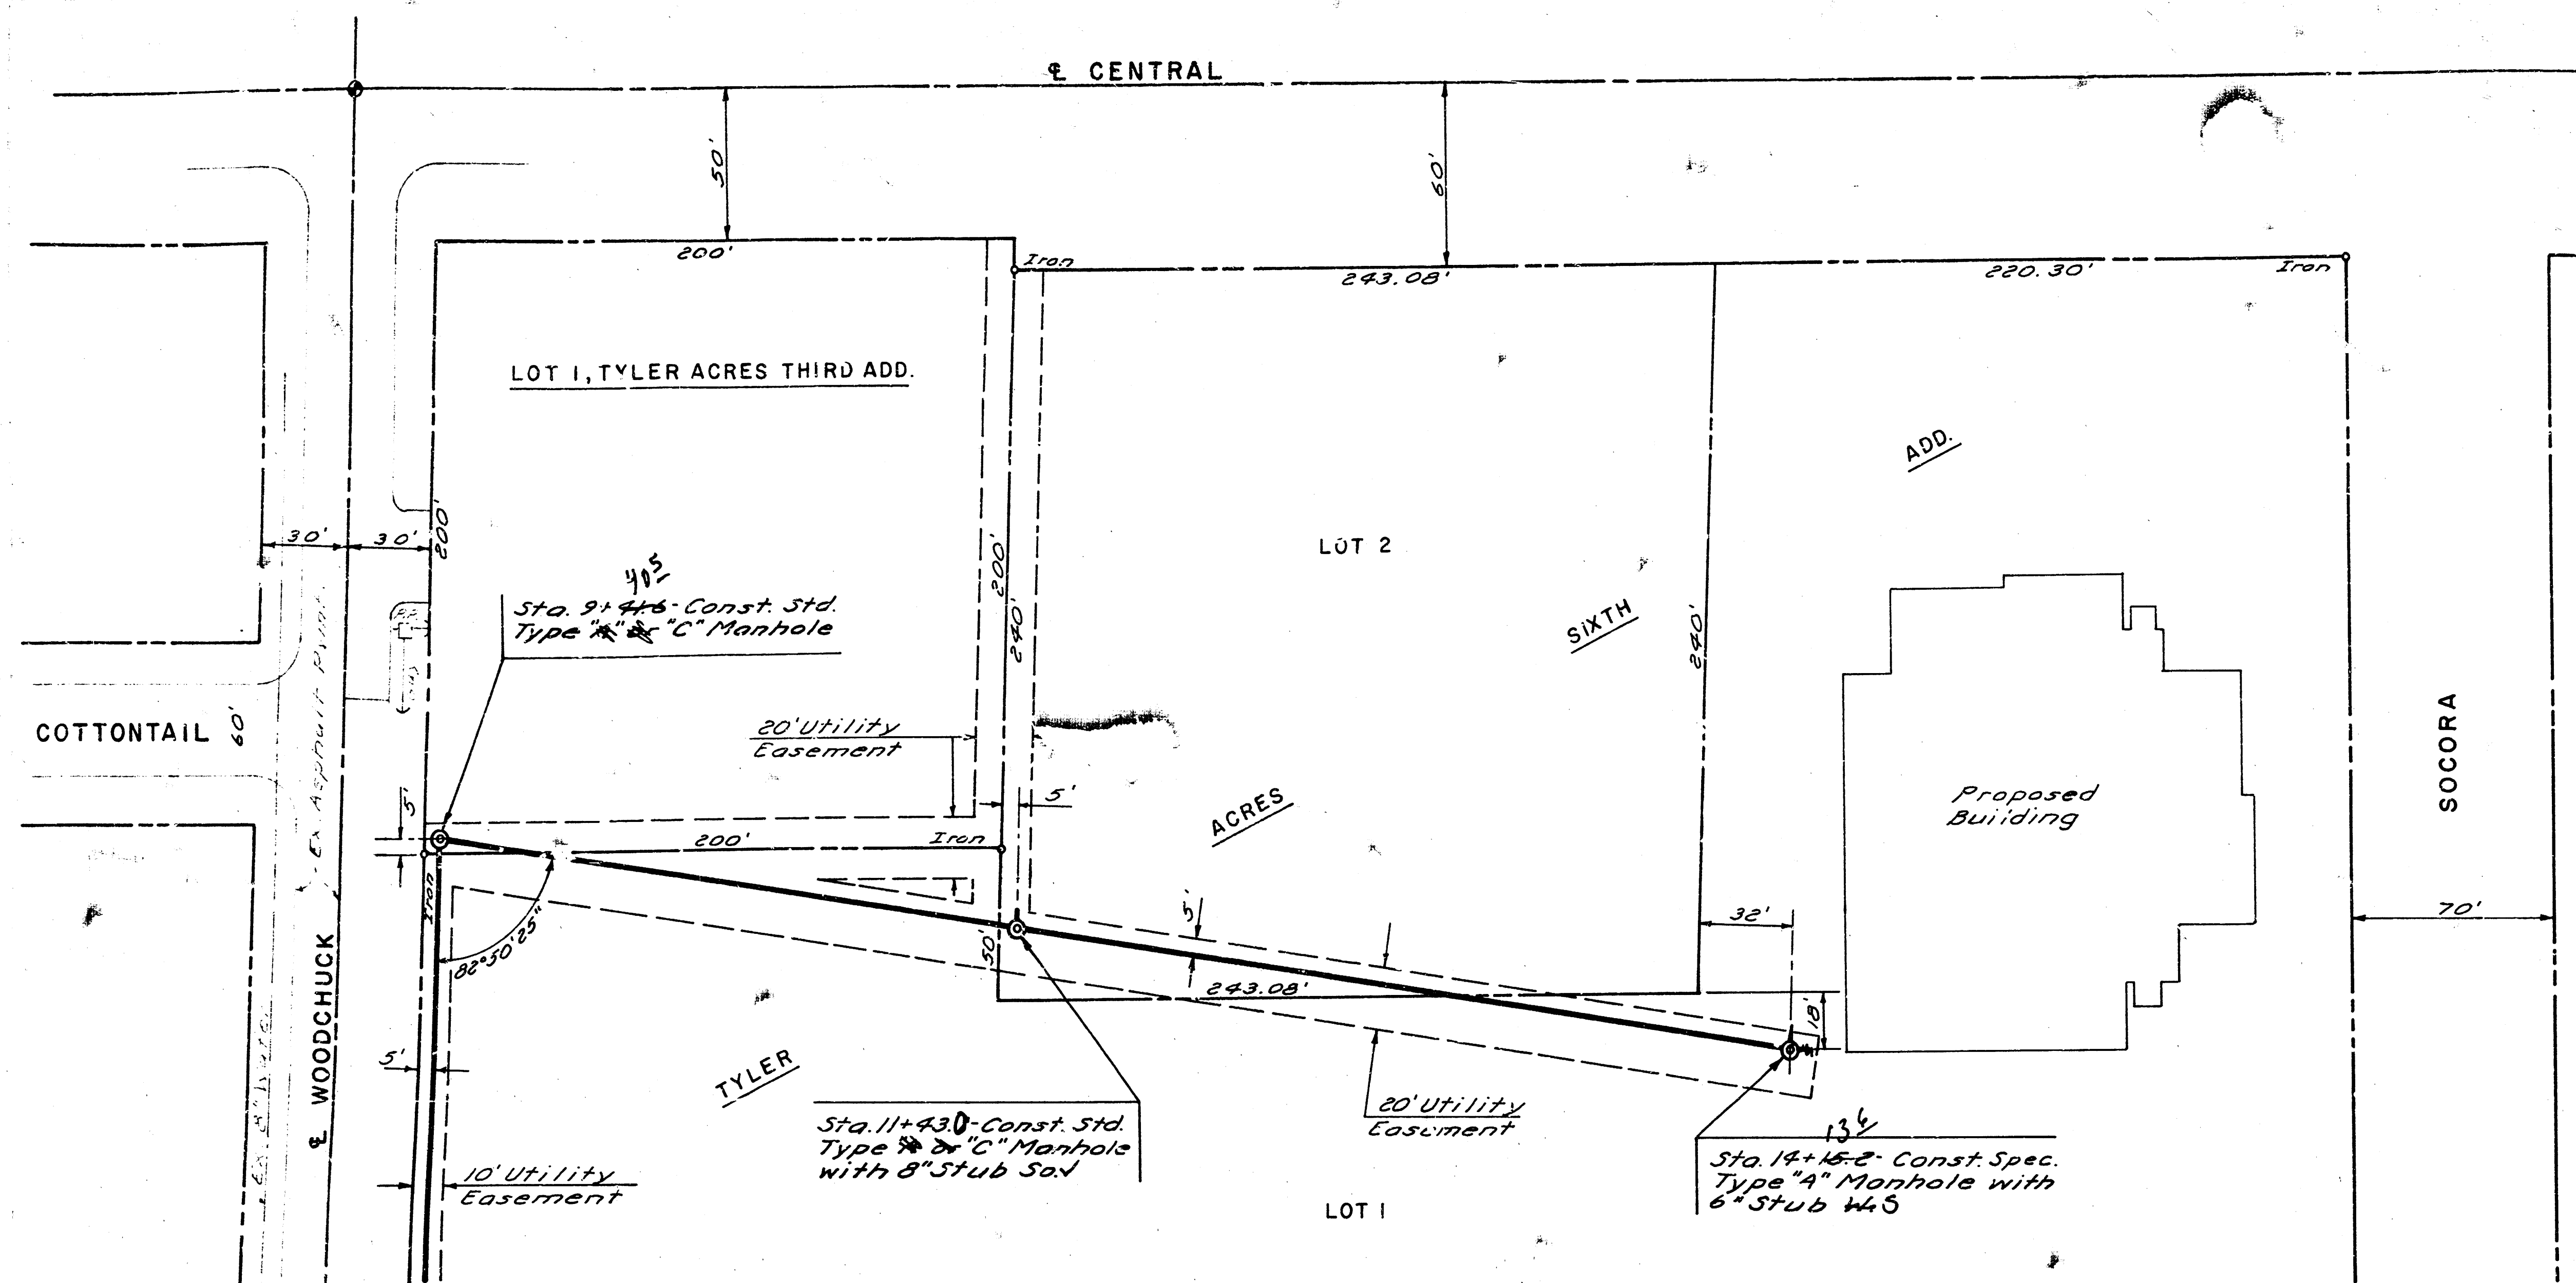


Scale: Hor. 1"=40'  
Ver. 1"=5'

As Built  
J.L.L.  
9-84

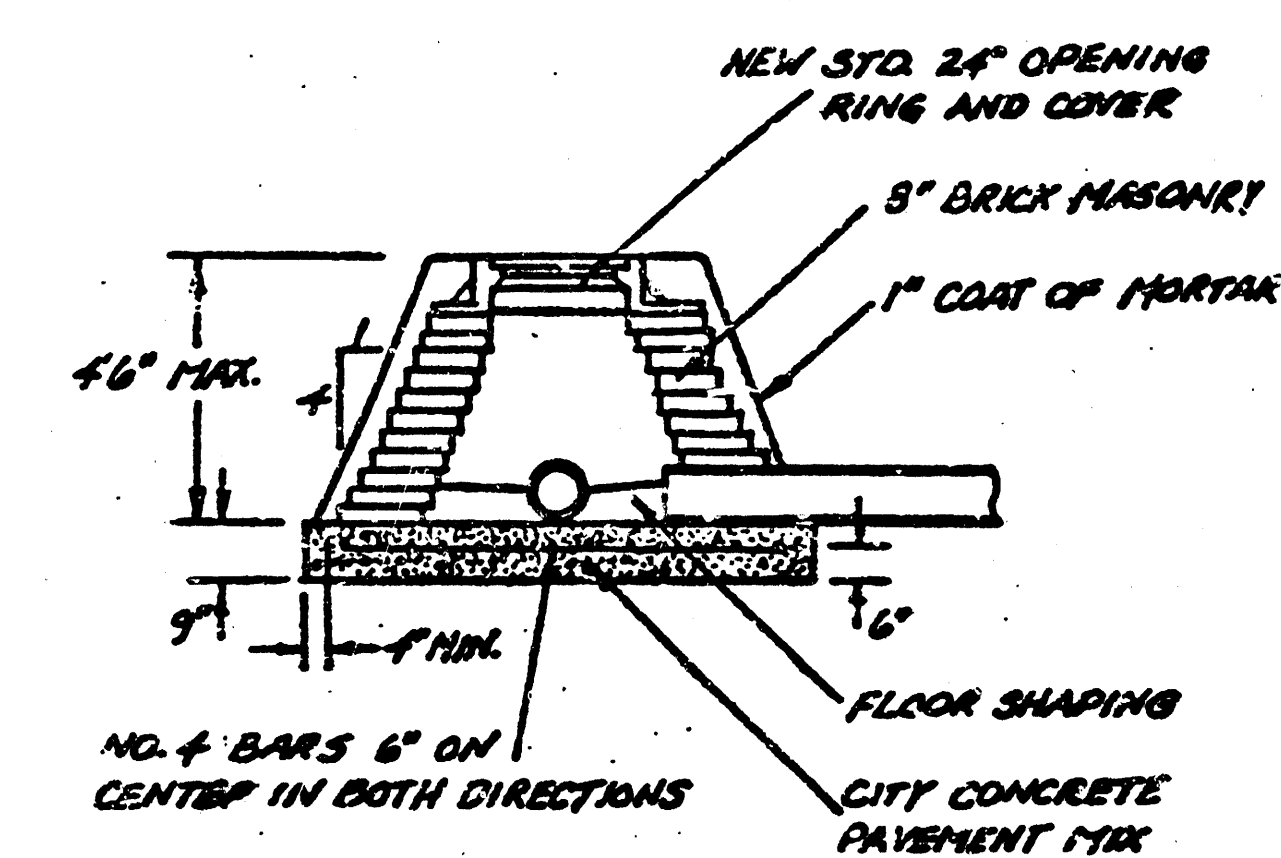

SPECIAL MANHOLE "TYPE A"

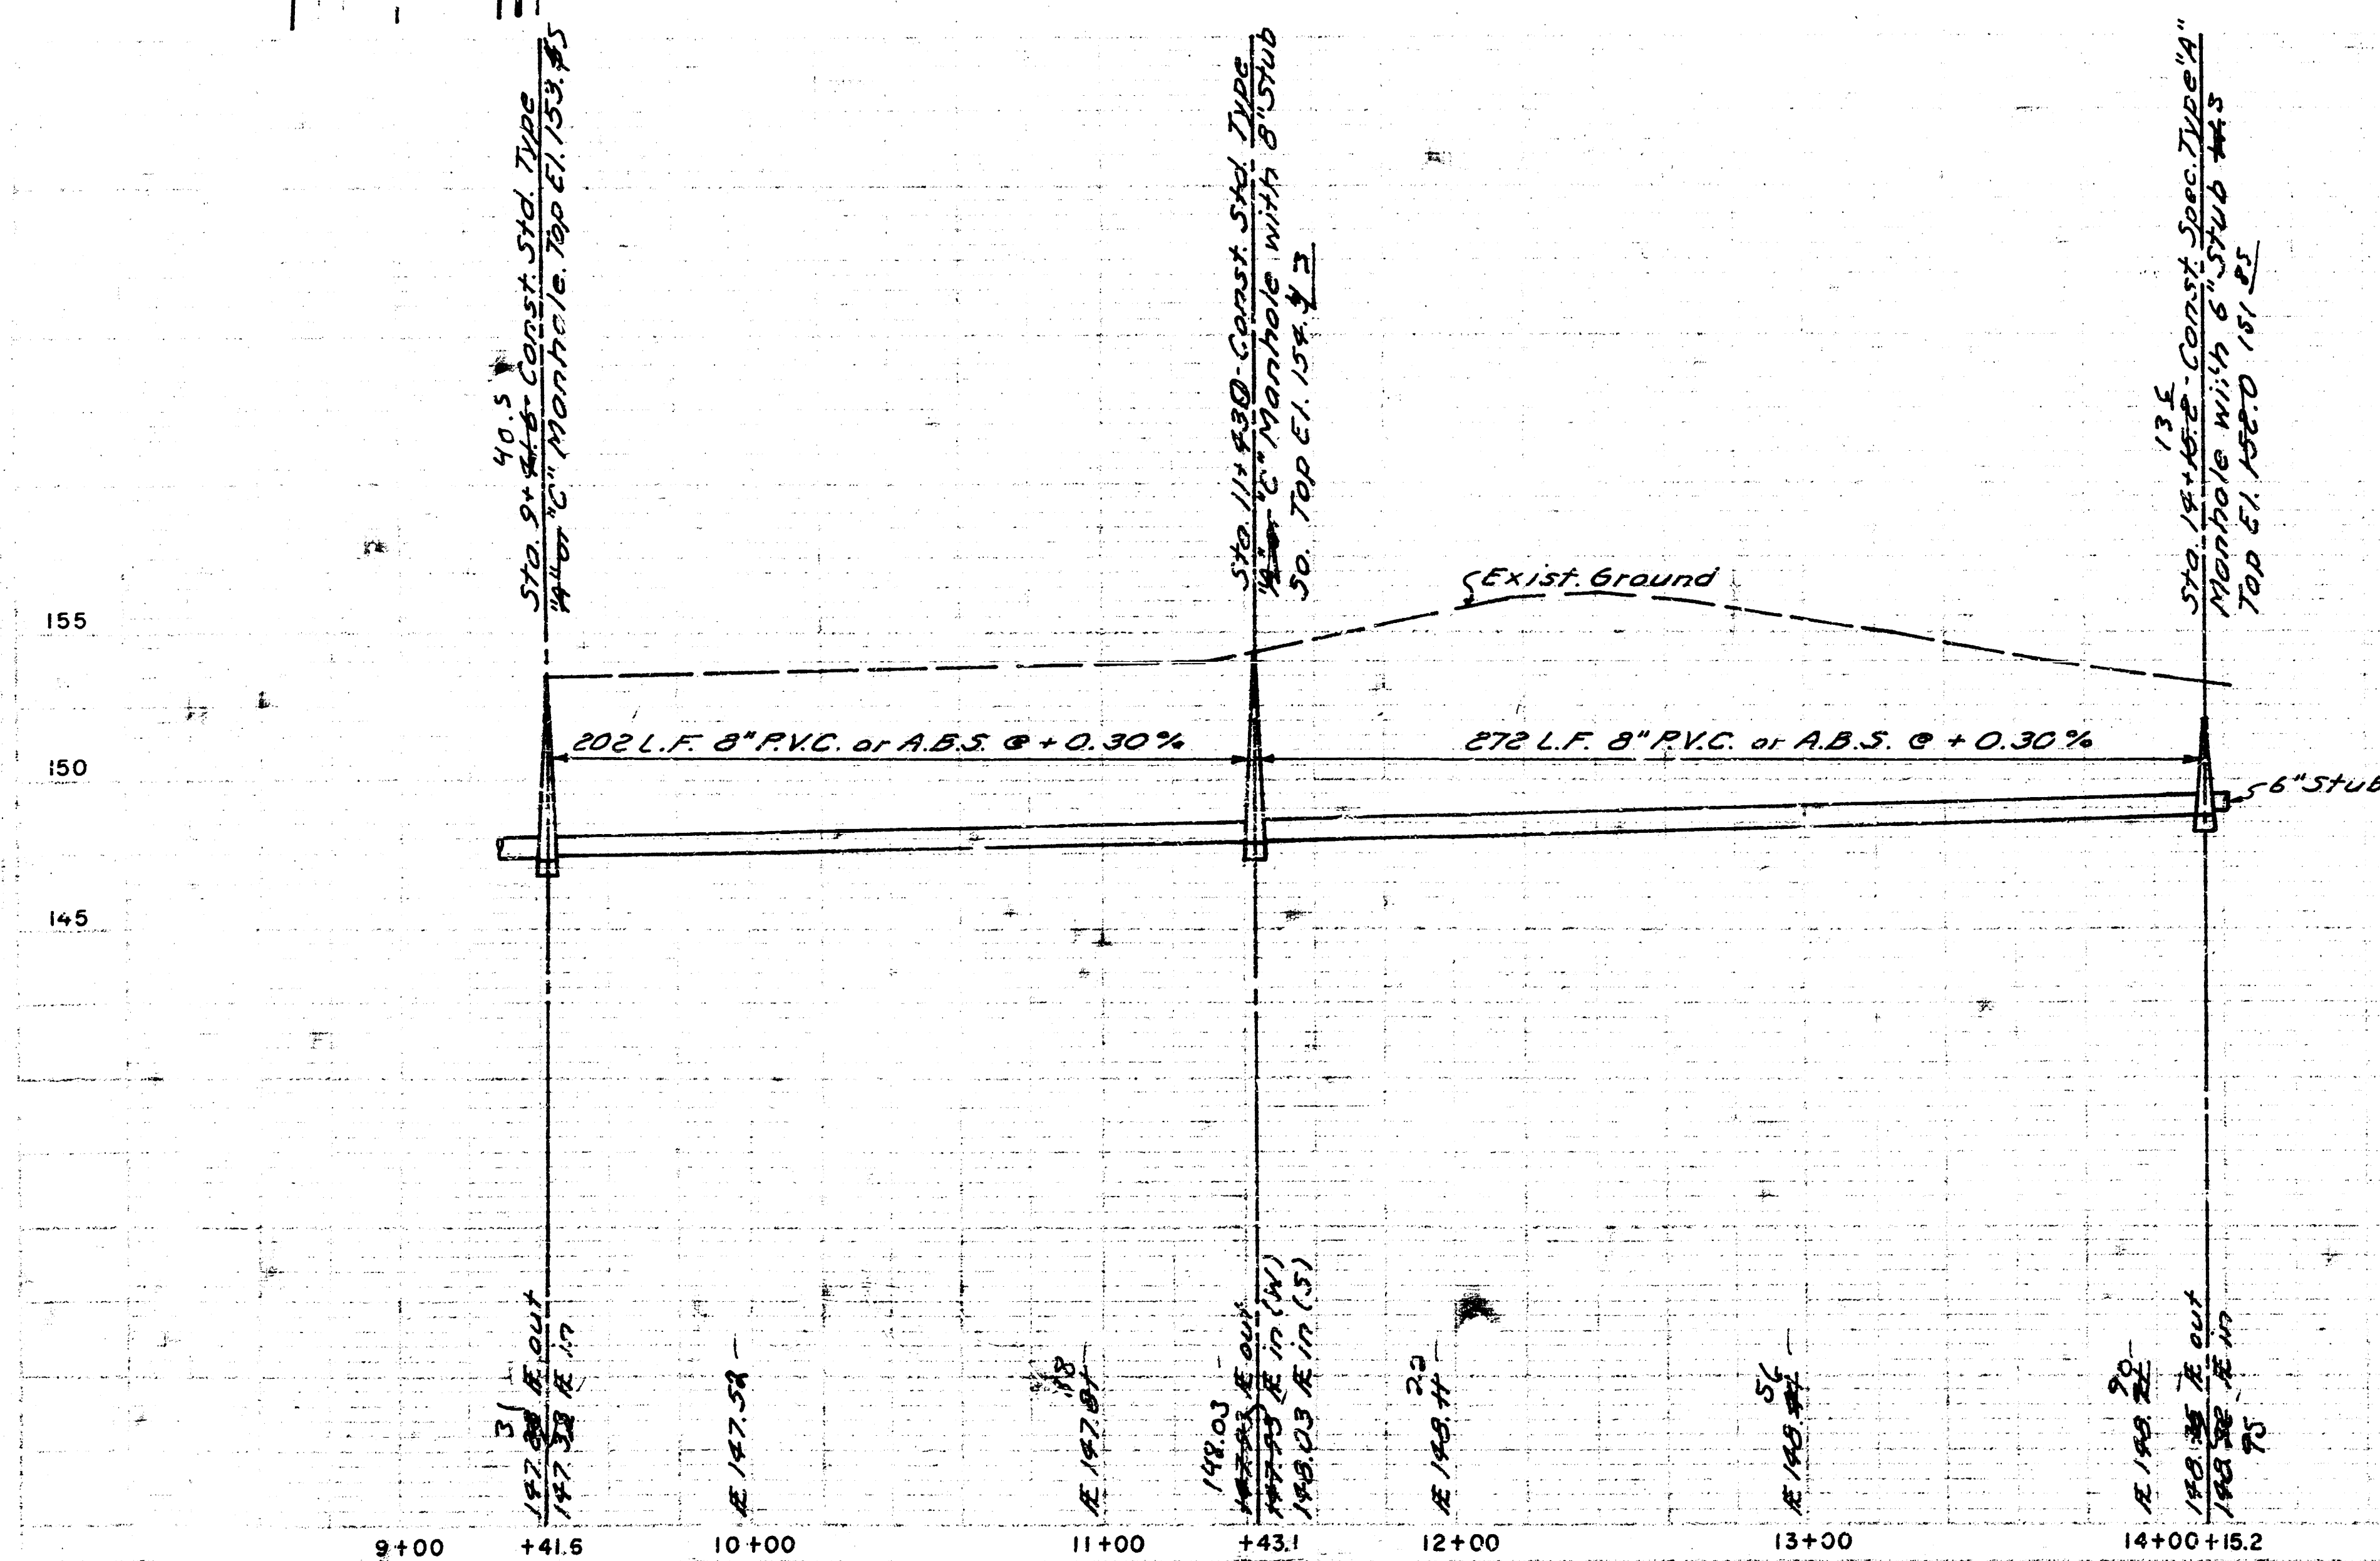

LATERAL 72 - WESTLINK SEWER  
PROJ. NO. 468-76-245-81277-000-000-001  
CITY OF WICHITA, KANSAS  
MIKE LINDBAK CITY ENGINEER

SH. 3 OF 3

14 8 3 0