


CONSTRUCTION PLANS FOR
LATERAL 78
OF THE
WESTLINK SEWER
THE CITY OF WICHITA,
SEDGWICK COUNTY, KANSAS

INDEX OF SHEETS
SHEET NO. 1 TITLE SHEET
SHEET NO. 2 KEY MAP AND PLAT
SHEET NO. 3-4 PLAN/PROFILE

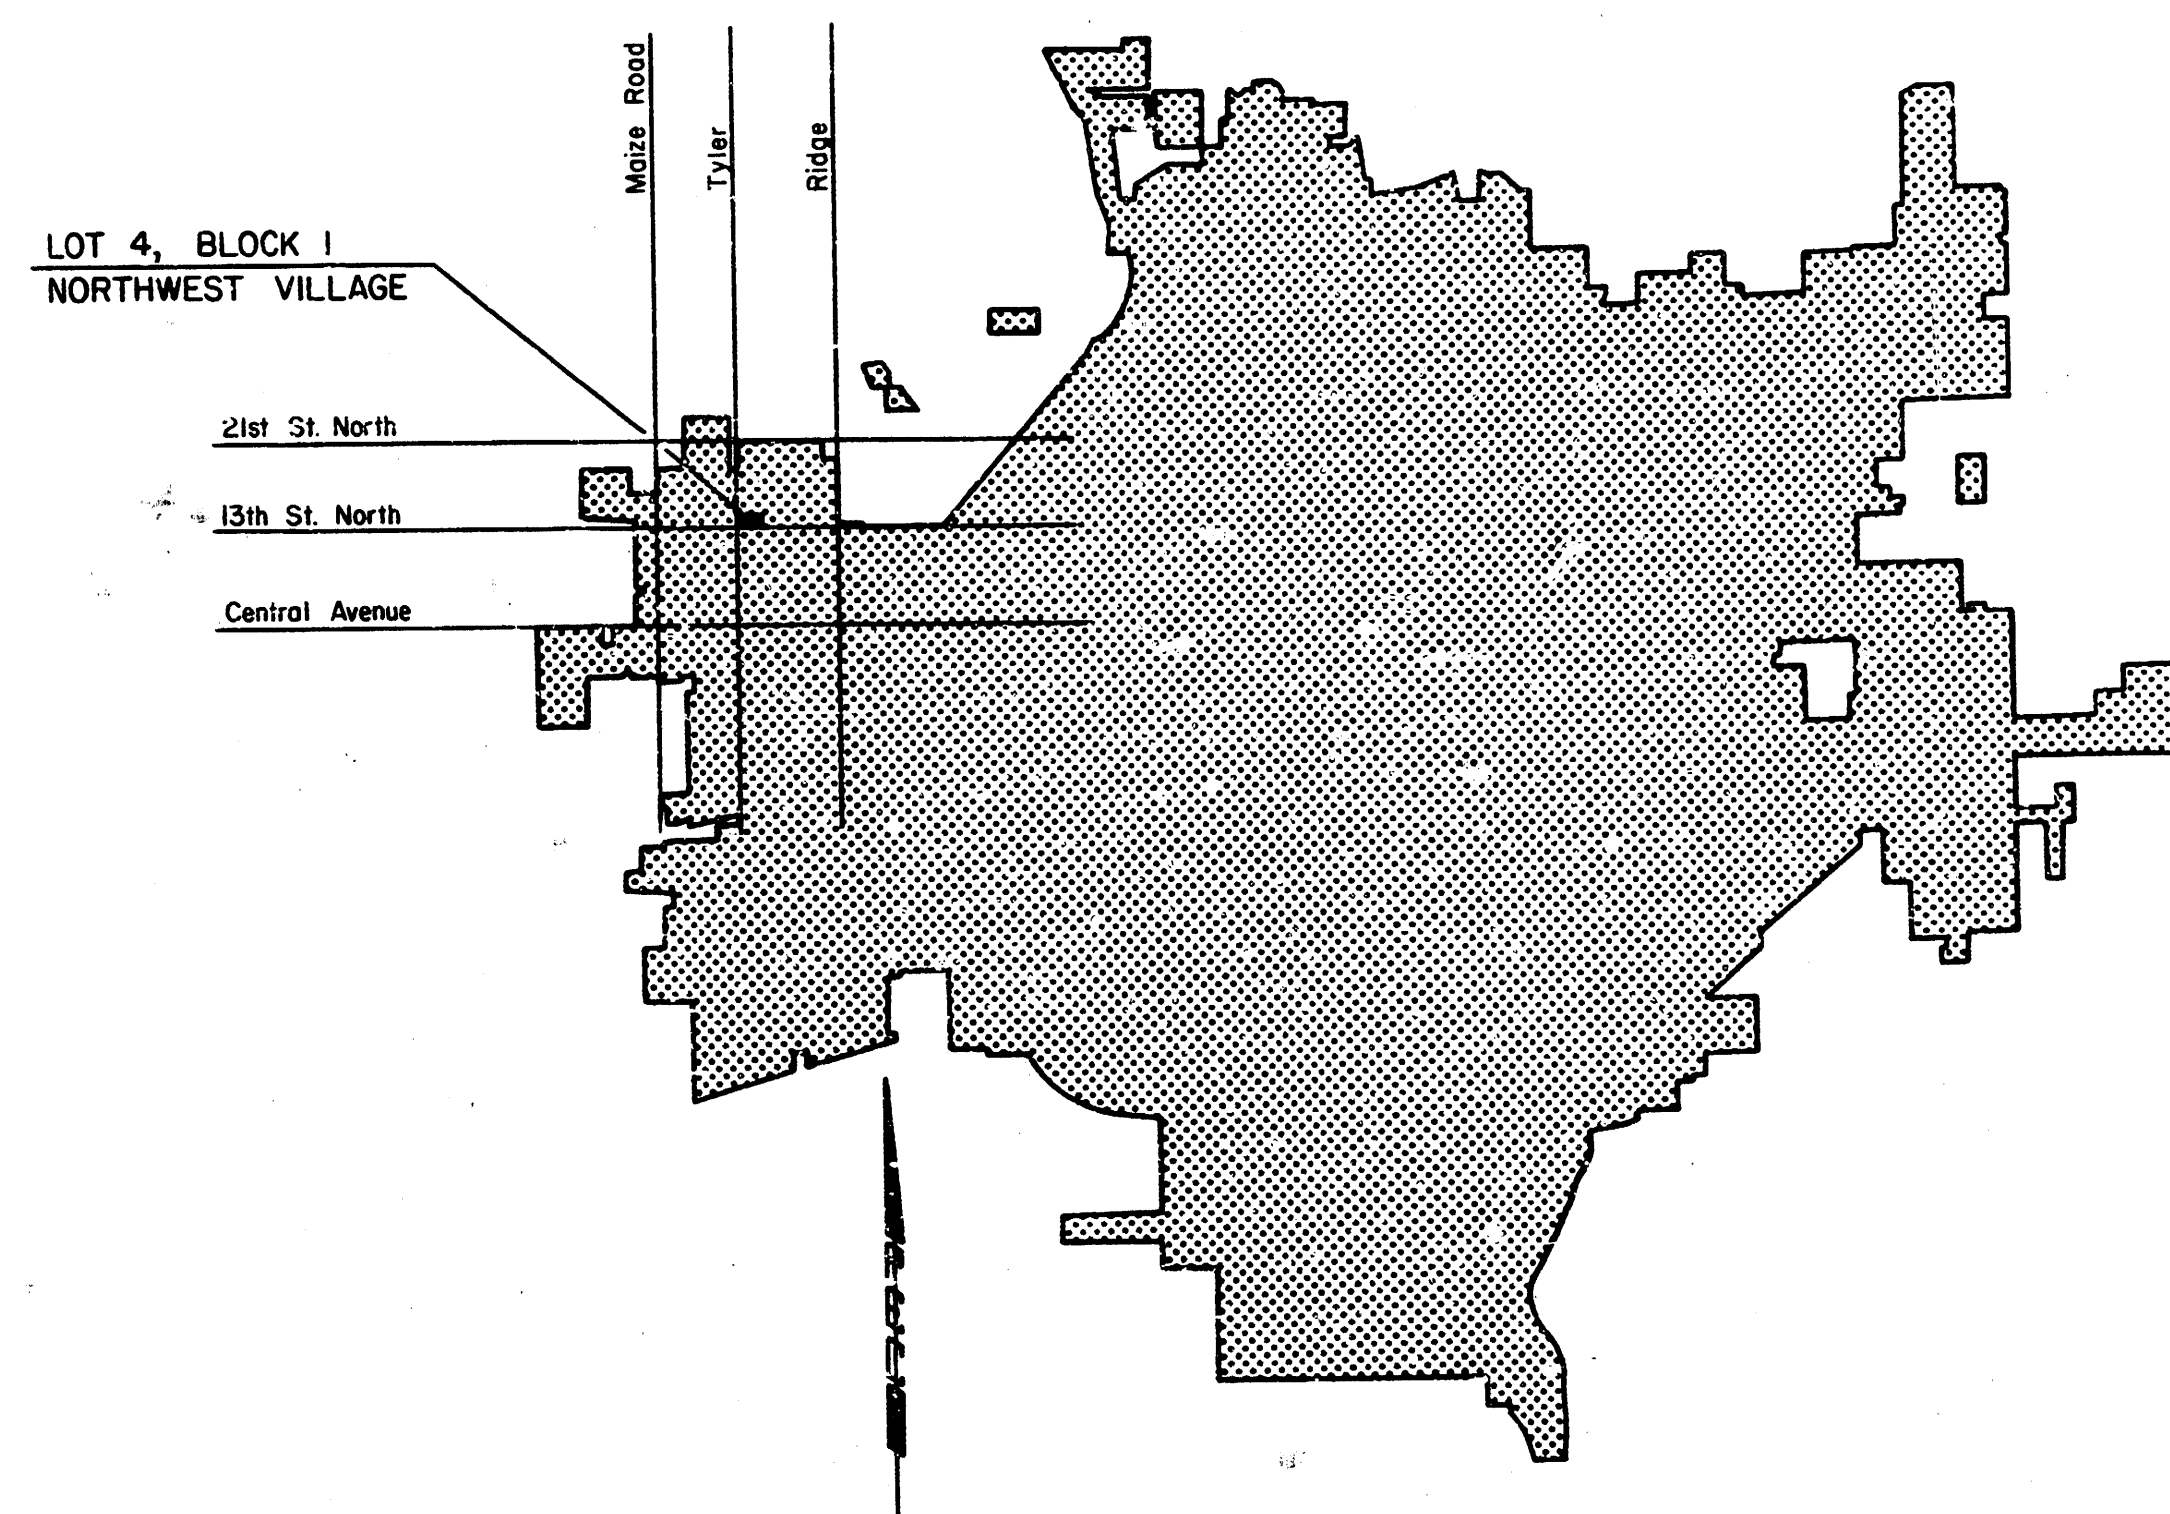


LOCATION MAP

CITY OF WICHITA PROJECT NO. 468-76-245-81375-000-000-001


MAY, 1984

PLANS PREPARED BY


PROFESSIONAL ENGINEERING CONSULTANTS, P.A.
ENGINEERS
WICHITA, KANSAS

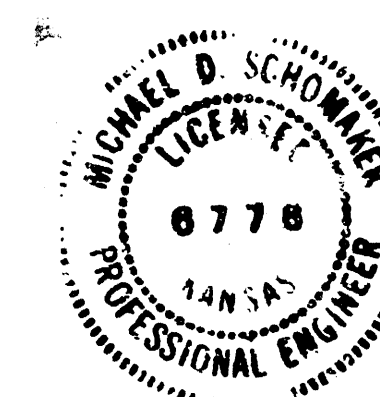

*As Built
S.L.L.
11-84*

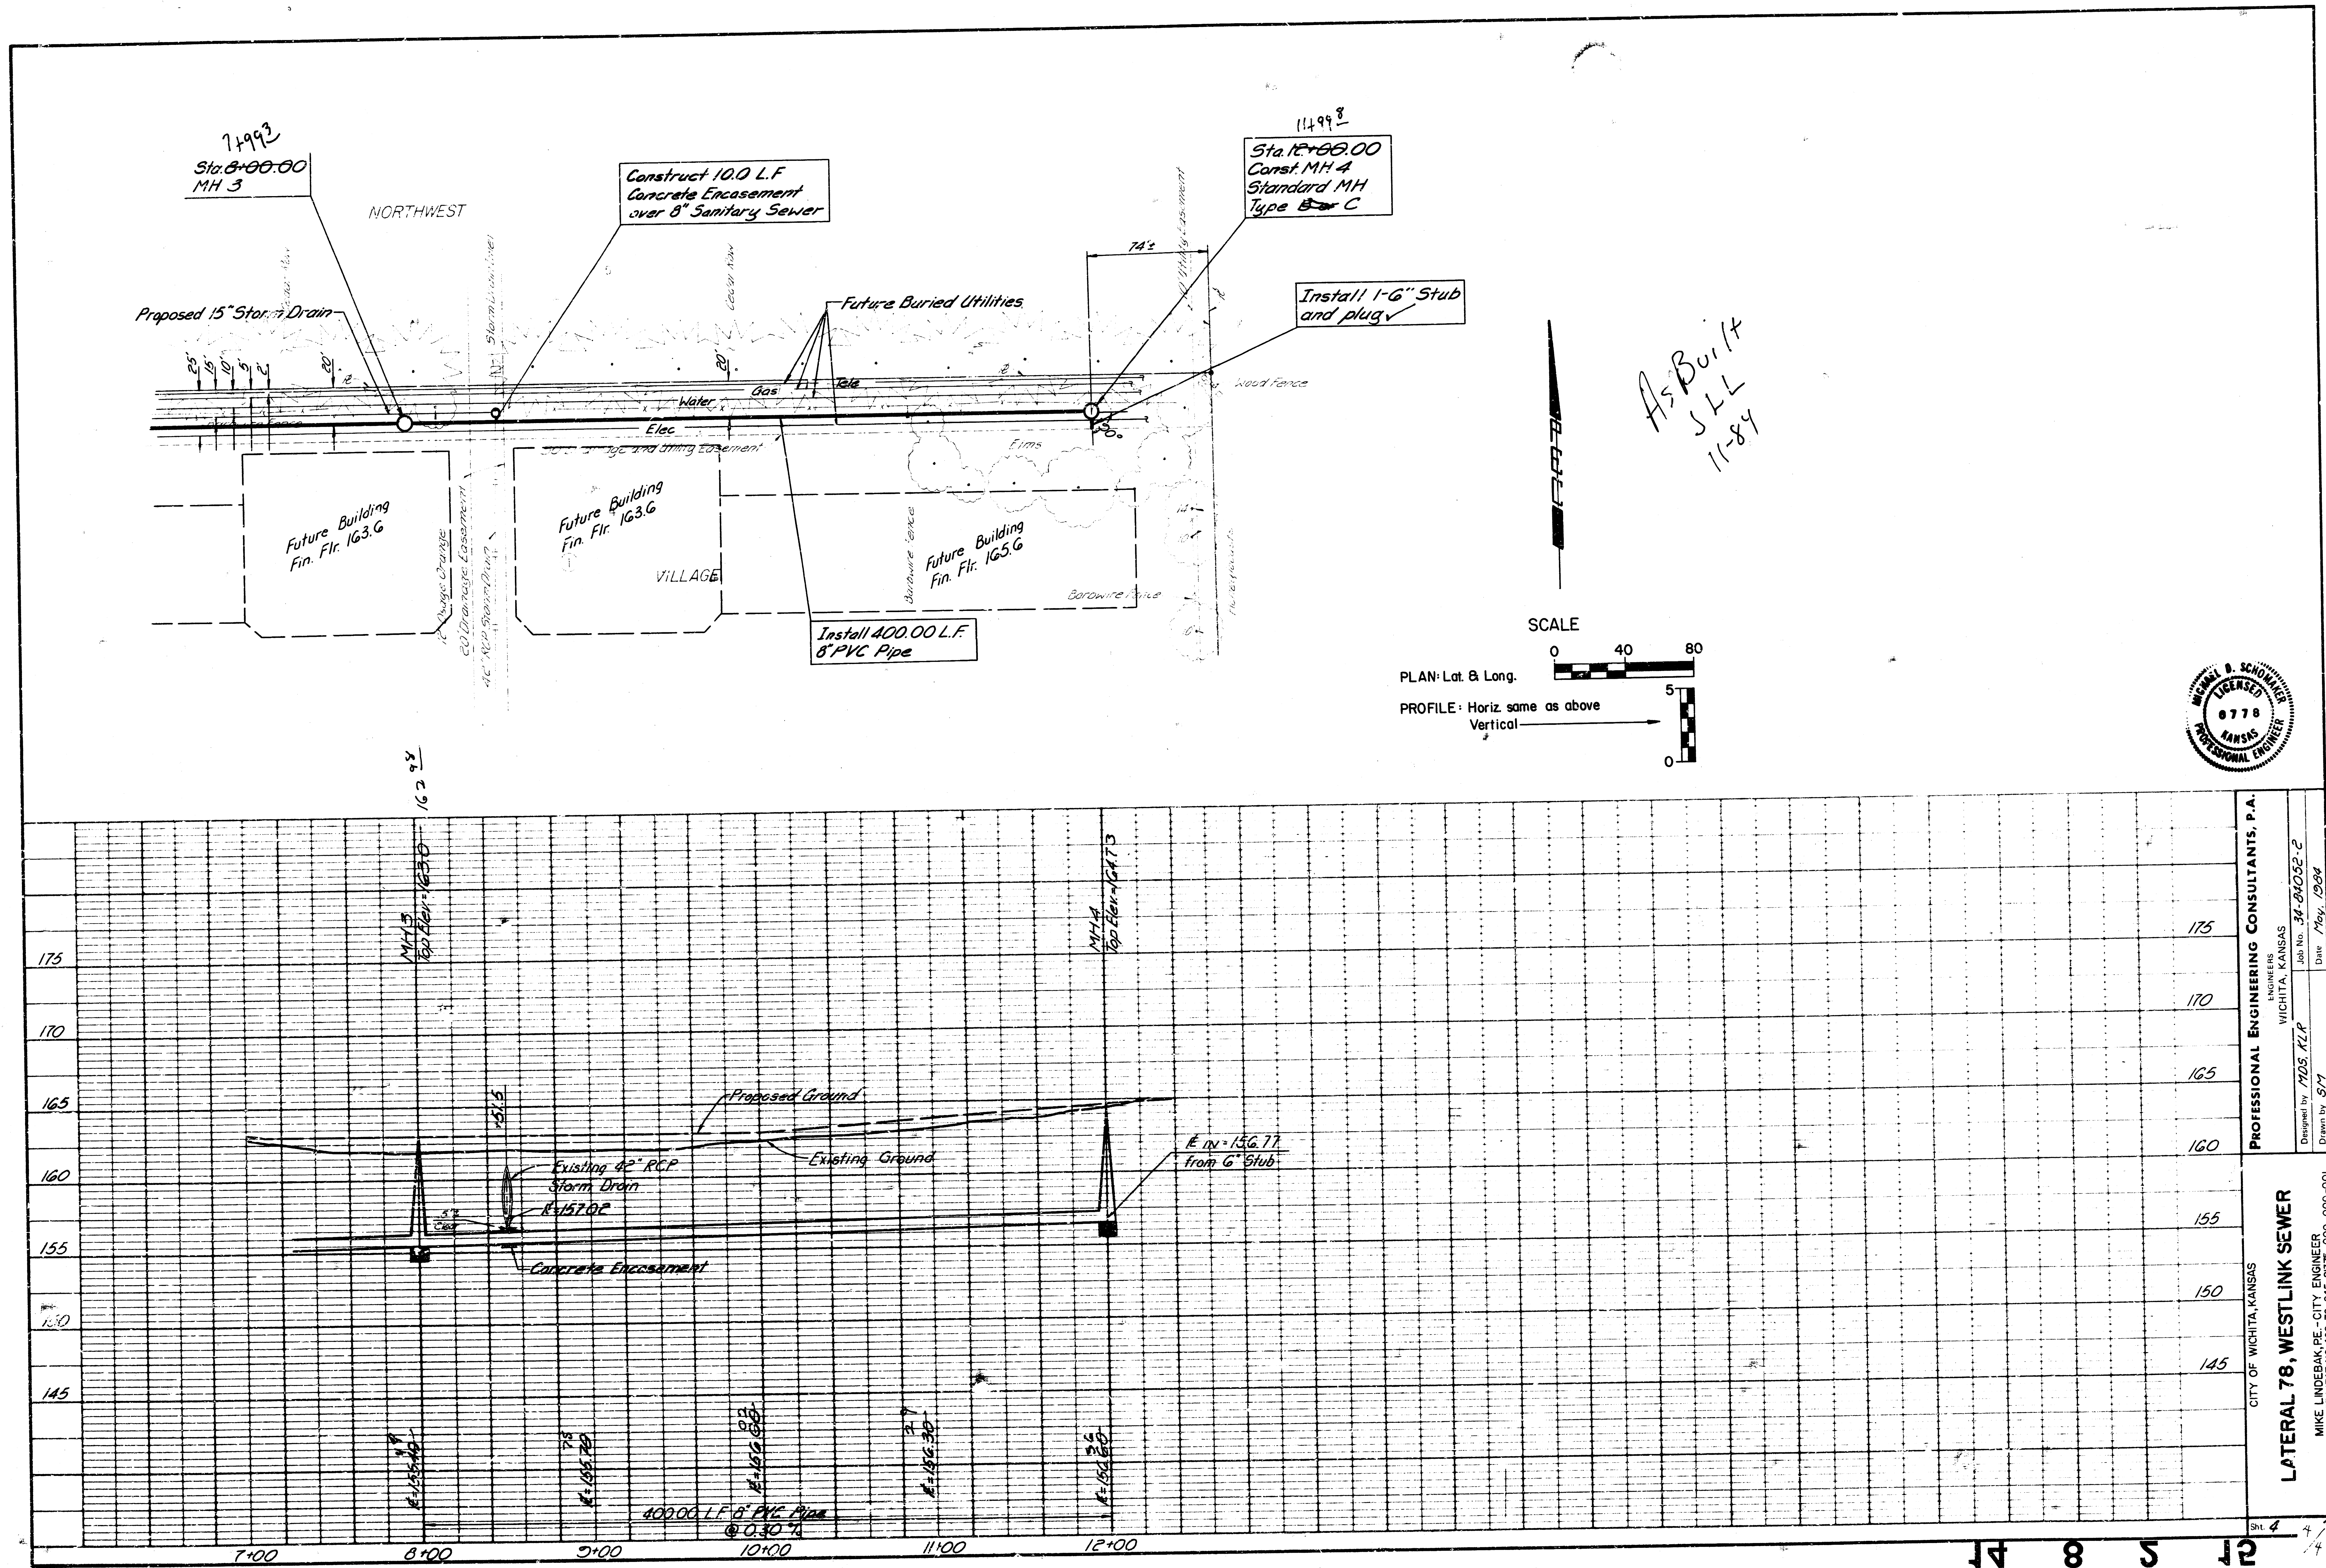

NORTHWEST VILLAGE TO WICHITA, SEDGWICK COUNTY, KANSAS

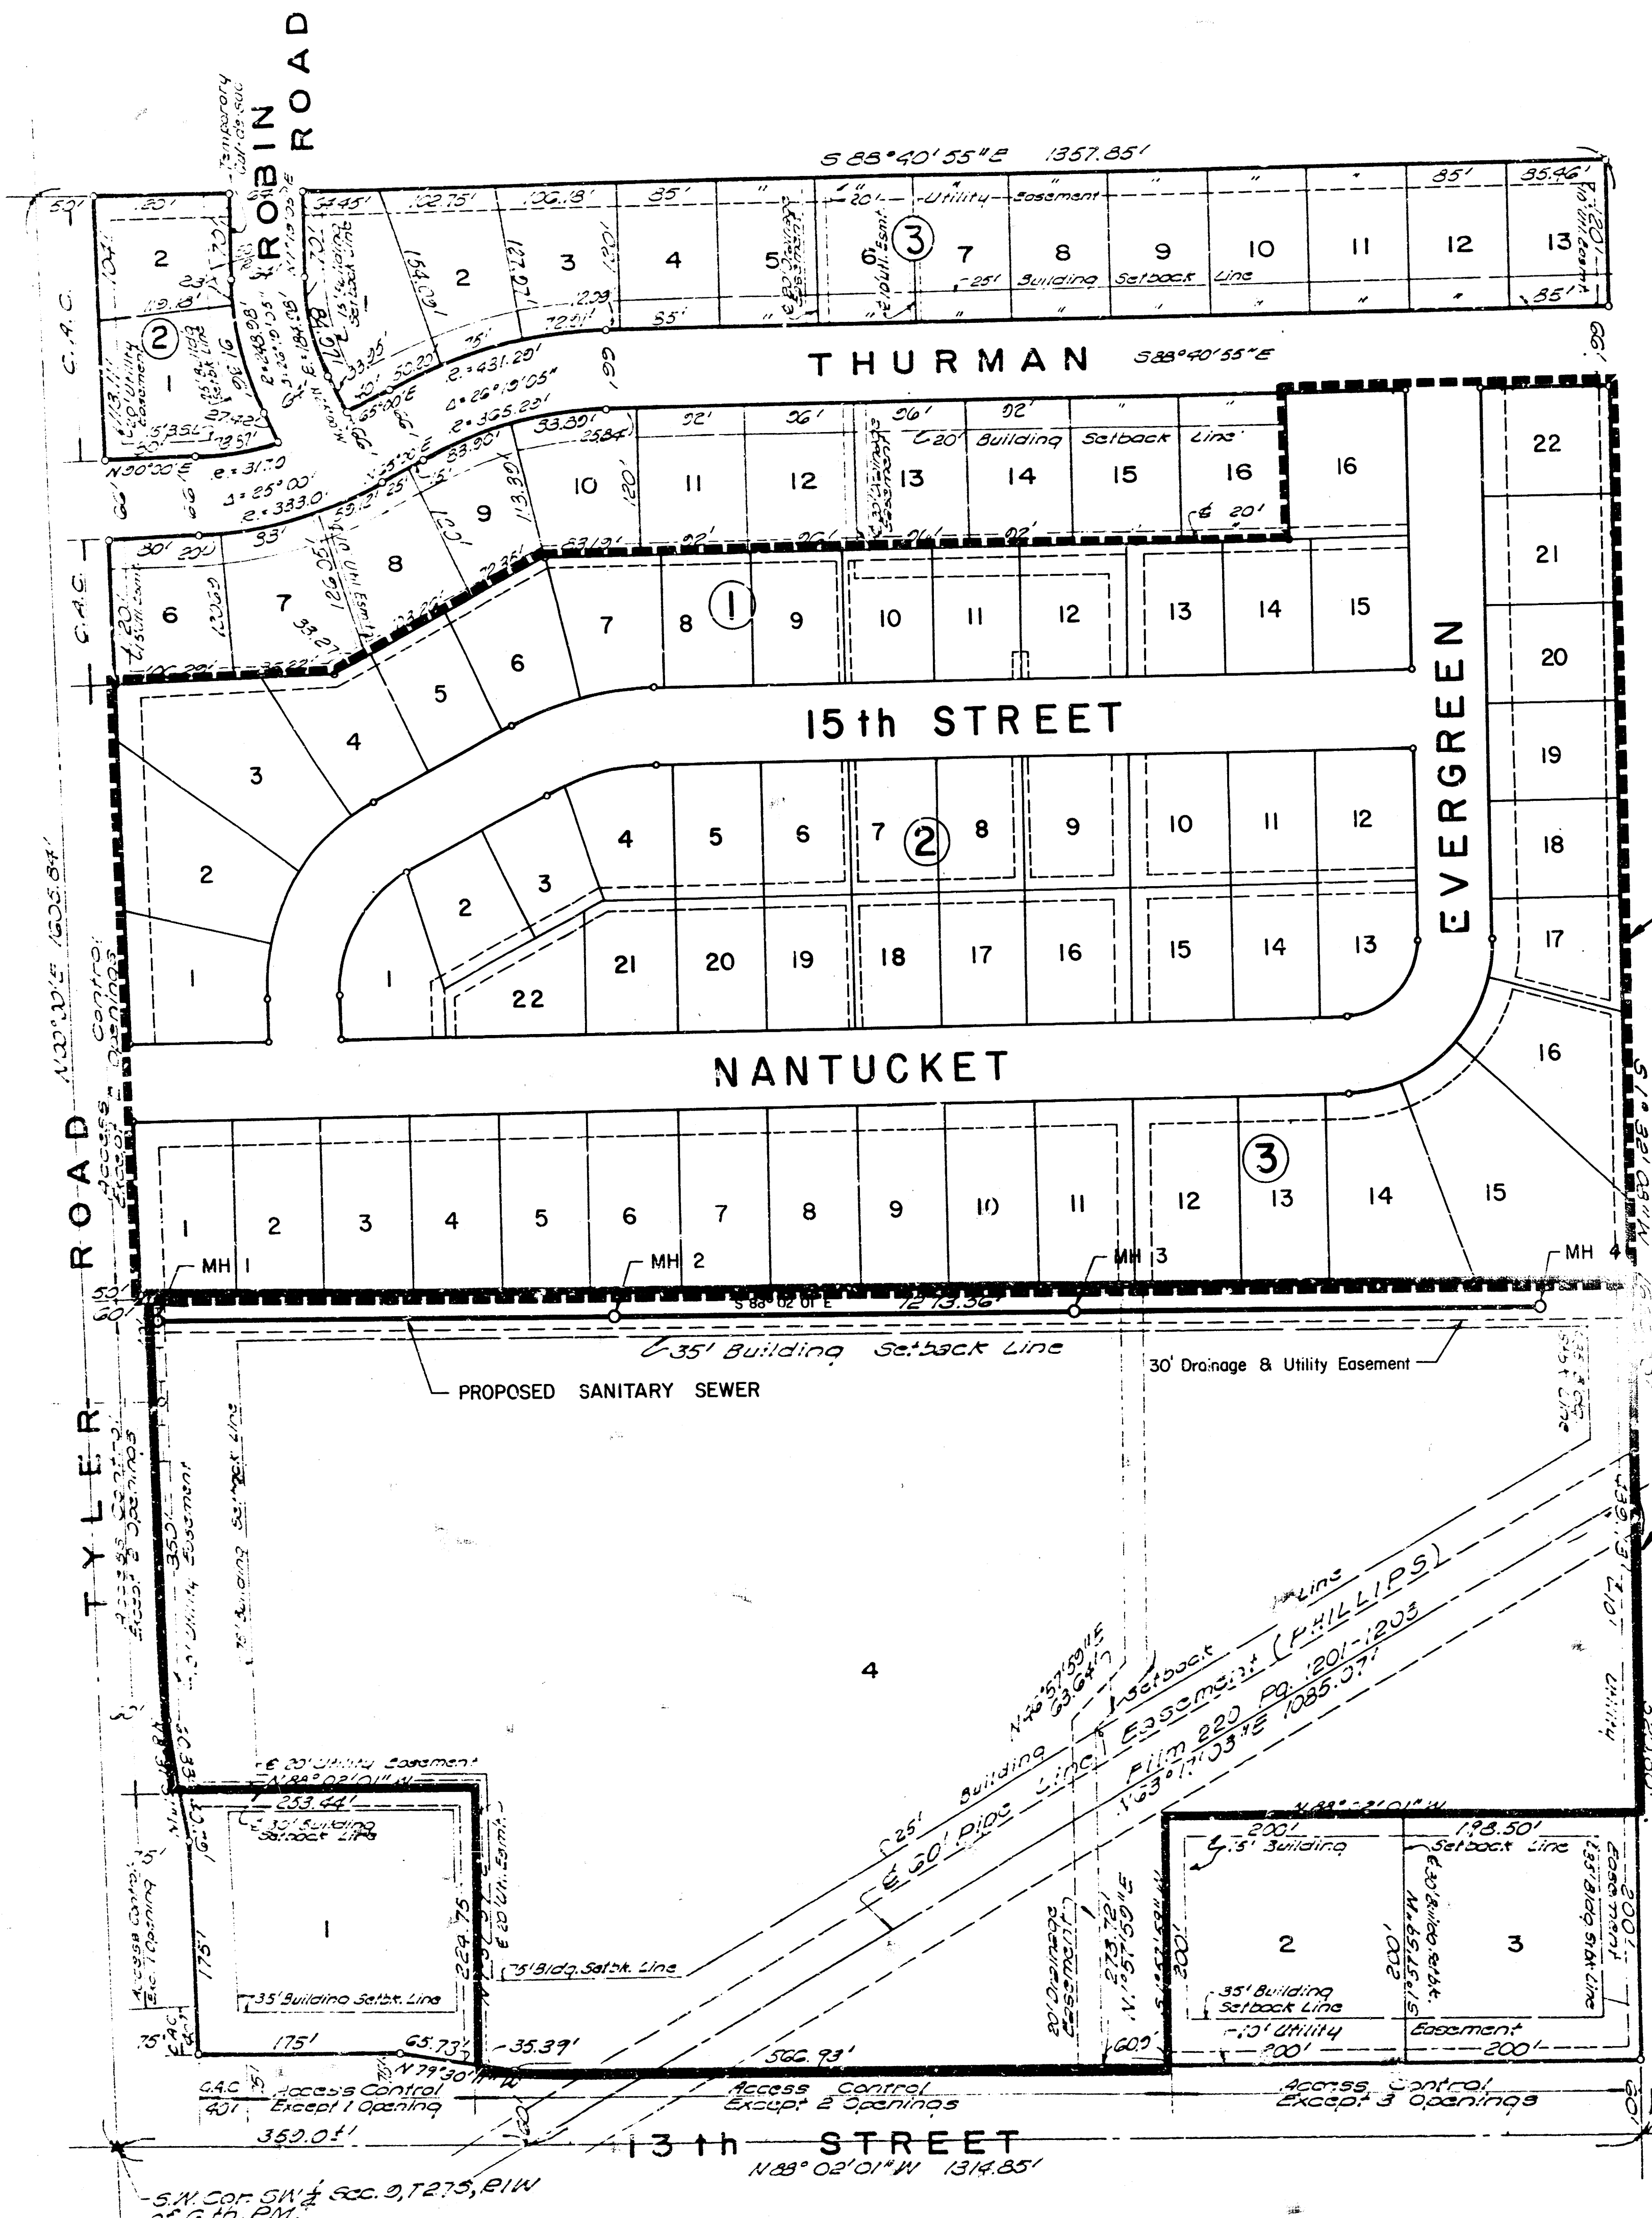

NORTHWEST VILLAGE 2ND ADDITION
A REPLAT OF LOTS 5, 17, 18 & 19, BLOCK 1, NORTHWEST VILLAGE

IMPROVEMENT DISTRICT


1"=100'

B.M. 172.48 City Std. Disc. Tyler
+ 17.17 - 31.54 - 32.15 E. both.

BENCH MARK LIST


- BM #1 - CHISELED "D" S.W. COR. CONCRETE HEADWALL @ S.W. COR. CONCRETE BOX N. SIDE 13TH ST. NORTH APPROX. 840' ± E. OF S.W. COR. SEC. 9.
ELEV. = 162.46 (CITY DATUM)
- BM #2 - RAILROAD SPIKE S.E. FACE POWER POLE N.W. COR. 13TH AND TYLER.
ELEV. = 166.83 (CITY DATUM)

FOLLOWING TESTING AND
ACCEPTANCE OF SANITARY
SEWER CONSTRUCTION, BREAK-
OUT TOP HALF OF EXISTING
PIPE

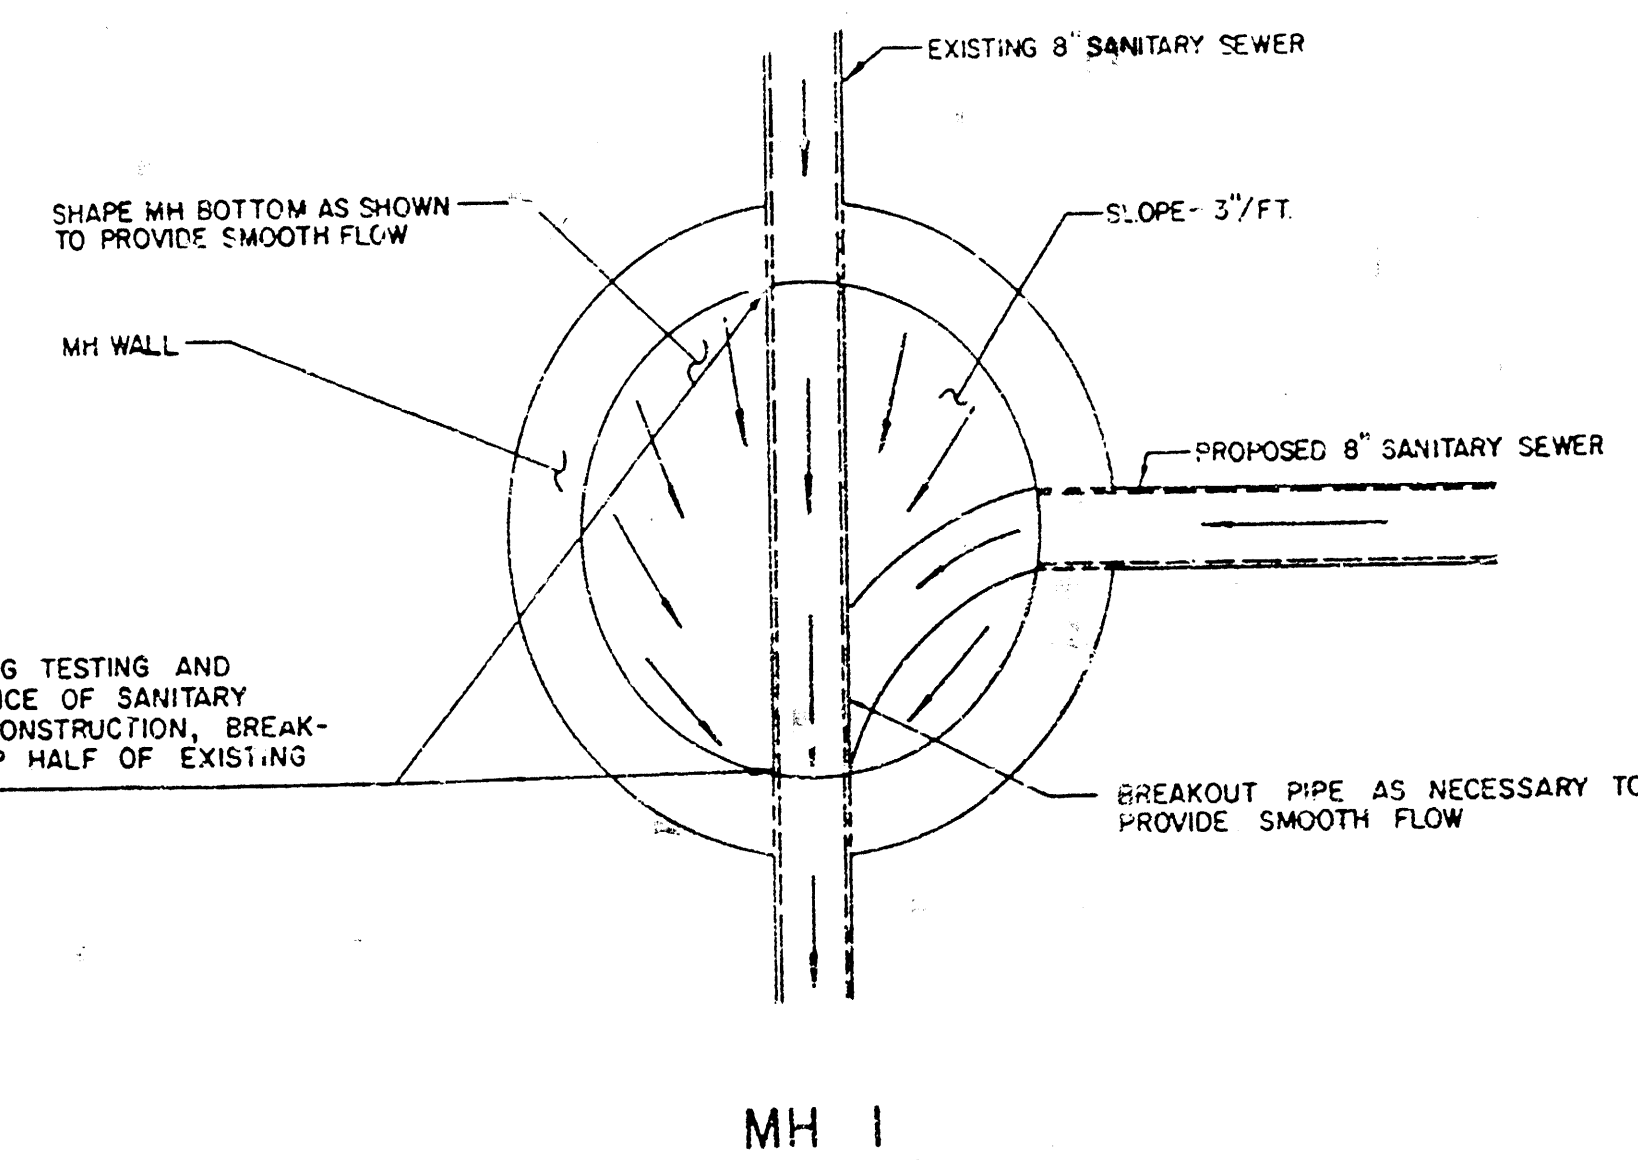




GENERAL NOTES

- ALL CONSTRUCTION AND MATERIALS TO COMPLY WITH CITY OF WICHITA SPECIFICATIONS AND STANDARDS.
- ALL ELEVATIONS SHOWN ARE CITY OF WICHITA DATUM (USGS-1167.4 = CITY DATUM).
- THE CONTRACTOR SHALL LIMIT THE EXTENT OF TRENCH TO REMAIN OPEN OVERNIGHTS AND WEEKENDS TO LESS THAN 50 FEET.
- AT LEAST 24 HOURS PRIOR TO BEGINNING EXCAVATION (EXCLUDING WEEKENDS AND HOLIDAYS), THE CONTRACTOR SHALL CONTACT THE UTILITY LOCATION SERVICE "KAY-U-DIG-IT" AT (316) 267-2889 TO REQUEST THE FOLLOWING UTILITY COMPANIES TO LOCATE ANY EXISTING LINES WITHIN THE PROJECT AREA: GAS SERVICE COMPANY, K.G. & E., SOUTHWESTERN BELL TELEPHONE COMPANY, THE WICHITA WATER DEPARTMENT, AND AIR CAPITAL CABLEVISION.
- THE BURIED UTILITIES AS LOCATED ON THE PLANS ARE APPROXIMATE LOCATIONS ONLY. IT SHOULD BE NOTED THAT OTHER BURIED LINES AND CABLES MAY EXIST WHICH ARE NOT SHOWN ON THESE PLANS. THE CONTRACTOR SHALL EXERCISE EXTREME CAUTION DURING TRENCHING OPERATIONS TO AVOID DAMAGING THESE LINES. ANY LINES DAMAGED SHALL BE REPLACED OR REPAIRED IMMEDIATELY AS DIRECTED BY THE ENGINEER AT THE CONTRACTOR'S EXPENSE.
- THE CONTRACTOR SHALL RESTORE ALL DITCHES, SWALES, ROAD SHOULDERS, ENTRANCES, AND BANK LINES TO THEIR ORIGINAL SLOPES AND GRADES.
- THE CONTRACTOR SHALL BE RESPONSIBLE FOR PRESERVING PROPERTY IRONS. THE CONTRACTOR SHALL BE REQUIRED TO RE-ESTABLISH ANY PROPERTY IRONS WHICH ARE DAMAGED OR DESTROYED BY HIS CONSTRUCTION OPERATIONS. SUCH IRONS SHALL BE RE-ESTABLISHED BY A LICENSED LAND SURVEYOR OR A LICENSED PROFESSIONAL ENGINEER IN ACCORDANCE WITH STATE LAWS. ALL COSTS FOR THIS WORK SHALL BE SUBSIDIARY TO THE OTHER ITEMS OF WORK.
- THE CONTRACTOR SHALL DISPOSE OF ALL EXCESS EXCAVATED SOIL ON SITE AS DIRECTED BY THE ENGINEER.
- THE CONTRACTOR SHALL AVOID REMOVAL OR TRIMMING OF ANY TREES WHERE POSSIBLE. WHERE THE CONTRACTOR BELIEVES THE REMOVAL OR TRIMMING IS UNAVOIDABLE, HE SHALL COORDINATE SUCH WORK WITH THE ENGINEER.
- TREE REMOVAL AND TREE TRIMMING SHALL BE DONE BY THE CONTRACTOR UNDER THE SUPERVISION OF THE ENGINEER AND SHALL BE CONSIDERED AS SUBSIDIARY TO OTHER ITEMS OF WORK.
- TREES REMOVED, TREE TRIMMINGS, FENCES AND OTHER DEBRIS SHALL BE HAULED FROM THE SITE BY THE CONTRACTOR AND WASTED AS DIRECTED BY THE ENGINEER AT NO ADDITIONAL COST TO THE OWNER.
- ~~RISERS AND ADDITIONAL STUBS SHALL BE INSTALLED ON THIS PROJECT TO SERVE FUTURE BUILDINGS WHEN ORDERED BY THE FIELD ENGINEER. RISER CONSTRUCTION SHALL CONFORM TO CITY OF WICHITA SPECIFICATIONS AND STANDARDS. LOCATIONS OF THE ENDS OF THE RISER SHALL BE MARKED BY FASTENING GREEN COLORED PLASTIC TAPE TO THE END OF THE RISER AND BROUGHT TO THE GROUND SURFACE AS THE EXCAVATION IS BACKFILLED SUCH THAT THE COLORED TAPE WILL BE VISIBLE WHEN THE PROJECT IS COMPLETED. ALL RISERS SHALL BE CONSTRUCTED USING S.D.R. 29.5 A.B.S. OR P.V.C. PIPE.~~
- PRIOR TO BEGINNING CONSTRUCTION, THE CONTRACTOR SHALL EXCAVATE AT THE PROPOSED LOCATION OF MH 1 TO VERIFY THE LOCATION AND ELEVATION OF THE EXISTING SEWERLINE. THE CONTRACTOR SHALL NOTIFY THE ENGINEER IMMEDIATELY IF IT APPEARS THAT ADJUSTMENTS TO THE PROPOSED LOCATION OR ELEVATION ARE NECESSARY.

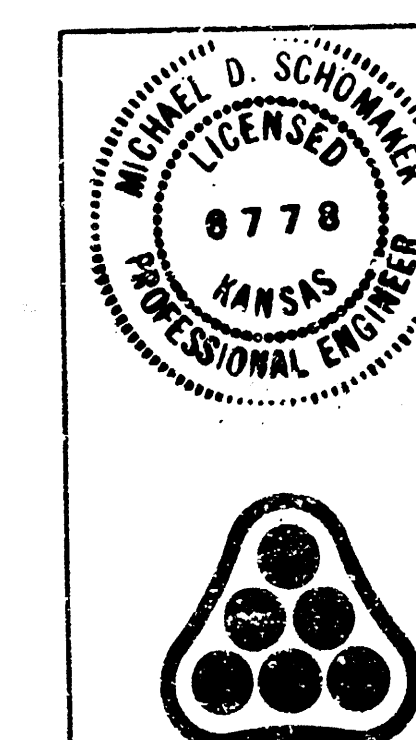


Revision		By	Date
CITY OF WICHITA, KANSAS			
KEY MAP AND PLAT			
MIKE LINDEBAK, P.E. - CITY ENGINEER			
CITY OF WICHITA PROJECT NO. 463-73-245-8375-000-000-001			
PROFESSIONAL ENGINEERING CONSULTANTS, P.A.			
ENGINEERS			
WICHITA, KANSAS			
Designed by MDS, KLR	Job No. 34-84052-2	Page 2 of 4	
Drawn by G.M. RF	Date May, 1984		

Note: Any sidewalk removal which the Contractor deems necessary for construction of the Sanitary Sewer shall be replaced in kind and shall be considered subsidiary to the project.

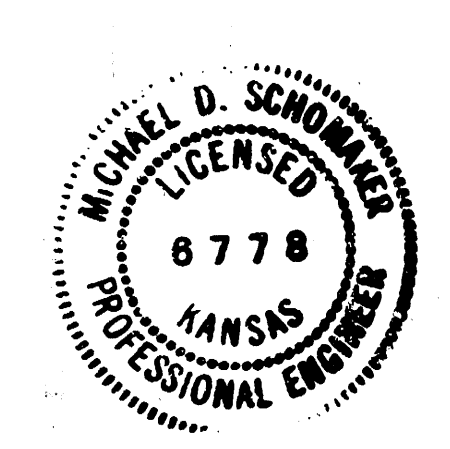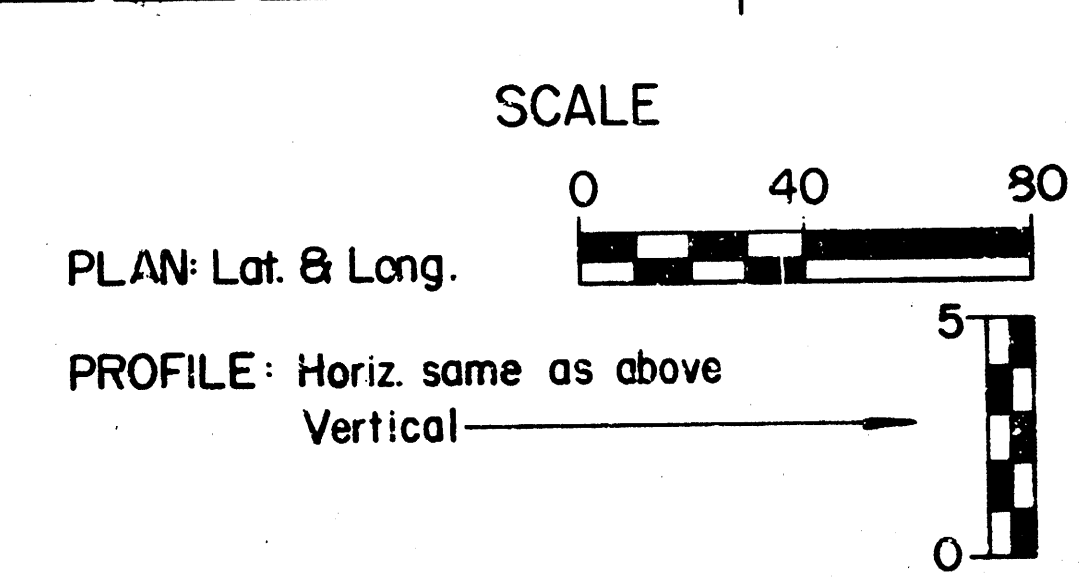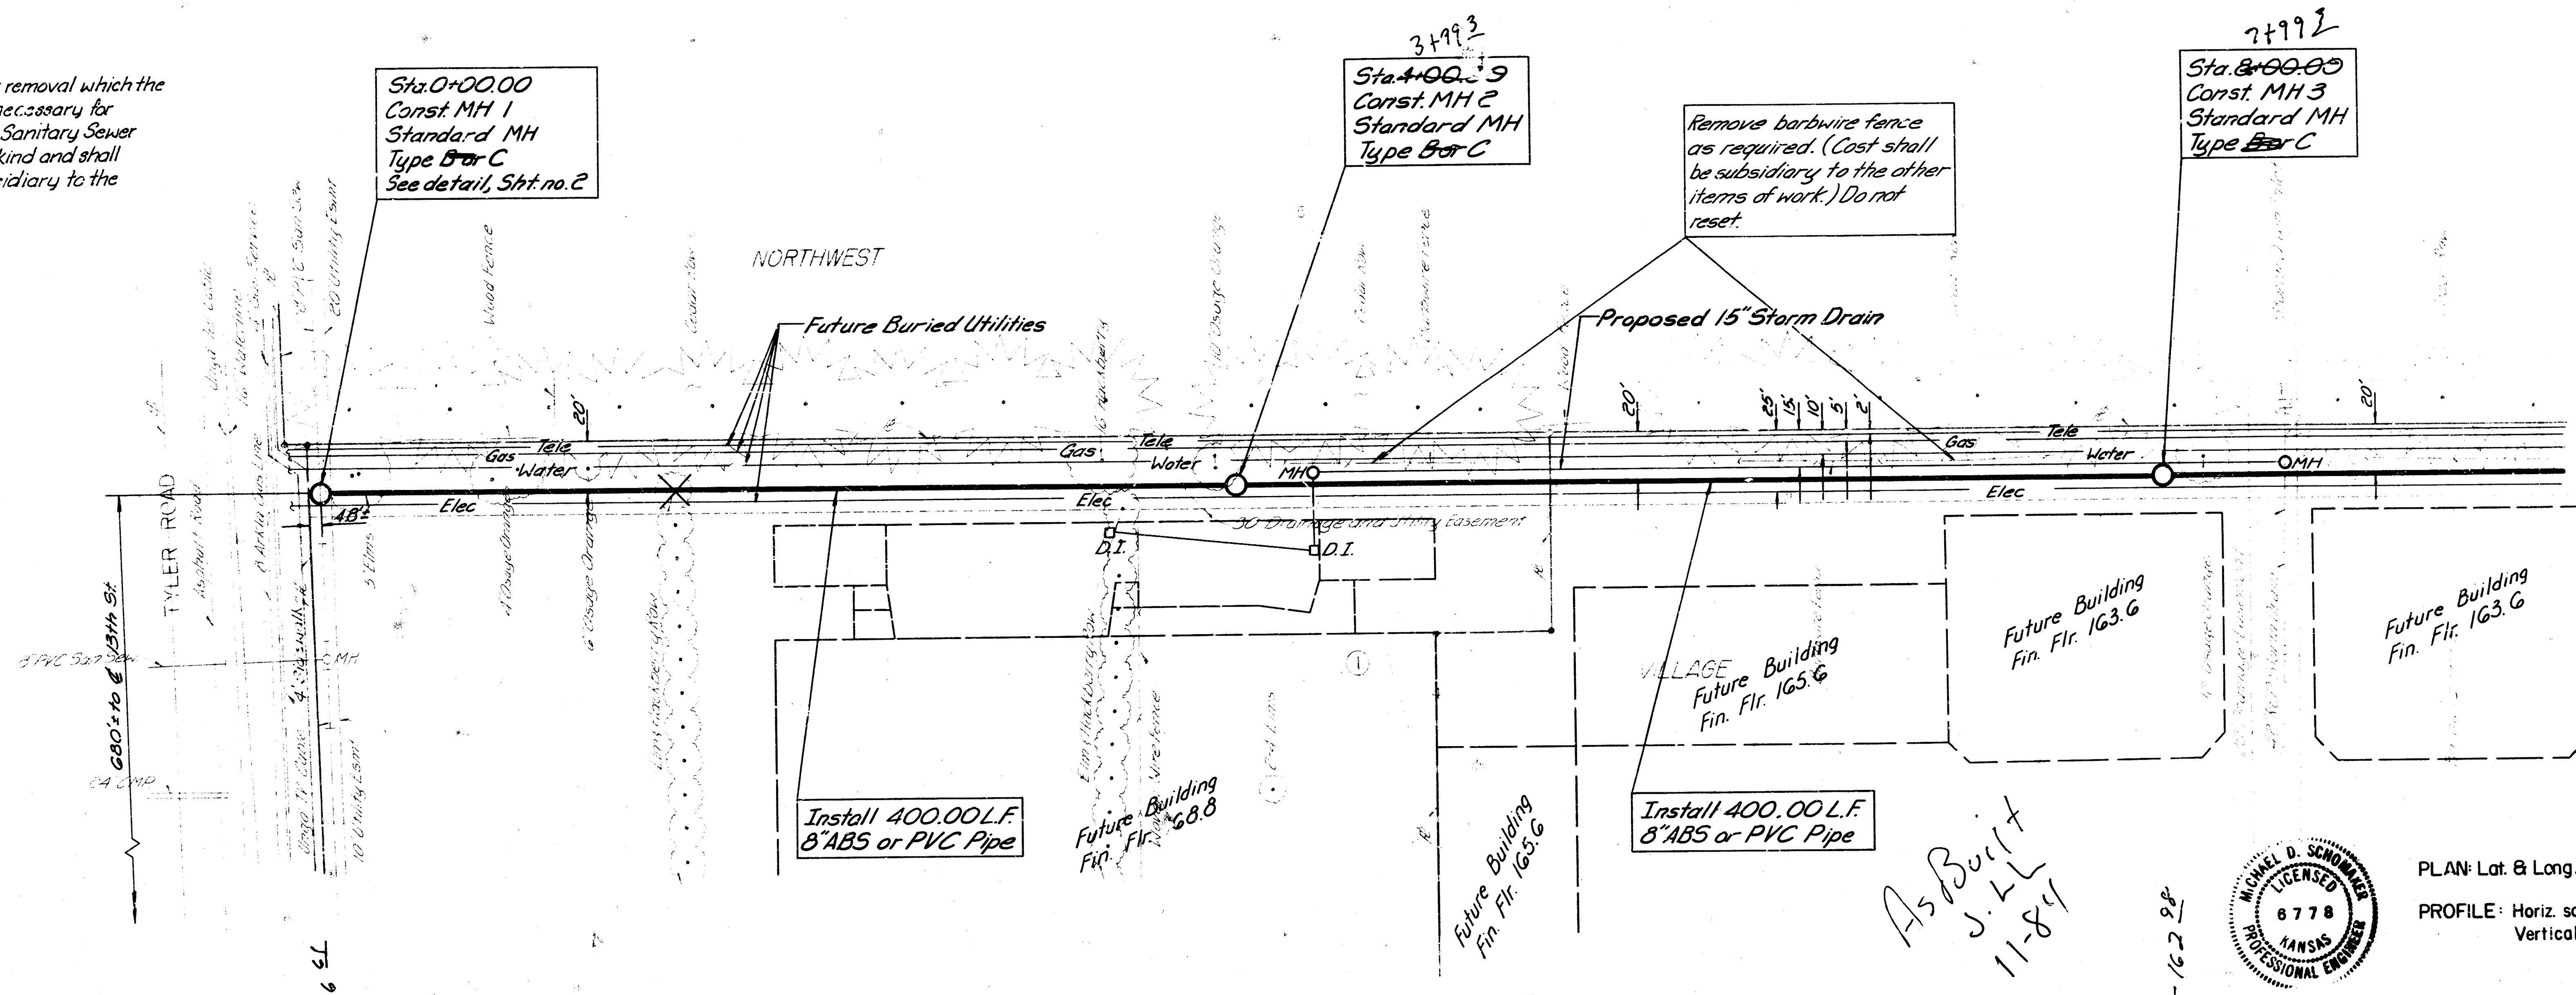

As Built
J.L.L.
11-84

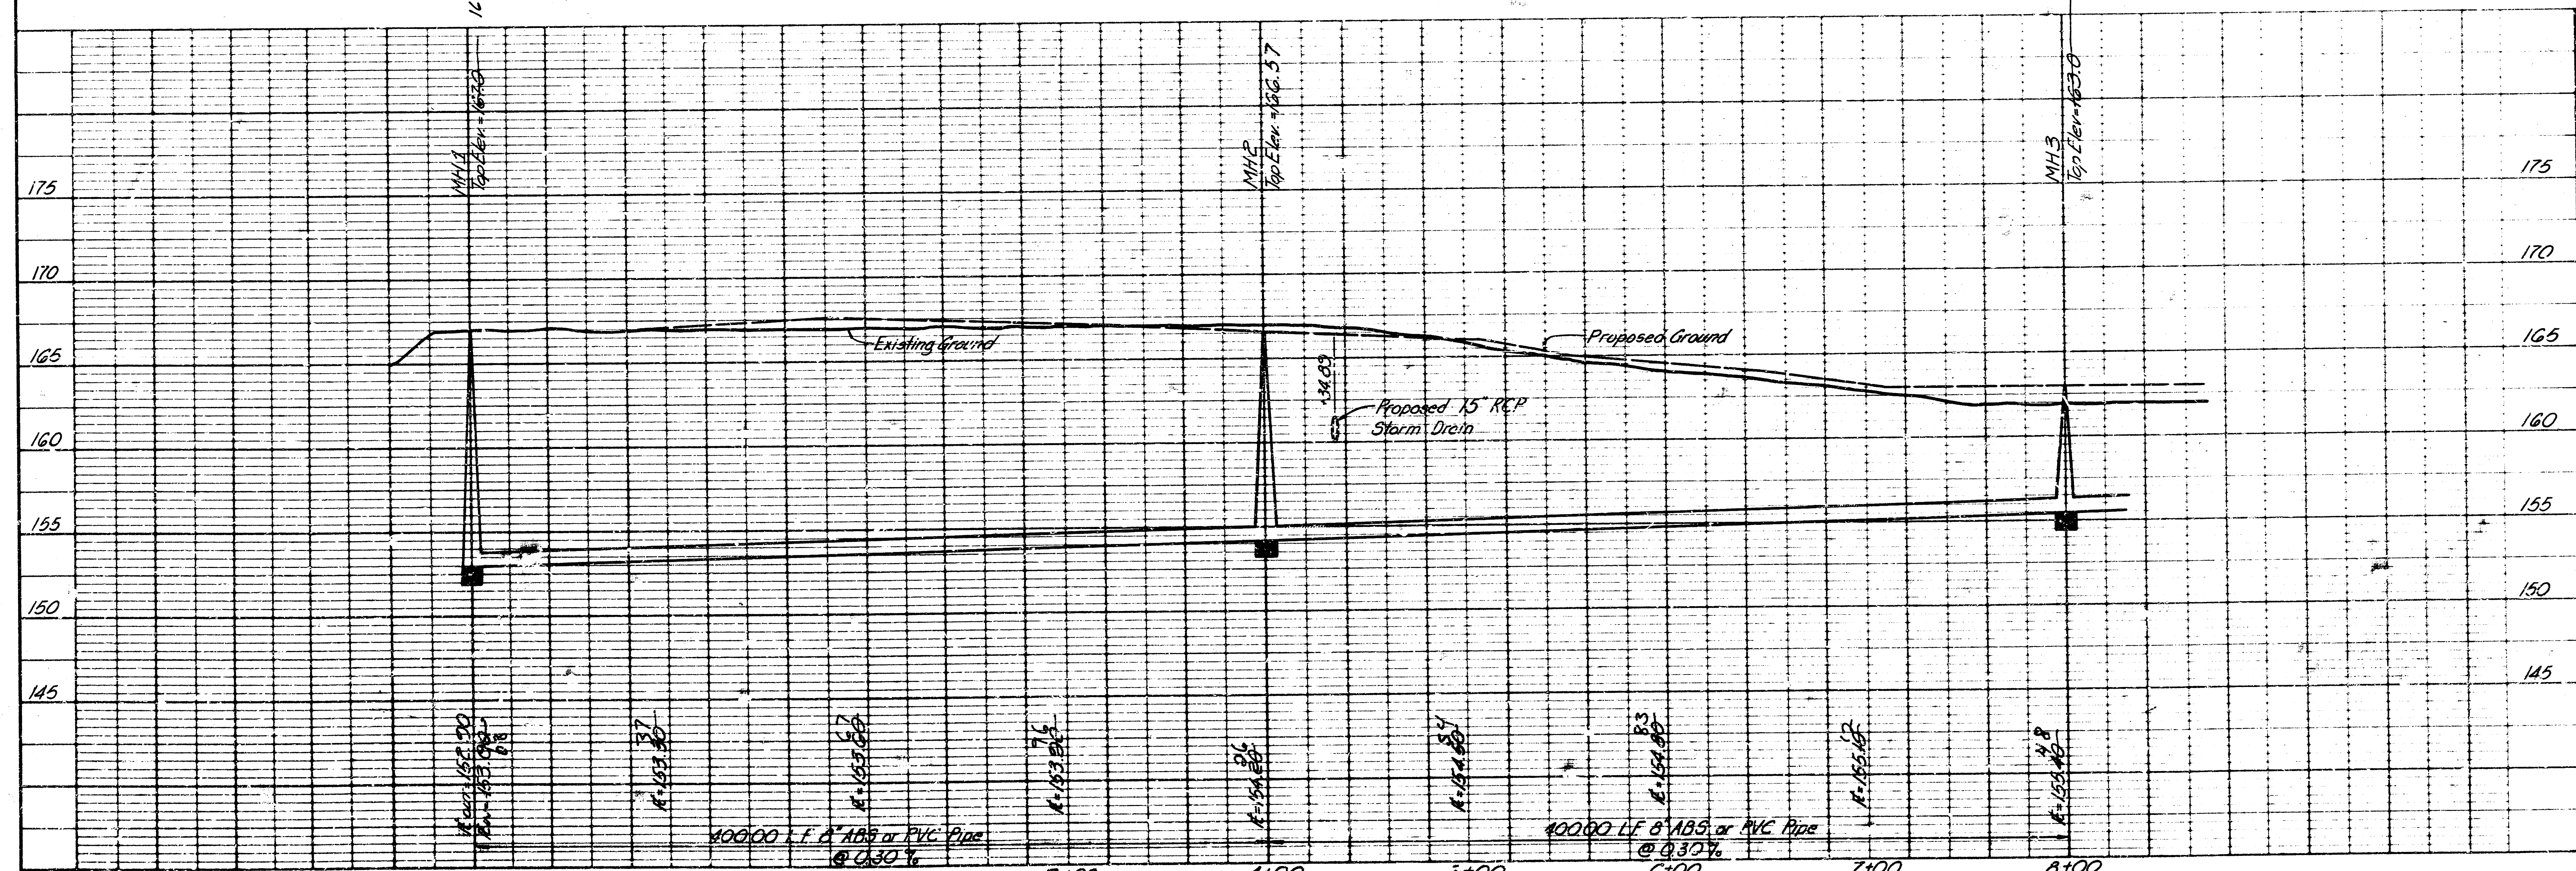

PROFESSIONAL ENGINEERING CONSULTANTS, P.A.
ENGINEERS
WICHITA, KANSAS
Job No. 34-84052-2
Designed by: MDS, KLP
Drawn by: STY
Date: May, 1984

CITY OF WICHITA, KANSAS
LATERAL 78, WESTLINK SEWER
MK: UNDERAK PE - CITY ENGINEER
CITY OF WICHITA PROJECT NO. 488-75-245-8375-000-000-001

Sht. 3 of 3