

LATERAL 87 - WESTLINK INTERCEPTOR

TO SERVE PART OF LOT 1, TIMBER GROVE LAKES ADDITION

PROJECT NO.

468-76-245-81780-000 000-001


CITY OF WICHITA, KANSAS

MICHAEL E. LINDEBAK


CITY ENGINEER

GENERAL NOTES

1. Underground utility service lines and overhead utility poles are to be adjusted as necessary by others prior to construction unless the plans specifically call for their adjustment by the Contractor or unless the plans specifically identify a utility to be adjusted by its owner during construction. Existing utilities and their location, as shown on the plans, represent the best information obtainable for design. The Contractor will be required to work around existing utilities within the right-of-way which do not conflict with proposed construction.
2. The Contractor shall be responsible for maintaining continuous flow of sewage through construction. Contractor's proposed method for maintaining sewage flow shall be approved by the Engineer. Cost of maintaining flow of sewage through construction will not be paid for directly and this cost shall be considered as subsidiary to the other pay items of work.
3. The Contractor shall be responsible for preserving property rights. The Contractor will be required to re-establish any property lines which are damaged or destroyed by his construction operations. Such lines shall be re-established by a licensed land surveyor or a licensed professional engineer in accordance with state laws.

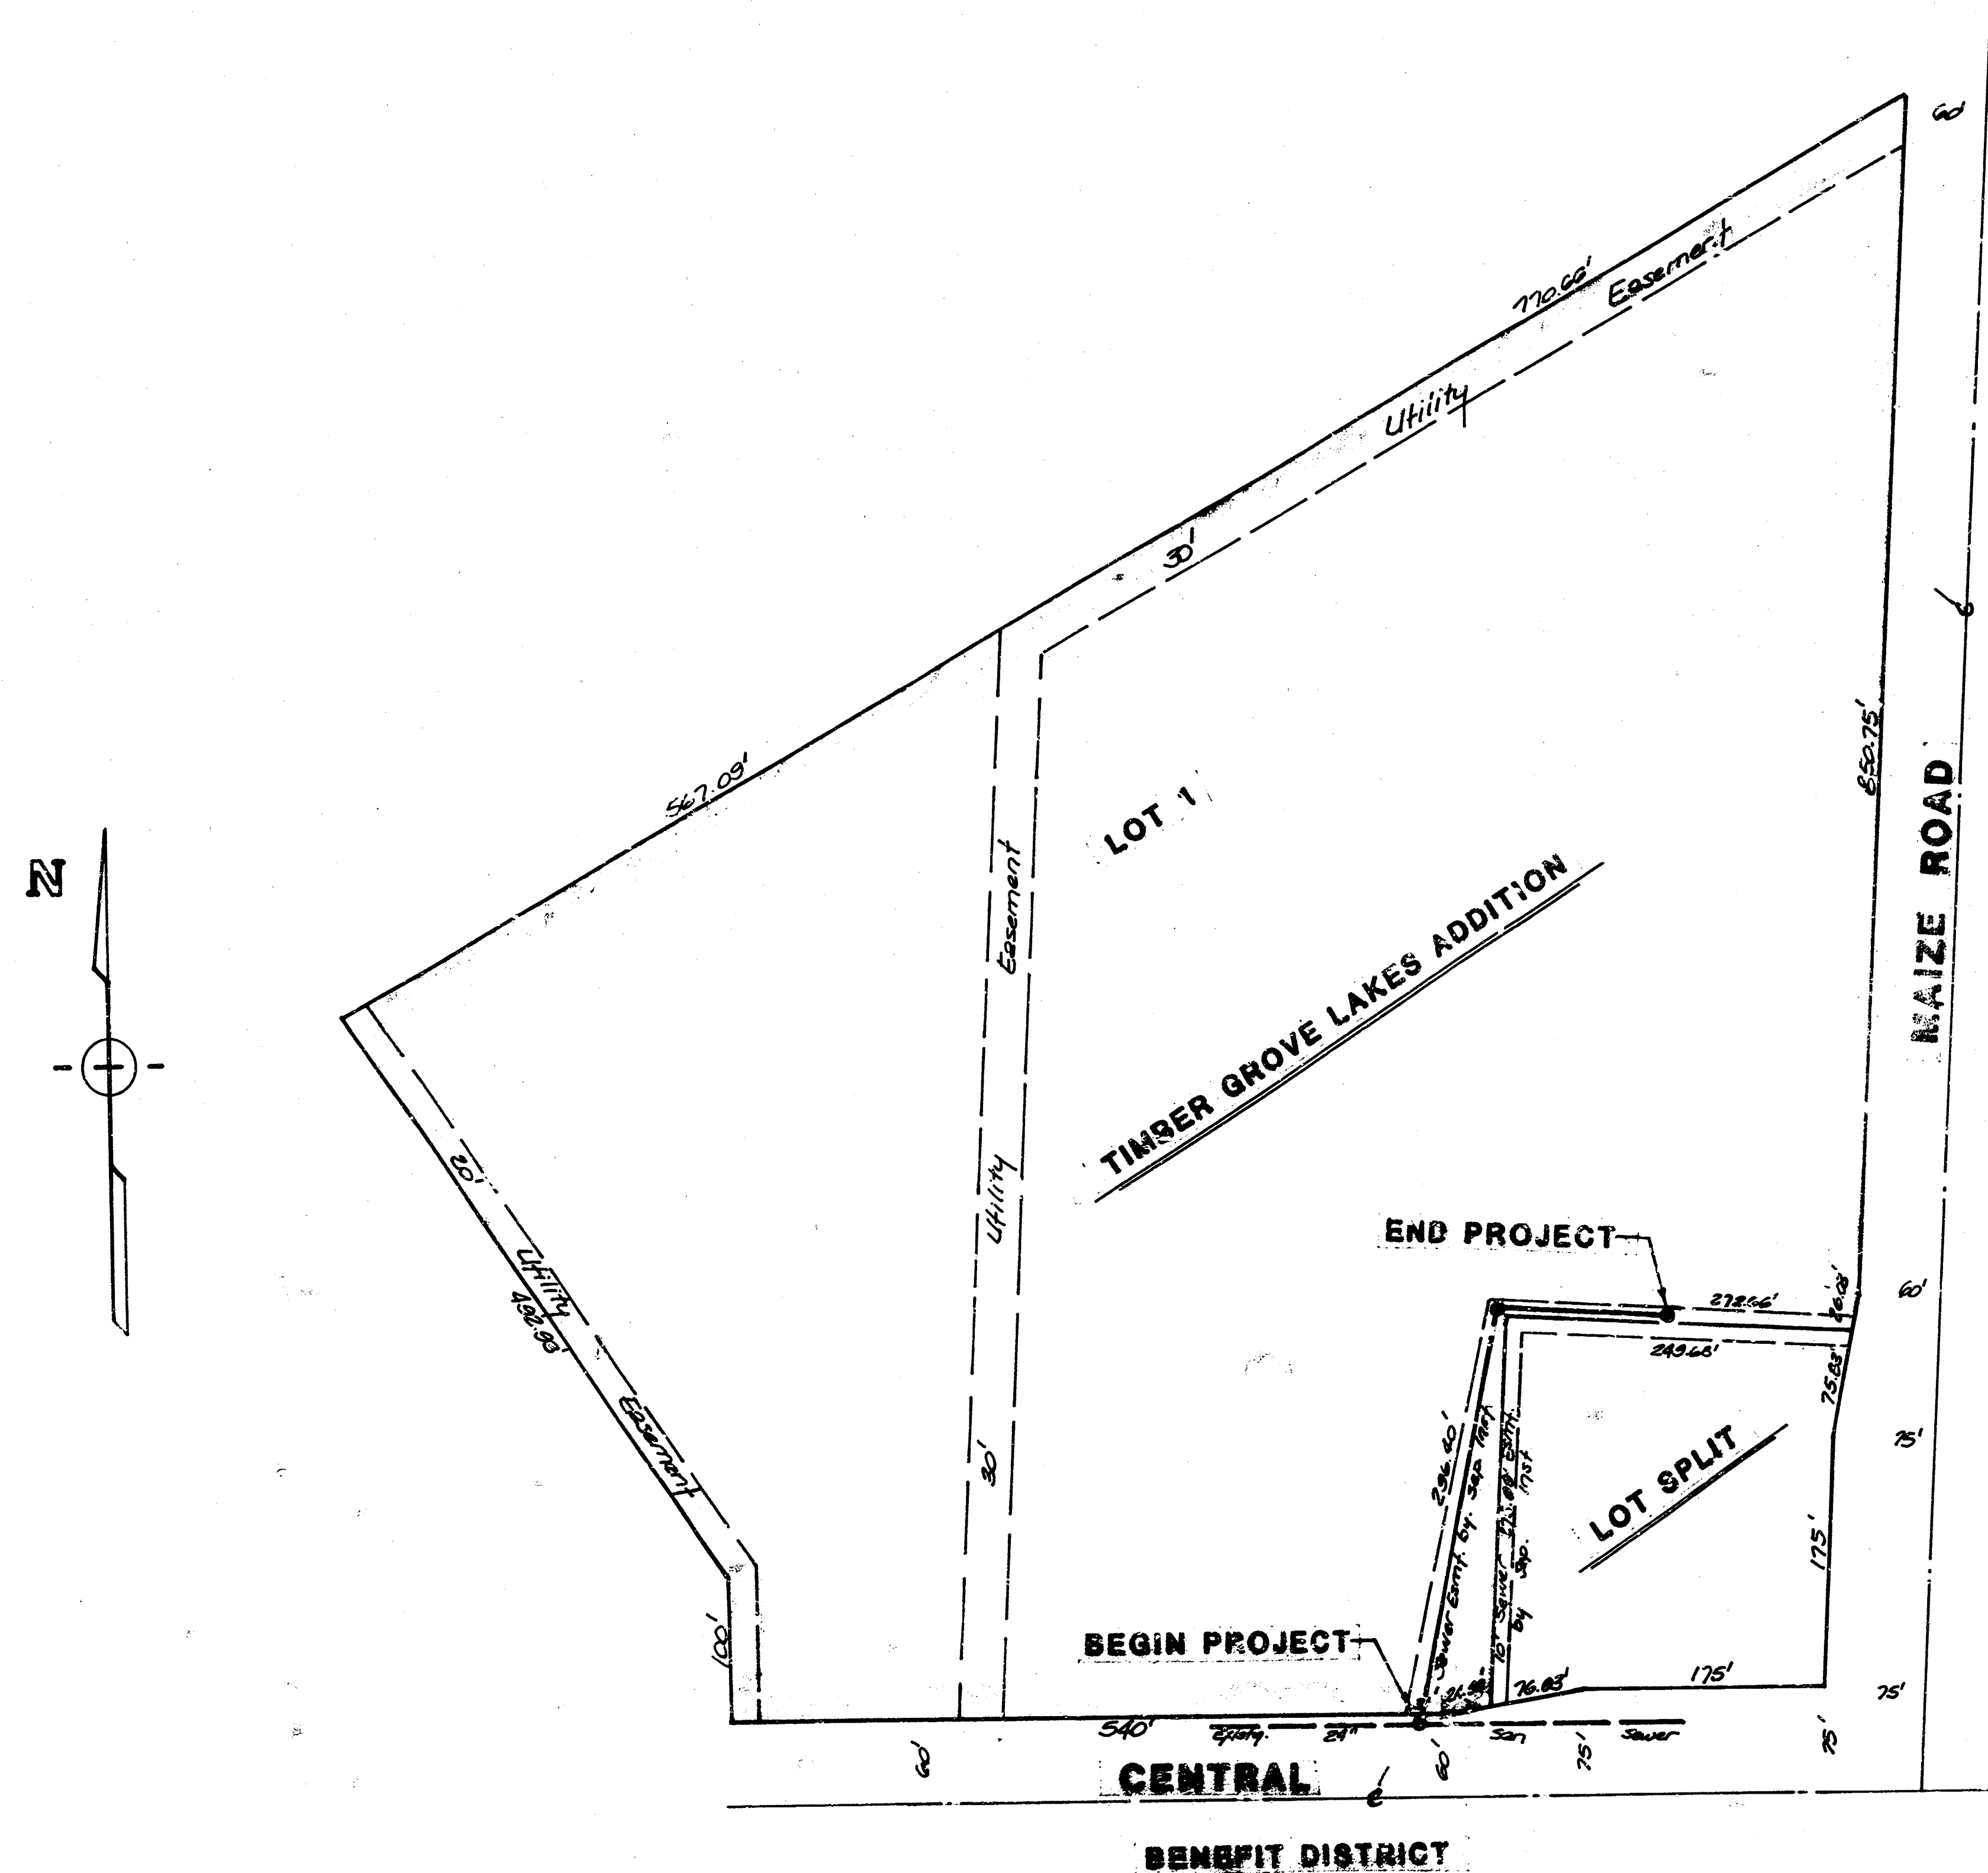

AS BUILT
12-88
ROL

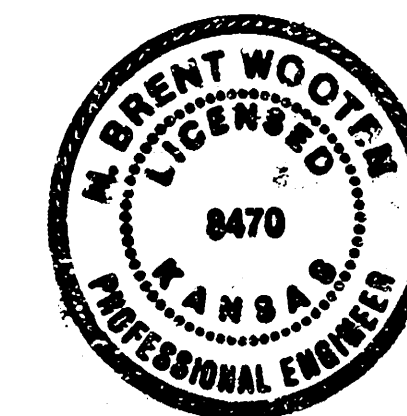

BAUGHMAN COMPANY P. A.
SURVEYING & ENGINEERING
316/262-7271 • 315 ELLIS • WICHITA, KANSAS 67211

5C 5 '89

