
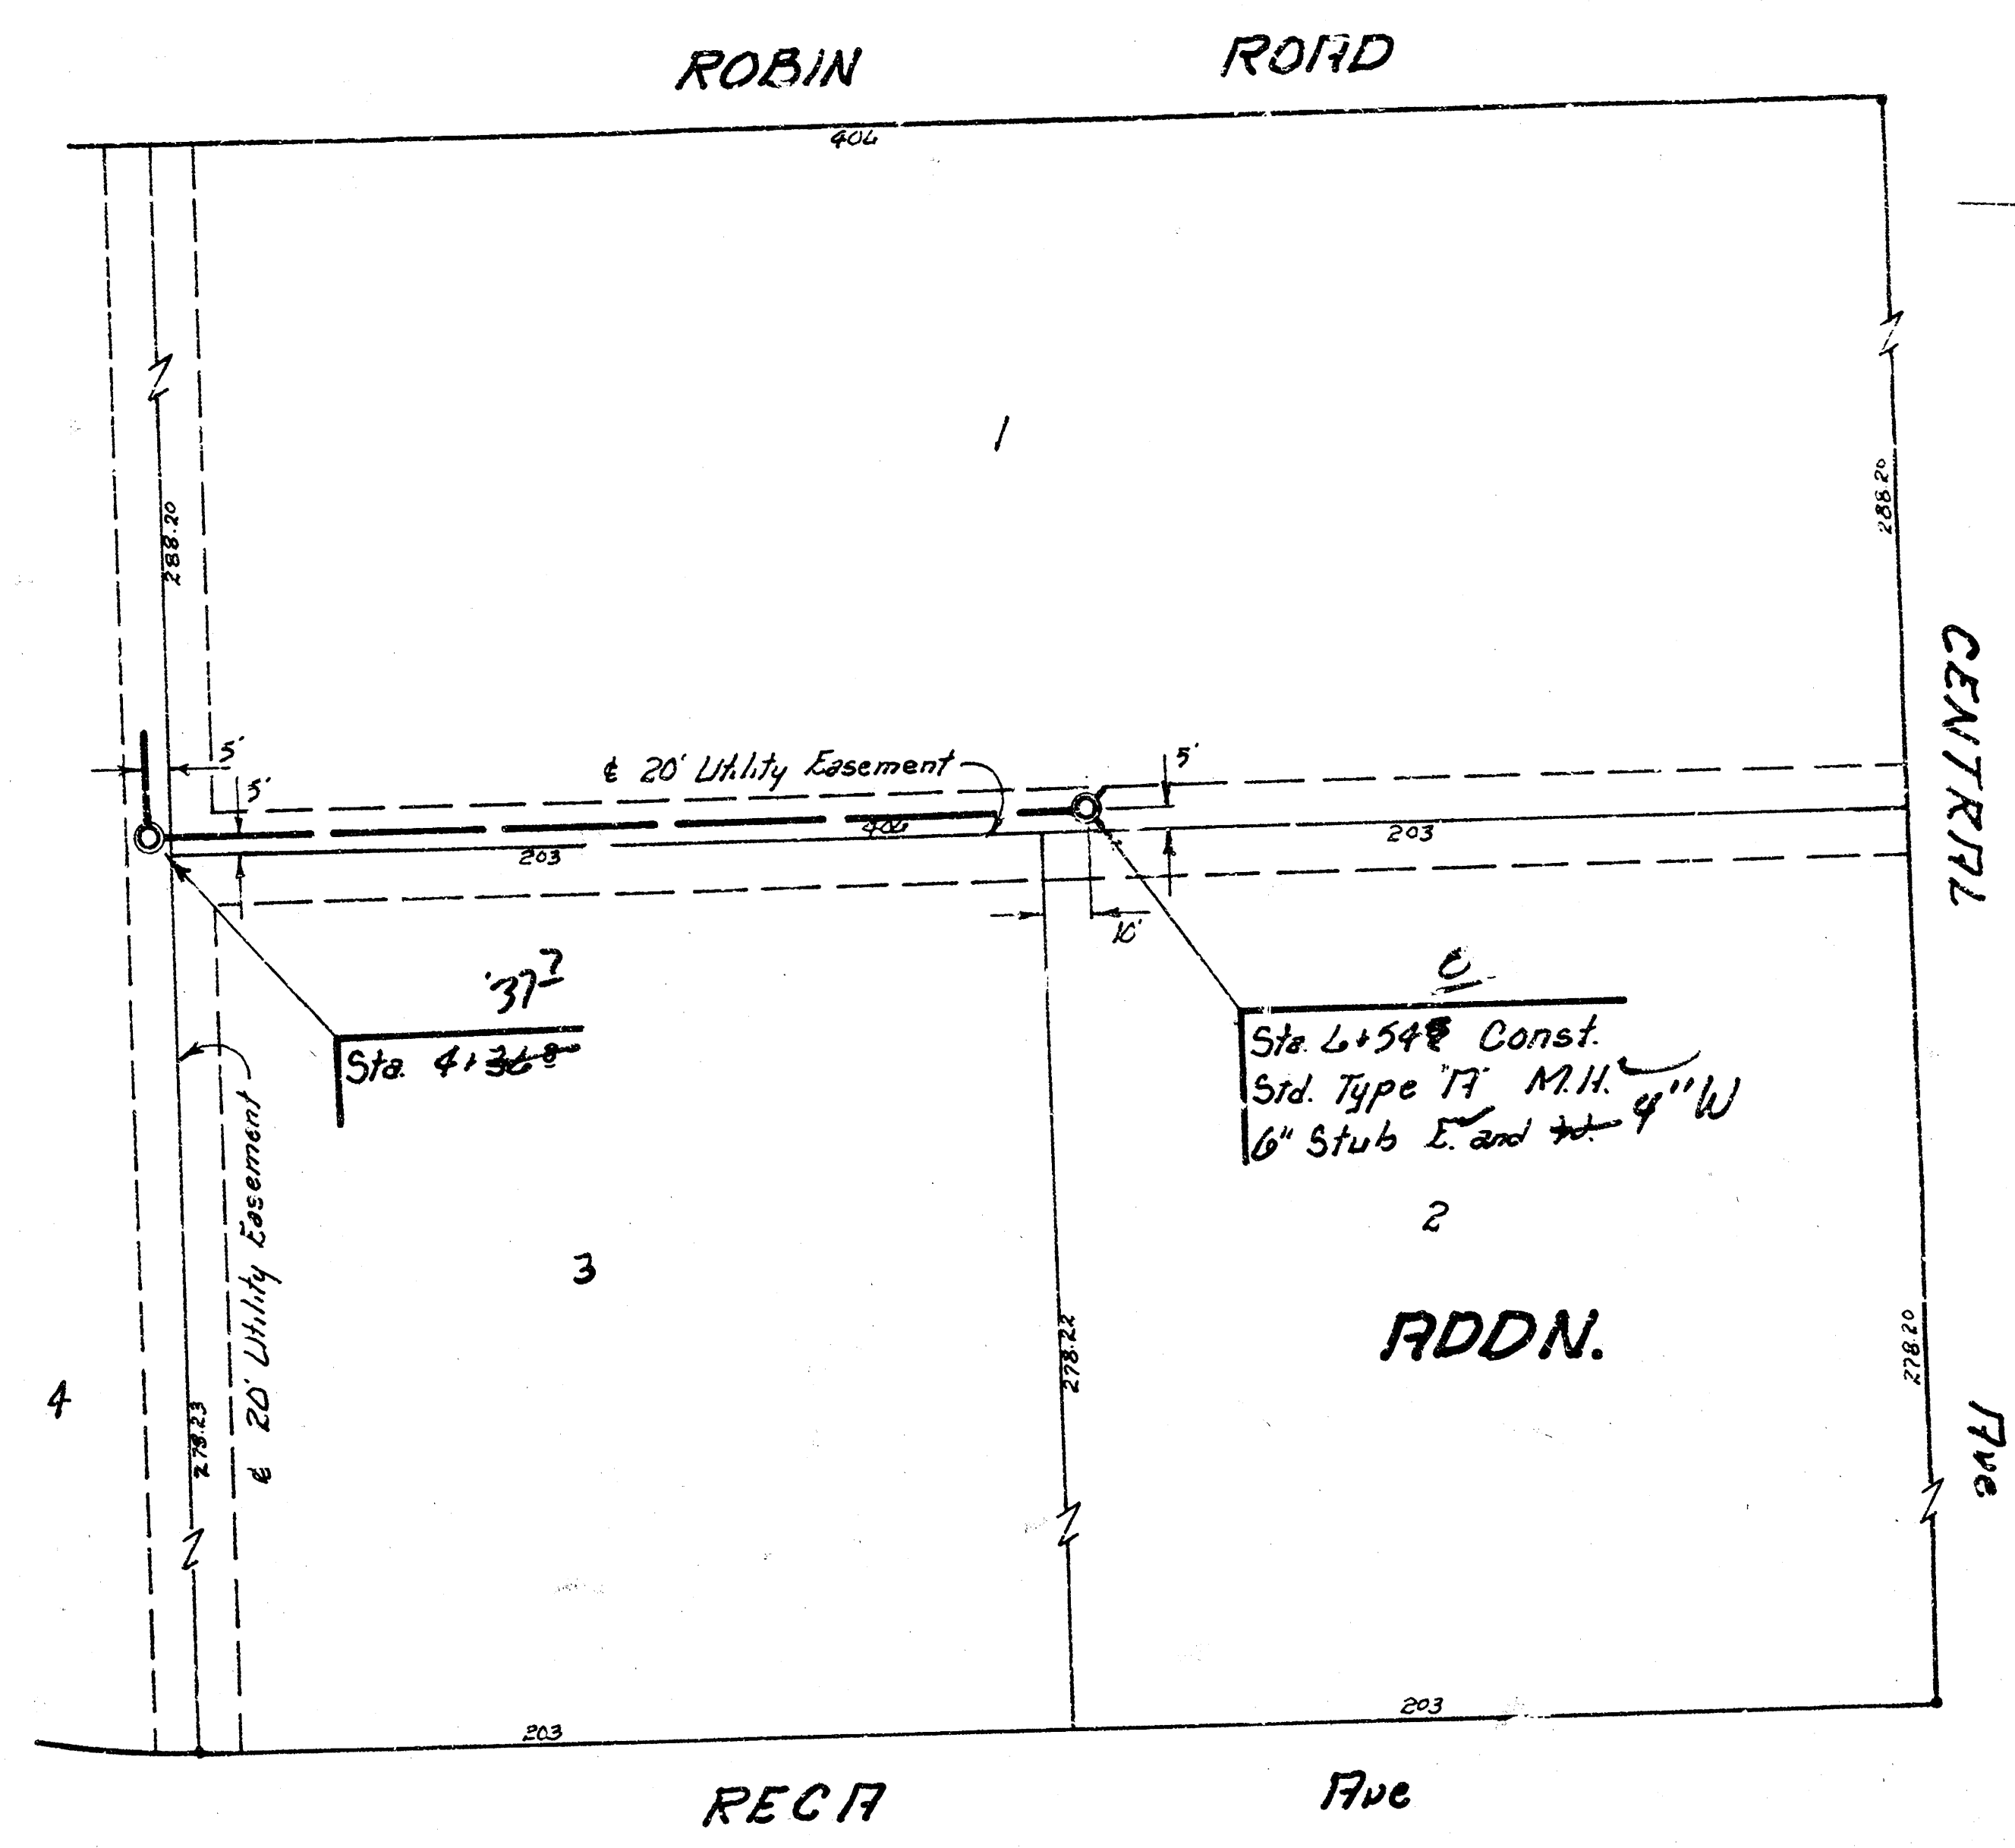



B.M. 143.903 City Sht. 56.2 N. and 38' W. of 6 TYLER ROAD and CENTRAL

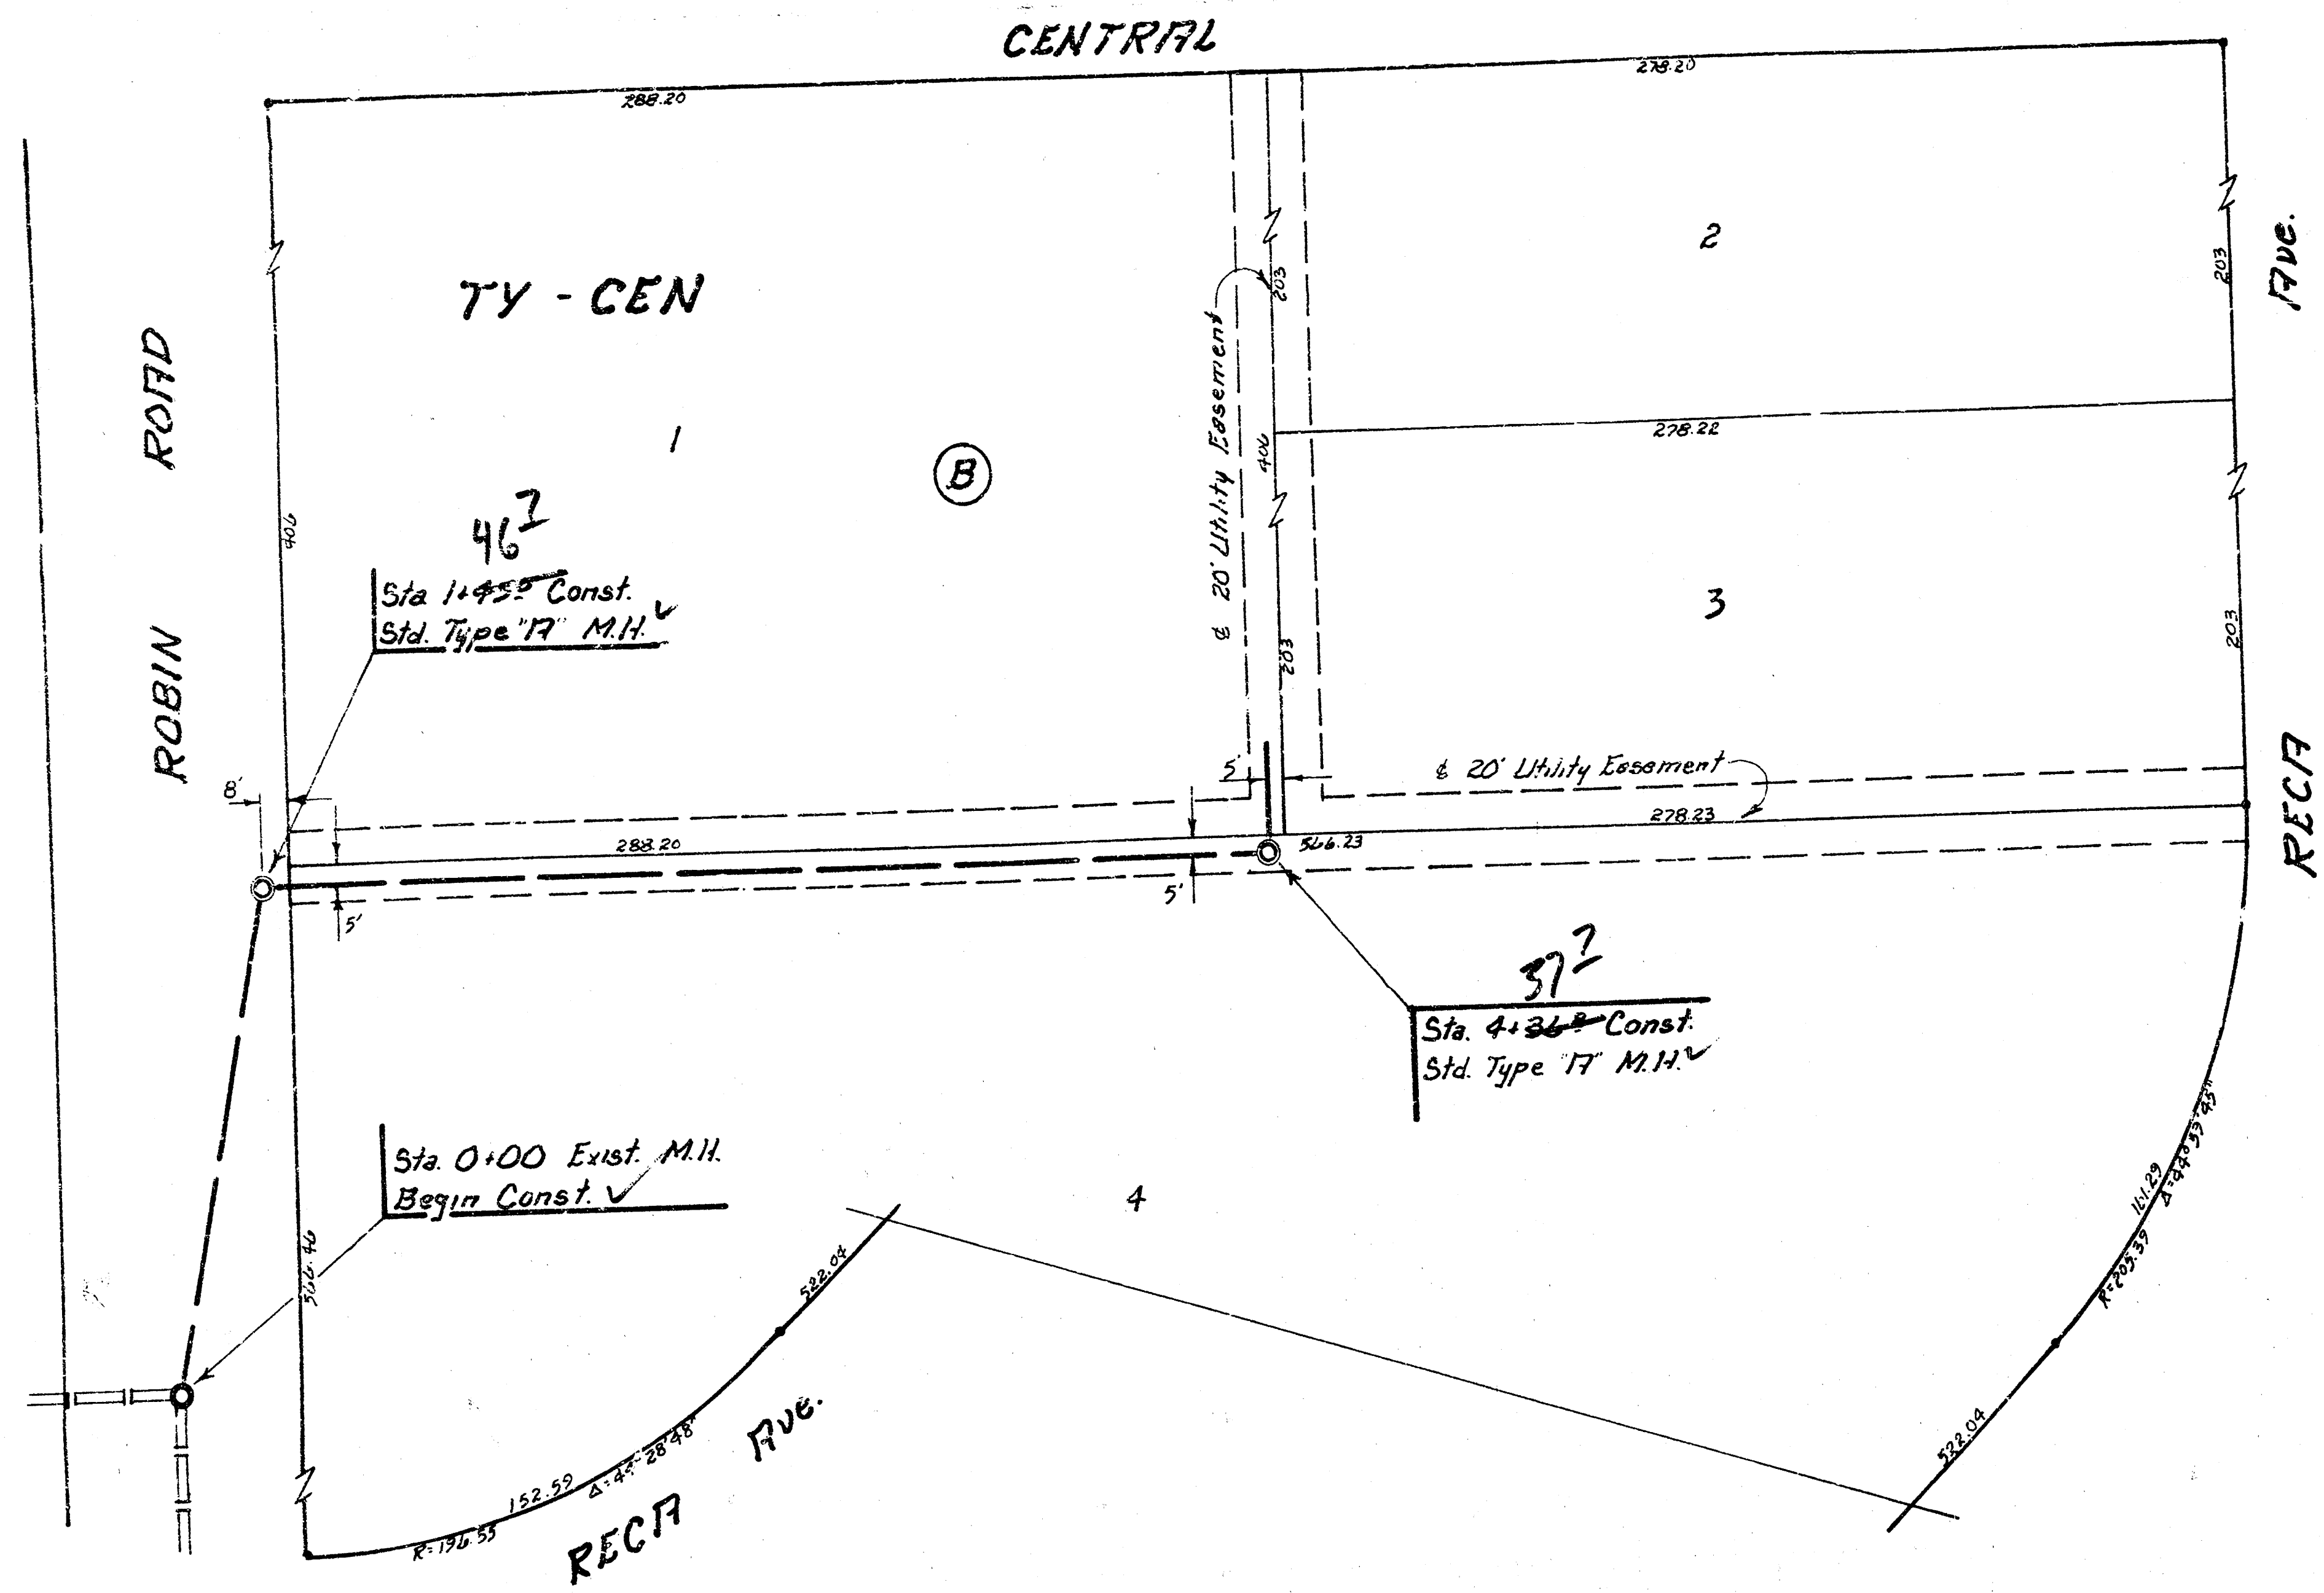

SCALE
PLAN 1" = 40'
PROFILE 1" = 40'
Horz. 1" = 40'
Vert. 1" = 5'

NOTE: EXCESS EXCAVATED MATERIAL SHALL BE USED TO MAINTAIN A MINIMUM COVER OF 20" OVER THE SEWER WHERE NECESSARY ON THIS PROJECT.

As Built
JSS
11/81

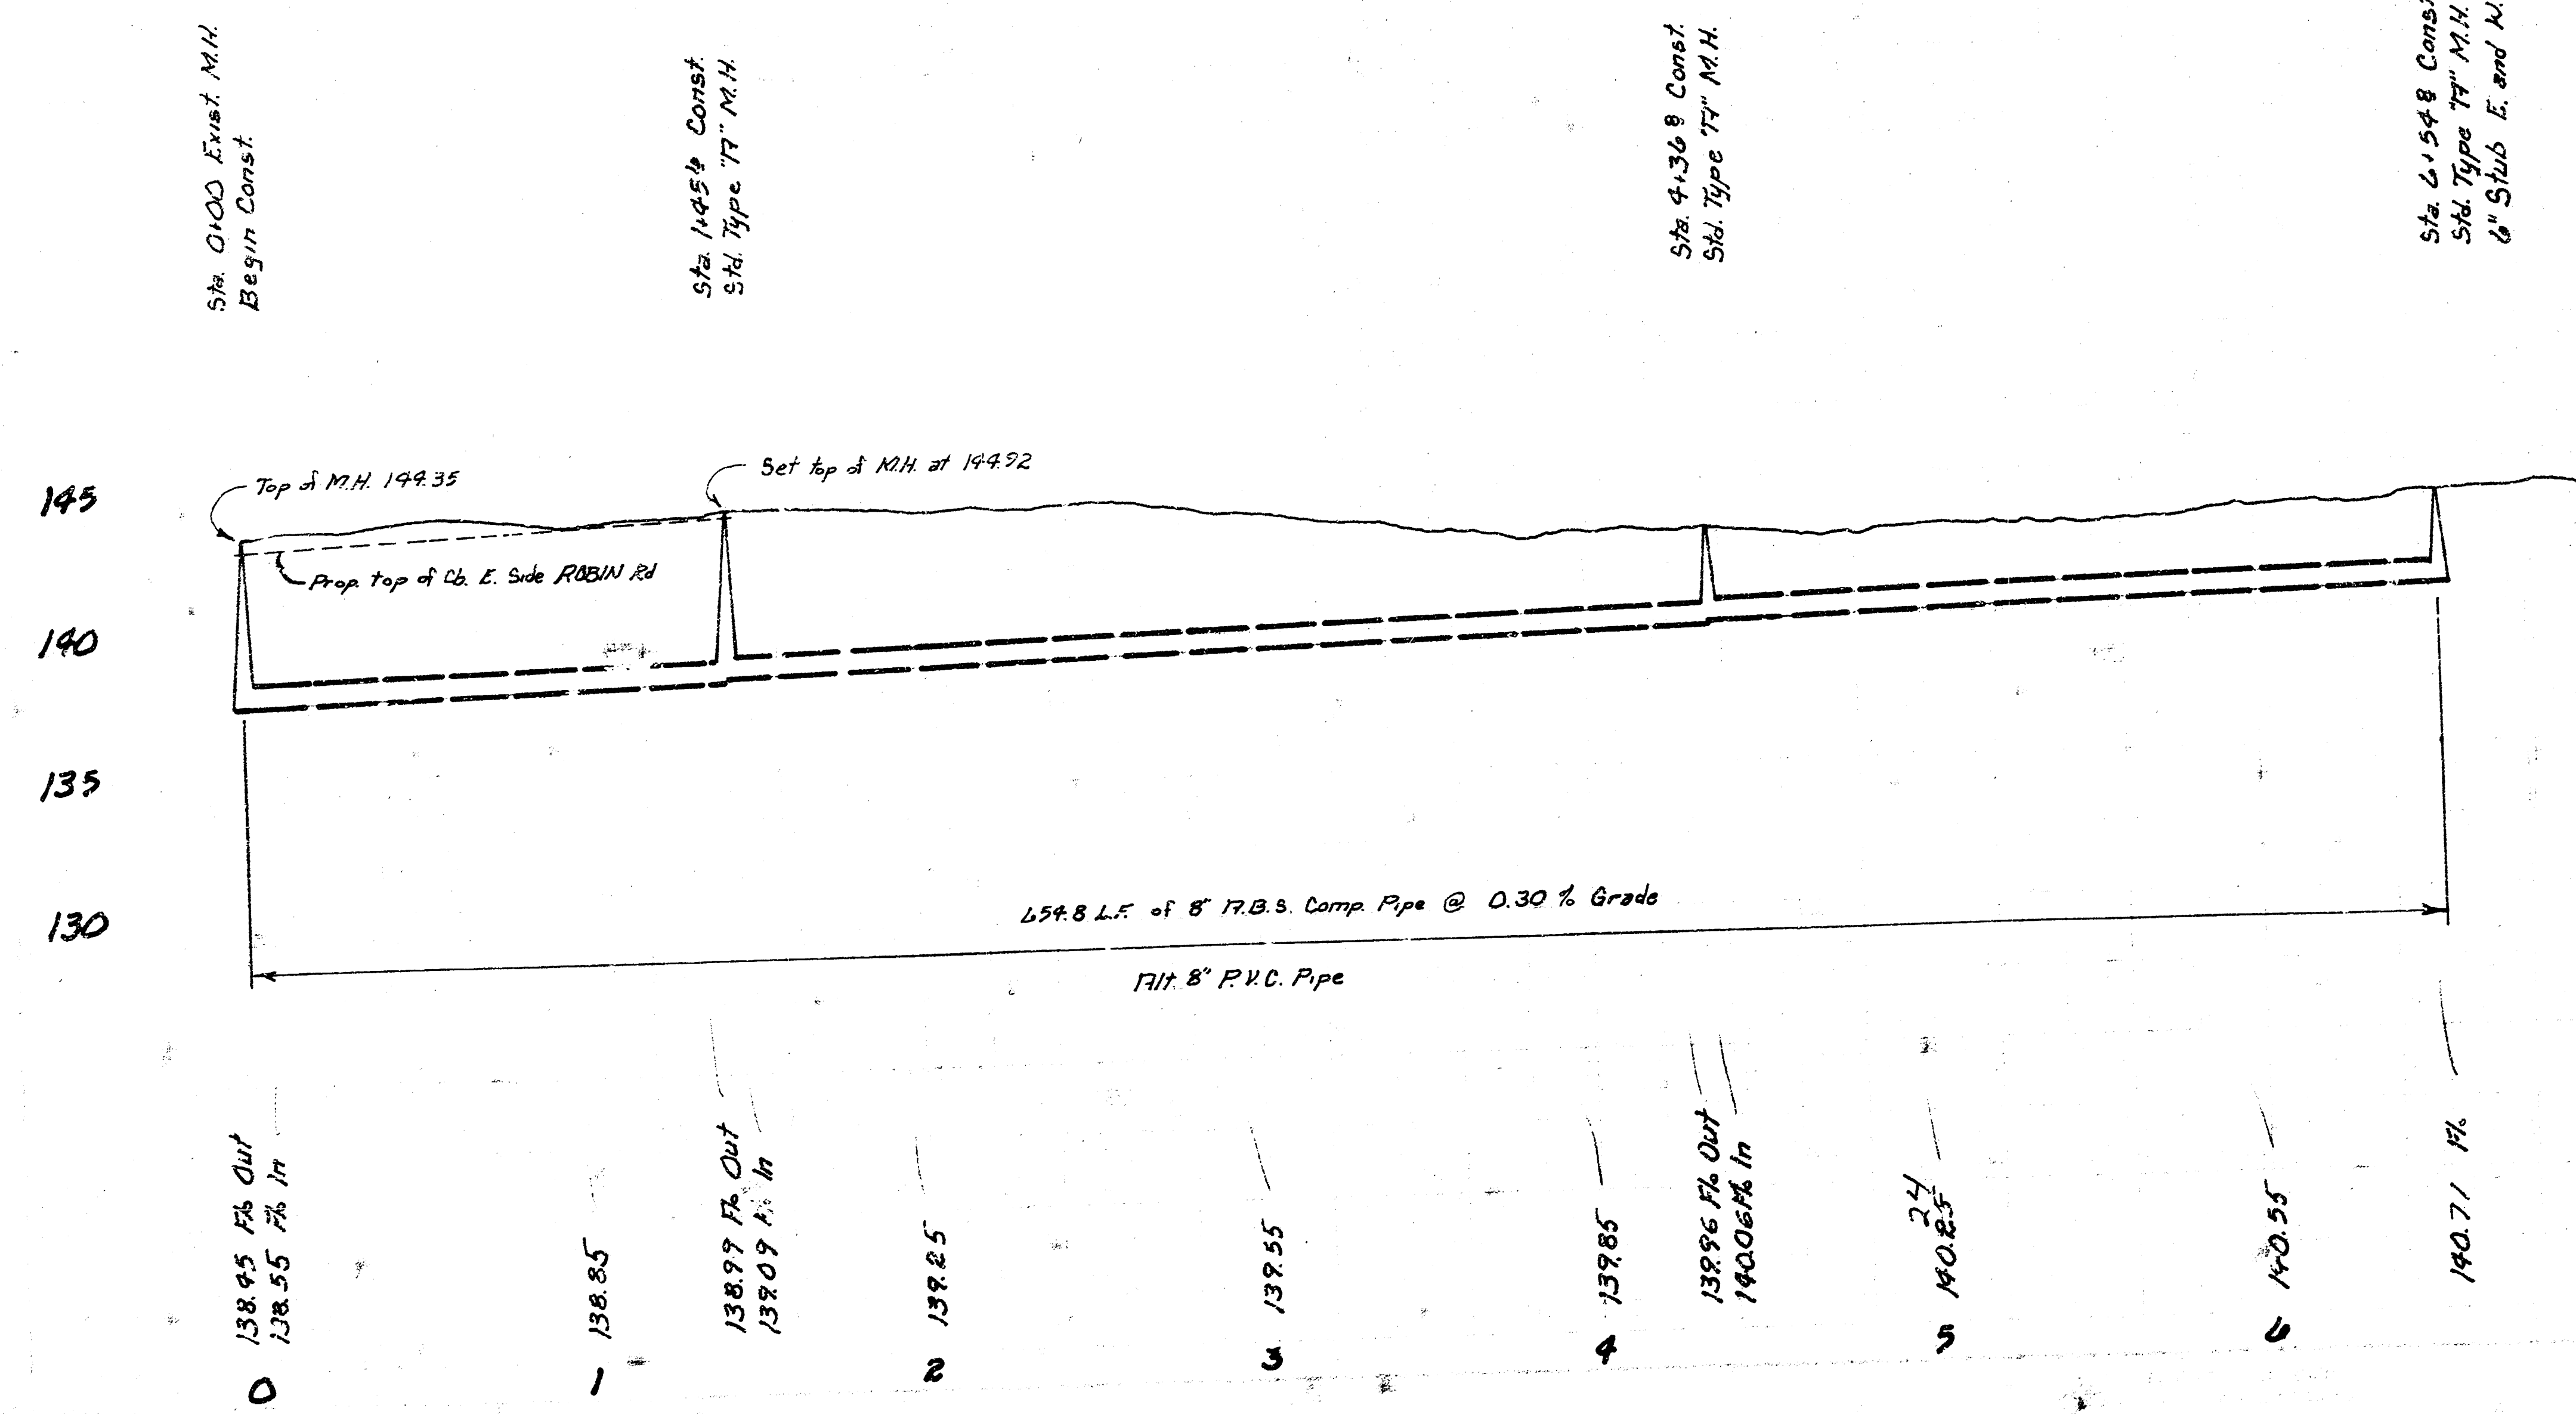

Lot 20, Main 1, WESTLINK SEWER
City of Wichita, Kansas
DEAN SELLERS CITY ENGINEER
Proj. No: 468-76-245-80761-000-001
Date

FILMED FROM THE BEST COPY AVAILABLE