
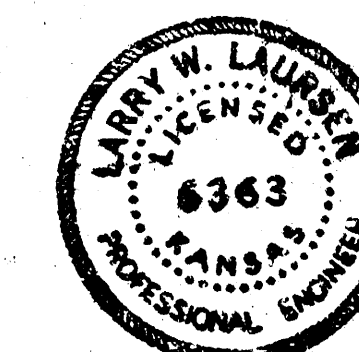
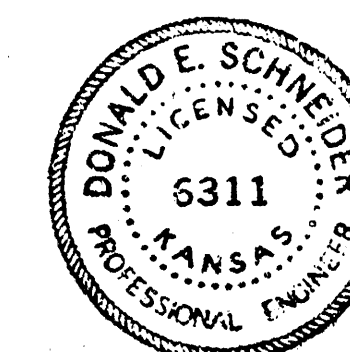
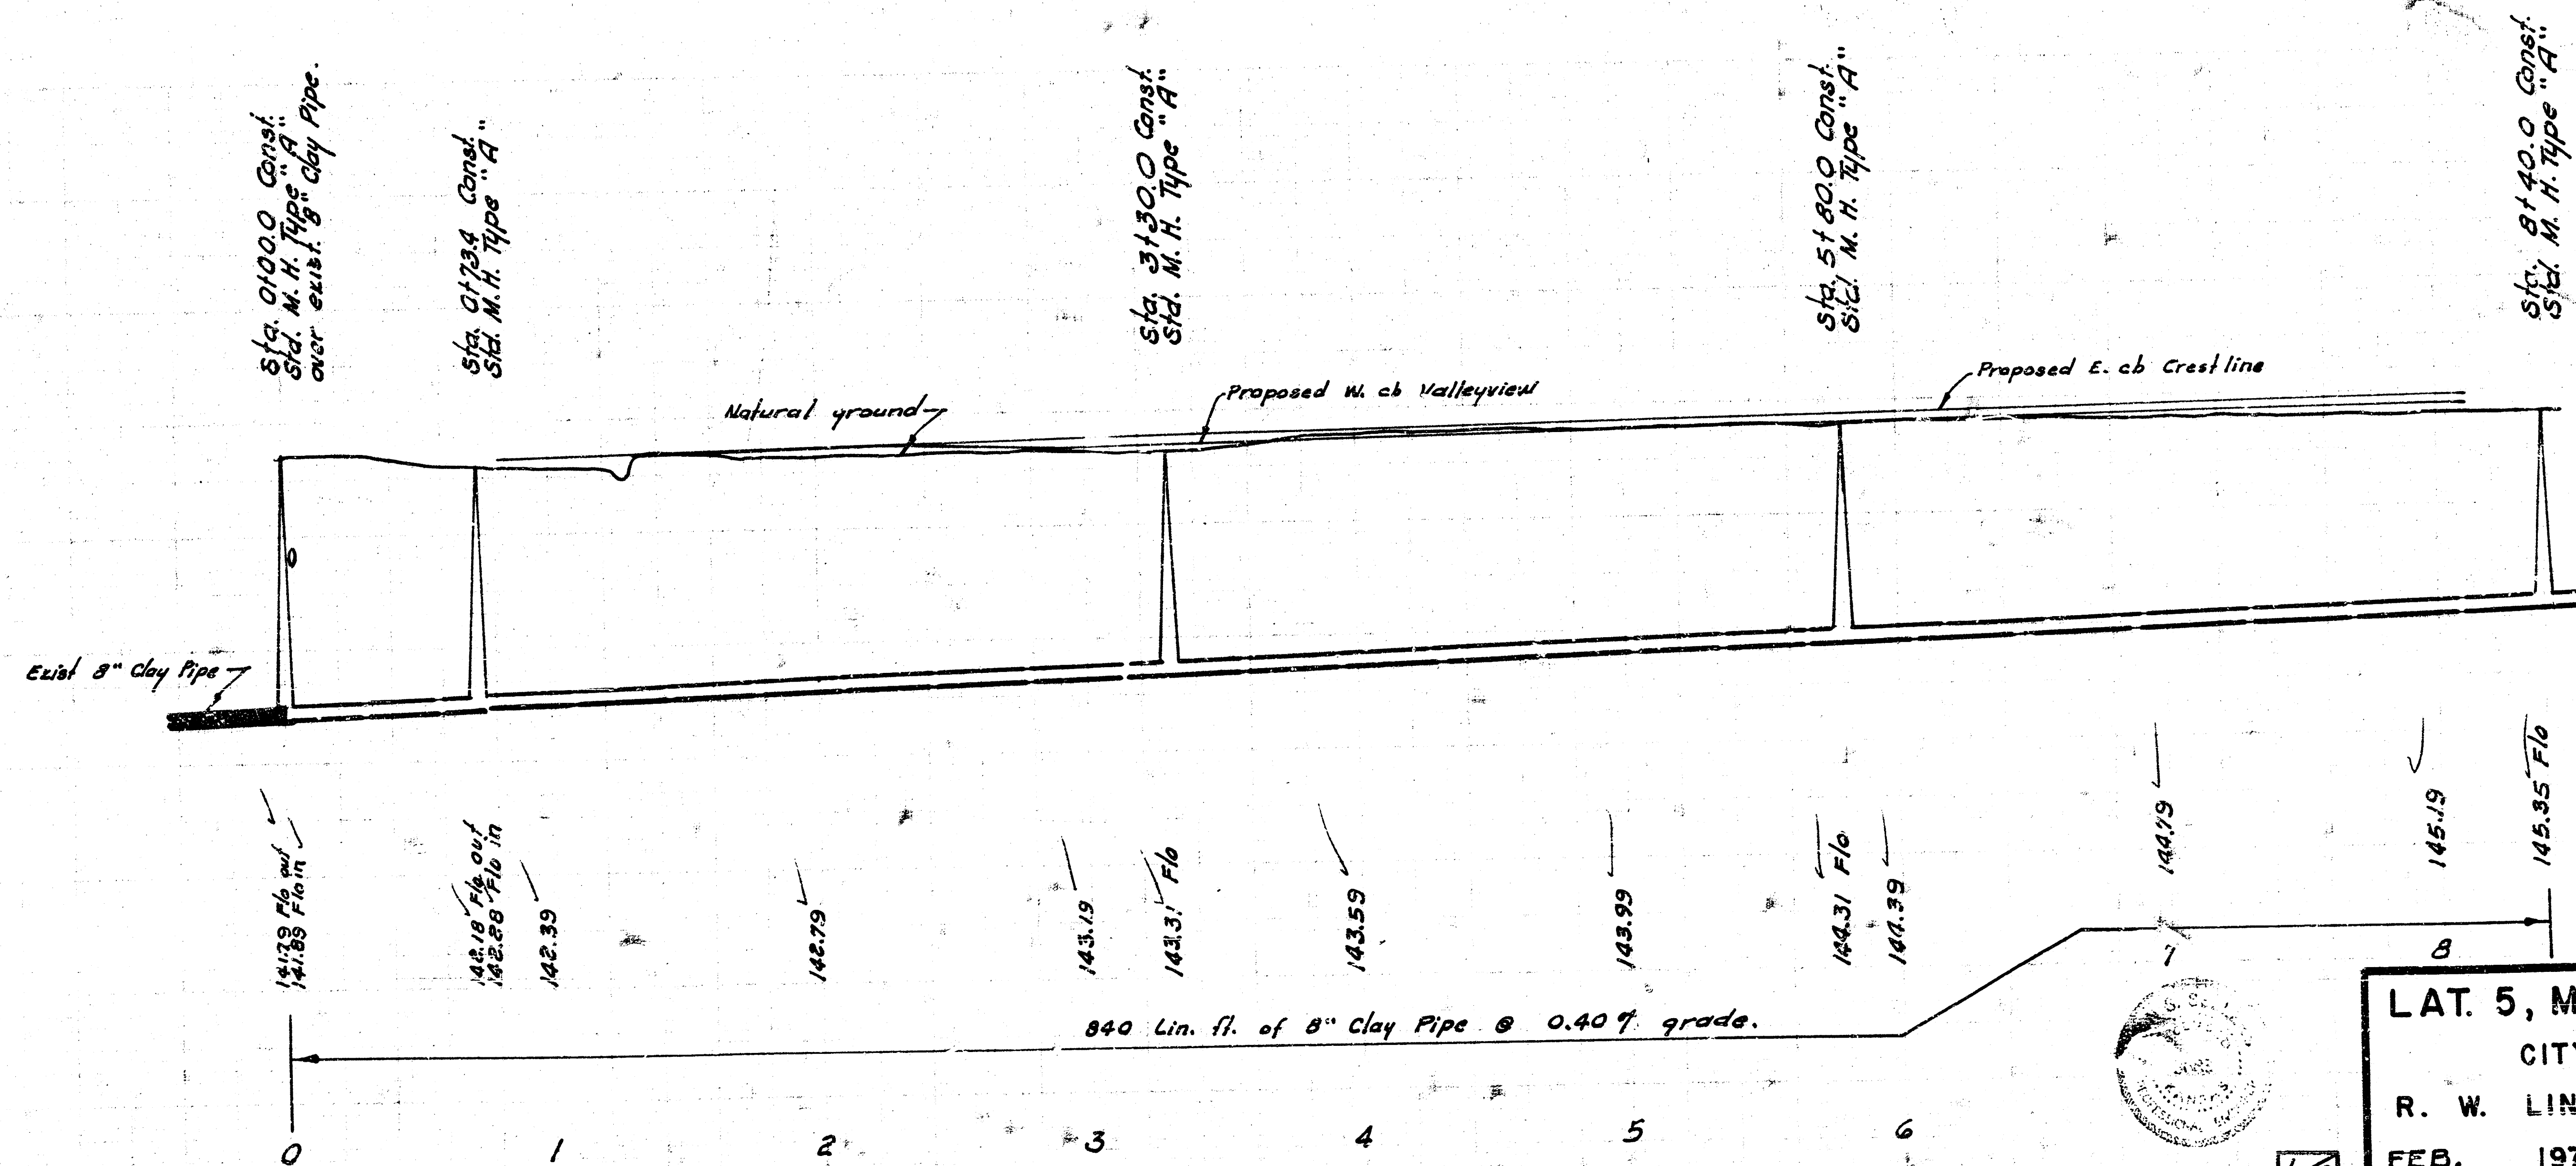


B. M. 15708 Top bolt S.W. cor. H.L.P.
Base S-Side K.G.E. Westlink
sub station on 13th.



Plan Scale 1" = 40'
Profile Scale 1" = 40' Horiz.
1" = 5' Vert.

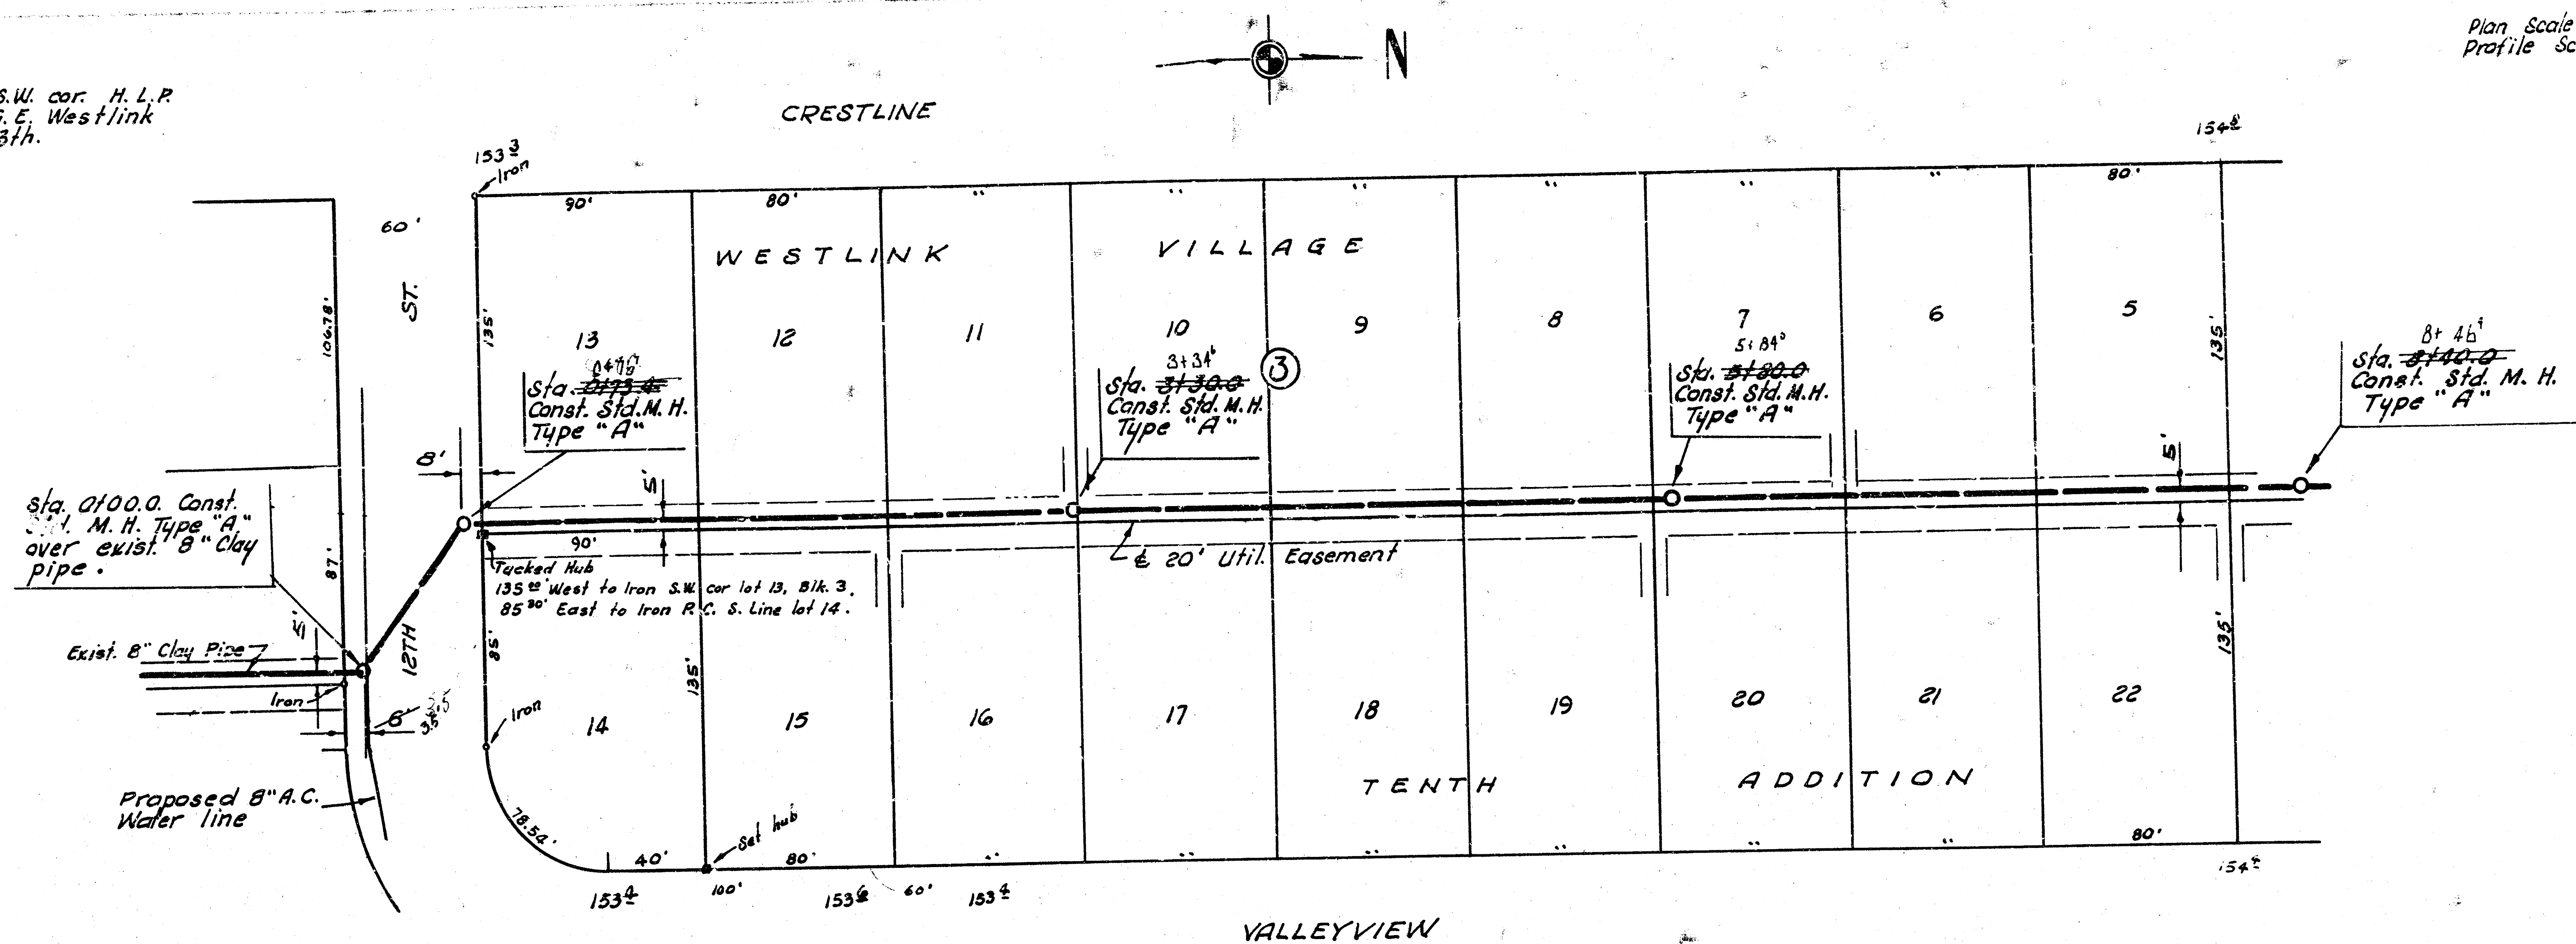


AS BUILT FROM PLAN K-109
LAT. 5, MAIN 2, WESTLINK SEWER
CITY OF WICHITA, KANSAS
R. W. LINN — CITY ENGINEER
FEB. 1973, PROJECT NO. DBKL572053

10 sets Engr.
1 set water

B. M. 157.08 top bolt S.W. cor. H. L. P. base
S-side K. G. E. Westlink Substation on 13th.

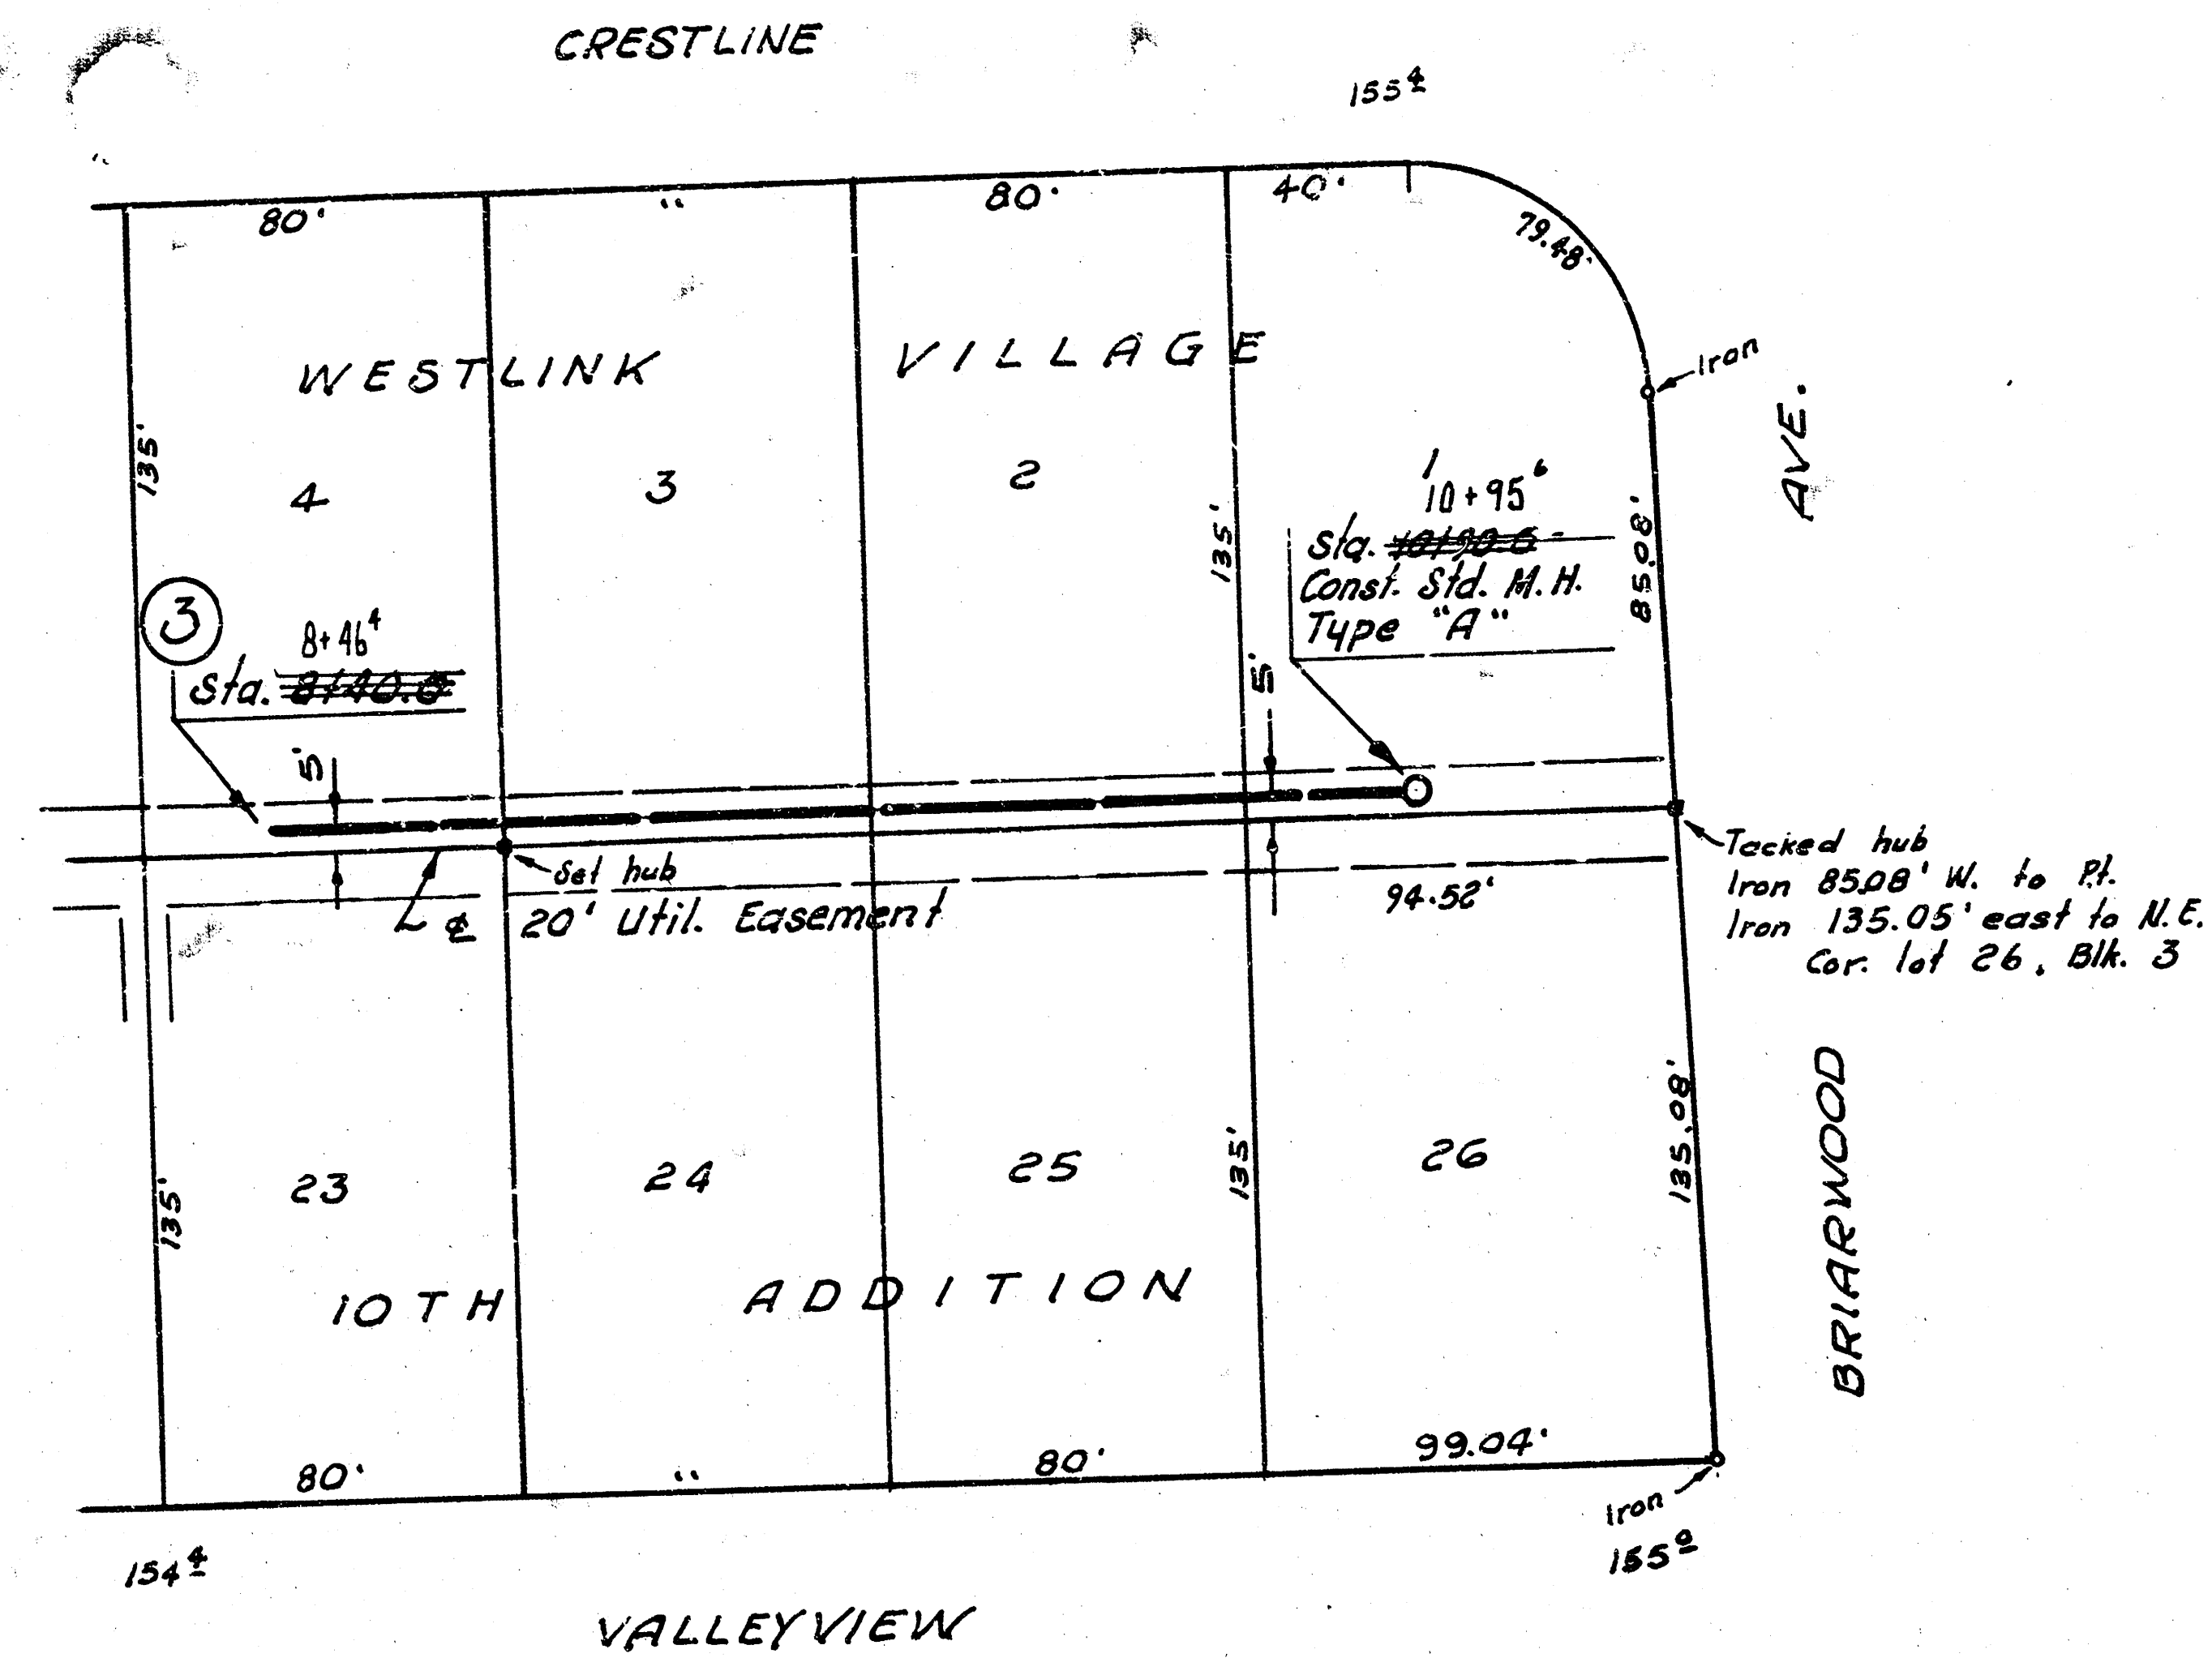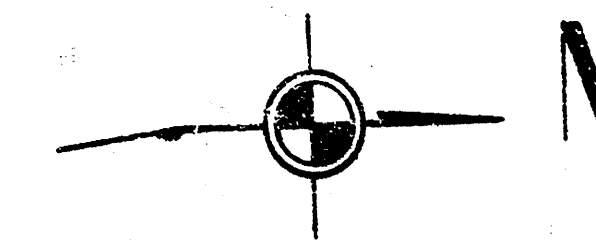

155
150
145
140

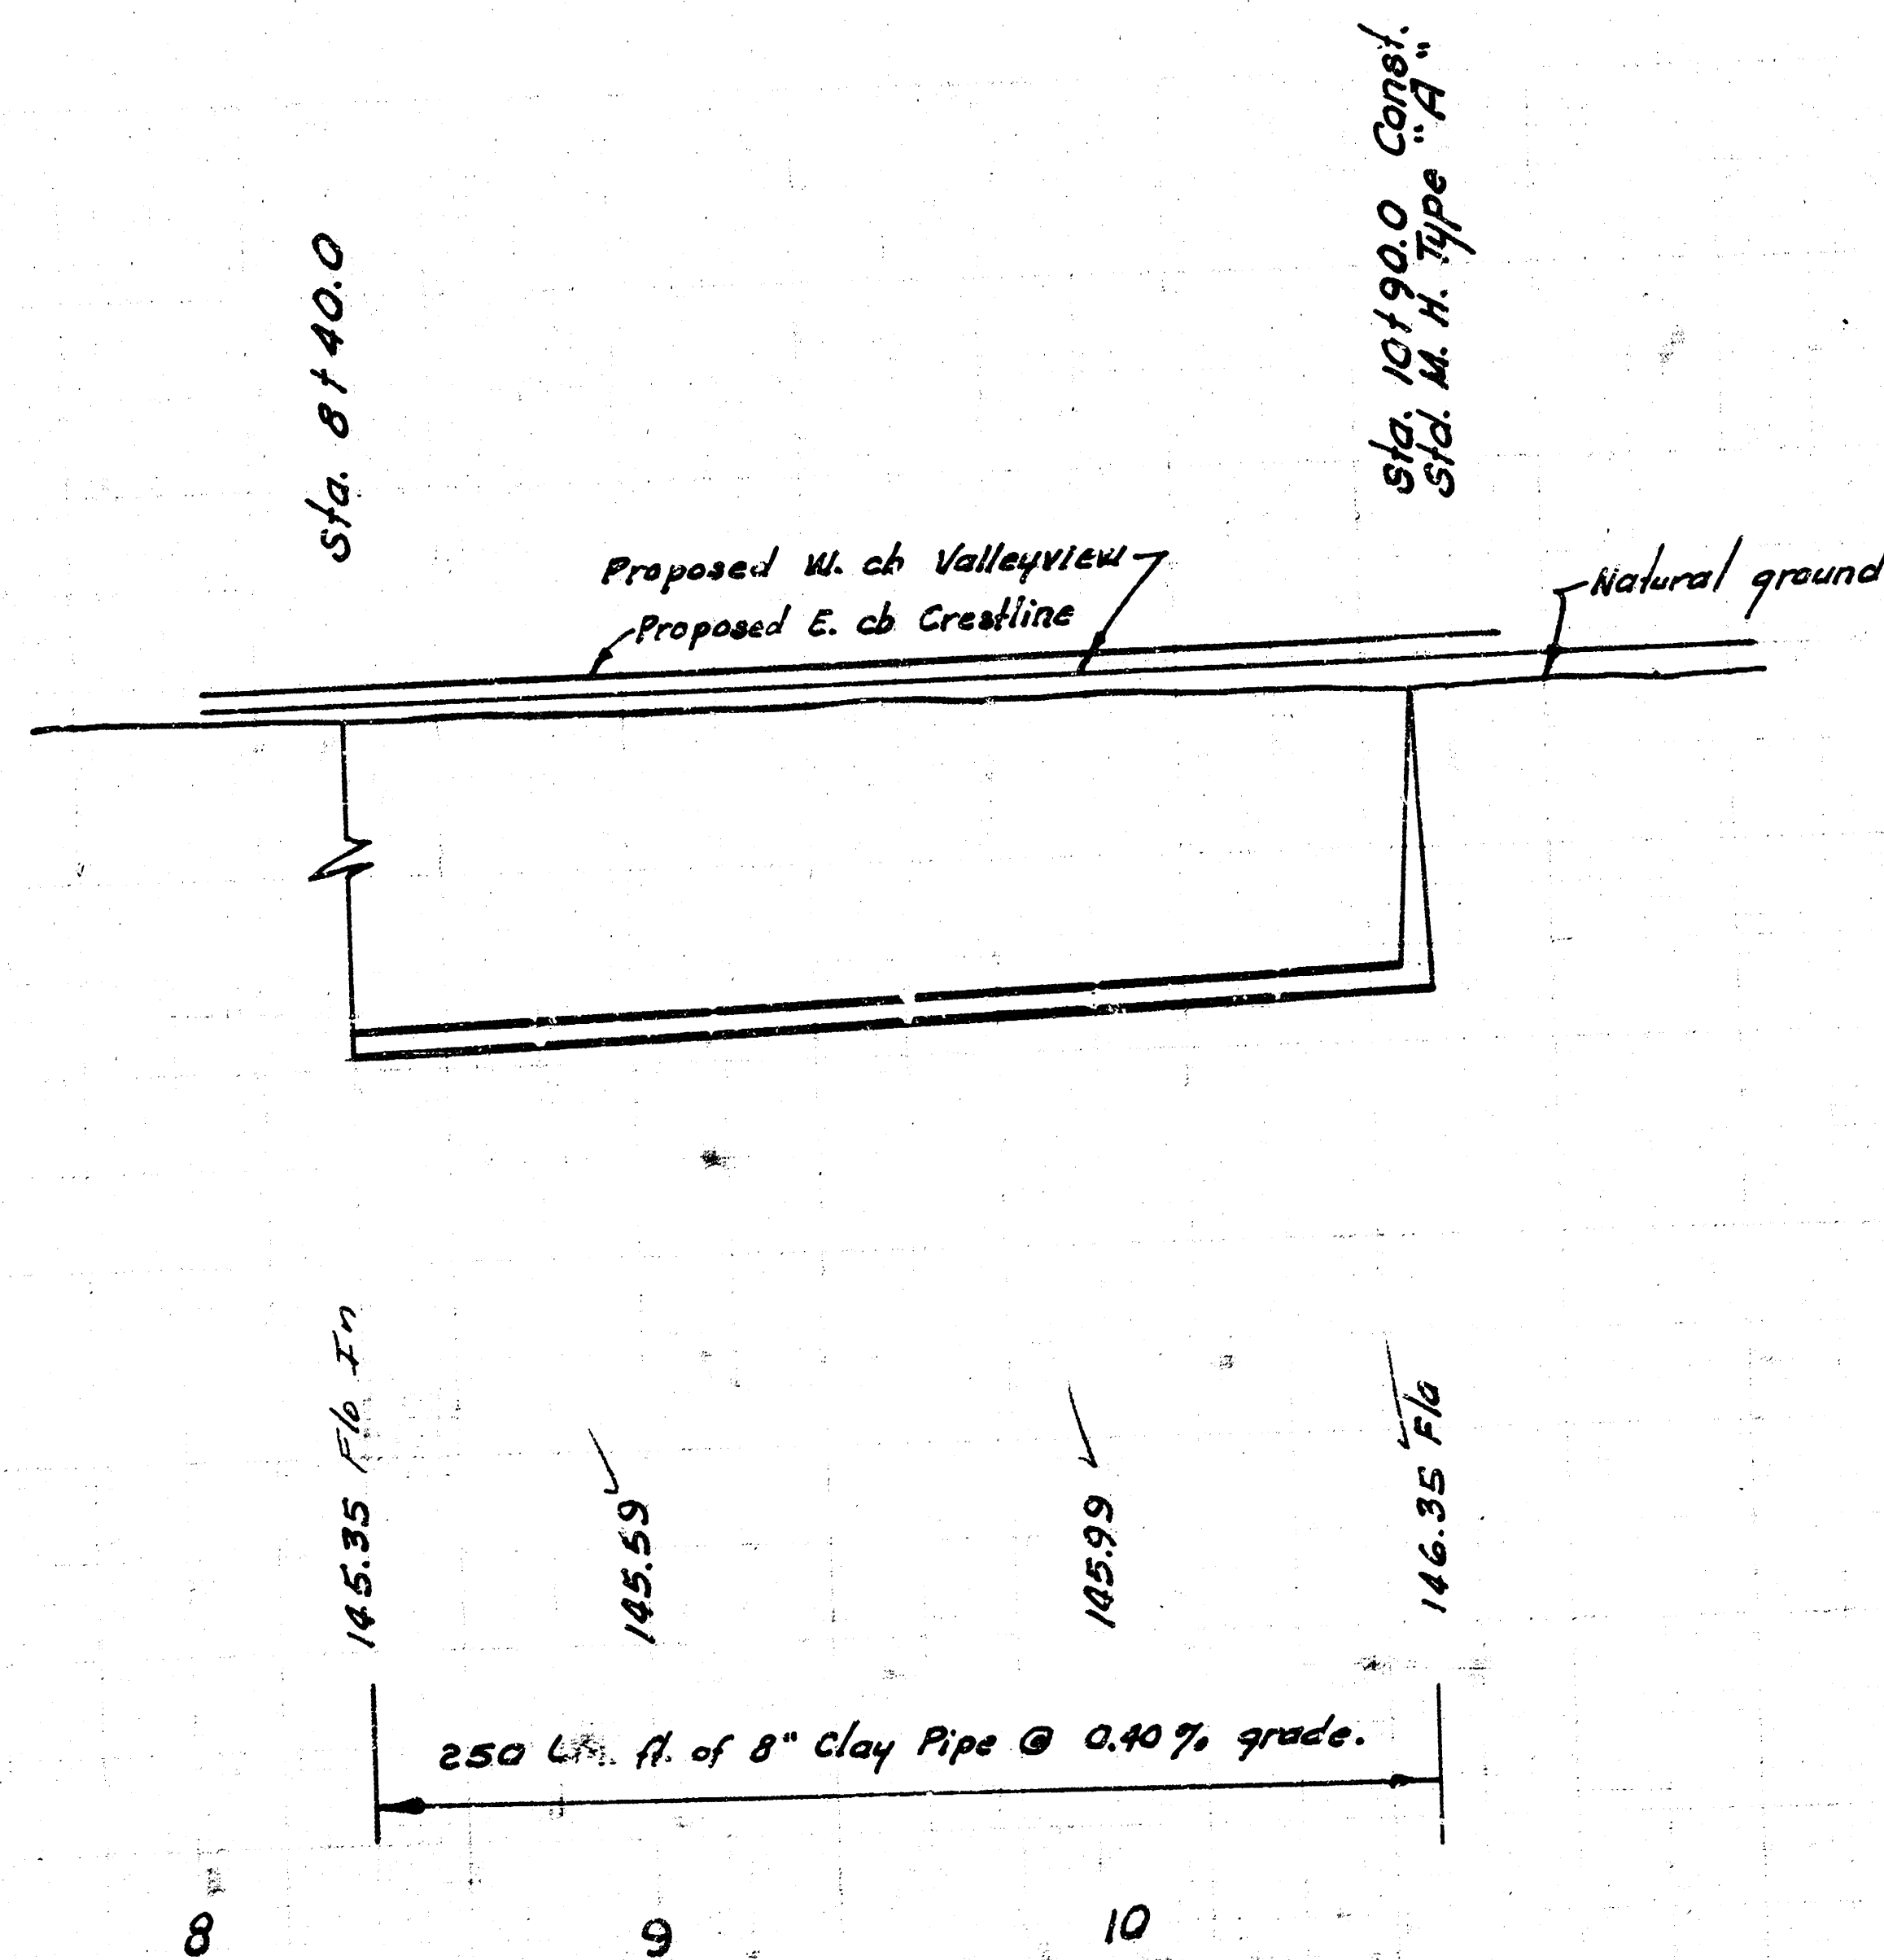

155
150
145
140

LAT. 5, MAIN 2, WESTLINK SEWER
PROJECT NO. DBKL572053

2/2

14 2 1 2