


D: C. P. D. W.



Plan Scale $1'' = 40'$
Profile Scale $1'' = 40'$ Horiz.
 $1'' = 5'$ Vert.

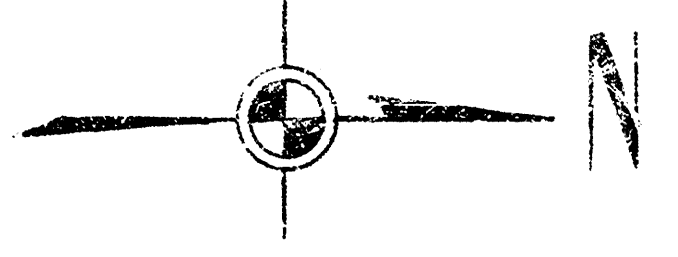

As Built 7-24-75

LAT. 5, MAIN 3, WESTLINK SEWER
CITY OF WICHITA, KANSAS

R. W. LINN — CITY ENGINEER

-1464 1975 PROJECT NO. DBKL574029