



BM 167.46 R.R. Spike West side Power Pole 12' North & 10.5' East of Iron at St. Thurman & Tyler
 BM 172.48 City Std Disc 31' S & 36' E. of NE corner of the SE. 1/4 of Sec. 8 T27 R1W

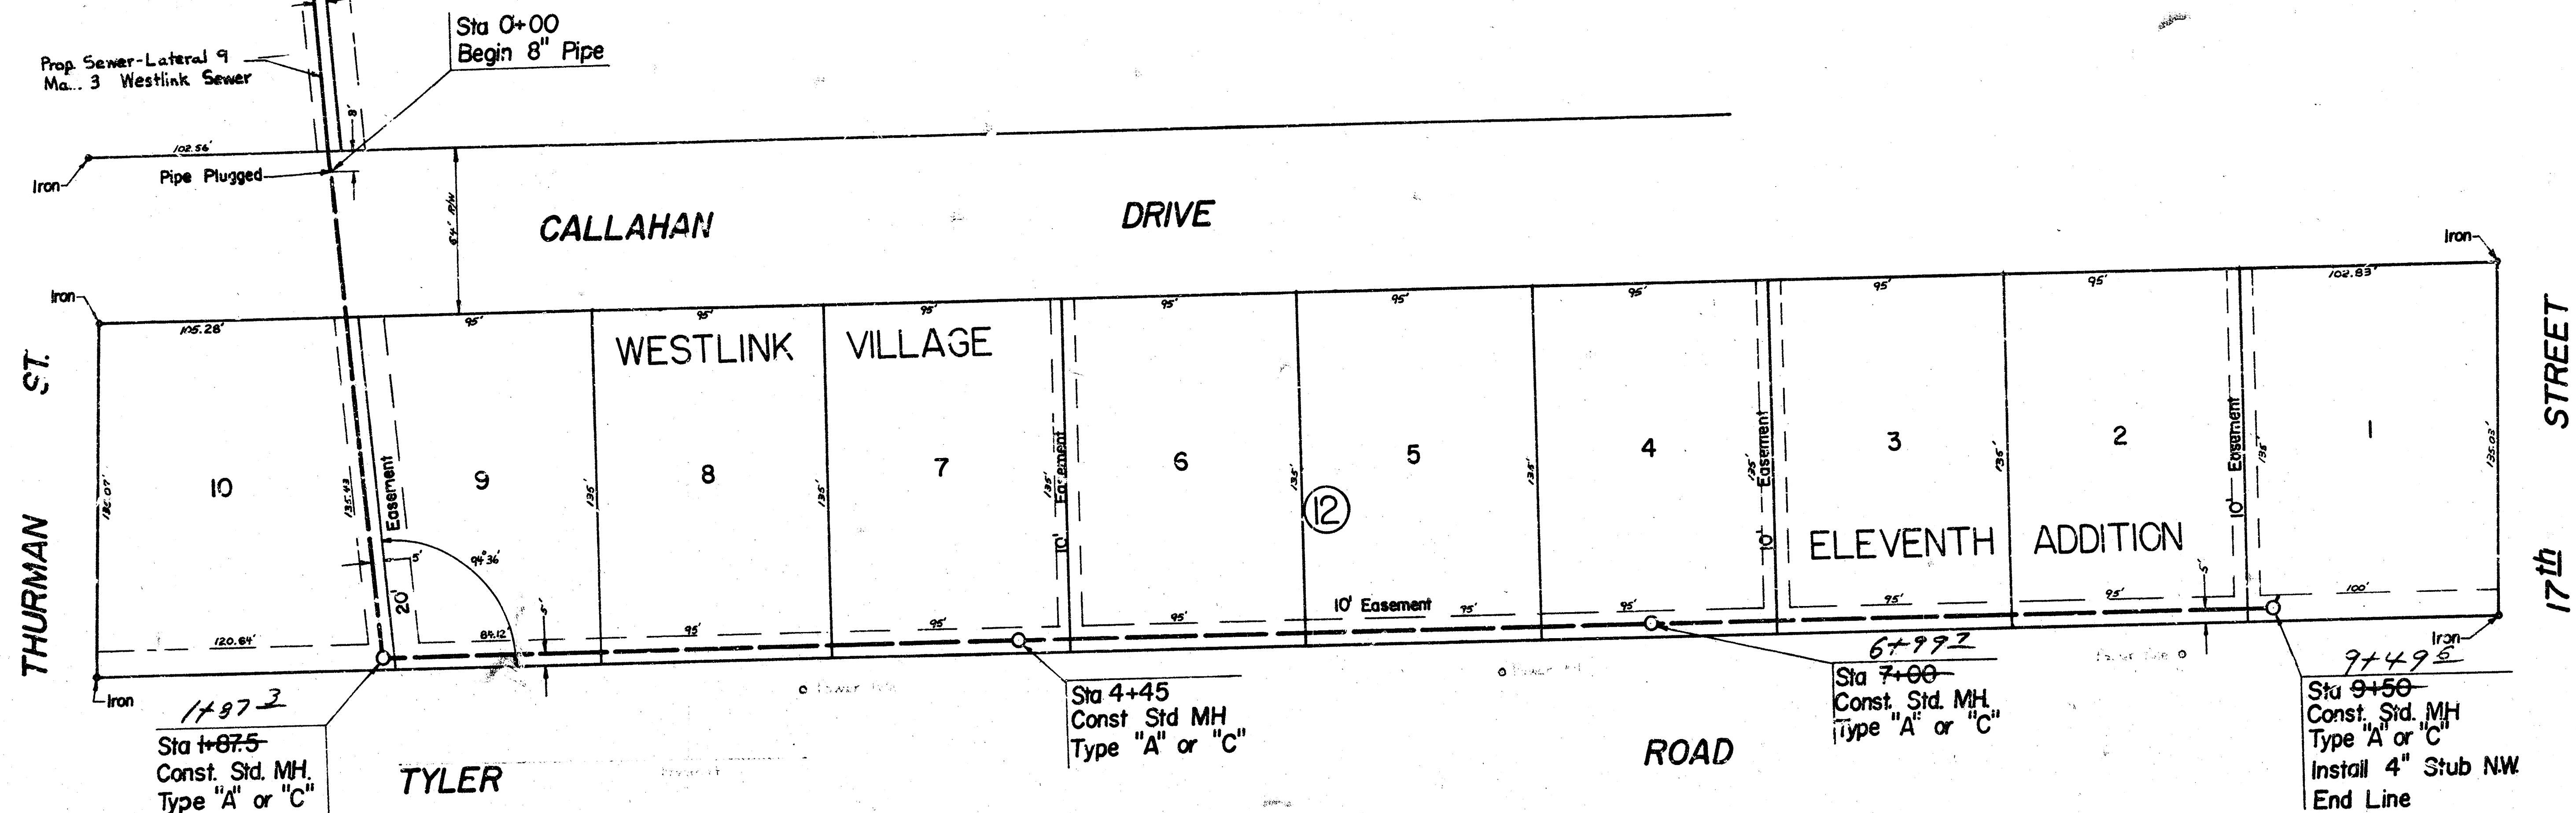

Plan Scale 1" = 40'
 Profile Scale 1" = 40' Horiz.
 1" = 5' Vert.

NOTE: PIPE BETWEEN STA. 0+00 AND STA. 1+87.5 SHALL BE THE SAME TYPE OF PIPE AS THAT WHICH IS TO BE INSTALLED BY CONTRACTOR FOR LATERAL 9, MAIN 3, WESTLINK SEWER.

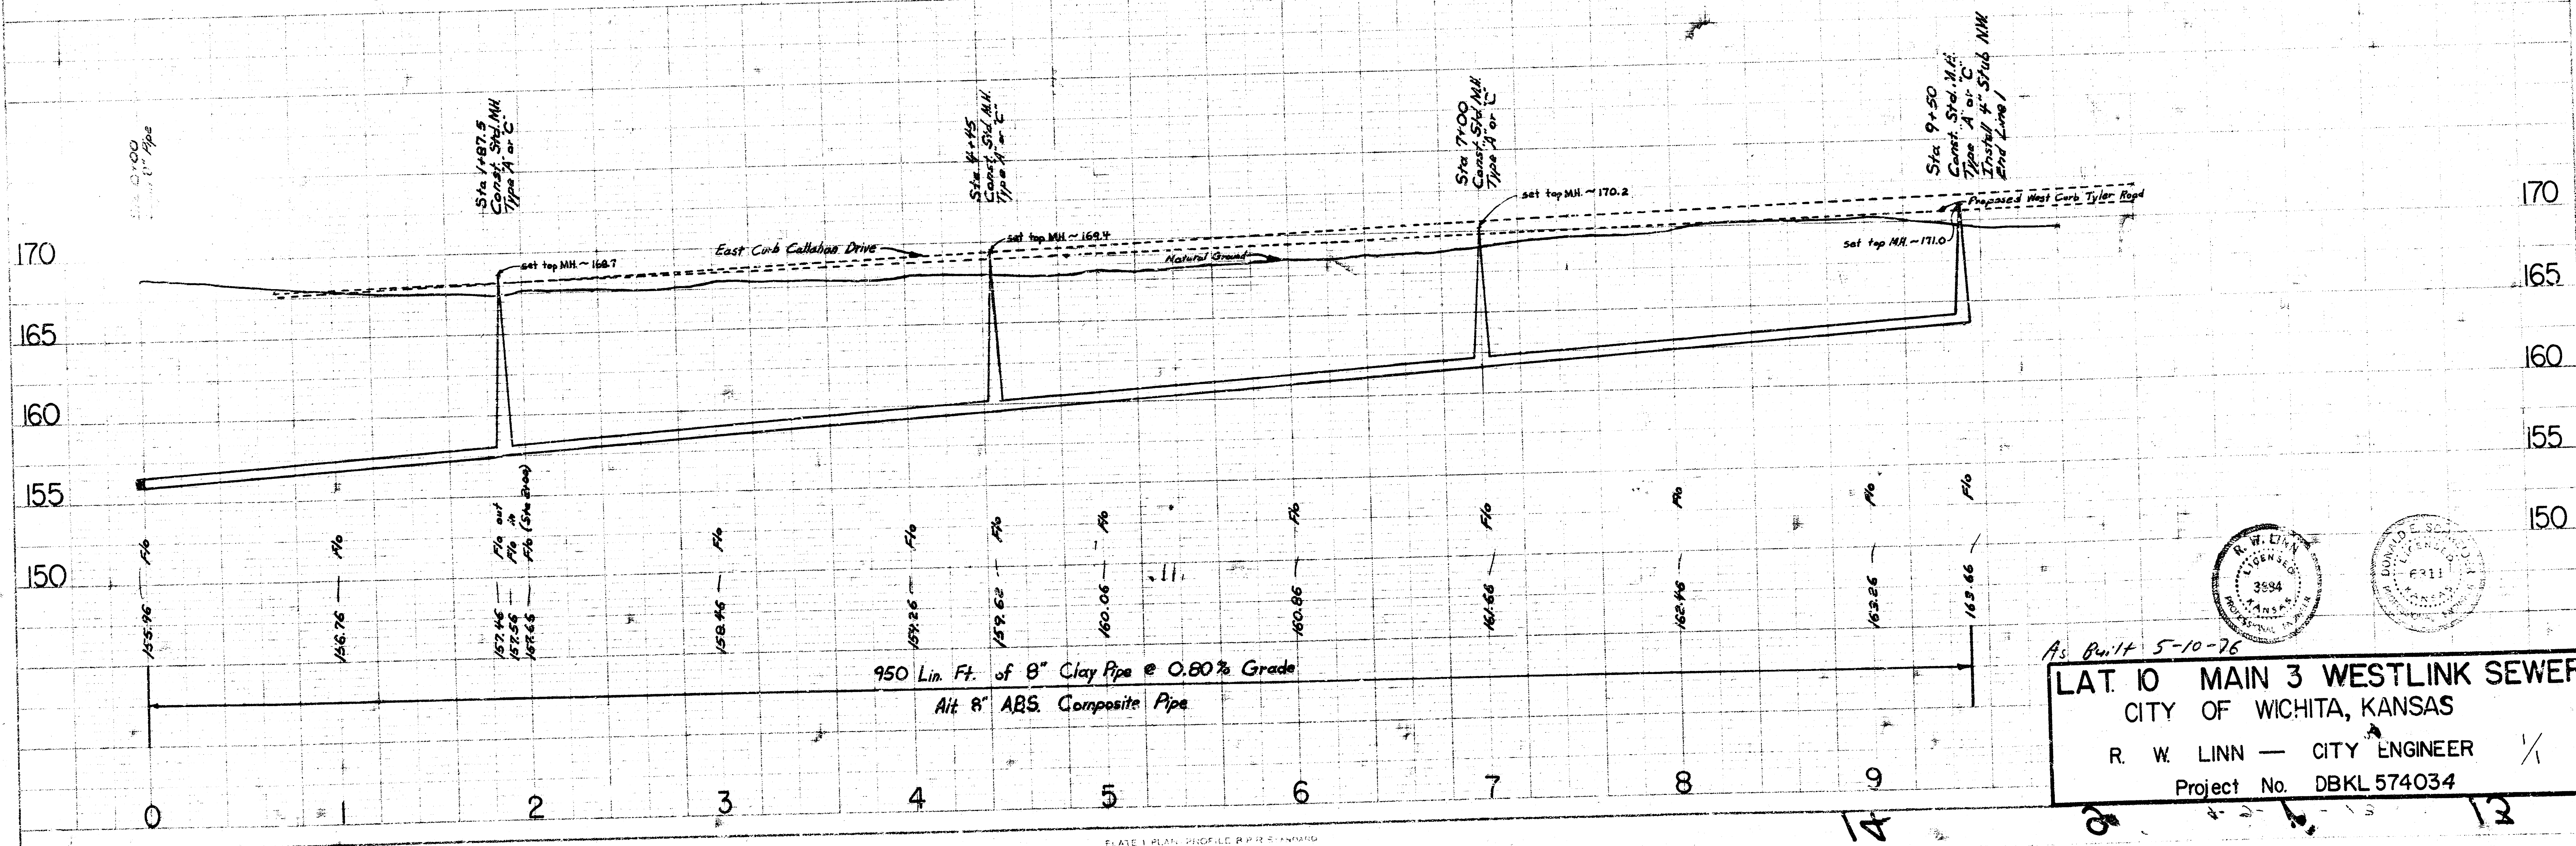

As Built 5-10-76
LAT. 10 MAIN 3 WESTLINK SEWER
 CITY OF WICHITA, KANSAS
 R. W. LINN — CITY ENGINEER
 Project No. DBKL 574034