
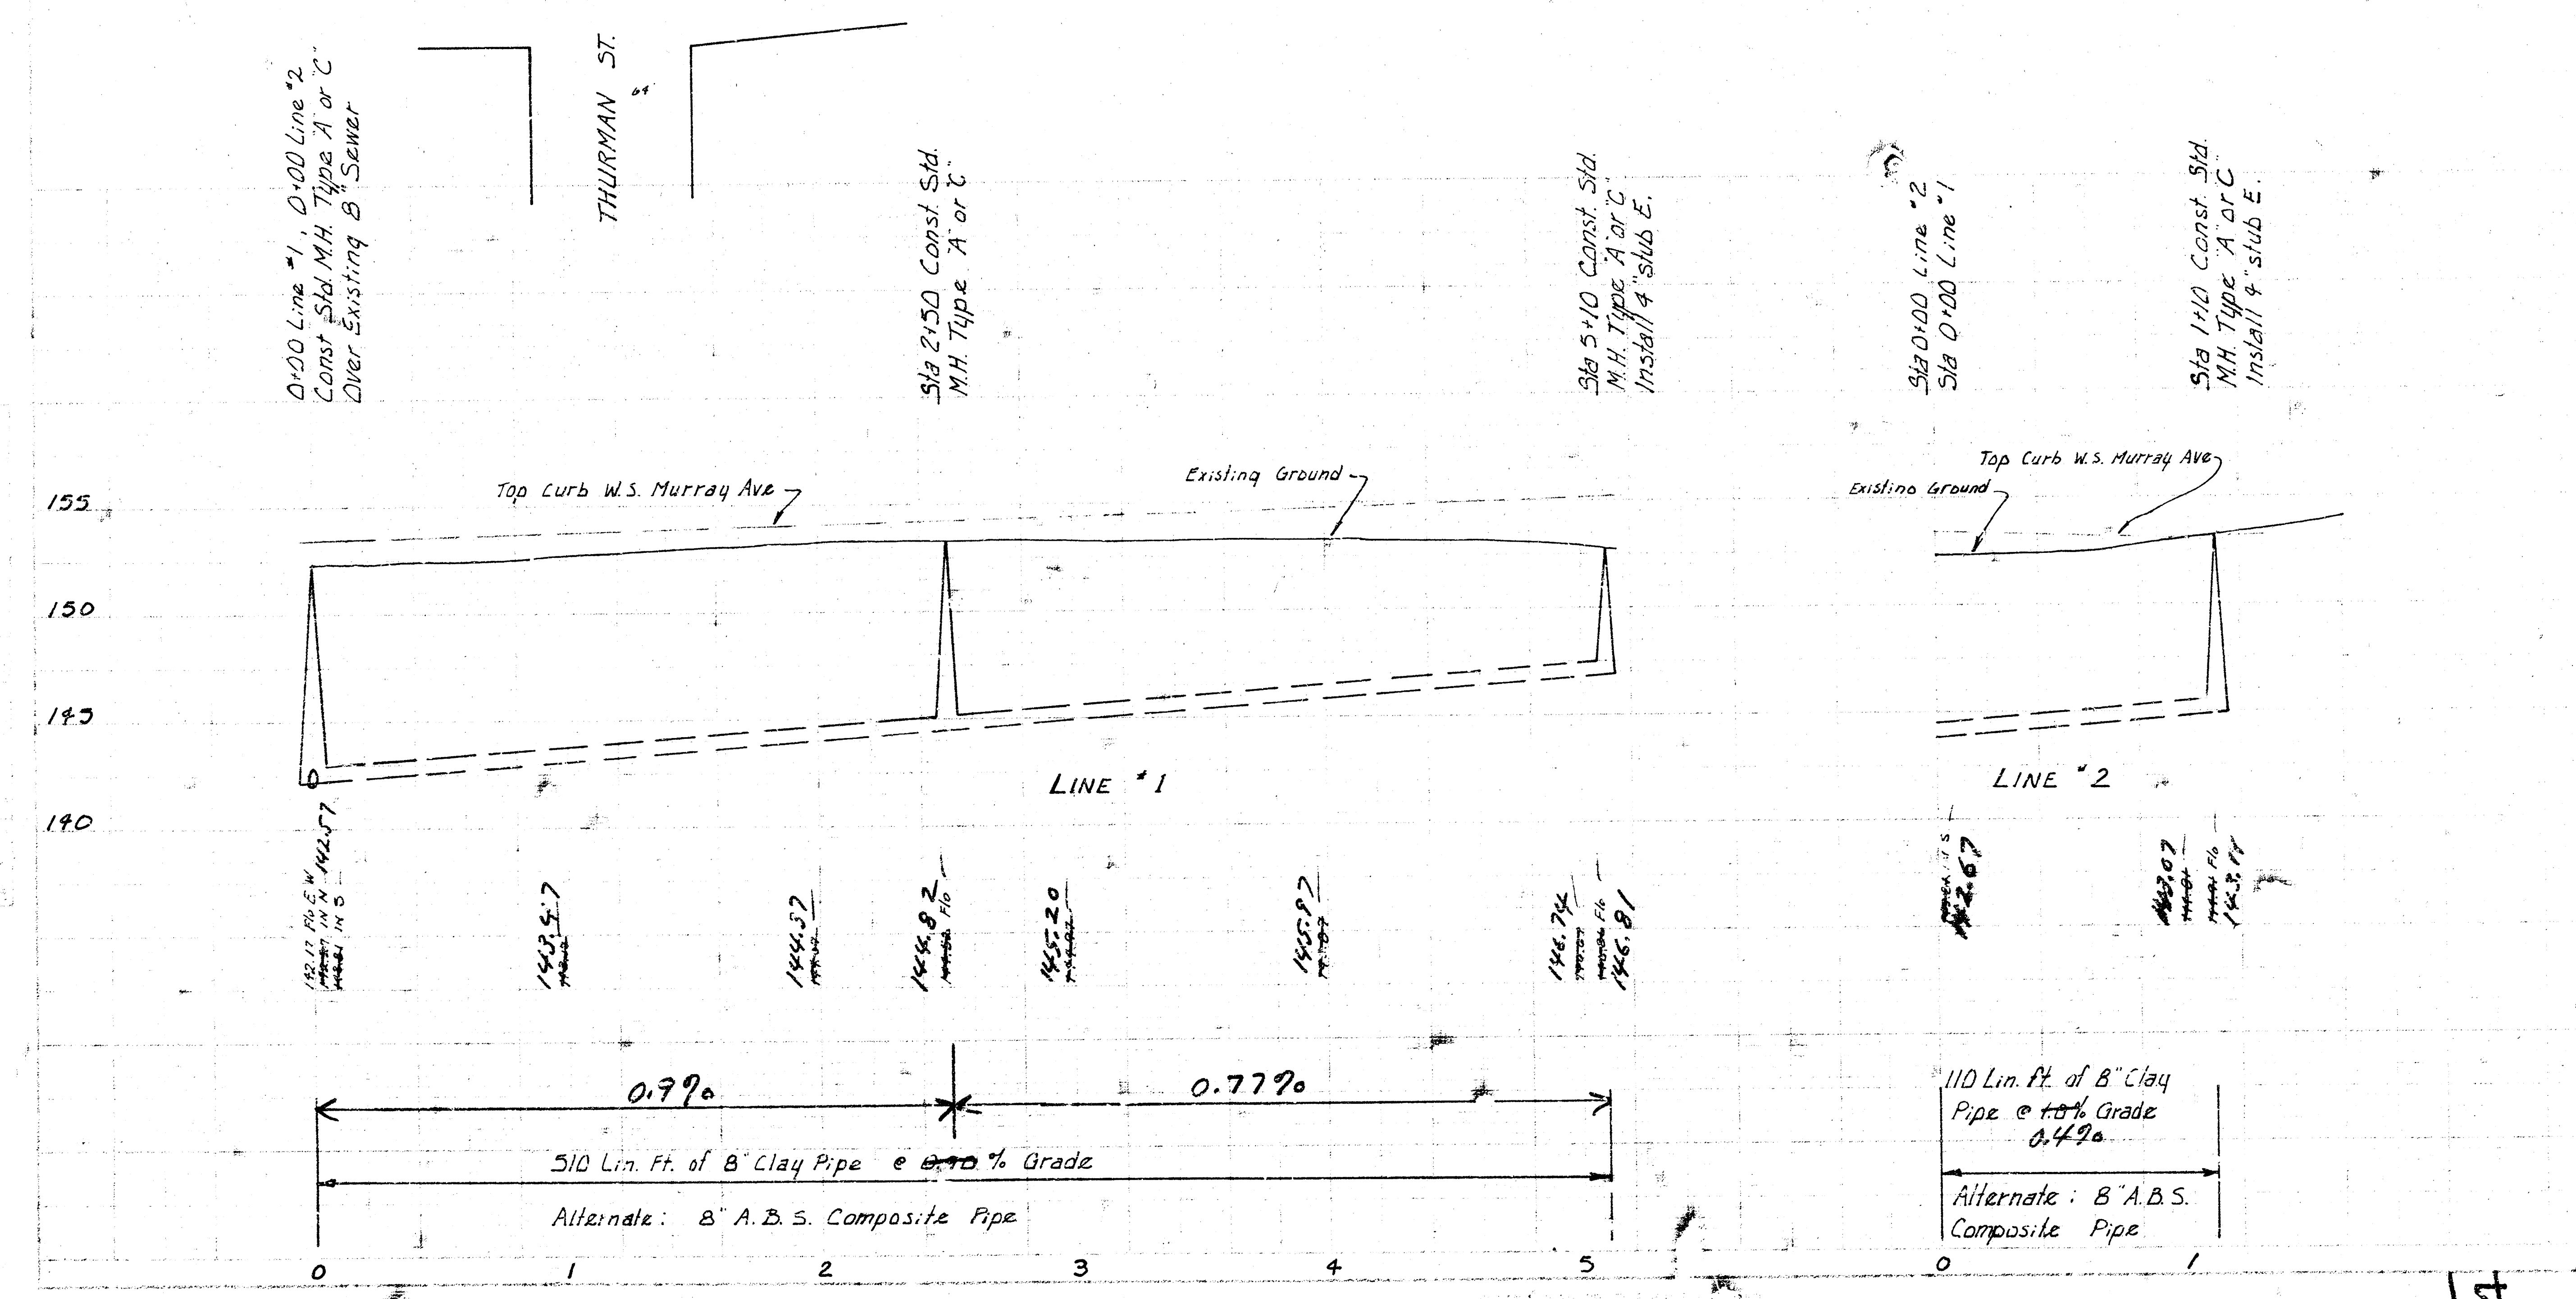


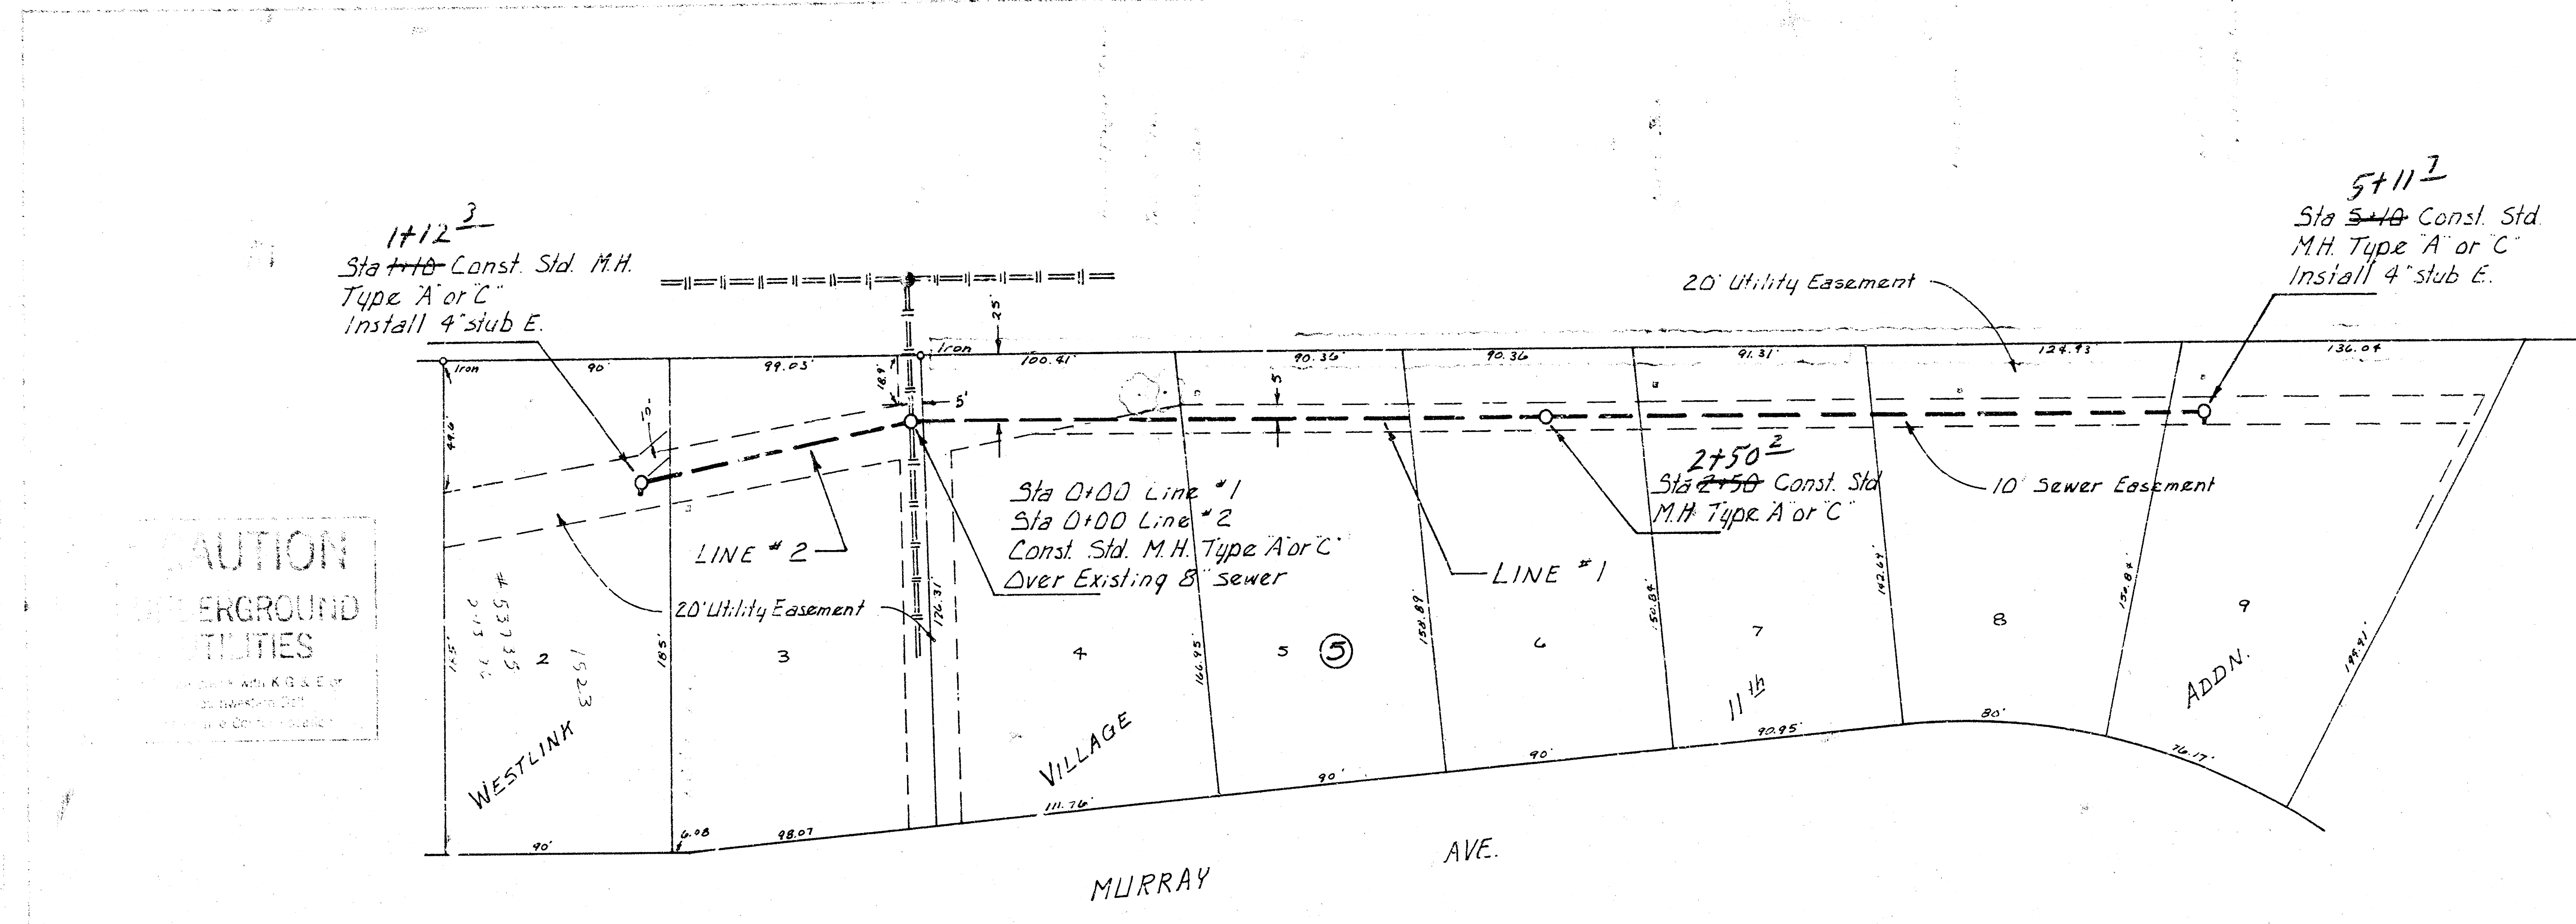

B.M. 158.58 N.W. Corner conc. porch west side of house at 1502 Murray Ave.

As Built 2-19-76
LAT II, MAIN 3, WESTLINK SEWER
 CITY OF WICHITA, KANSAS
 R. W. LINN — CITY ENGINEER
 Jan., 1976 PROJECT NO. DBKL574035 1/1