


B.M. 172.48 17th & Tyler City B.M. Disc
 31' So. & 36' E. of 1/4 Sec. 8
 B.M. 155.04 R.R. Spk. S. Fc. Large Usage Orange
 Hedge Tree 1' So. N.W. Cor. S.E. 1/4 Sec. 8

WESTLINK VILLAGE ELEVENTH ADDITION



Plan Scale 1" = 40'
 Profile Scale 1" = 40' Horiz.
 1" = 5' Vert.

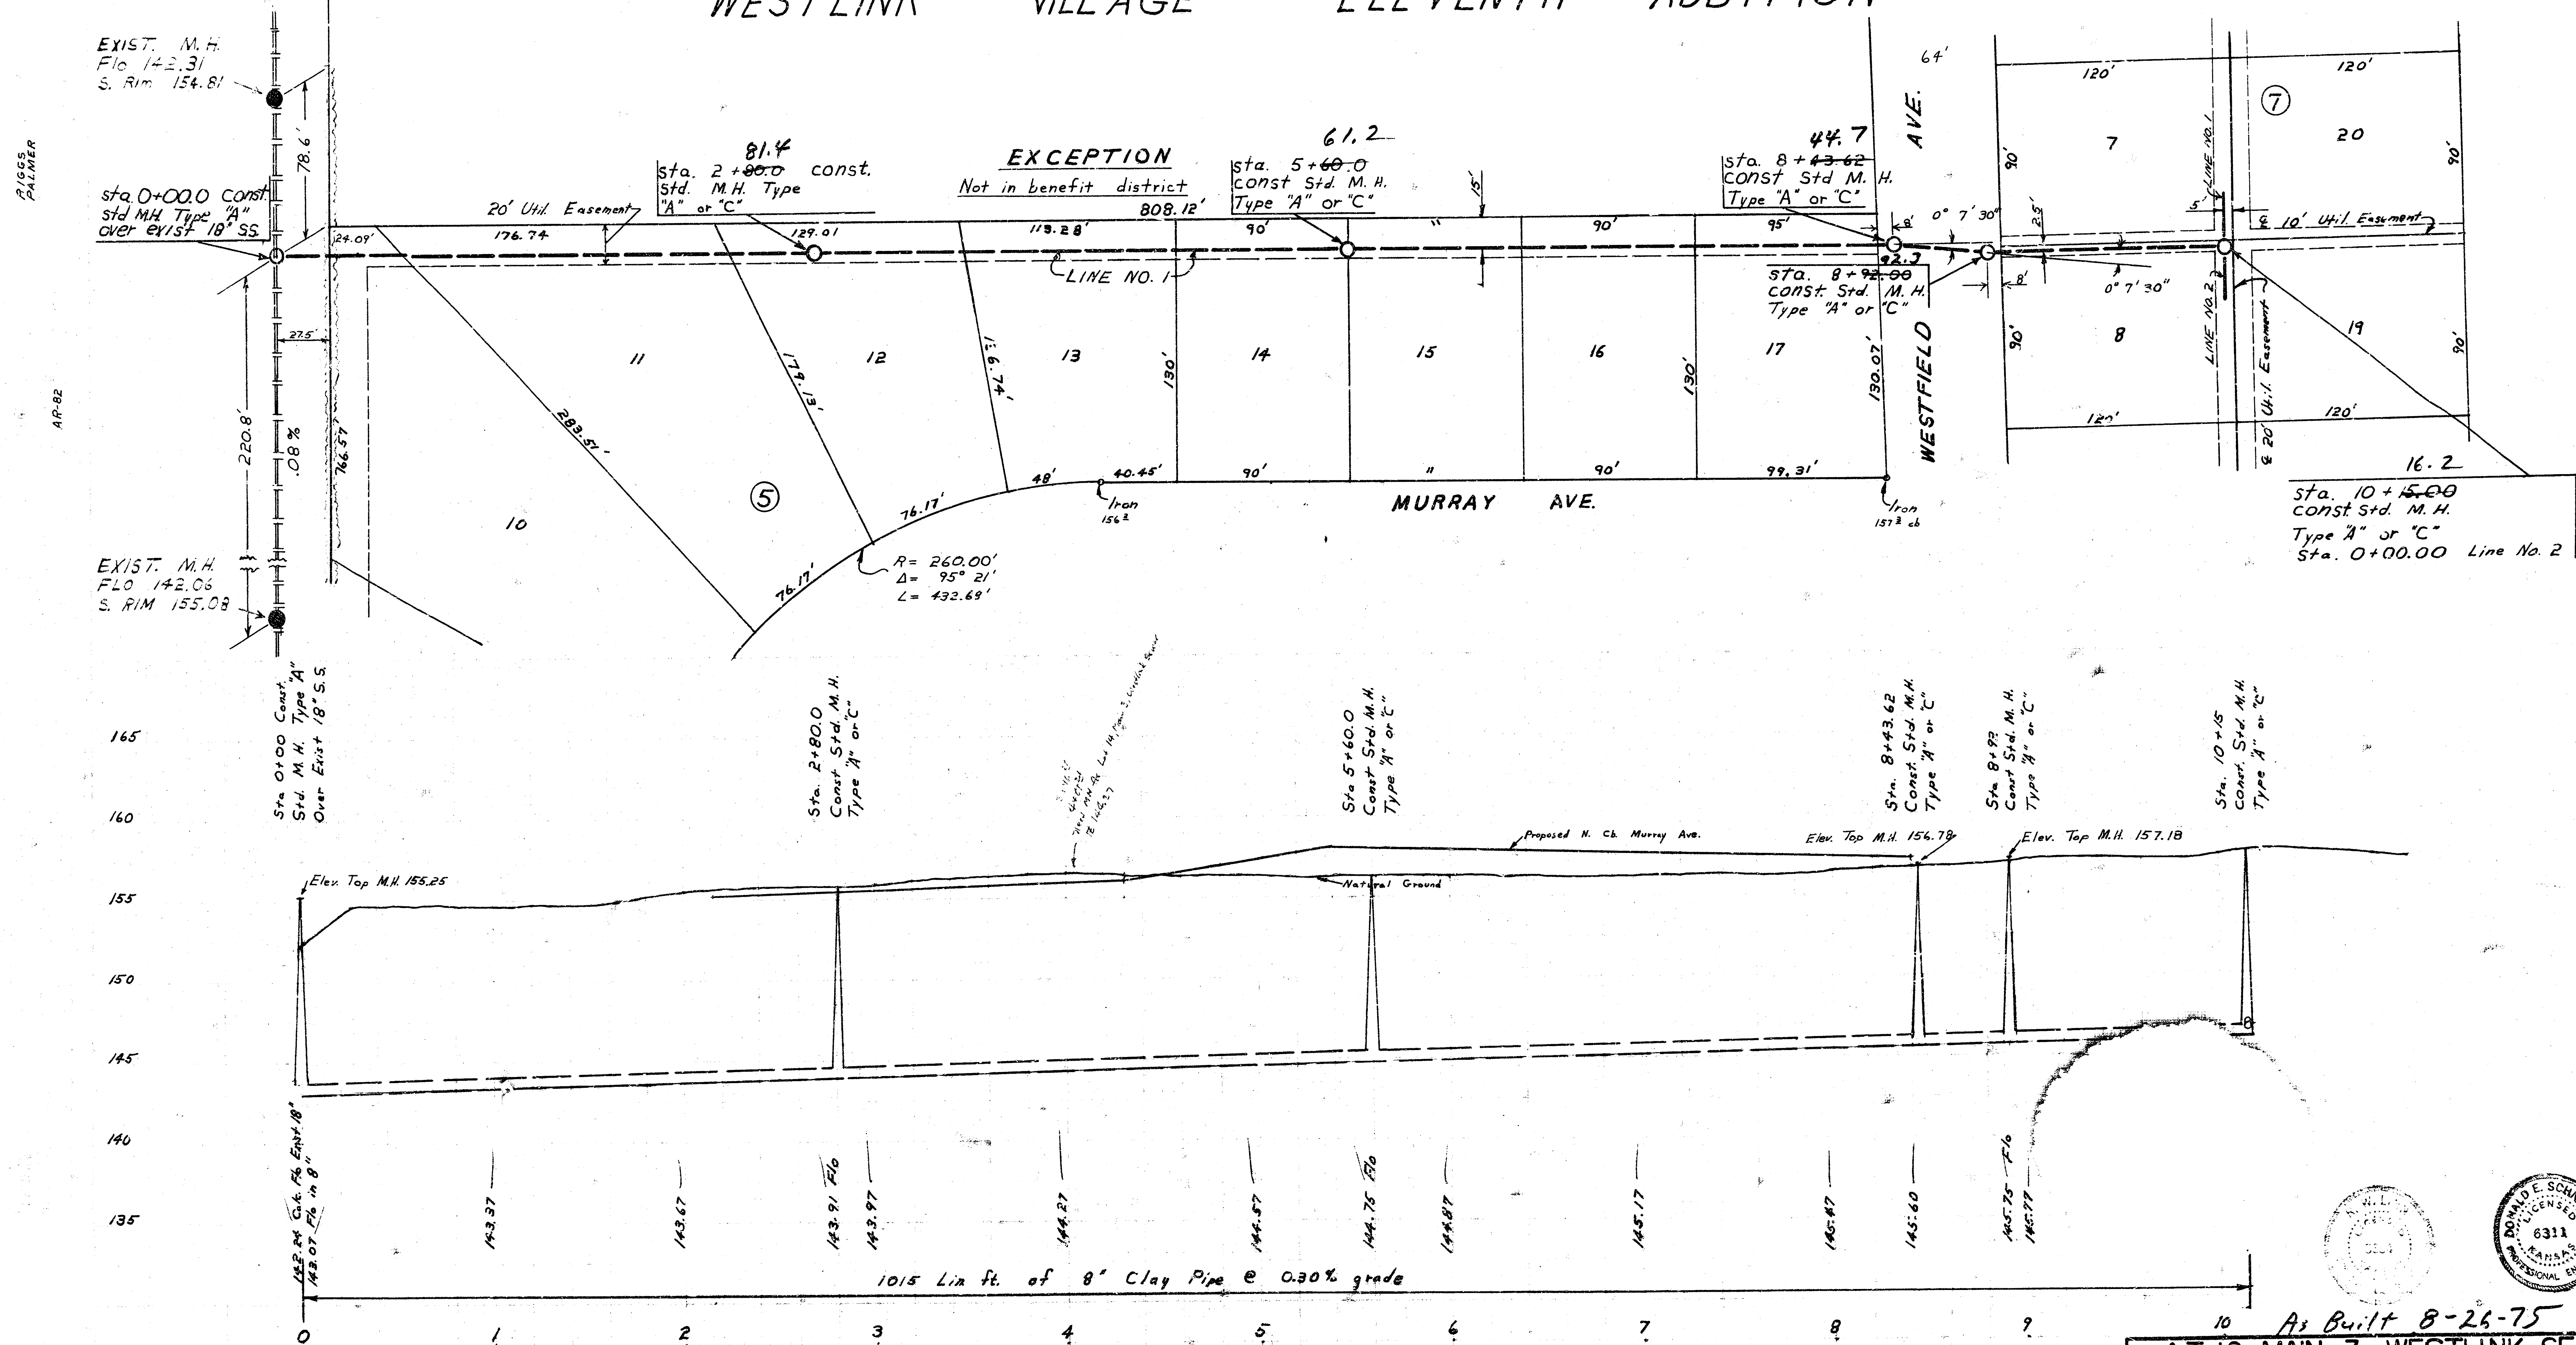


As Built 8-26-75
 LAT. 12, MAIN 3, WESTLINK SEWER
 CITY OF WICHITA, KANSAS
 R. W. LINN — CITY ENGINEER
 Feb. 1975 PROJECT NO. DBKL574036

(M-267)
 Book outland
 1 of 3

FILMED FROM THE BEST

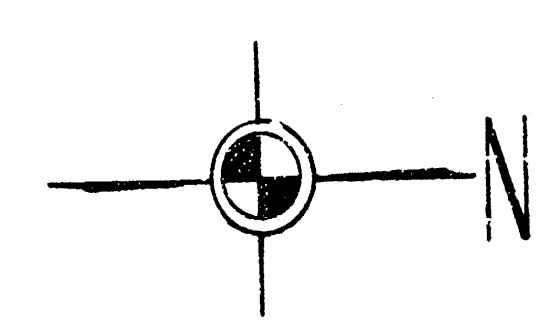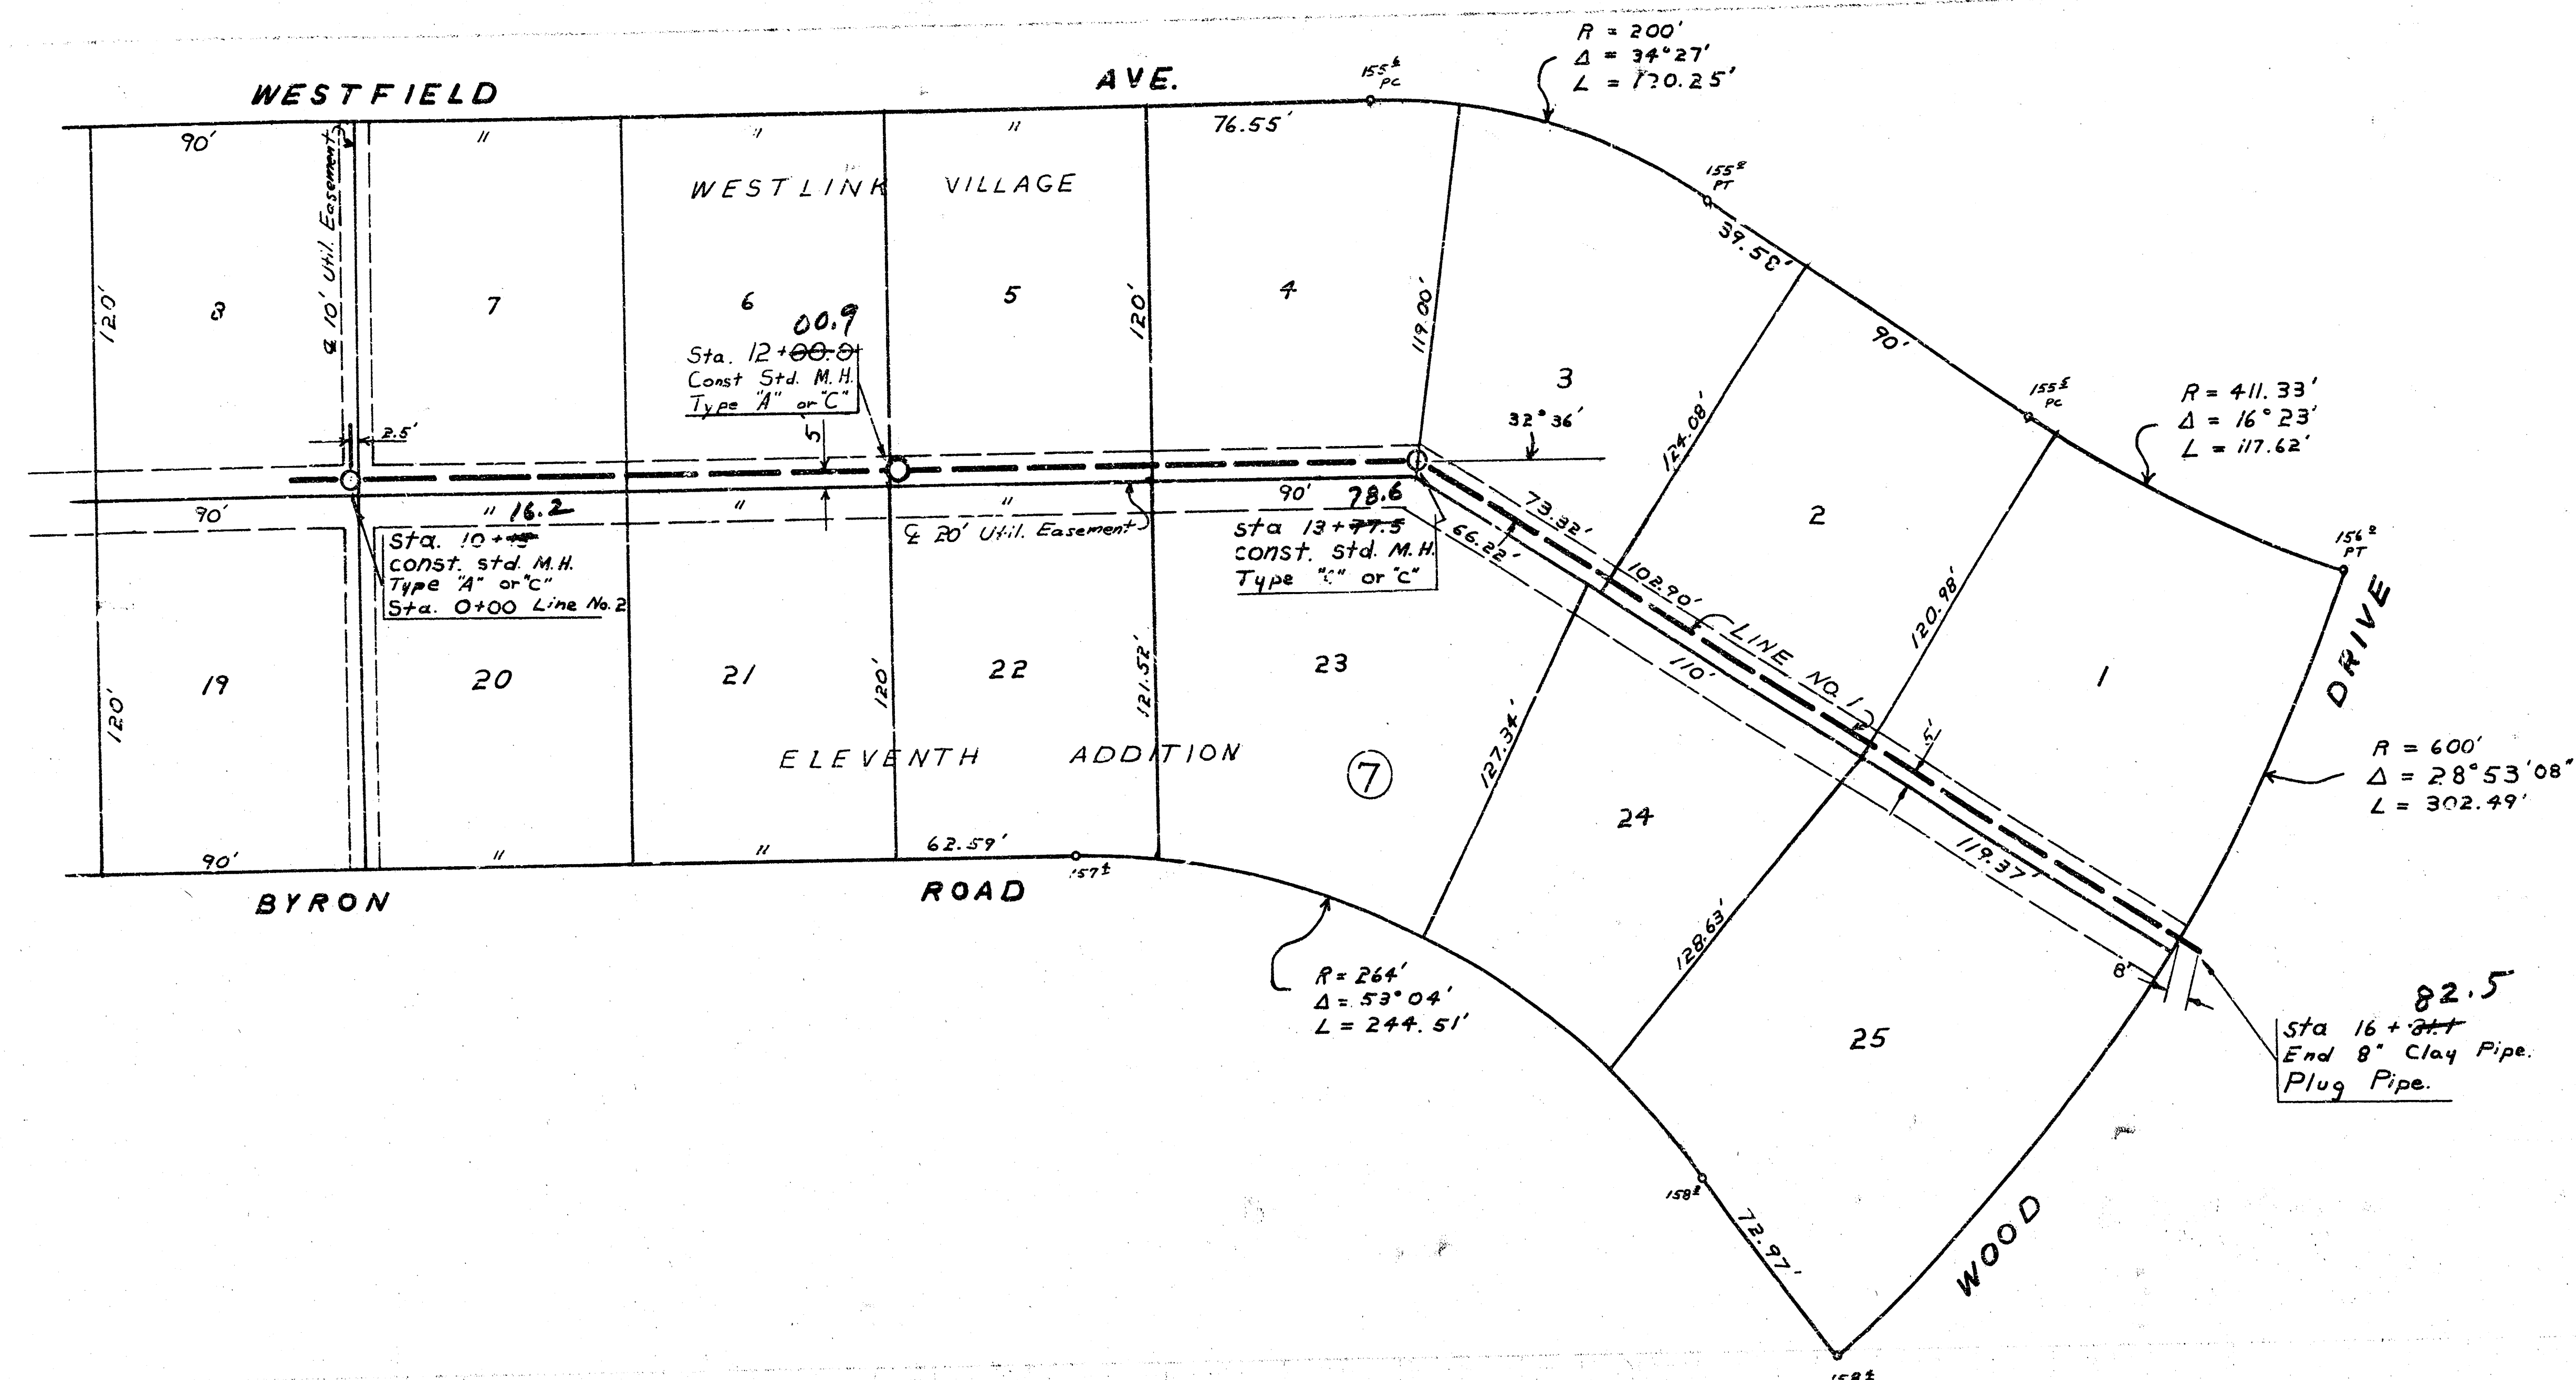

Plan Scale 1" = 40'
 Profile Scale 1" = 5' Vert


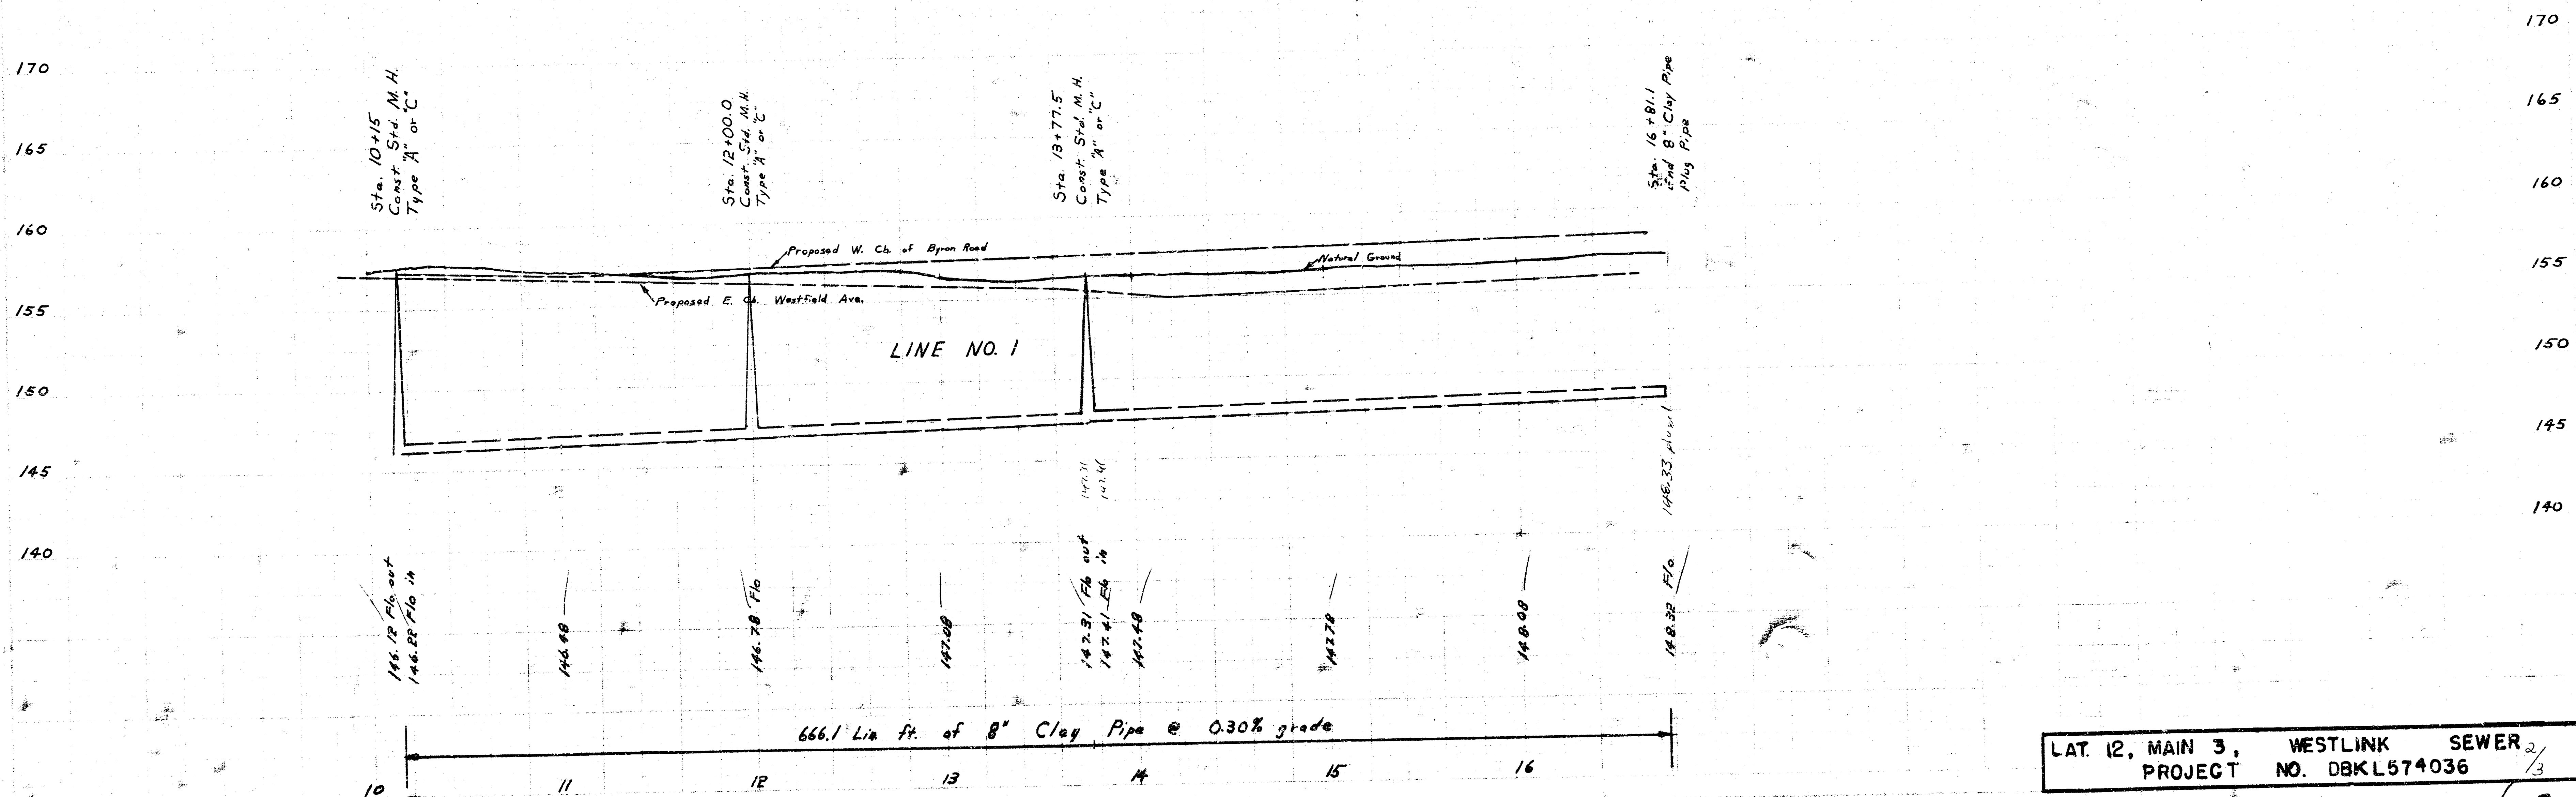


LAT. 12, MAIN 3, WESTLINK SEWER
 PROJECT NO. DBKL574036

2 of 3

WESTLINK


VILLAGE

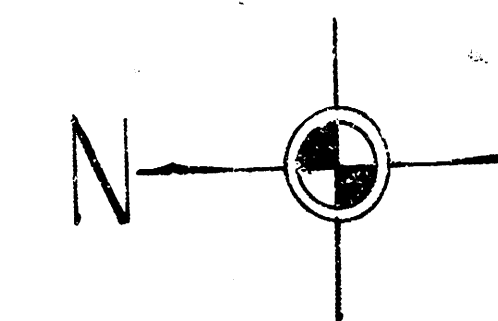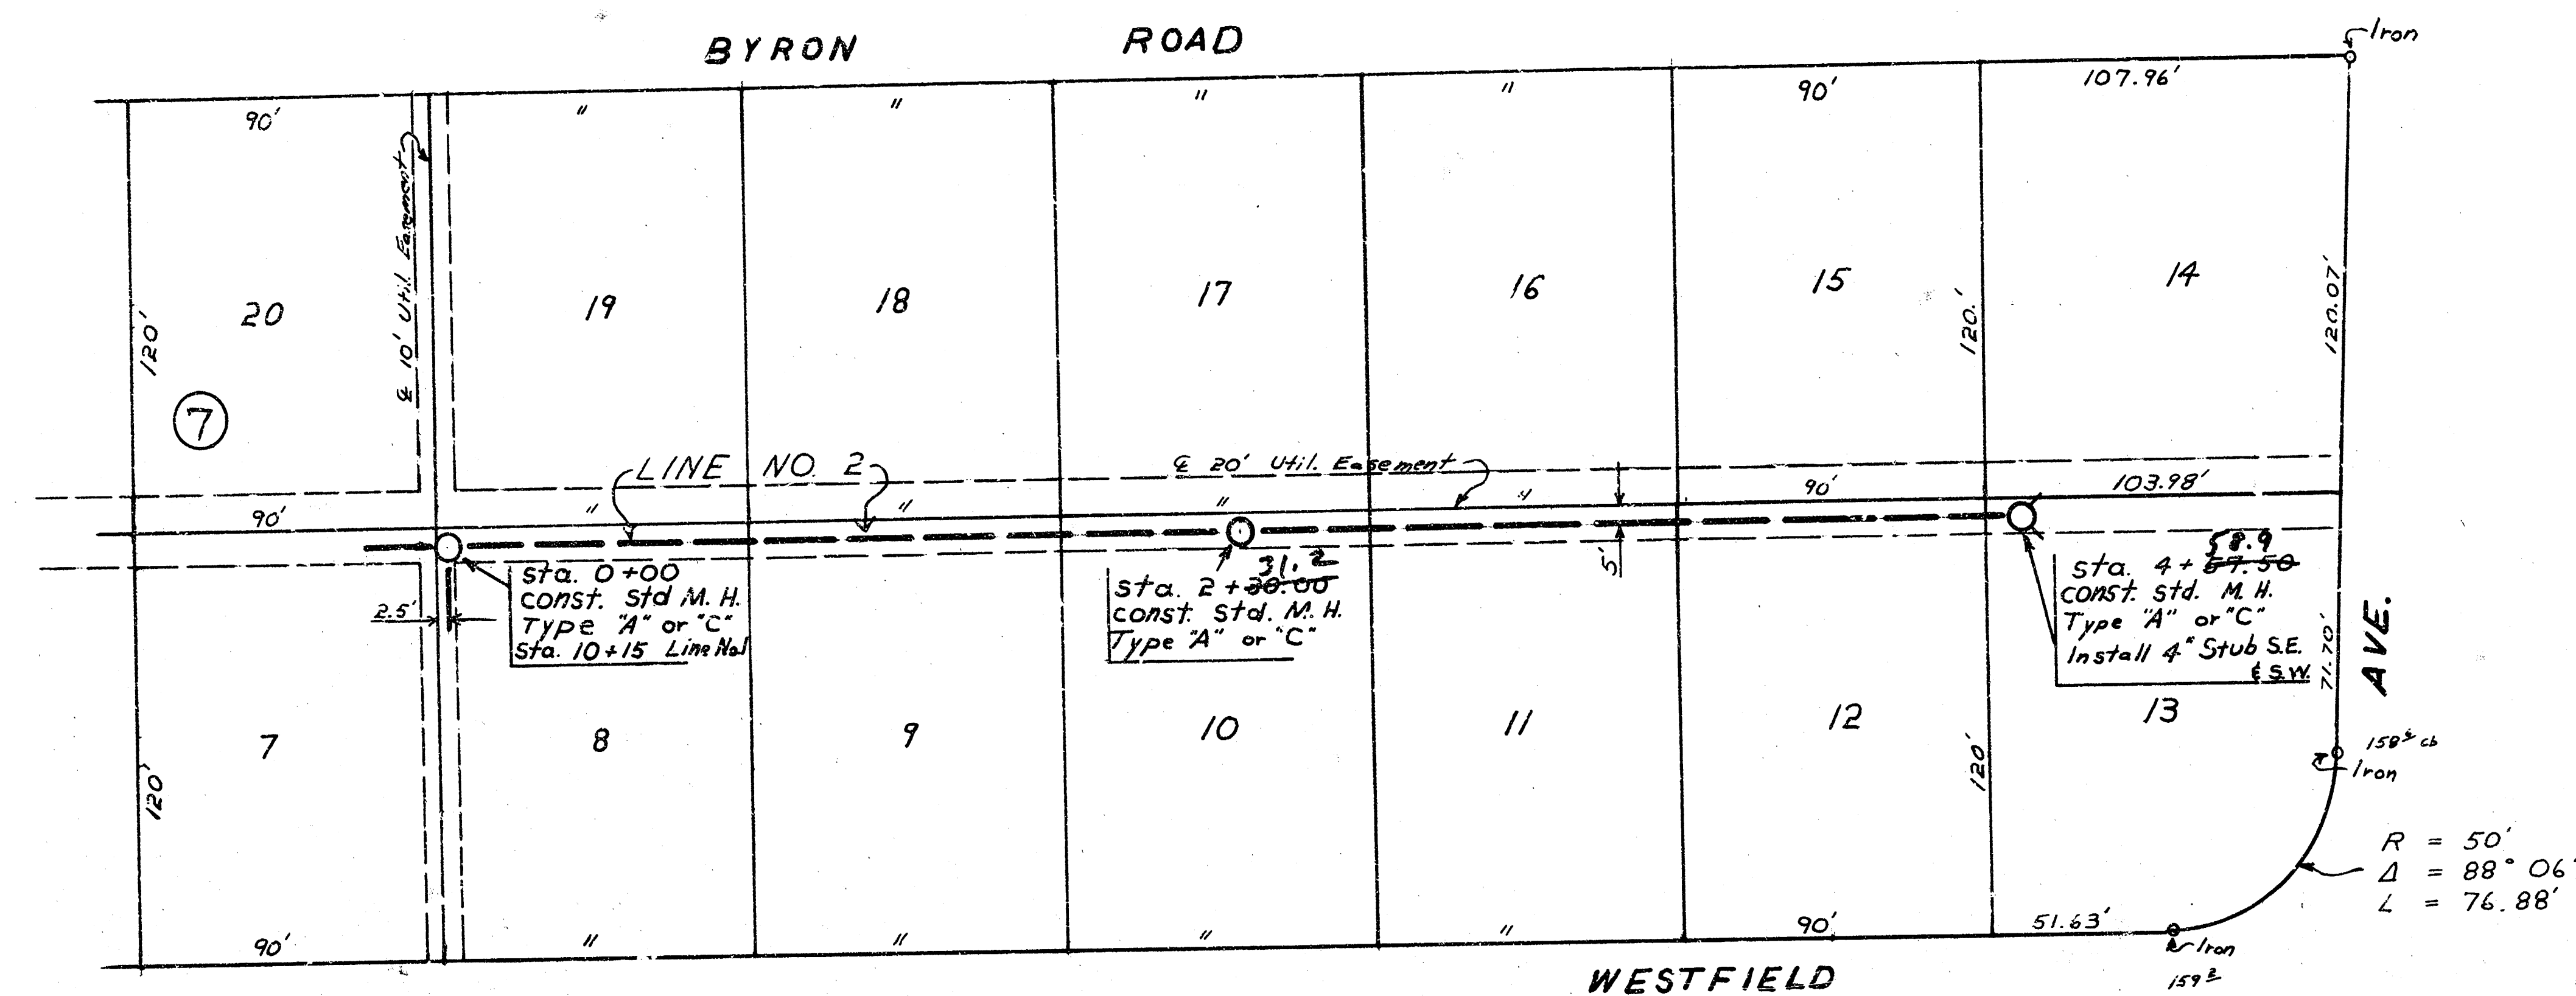

Plan Scale 1" = 40'
Profile Scale 1" = 40' Horiz.
1" = 5' Vert.

ELEVENTH

ADDITION

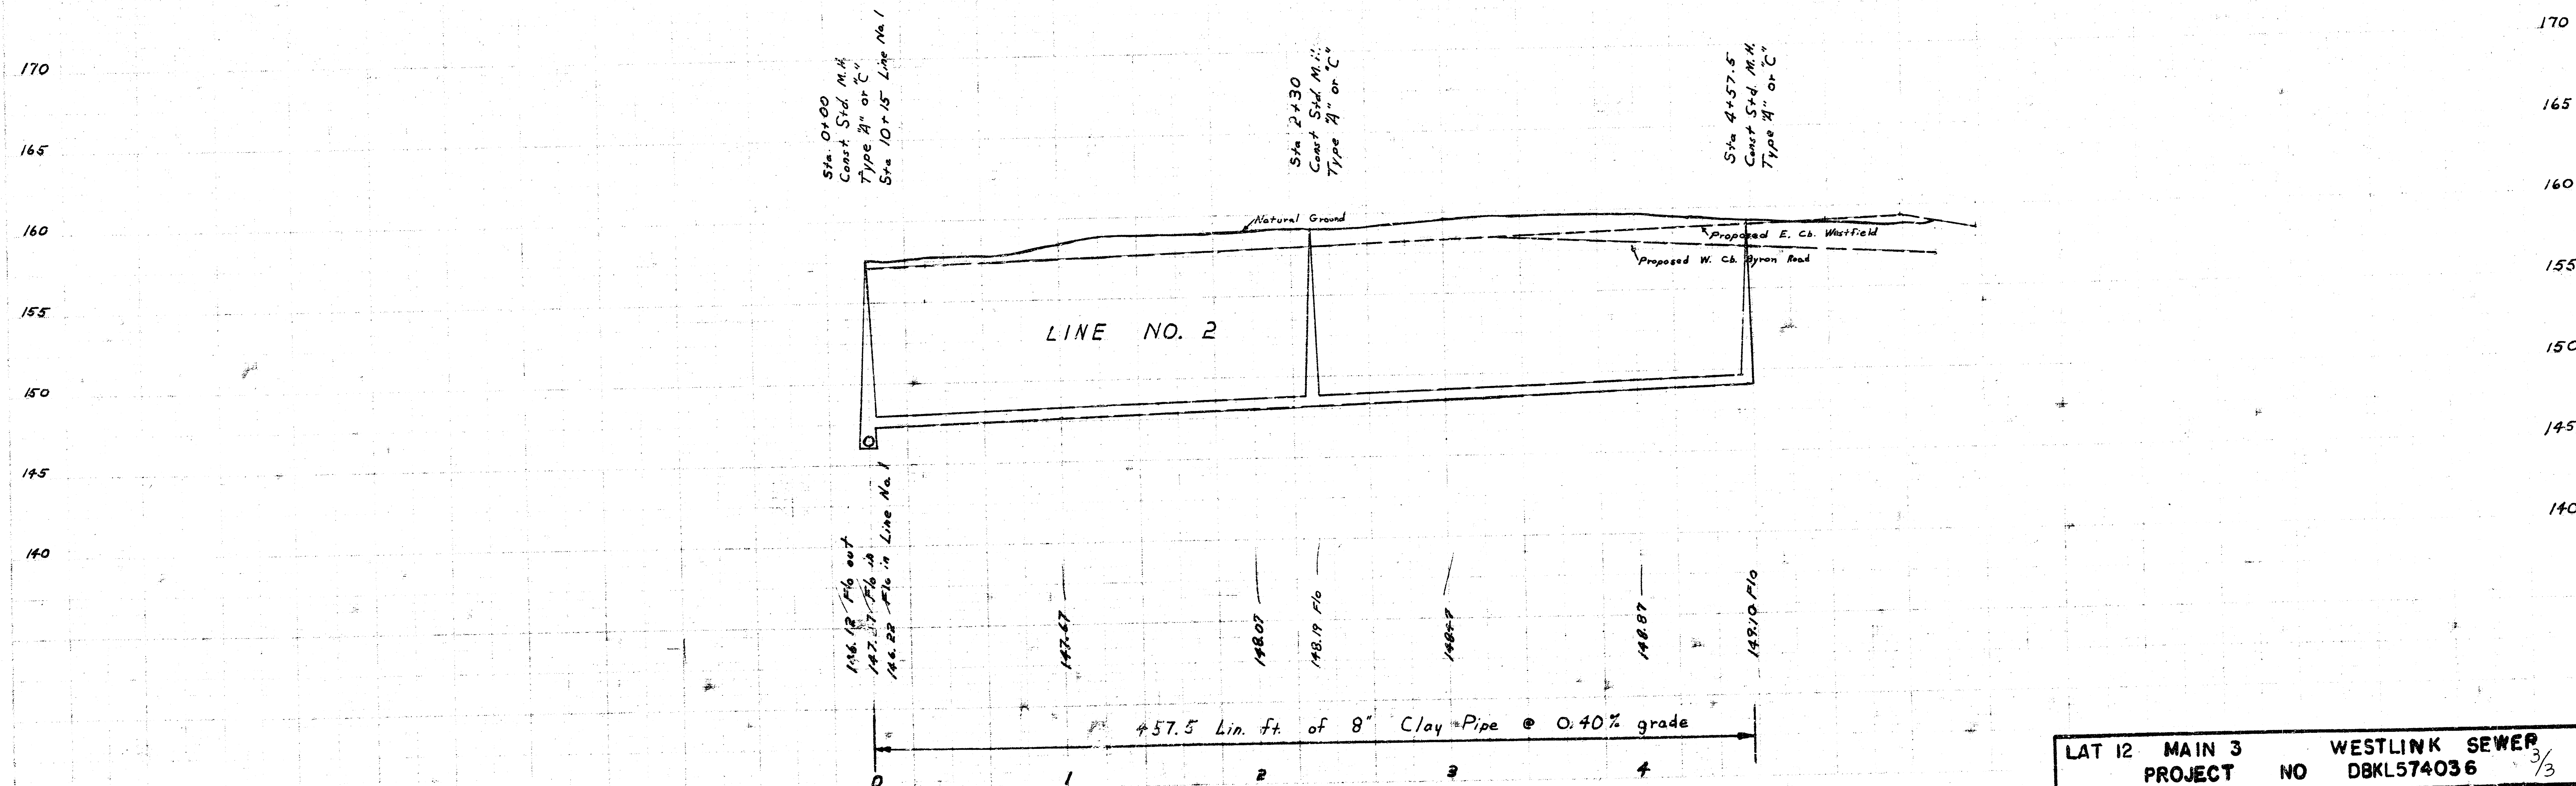

LAT 12 MAIN 3 WESTLINK SEWER
PROJECT NO DBKL574036 3/3

14 1 230789