

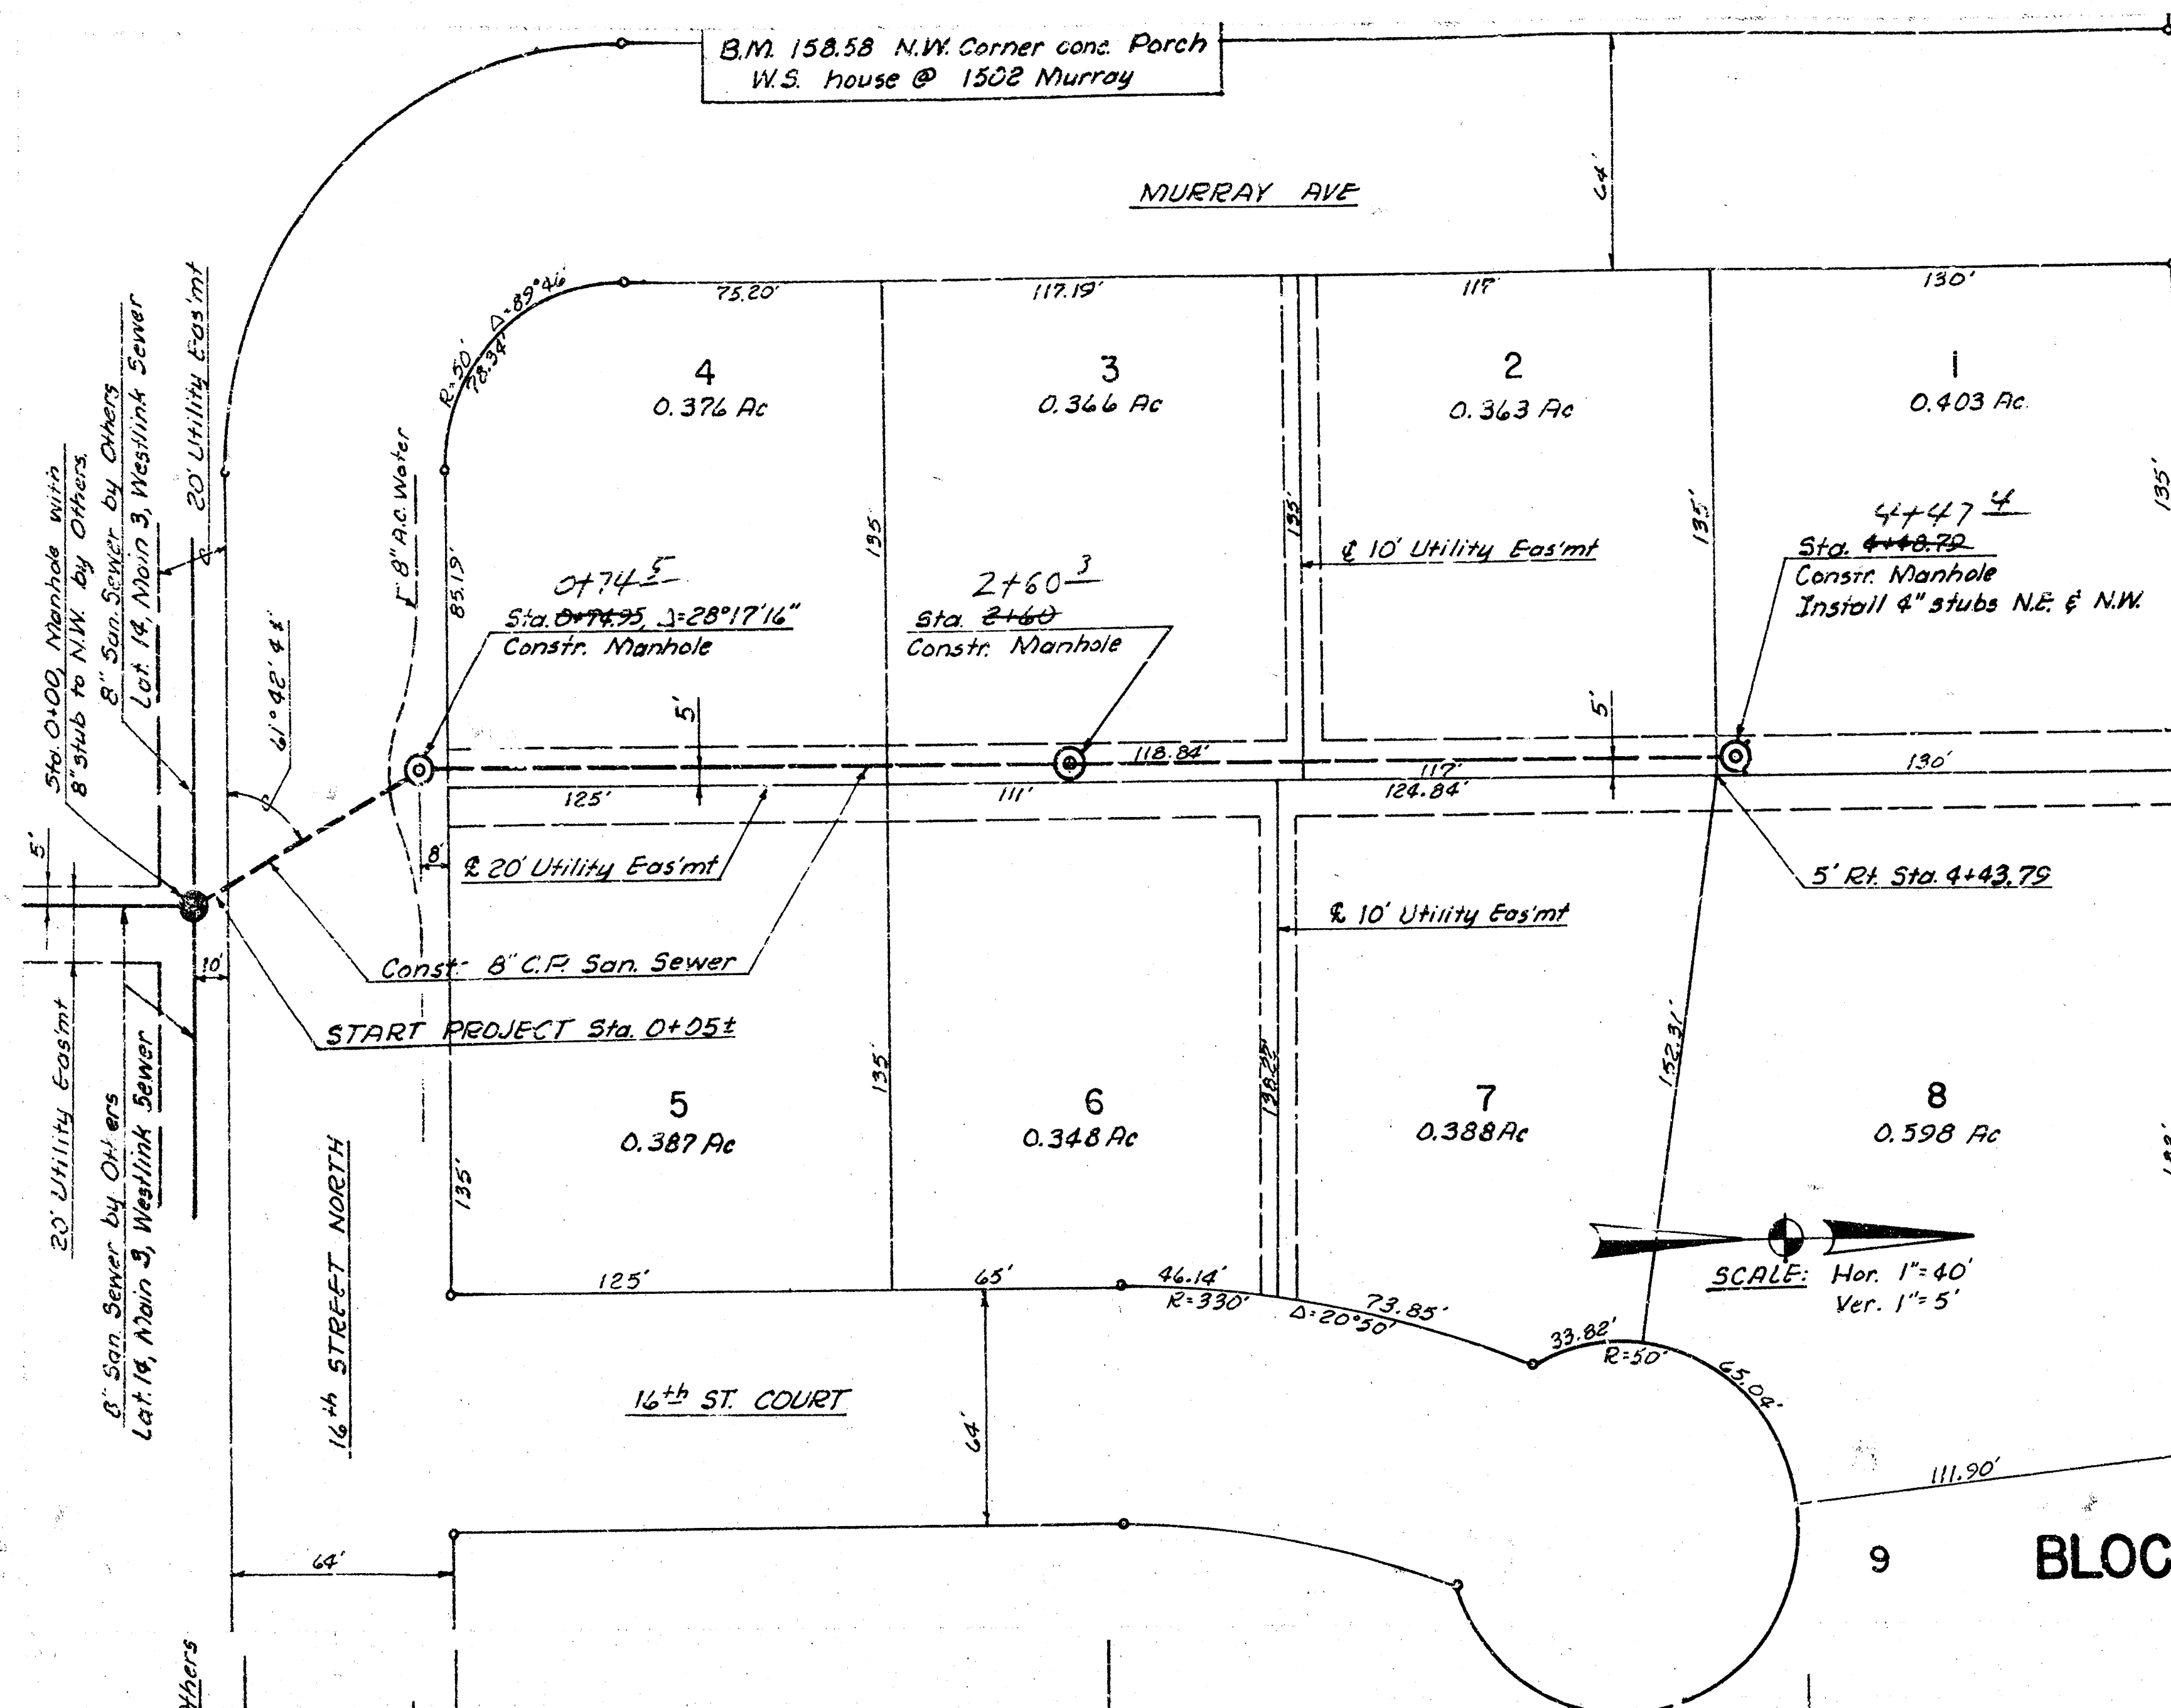
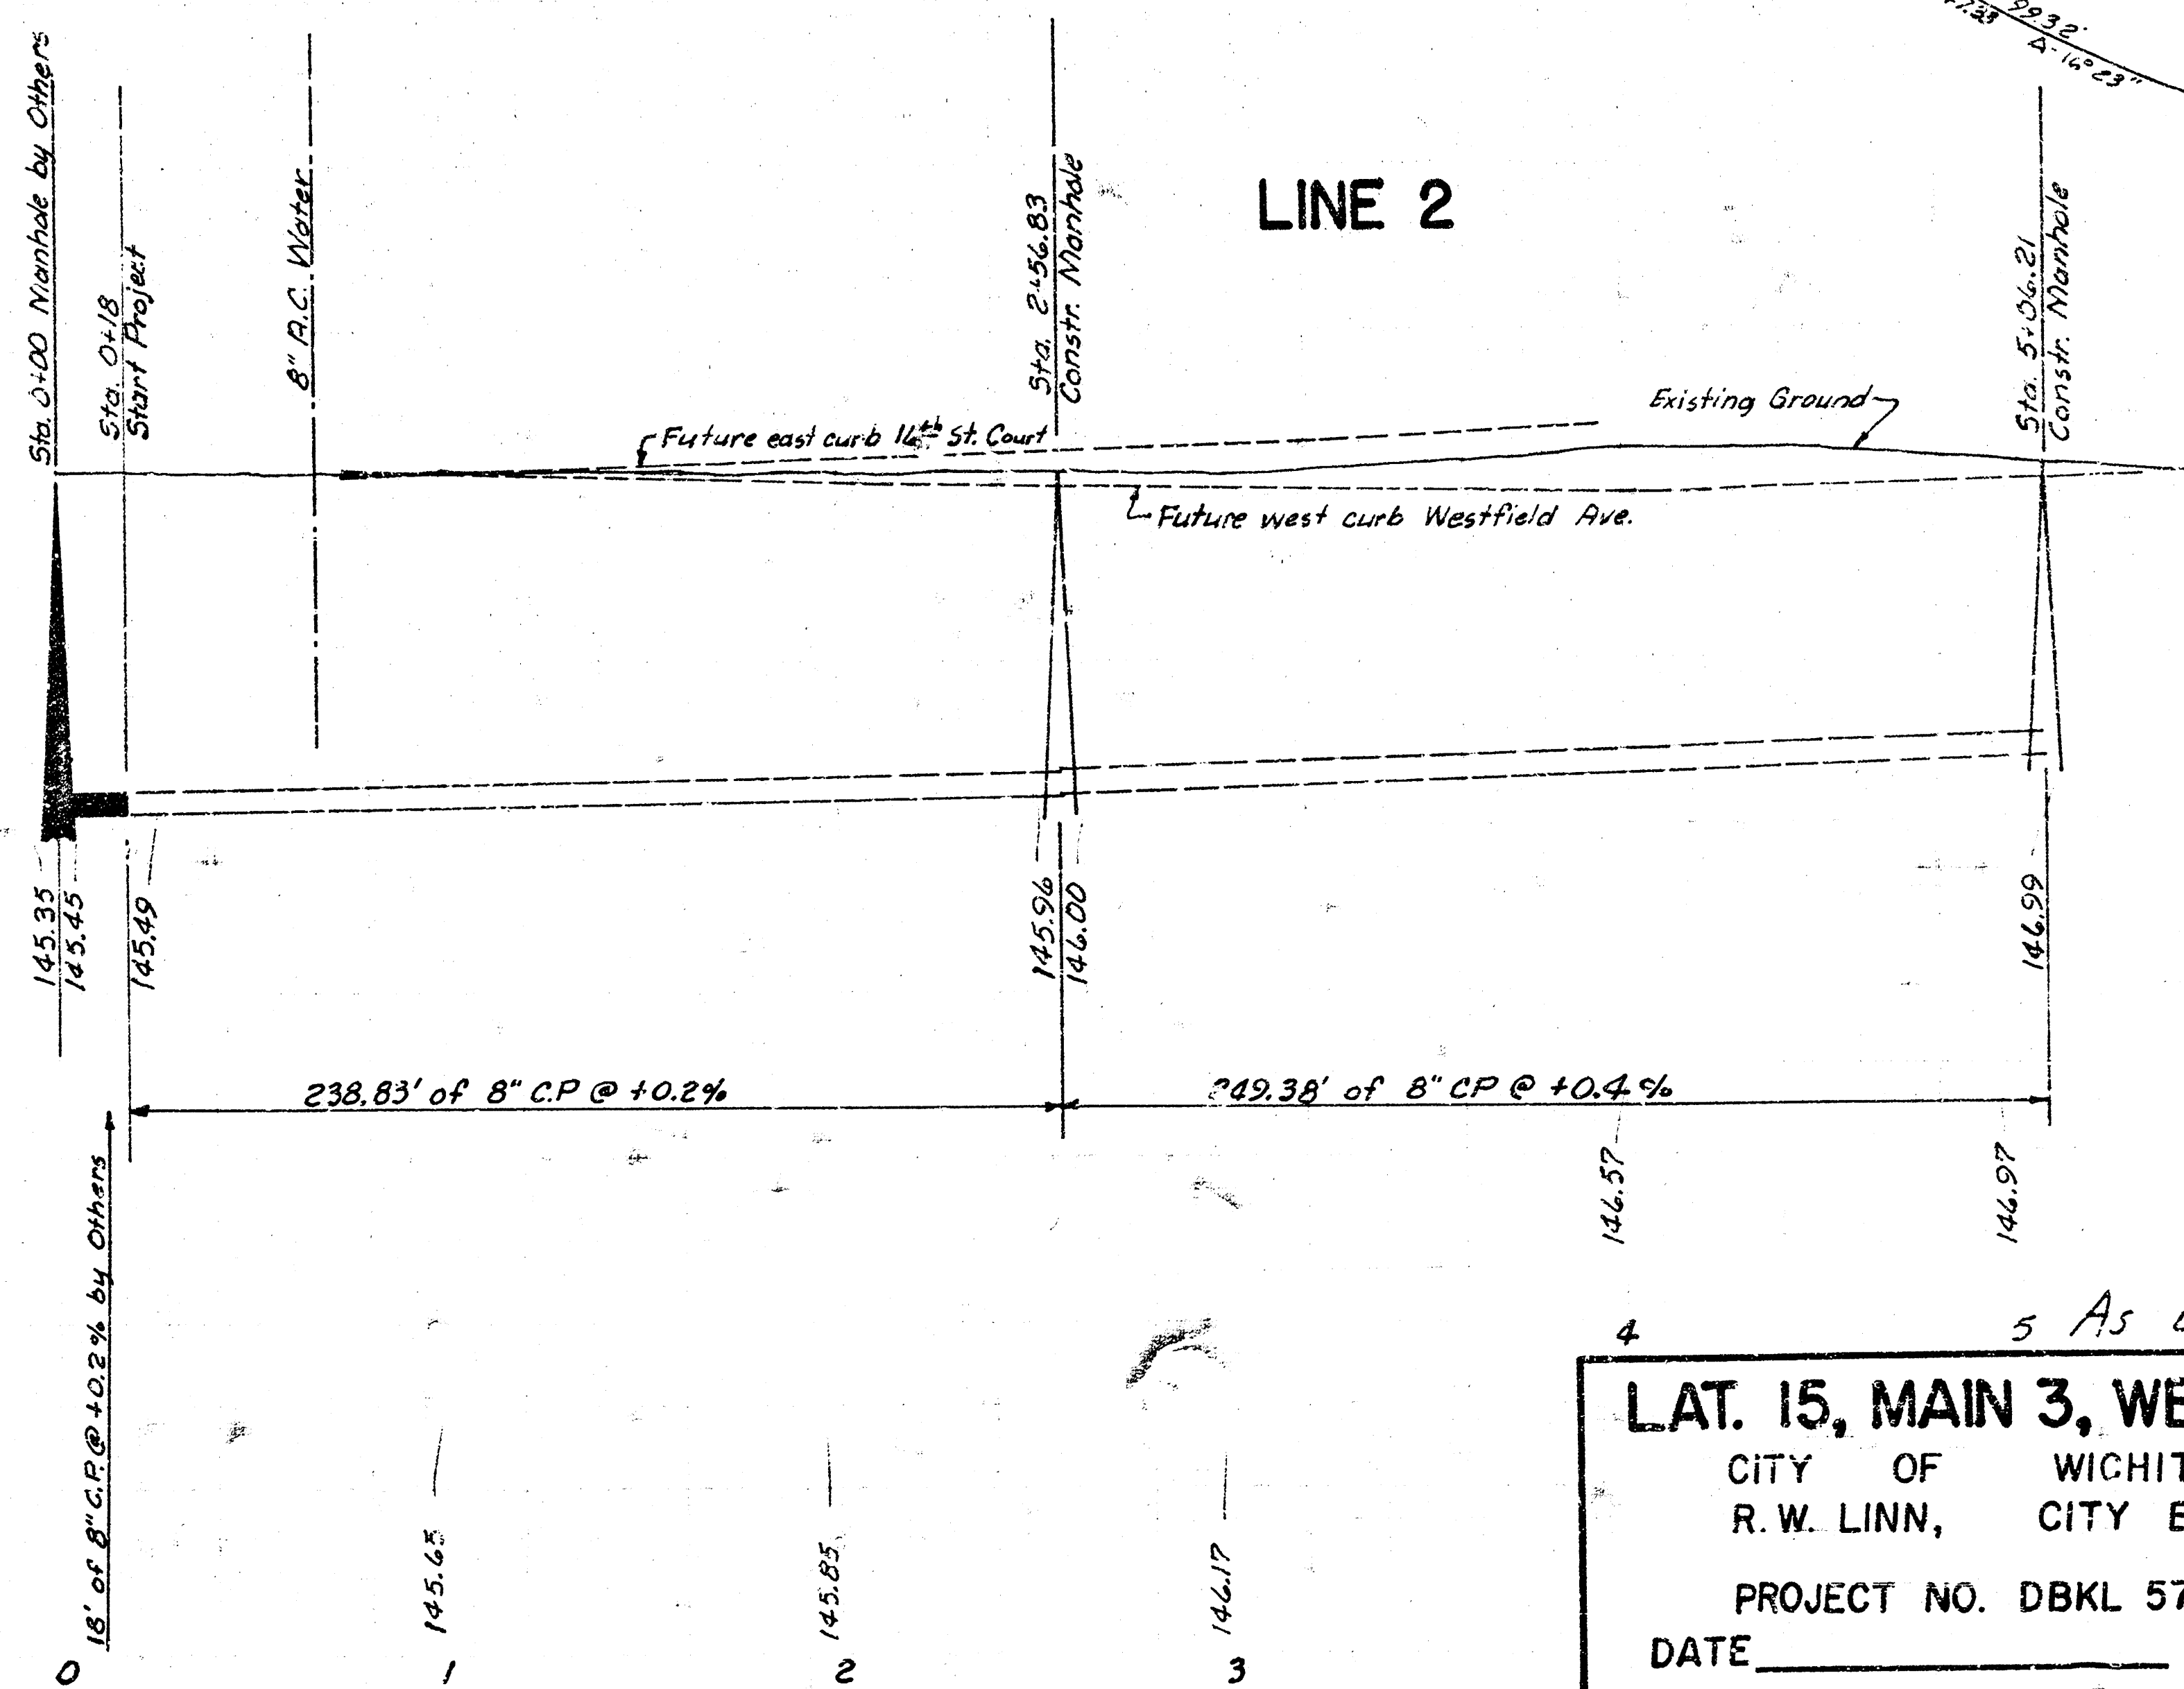


JFG, 184 (LES 2)
WSK

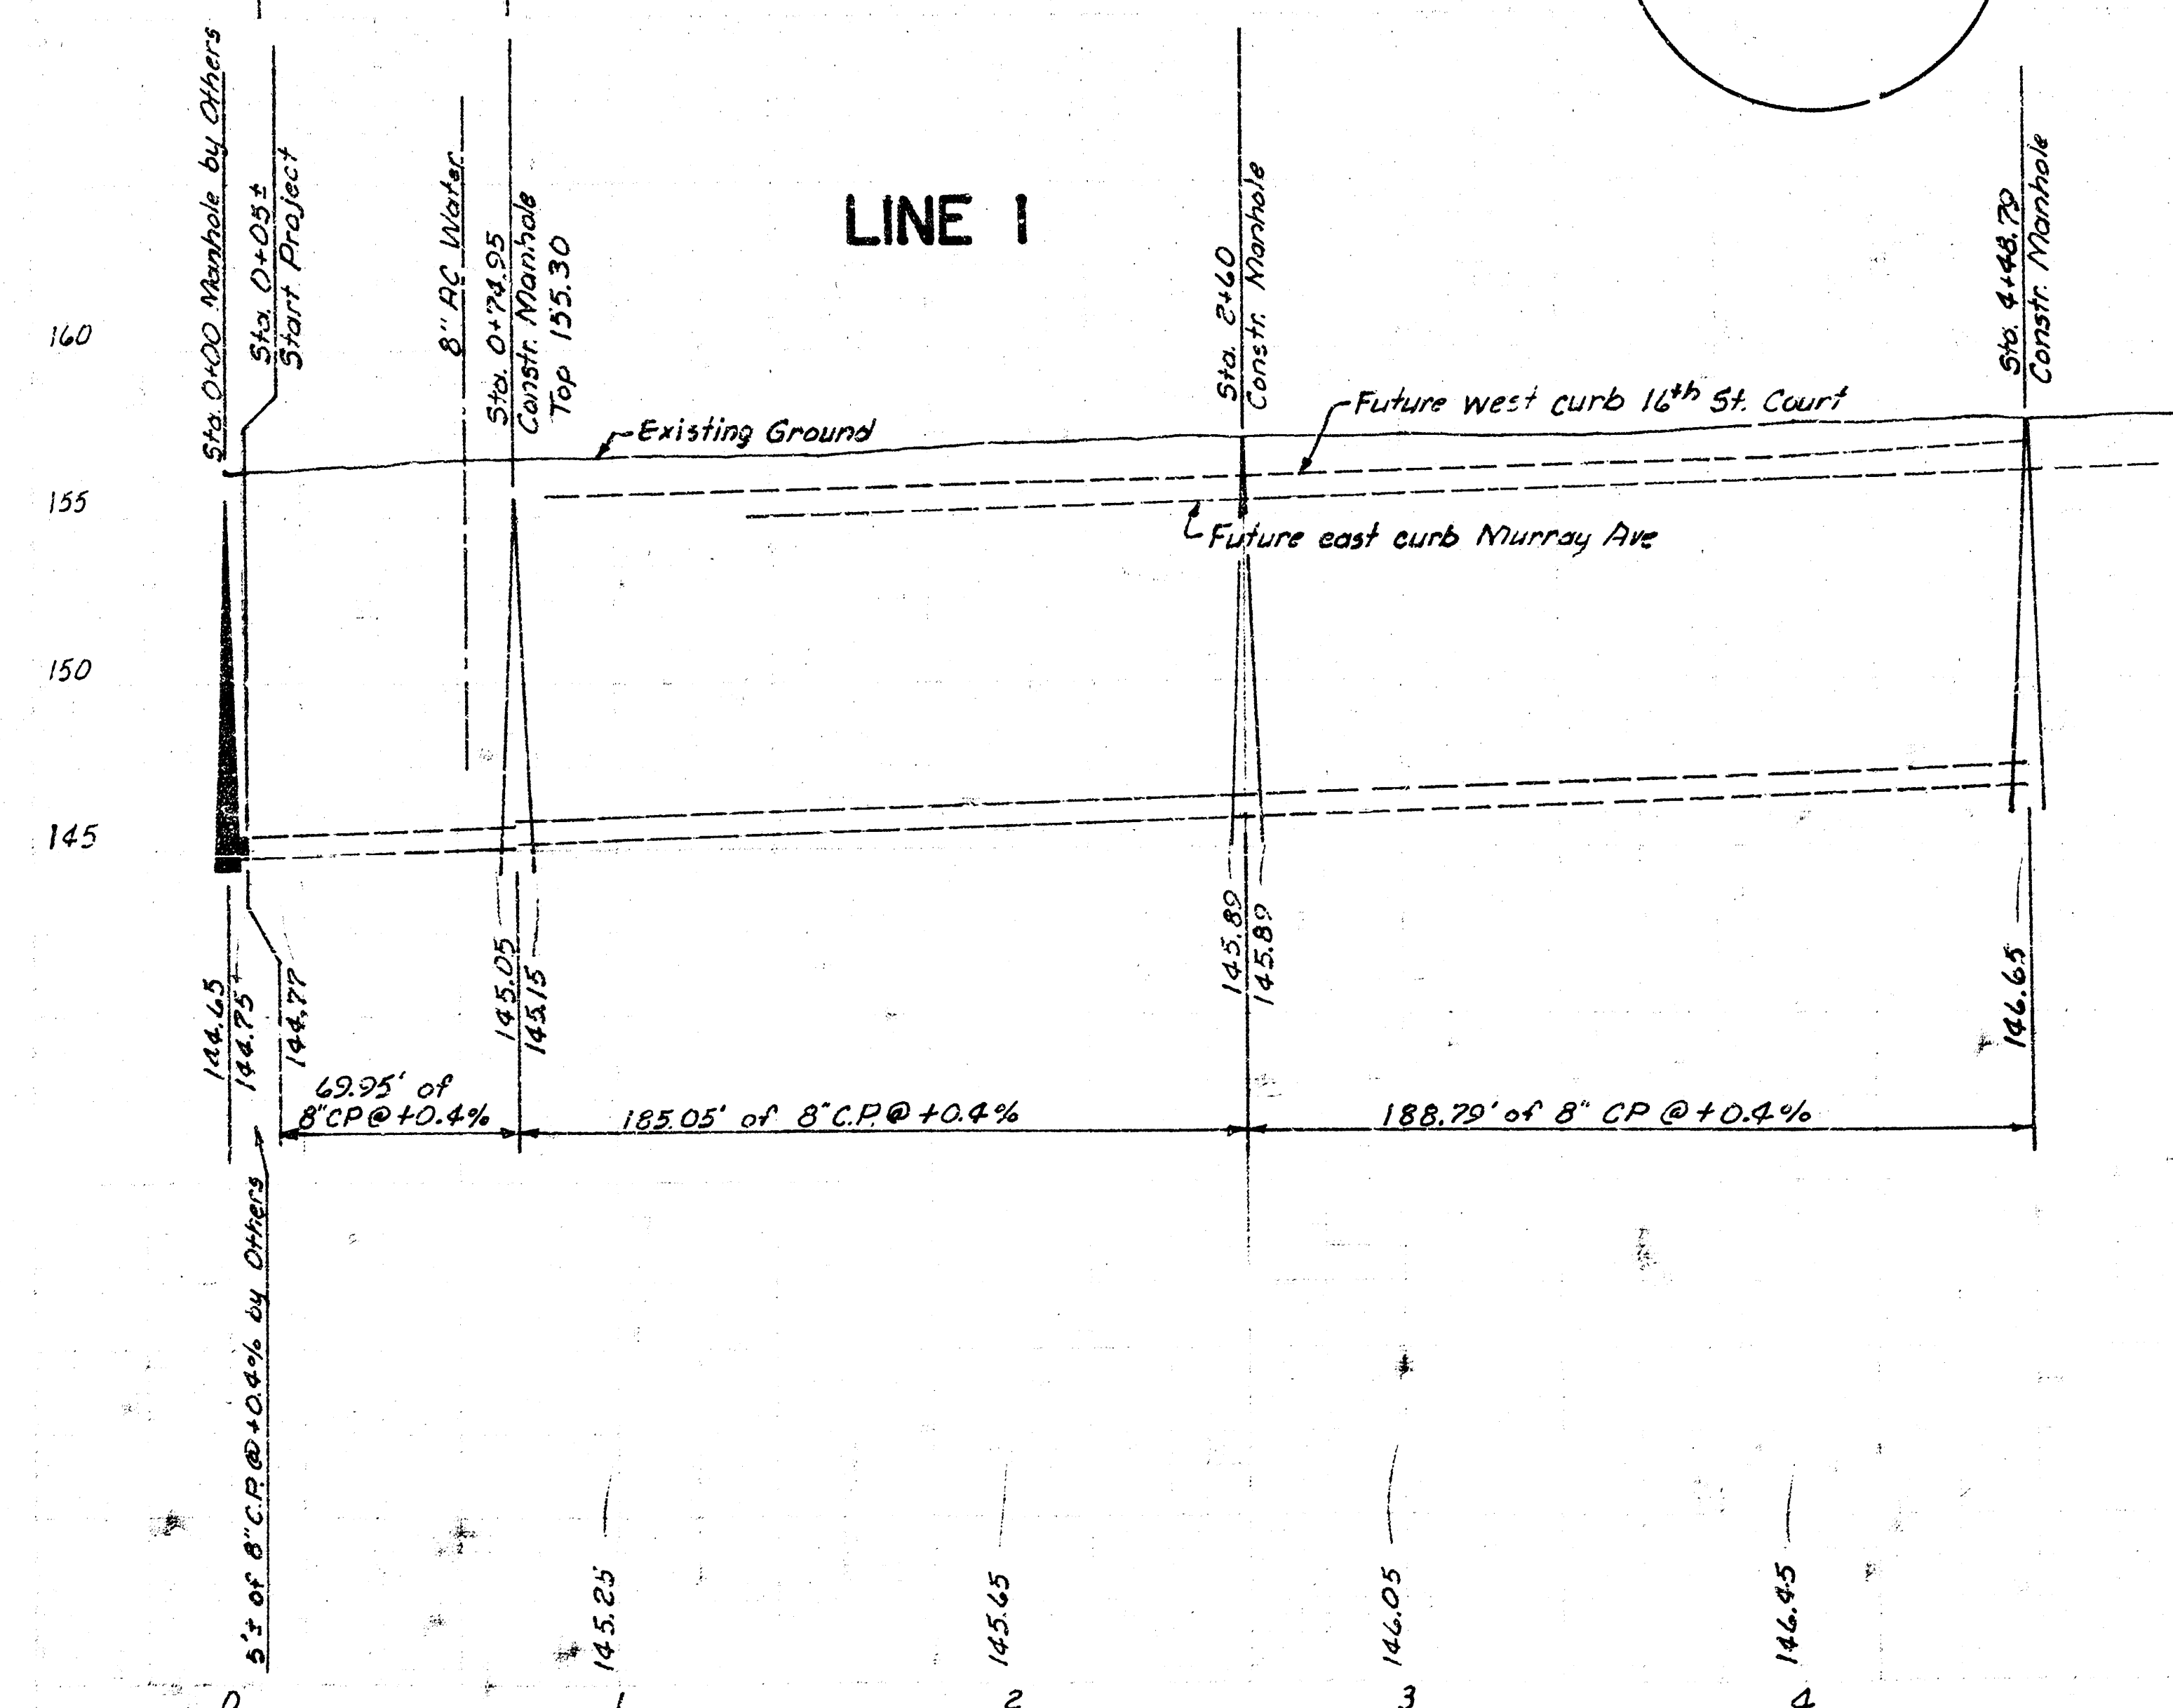

BENEFIT DISTRICT IS
BLOCK 2, WESTLINK VILLAGE TWELFTH ADDITION

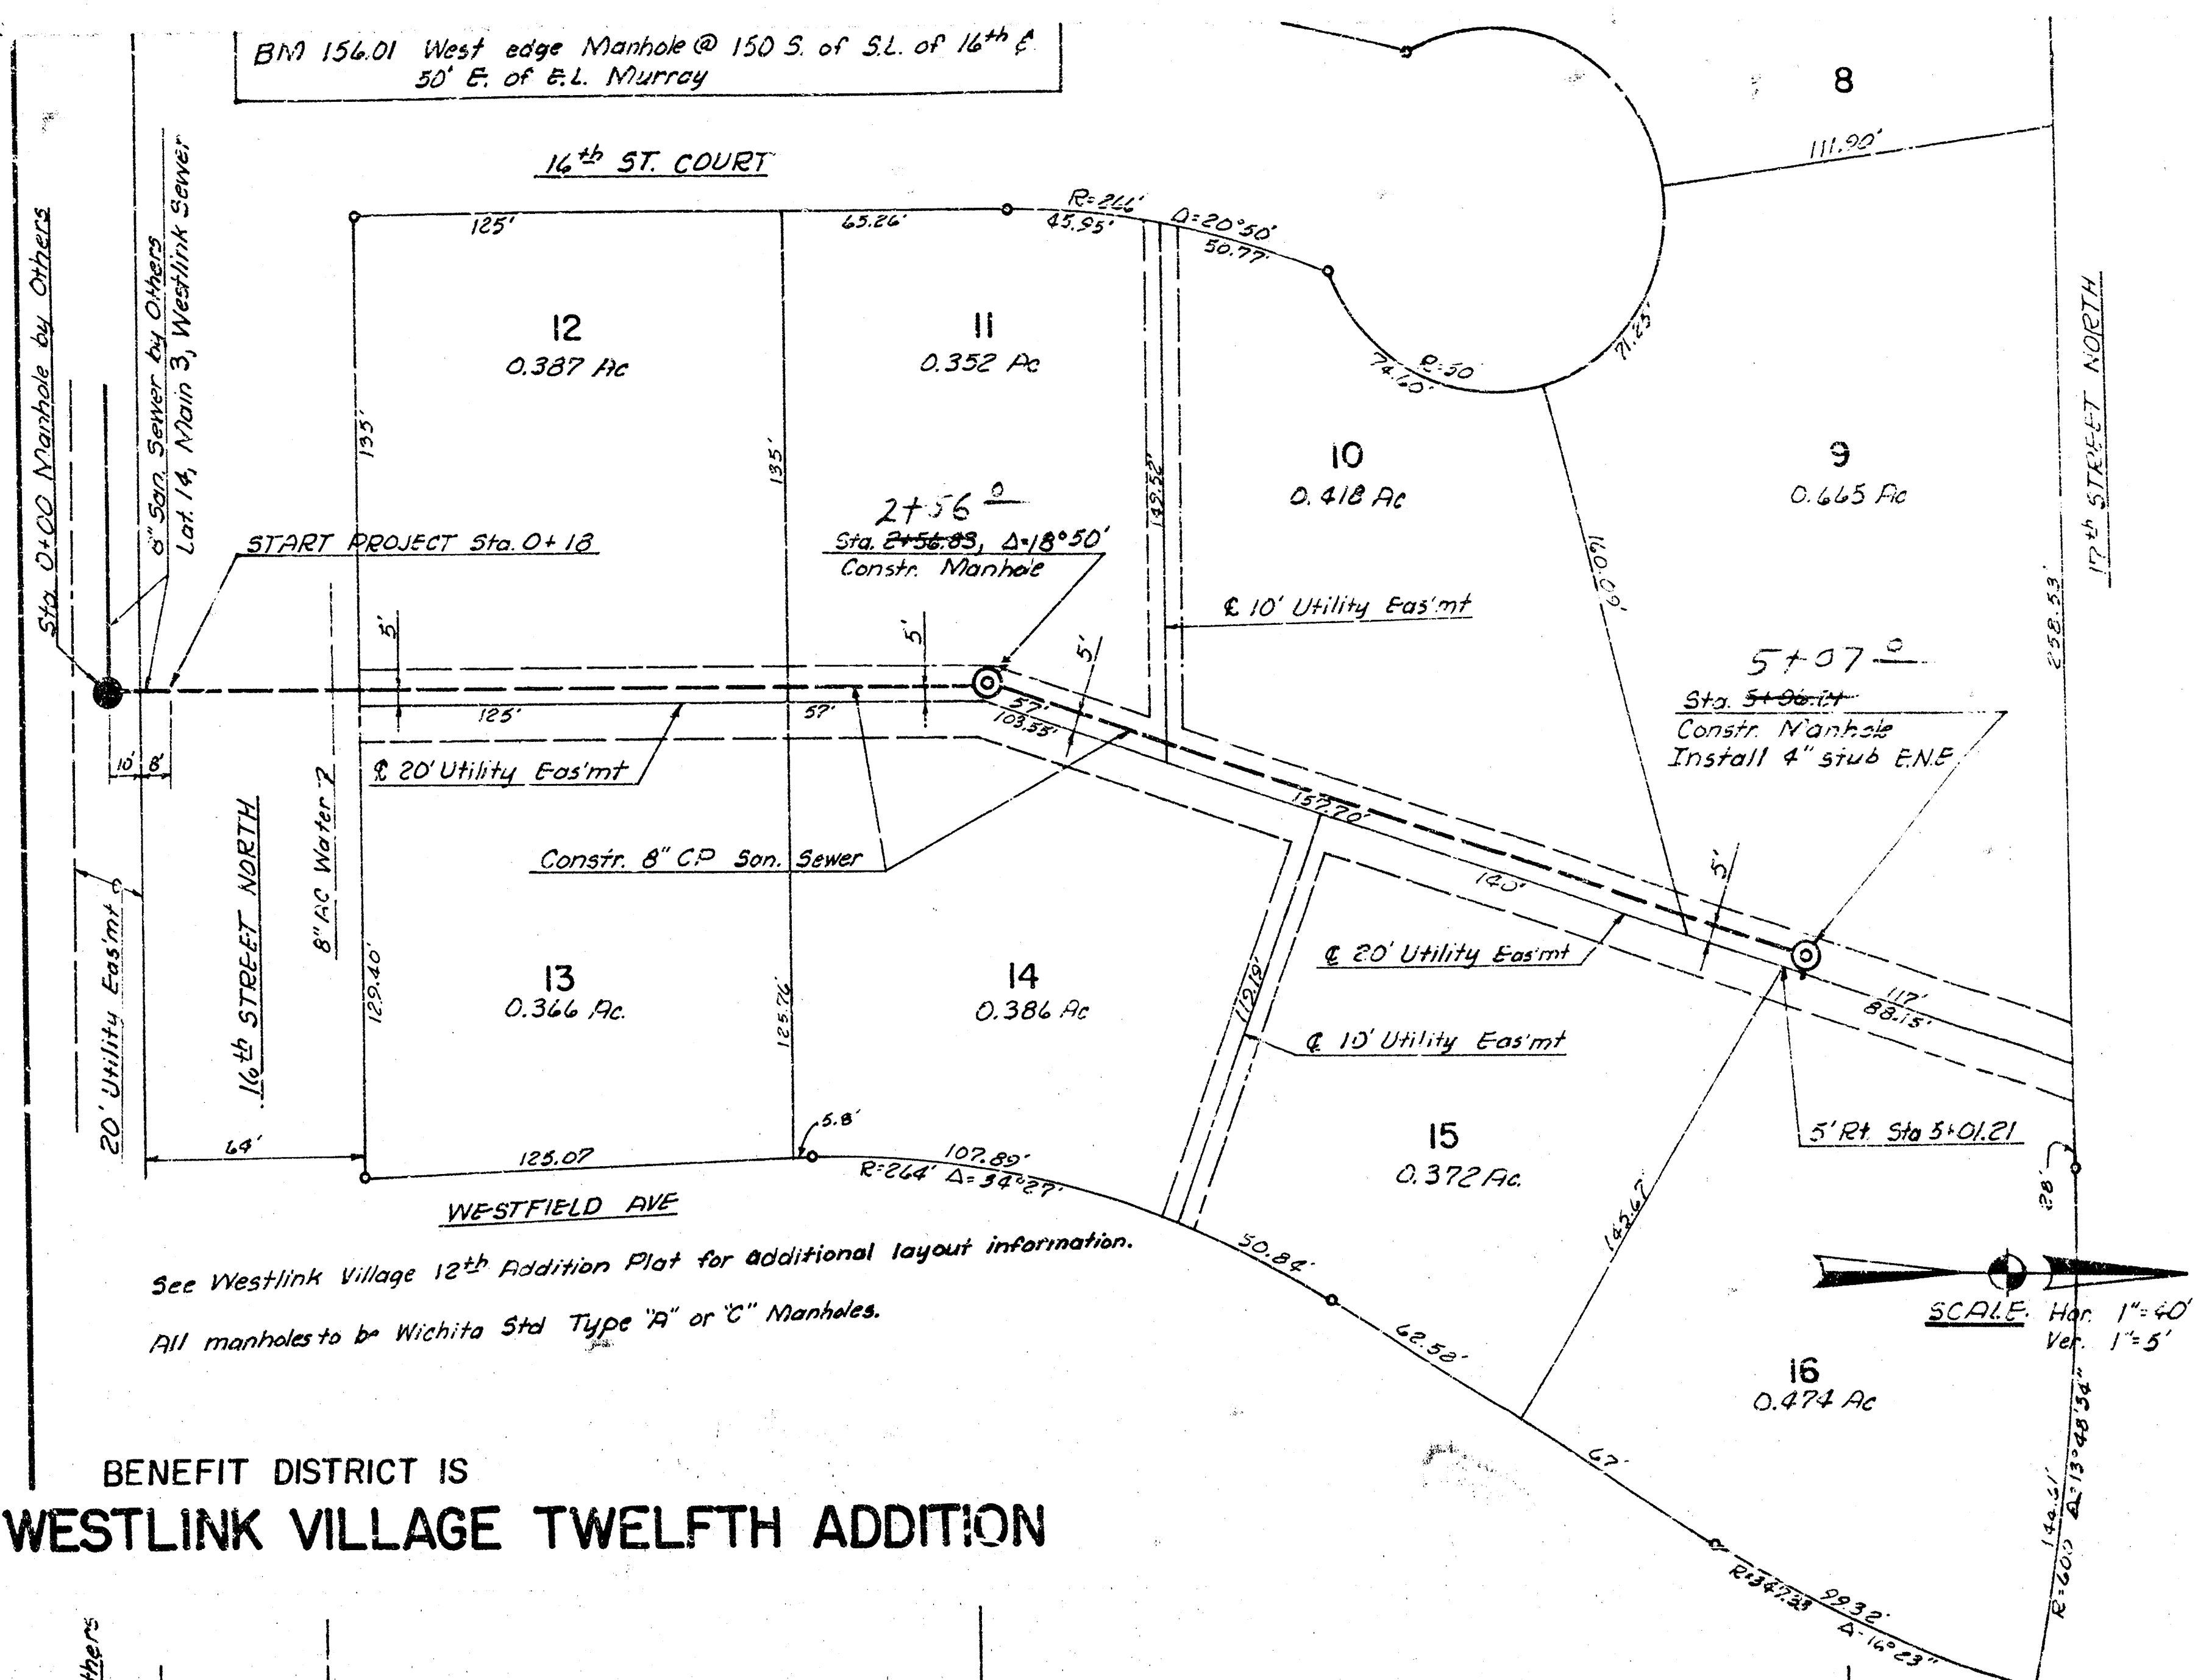

As Built 12-16-75

LAT. 15, MAIN 3, WESTLINK SEWER

CITY OF WICHITA, KANSAS
R.W. LINN, CITY ENGINEER

PROJECT NO. DBKL 575040

DATE 8 SHEET 1 OF 1