

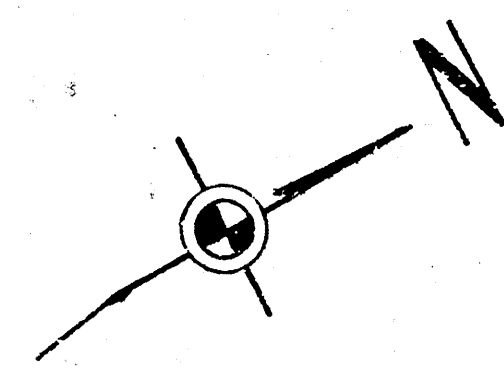
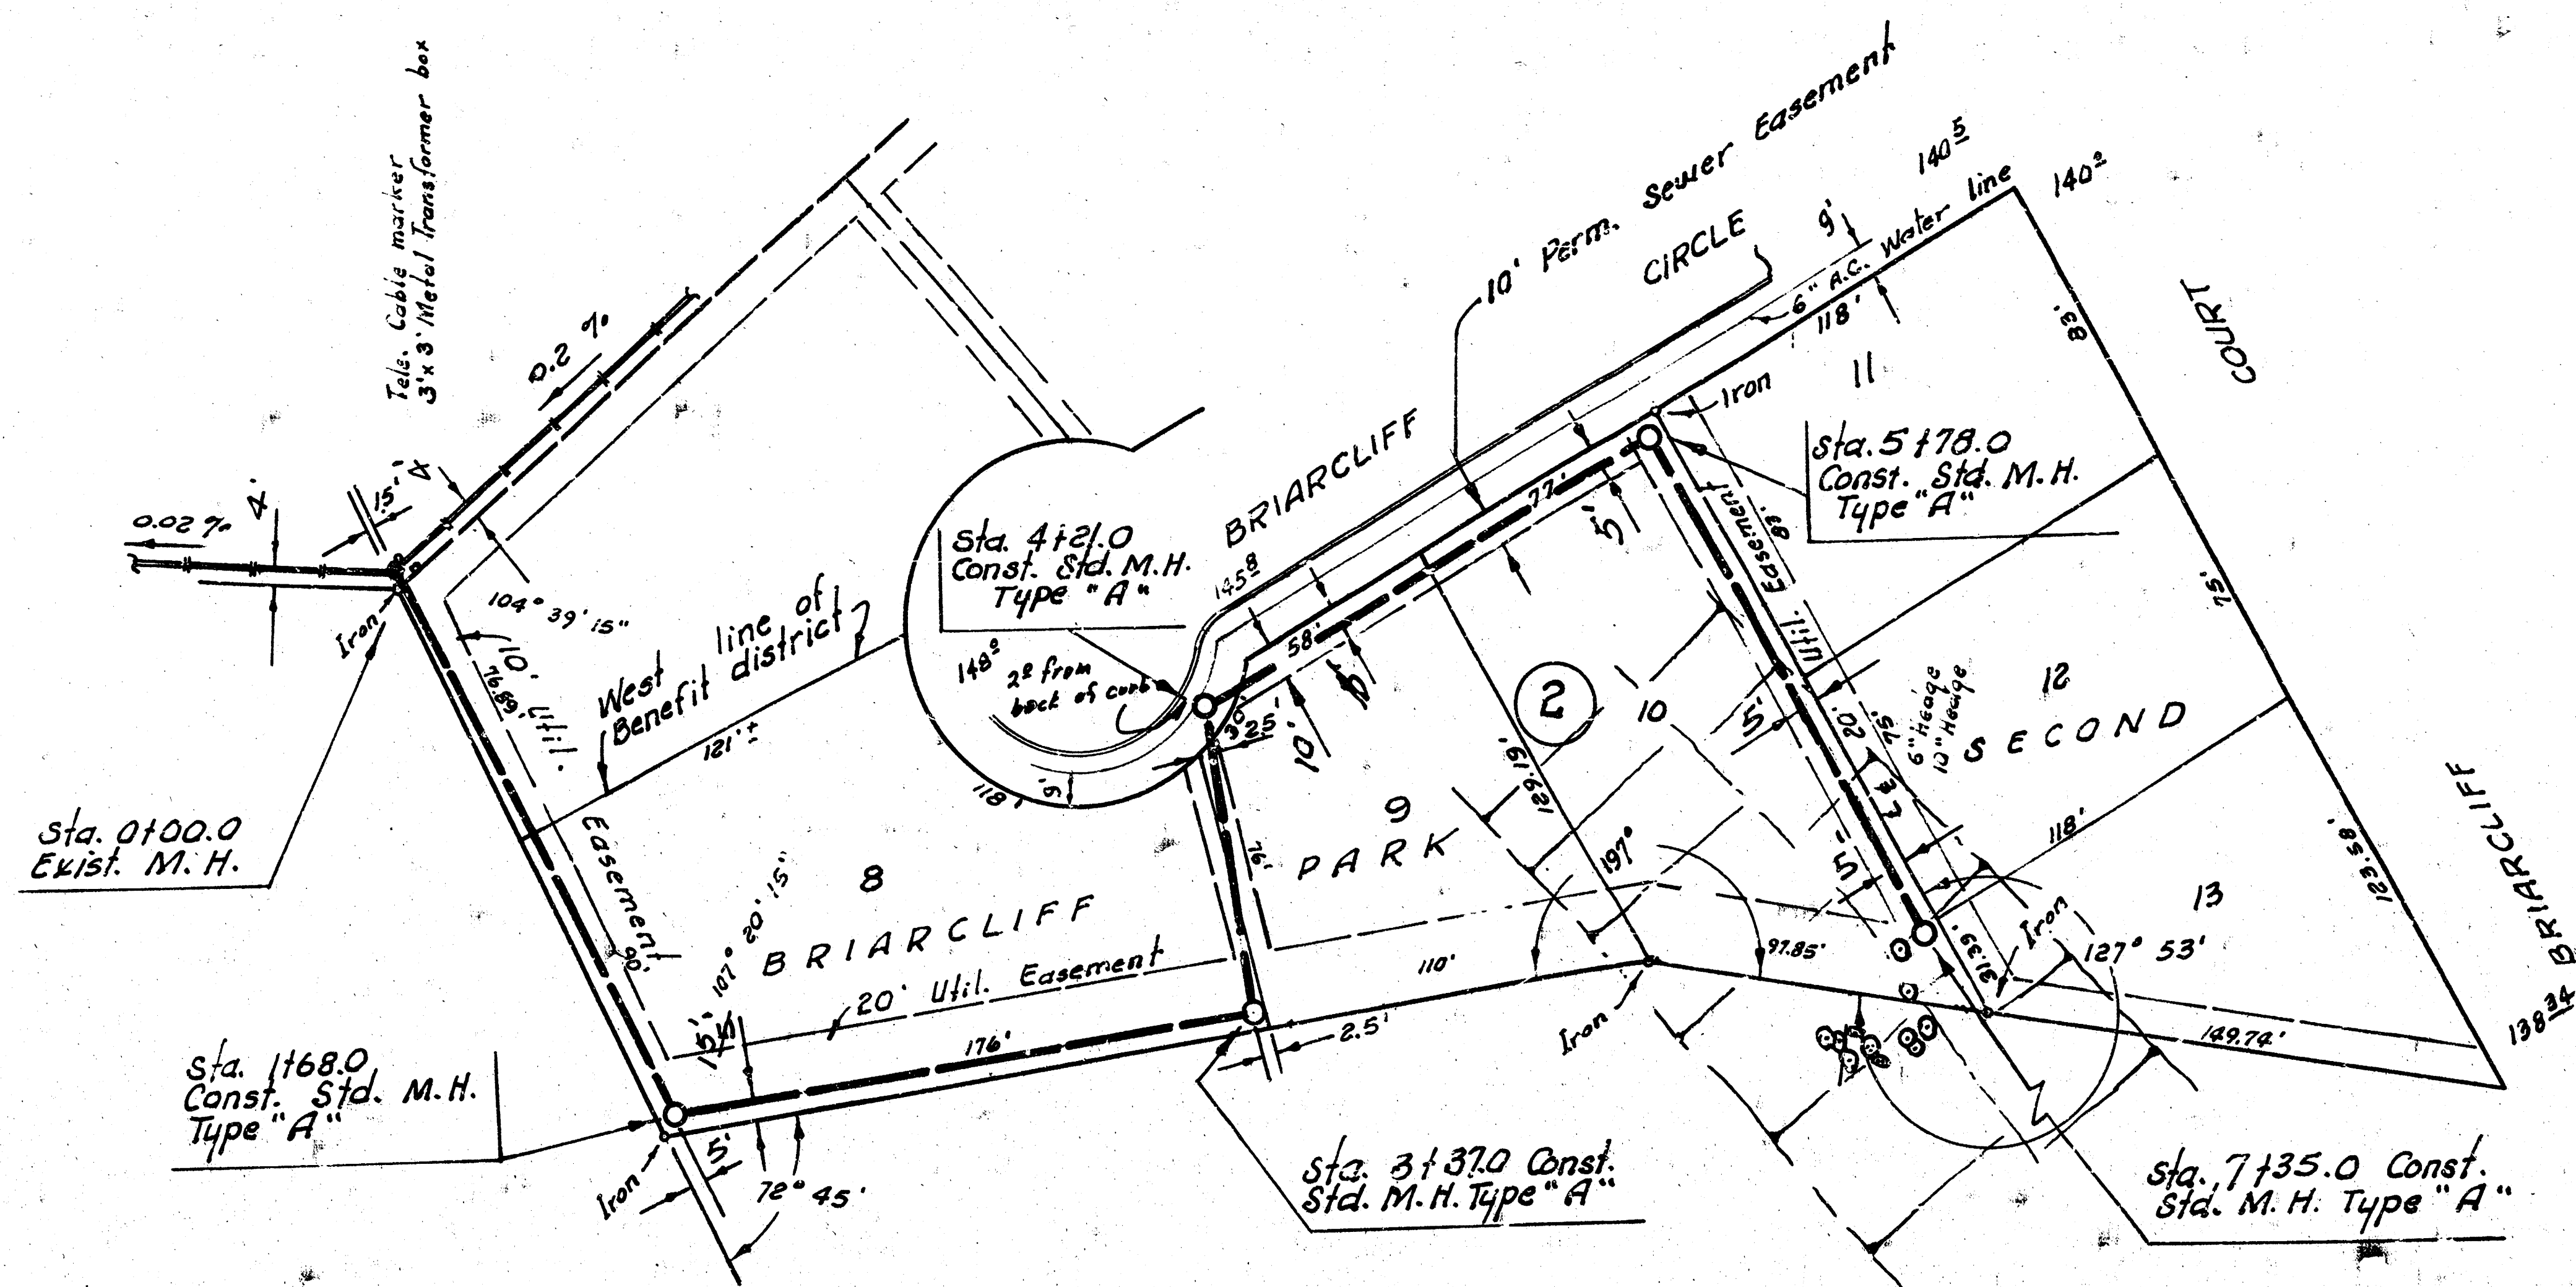


B. M. #1 145.79 "R" in Ritchie St. end Rad.
S. E. cor. Zimmerly and Briarcliff Circle.
B. M. #2 148.85 E. Rim M.H. Sta 0+00

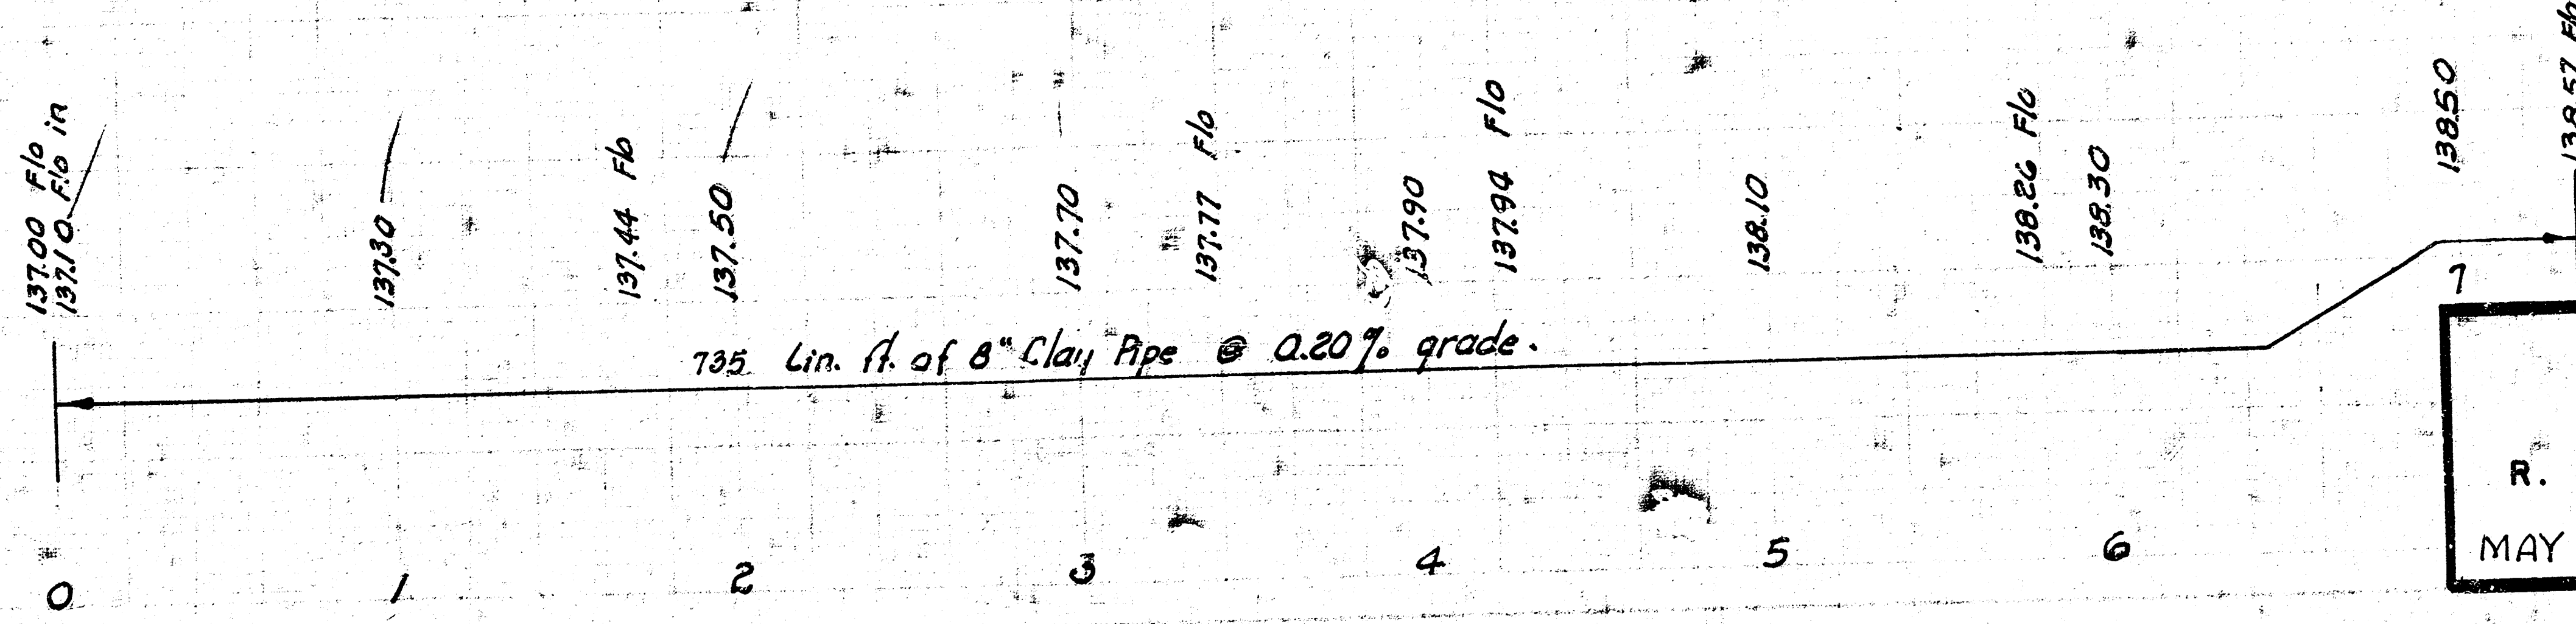

Plan Scale 1" = 40' Horiz.
Profile Scale 1" = 5' Vert.

NOTE:
San. Sewer pipe must have a minimum of 30" cover.

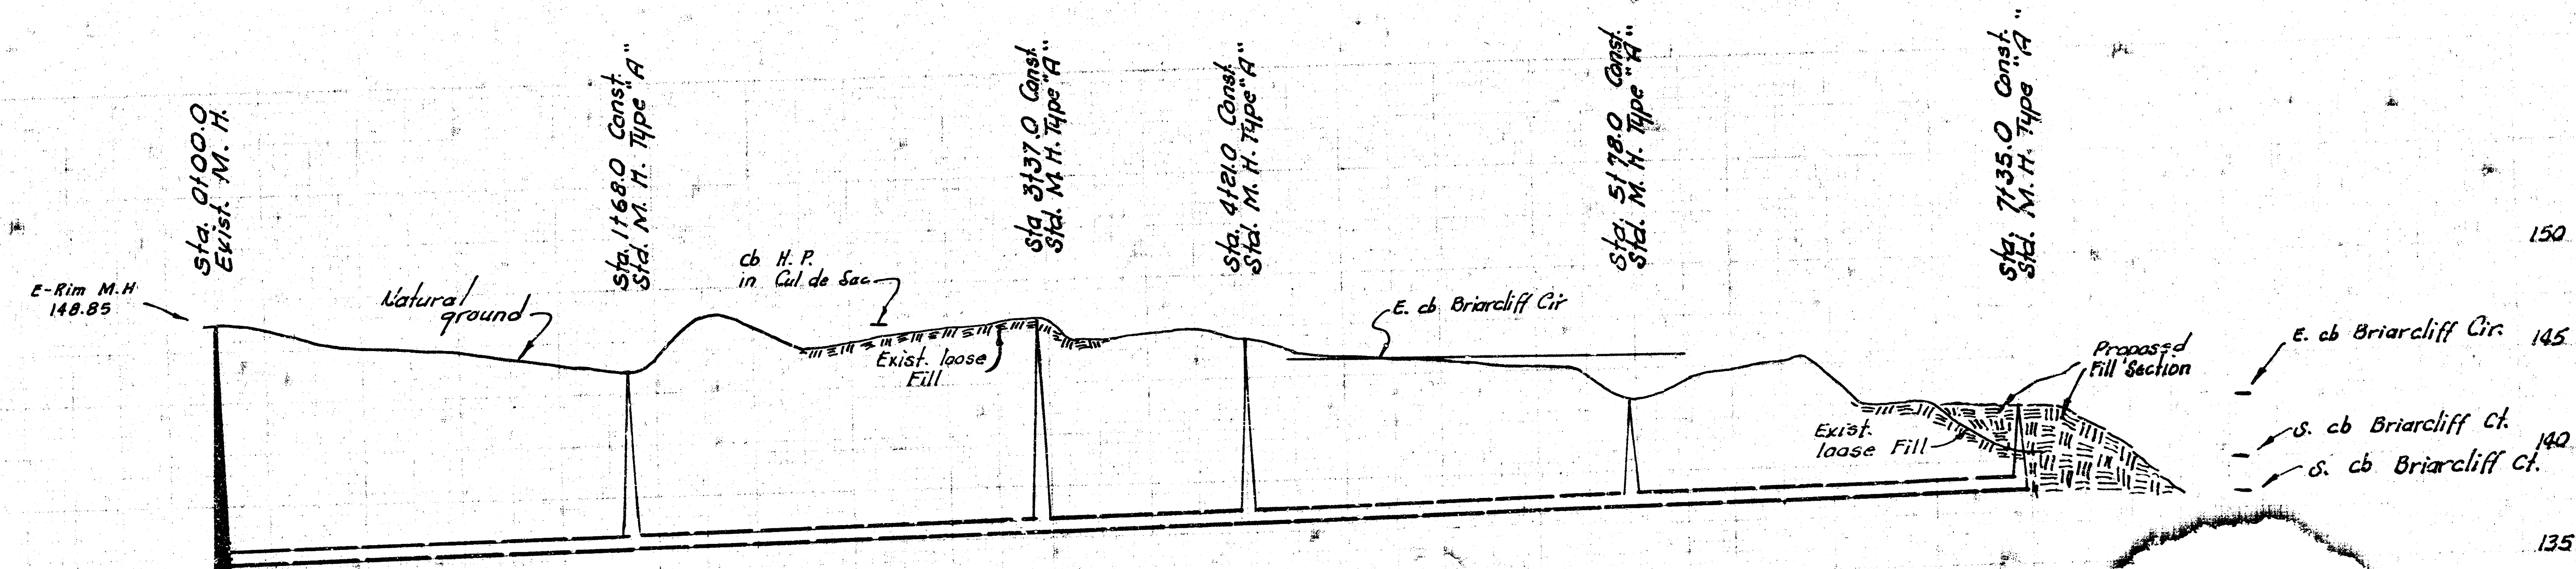

Revised May 6, 1974
As Built final Meas. G-2

LAT. 53, W. I. S.
CITY OF WICHITA, KANSAS
R. W. LINN — CITY ENGINEER
MAY 1974 PROJECT NO. DBKL572061

