



B. M. 148.10 City Std. @ Ridge Rd.
 4' 13th St.
 B. M. 153.12 R.R. Spike W. side P. Pole
 2' E. of S. cb. Holland approx.
 25' N. of N. Line 13th St.

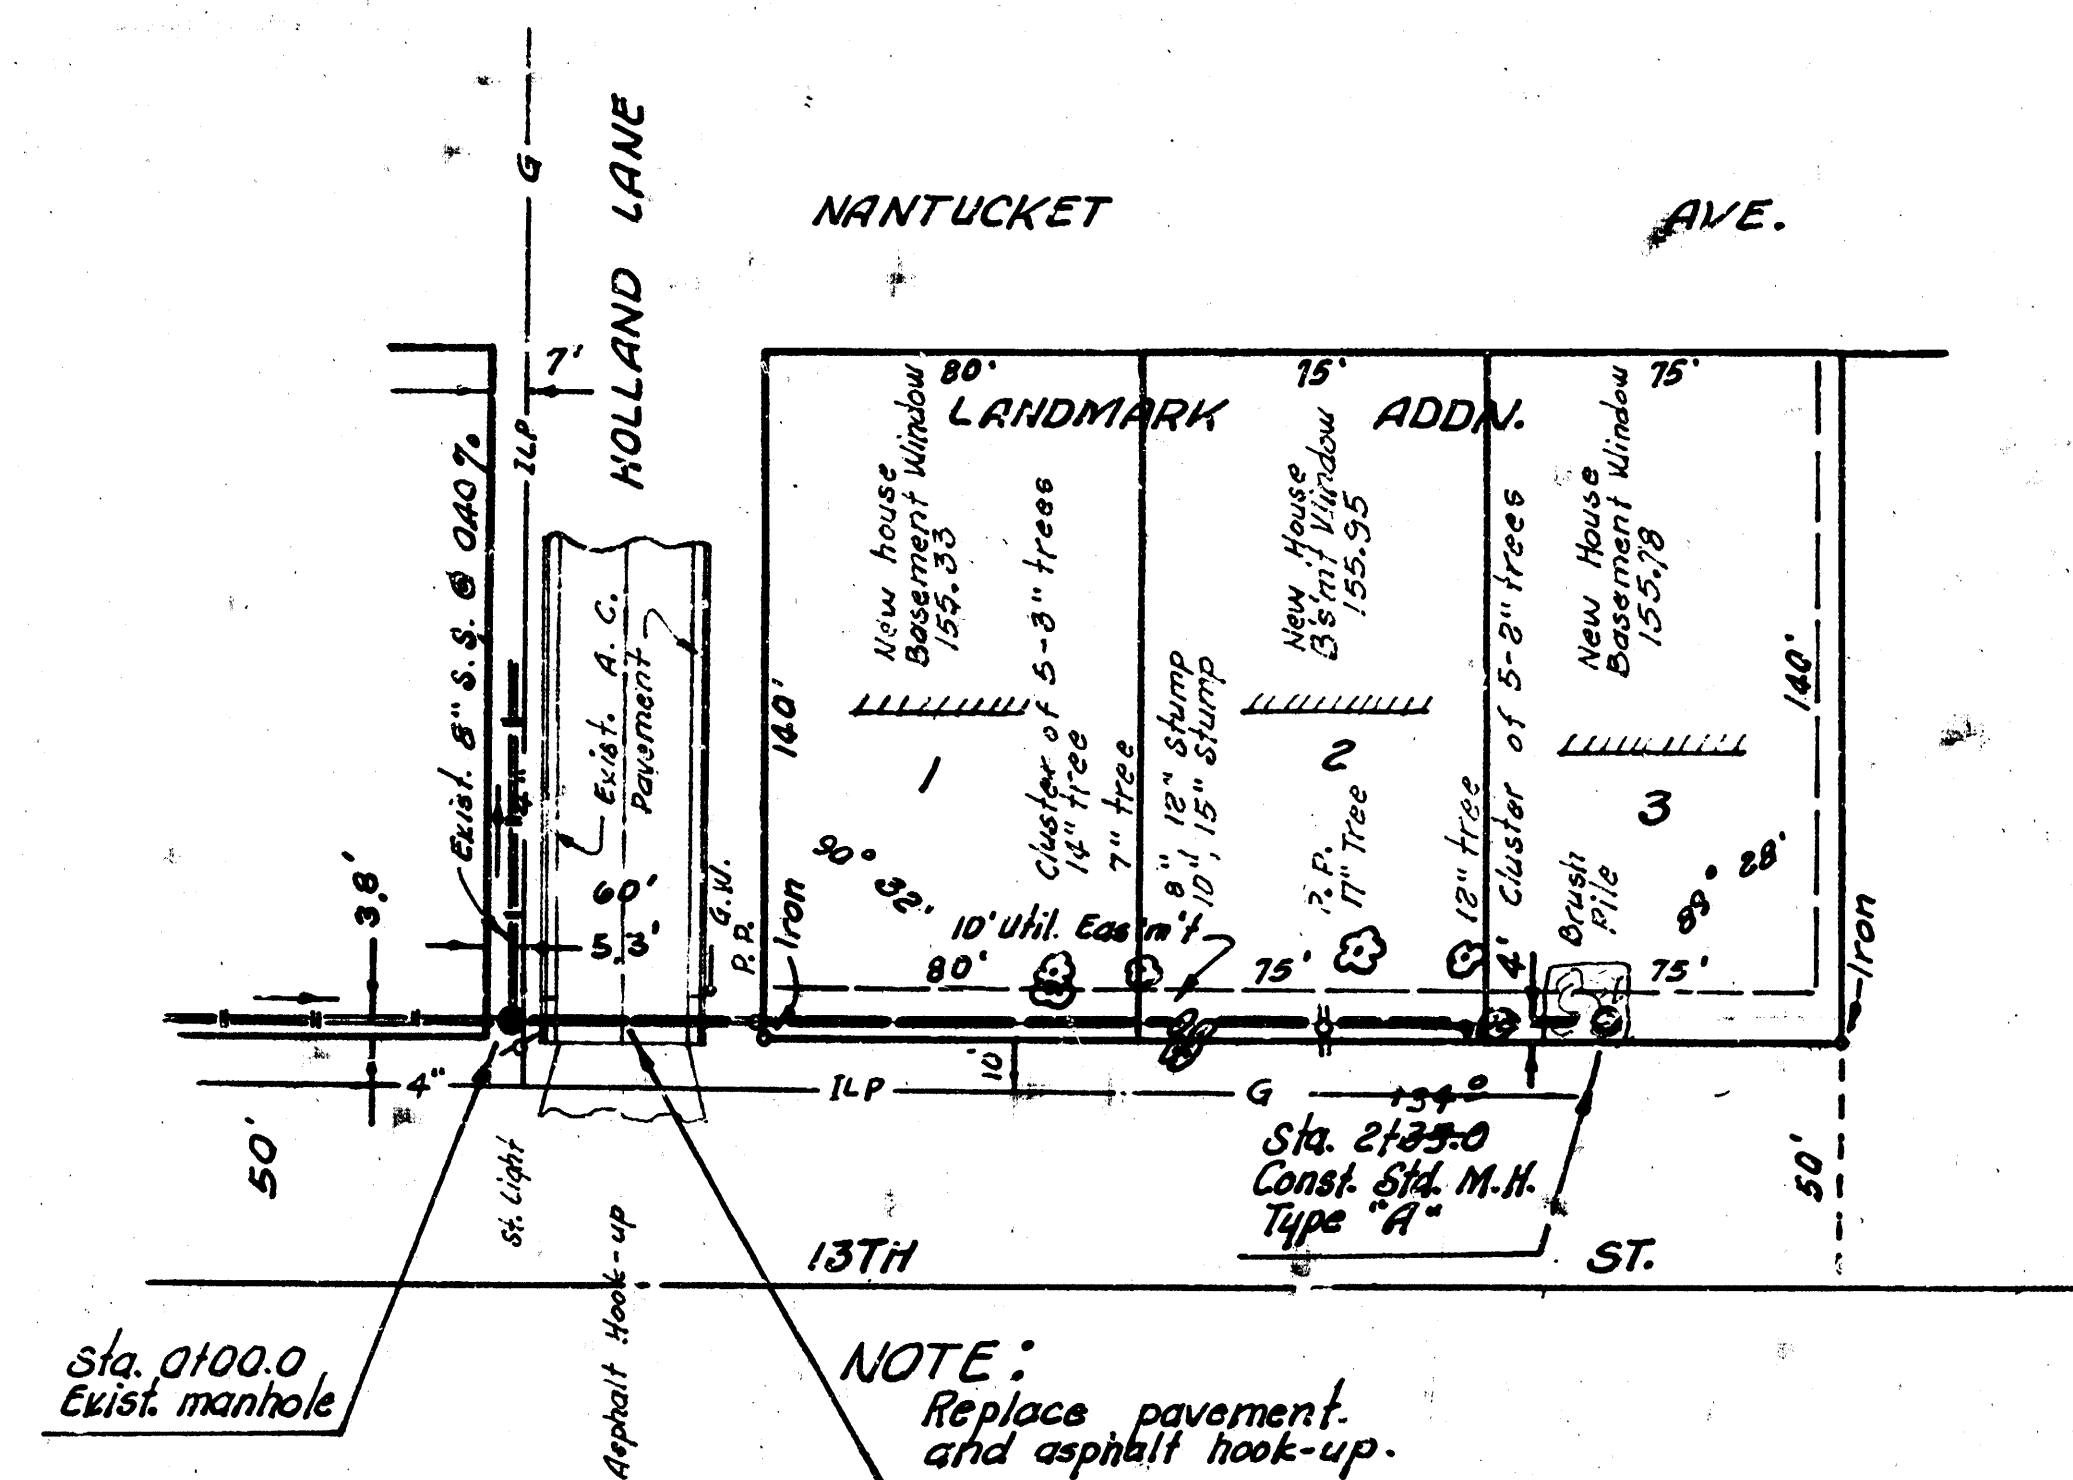

Plan Scale 1" = 40' Horiz.
 Profile Scale 1" = 5' Vert.

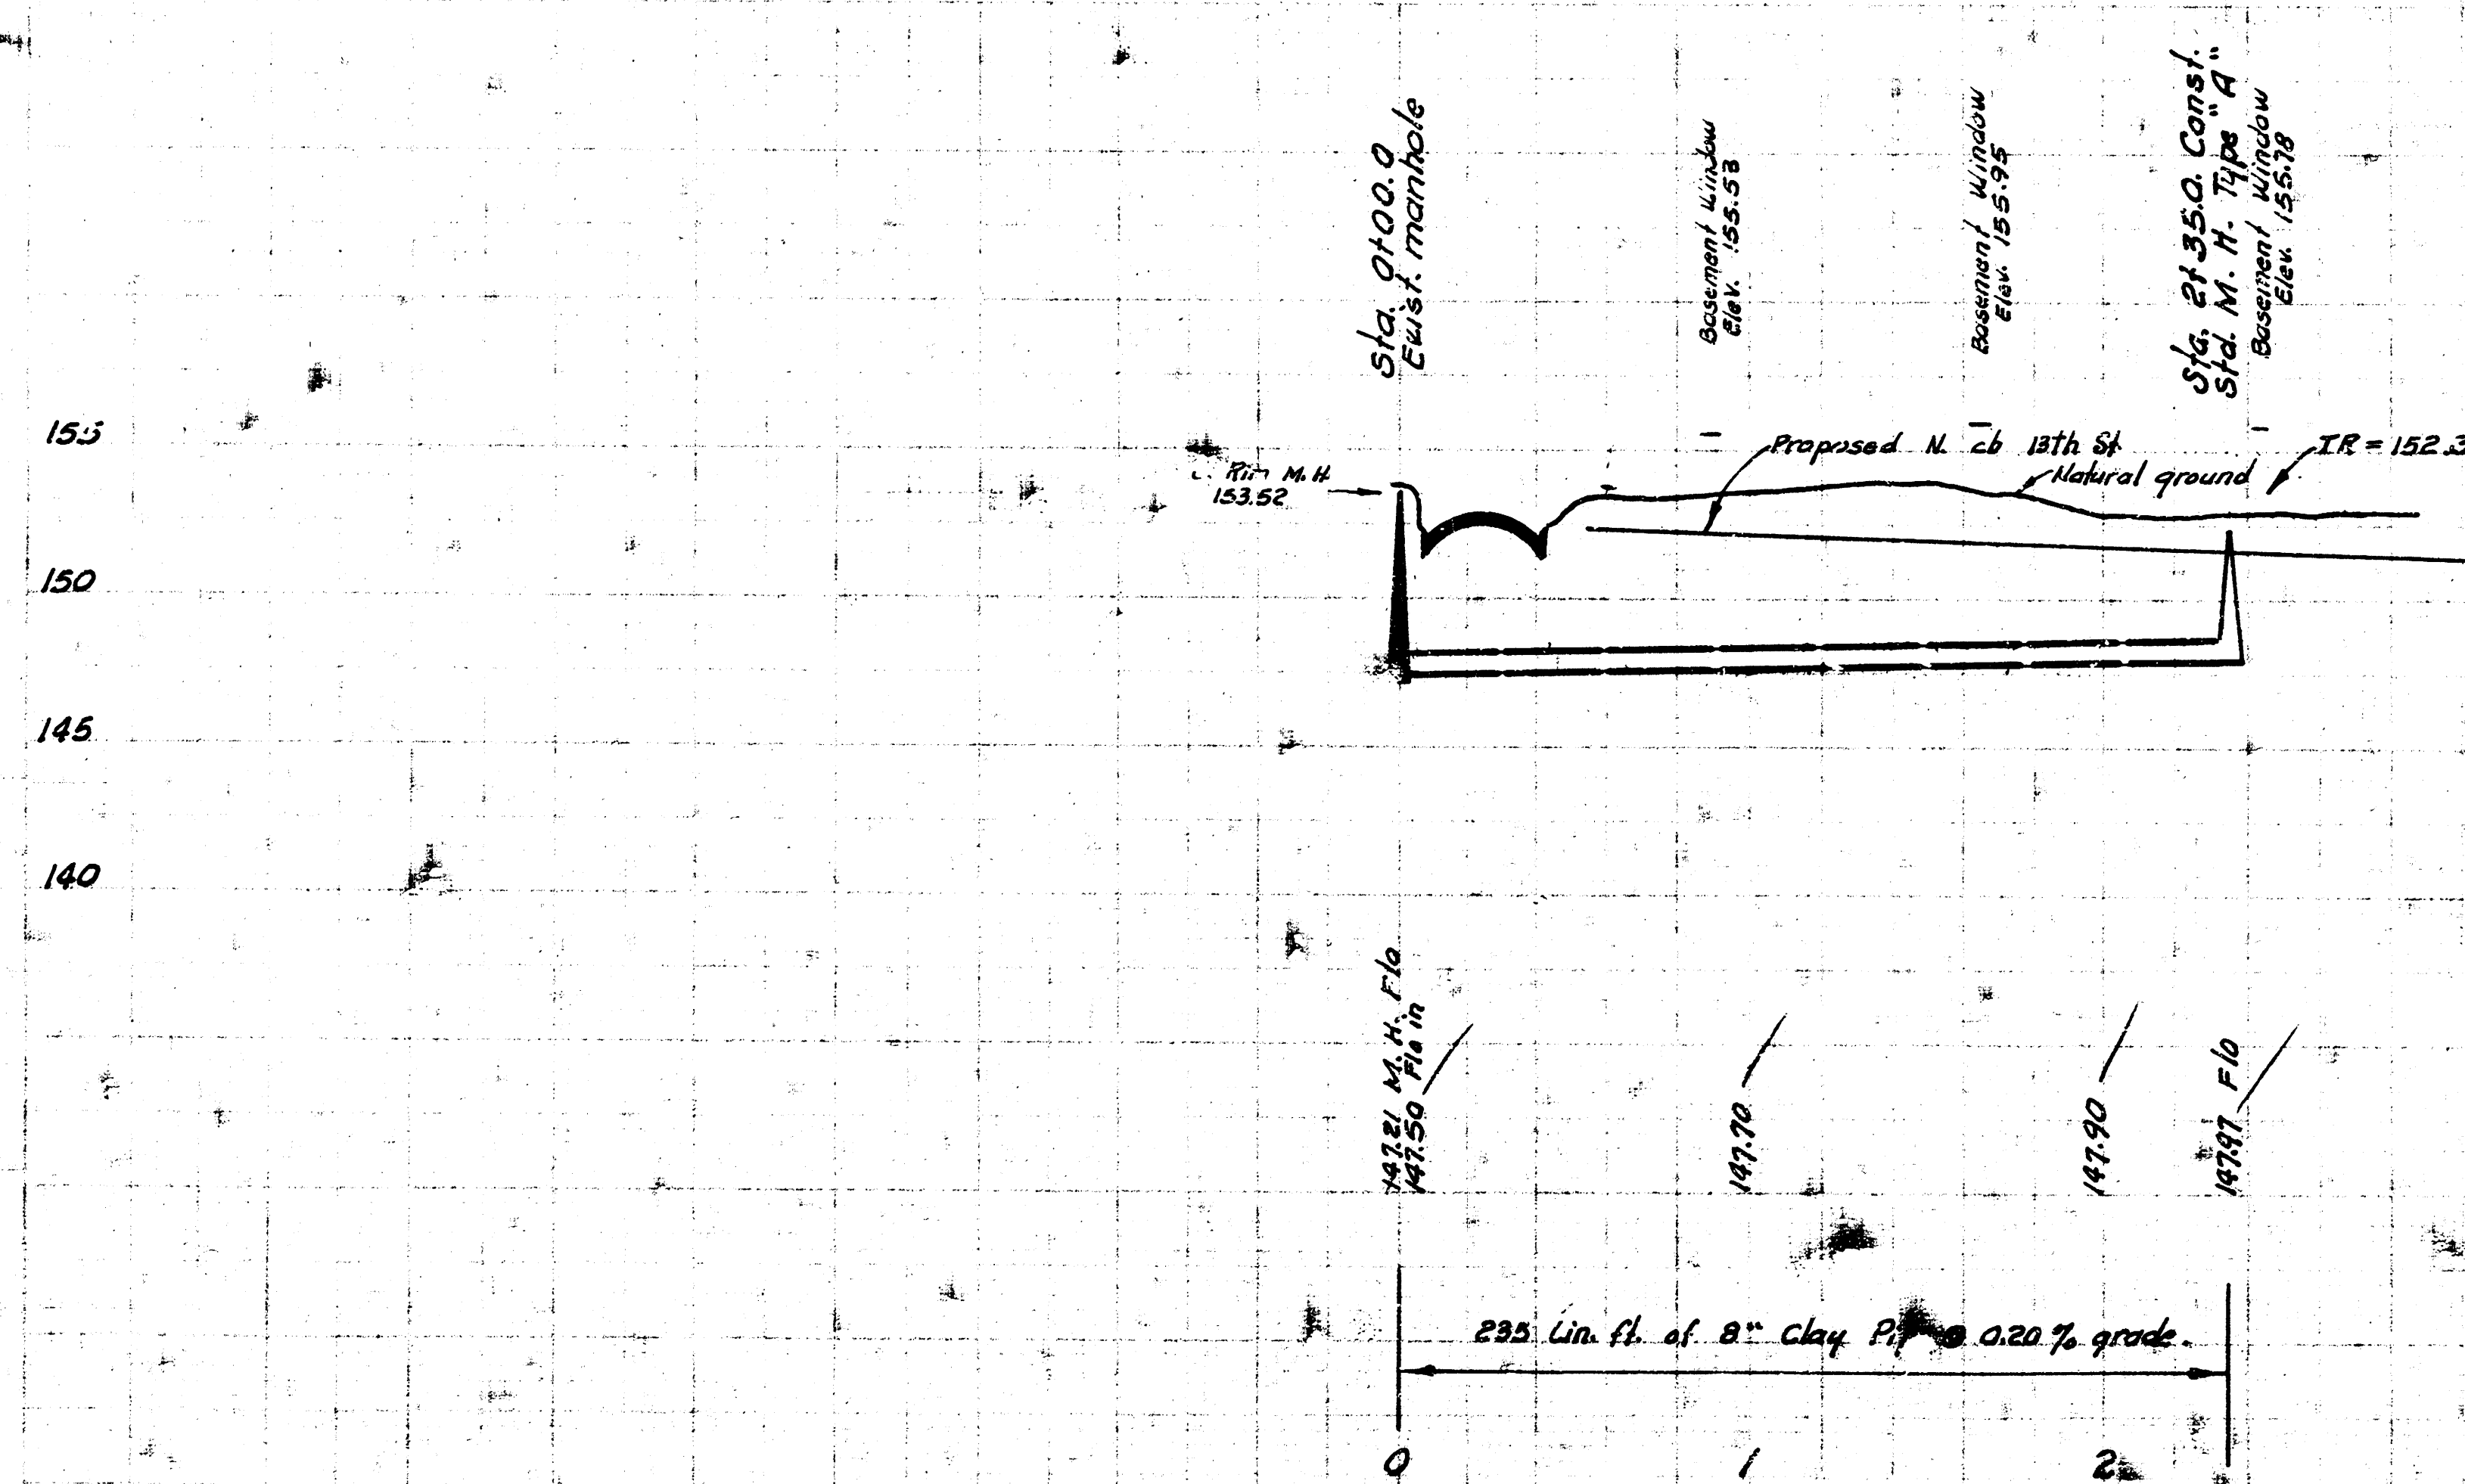

As Built Final Meas. K-105

LAT. 57, WESTLINK SEWER
 CIT OF WICHITA, KANSAS
 R. W. LINN CITY ENGINEER
 DEC. 1973 PROJECT NO. DBKL573006