
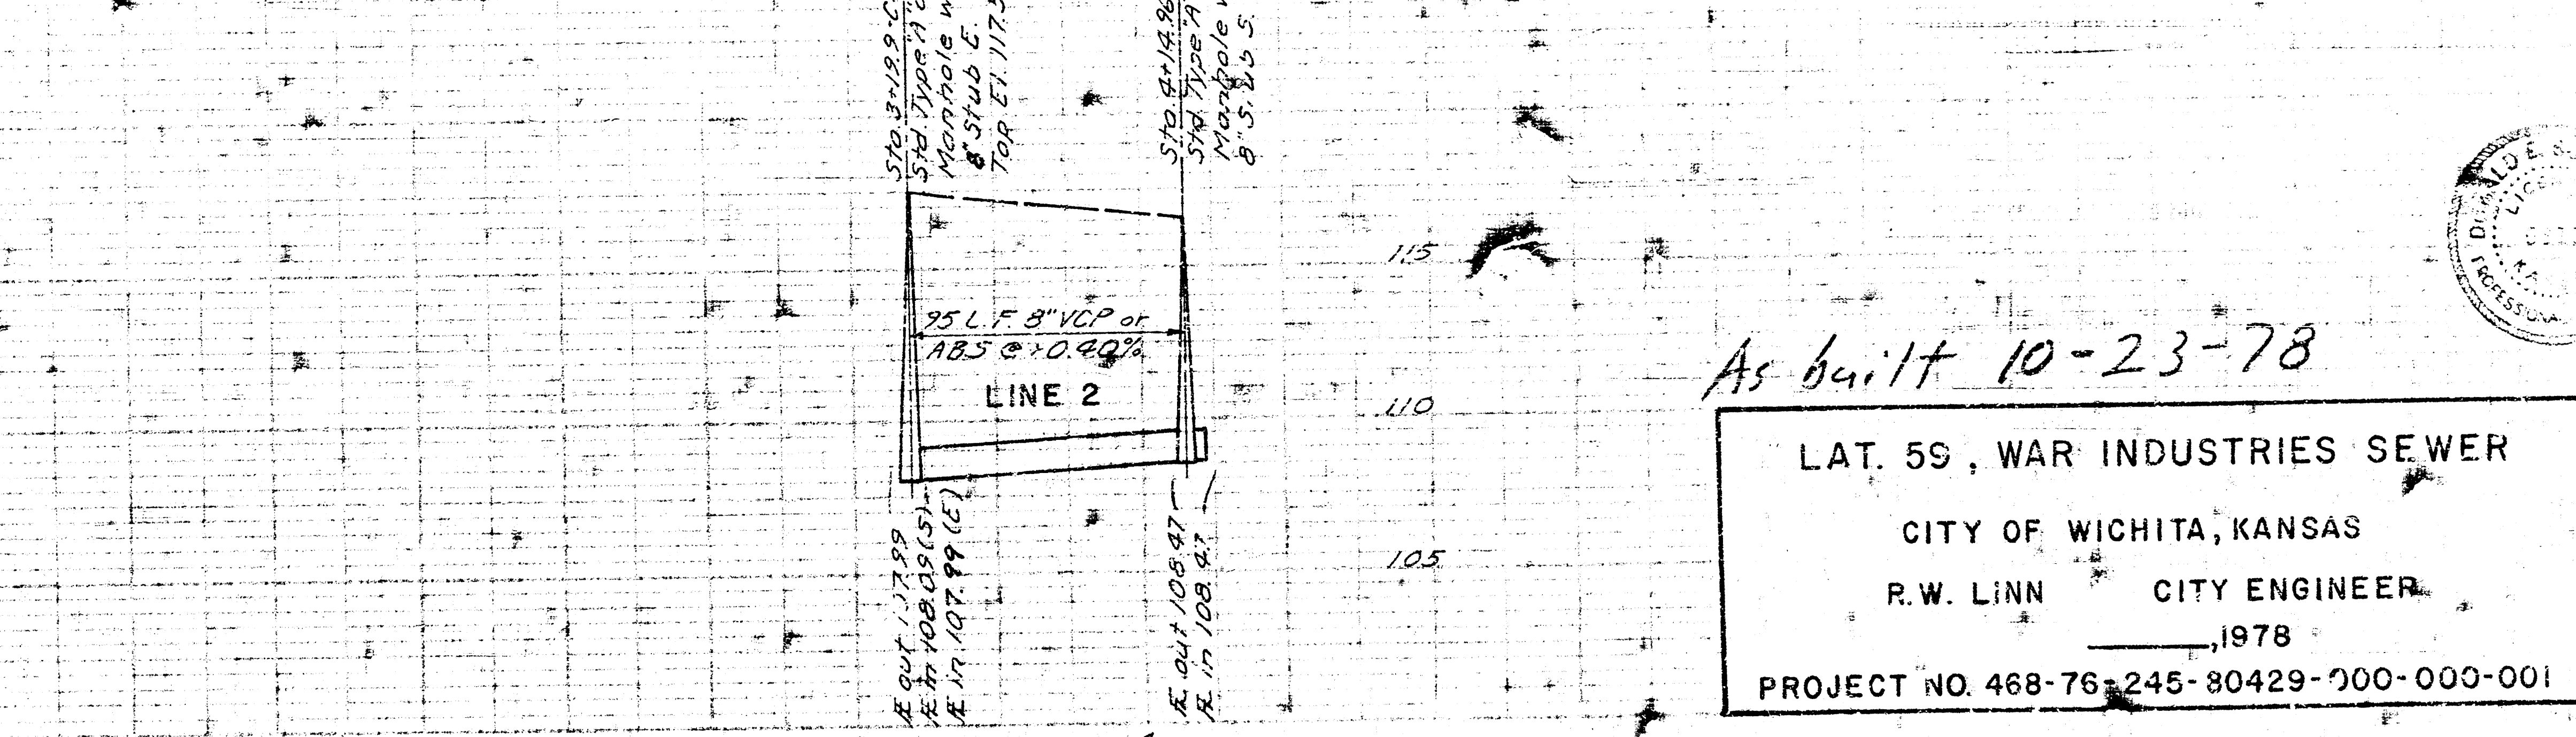
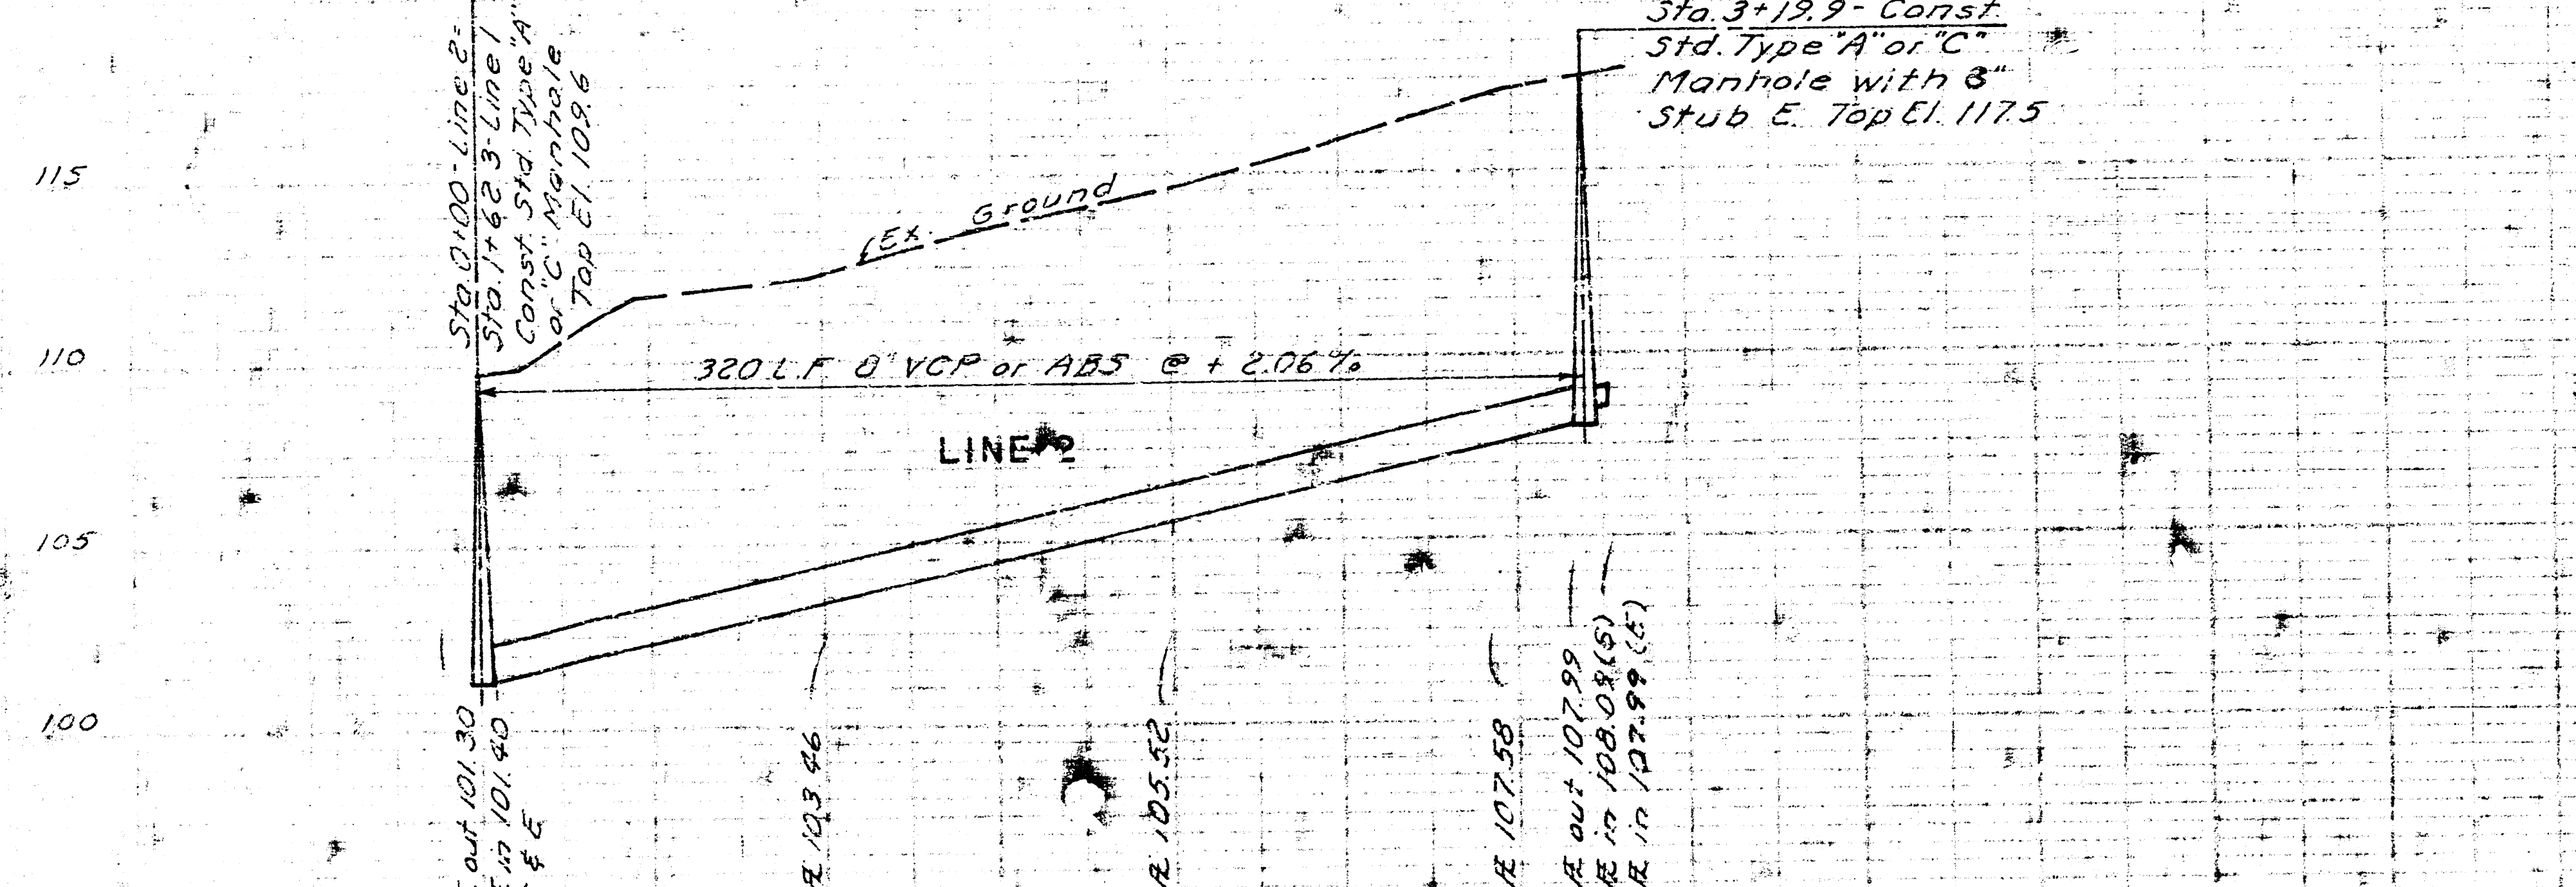
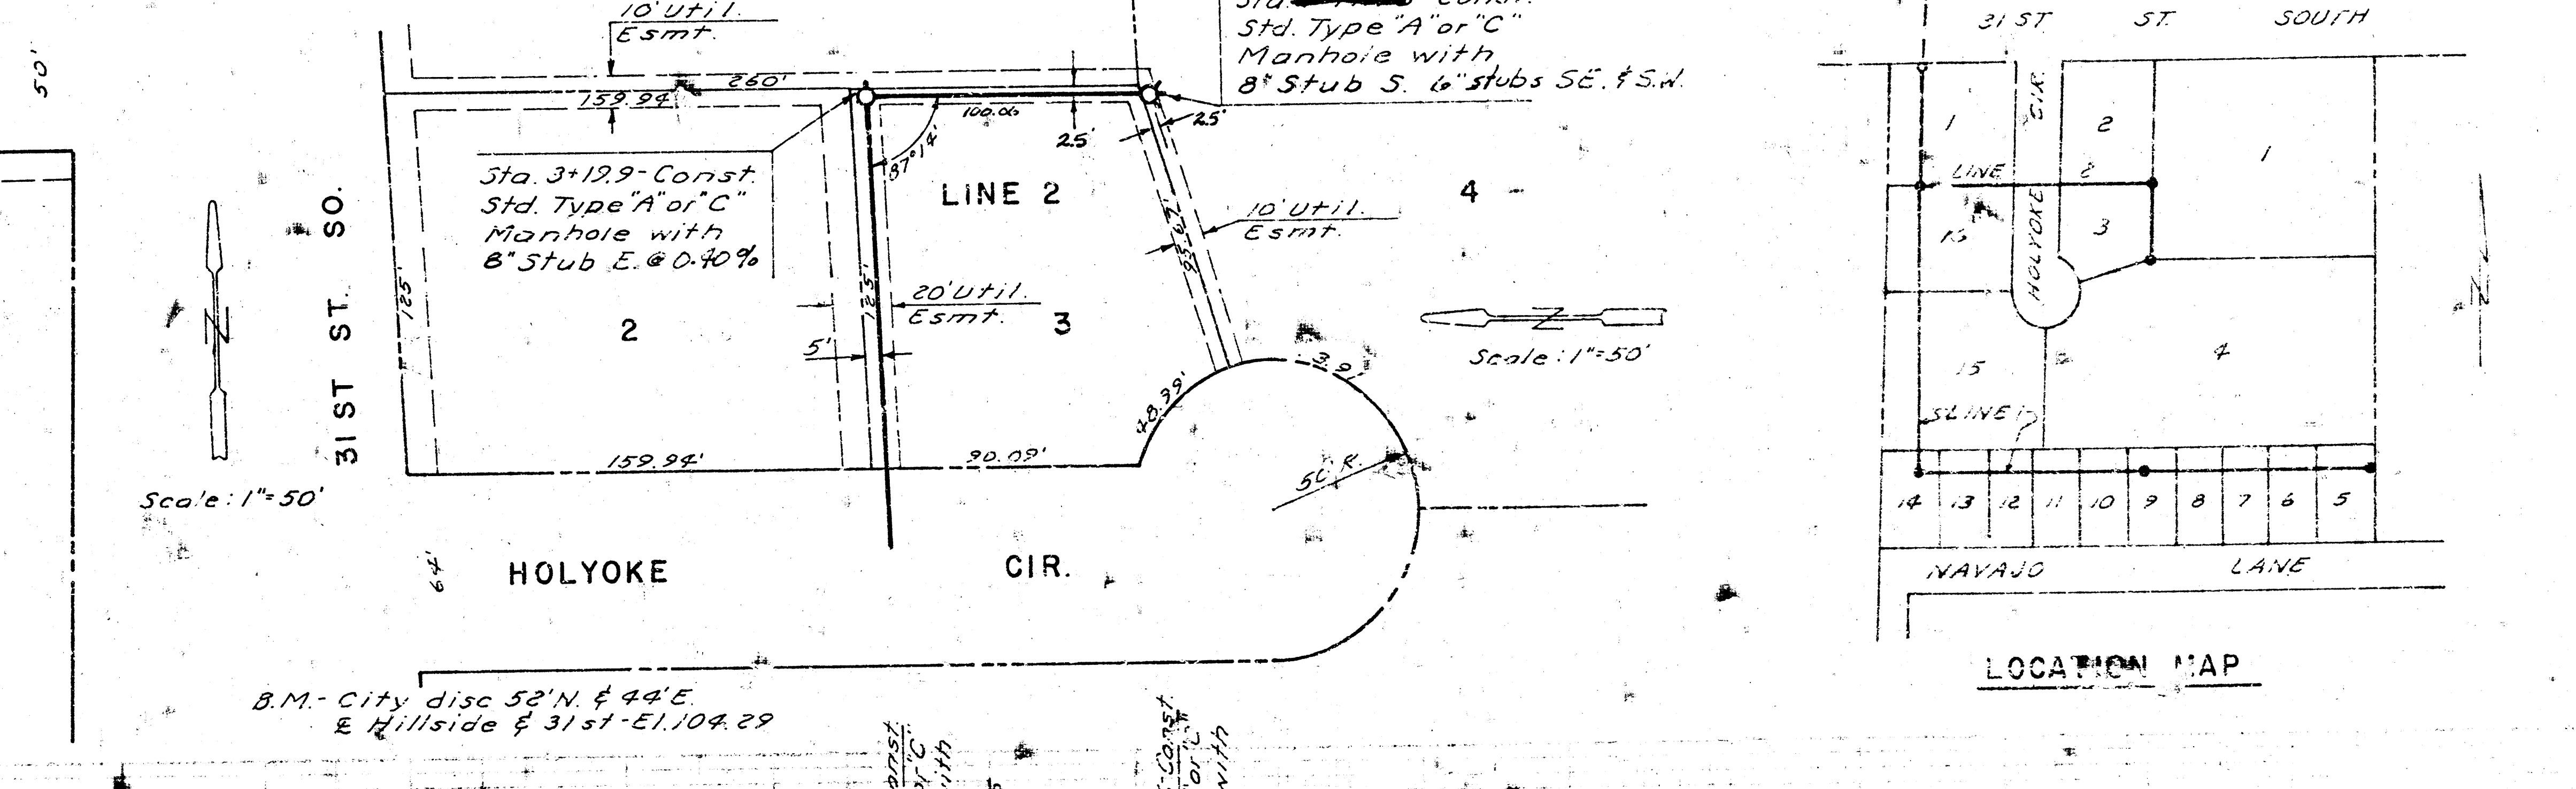
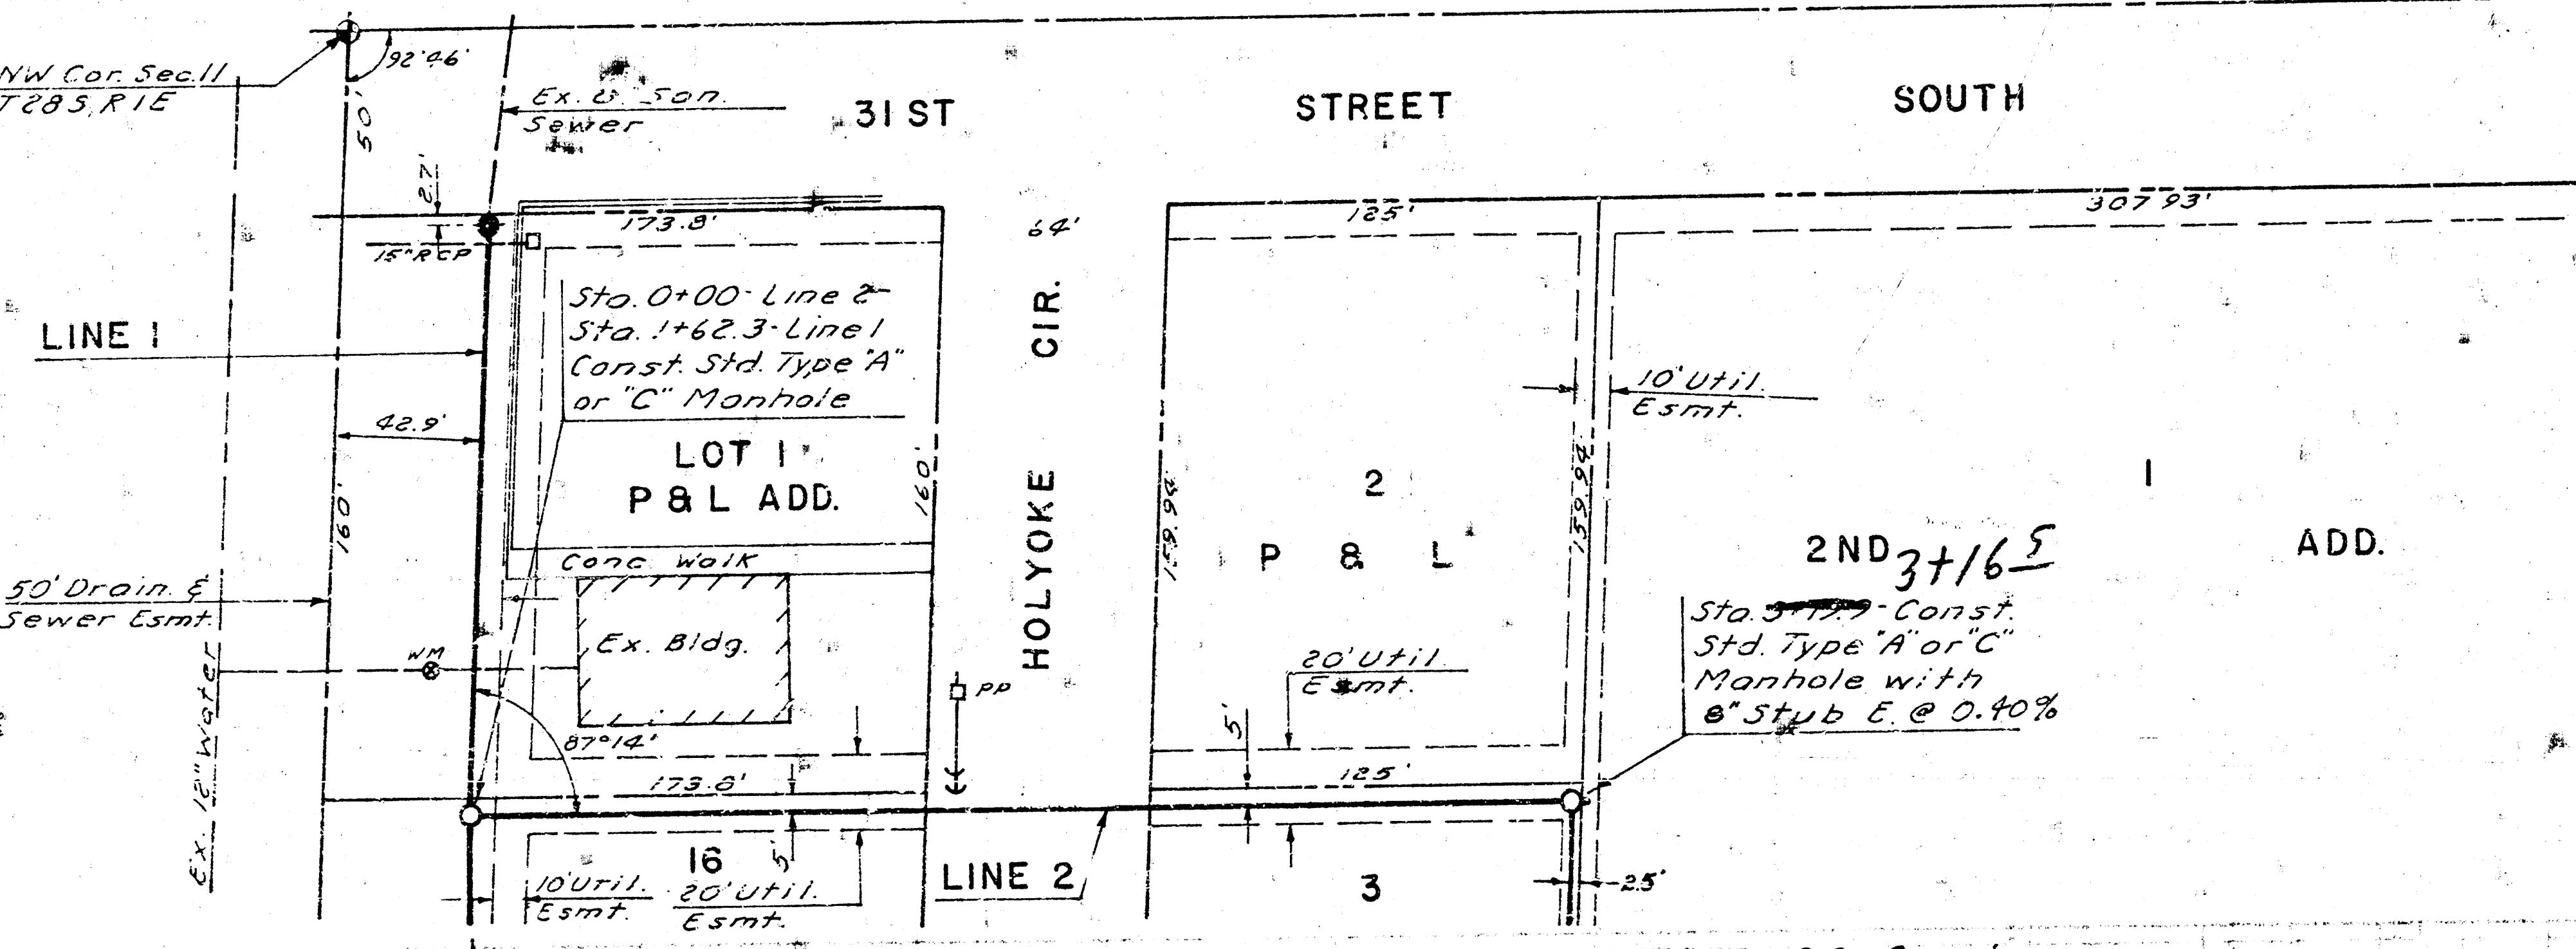
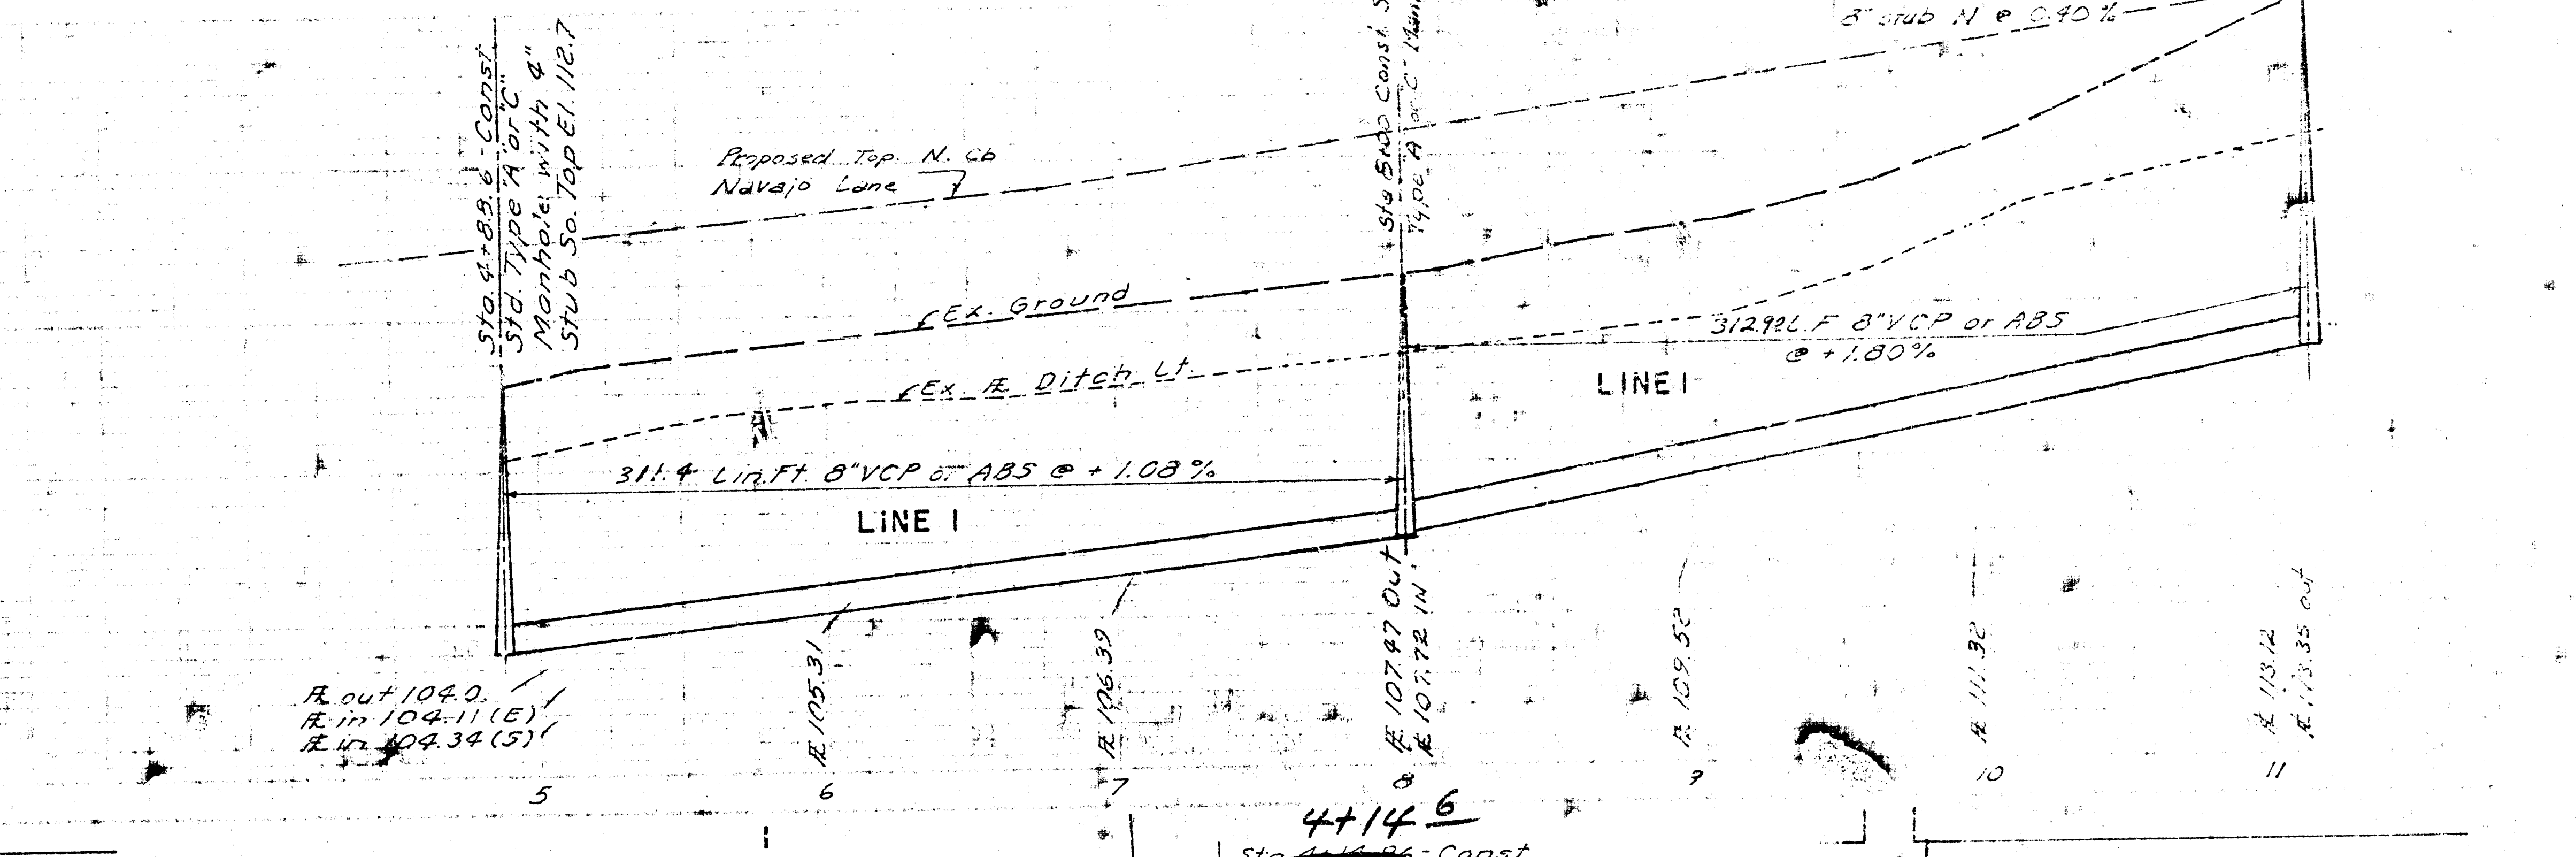
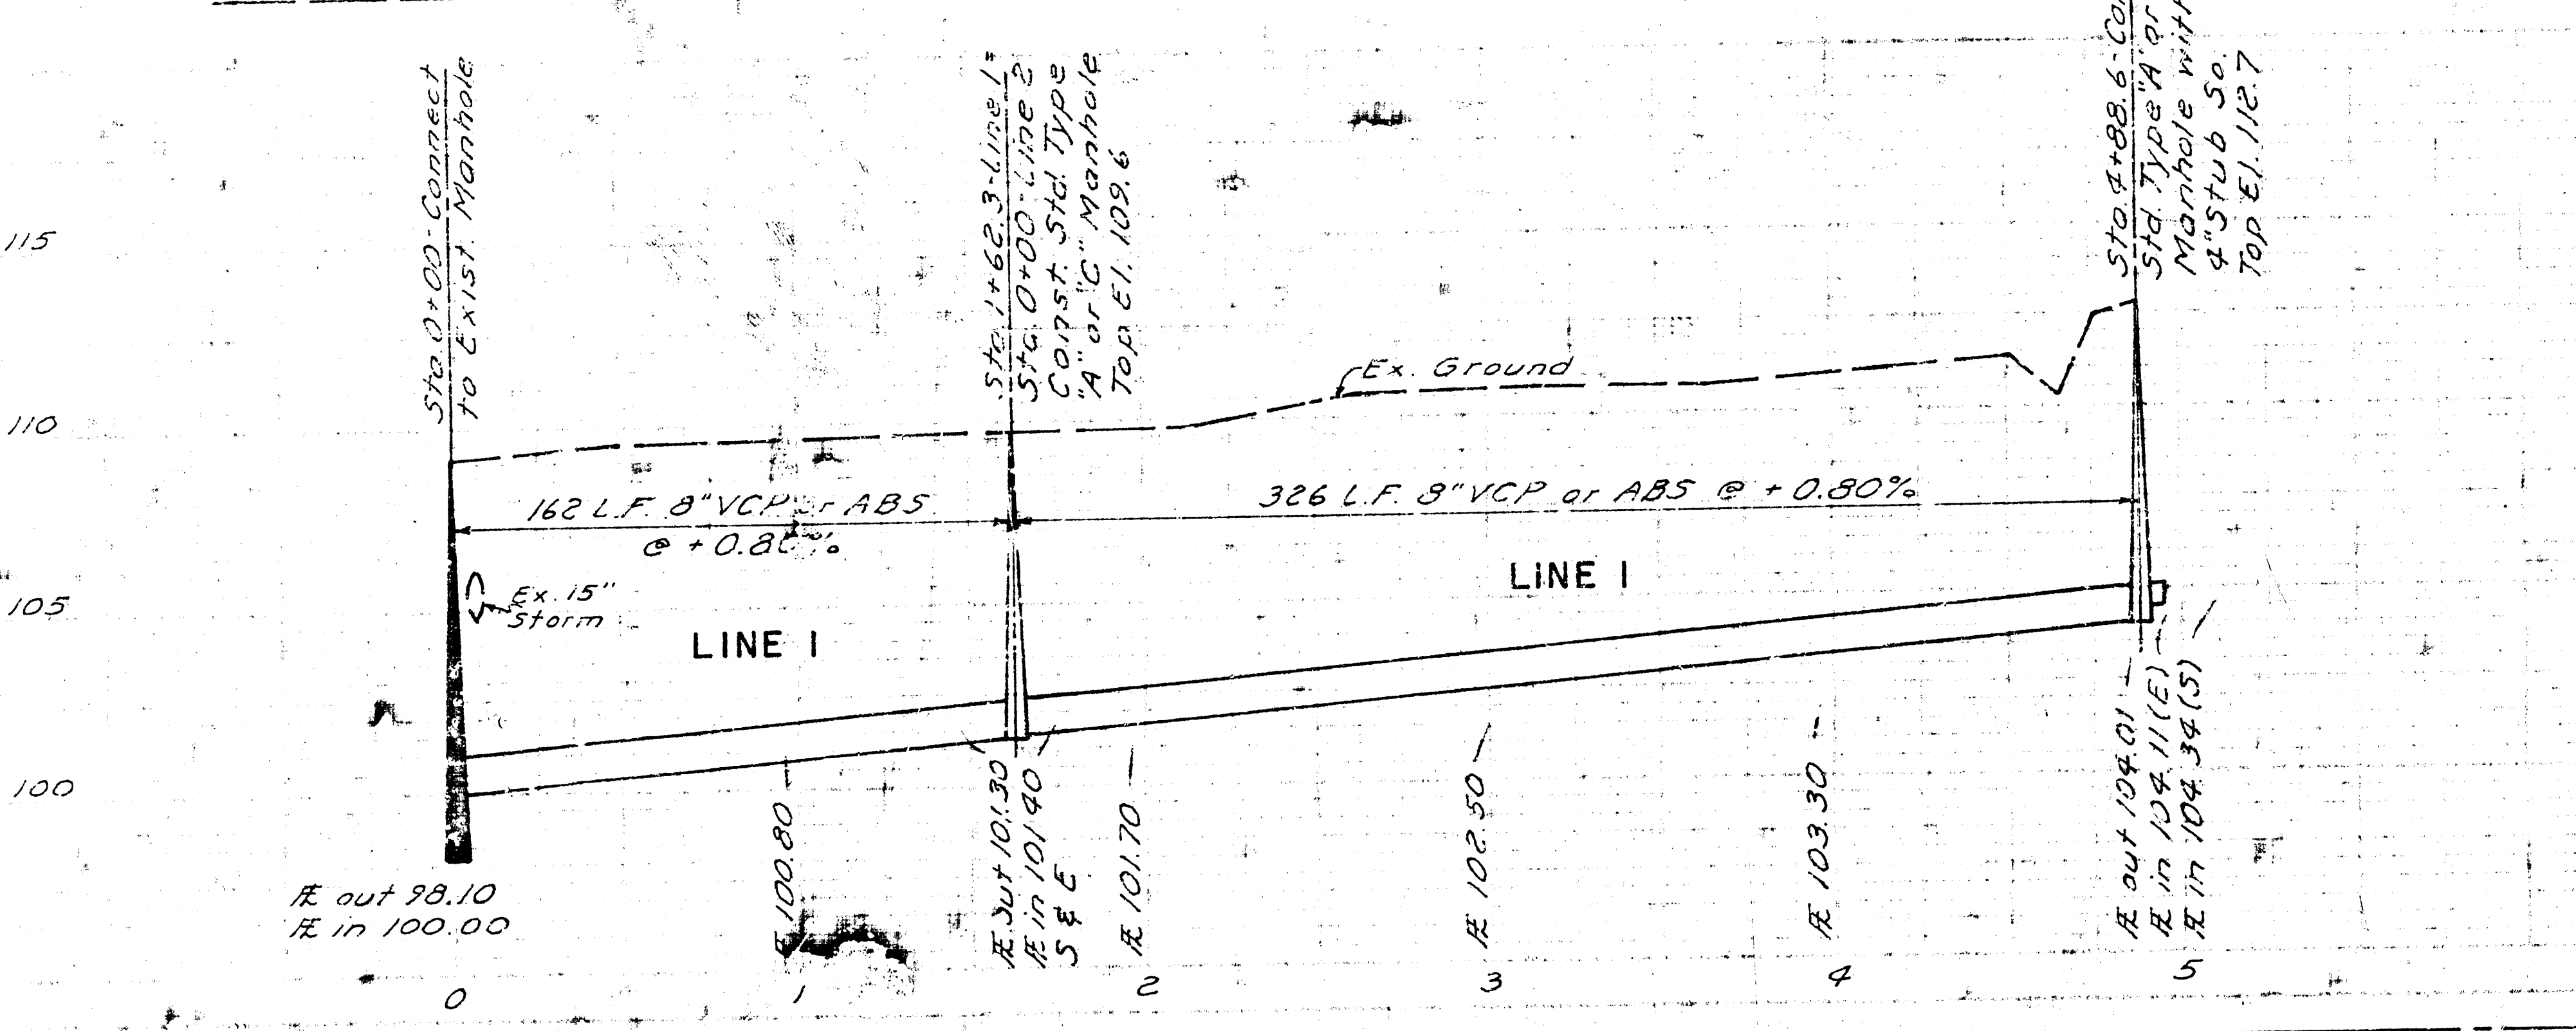
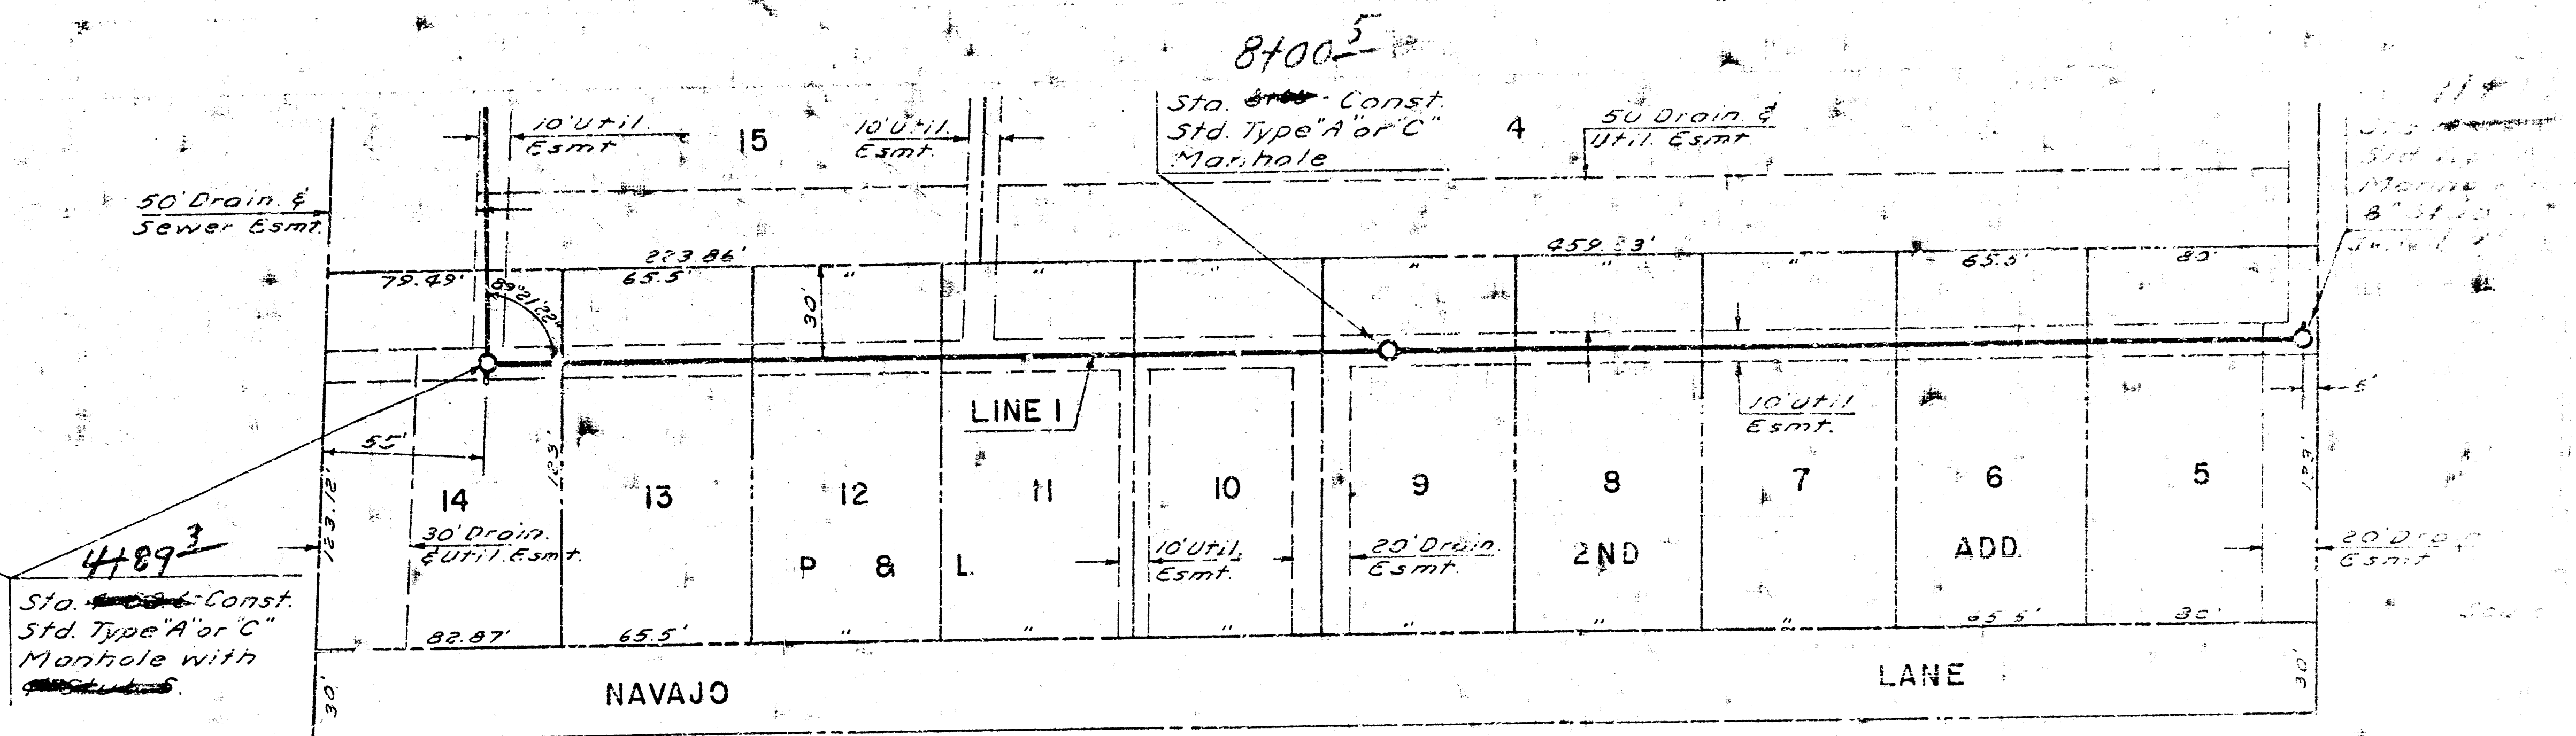


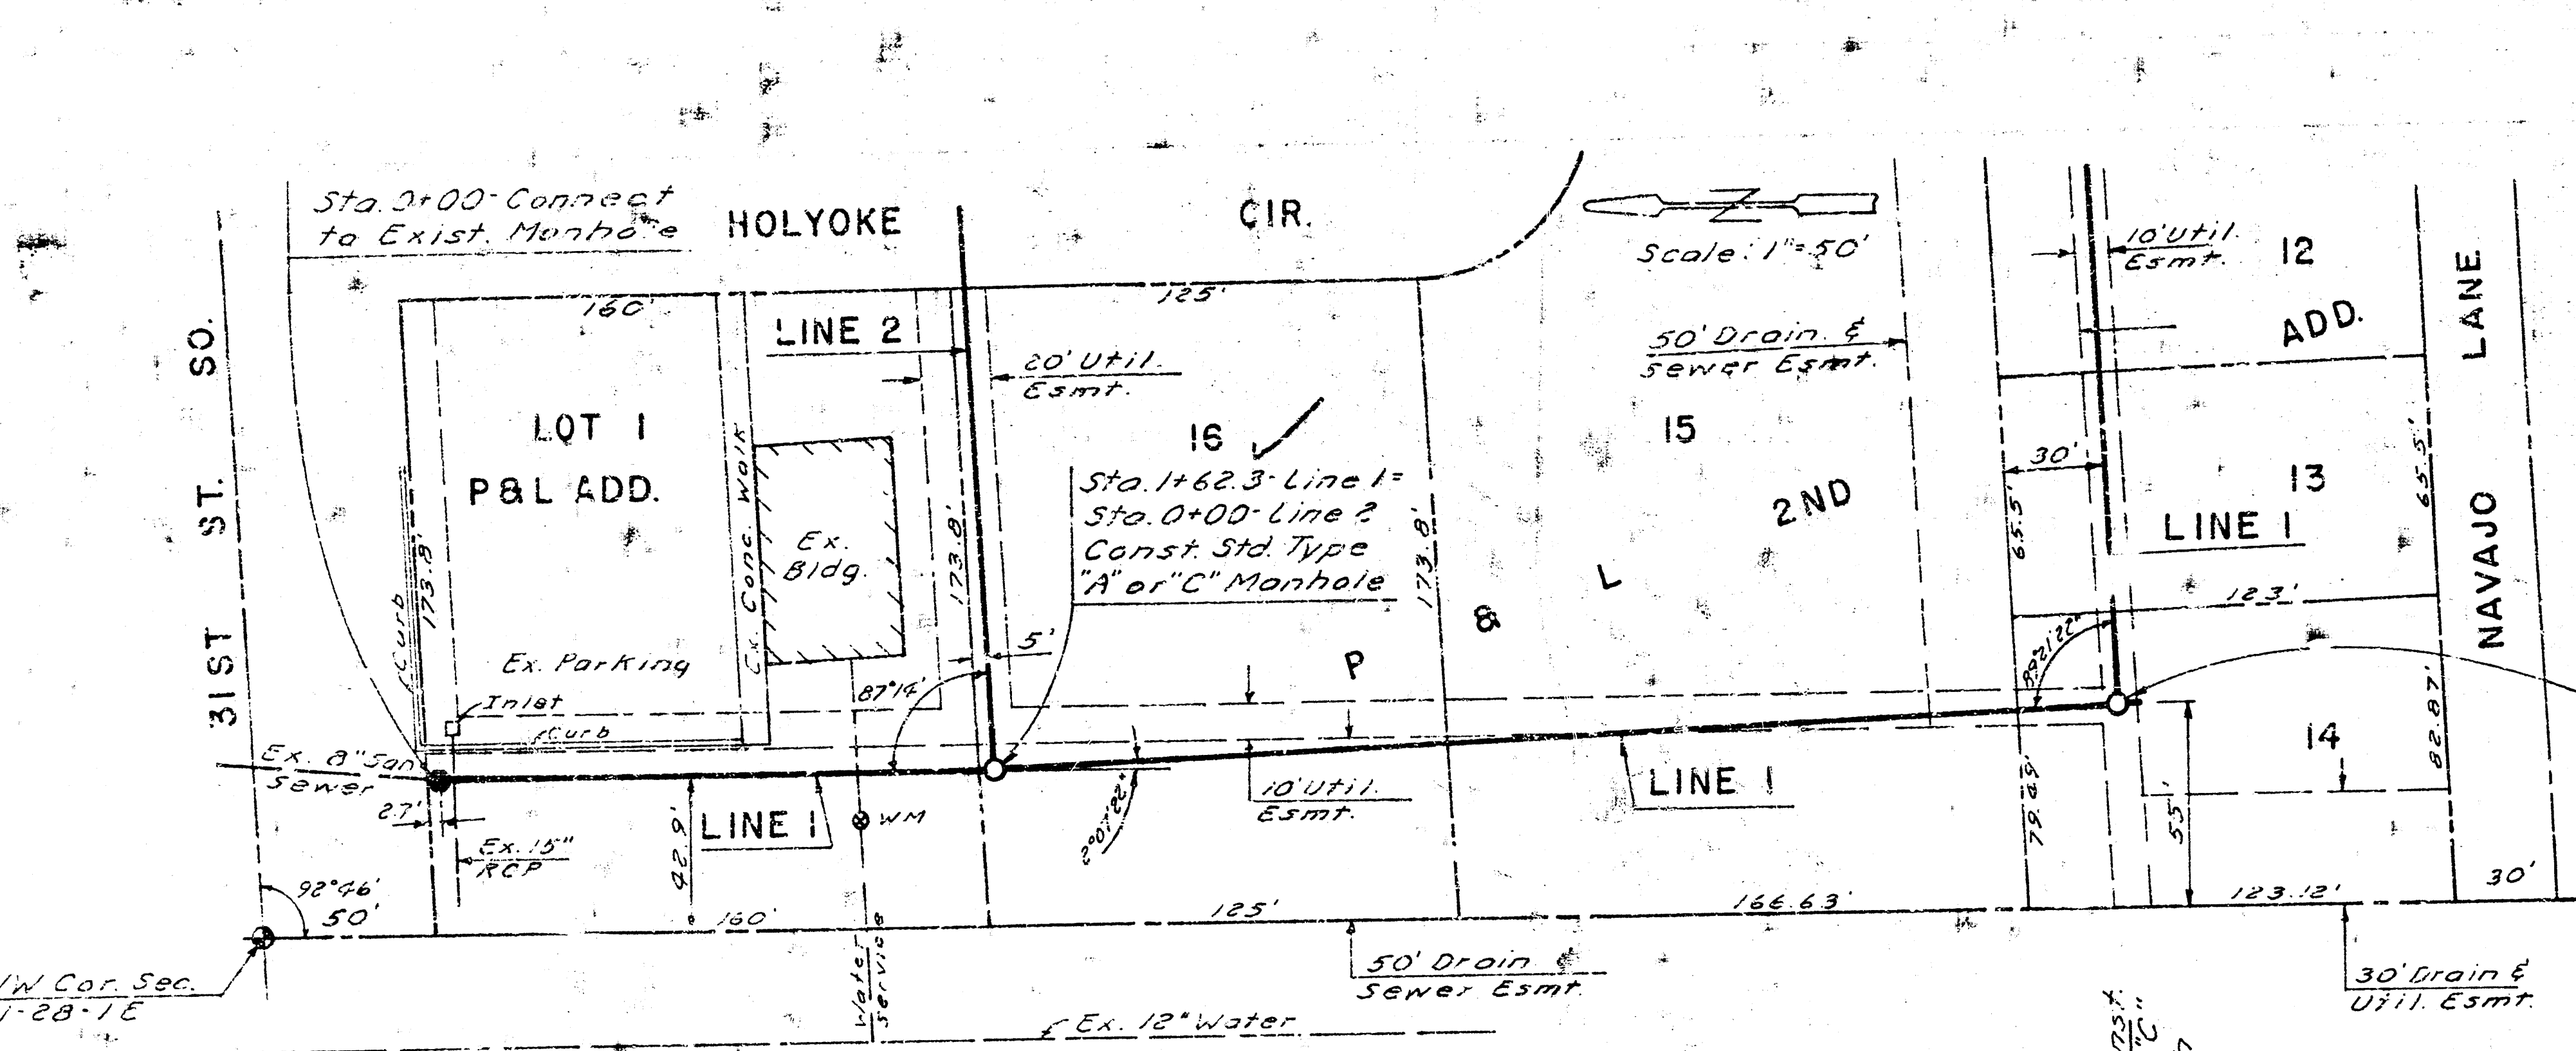

As built 10-23-78

LAT. 59, WAR INDUSTRIES SEWER

CITY OF WICHITA, KANSAS

R.W. LINN CITY ENGINEER

1978

PROJECT NO. 468-76-245-80429-700-000-001