

LATERAL 67, WAR INDUSTRIES SEWER

PROJECT NO.

468-76-245-81069-000-000-001


CITY OF WICHITA, KANSAS
R. W. BRUGGEMAN, CITY ENGINEER
MARCH, 1981
FOLIAGE

LEGEND

PROPOSED LINE -----
EXISTING LINE -----
BENEFIT DISTRICT BOUNDARY -----

NOTE: Risers and additional stubs shall be installed on this project to serve individual lots when ordered by the Field Engineer. Riser construction shall conform to the requirements as shown on Standard Riser Detail Sheet. Locations of the ends of the risers shall be marked by fastening green plastic colored tape to the end of the riser and brought to the ground surface as the excavation is backfilled such that the colored tape will be visible when the project is completed. All risers shall be constructed using S.D.R. 71.5 A.B.S. or P.D.C. Pipe. Elevations of stubs and tops of risers shall be such that will facilitate connection of basement drains when those lots are developed.

B.M. #1
3/8" Spike - South of Pond.
ELEV. = 190.33'
B.M. #2
Iron - Northeast Corner of Lot 1, Block 1
ELEV. = 194.05'
B.M. #3
Iron - Southwest Corner of Lot 14, Block 1 @ PC
ELEV. = 192.77'
B.M. #4
3/8" Spike - Southeast Corner of Lot 14, Block 1
ELEV. = 193.33'
B.M. #5
Iron - Southeast Corner of Lot 15, Block 1
ELEV. = 193.15'
B.M. #6
Iron - Southwest Corner of Lot 20, Block 1
ELEV. = 193.15'
B.M. #7
Iron - South Corner of Lot 21, Block 1
ELEV. = 189.66'

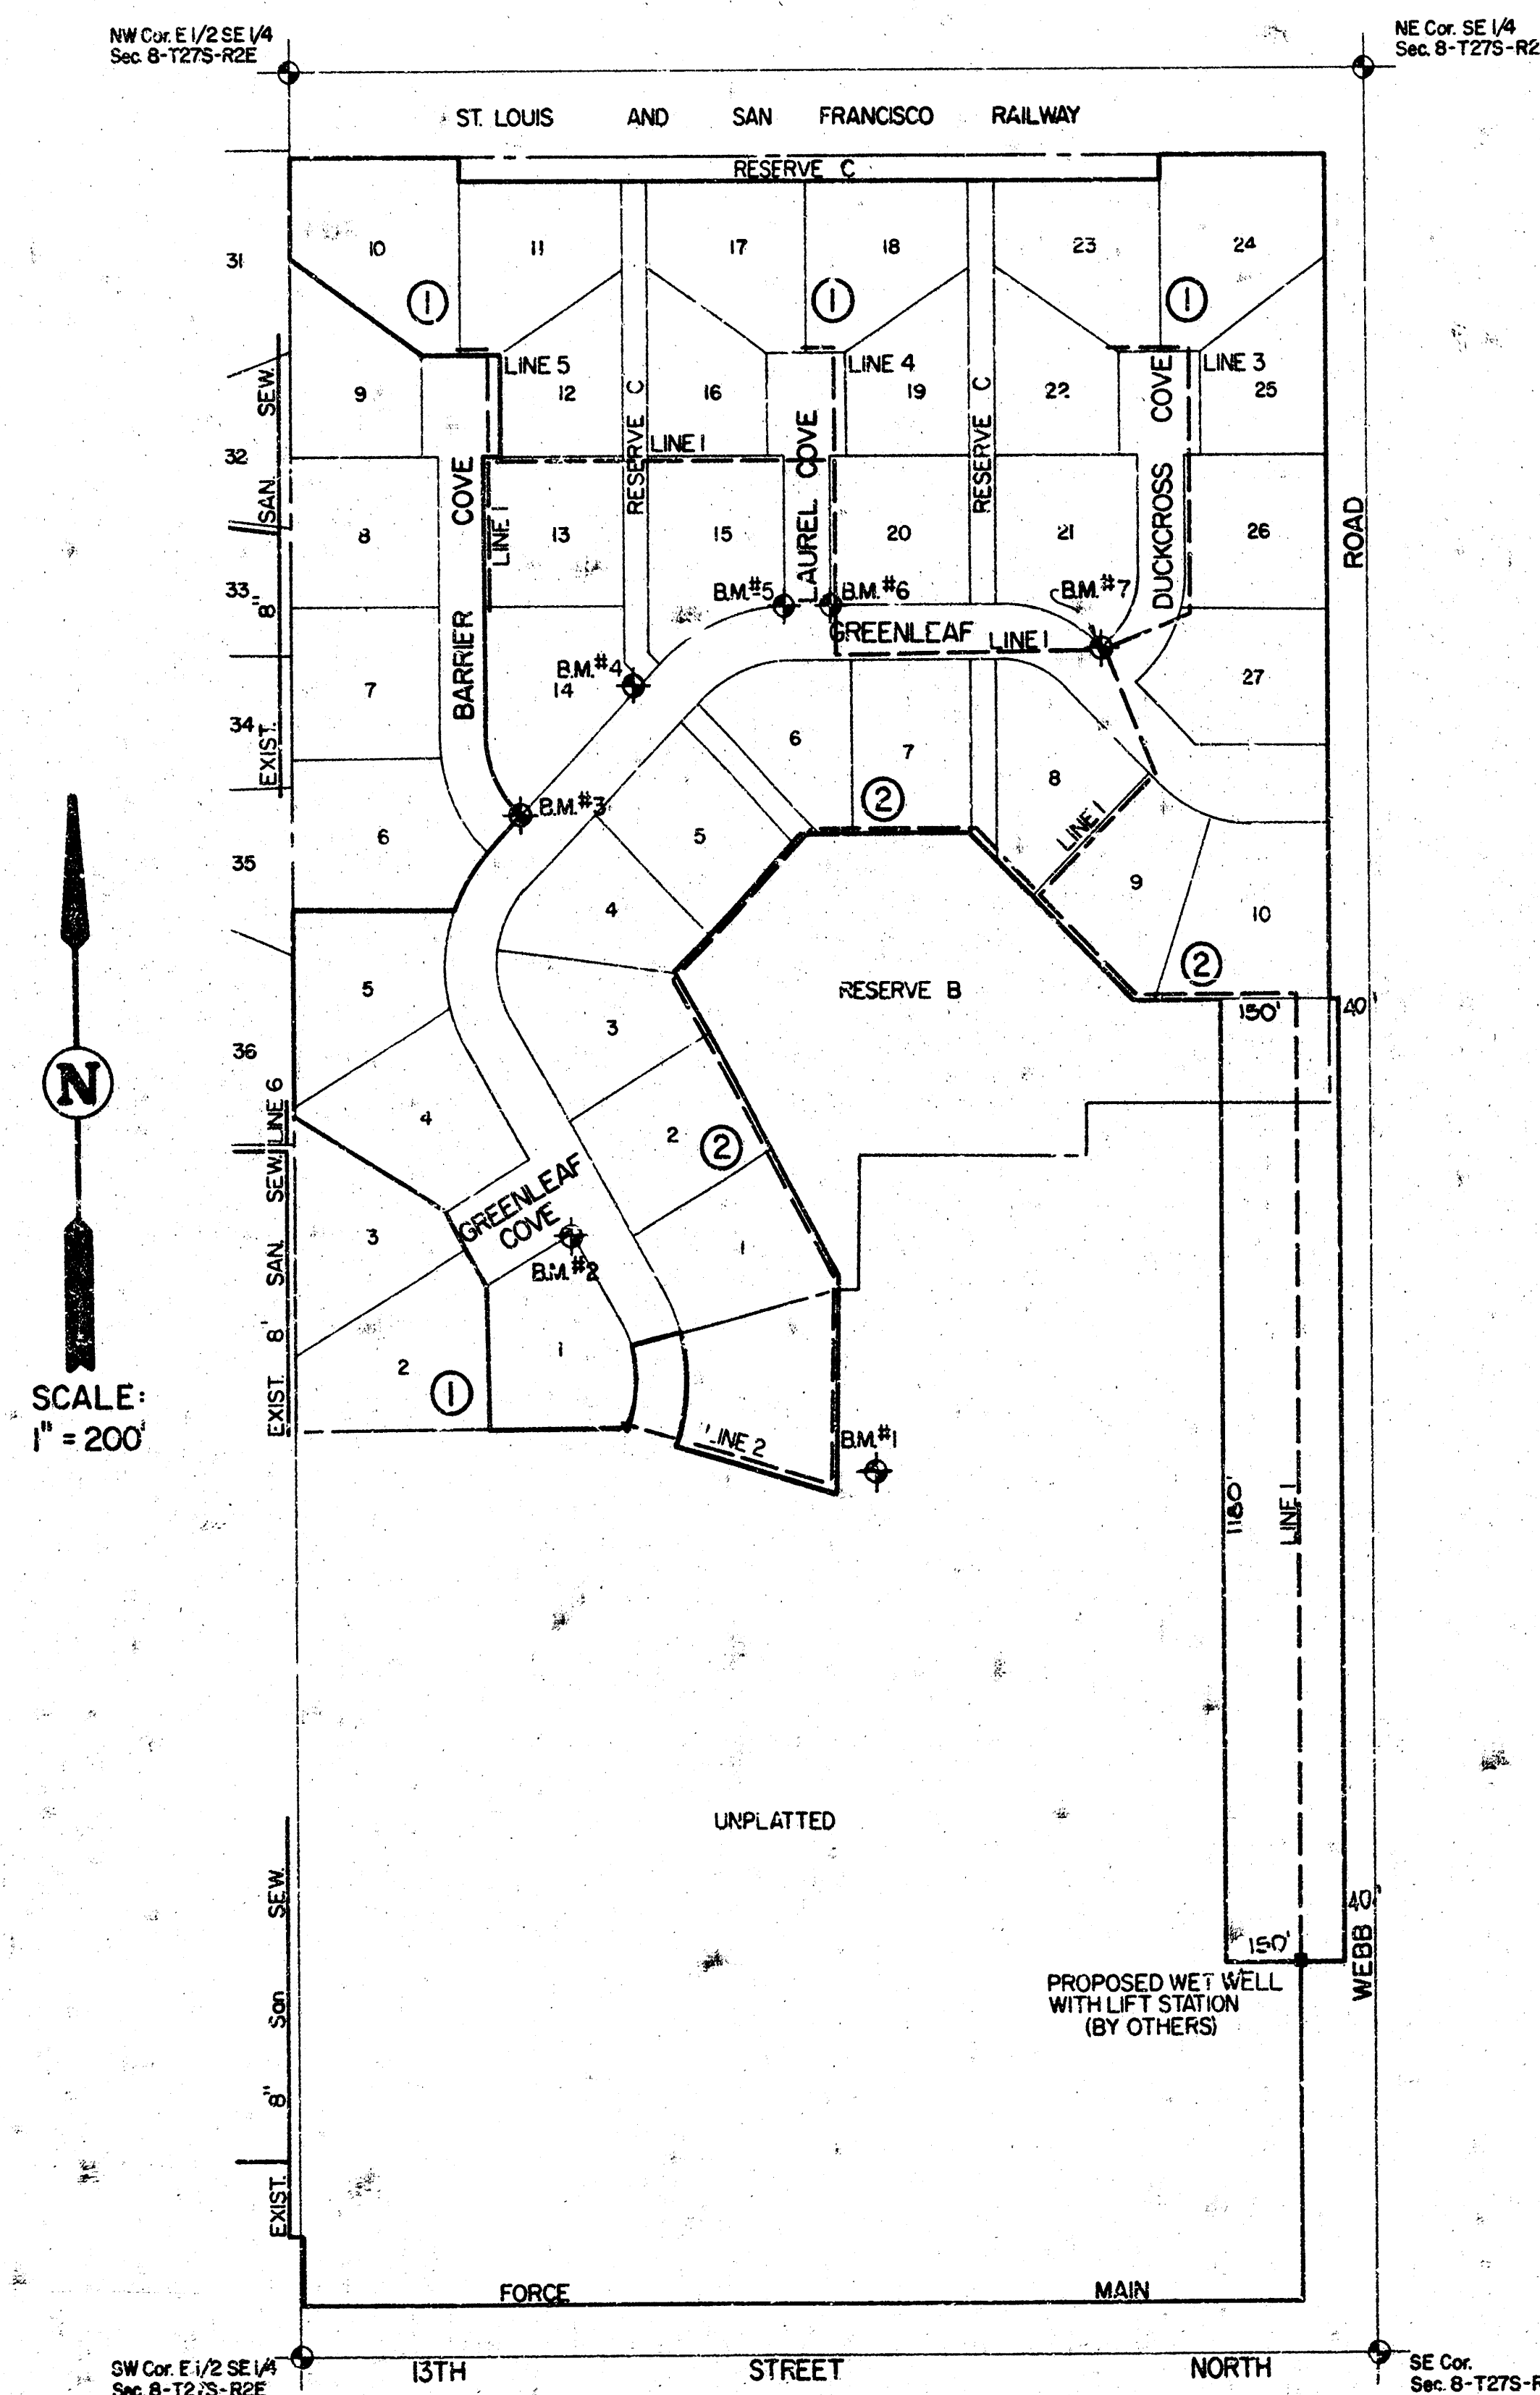


INDEX	TO	DRAWINGS
SHEET NO.		DESCRIPTION
1		COVER SHEET
2-5		LINE 1
5-6		LINE 2
7		LINE 3 & 4
8		LINE 5 & 6
9		PLAT


As Built
11/81
JSS




Van Doren Hazard Stallings
Architects - Engineers - Planners
Topeka - Wichita - Minneapolis - Kansas City

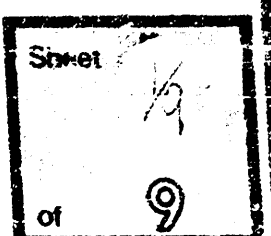

FOLIAGE
LATERAL 67, WAR INDUSTRIES SEWER
468-75-245-81069-000-000-001

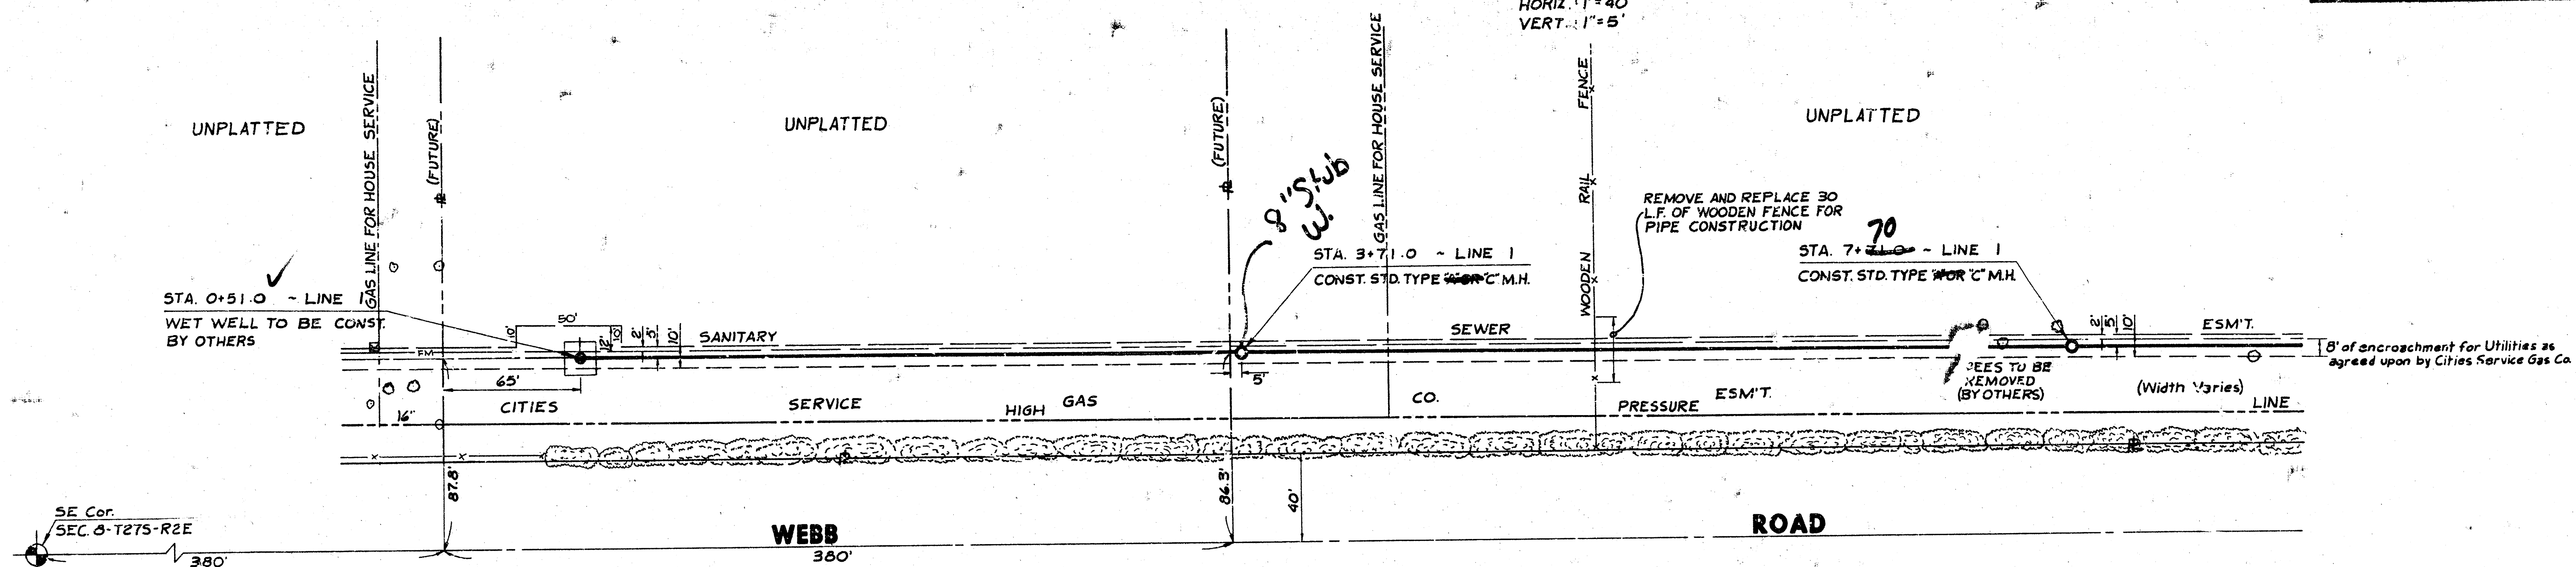


NOTE: AN AGREEMENT HAS BEEN EXECUTED WITH CITIES SERVICE GAS COMPANY WHICH ALLOWS INSTALLATION OF UTILITIES IN THE WEST 8' OF THEIR PIPE-LINE EASEMENT ALONG THE WEST SIDE OF WEBB ROAD. THE AGREEMENT ALSO ALLOWS UTILIZATION OF THE EAST 10' OF THE WEST 18' OF THIS SAME PIPE-LINE EASEMENT FOR OPERATION AND MAINTENANCE OF THE UTILITY INSTALLATION.


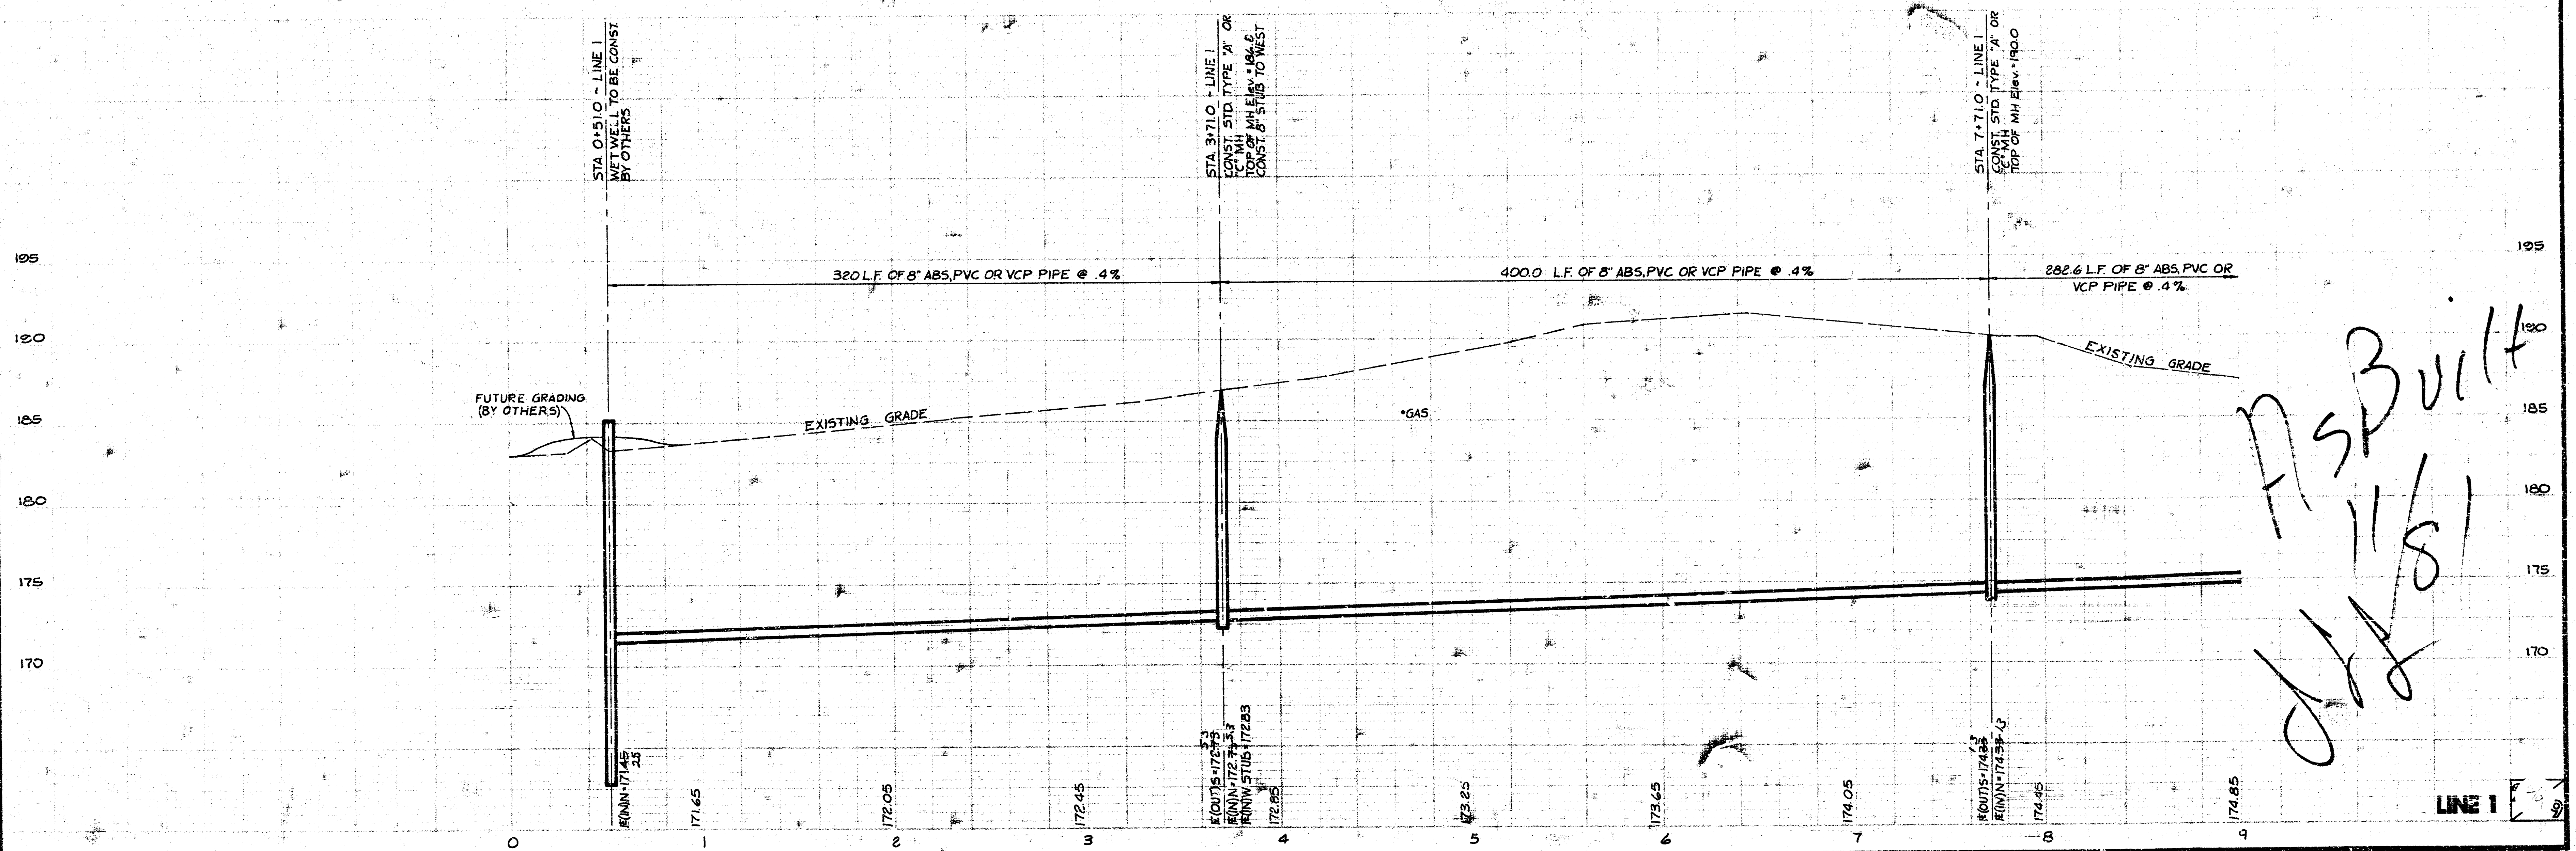


As Built
11/81
JJA

FOLIAGE
LATERAL 67, WAR INDUSTRIES SEWER
468-76-245-81069-000-000-001



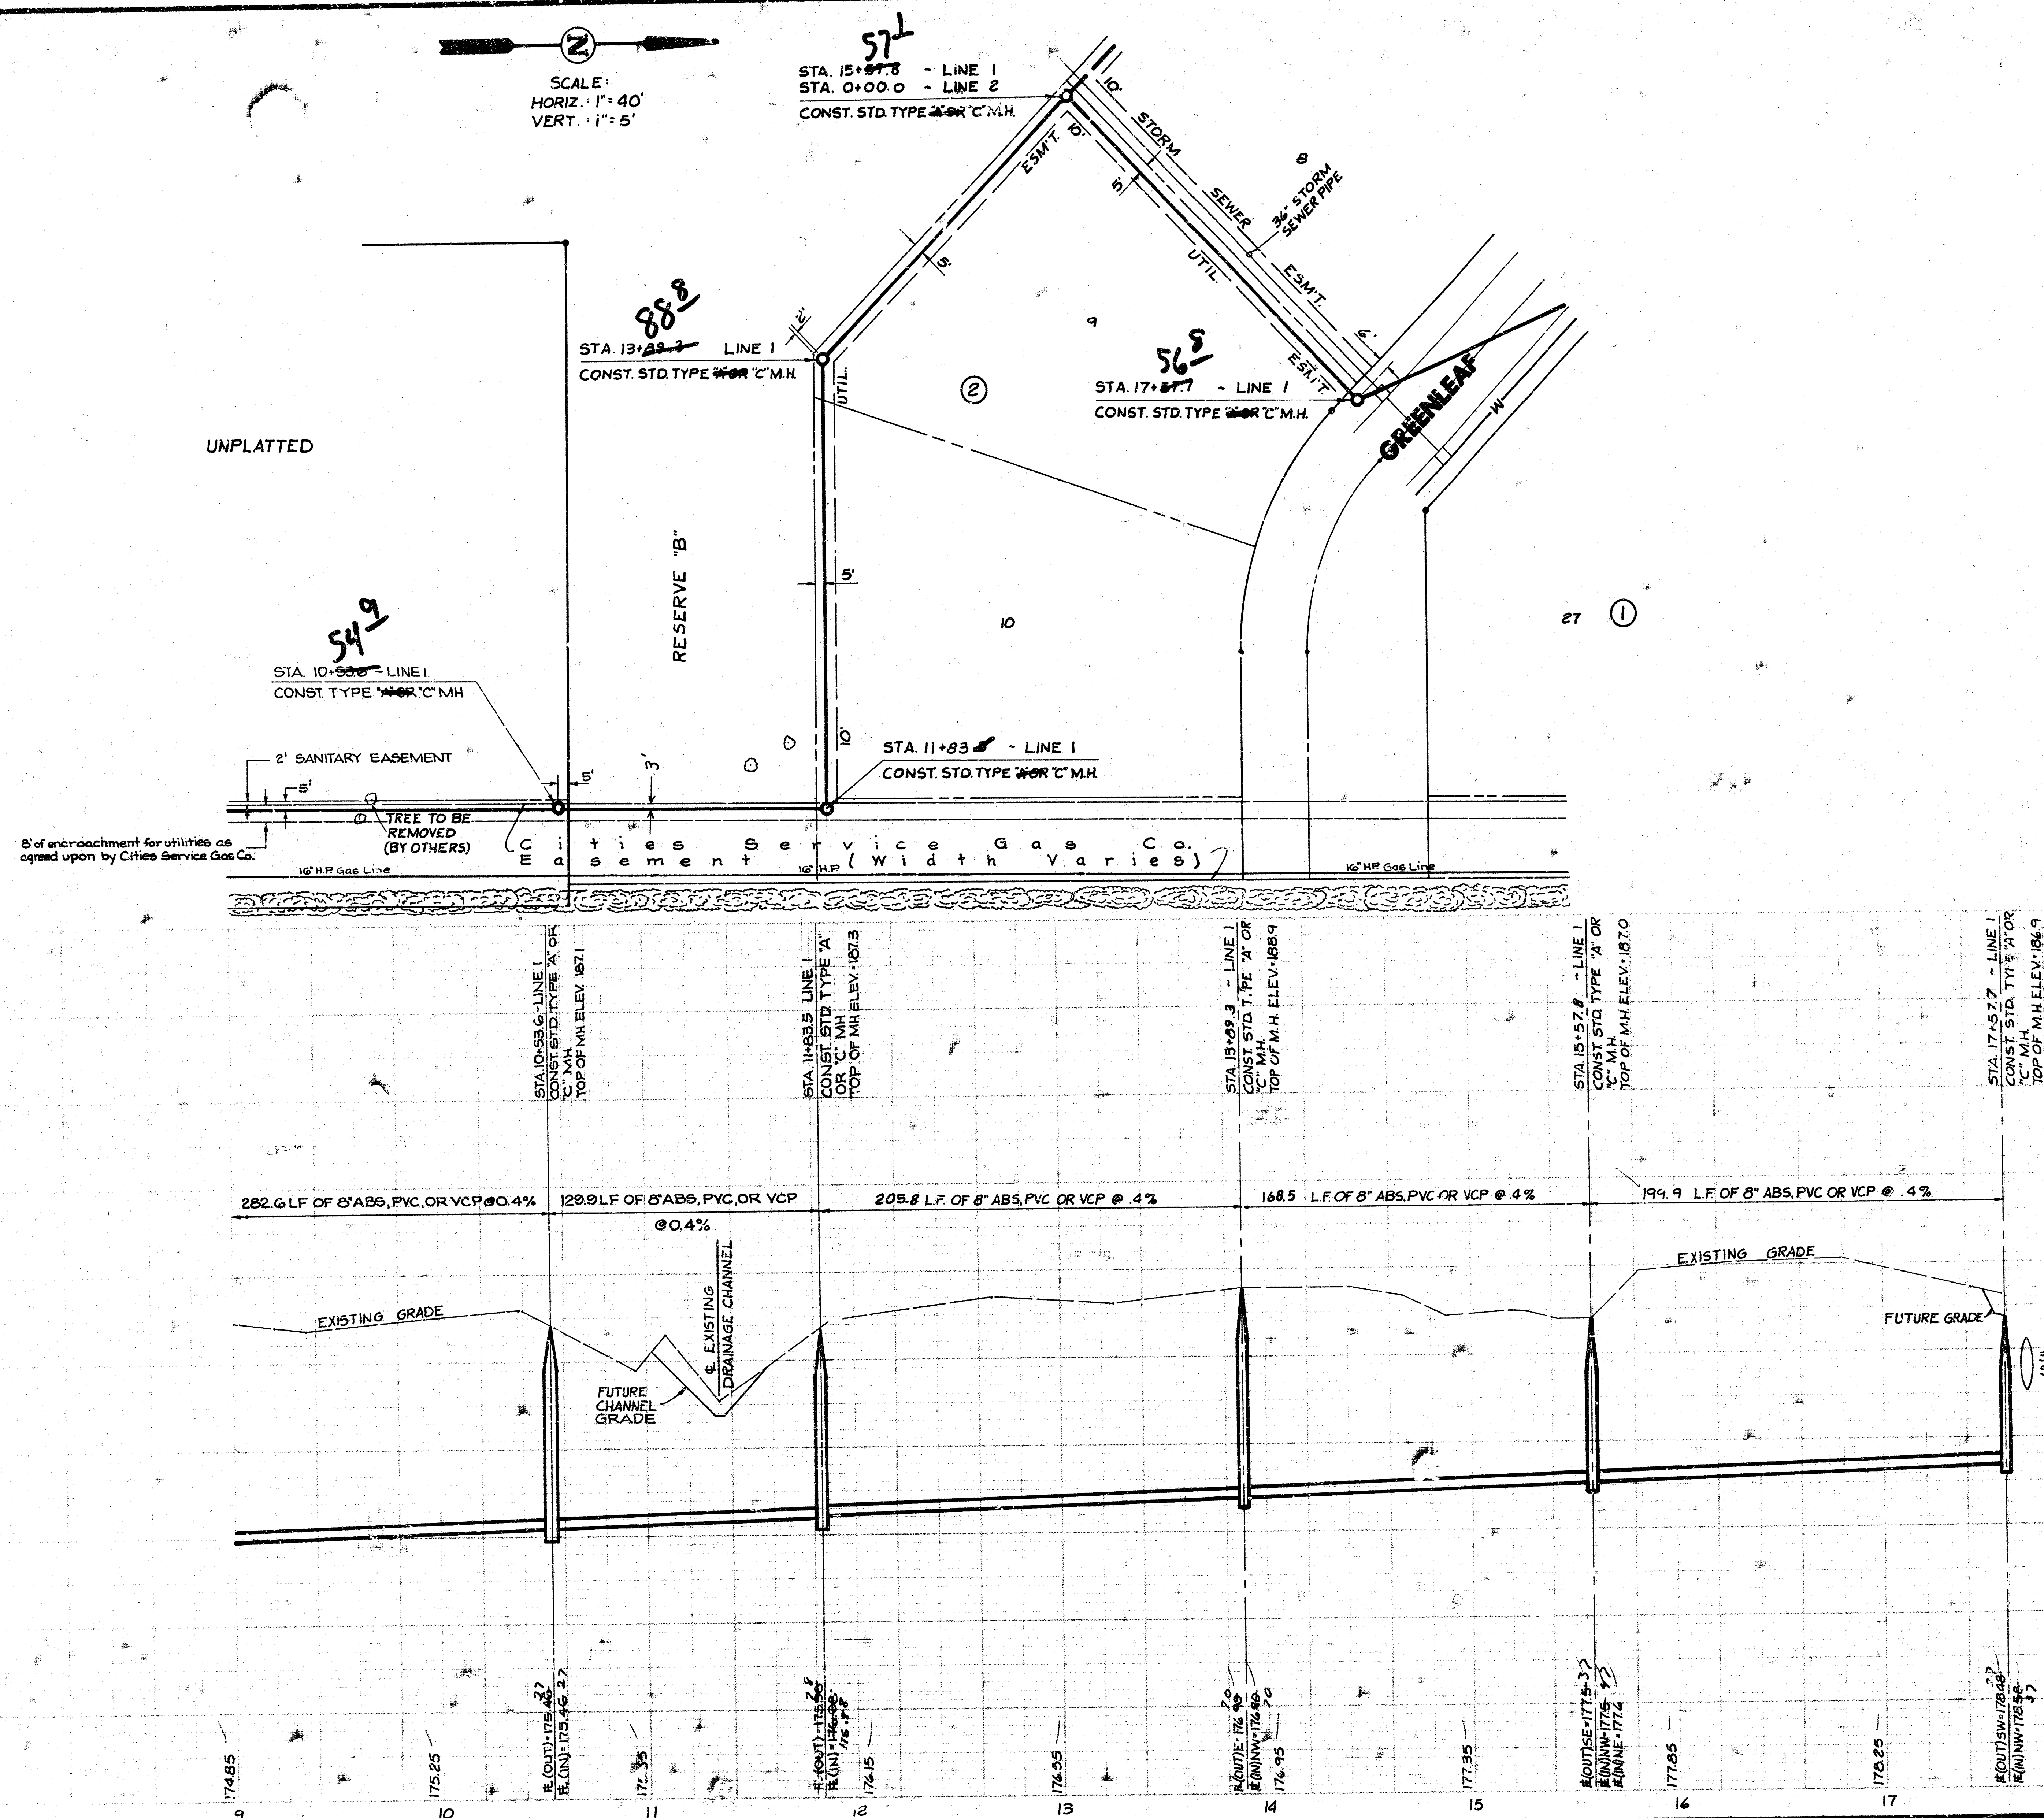


FOLIAGE
LATERAL 67, WAR INDUSTRIES SEWER
468-76-245-81069-000-000-001

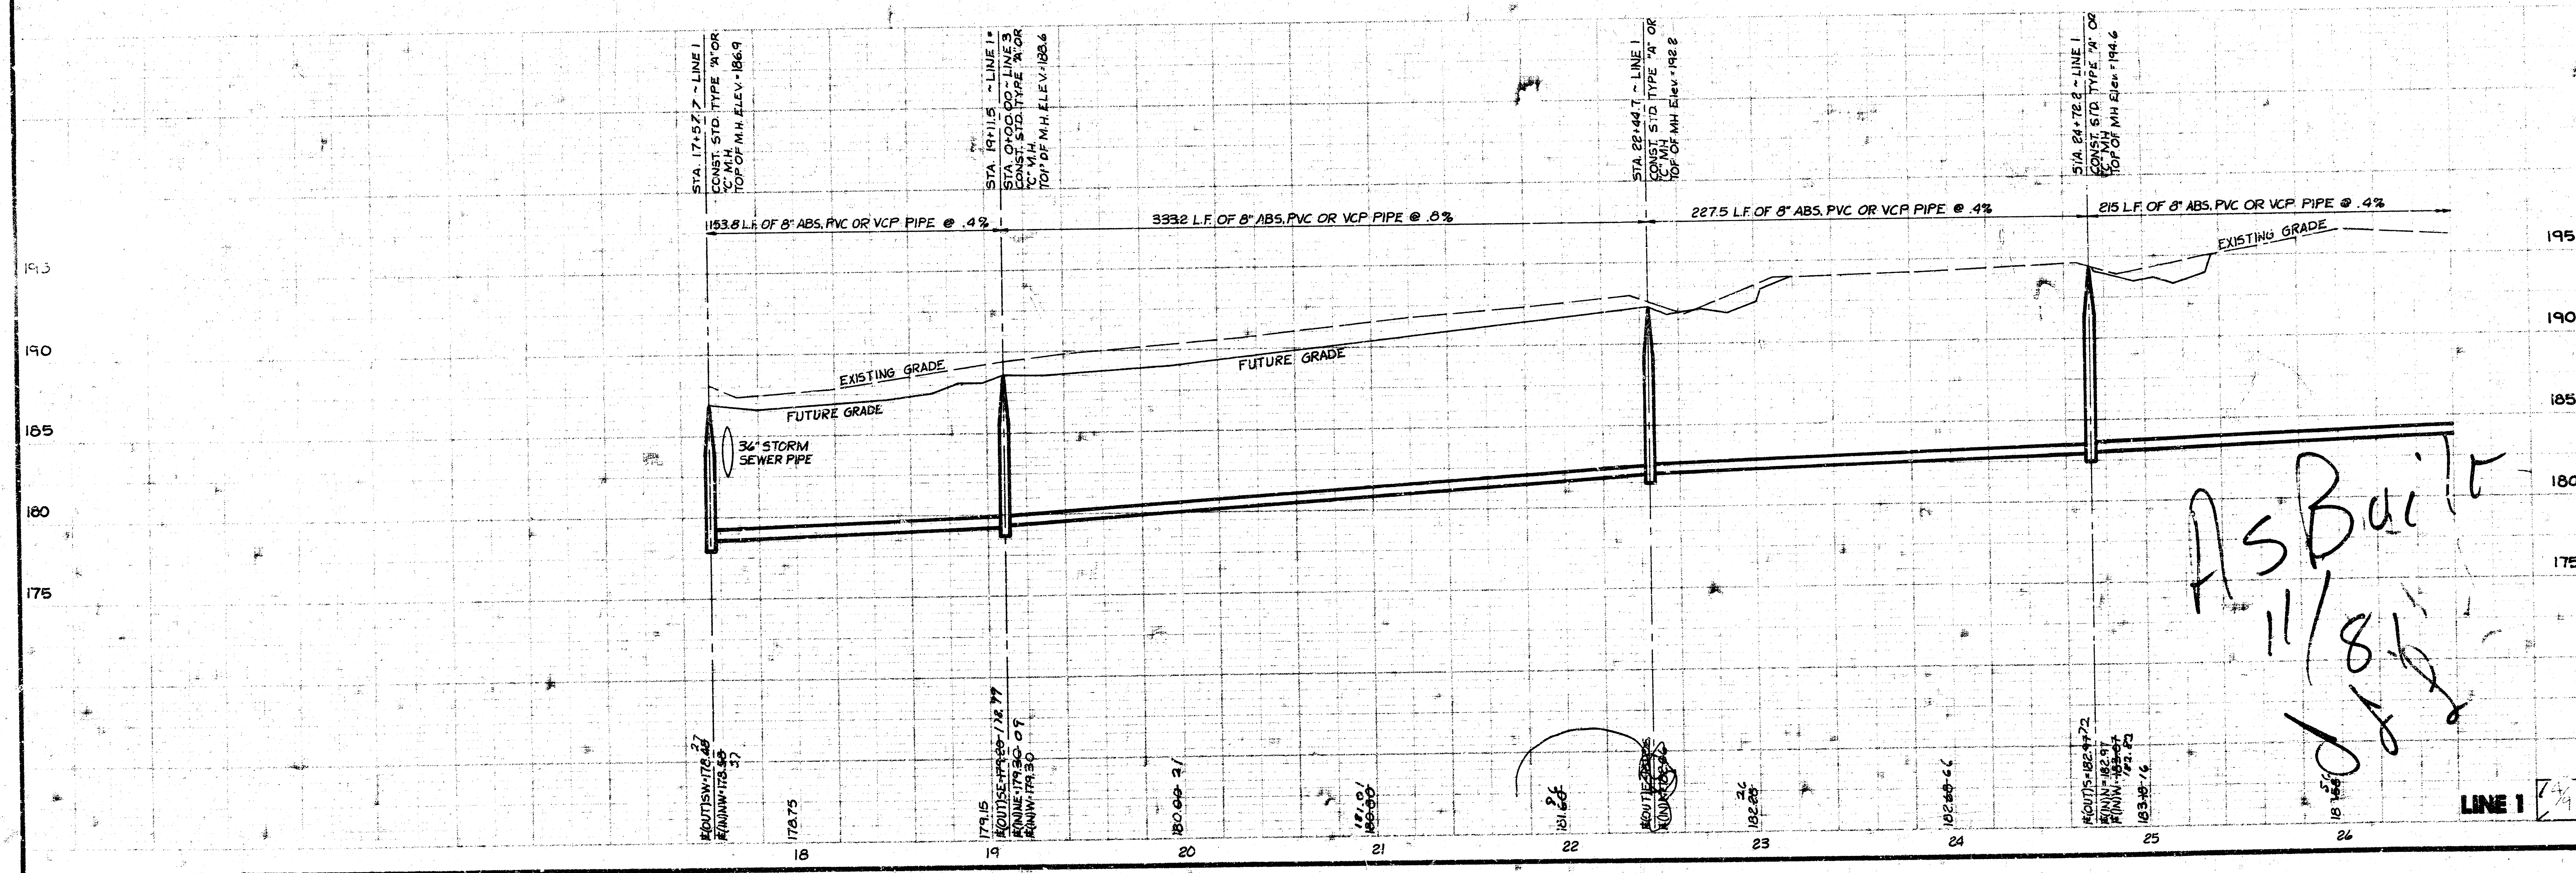
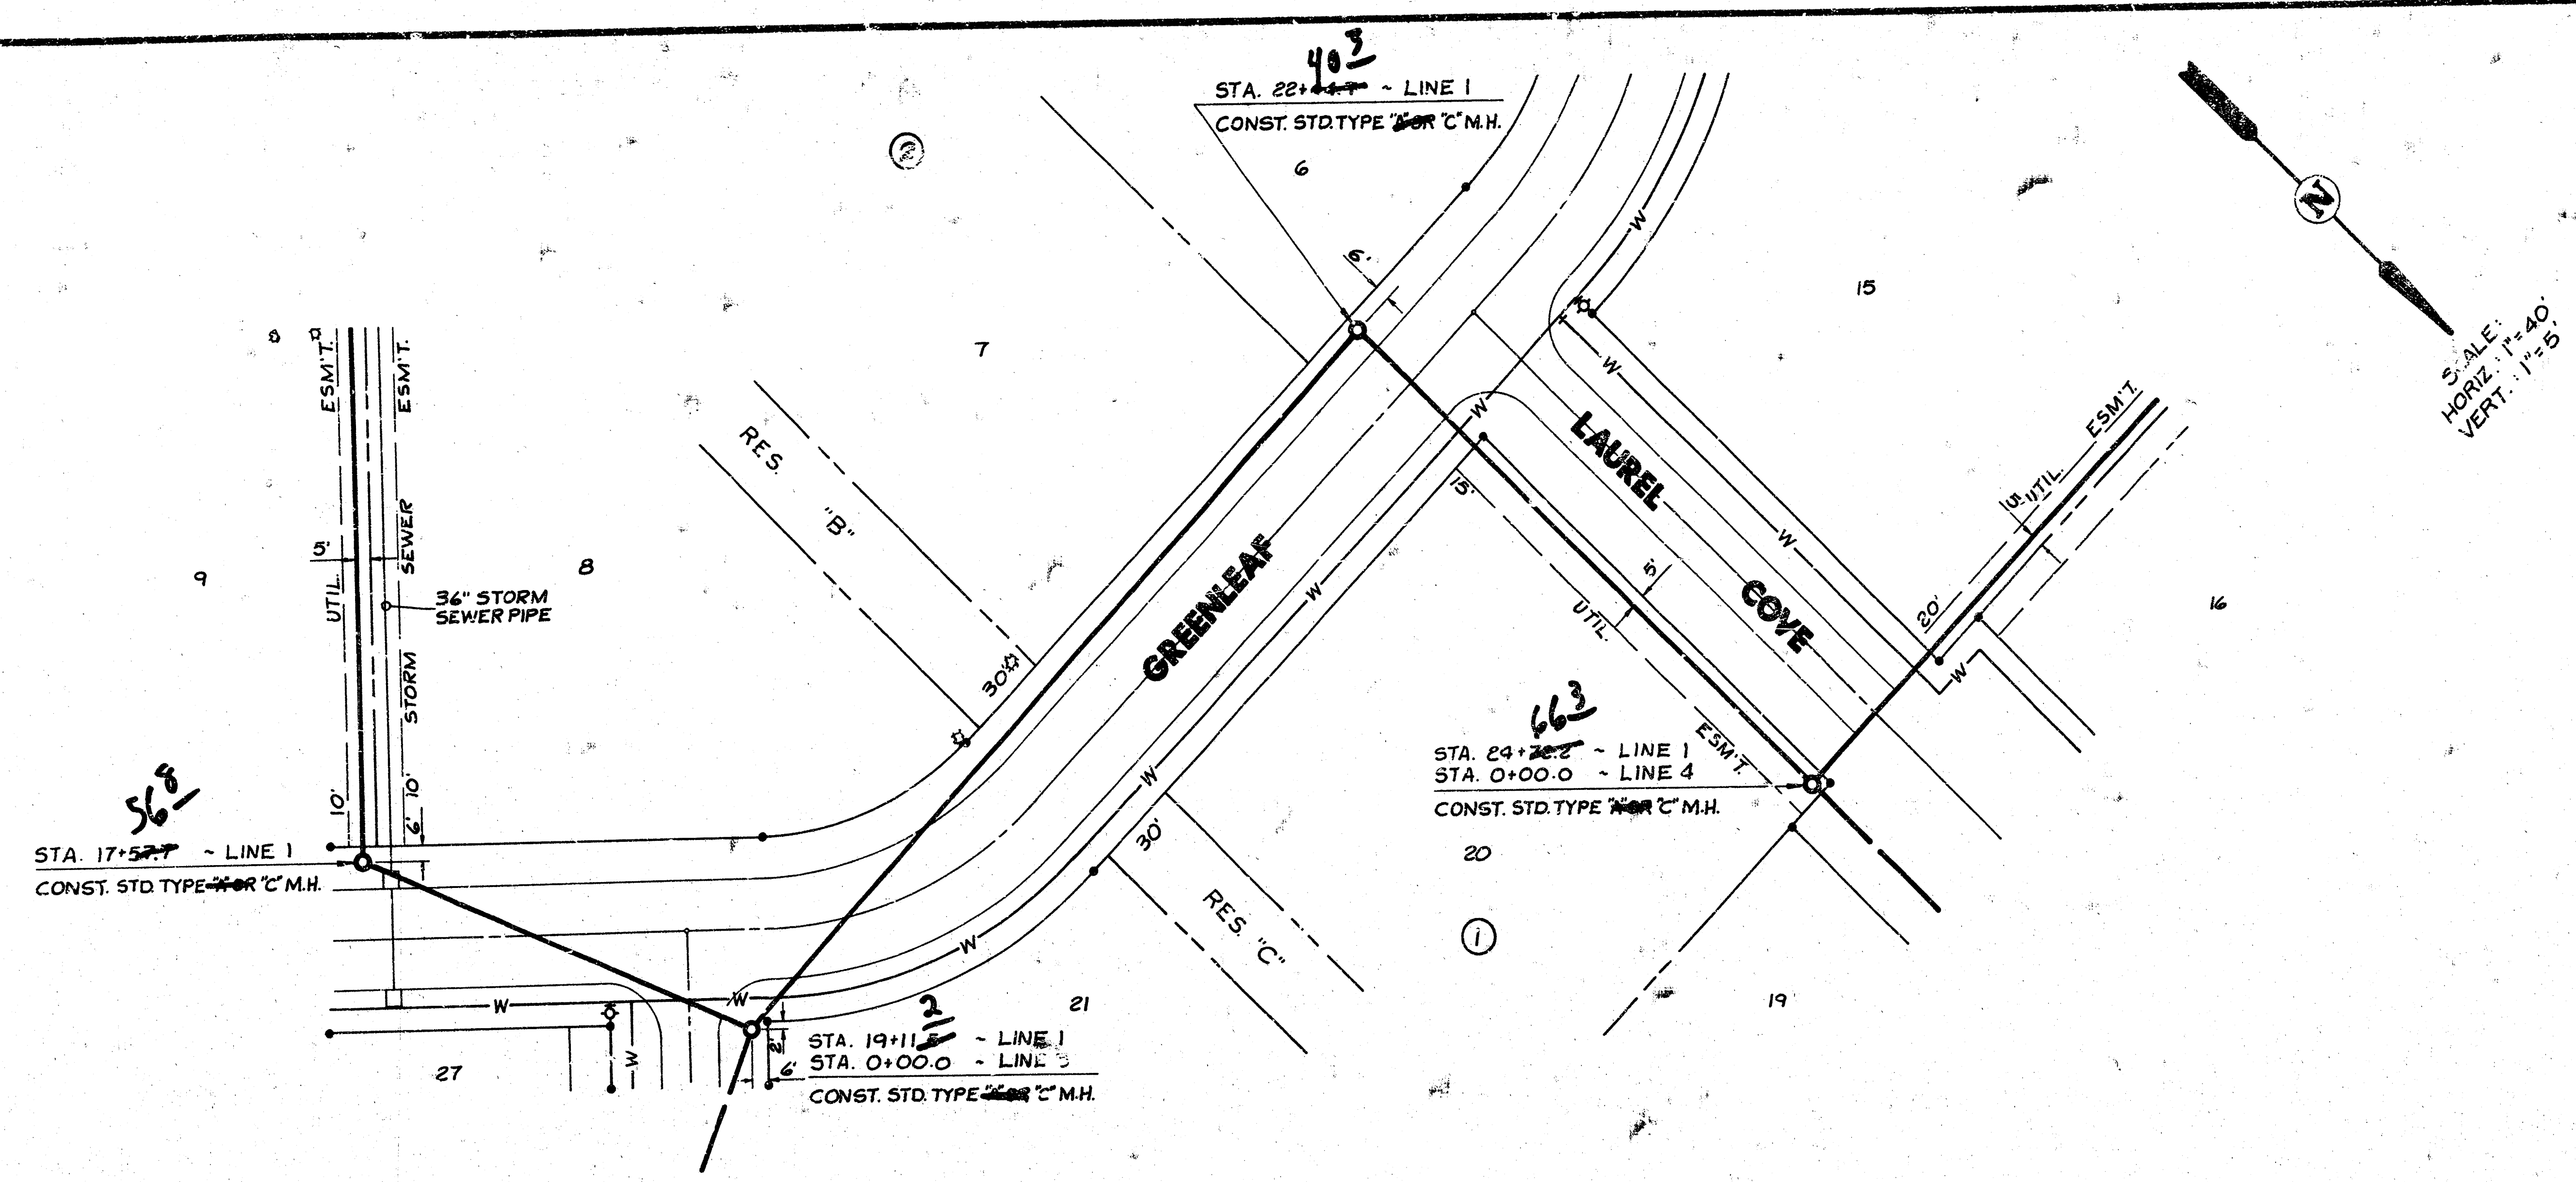


As Built
11/8/82

FOLIAGE
LATERAL 67, WAR INDUSTRIES SEWER
468-76-245-81069-000-000-001

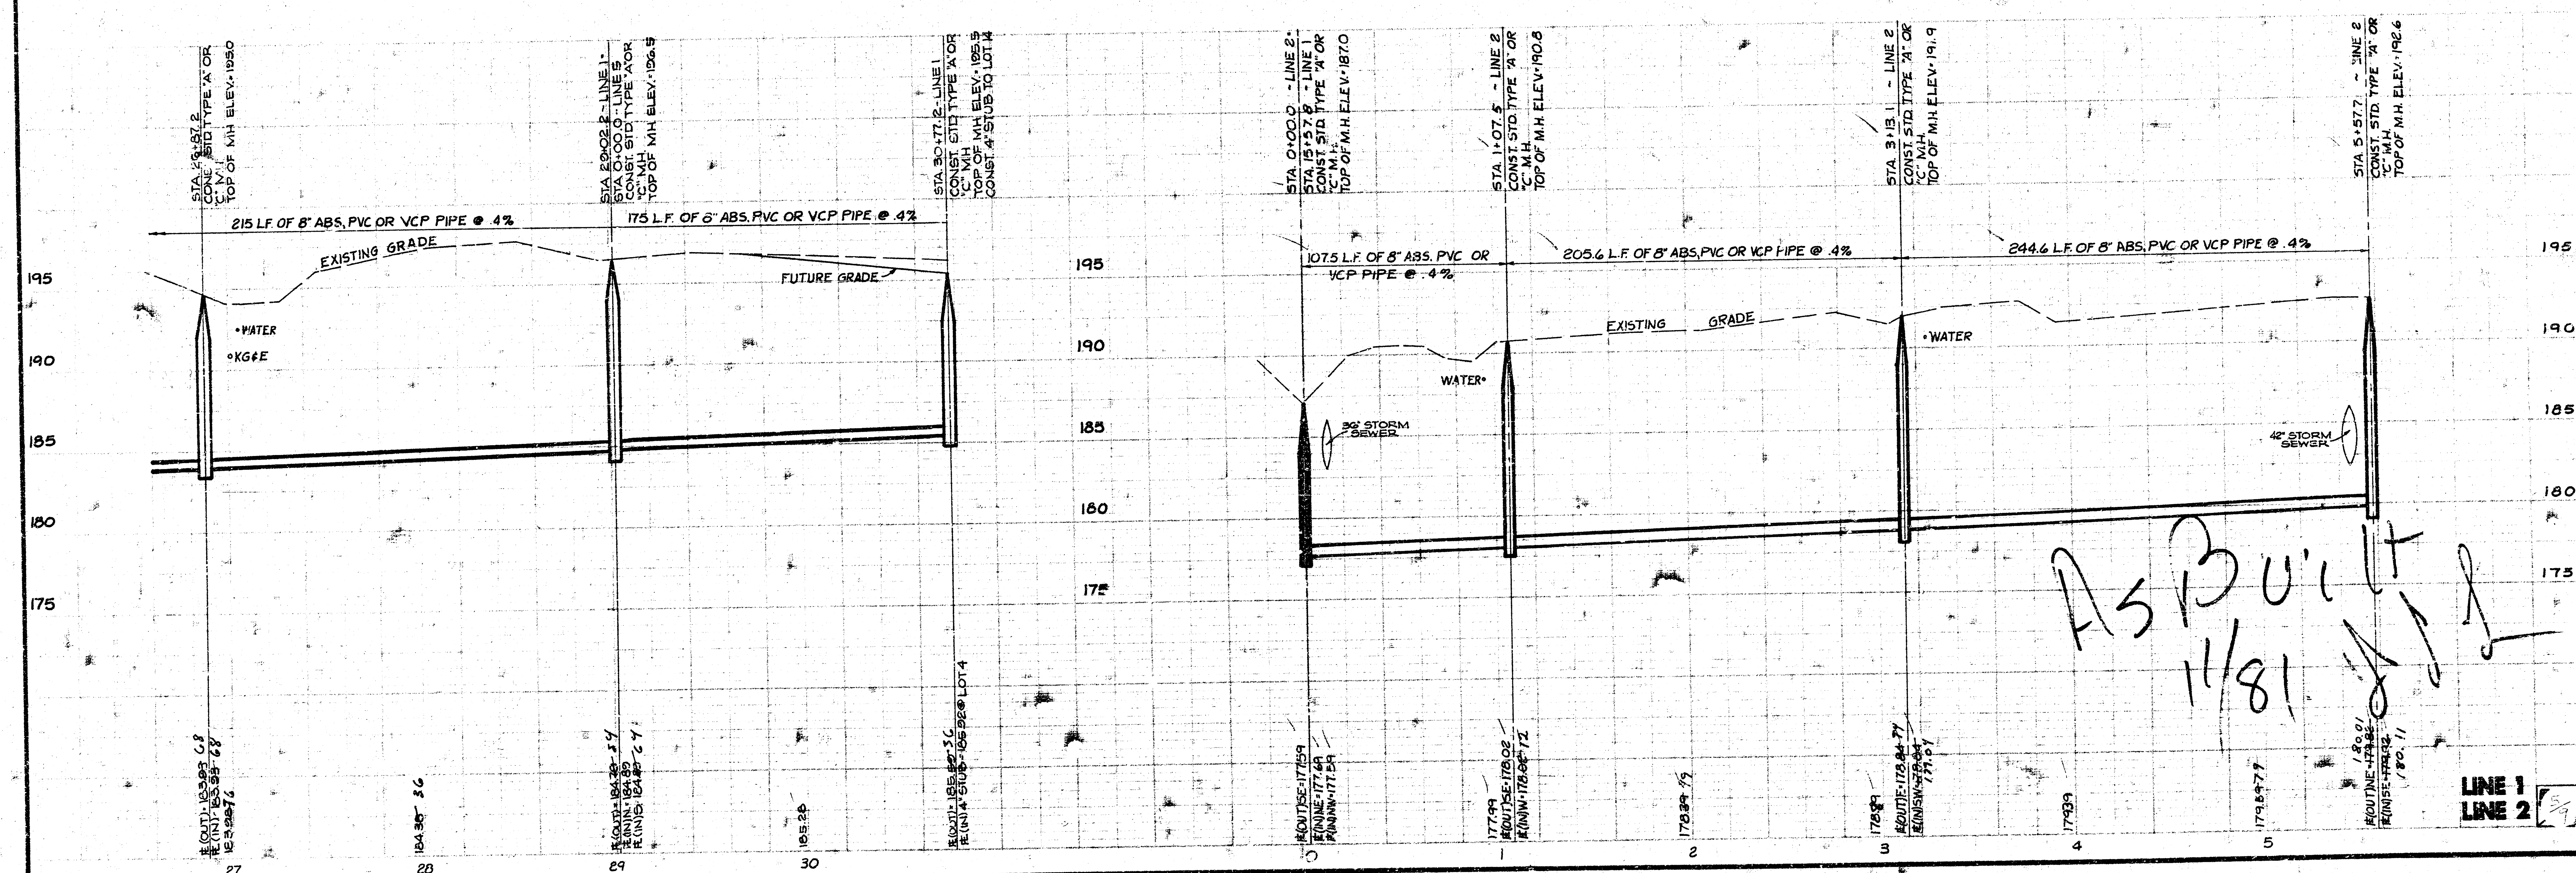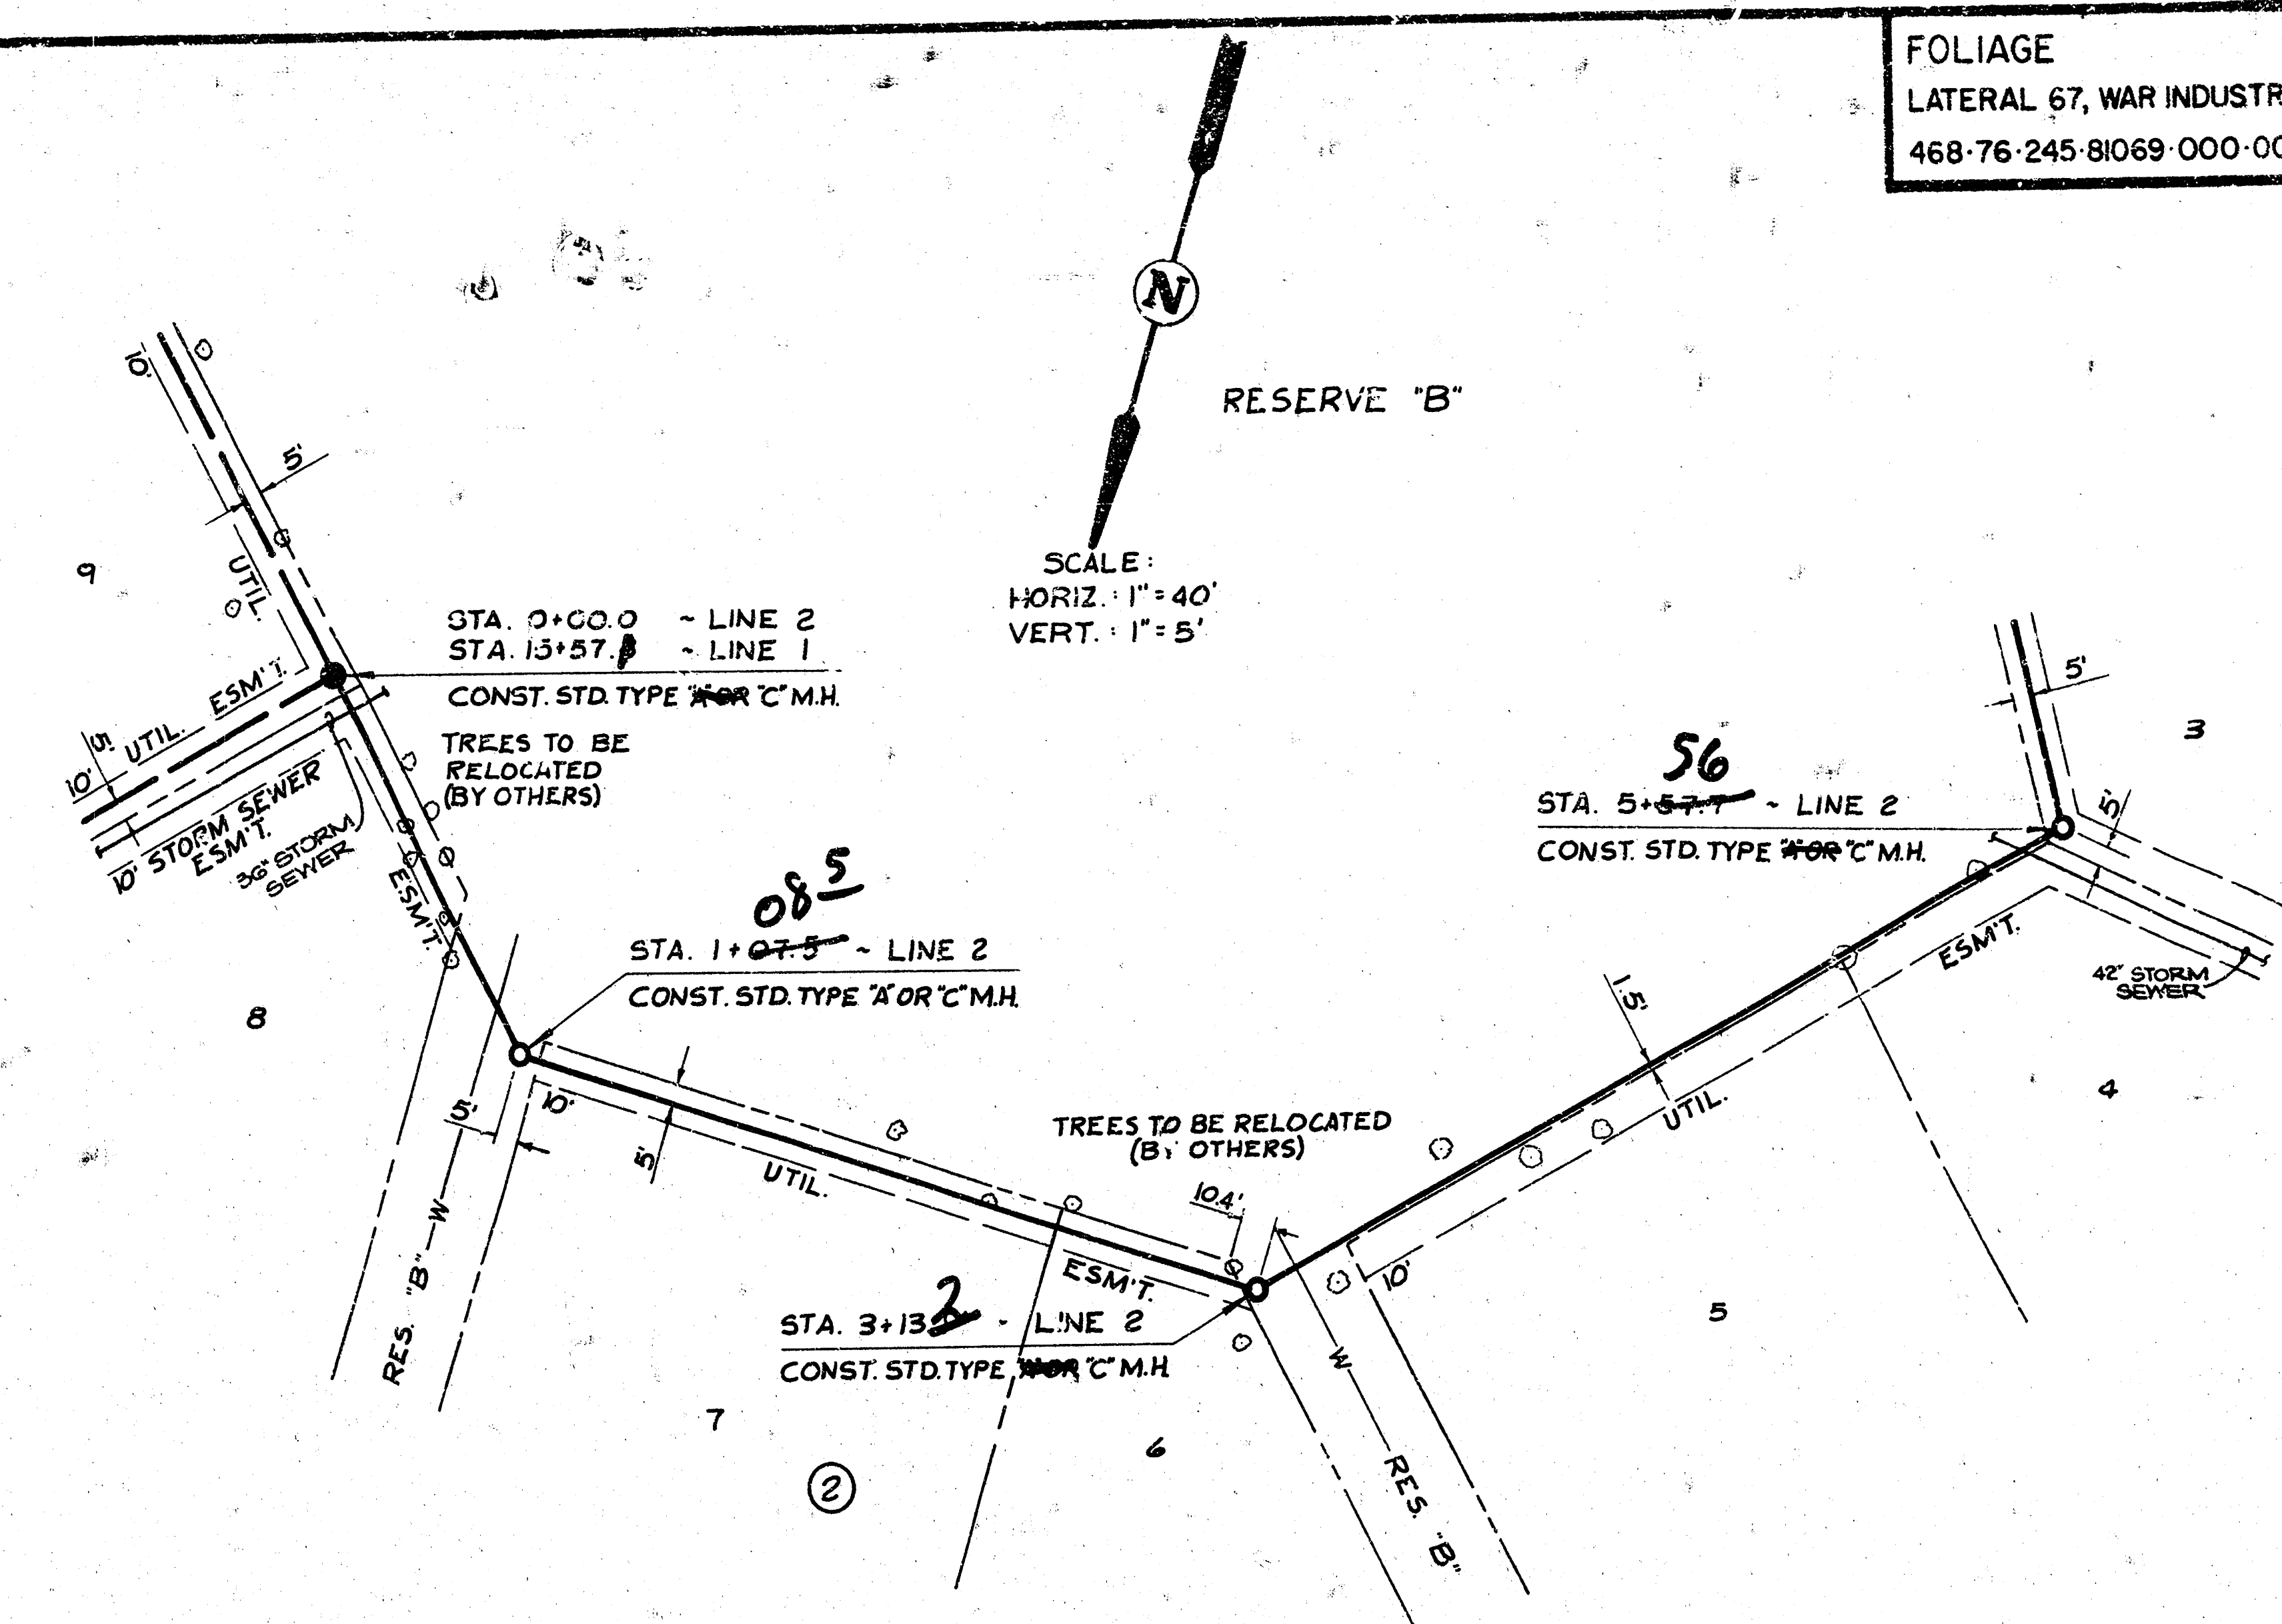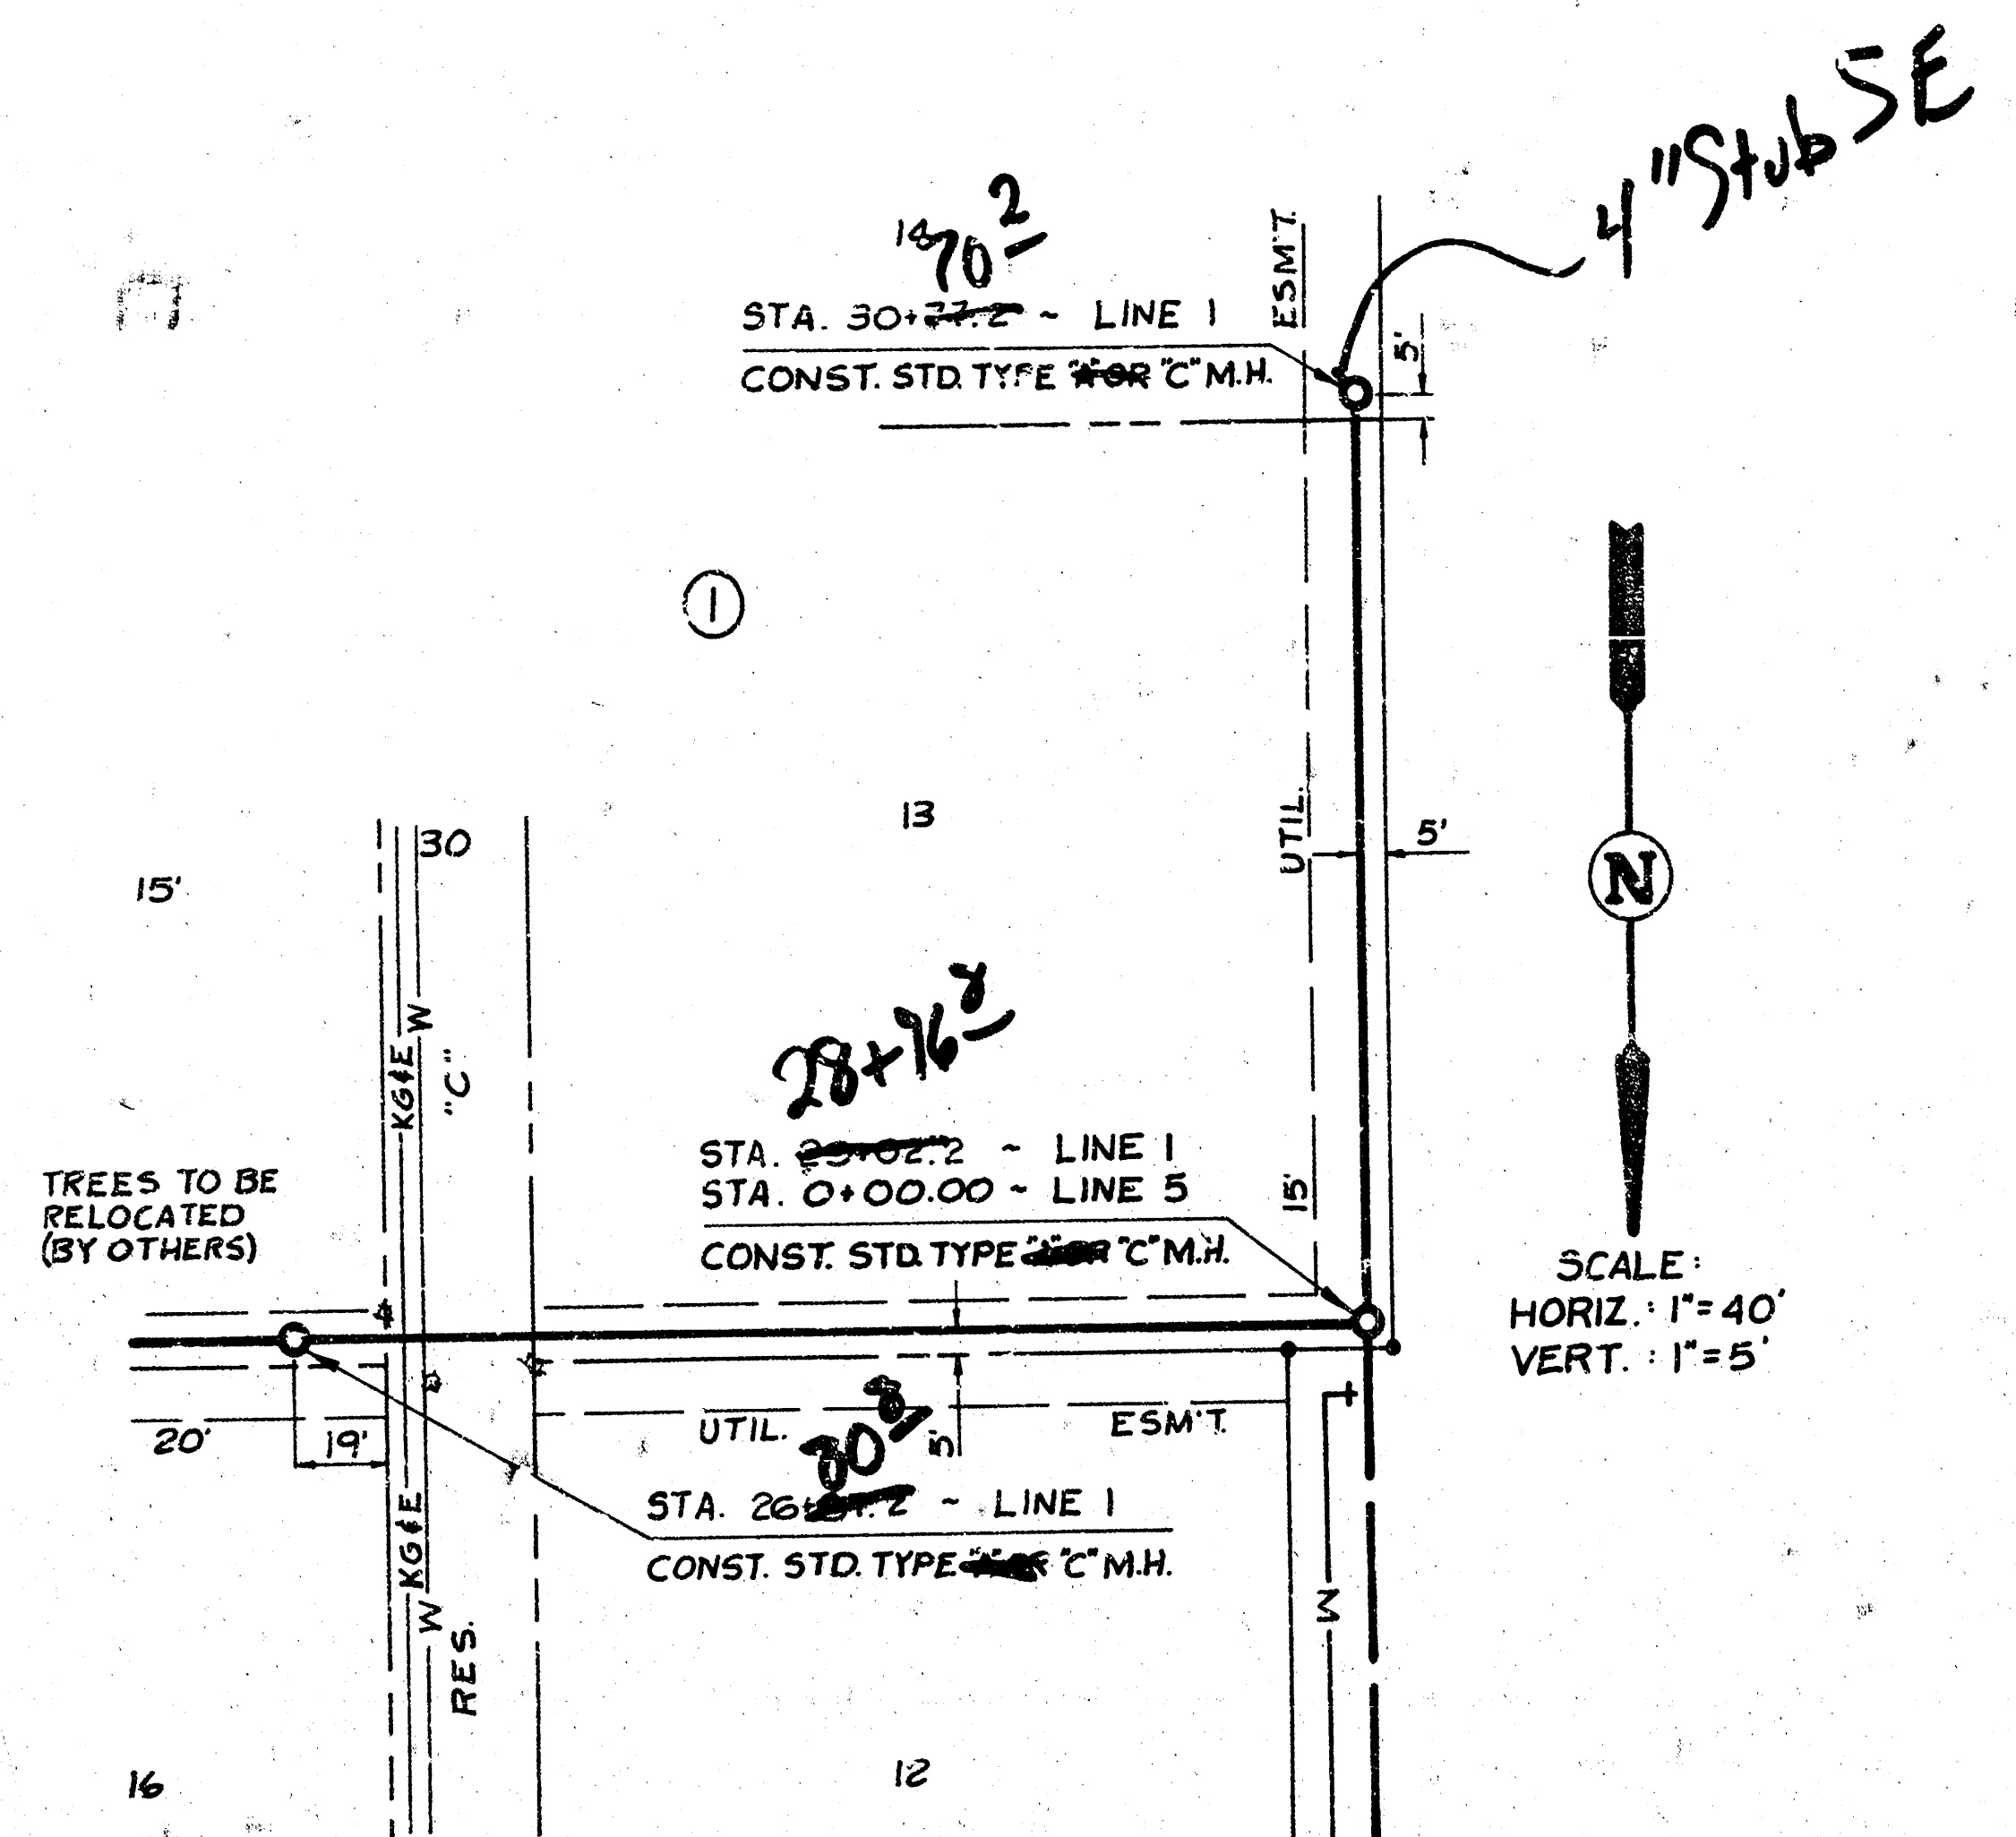





FOLIAGE
LATERAL 67, WAR INDUSTRIES SEWER
468-76-245-81069-000-000-001

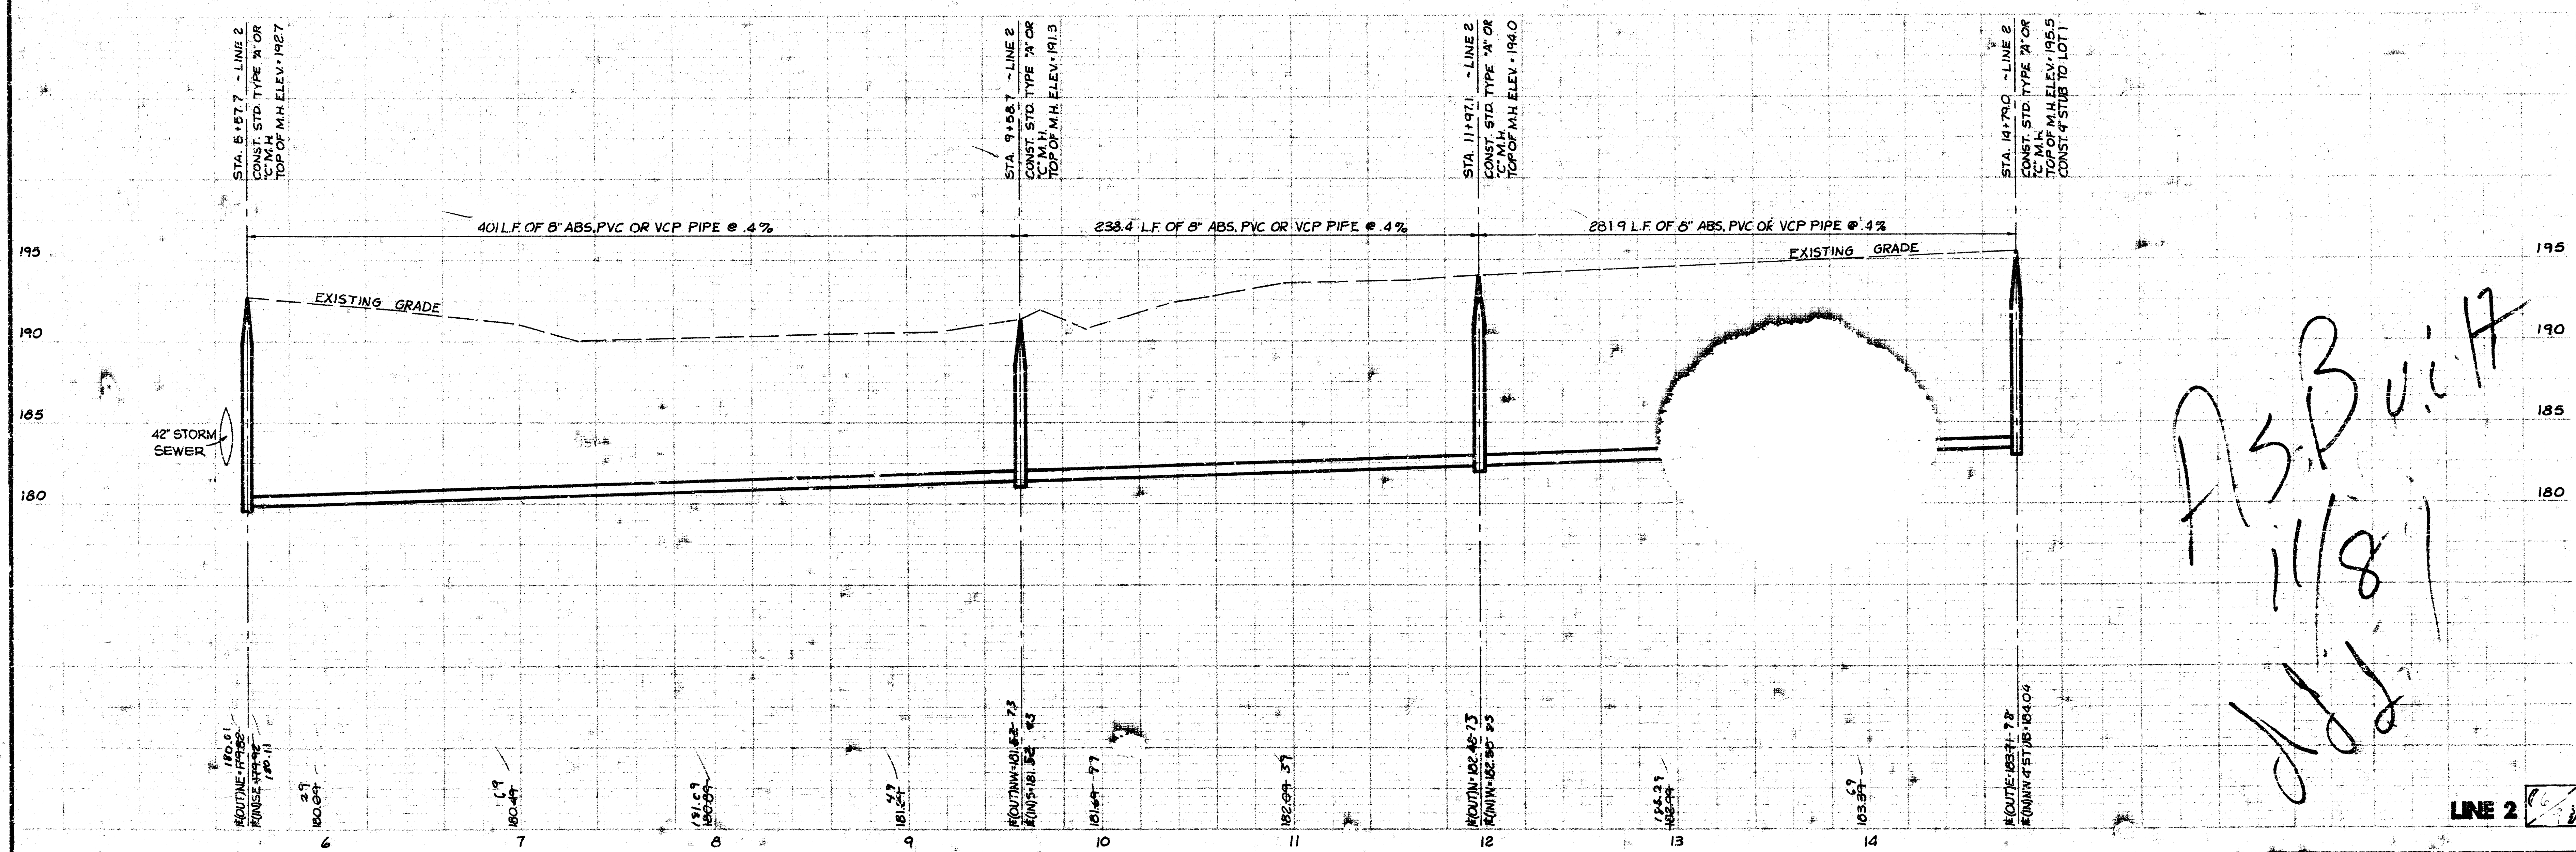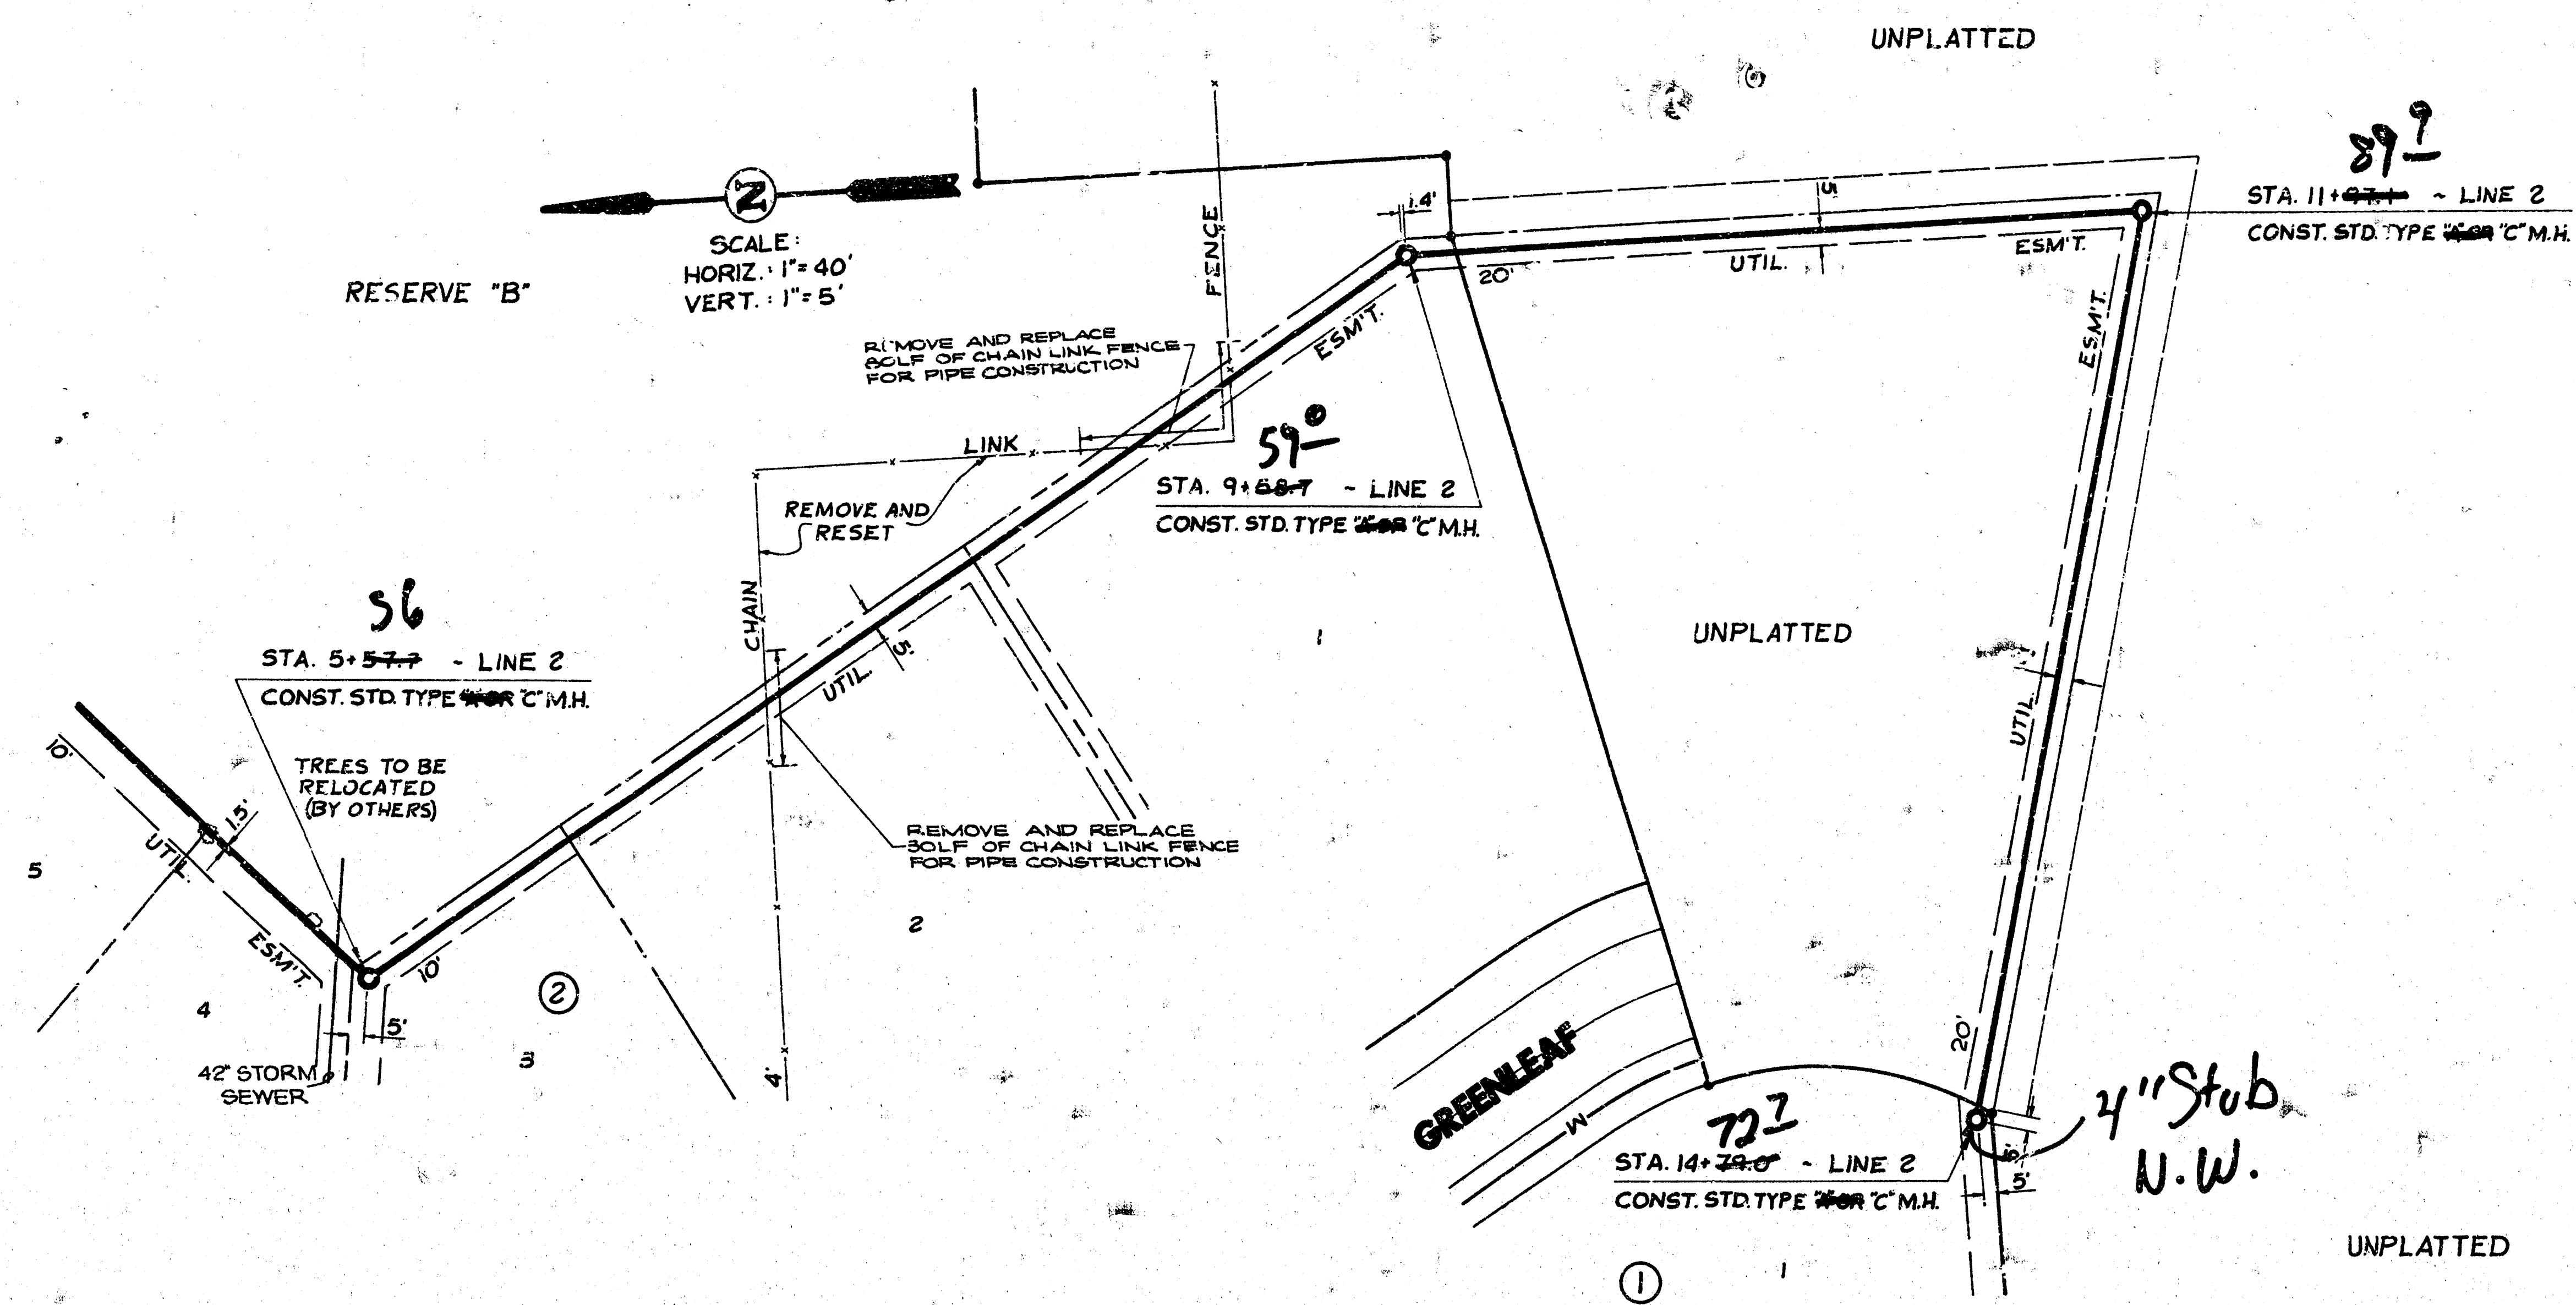

AS Built
11/8/1
dd

LINE 2


FOLIAGE
LATERAL 67, WAR INDUSTRIES SEWER
468-76-245-81069-000-000-001

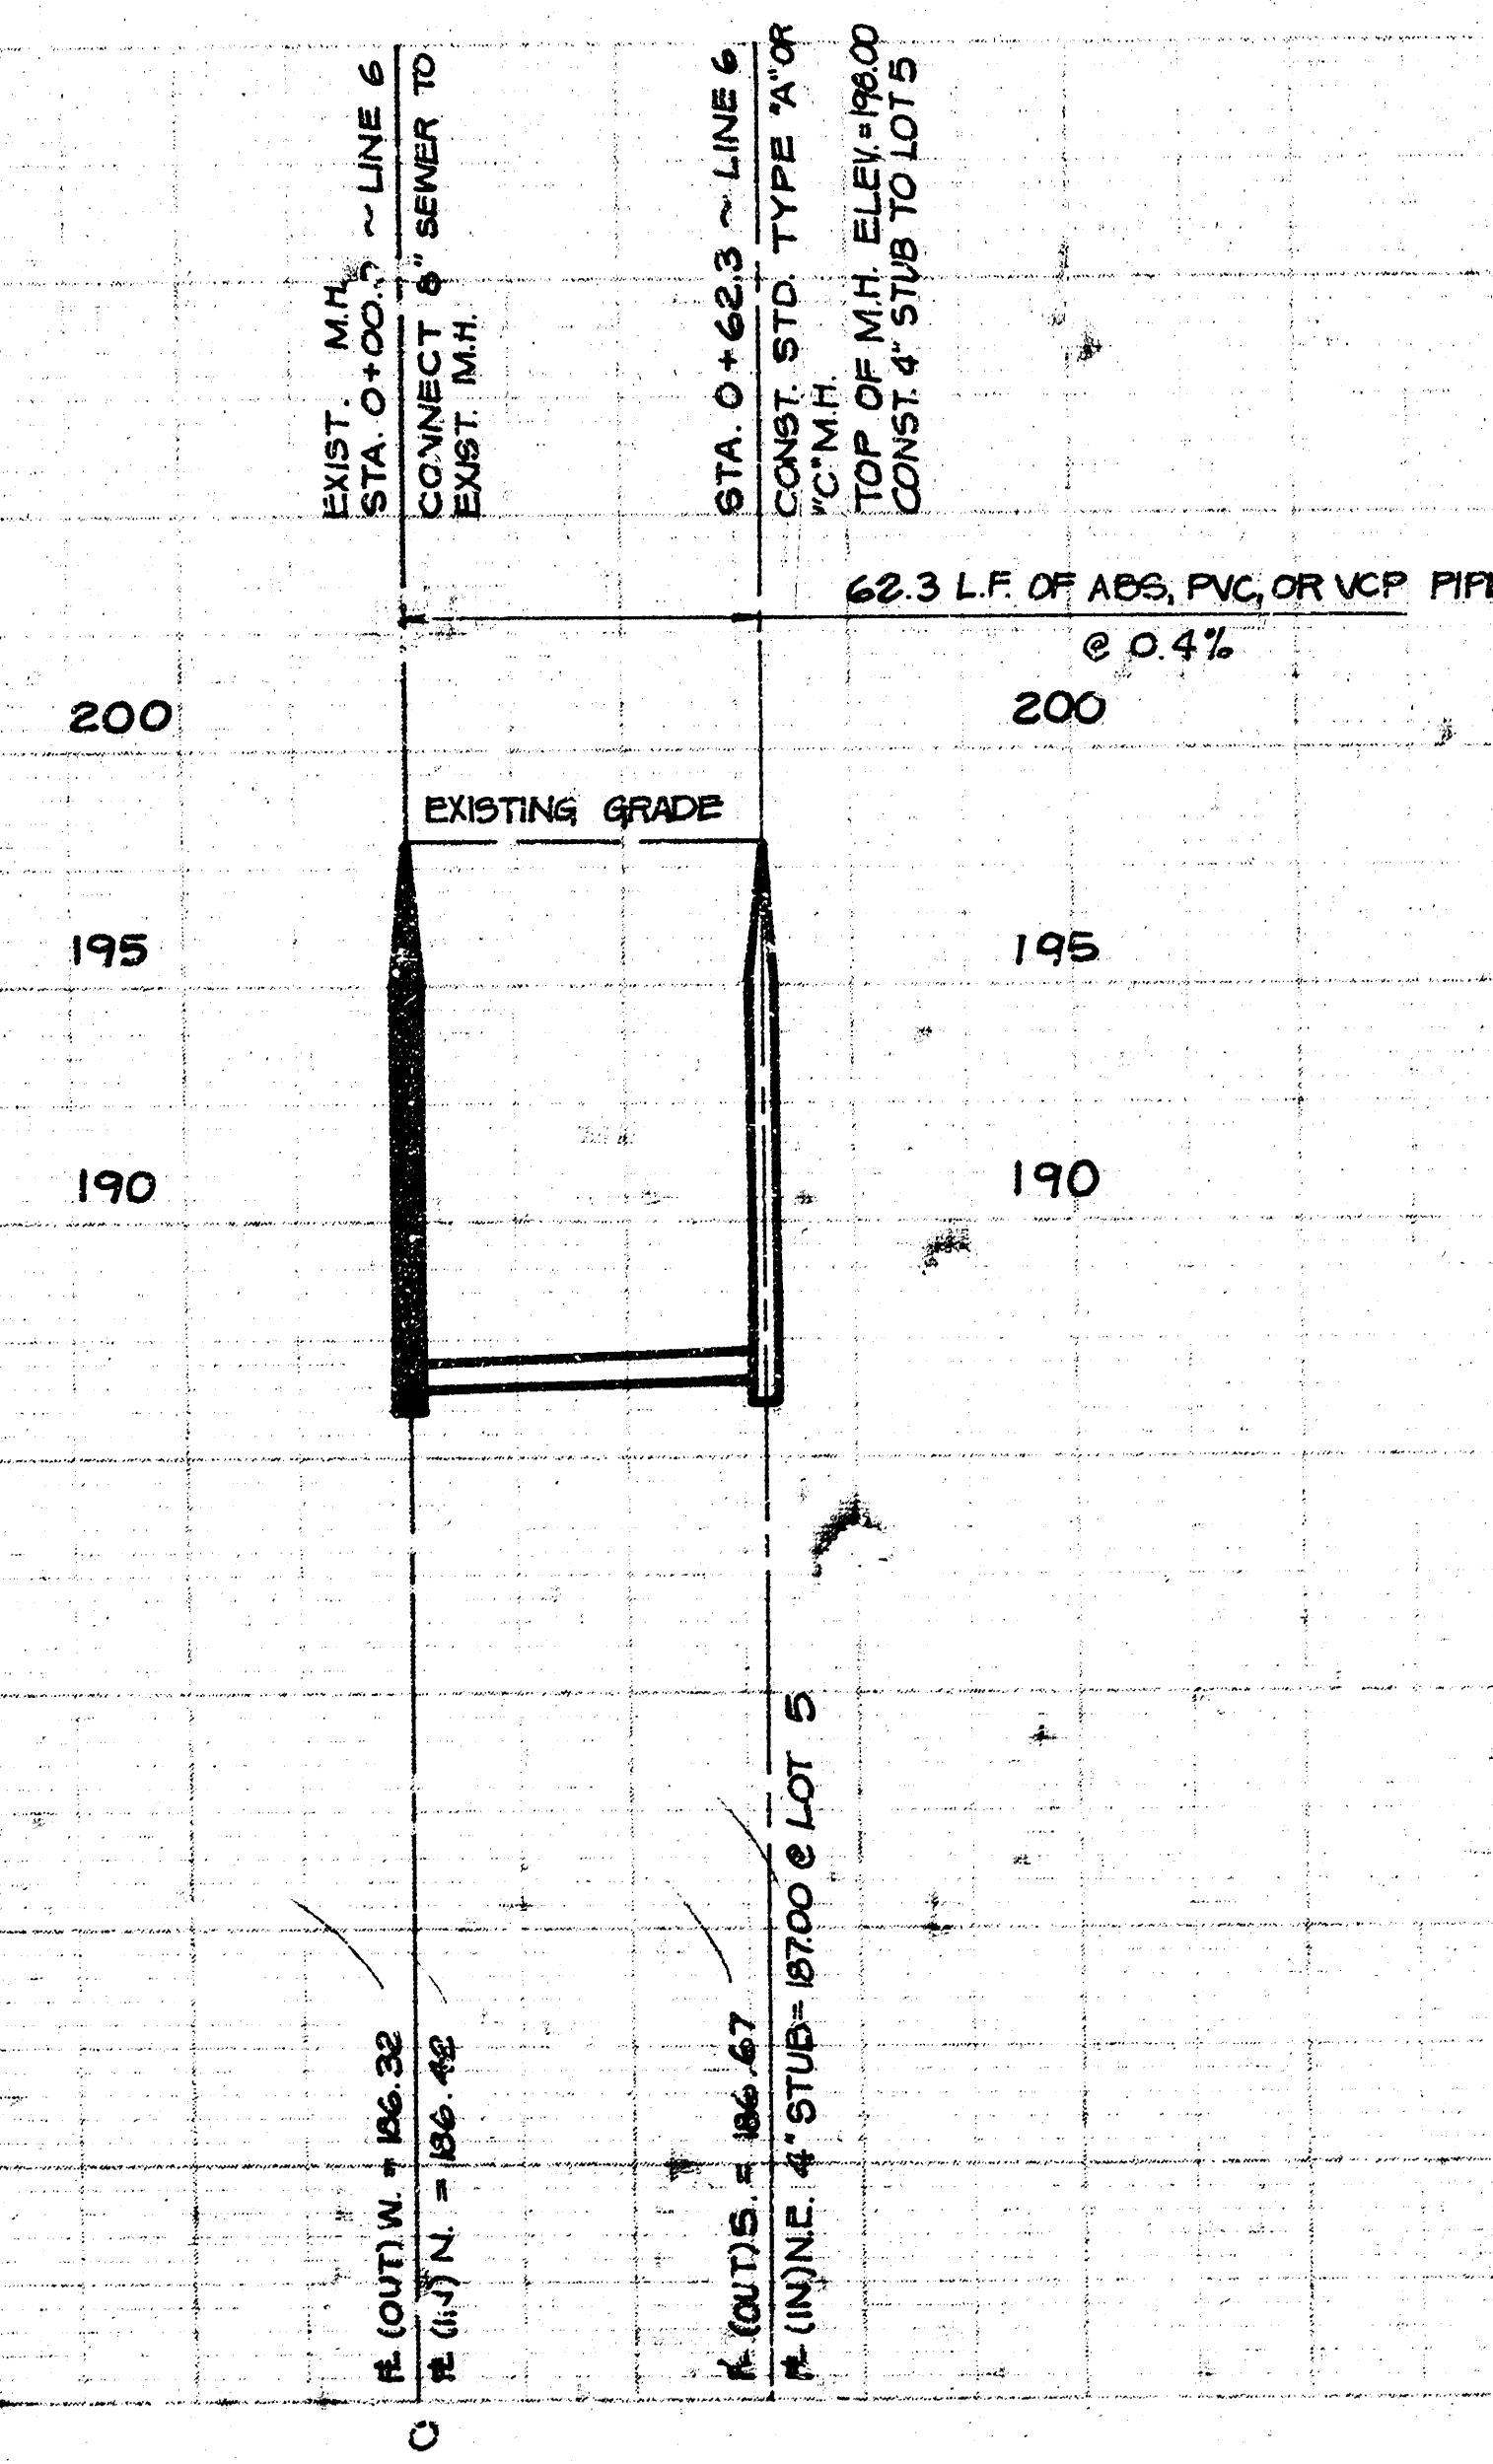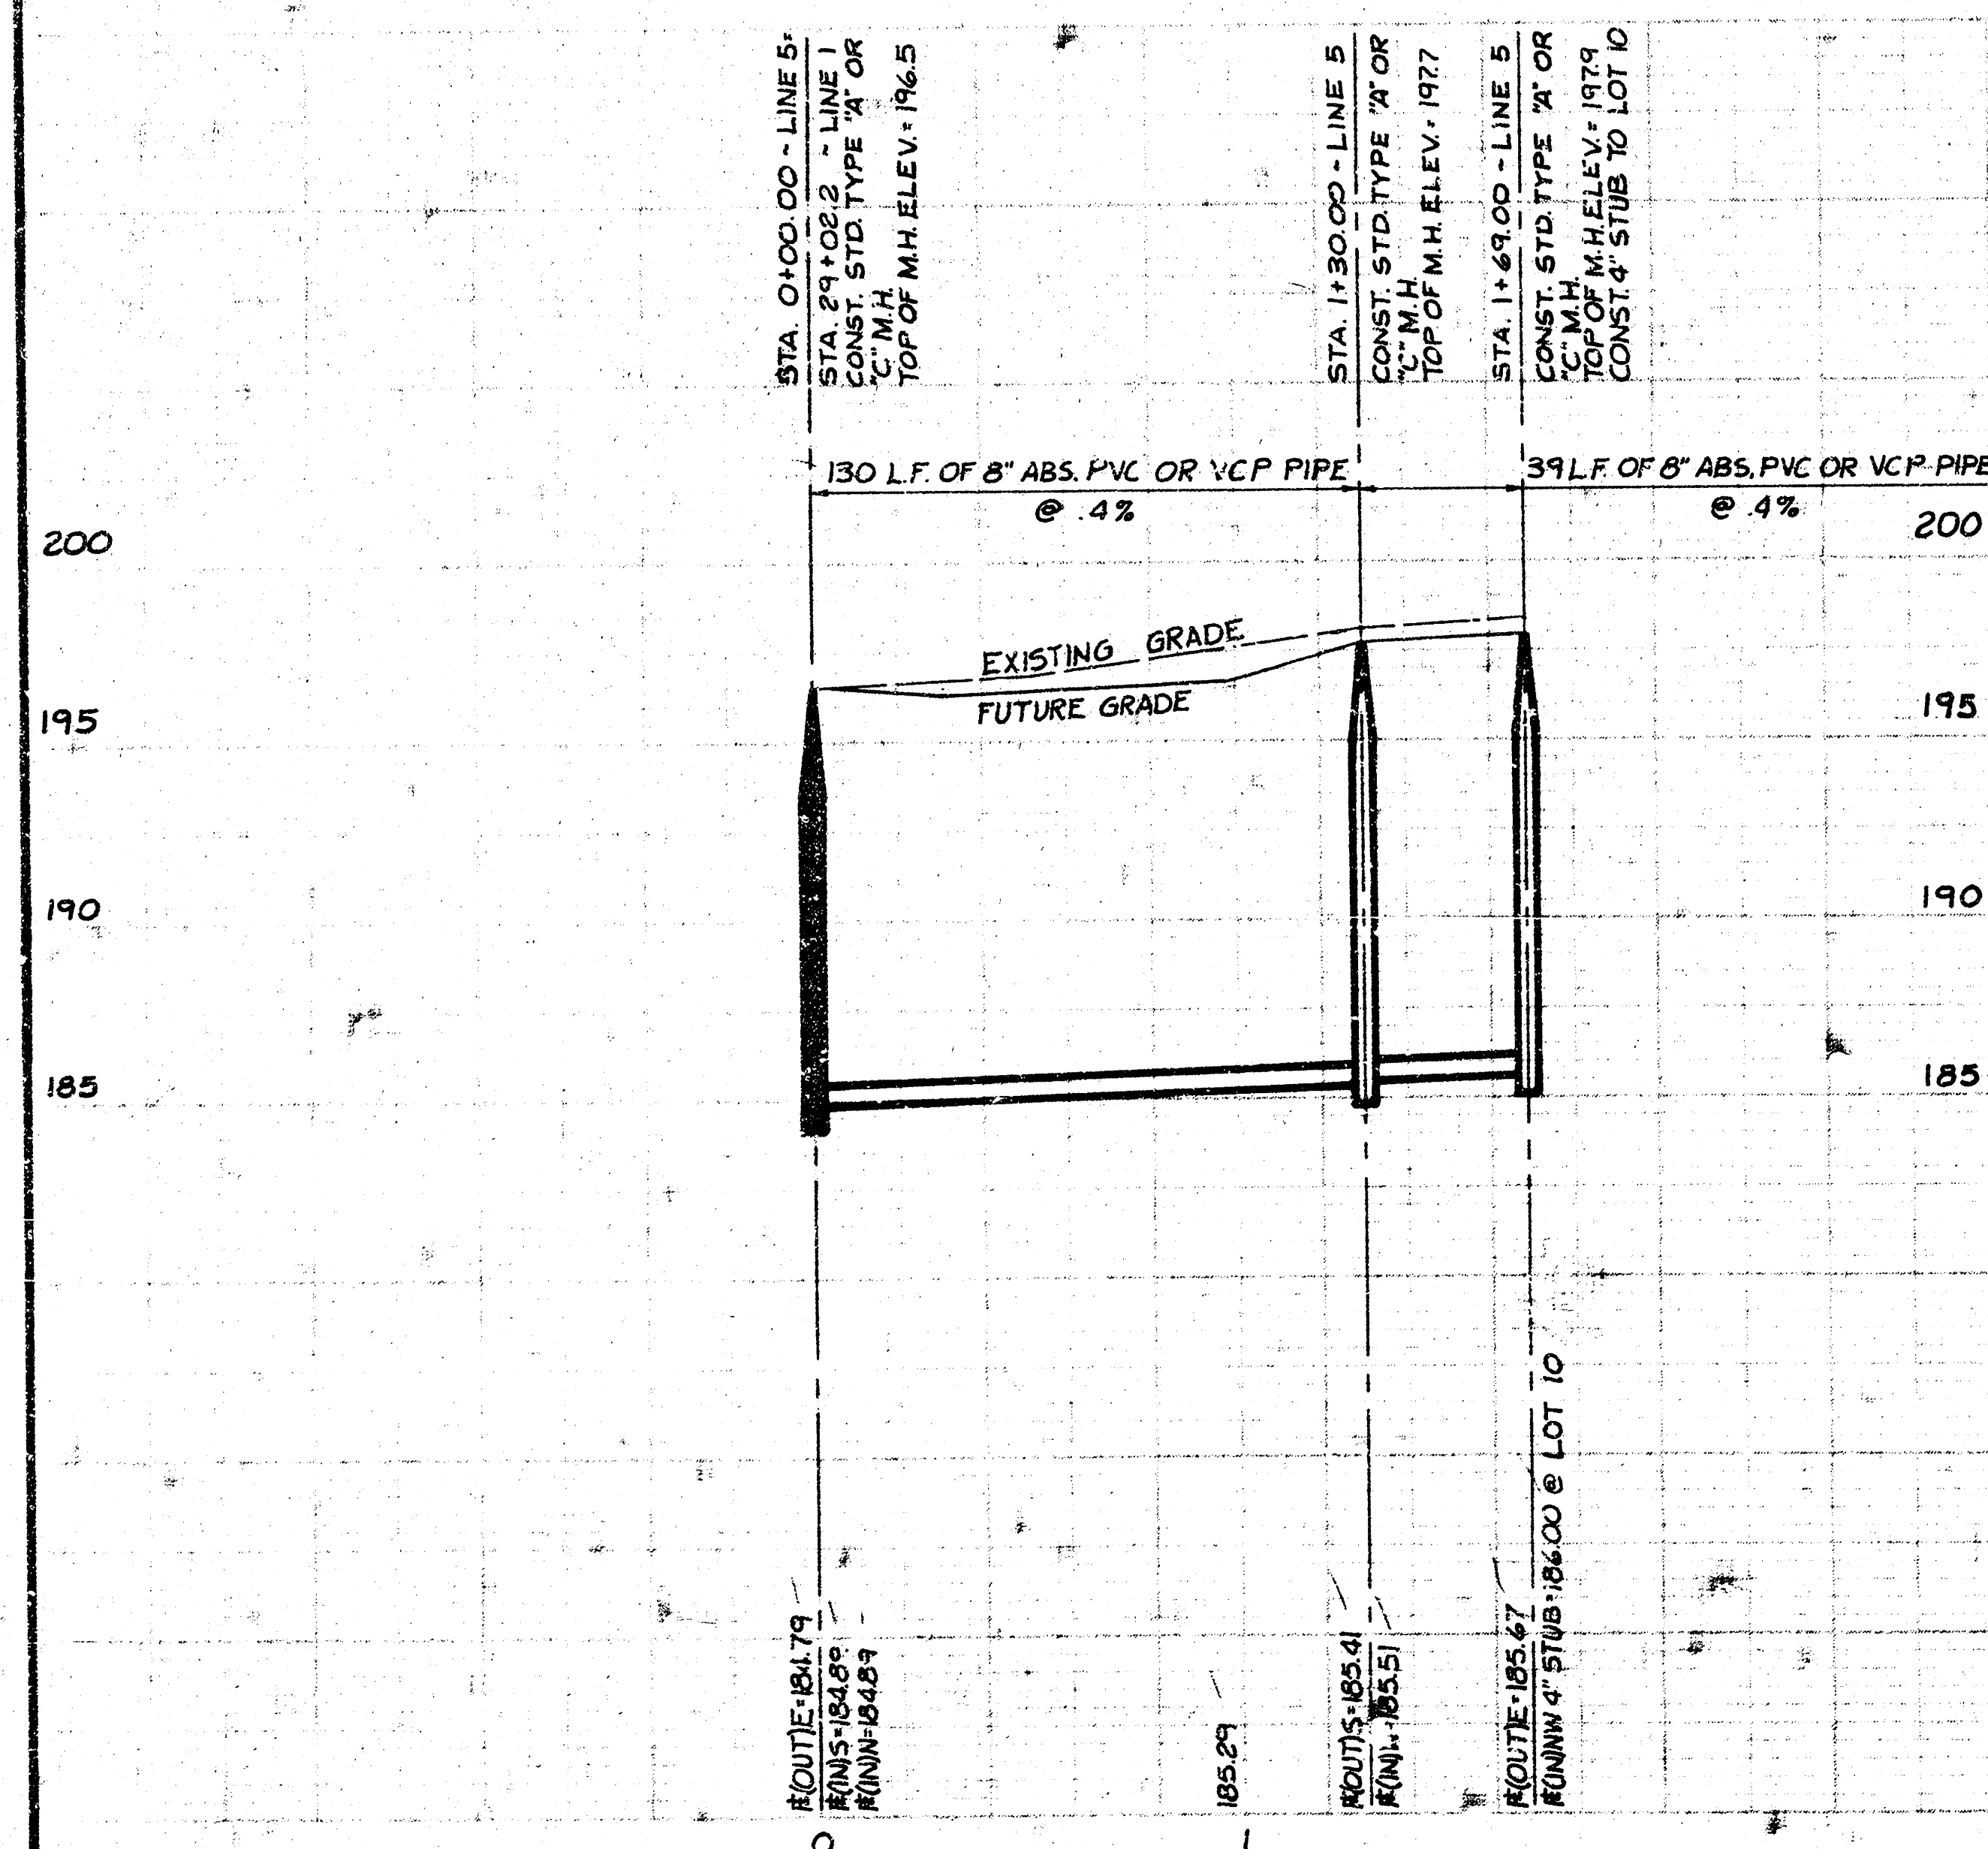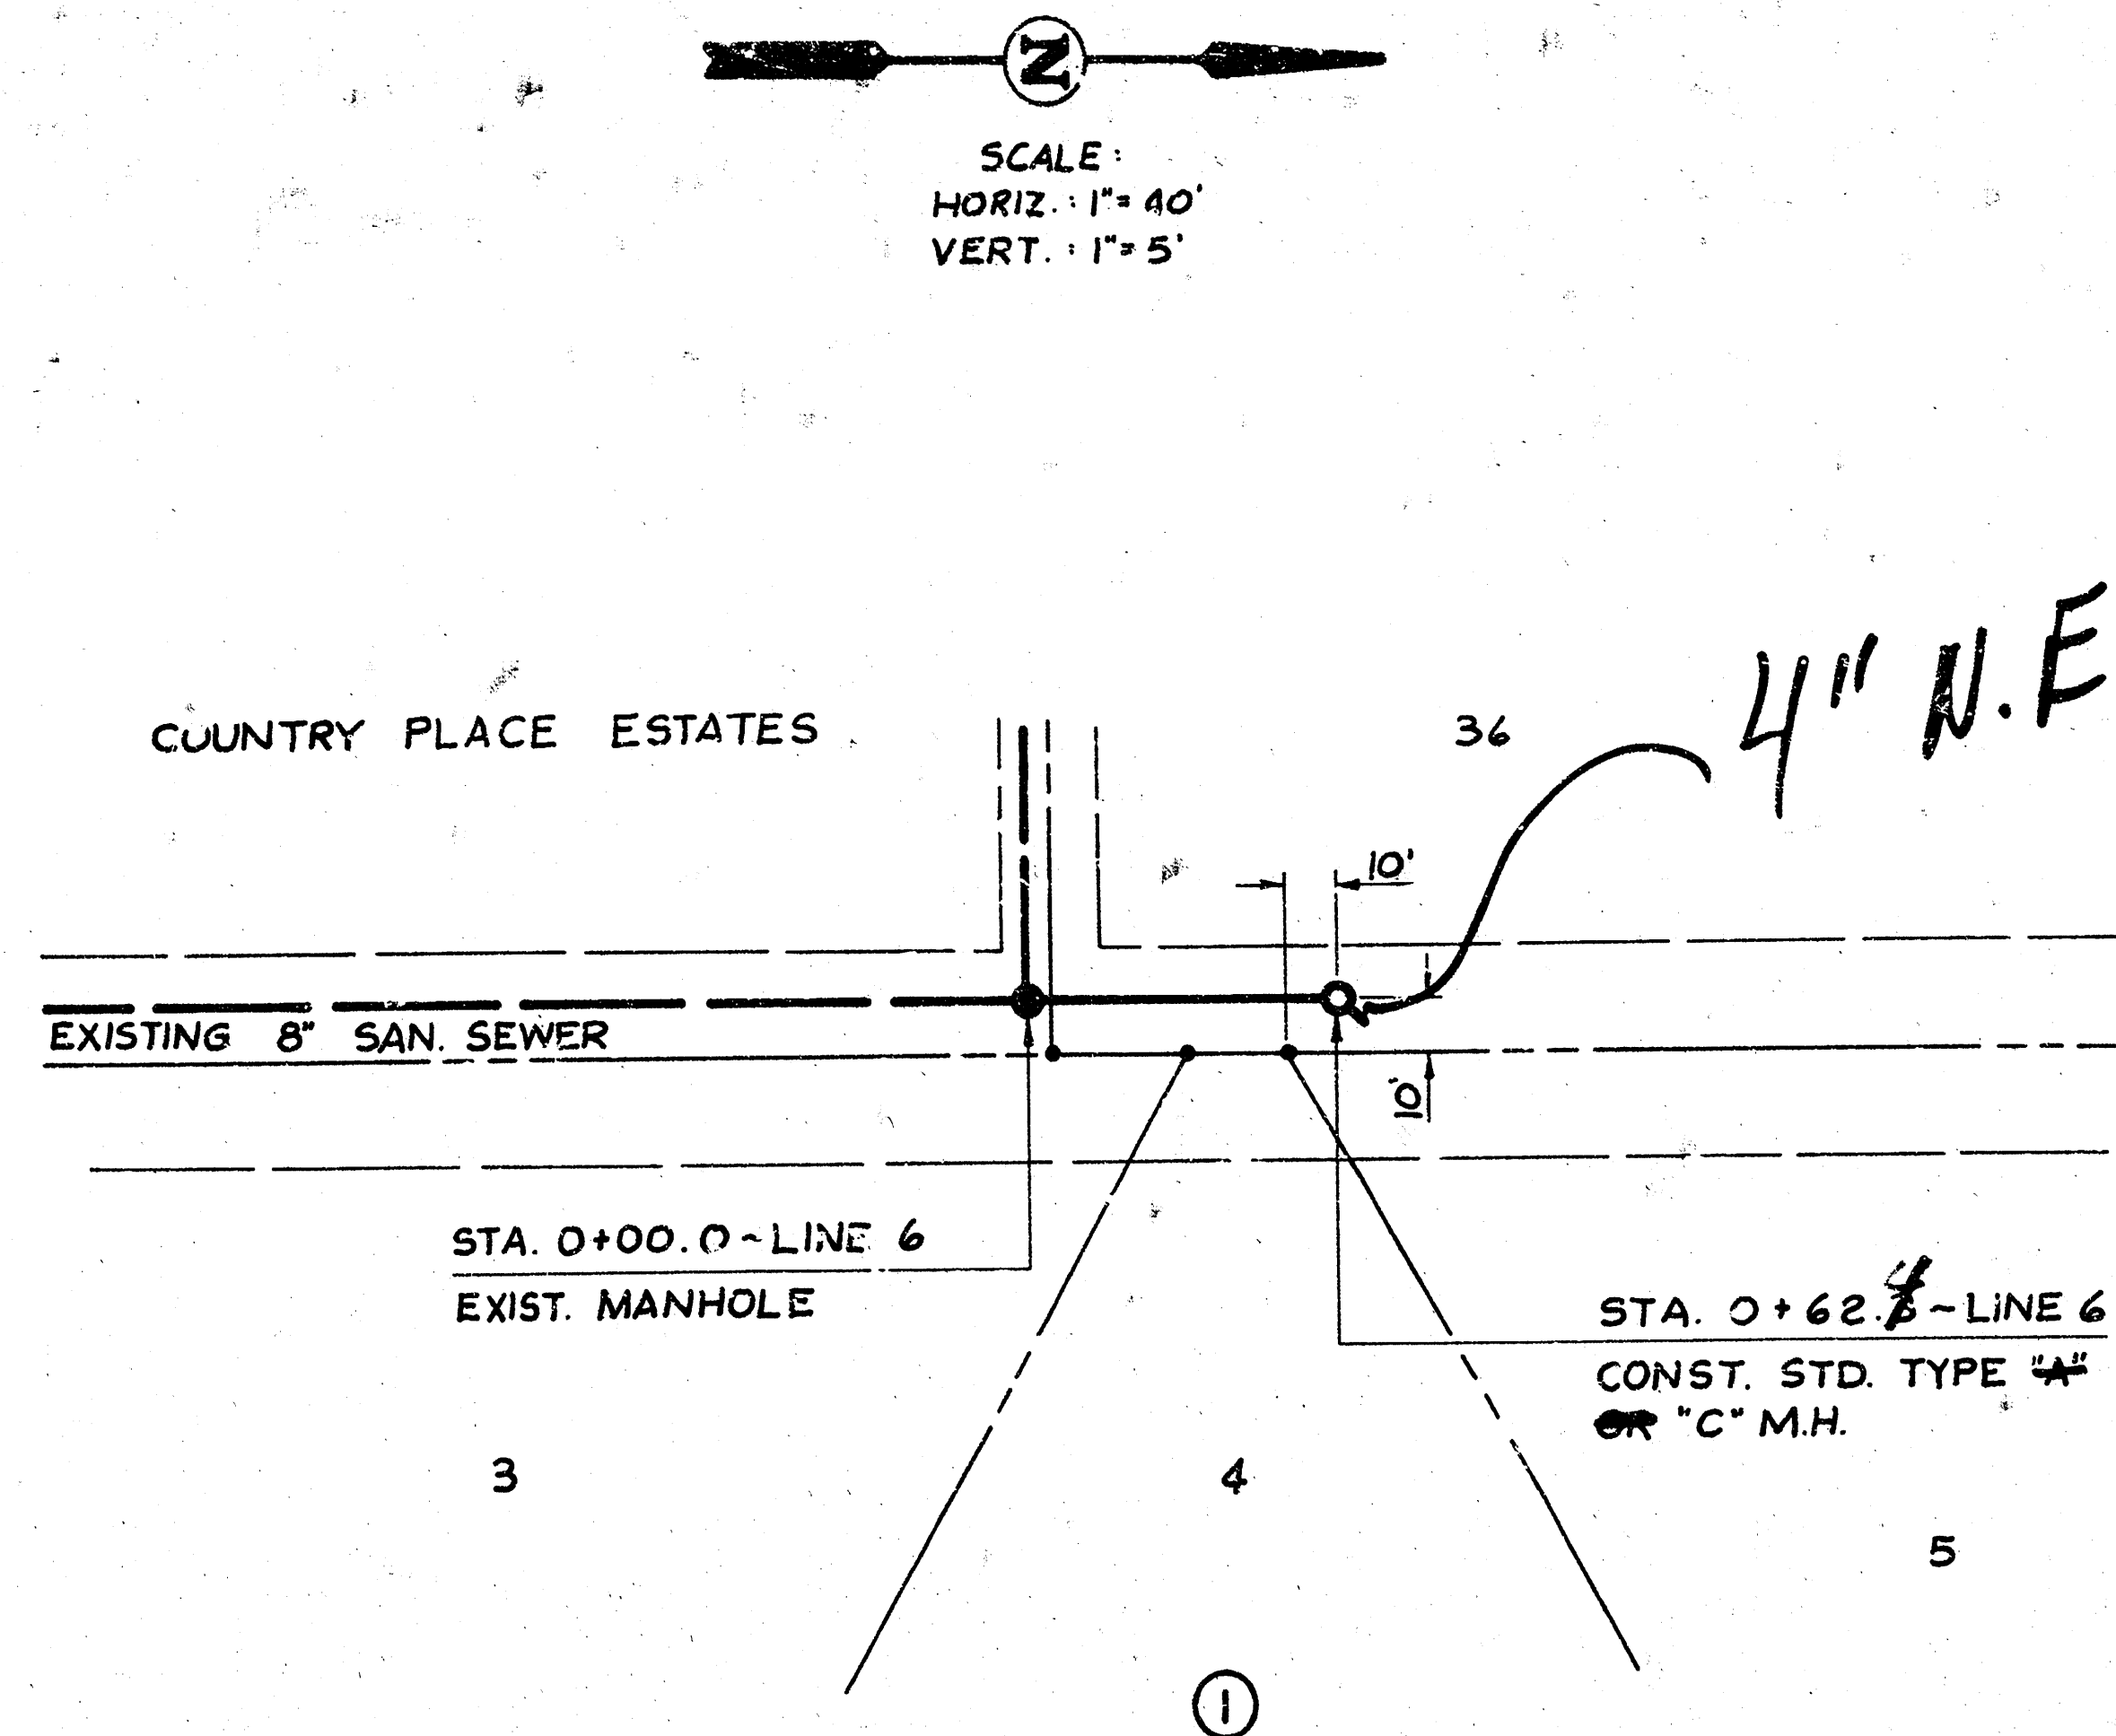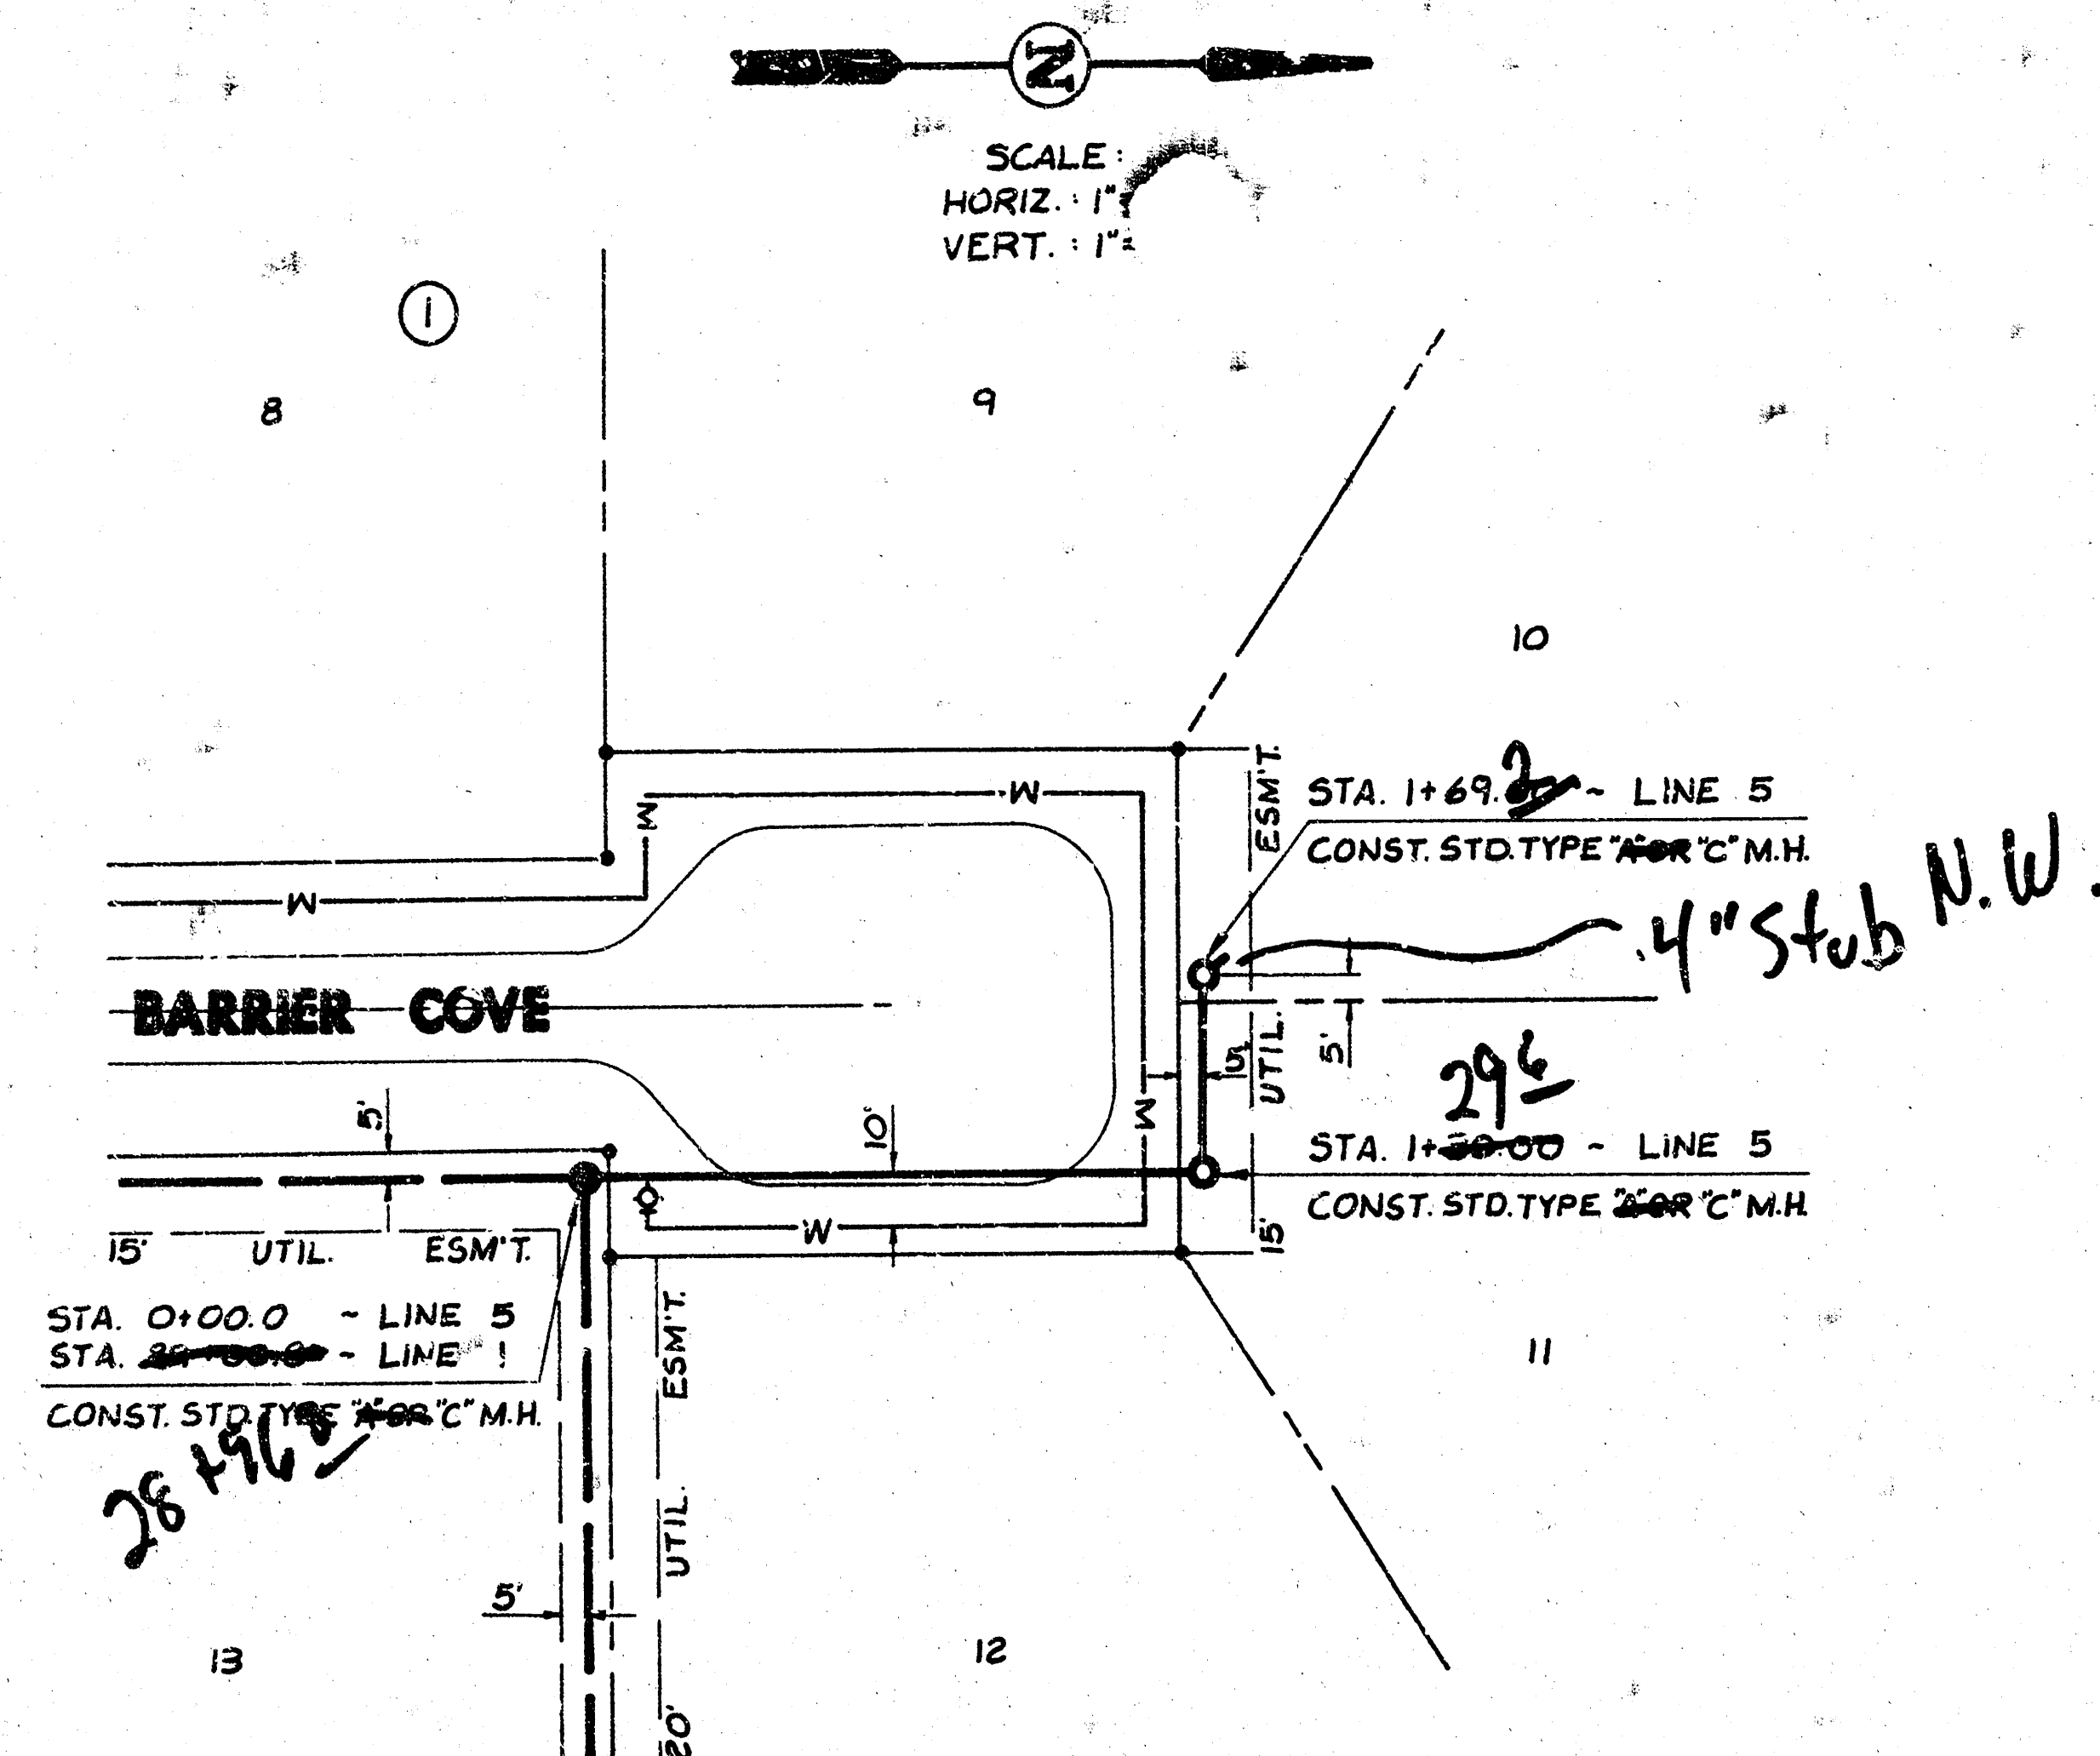

As Built
JSS
11/81

LINE 6
LINE 5

AN ADDITION TO SEDGWICK COUNTY, KANSAS

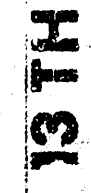[illegible]

10

[illegible]

STATE OF KANSAS

Public

Dated this 20TH day of NOVEMBER, 1980.

Wichita-Sedgwick County Metropolitan Area Planning Commission

Michael J. Chalmers

Robert A. Lakin

100

This plat approved and all dedications shown hereon, is by the Board of County Commissioners of Sedgewick County

27

[Handwritten signature]

LIBRARY OF CONGRESS

West. Charlotte & White, (cont.) Clark

Entered on Transfer record this 23 day of February 1981.

Reading is a pleasure
Joseph H. White

[Faint handwritten notes at bottom left]

THE UNIVERSITY OF CHICAGO PRESS

[illegible]