

TEMPORARY LIFT STATION AND FORCE MAIN FOR LATERAL 67 WAR INDUSTRIES SEWER

PROJECT NO.
468-76-245-81070-000-000-001


CITY OF WICHITA, KANSAS
R. W. BRUGGEMAN, CITY ENGINEER
MARCH, 1981
FOLIAGE

LEGEND

PROPOSED LINE _____

EXISTING LINE - - - - -

BENEFIT DISTRICT BOUNDARY = = = = =

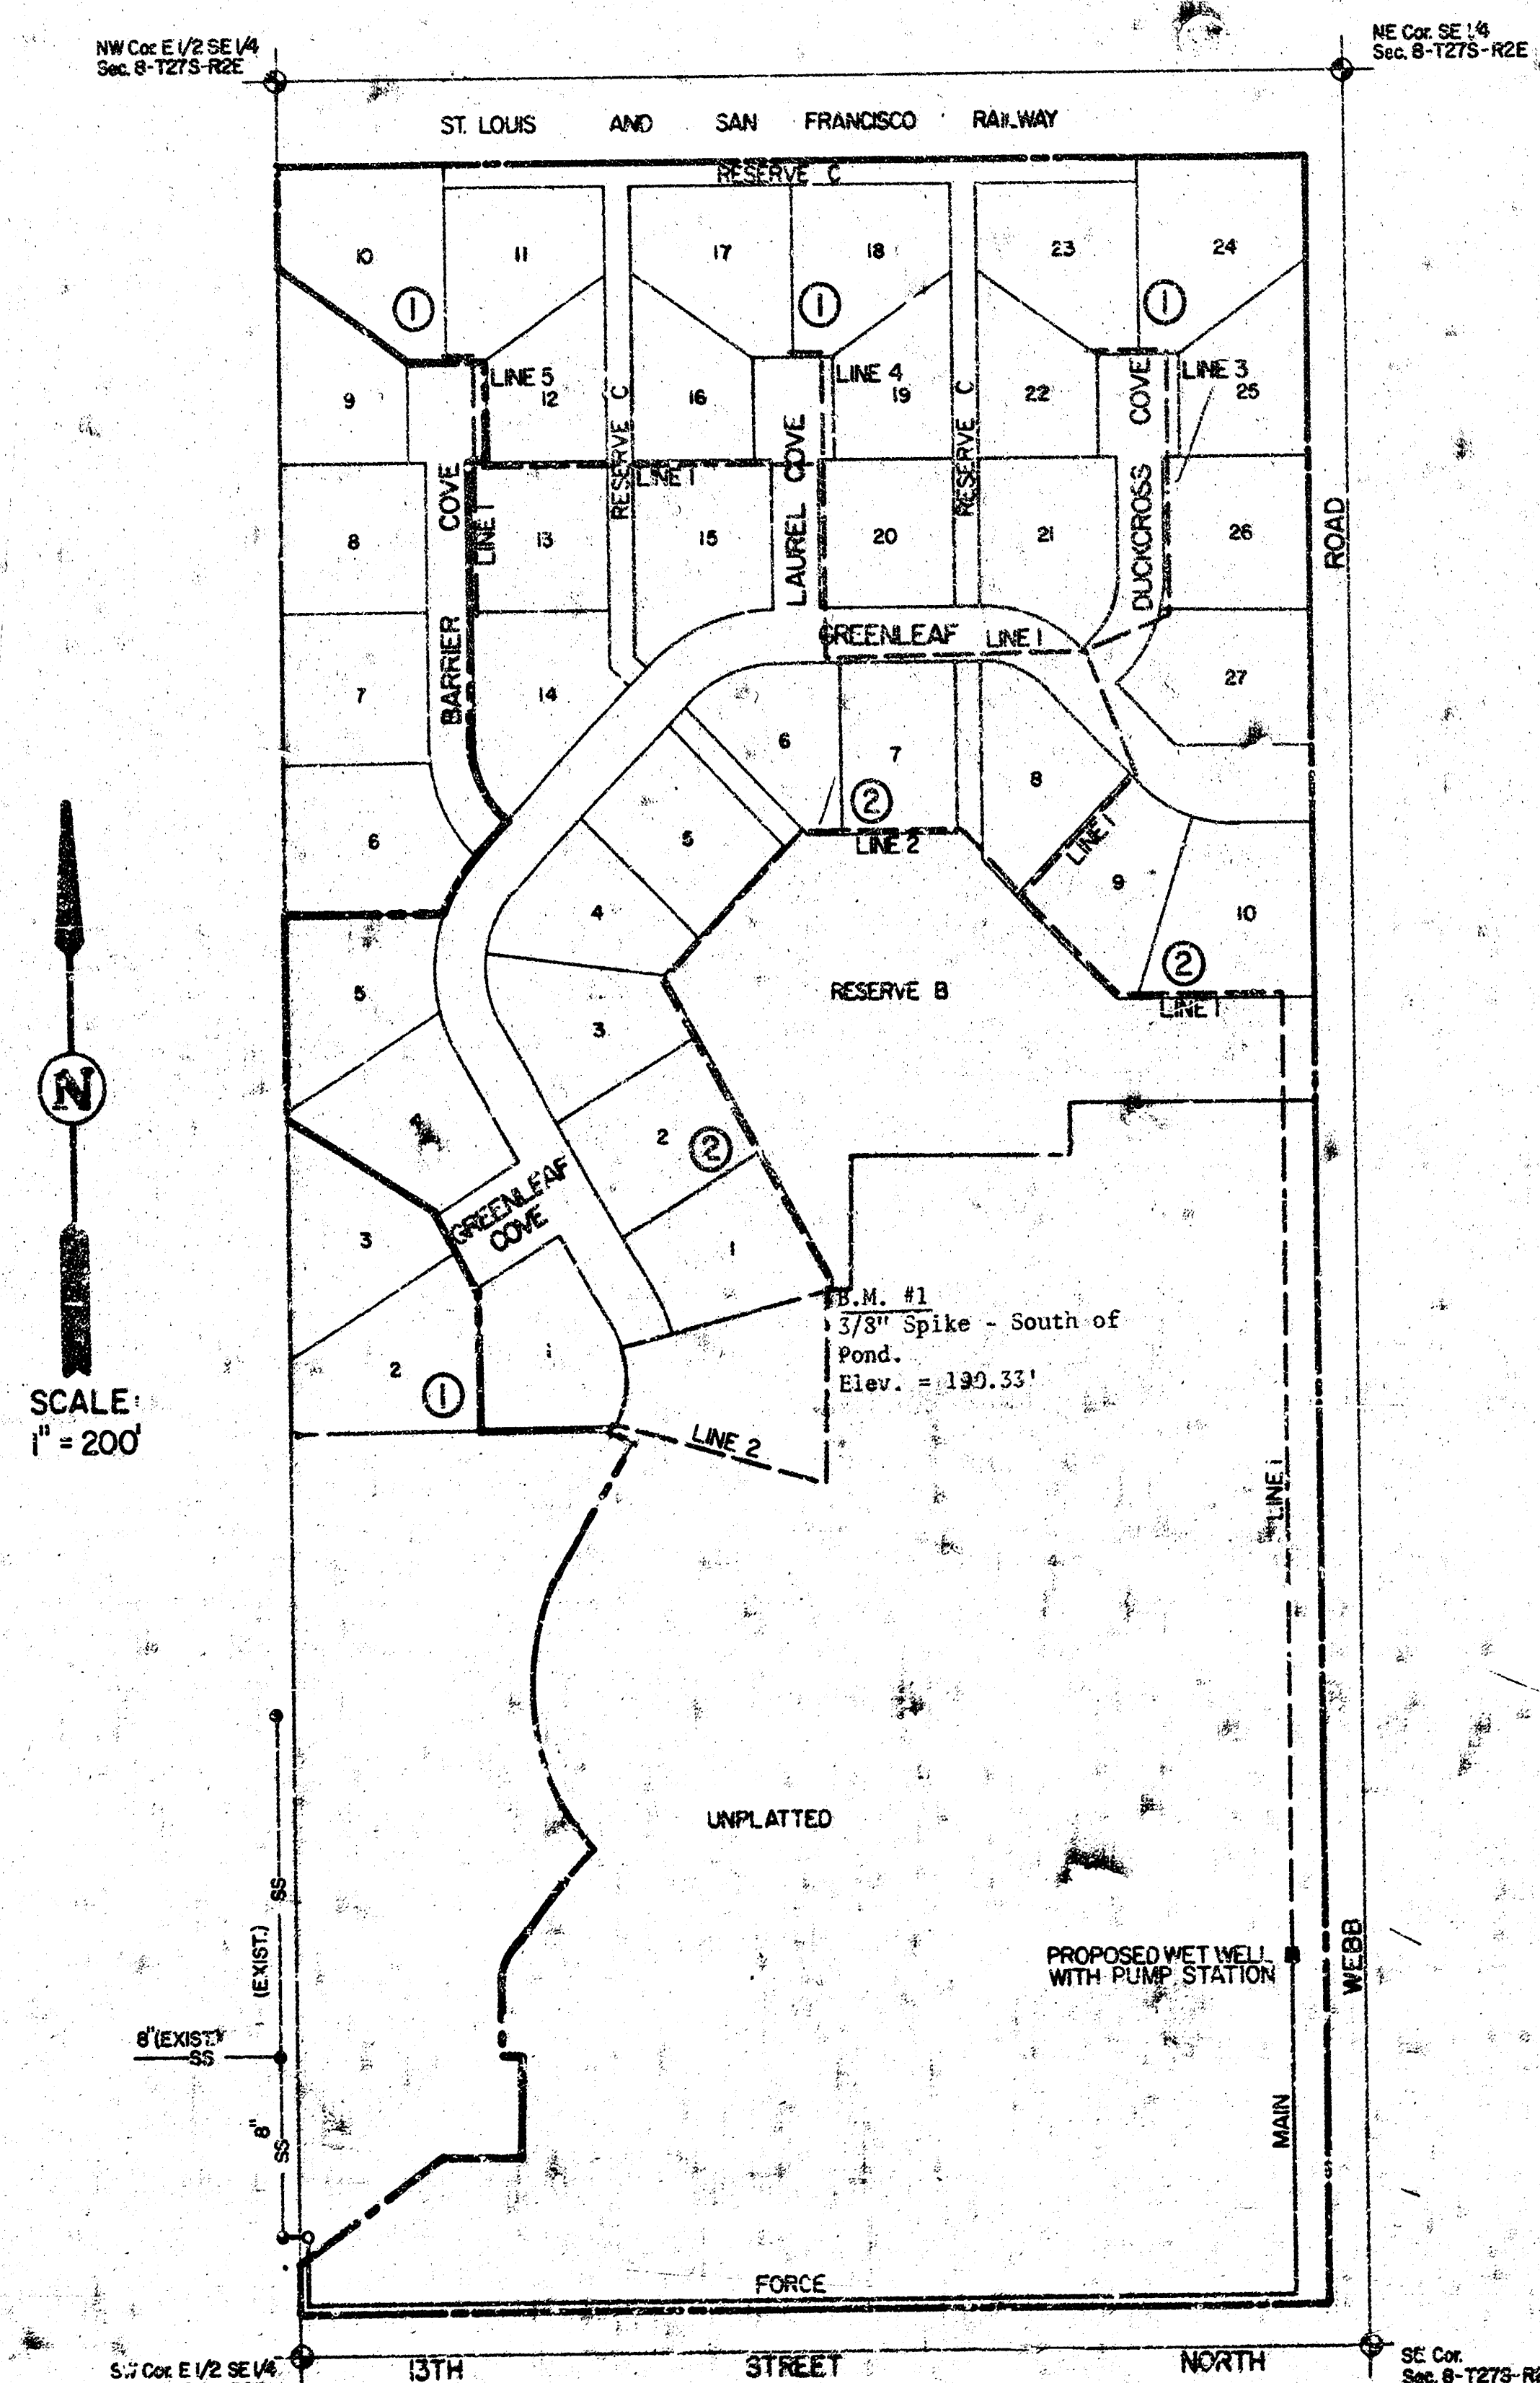

INDEX	TO	DRAWINGS
SHEET NO.		DESCRIPTION
1		COVER SHEET
2-3		FORCE MAIN
4		PUMP STATION DETAILS

NOTE : CONTRACTOR MUST OBTAIN ALL
BUILDING AND ELECTRICAL PERMITS
FROM SEDGWICK COUNTY.

As Built
J.L.L.
8-82


*Revised 11/16/81 move pump sta. north
shifted force main south*




Van Doren Hazard Stallings
Architects-Engineers-Planners
Topeka - Wichita - Minneapolis - Kansas City

Sheet 1
of 4

FOLIAGE
LAT. 67, WAR IND. SEW. (FORCE MAIN)
468-76-245-81070-000-000-001

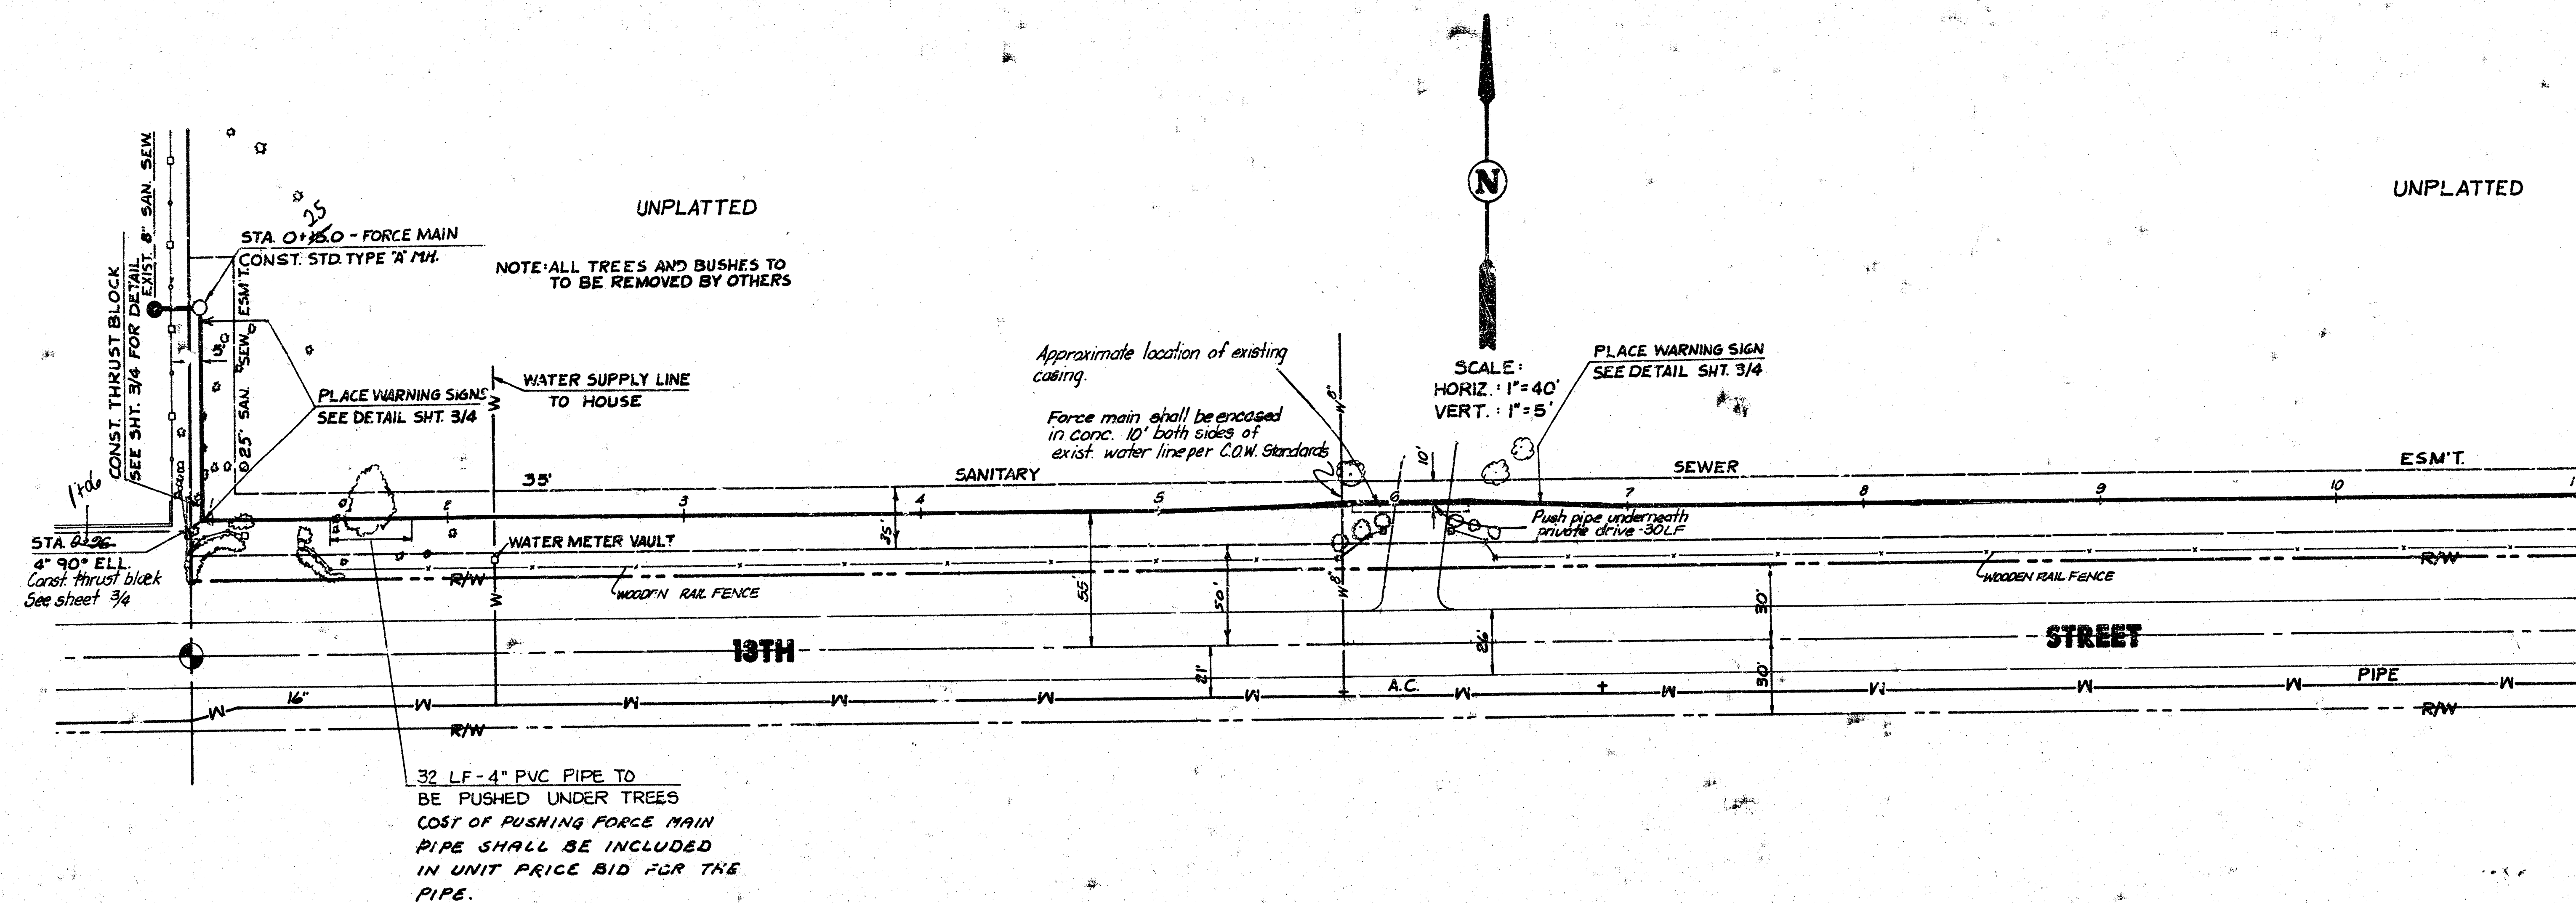

As Bui.
J.L.L.
8-82

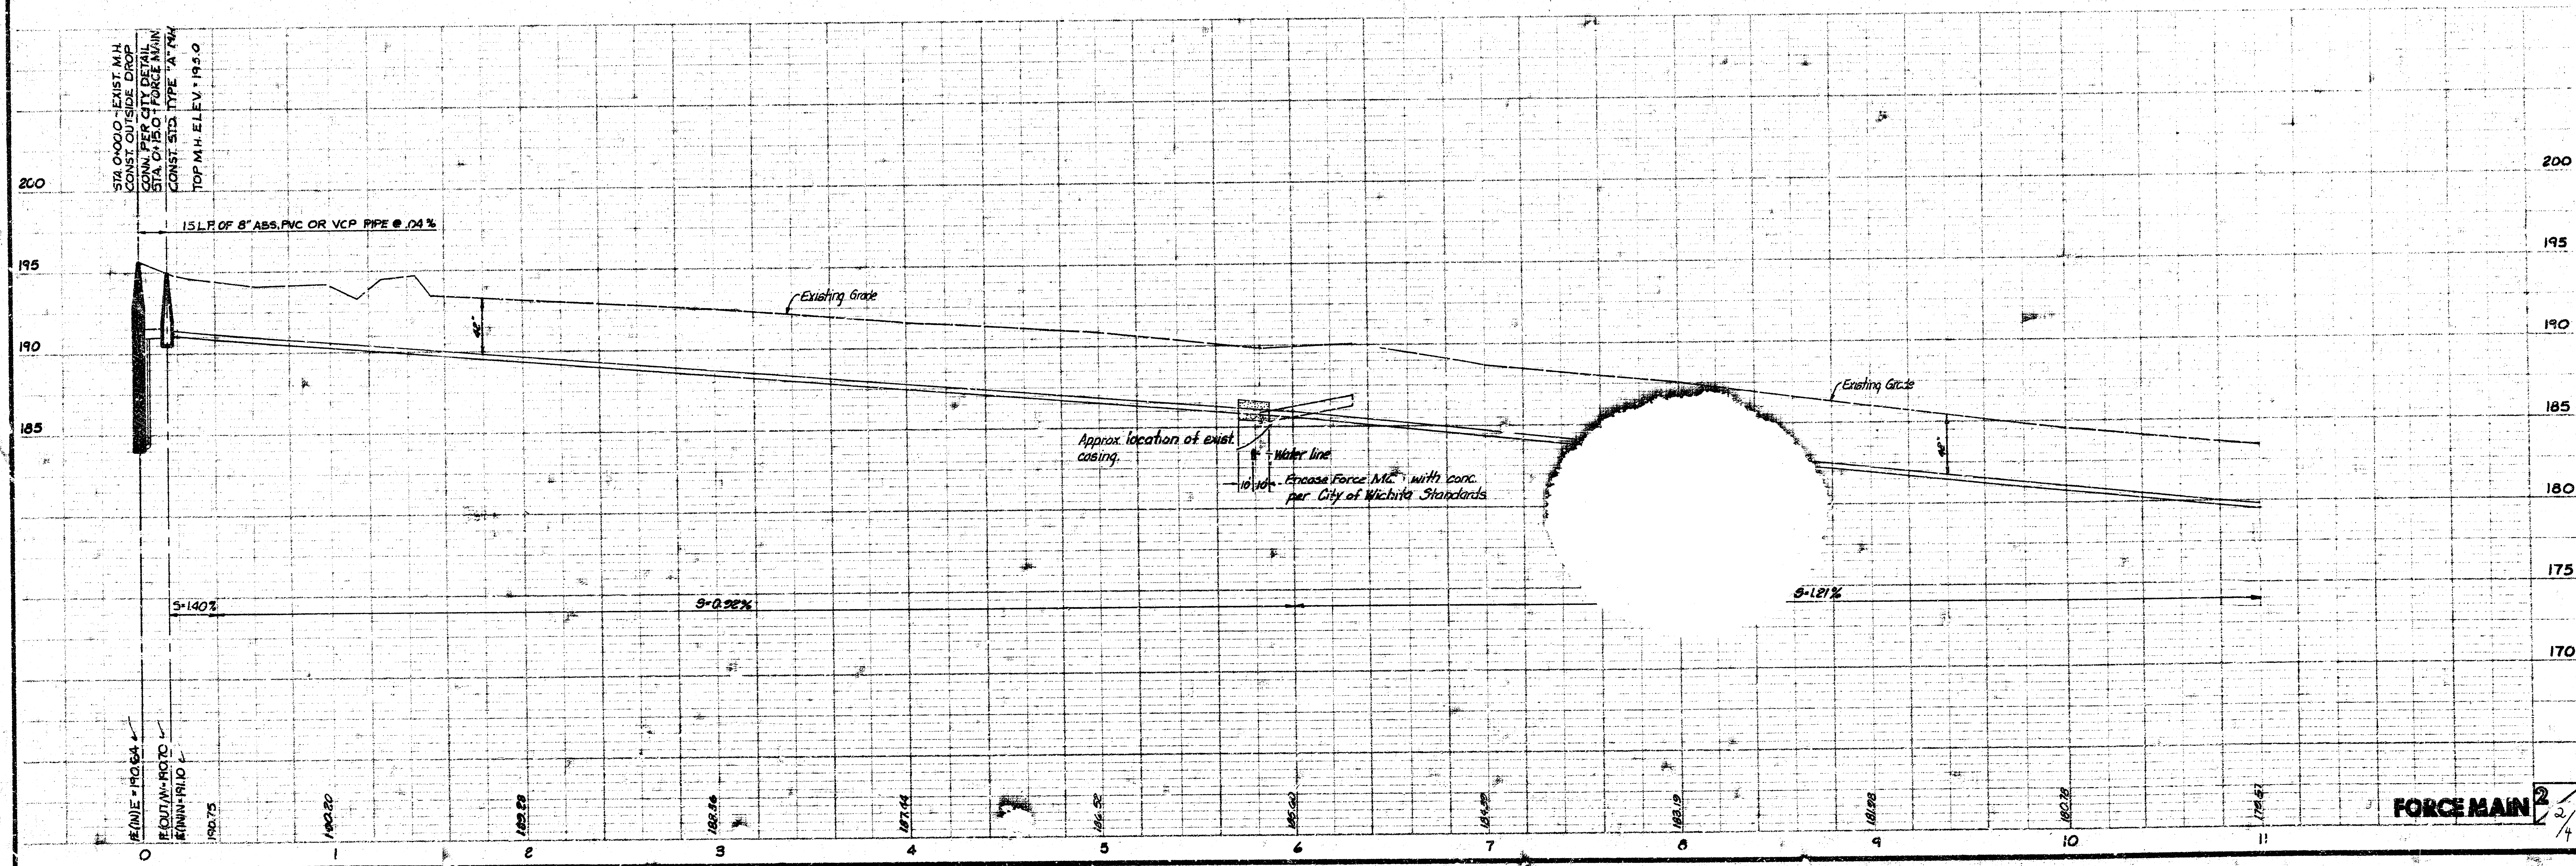

FOLIAGE
LAT. 67, WAR IN. SEW. (FORCE MAIN)
468-76-245-81070-000-000-001

