


LATERAL 71, WAR INDUSTRIES SEWER

Project no. 468-76-245-81138-000-000-001

CITY OF WICHITA, KANSAS
MIKE E. LINDEBAK CITY ENGINEER

As Built
8-82
7-85

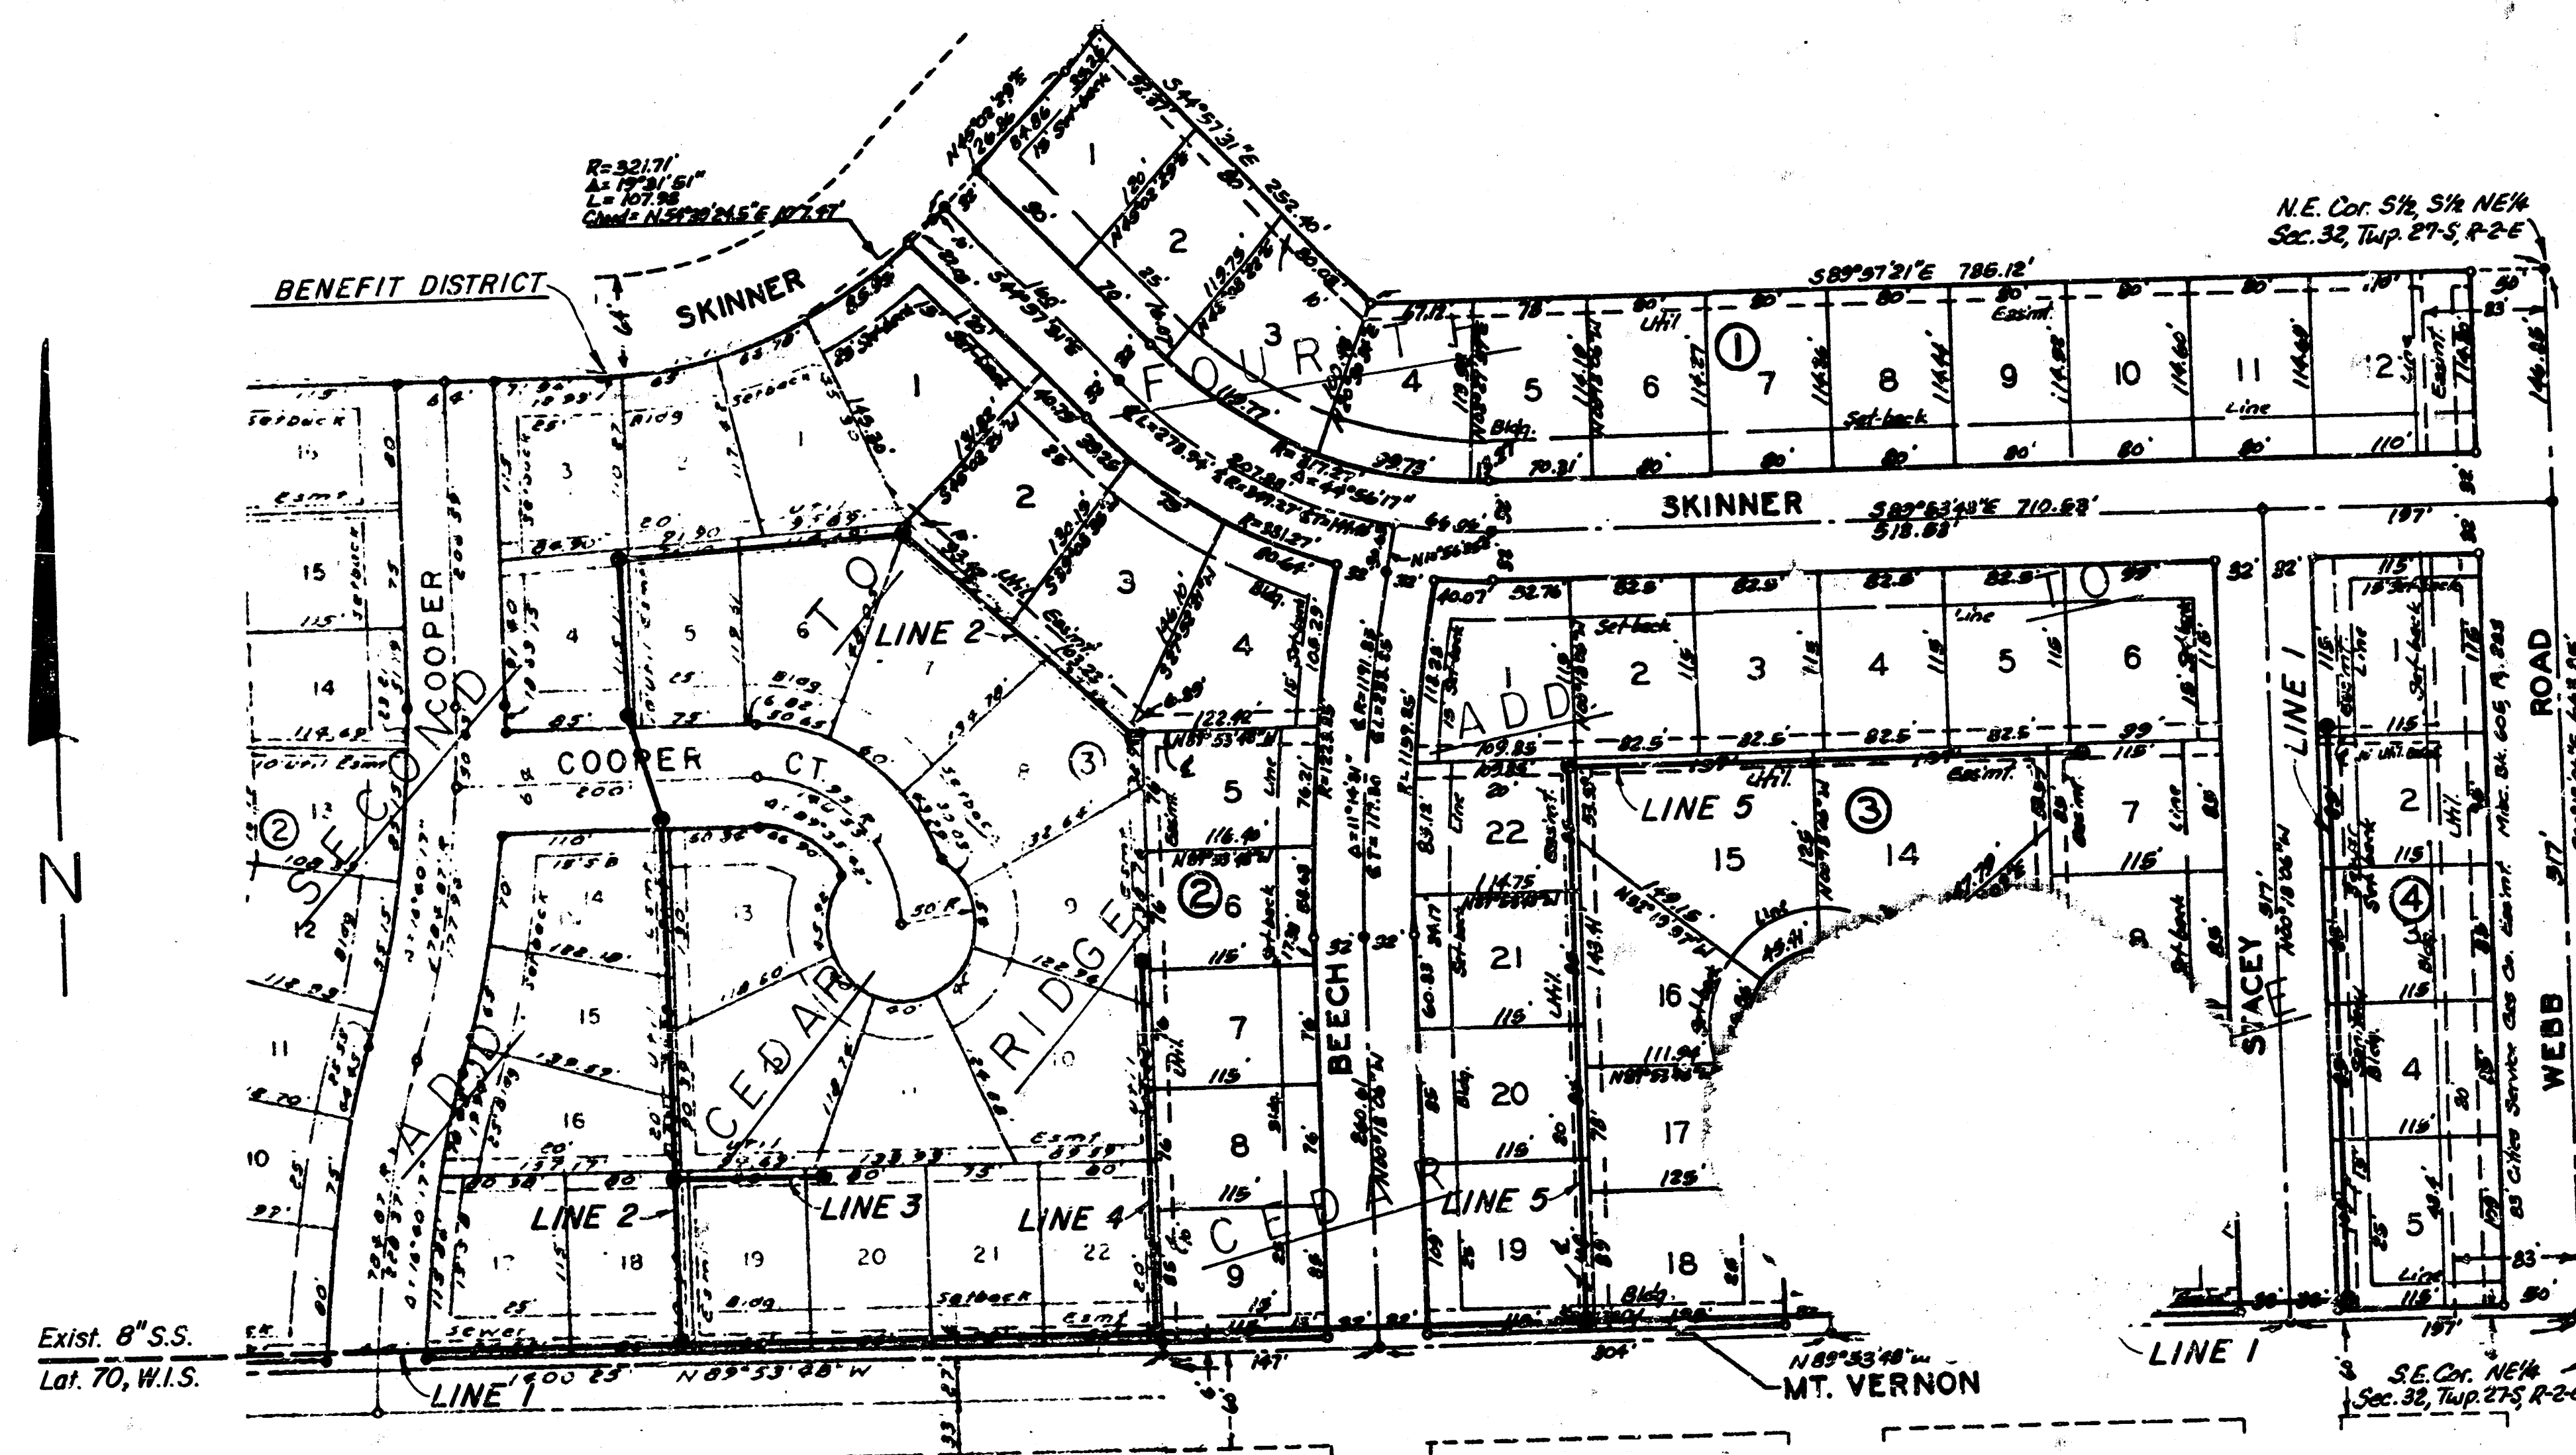


GENERAL NOTE

The Contractor shall be responsible for preserving property irons. The Contractor shall be required to re-establish any property irons which are destroyed or damaged by his construction operations. Such irons shall be re-established by a licensed land surveyor or a professional engineer in accordance with state laws.



MAY 1984

BAUGHMAN COMPANY, P.A.
SURVEYING & ENGINEERING
316/262-7271 • 338 LAURA • WICHITA, KANSAS 67211

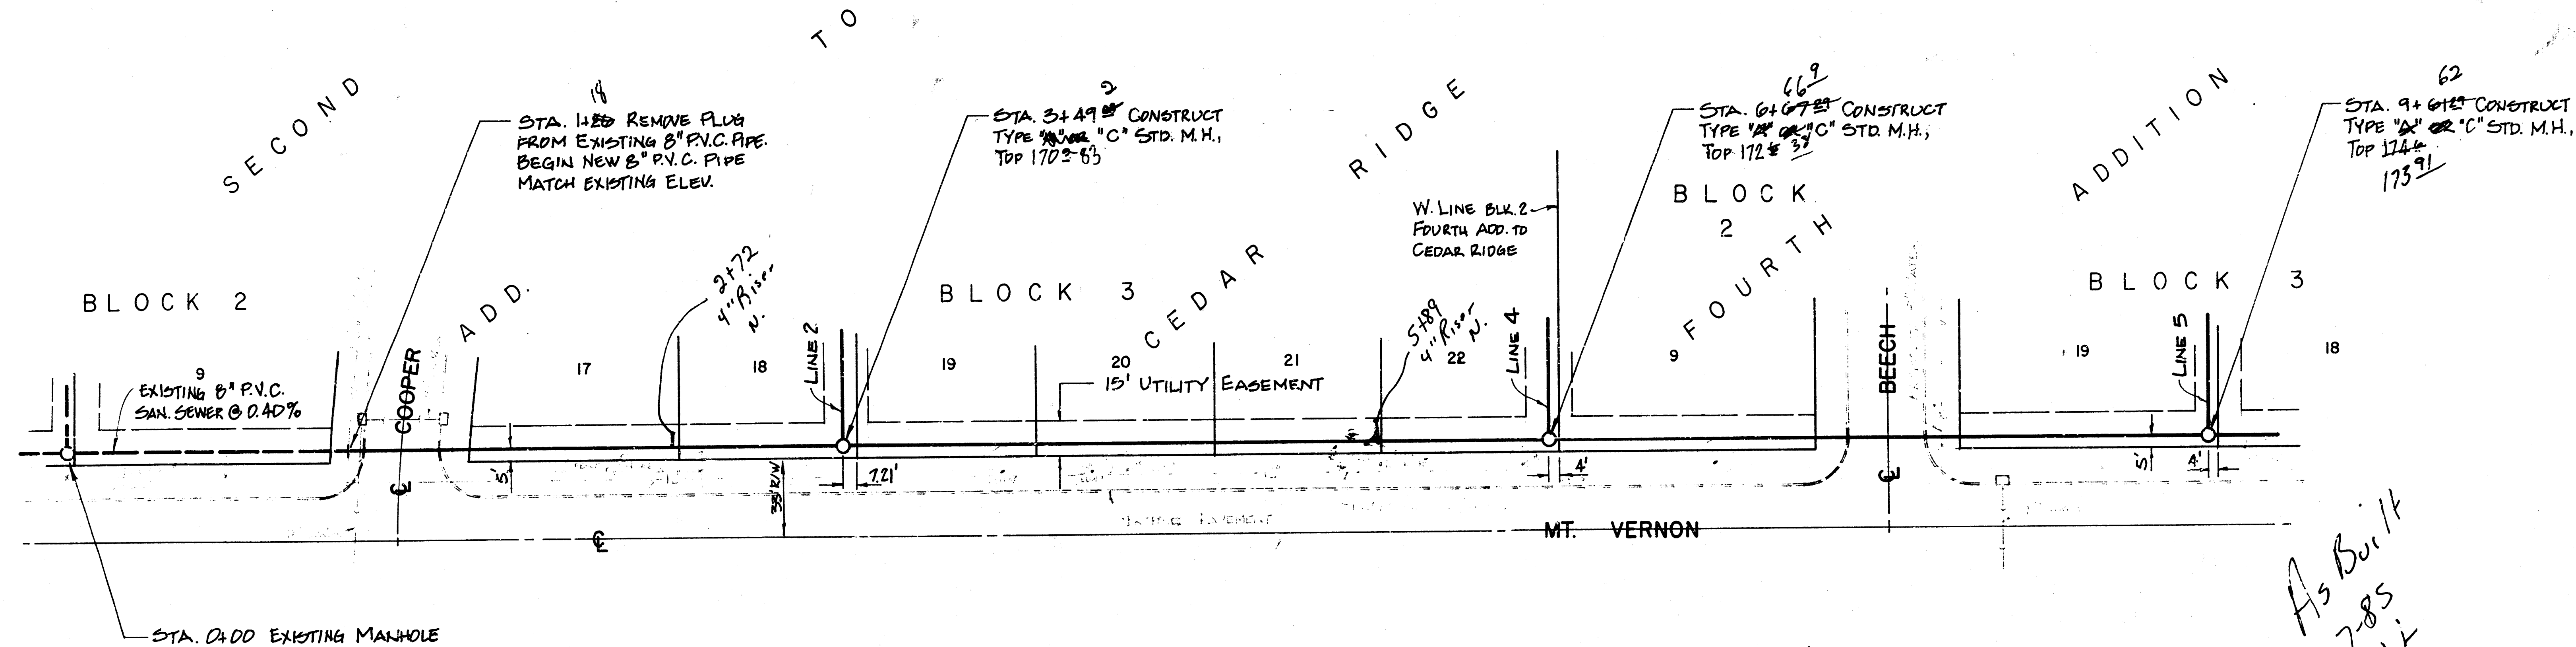

GENERAL NOTE

TREES AND HERBES TO BE REMOVED AS REQUIRED FOR CONSTRUCTION. COST OF REMOVAL SHALL BE INCIDENTAL TO L.F. OF PIPE.



BENCH MARK

CITY OF WICHITA STR. DIAC
47' W. & 44' N. OF & MT. VERNON
+ WOOD ROAD, ELEV. 182.48

SCALE

PLAN - 1" = 40'

PROFILE - 1" = 40' HORIZ.
1" = 5' VERT.

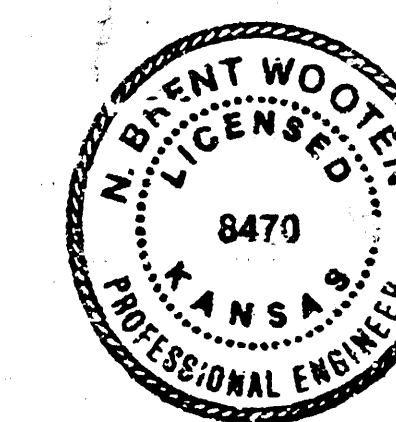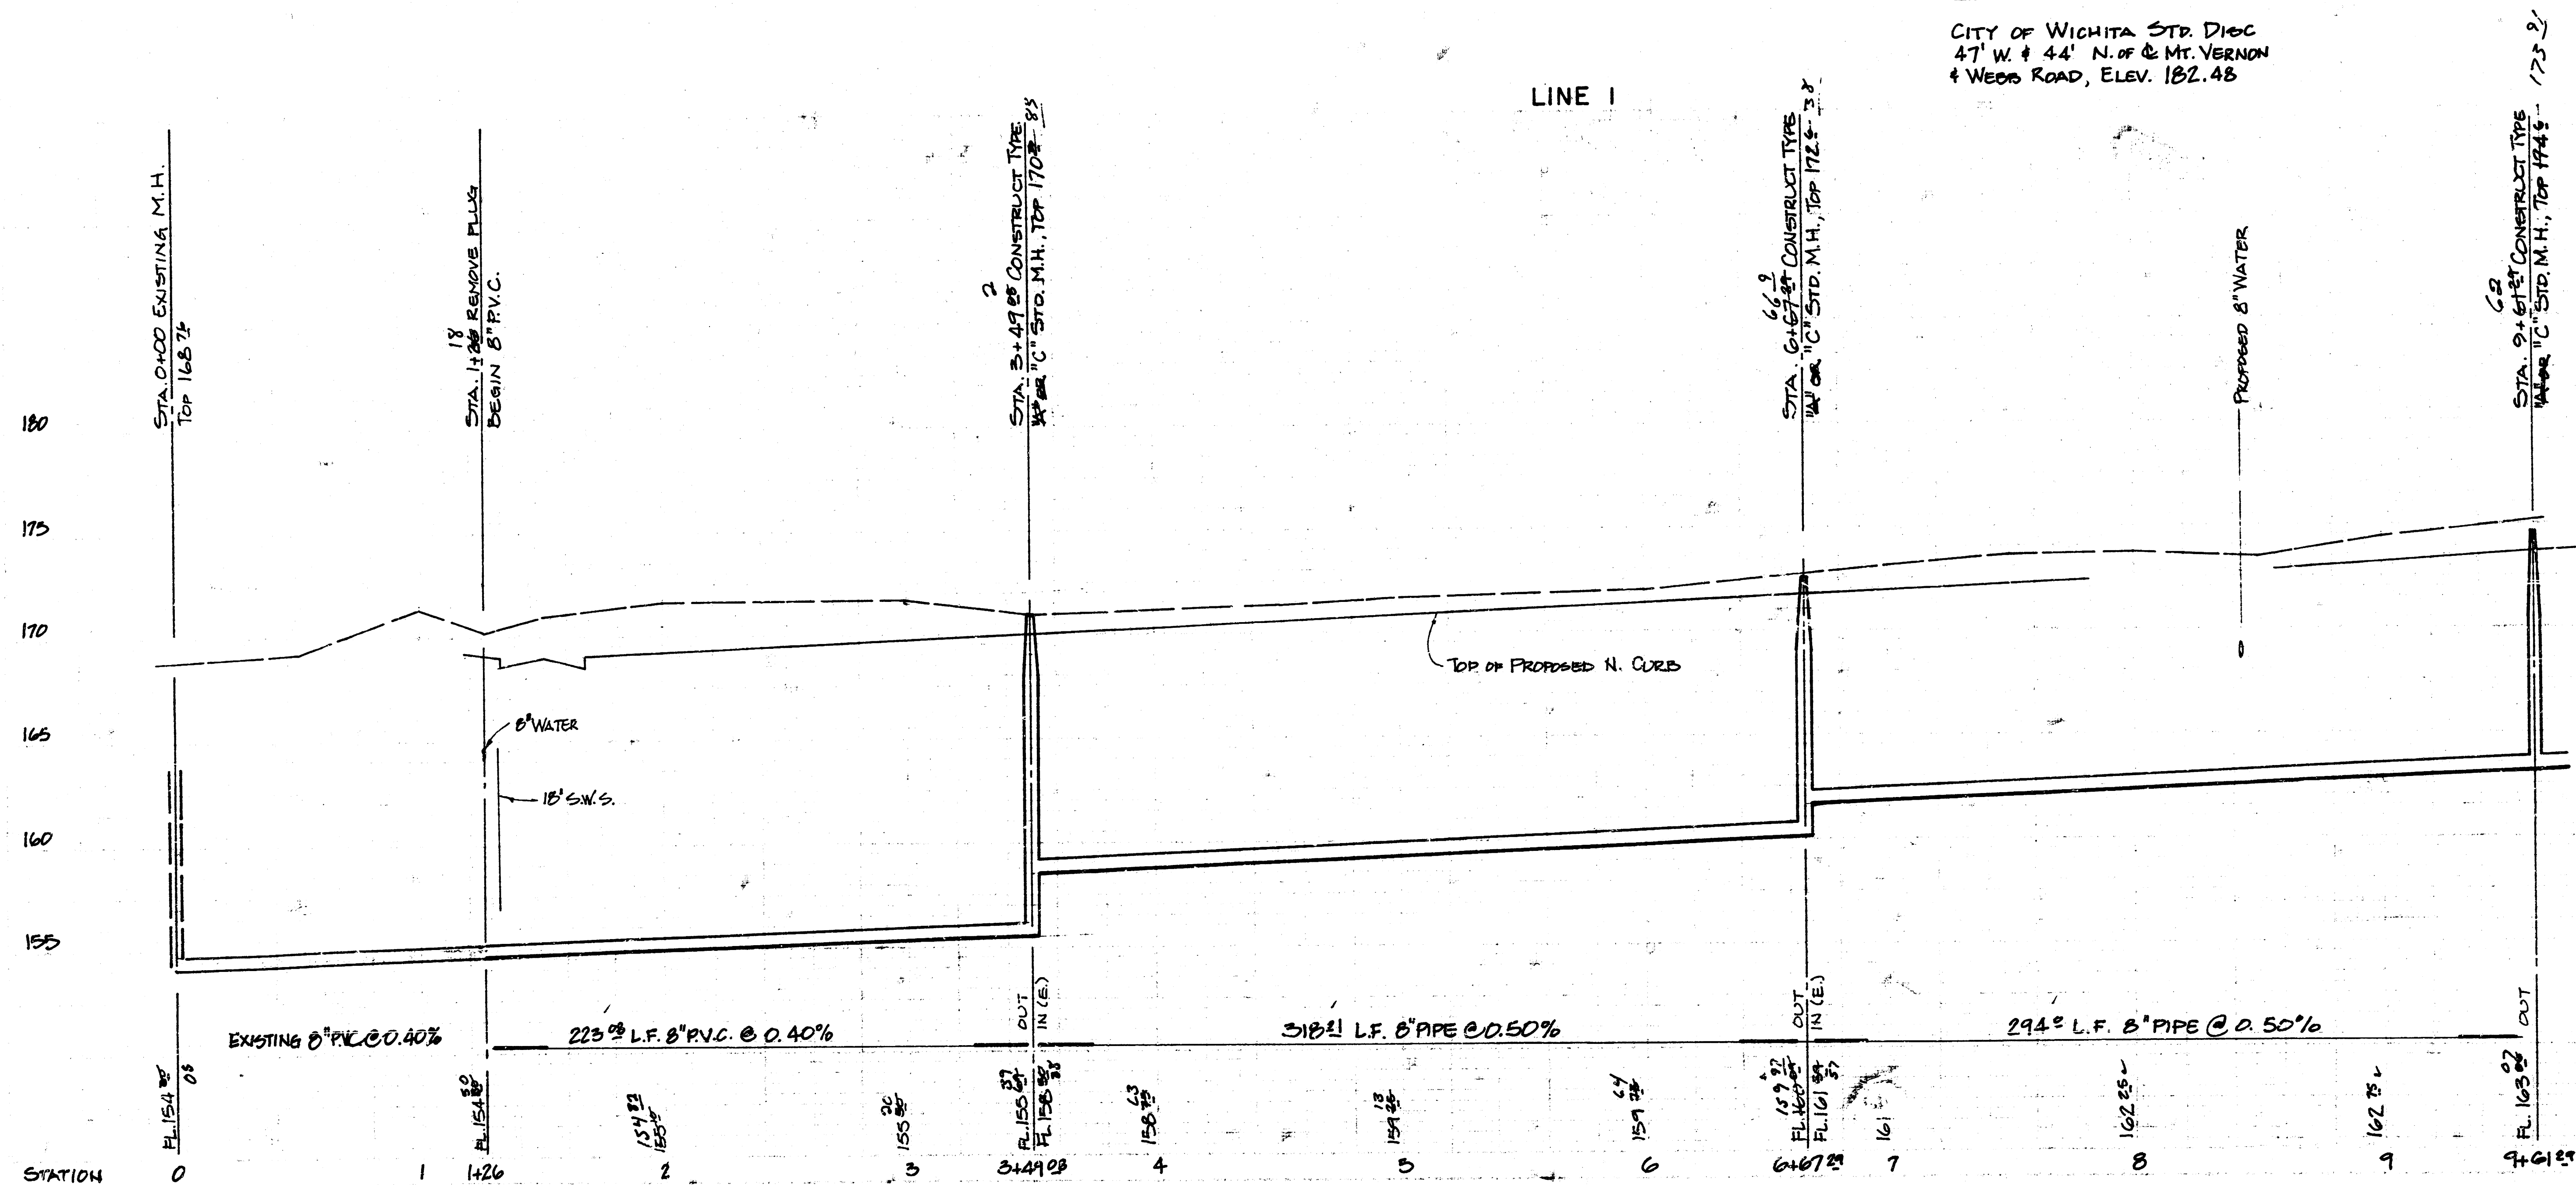


**LATERAL 71
WAR INDUSTRIES SEWER**

City of Wichita, Kansas

Project no 468-76-245-81138-000-000-001


BAUGHMAN COMPANY, P.A.
SURVEYING & ENGINEERING
316/263-7271 • 330 LAURA • WICHITA, KANSAS 67211

2 of 10

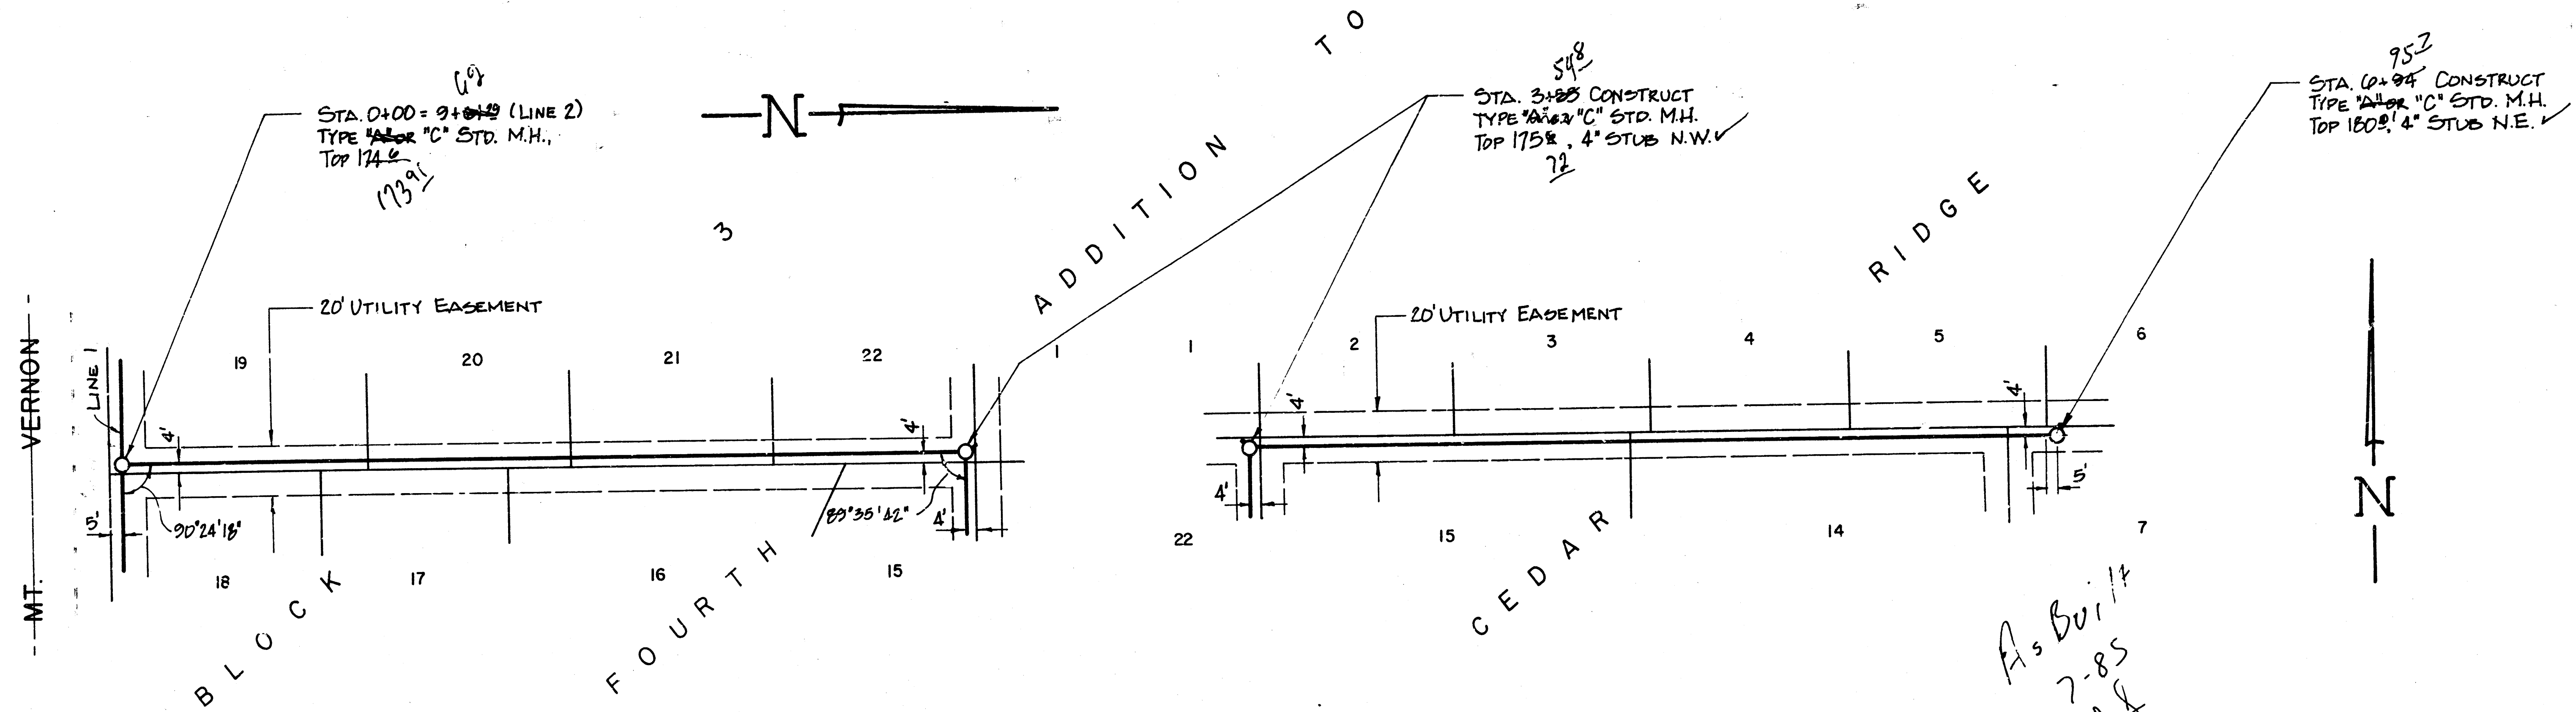


SCALE
PLAN - 1" = 40'
PROFILE - 1" = 40' HORIZ.
1" = 5' VERT.

LINE 5

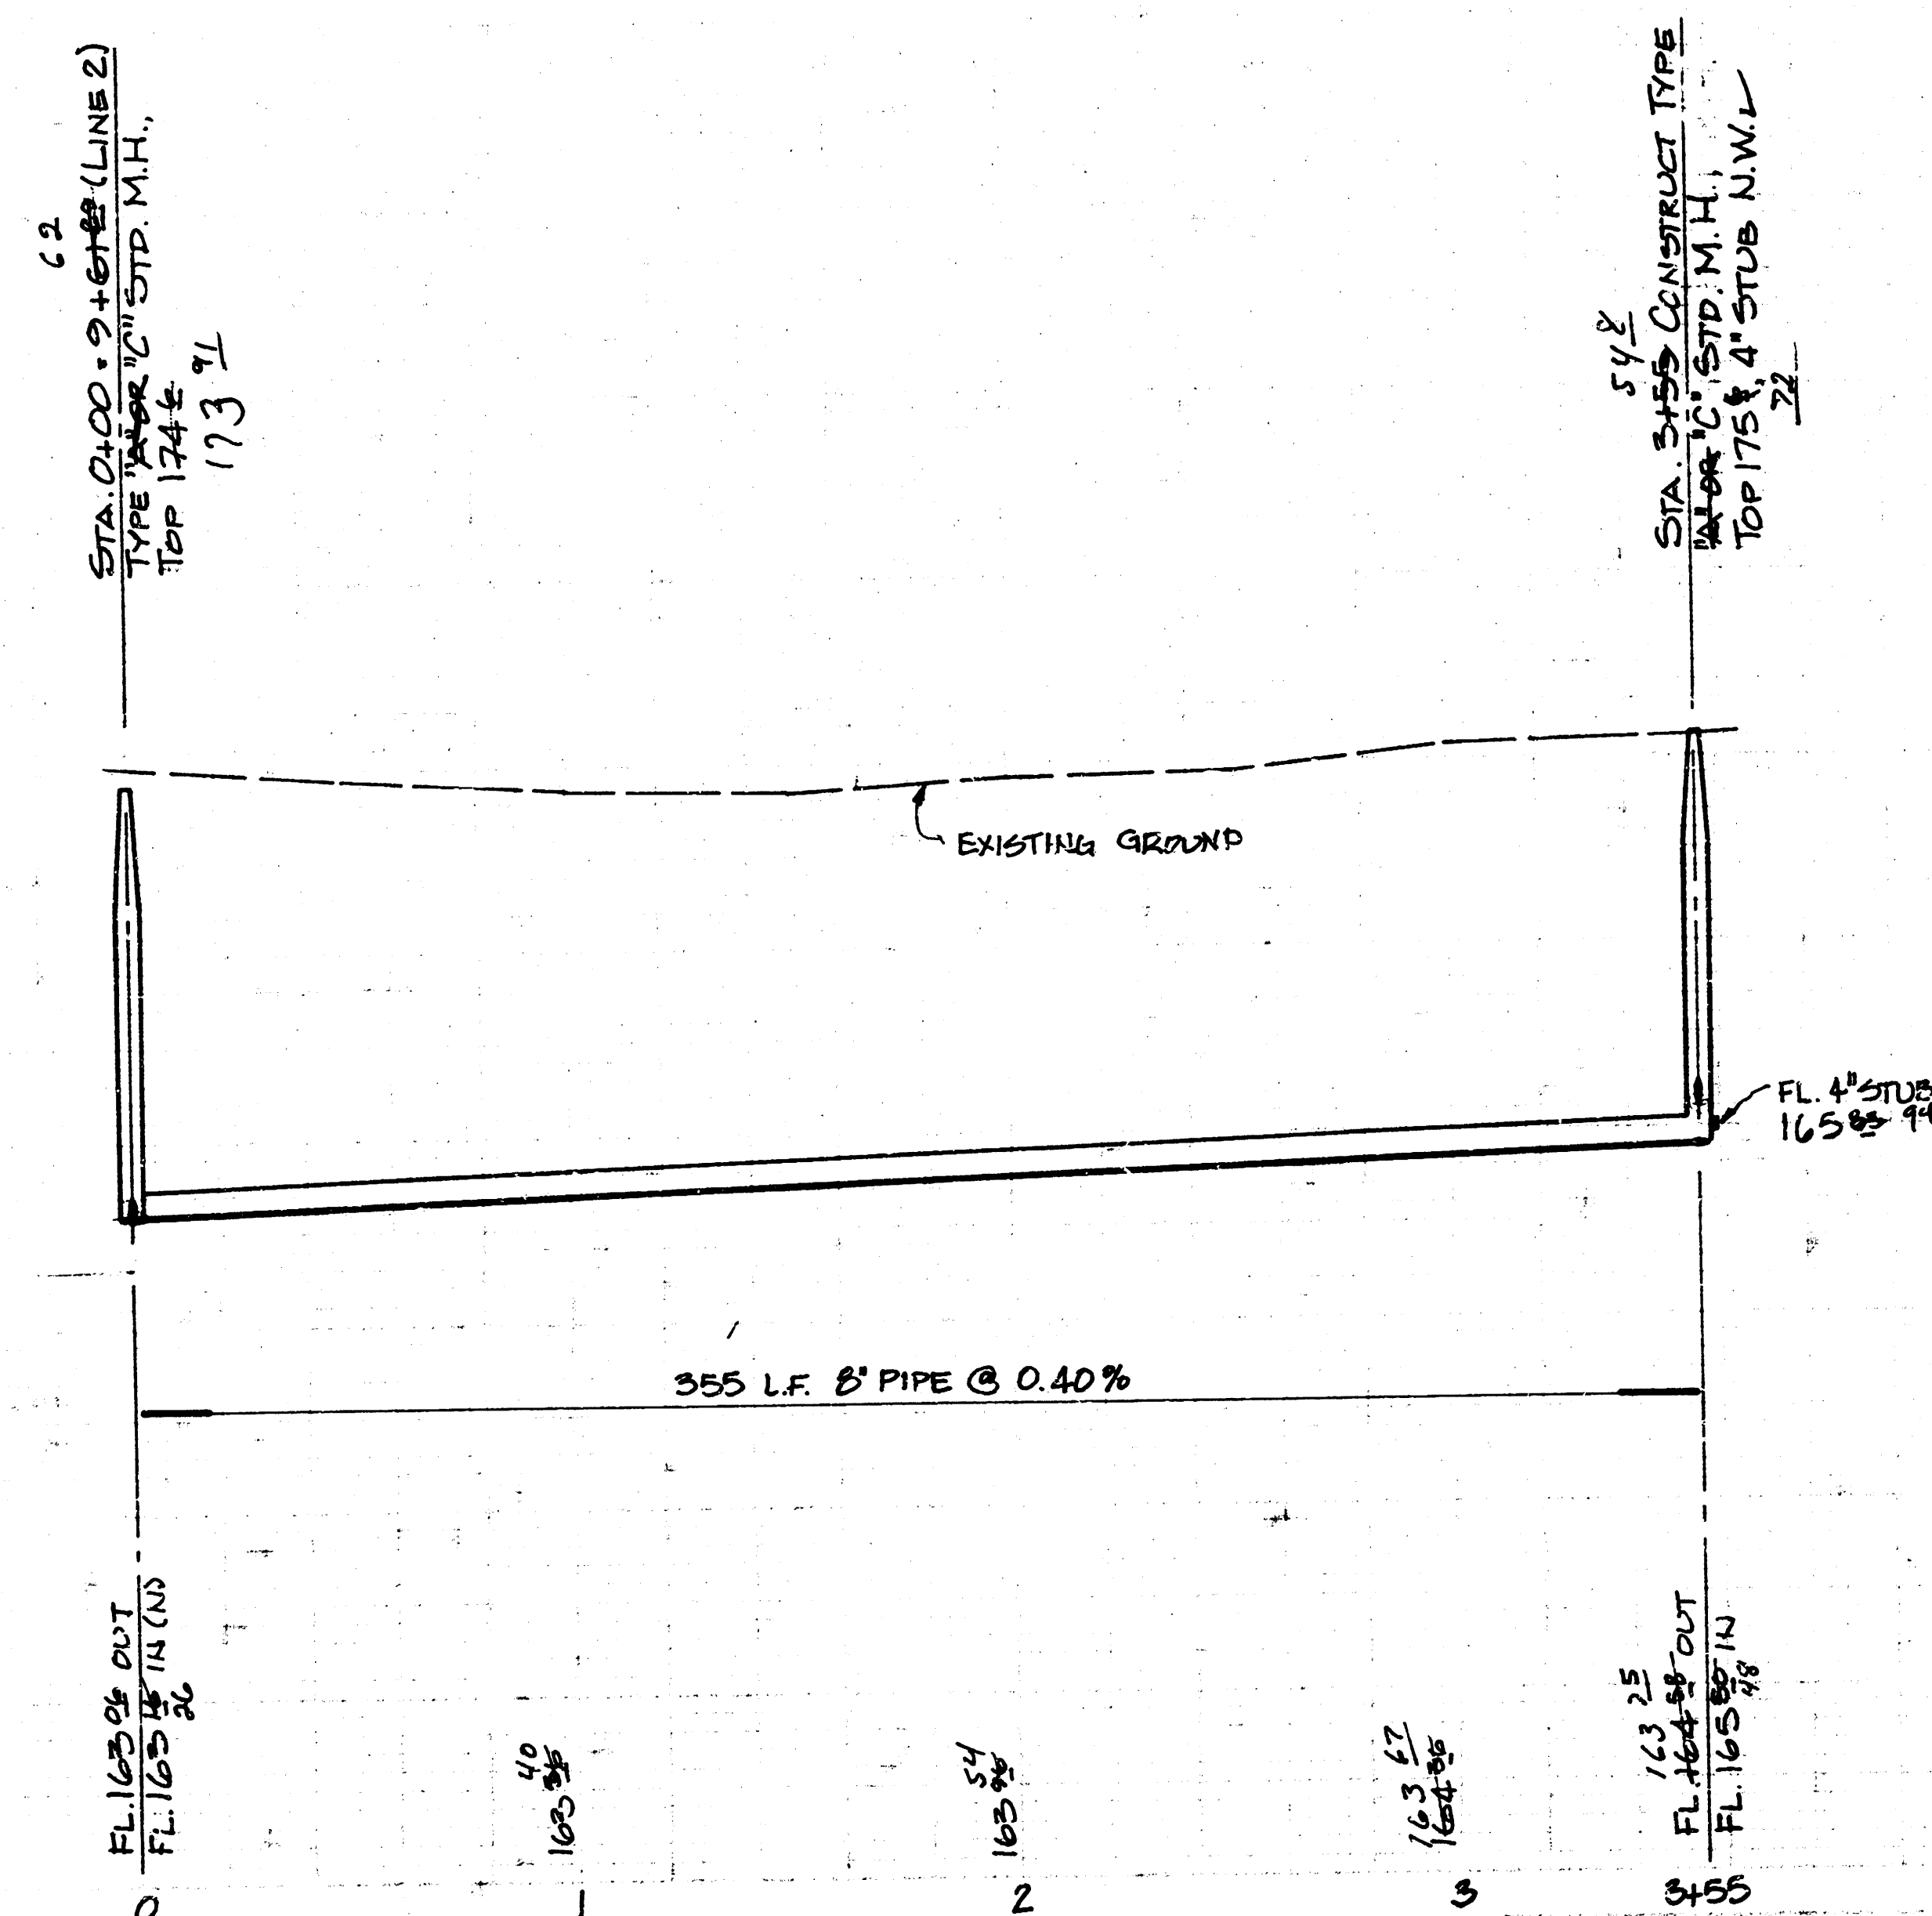

LINE 5


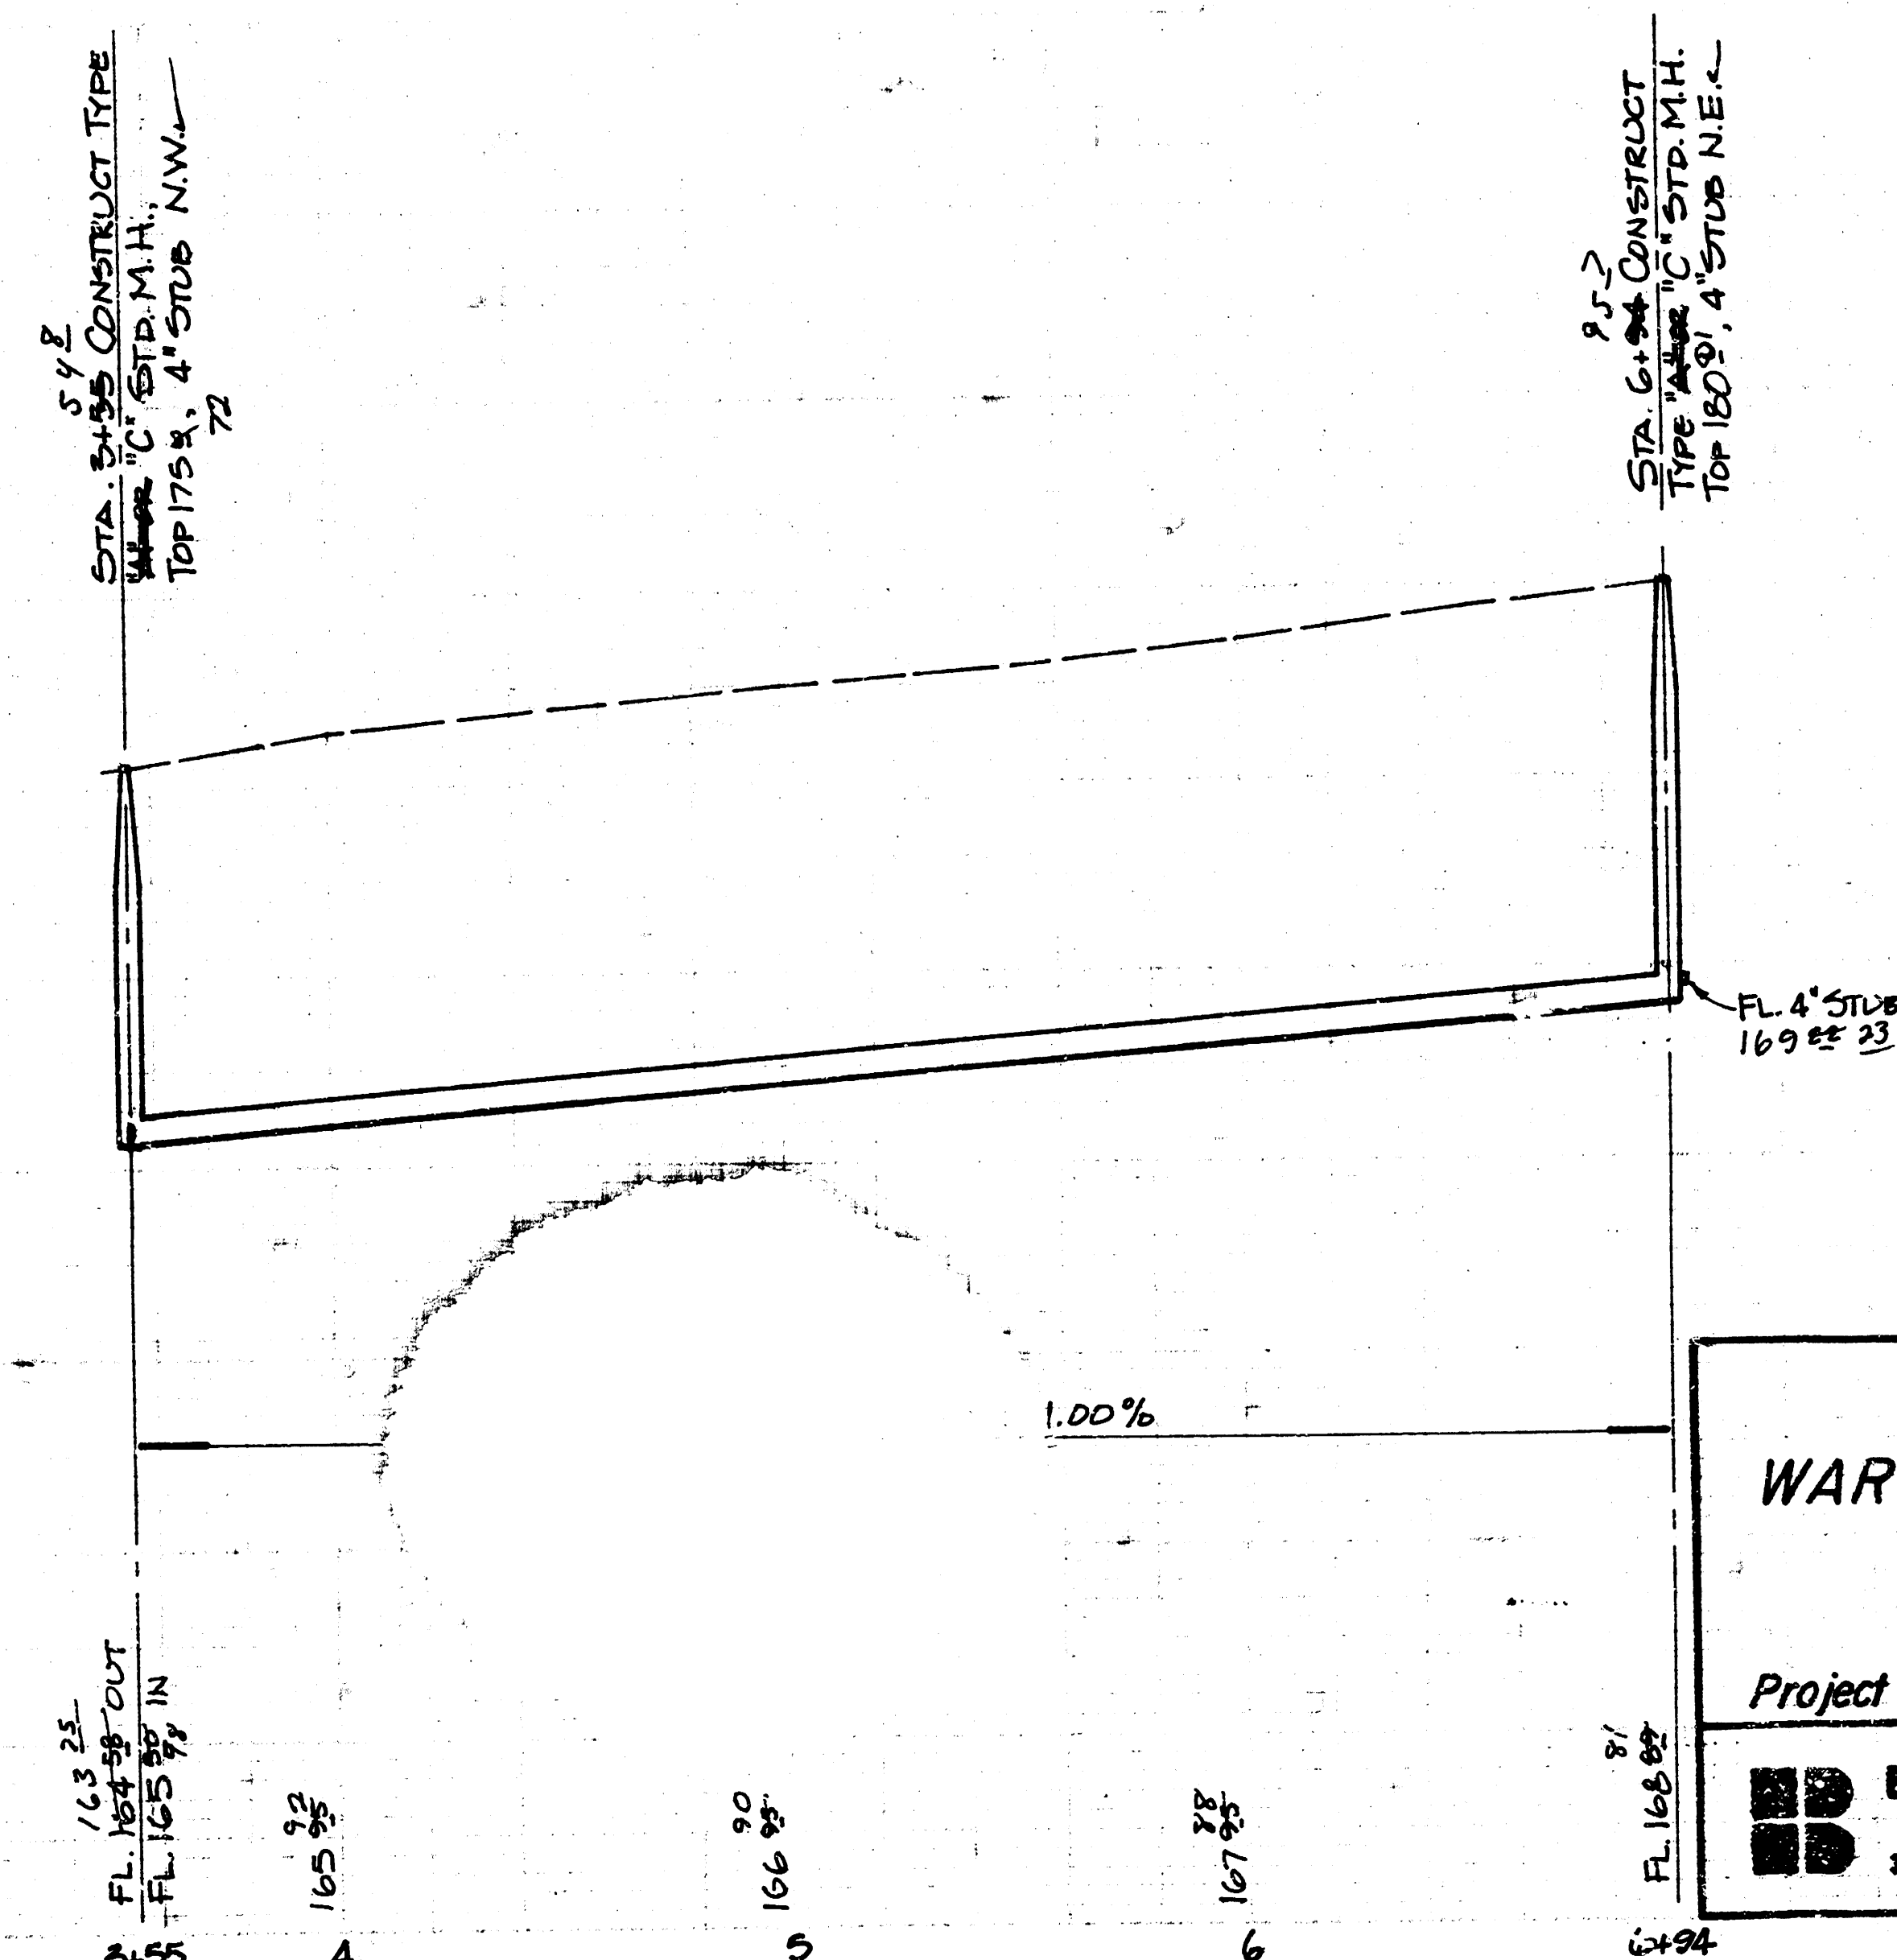


LATERAL 71
WAR INDUSTRIES SEWER
City of Wichita, Kansas
Project no. 468-75-245-8113B-000-000-001
BAUGHMAN COMPANY, P.A.
SURVEYING & ENGINEERING
316/242-7271 • 220 LAURA • WICHITA, KANSAS 67211

STATION

185
180
175
170
165

6 OF 10

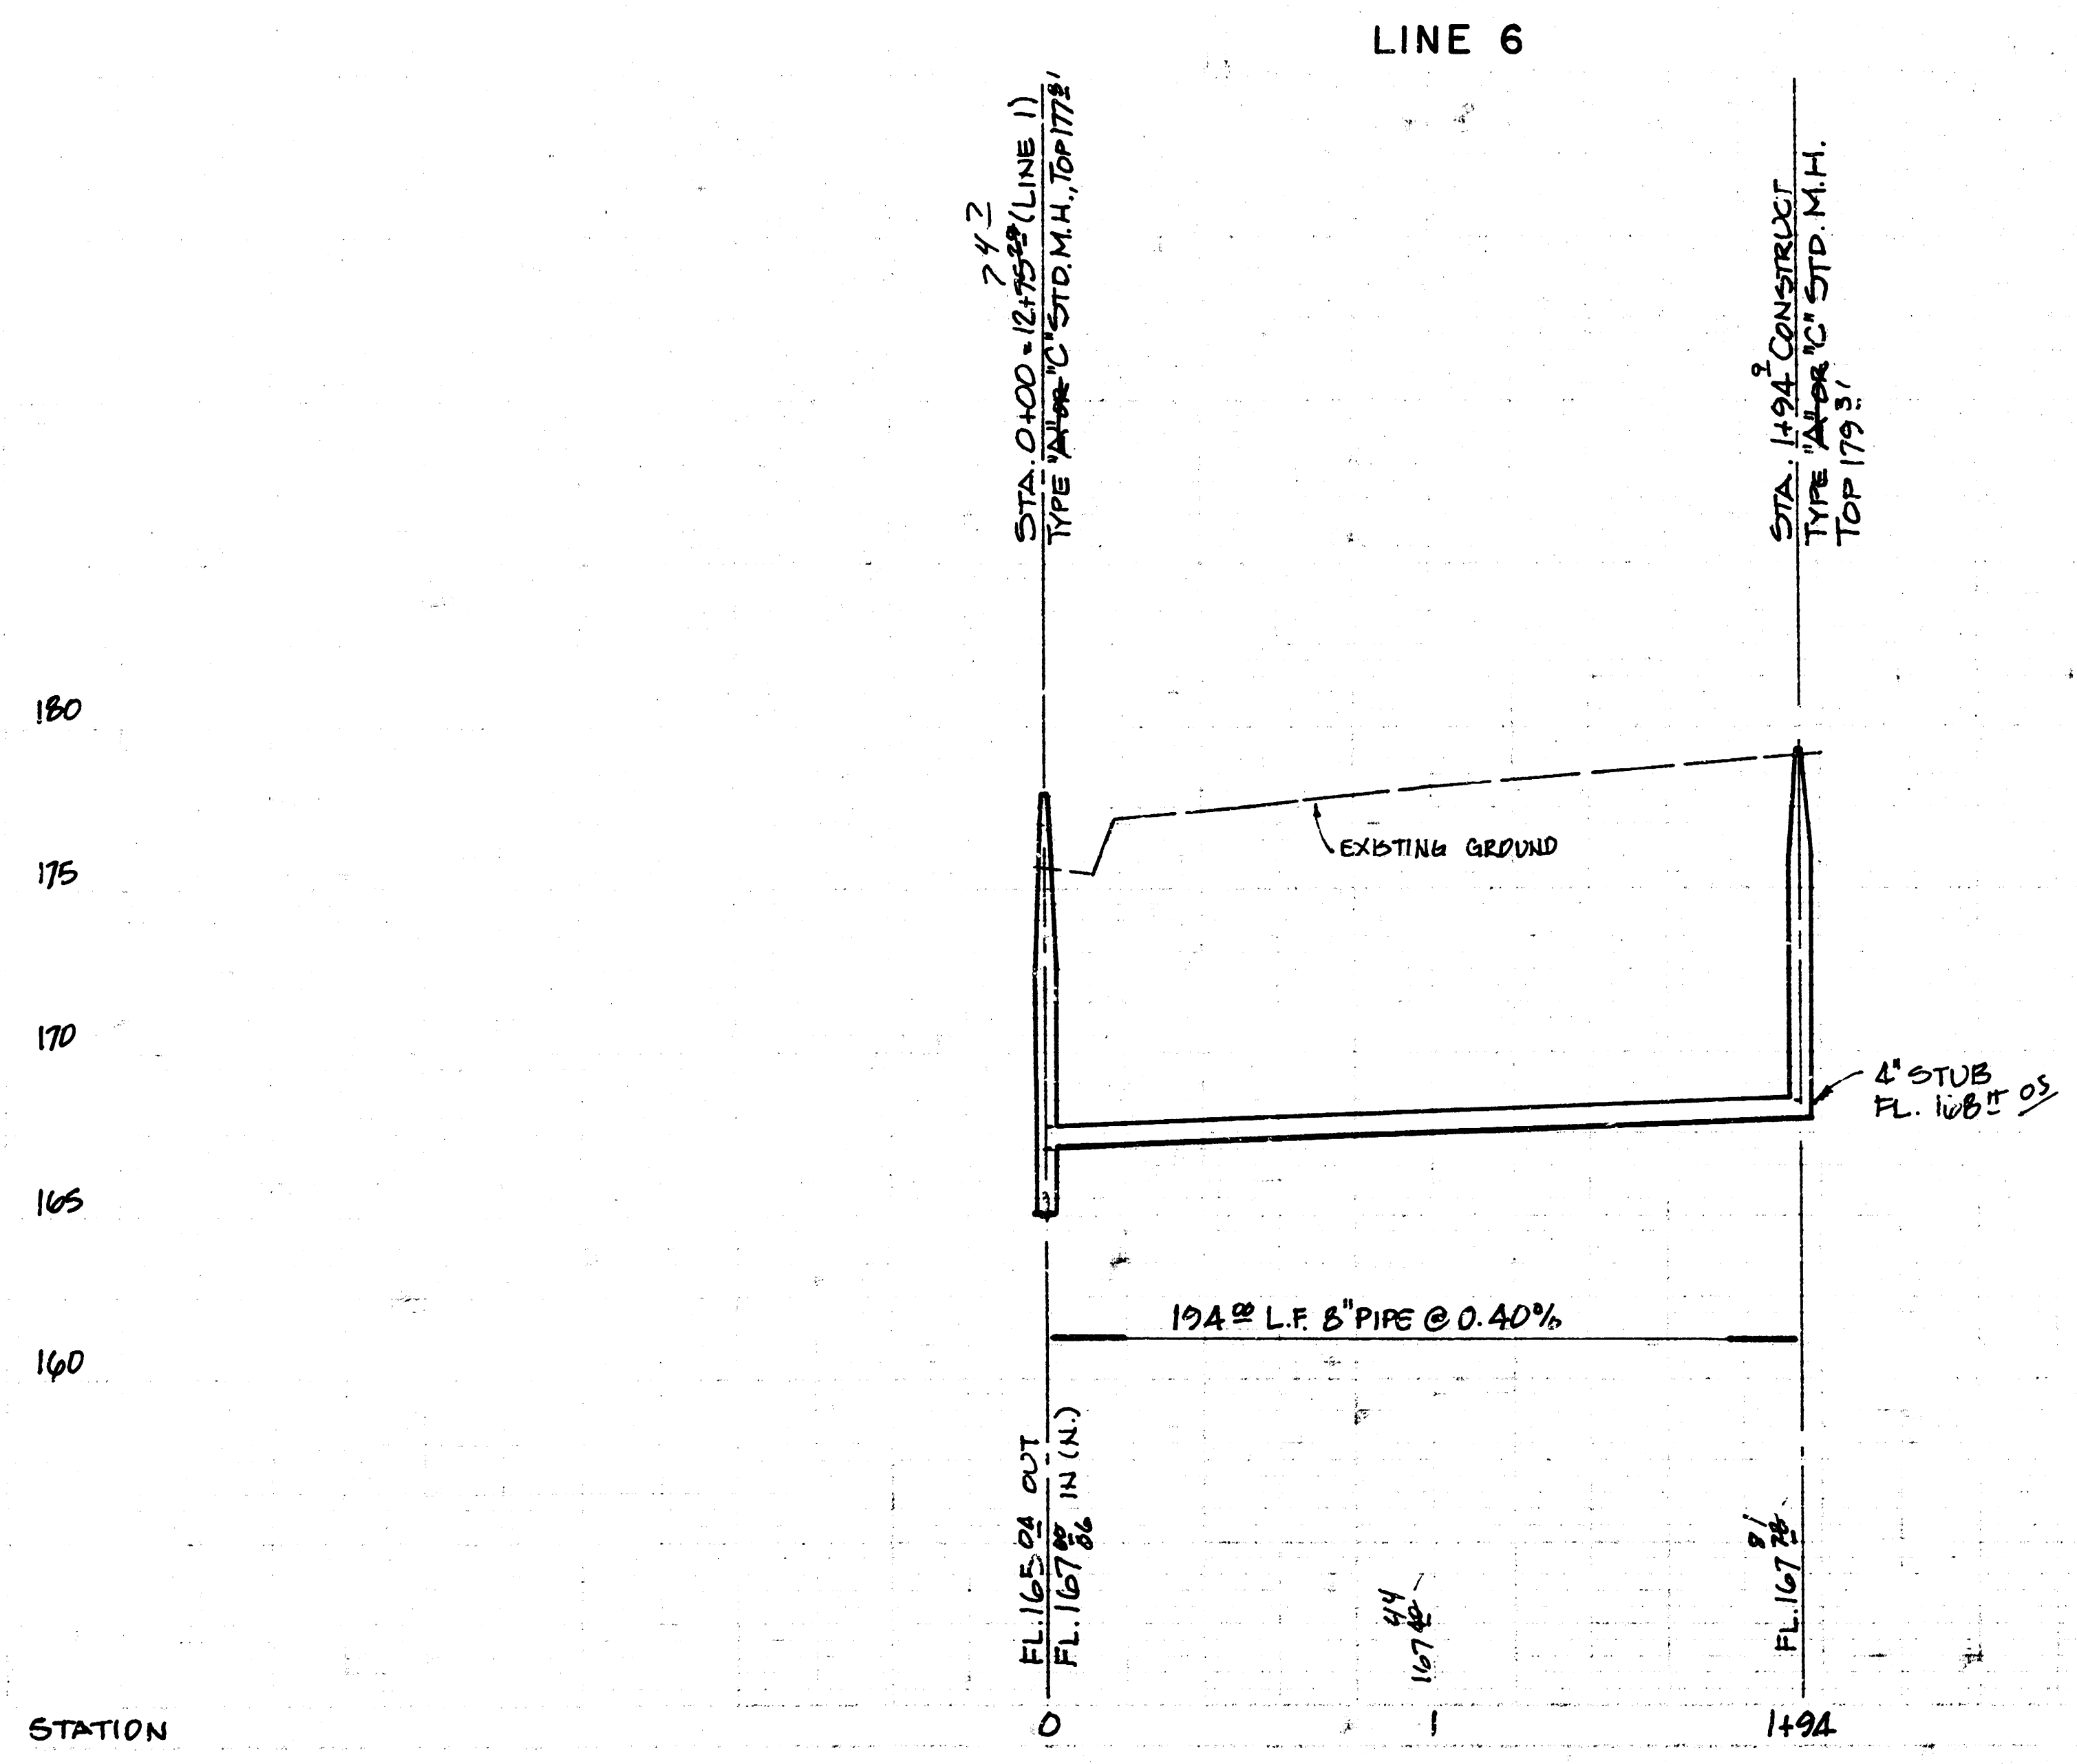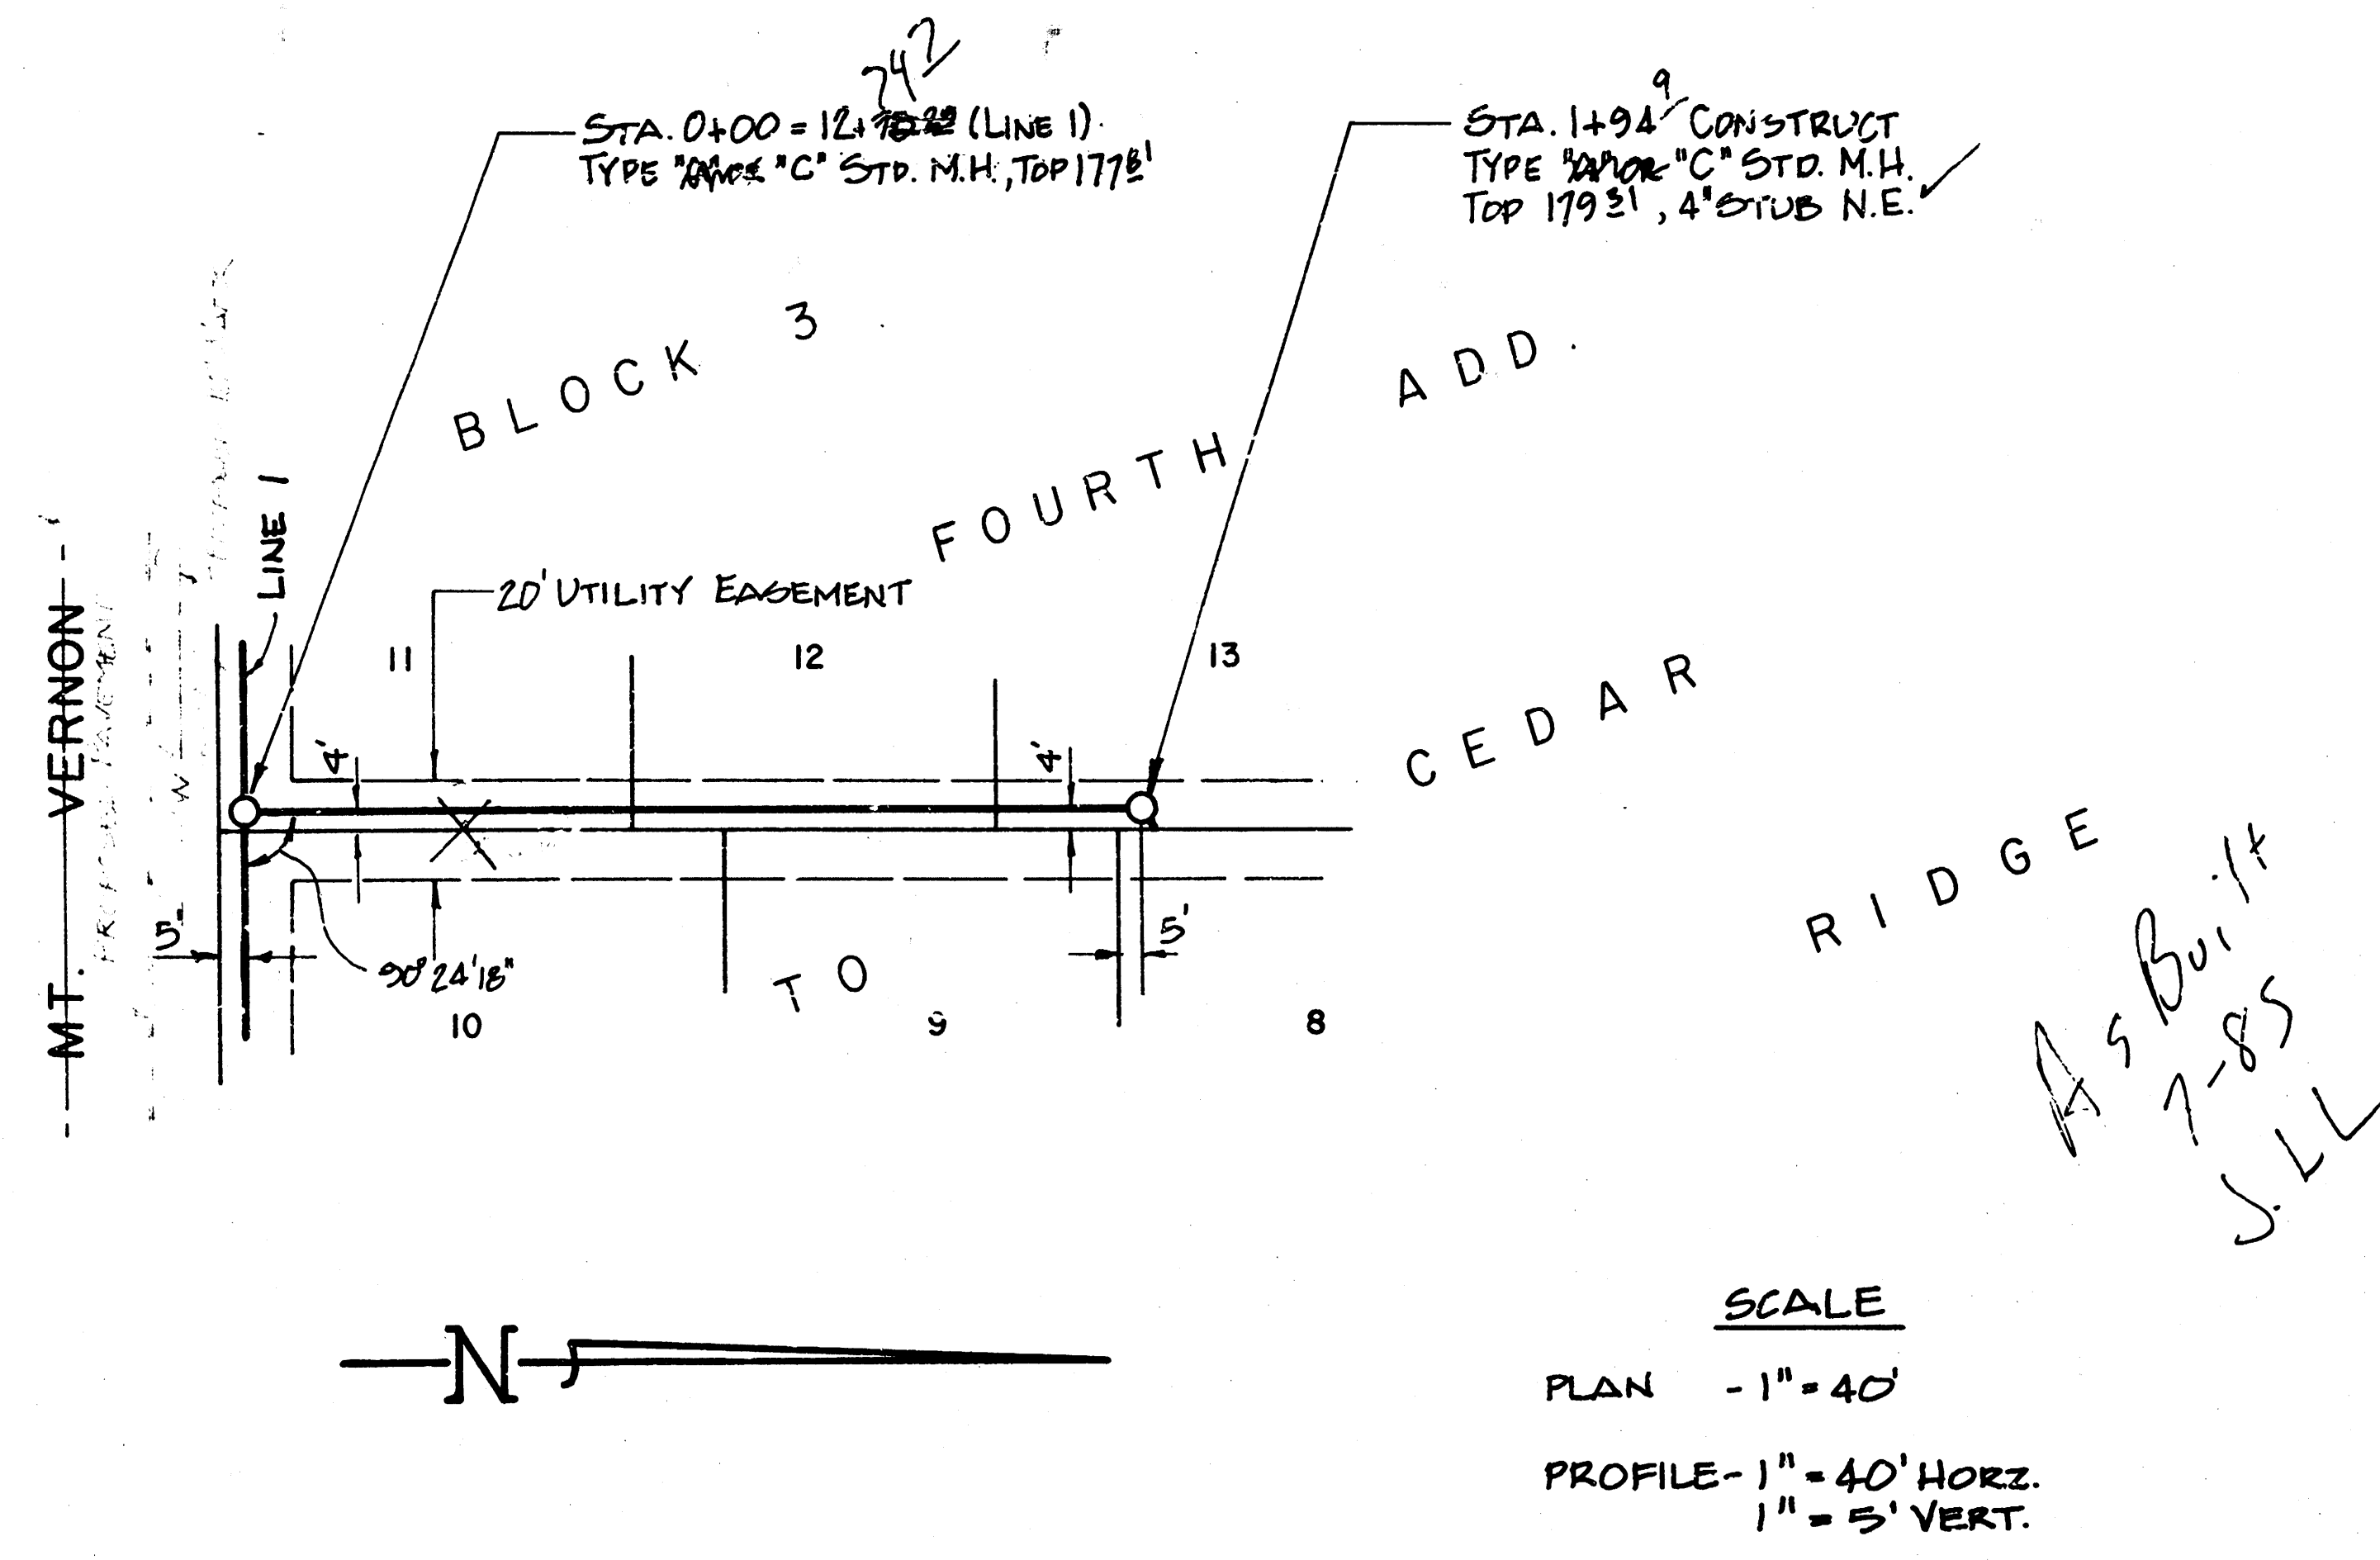


**LATERAL 71
 WAR INDUSTRIES SEWER**

City of Wichita, Kansas

Project no. 468-76-245-81138-000-000-001

BAUGHMAN COMPANY, P.A.
 SURVEYING & ENGINEERING
 215/753-7271 • 380 LAURA • WICHITA, KANSAS 67211

CITY OF WICHITA, KANSAS

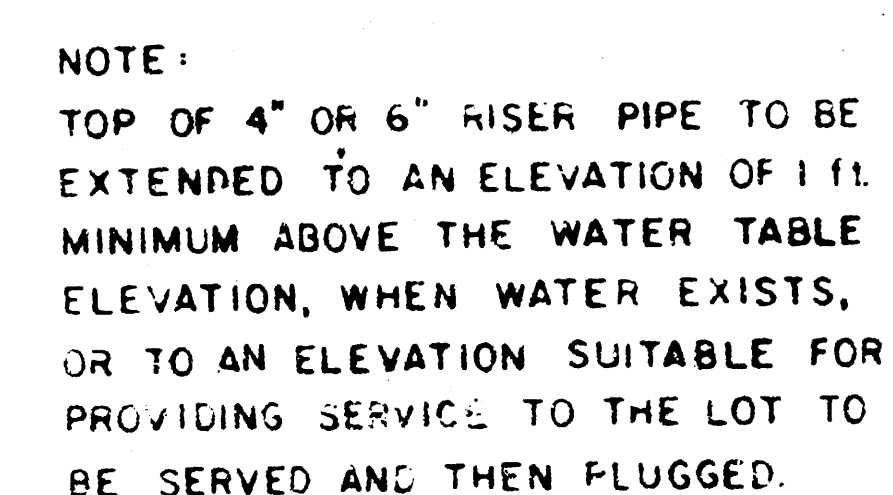

UNDISTURBED EARTH

TRENCH CUT (VAR)

TRENCH WALL

MAXIMUM WATER TABLE ELEVATION

1ft. MINIMUM

6" MINIMUM ALL SIDES

No. 5 BARS

NOTCH OUT FOR ENCASEMENT TO TOP OF BEND

BEND AS REQUIRED

4 - No. 5 BARS

REINFORCED CONCRETE ENCASEMENT, 8" MINIMUM ALL SIDES

CITY CONC PAVEMENT MIX

TEE SADDLE

MAIN SEWER

1' 3" TYPICAL

45° MIN

VAR

TYPICAL RISER FOR VERTICAL TRENCH WALLS


PRICES IN AND INS ALLOW RISERS SHALL BE PAID FOR AT THE UNIT PRICES LISTED IN THE PRICE SCHEDULE AND SHALL INCLUDE CONCRETE REINFORCEMENT FOR THE RARIO'S MAIN STEIN PIPE SIZES INDICATED WHICH PRICE SHALL INCLUDE ALL COSTS FOR COMPLETION OF THIS ITEM INCLUDING SADDLES, BENDS, CONCRETE REINFORCING, STEEL CAPS OR TIES AND ALL OTHER NECESSARY MATERIALS OR WORK. CONCRETE REINFORCEMENT OF THE RISER PIPE TO THE TOP OF THE HEAD AS SHOWN ON THE DRAWINGS SHALL BE PROVIDED BY THE BIDDER FOR THIS WORK SHALL BE CONSIDERED AS AN ESTIMATORY OF THE OTHER ITEM OF WORK.

THE PROJECT INSPECTOR SHALL REPORT ON INSPECTION CARDS THE LOCATION OF ALL RISERS CONVEYED AS MEASURED FROM THE NEAREST MANHOLE, THE DIRECTION OF SERVICE, THE ELEVATION OF THE TOP OF THE RISER, AND THE PAVEMENTITIES INVOLVED. THE PROJECT INSPECTOR SHALL ALSO REPORT ON INSPECTION CARDS THE LOCATION, DIRECTION OF SERVICE, AND SIZE OF ALL STUBS INSTALLED IN MANHOLES.

BAUGHMAN COMPANY, P.A.
SUEVYING & ENGINEERING
314/363-7271 • 320 LAURA • WICHITA, KANSAS 67201

SECOND ADDITION TO CEDAR RIDGE

WICHITA, KANSAS

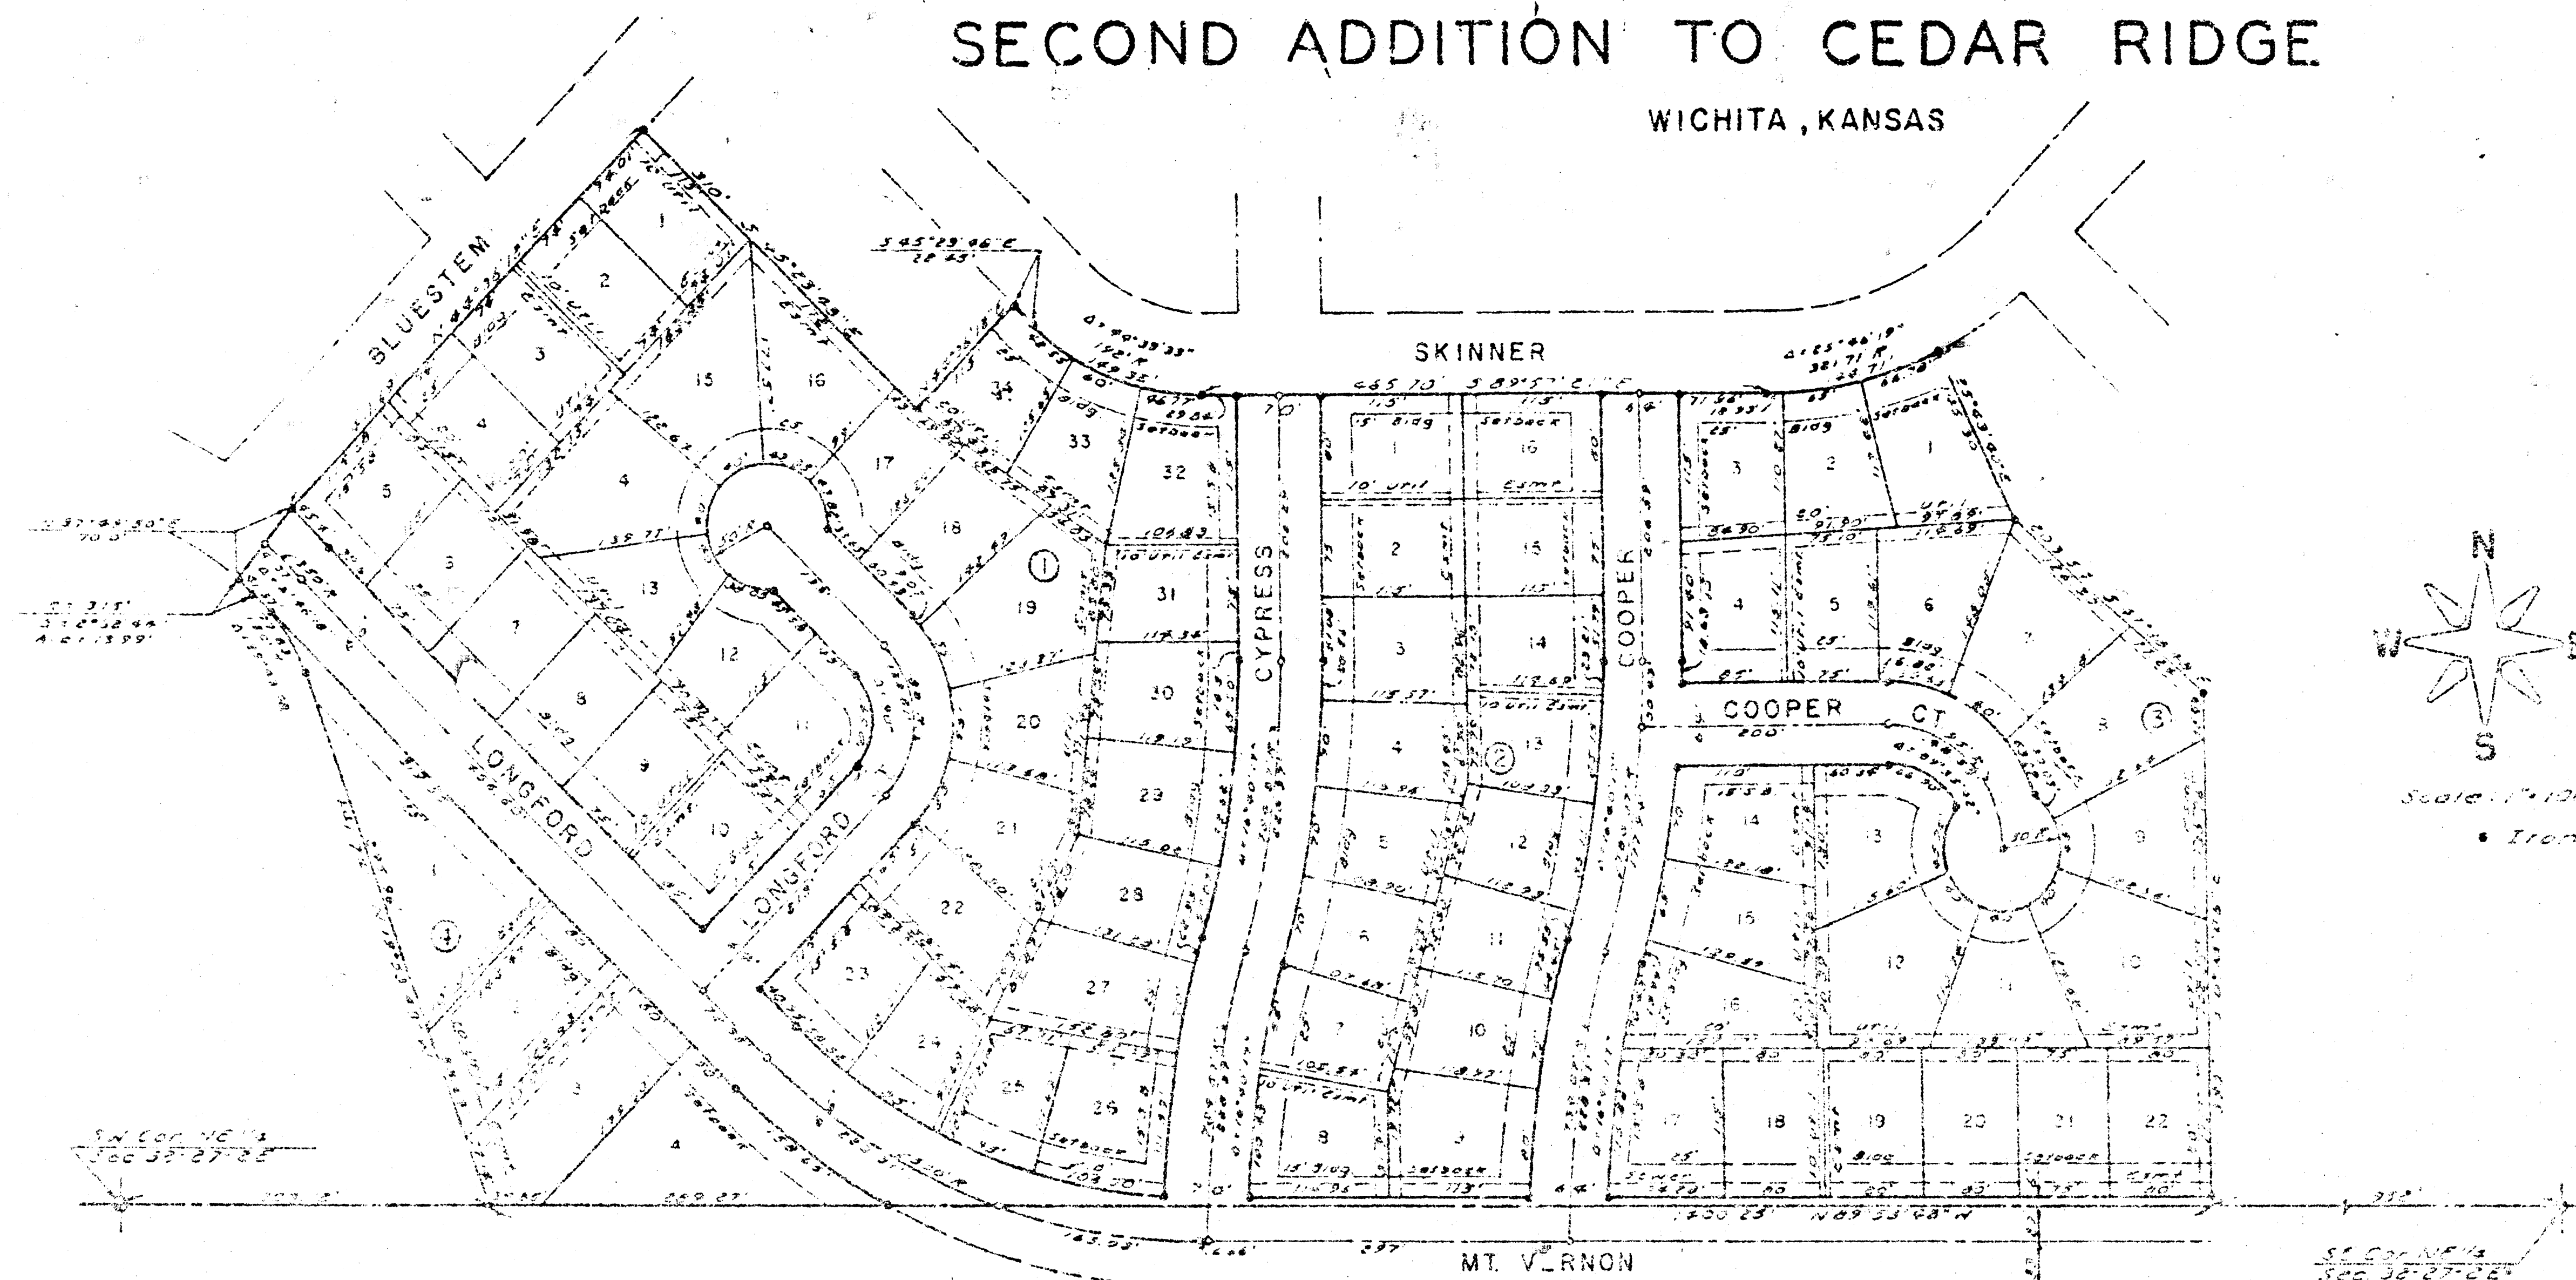

State of Kansas, ss. We, Baughman Company, P.A. Surveyors in and for said county and state do hereby certify that we have surveyed and plotted "SECOND ADDITION TO CEDAR RIDGE", Wichita, Kansas, and that the accompanying plat is a true and correct exhibit of the property surveyed, described as a replat of Lot 5, Blk. 4 of Fourth Addition to Cherry Creek Hills, Wichita, Kansas, and all that part of the NE 1/4 of Section 32, T15S, R26E of the 6th P.M., Sedgwick County, Kansas, lying south and east of the Fourth Addition to Cherry Creek Hills, Wichita, Kansas, south of First Addition to Cedar Ridge, Wichita, Kansas, east of Hedgecliff Addition, Wichita, Kansas, and west of the following described line: Beginning at a point on the south line of said NE 1/4, said point being 952 feet west of the SE corner thereof; thence N 0° 18' 05" W, parallel with the east line of said NE 1/4, 355 feet; thence N 47° 38' 10" W, 203.54 feet; thence N 65° 43' 40" W, 195.30 feet to the south line of Skinner St. as plotted in said First Addition to Cedar Ridge.

Date June 12, 1931. Baughman Company, P.A.
John E. Baughman Surveyor

Know all men by these presents, that we, the undersigned, have caused the land described in the surveyors certificate to be plotted into lots, blocks and streets to be known as "SECOND ADDITION TO CEDAR RIDGE", Wichita, Kansas. The easements are hereby granted as indicated for the construction and maintenance of public utilities. The streets are hereby dedicated to and for the use of the public.

Cherry Creek Development, Inc.
Clifford A. Nies President

State of Kansas, ss. The foregoing instrument was acknowledged before me this 12th day of June, 1931, by Cherry Creek Development, Inc., by Clifford A. Nies, President. In testimony whereof, I have hereunto set my hand and affixed my notarial seal the day and year above written.

W. H. Smith Notary Public
 My Commission Expires June 12, 1932

This plat of "SECOND ADDITION TO CEDAR RIDGE", Wichita, Kansas, has been submitted to and approved by the Wichita-Sedgwick County Metropolitan Area Planning Commission, Wichita, Kansas. Dated this 17th day of July, 1931.

Wichita-Sedgwick County Metropolitan Area Planning Commission
William H. Smith Chairman
Robert A. Lakin Secretary

This plat approved and all dedications shown hereon accepted by the Board of City Commissioners, Wichita, Kansas, this day of July, 1931.

W. H. Smith Mayor
Clifford A. Nies City Clerk

This plat approved and all dedications shown hereon accepted by the Board of County Commissioners, Sedgwick County, Kansas, this day of July, 1931.

W. H. Smith Chairman
Clifford A. Nies Commissioner
Clifford A. Nies County Clerk

Entered on transfer record this 21st day of July, 1931.


Clifford A. Nies County Clerk

State of Kansas, ss. This is to certify that this plat has been filed for record in the Office of the Register of Deeds this day of July, 1931, at 2 o'clock, P.M., and is duly recorded.

W. H. Smith Register of Deeds
Clifford A. Nies Deputy

FOURTH ADDITION TO CEDAR RIDGE

WICHITA, KANSAS

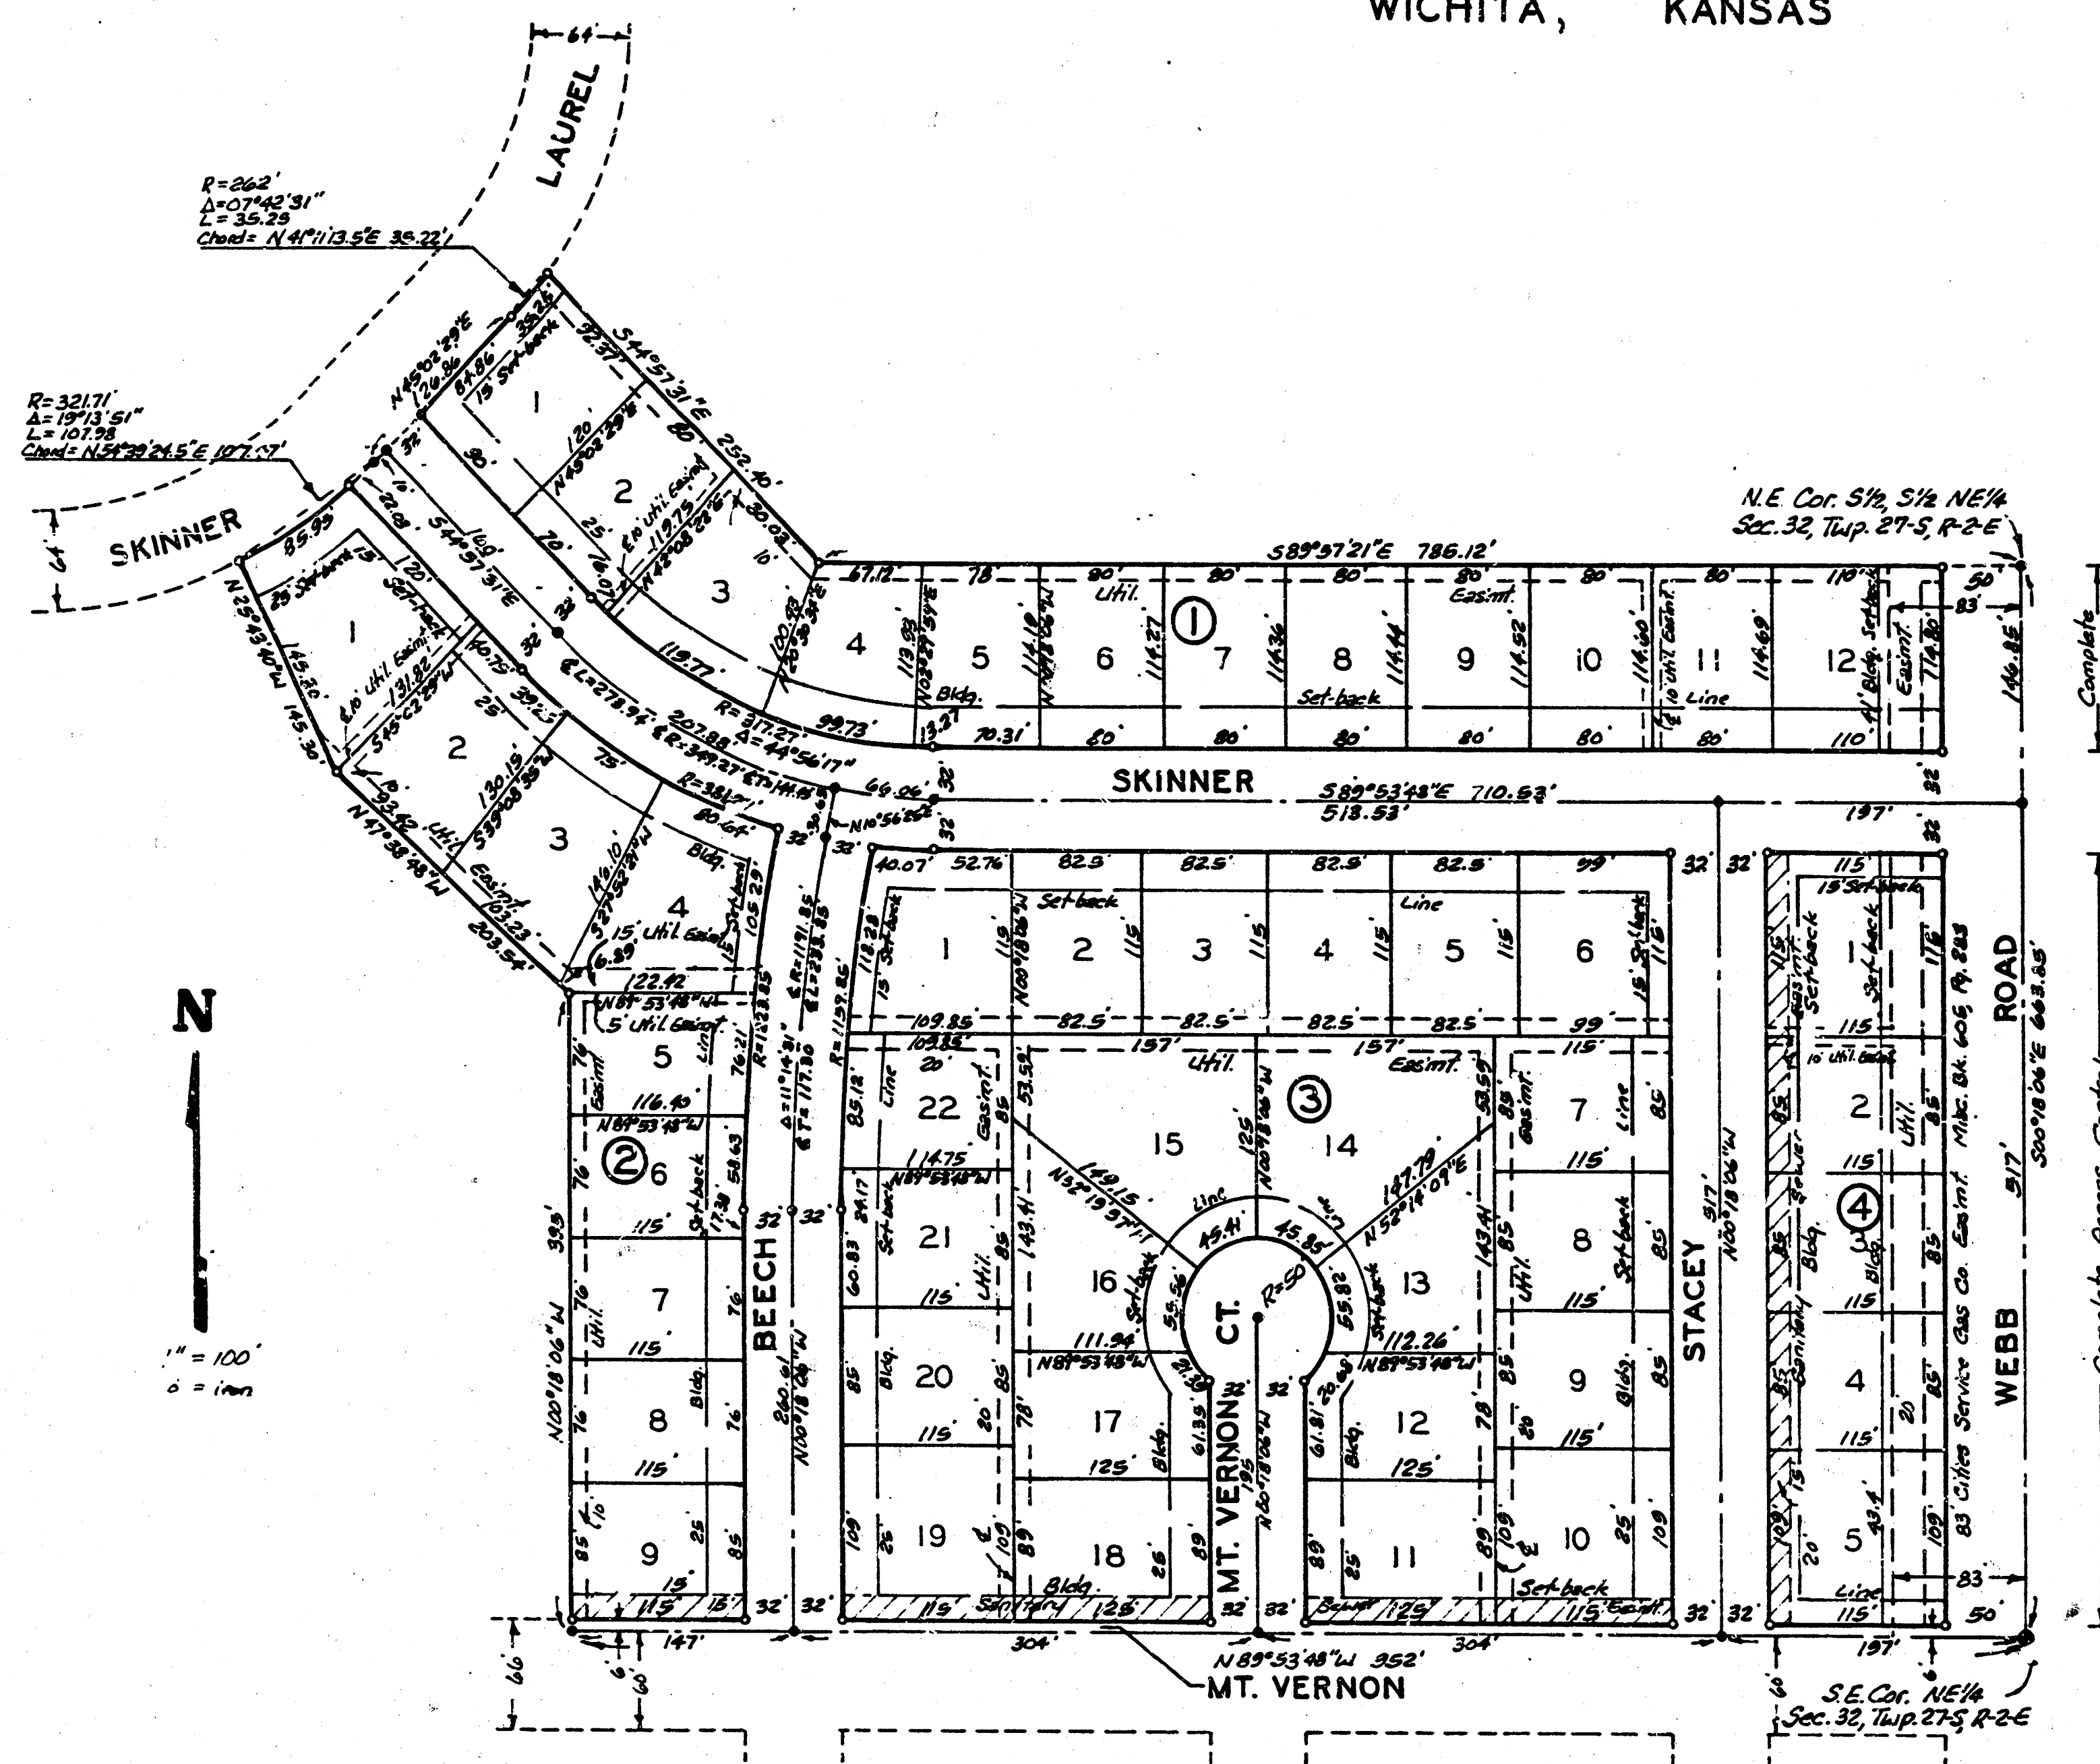

State of Kansas? S.S. We, Baughman Company, P.A. Surveyors in and said county and state do hereby certify that we have surveyed and plotted "FOURTH ADDITION TO CEDAR RIDGE", Wichita, Kansas and that the accompanying plat is a true and correct exhibit of the property surveyed, described as and being a replat of Lot 1, Block 2 and Lots 1 and 2, Block 3 and part of Skinner as platted in First Addition to Cedar Ridge, Wichita, Kansas and part of the S½ of the NE¼ of Sec. 32, Twp. 27-S, R-2-E of the 6th. P.M., Sedgwick County, Kansas, all being described as follows:
Beginning at the S.E. Corner of said NE¼; thence N 89° 53' 43" W, along the south line of said NE¼ 95.2 feet; thence N 00° 13' 06" W, parallel with the east line of said NE¼ 395 feet; thence N 47° 38' 43" W, 203.54 feet; thence N 25° 43' 40" W, 145.30 feet to a point on a curve to the left, having a radius of 321.71 feet, a central angle of 19° 13' 51" and an arc length of 107.98 feet; thence northeasterly, along said curve, having a chord bearing N 54° 38' 24.5" E, 197.47 feet to the point of tangency of said curve; thence N 45° 02' 29" E, along the tangent of said curve, 126.86 feet to the point of curvature of a curve to the left, having a radius of 262 feet; thence northeasterly along said curve, through a central angle of 07° 42' 31", an arc distance of 35.25 feet and having a chord bearing N 41° 11' 13.5" E, 35.22 feet; thence S 44° 57' 31" E, 252.40 feet to a point on the north line of the S½ of the S½ of said NE¼; thence S 89° 57' 21" E, along the north line of the S½ of the S½ of said NE¼, 785.12 feet, to the NE Corner thereof; thence S 00° 18' 06" E, 663.85 feet to the place of beginning. Skinner Street being vacated by virtue of K.S.A. 12-512(b).

1-19-84
LSTB

Baughman Company, P.A.

William L. Korbner
Surveyor

Know all men by these presents, that we the undersigned, have caused the land described in the surveyors' certificate to be platted into Lots, Blocks and Streets to be known as "FOURTH ADDITION TO CEDAR RIDGE" Wichita, Kansas. Easements are hereby granted as indicated for the construction and maintenance of all public utilities. The streets are hereby dedicated to and for the use of the public. All abutters rights of access to or from Webb Rd. over and across the east line of Lot 12, Block 1, and the east line of Lots 1, 2, 3, 4 and 5, Block 2, are hereby granted to the City of Wichita, Kansas.

Cherry Creek Development, Inc.

Clifford A. Nies
President

Equitable Owner
Red Oaks, Inc.

Stephen Russell
President

State of Kansas? S.S. The foregoing instrument was acknowledged before me, this 2nd day of February, 1984, by Clifford A. Nies, President of Cherry Creek Development, Inc., on behalf of the corporation and by Stephen Russell, President of Red Oaks, Inc., on behalf of the corporation.

Mark A. Savoy
Notary Public

My Appt. Exp. 12 May 1984

This plat of "FOURTH ADDITION TO CEDAR RIDGE", Wichita, Kansas, has been submitted to and approved by the Wichita-Sedgwick County Metropolitan Area Planning Commission, Wichita, Kansas. Dated this 22nd day of March, 1984.

Wichita-Sedgwick County Metropolitan Area Planning Commission.

Robert E. Chynoweth
Chairman
Robert A. Lakin
Secretary

This plat approved and all dedications shown hereon accepted by the Board of Commissioners of Wichita, Kansas, this 3rd day of April, 1984.

Margaret Wright
Mayor
Donald E. Black
City Clerk

This plat approved and all dedications shown hereon accepted by the Board of Commissioners of Sedgwick County, Kansas, this day of April, 1984.

Jack Spratt
Chairman
Donald E. Gregg
Commissioner
Tom Scott
County Clerk
Dorothy K. White

Entered on transfer record this day of April, 1984.

Dorothy K. White
County Clerk

State of Kansas? S.S. This is to certify that this plat has been filed for record in the office of the Register of Deeds, this day of April, 1984, at 11 o'clock A.M., and is duly recorded.

Bette F. McCort
Register of Deeds
Pat Kettler
Deputy