


LATERAL 73, WAR INDUSTRIES SEWER

Project no. 468-76-245-81168-000-000-001

CITY OF WICHITA, KANSAS
MIKE E. LINDEBAK CITY ENGINEER

As Built
J.L.
8-84

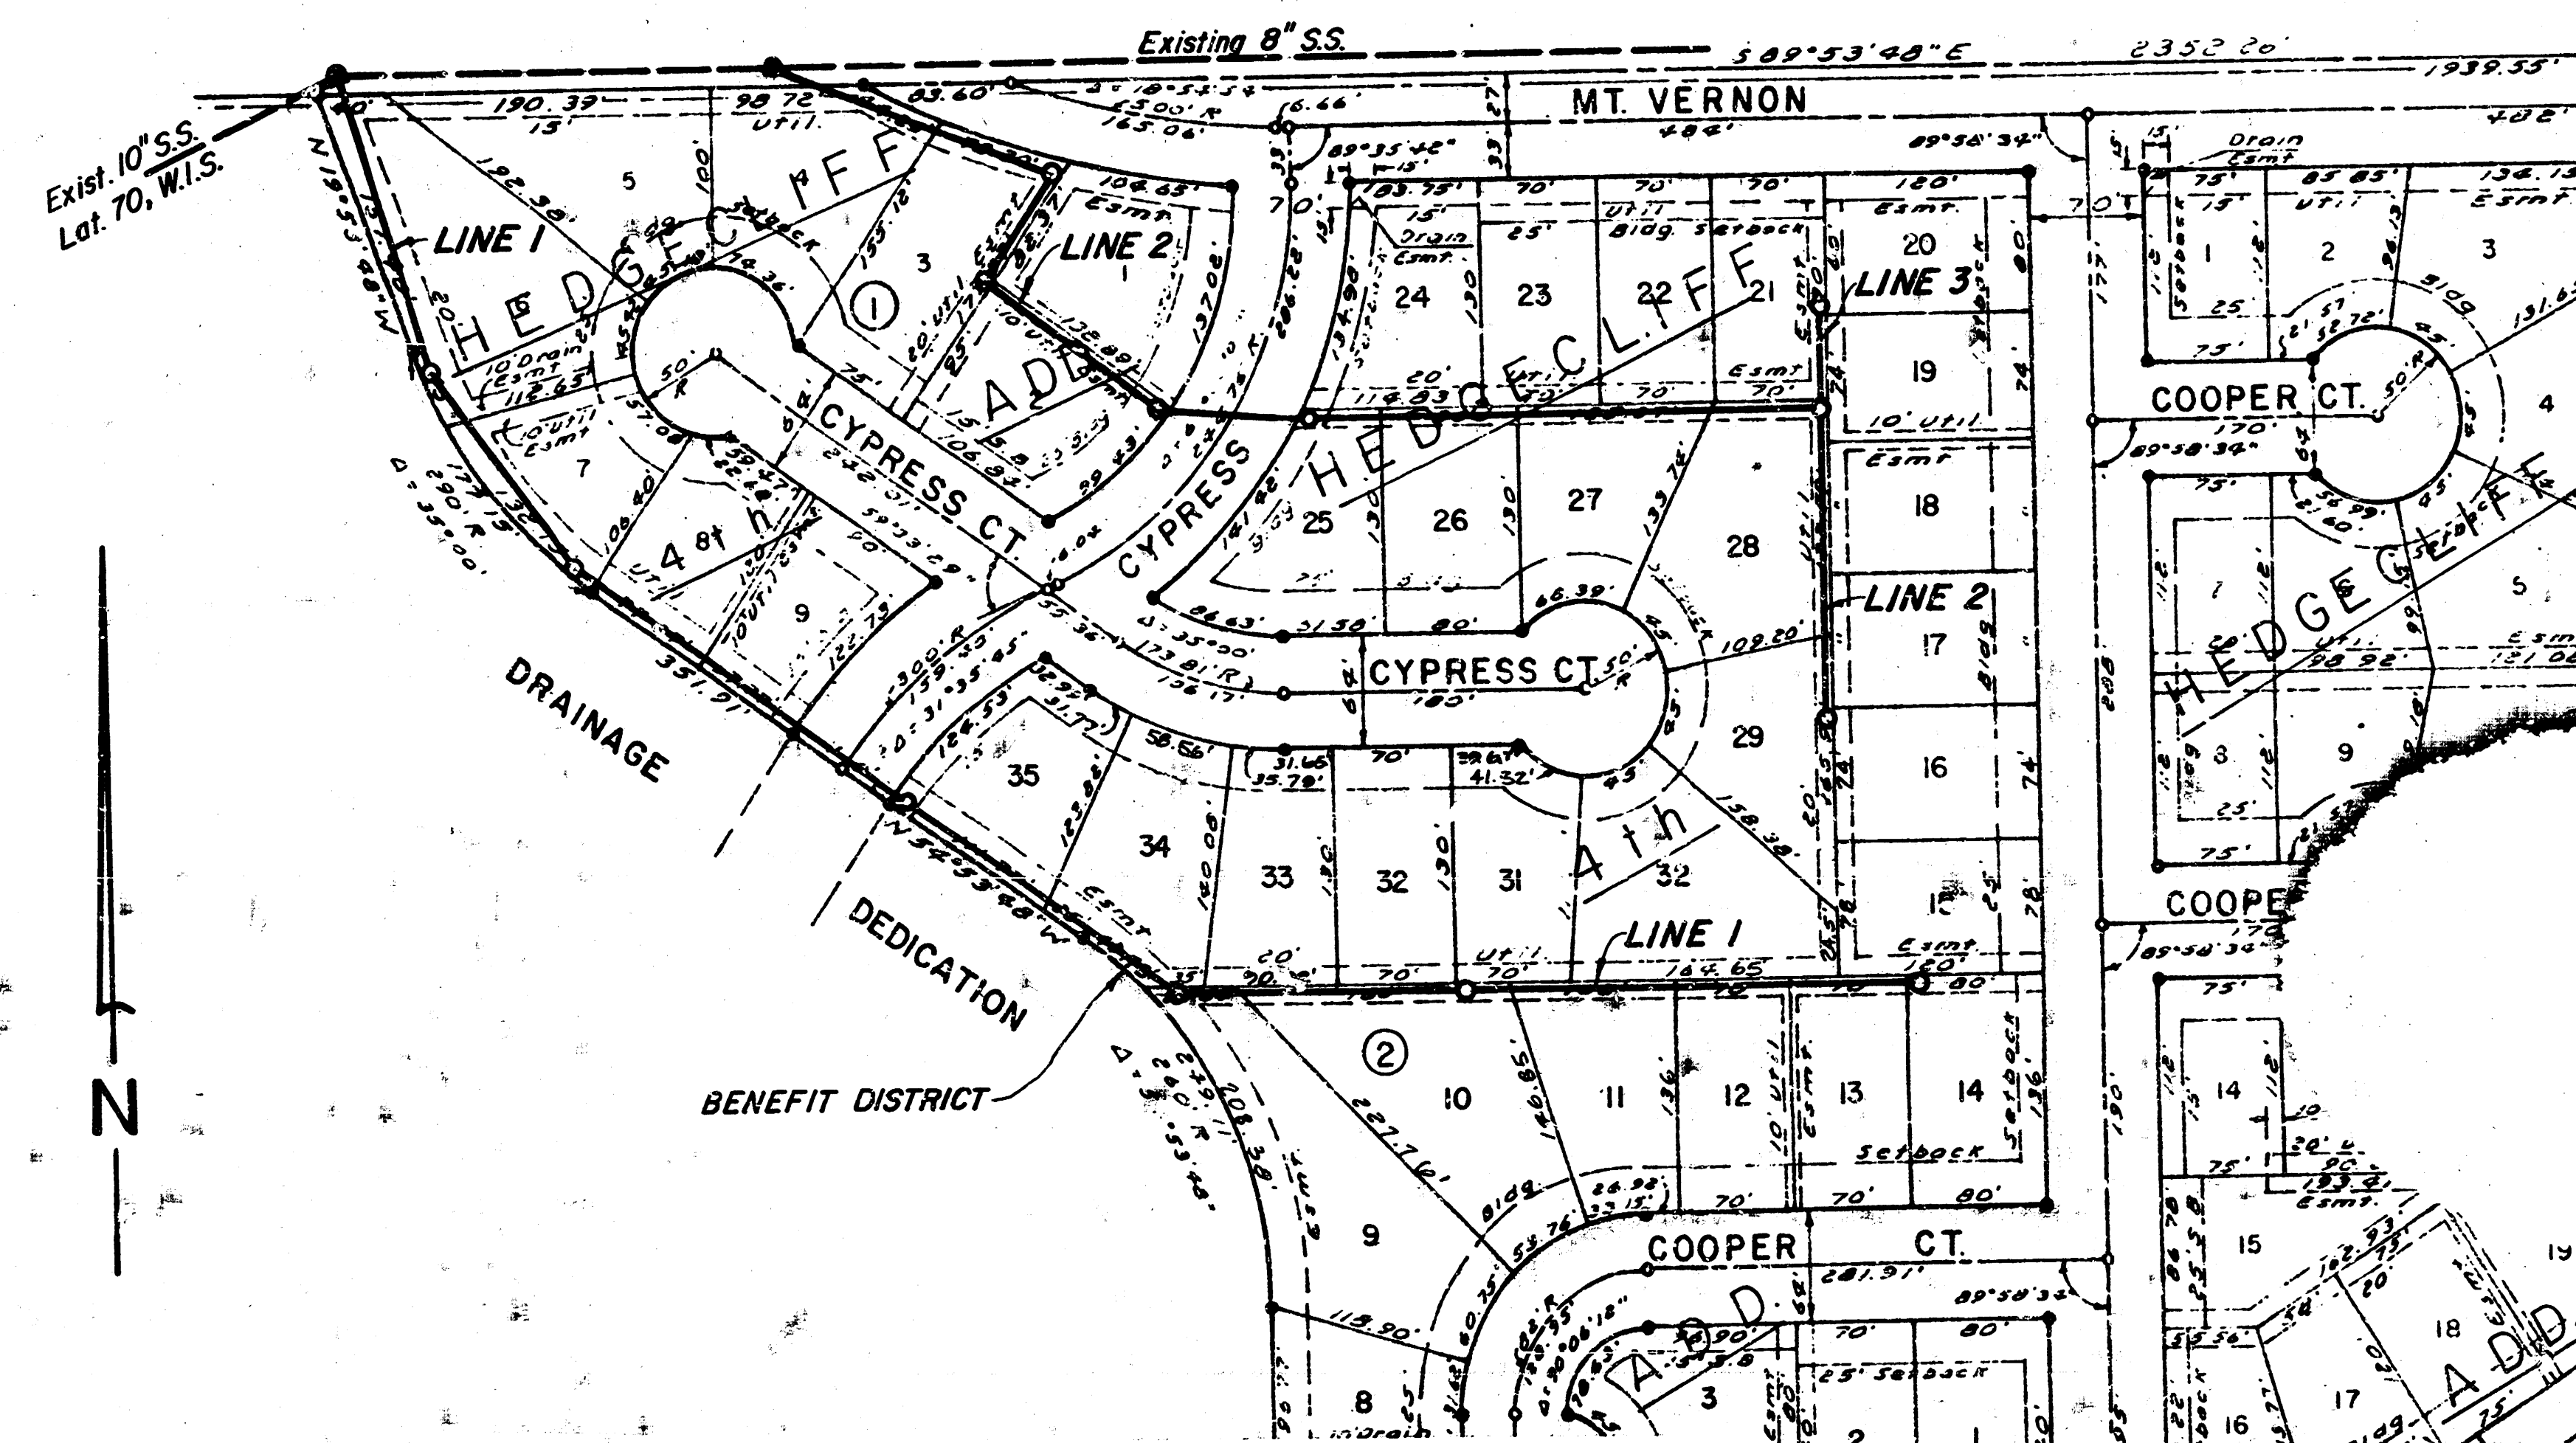


NOTE: AREA SERVED BY THIS SEWER IS PRESENTLY PLATTED AS HEDGECLIFF 3RD ADDITION AND IS IN THE PROCESS OF BEING PLATTED INTO HEDGECLIFF 4TH ADDITION.





BAUGHMAN COMPANY, P.A.
SURVEYING & ENGINEERING
314/262-7221 • 330 LAURA • WICHITA, KANSAS 67211

FILMED FROM THE BEST
AVAILABLE COPY

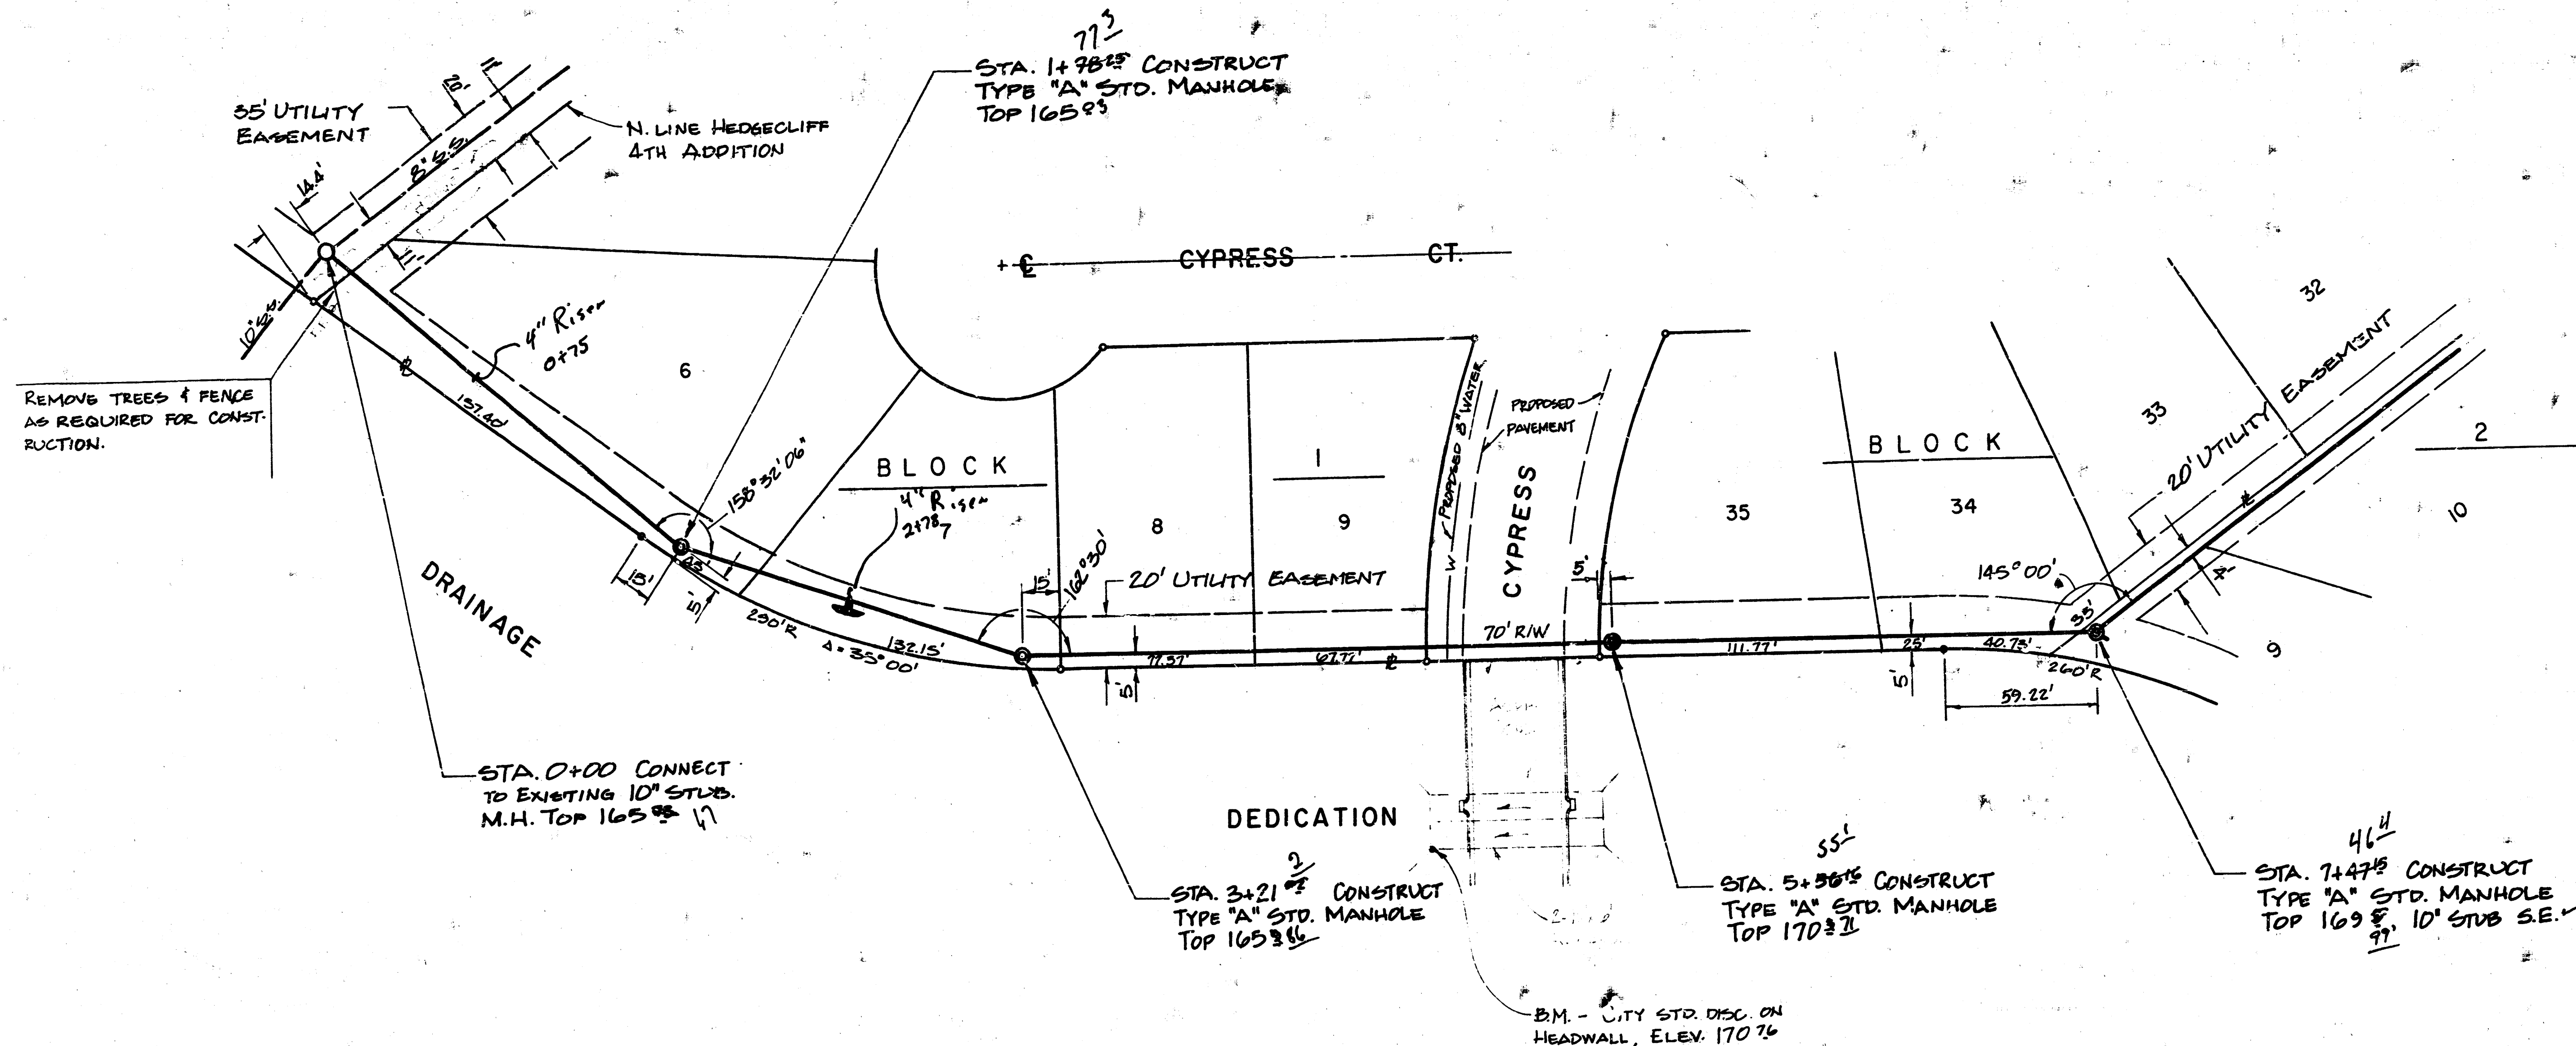

As Built
J.L.L.
8-84





SCALE
PLAN 1" = 40'
PROFILE 1" = 40' HORIZ.
1" = 5' VERT.

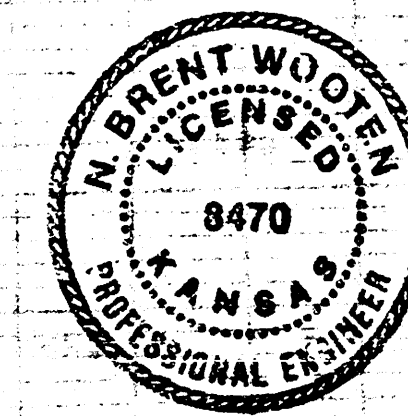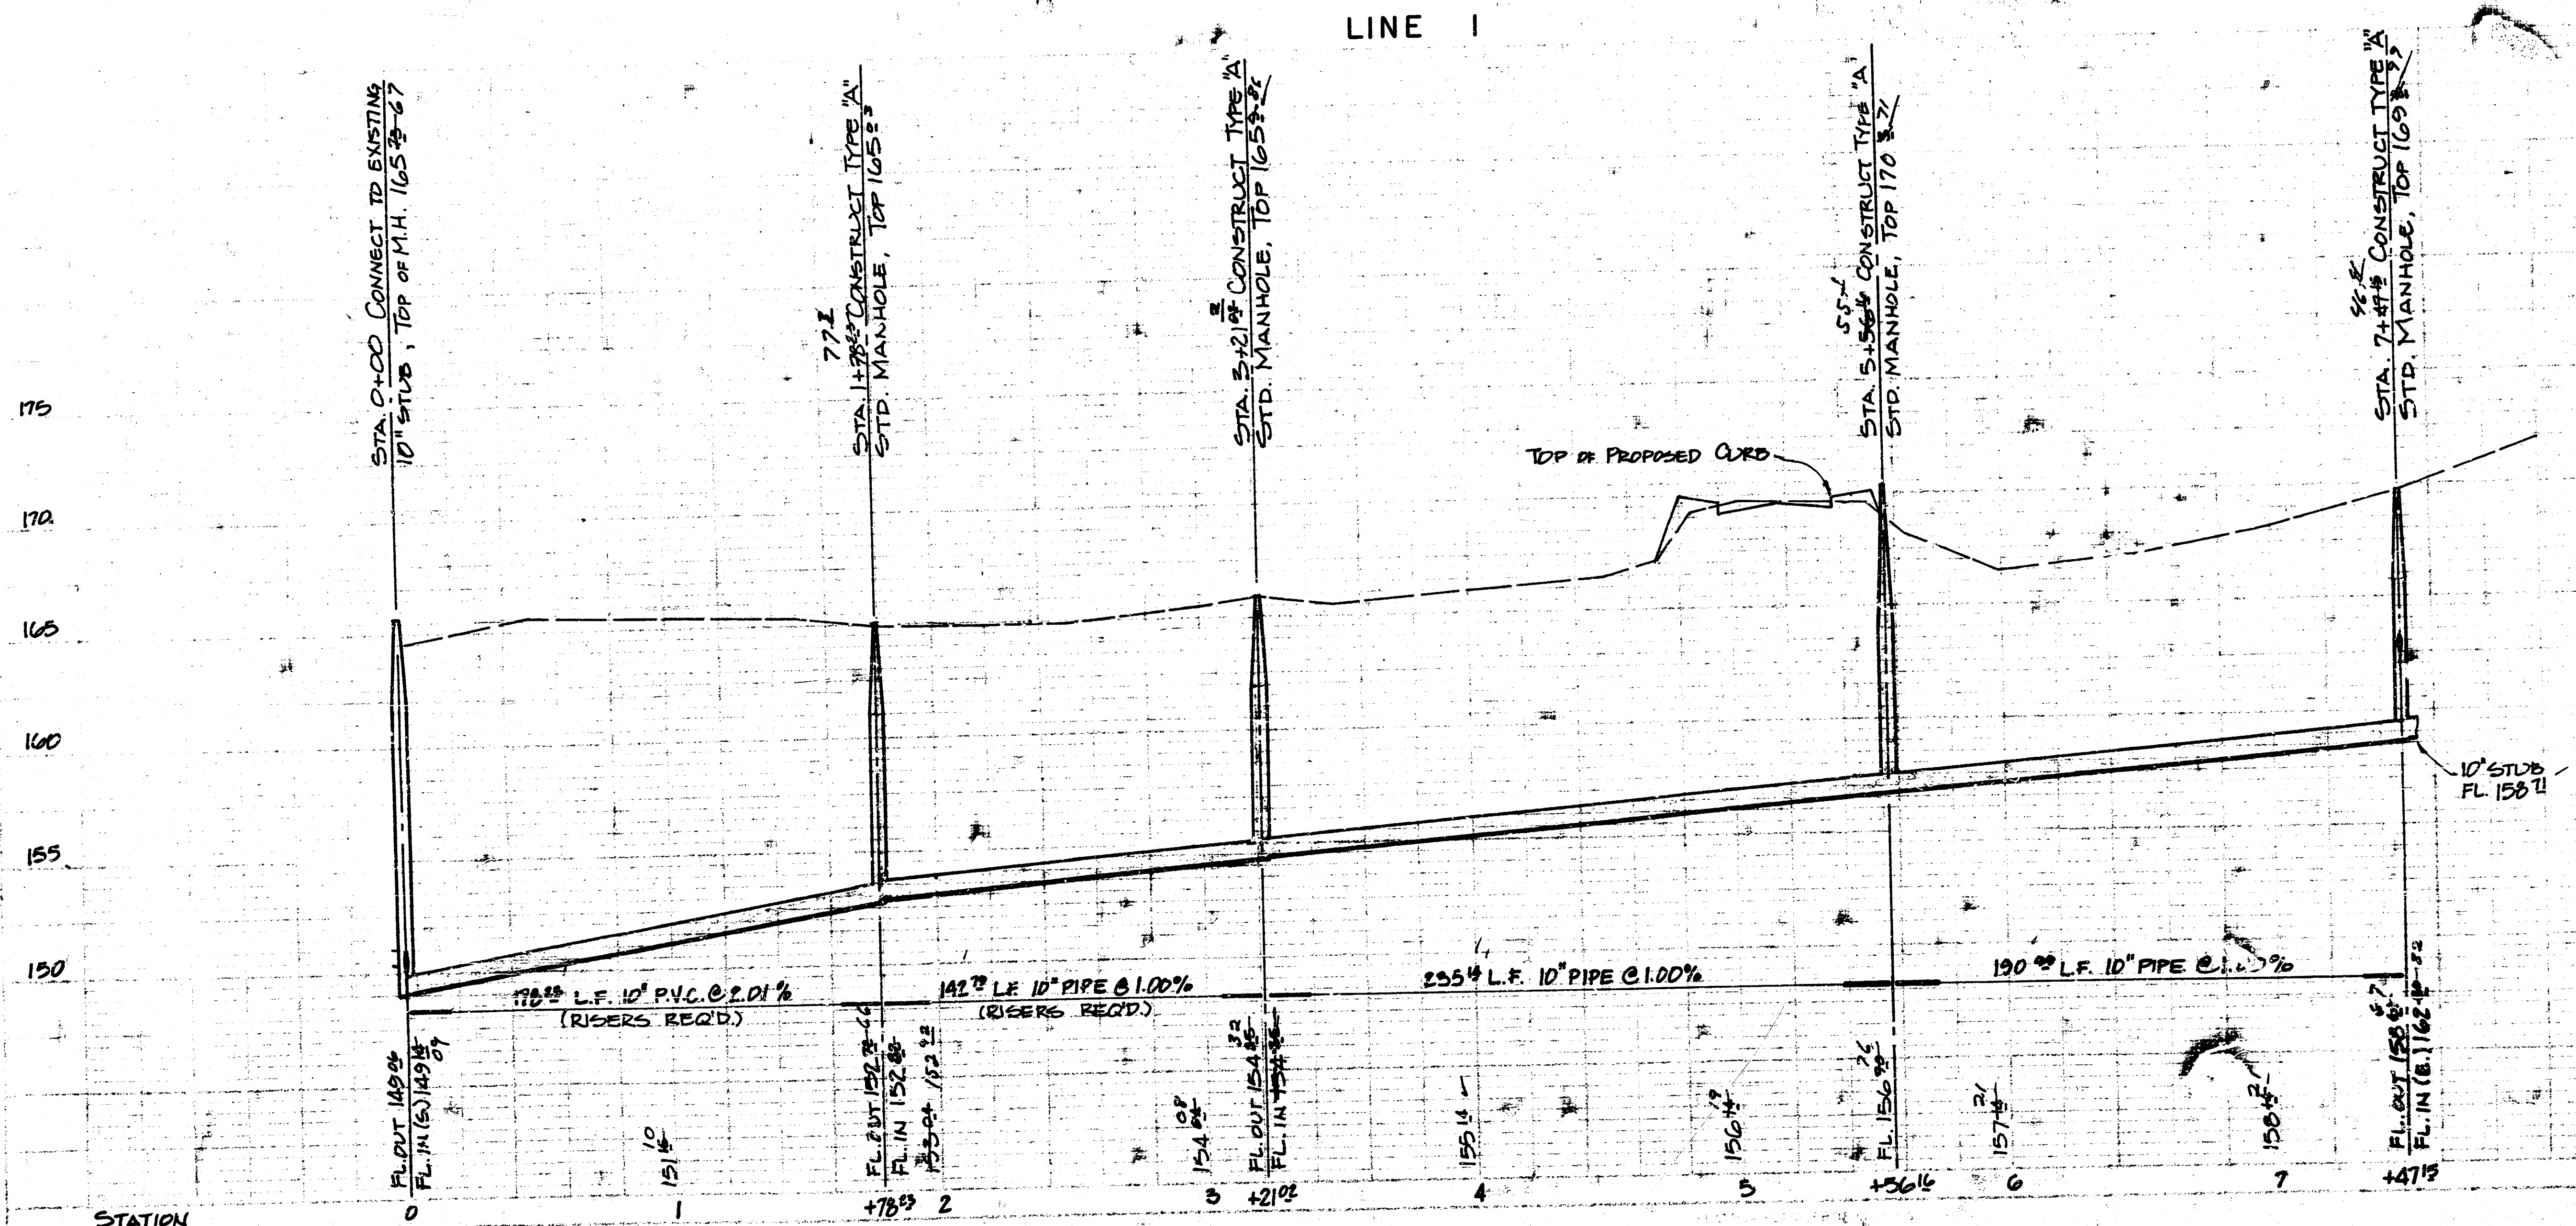

**LATERAL 73
WAR INDUSTRIES SEWER**
City of Wichita, Kansas
Project No. 68-76-245-81168-000-001



BAUGHMAN COMPANY, P.A.
SURVEYING & ENGINEERING
2147 245-7771 • 220 S. WABASH • WICHITA, KANSAS 67211

FILMED FROM THE BEST
AVAILABLE COPY.....

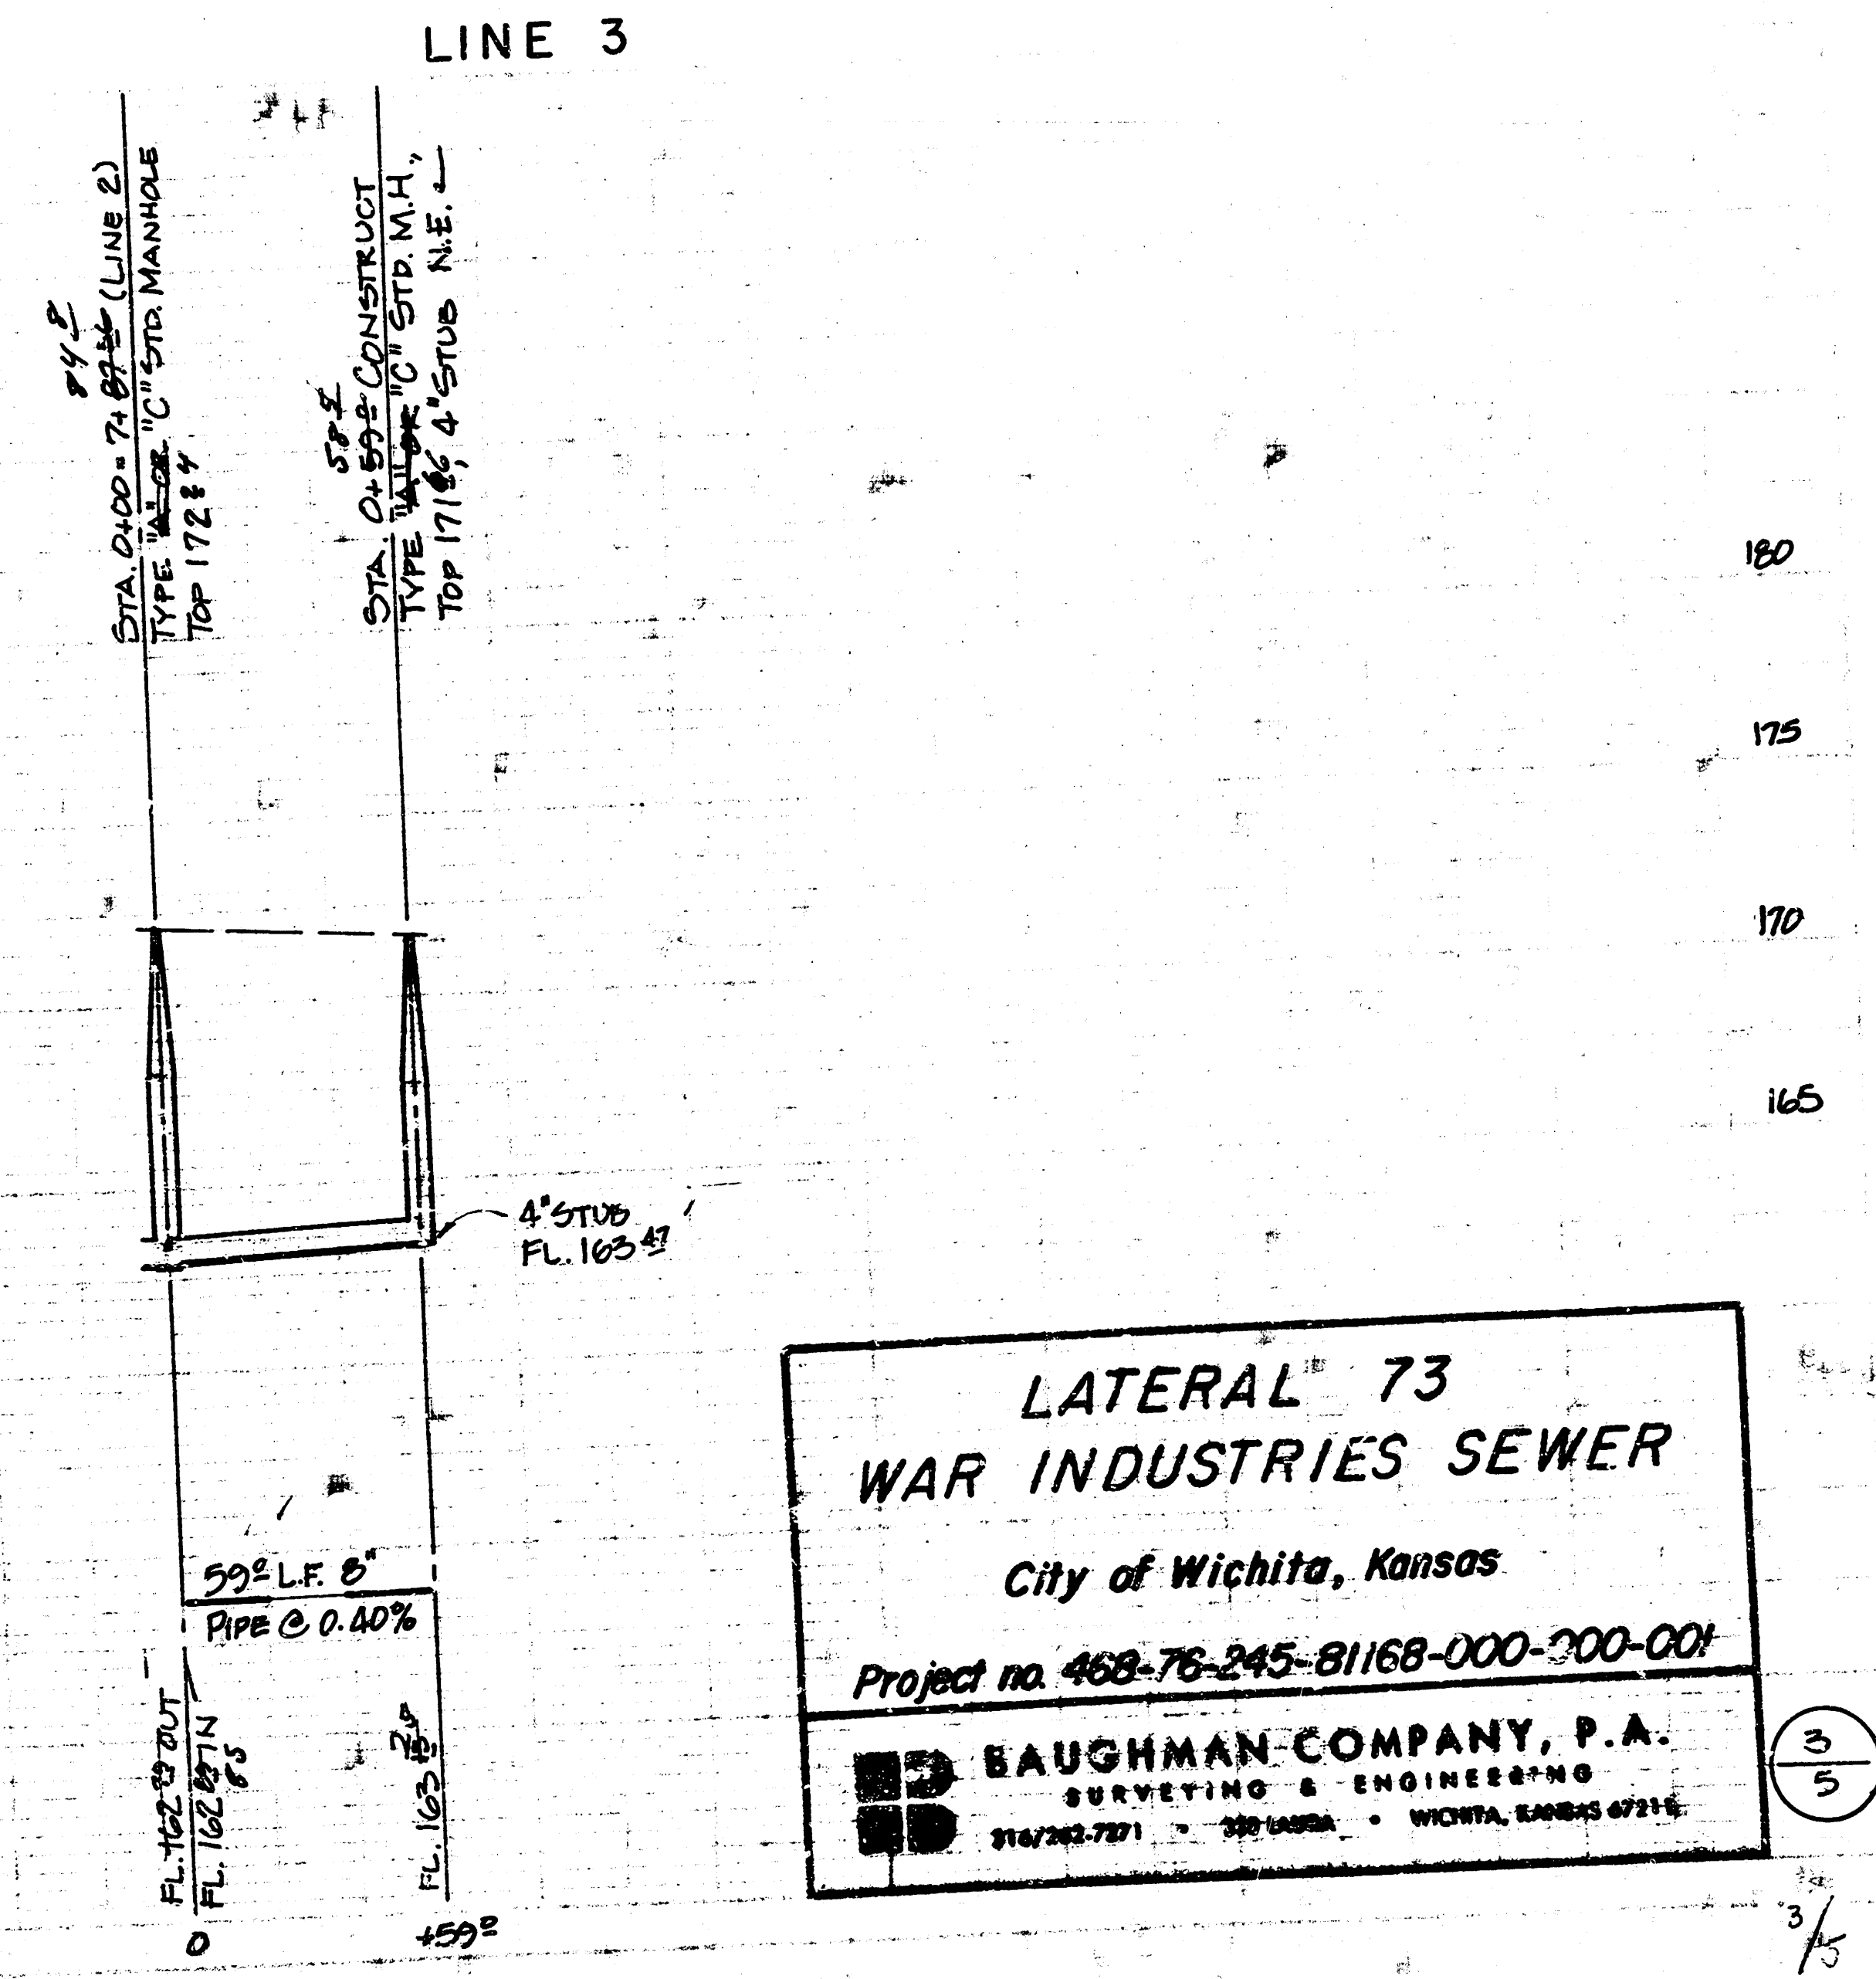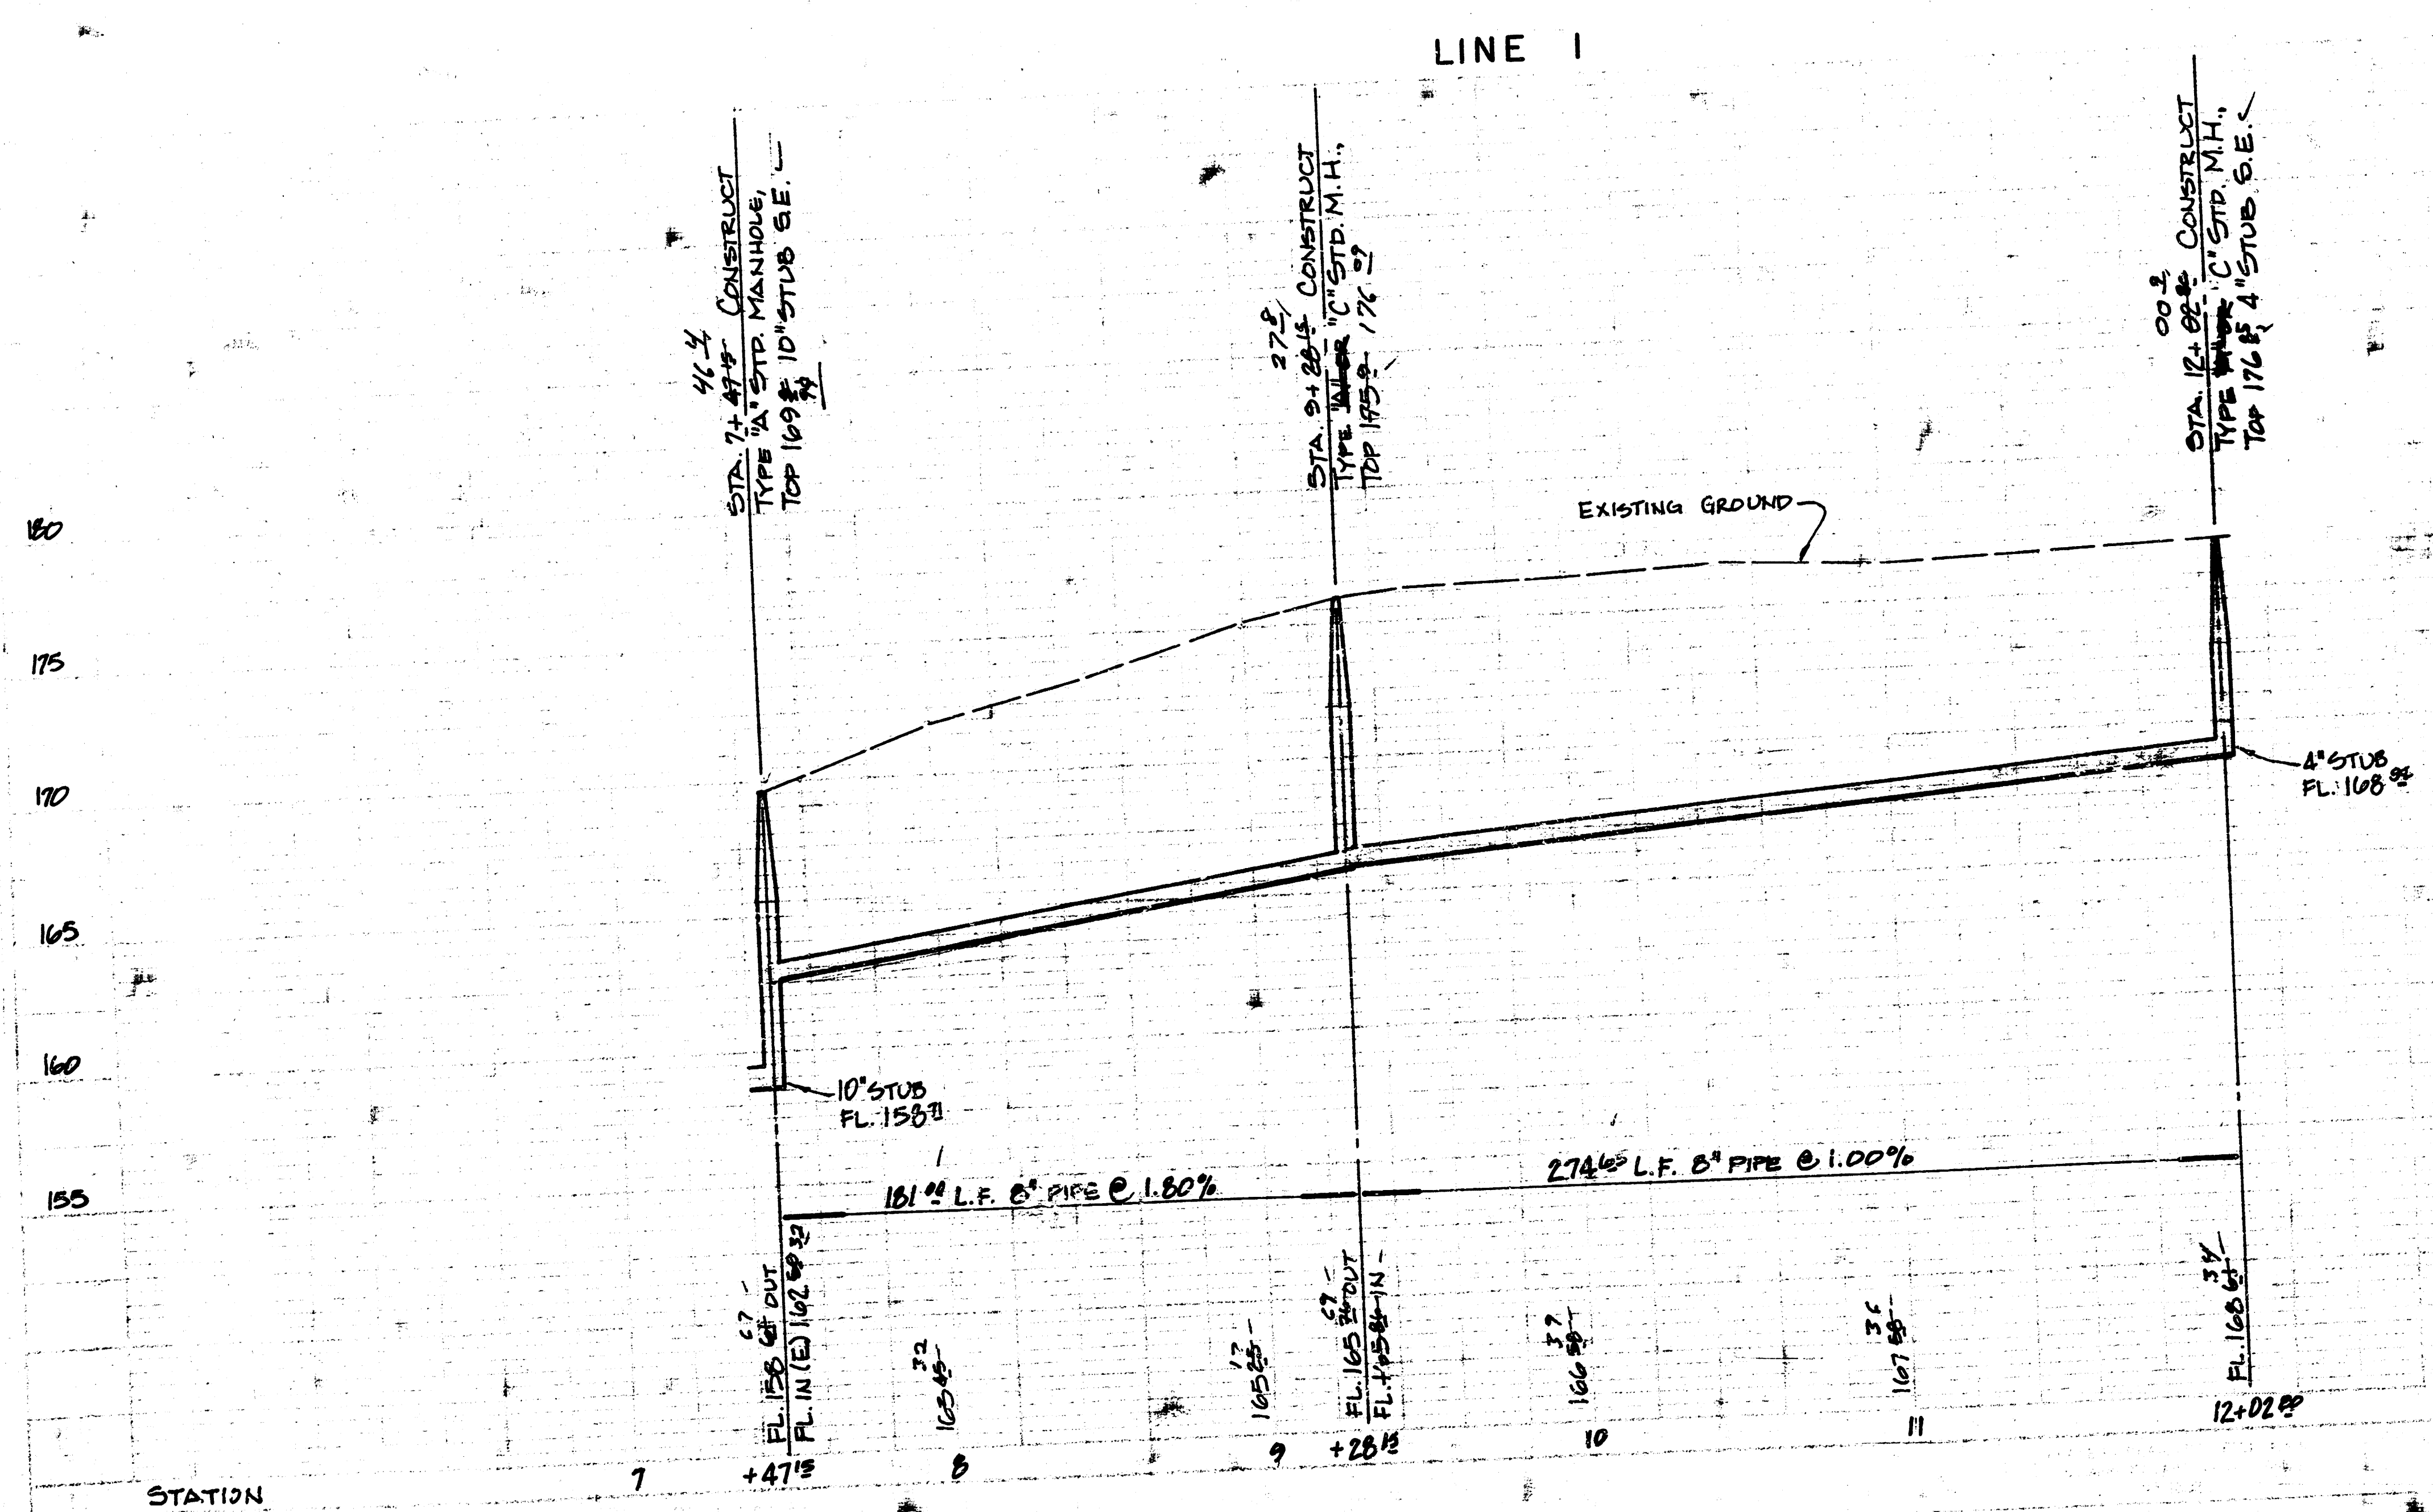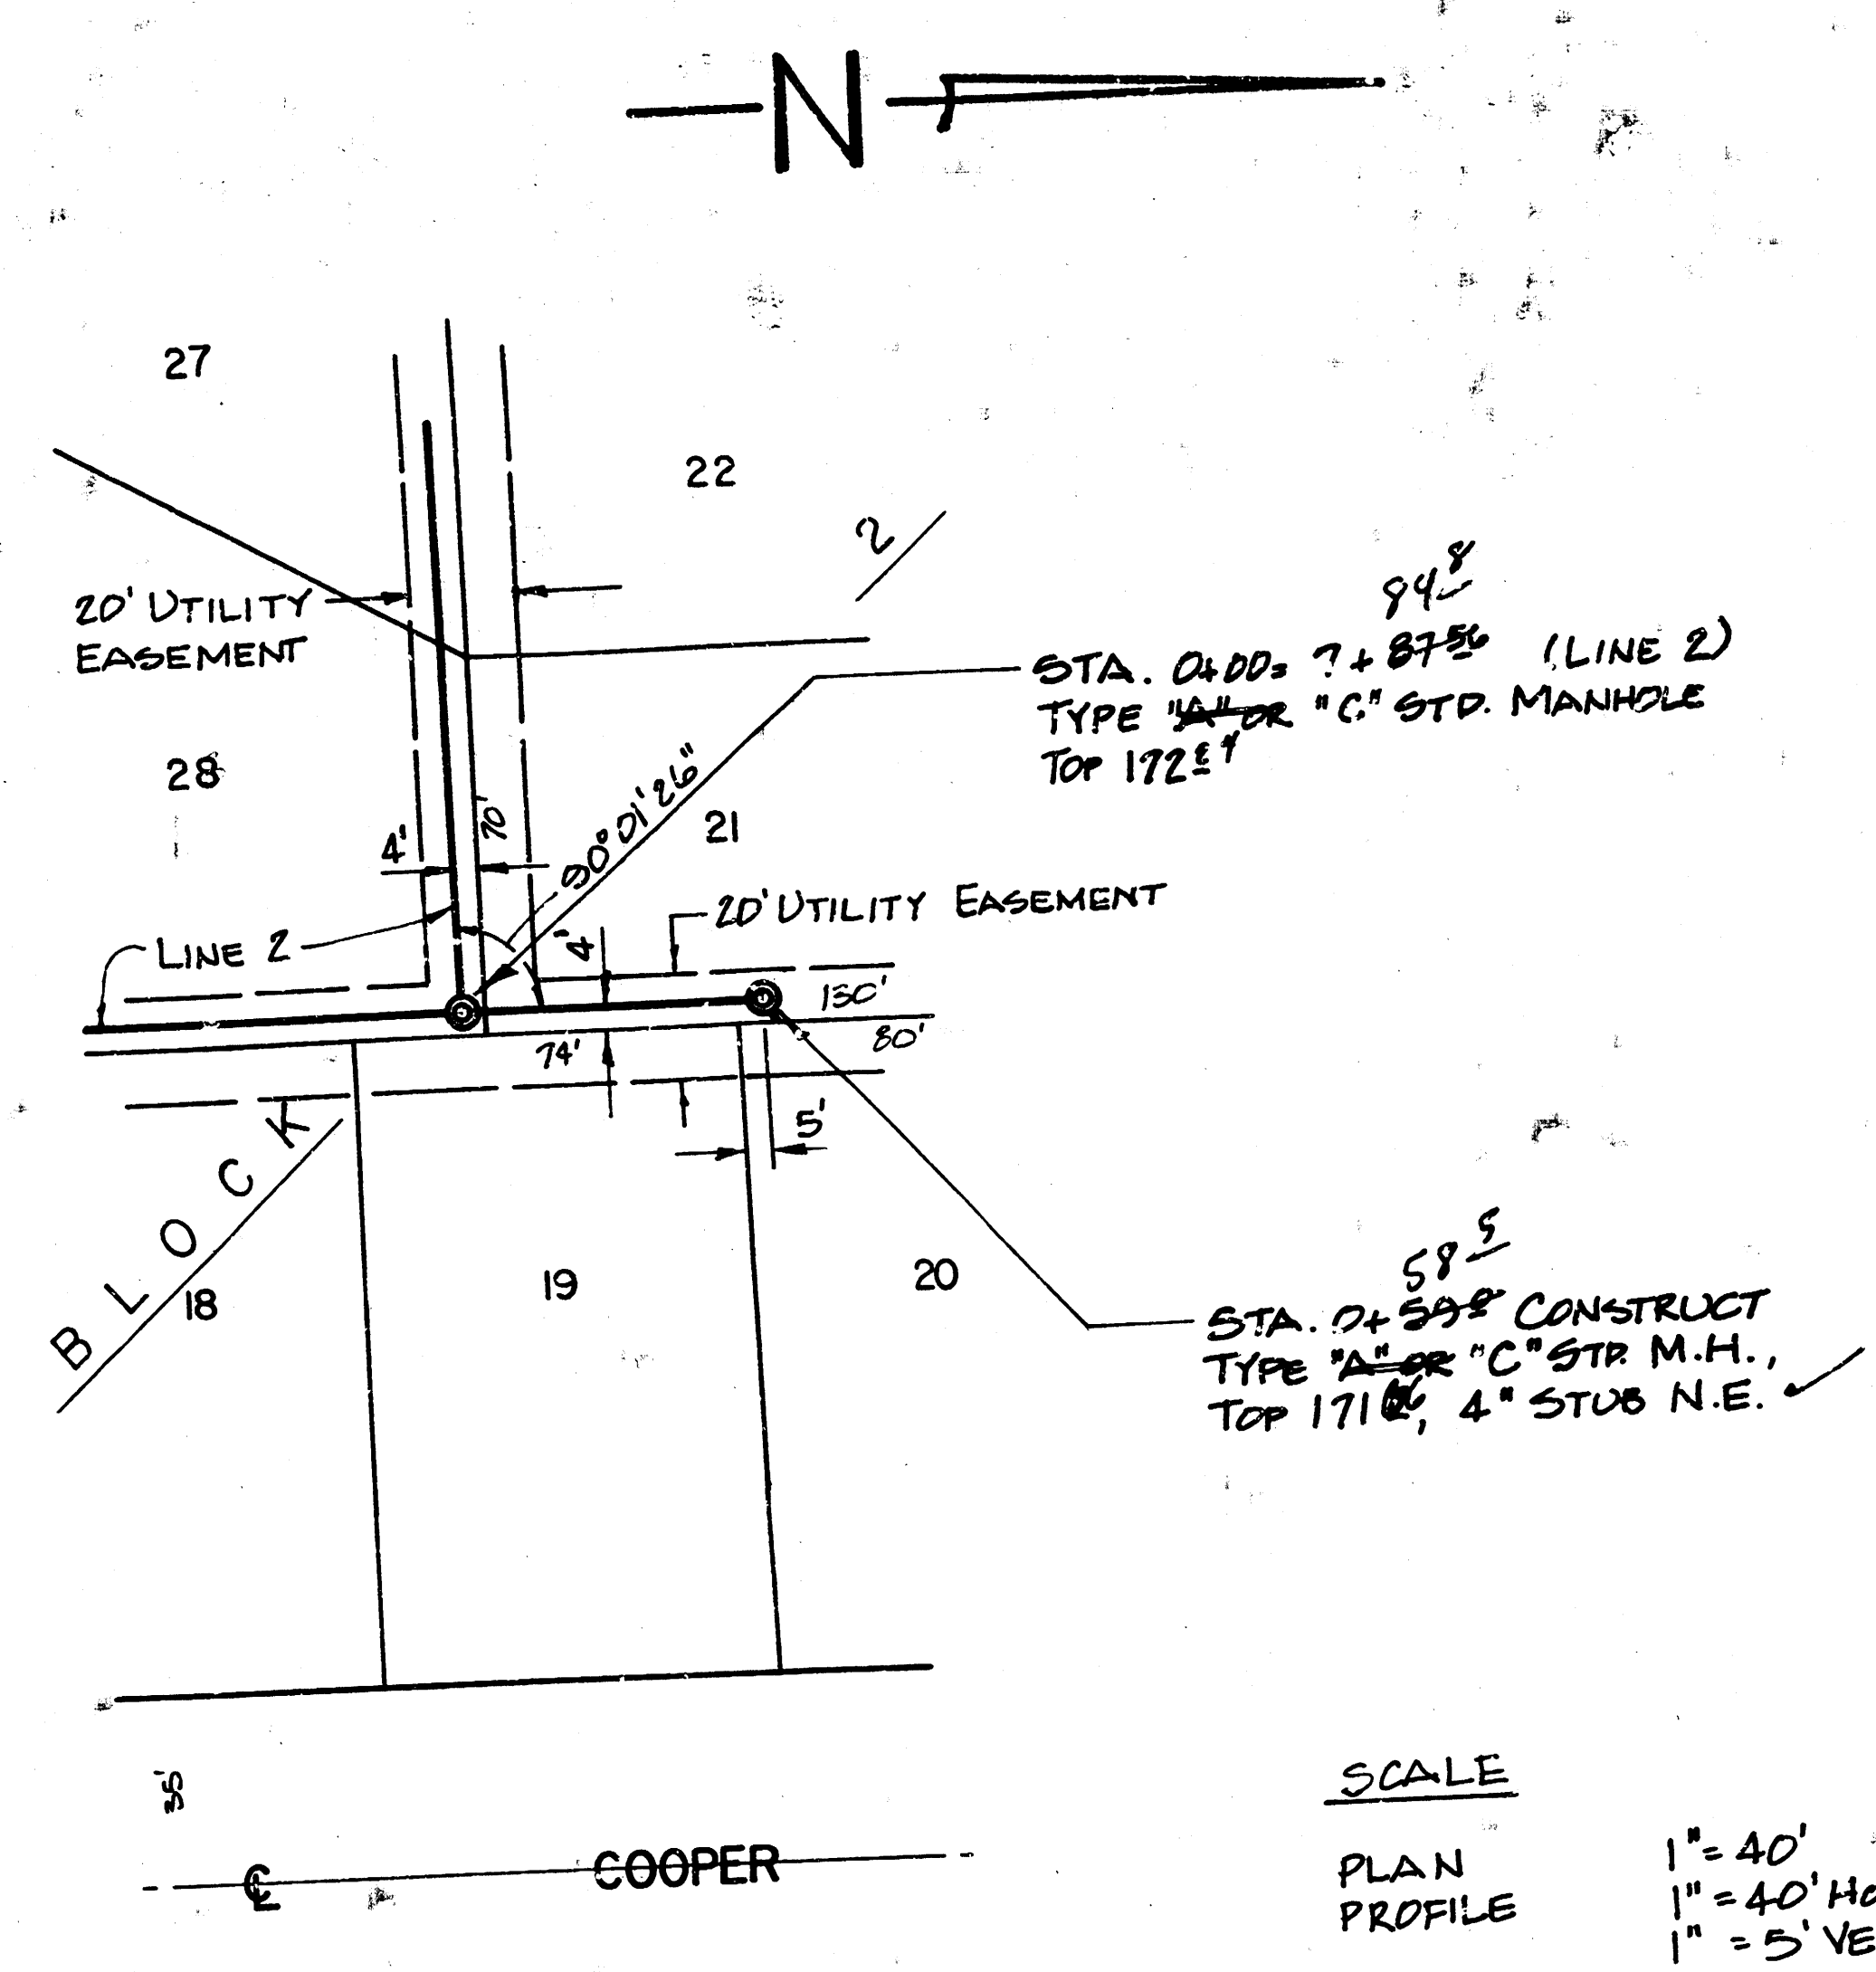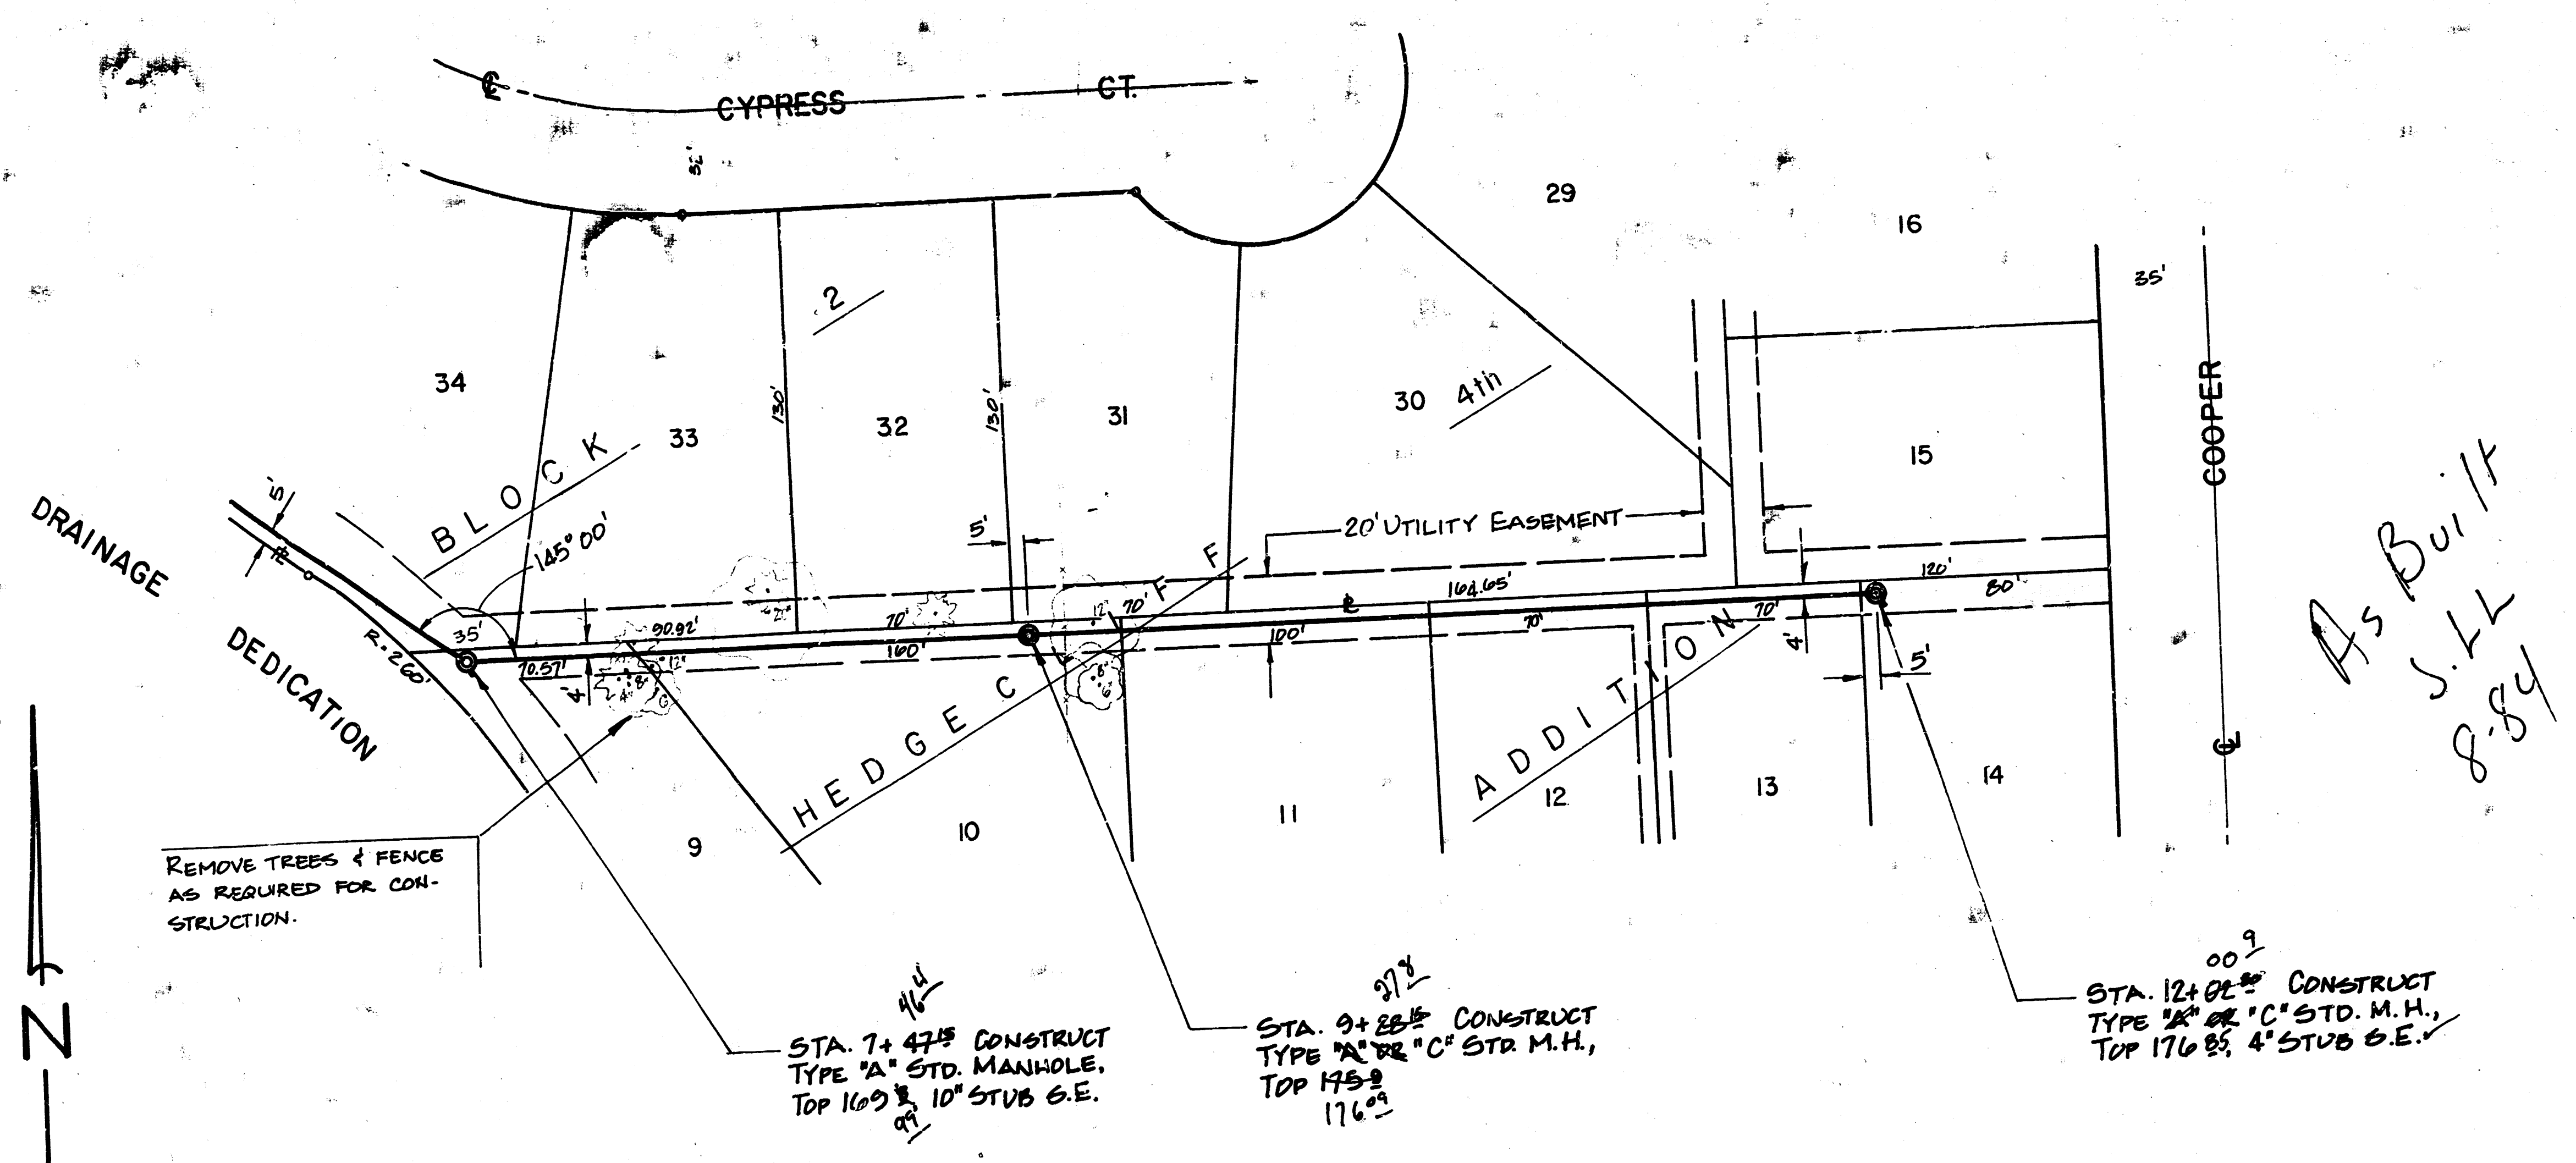

LATERAL 73
WAR INDUSTRIES SEWER
City of Wichita, Kansas
Project no. 468-76-245-81168-000-001
BAUGHMAN COMPANY, P.A.
SURVEYING & ENGINEERING
314/262-7271 • 300 W. 10TH • WICHITA, KANSAS 67214

FILMED FROM THE BEST AVAILABLE COPY....

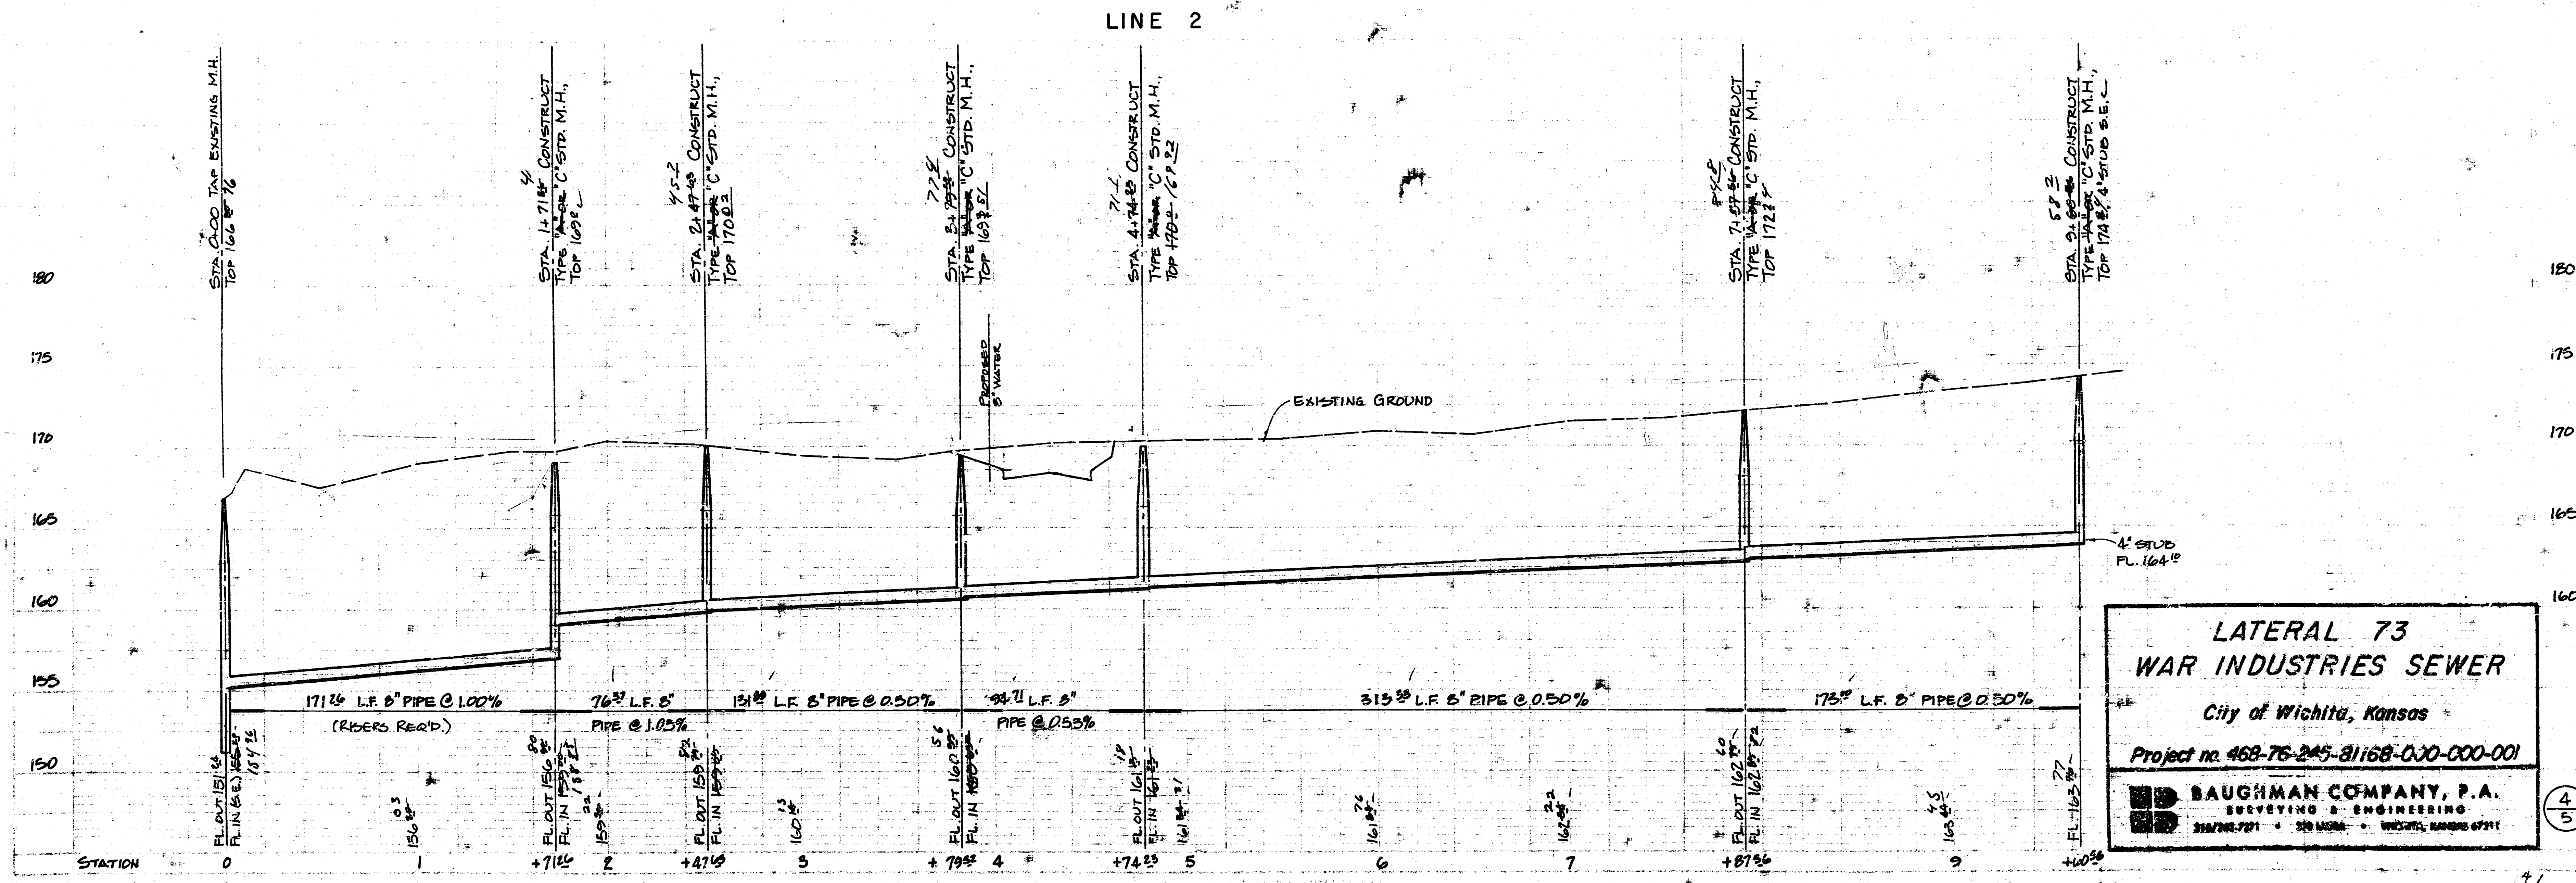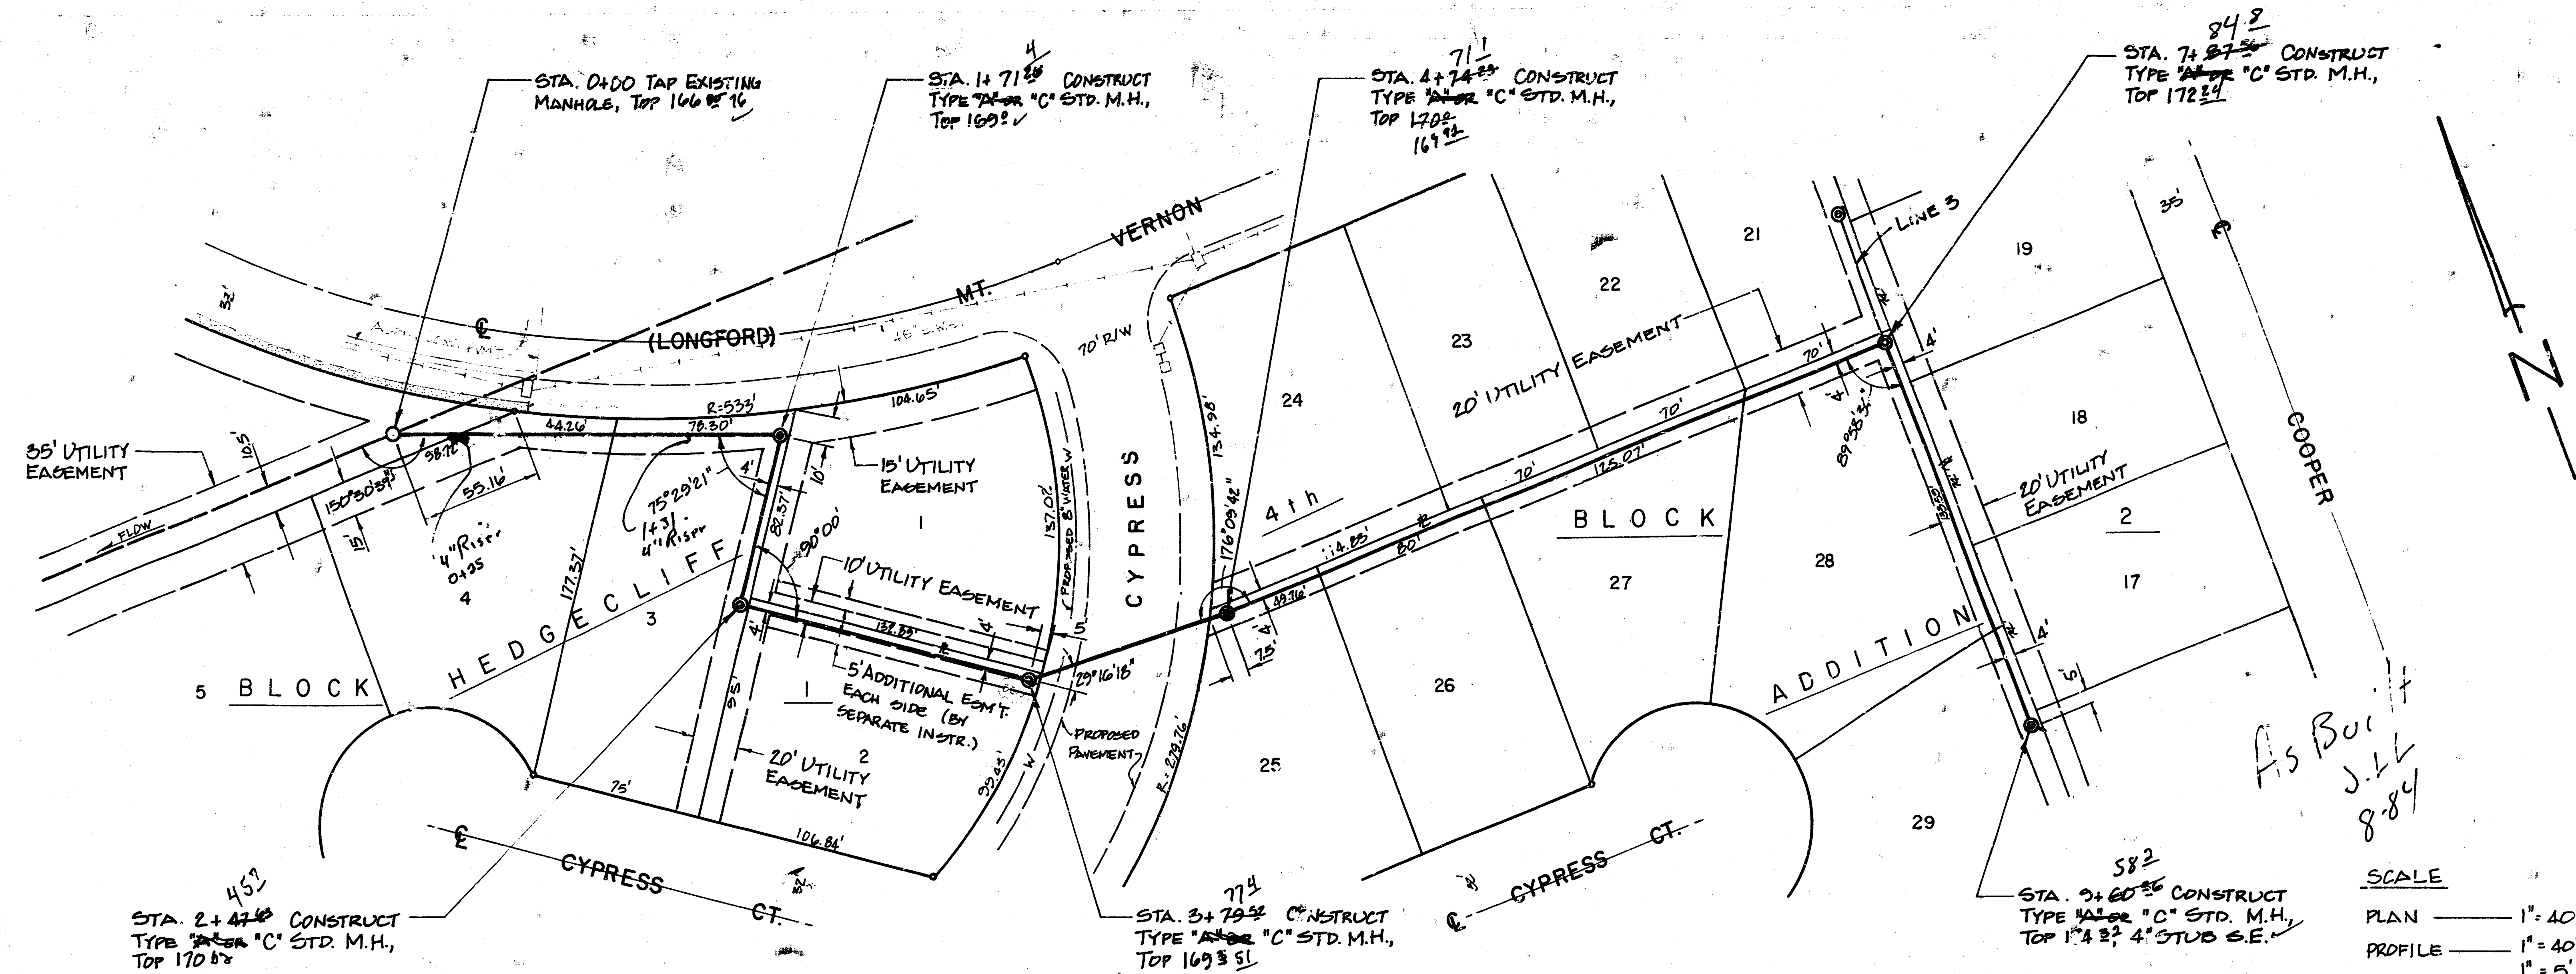


**LATERAL 73
WAR INDUSTRIES SEWER**
City of Wichita, Kansas
Project no. 468-76-245-81168-000-001

BAUGHMAN COMPANY, P.A.
SURVEYING & ENGINEERING
2107 W. 21ST ST. • WICHITA, KANSAS 67211

4/5


VERTICAL RISER DETAIL ADOPTED AS STANDARD DESIGN BY

CITY OF WICHITA, KANSAS

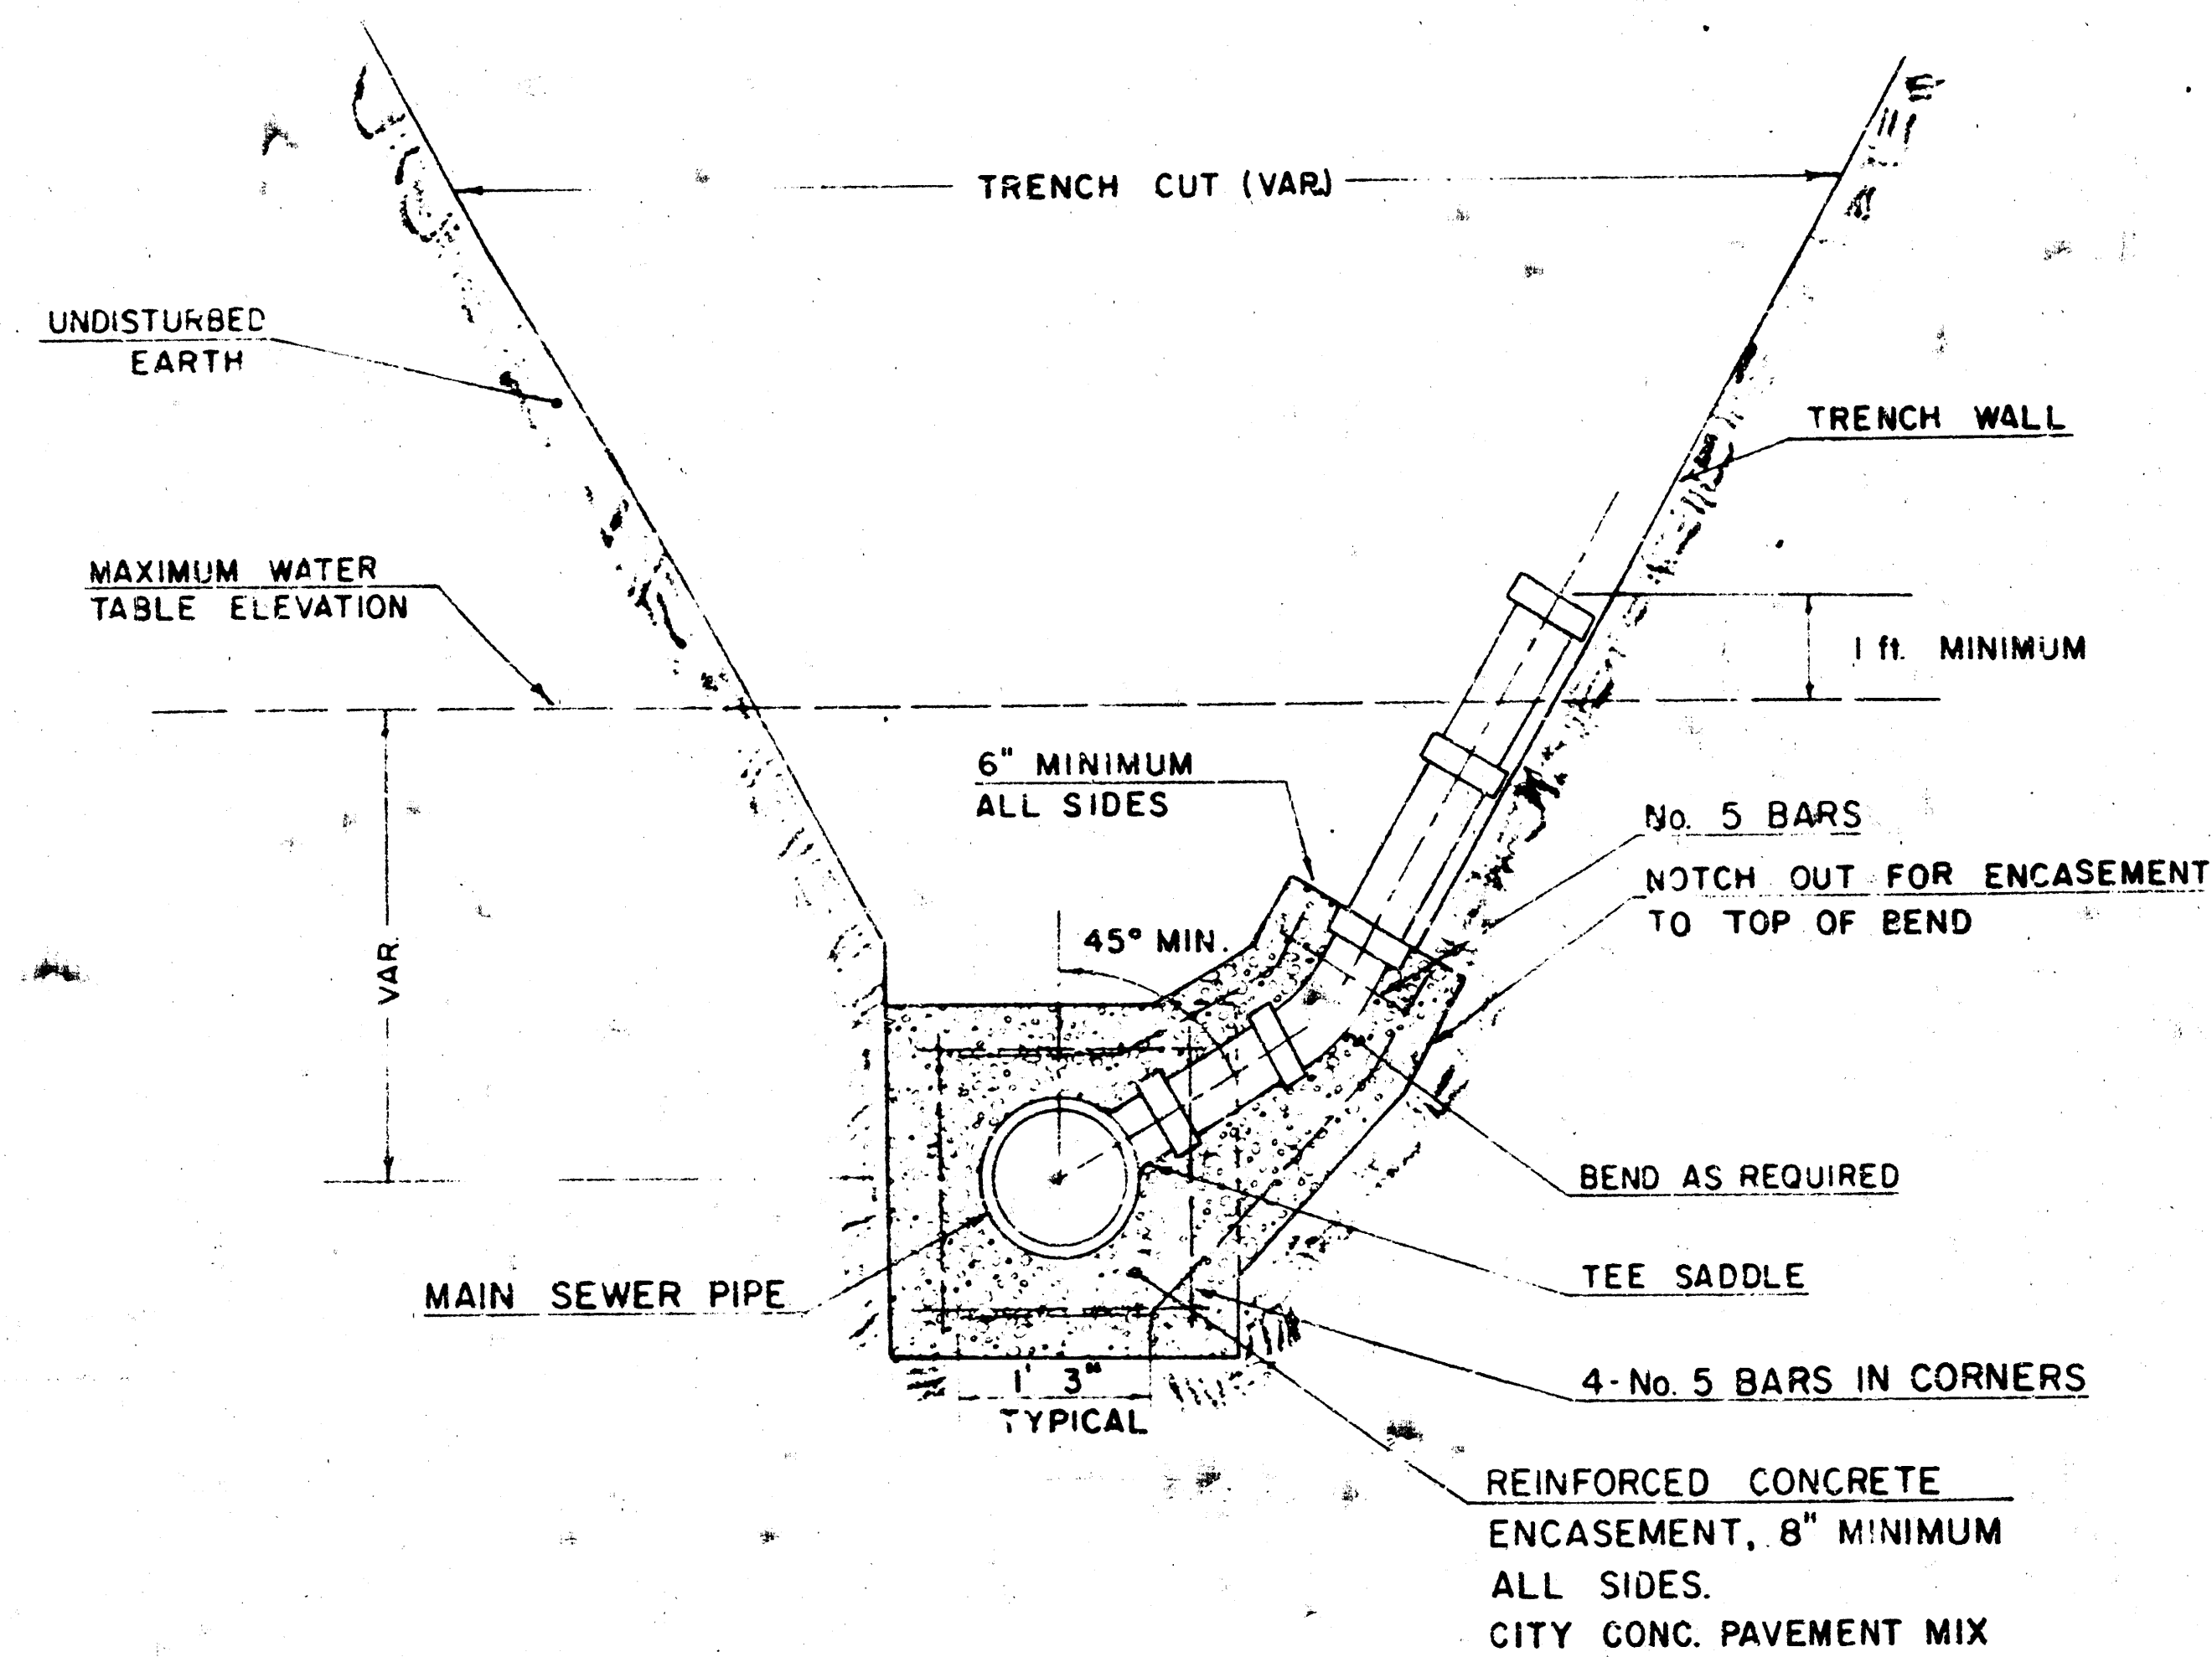


TYPICAL RISER FOR SLOPING TRENCH WALLS

NOTE:
TOP OF 4\"/>

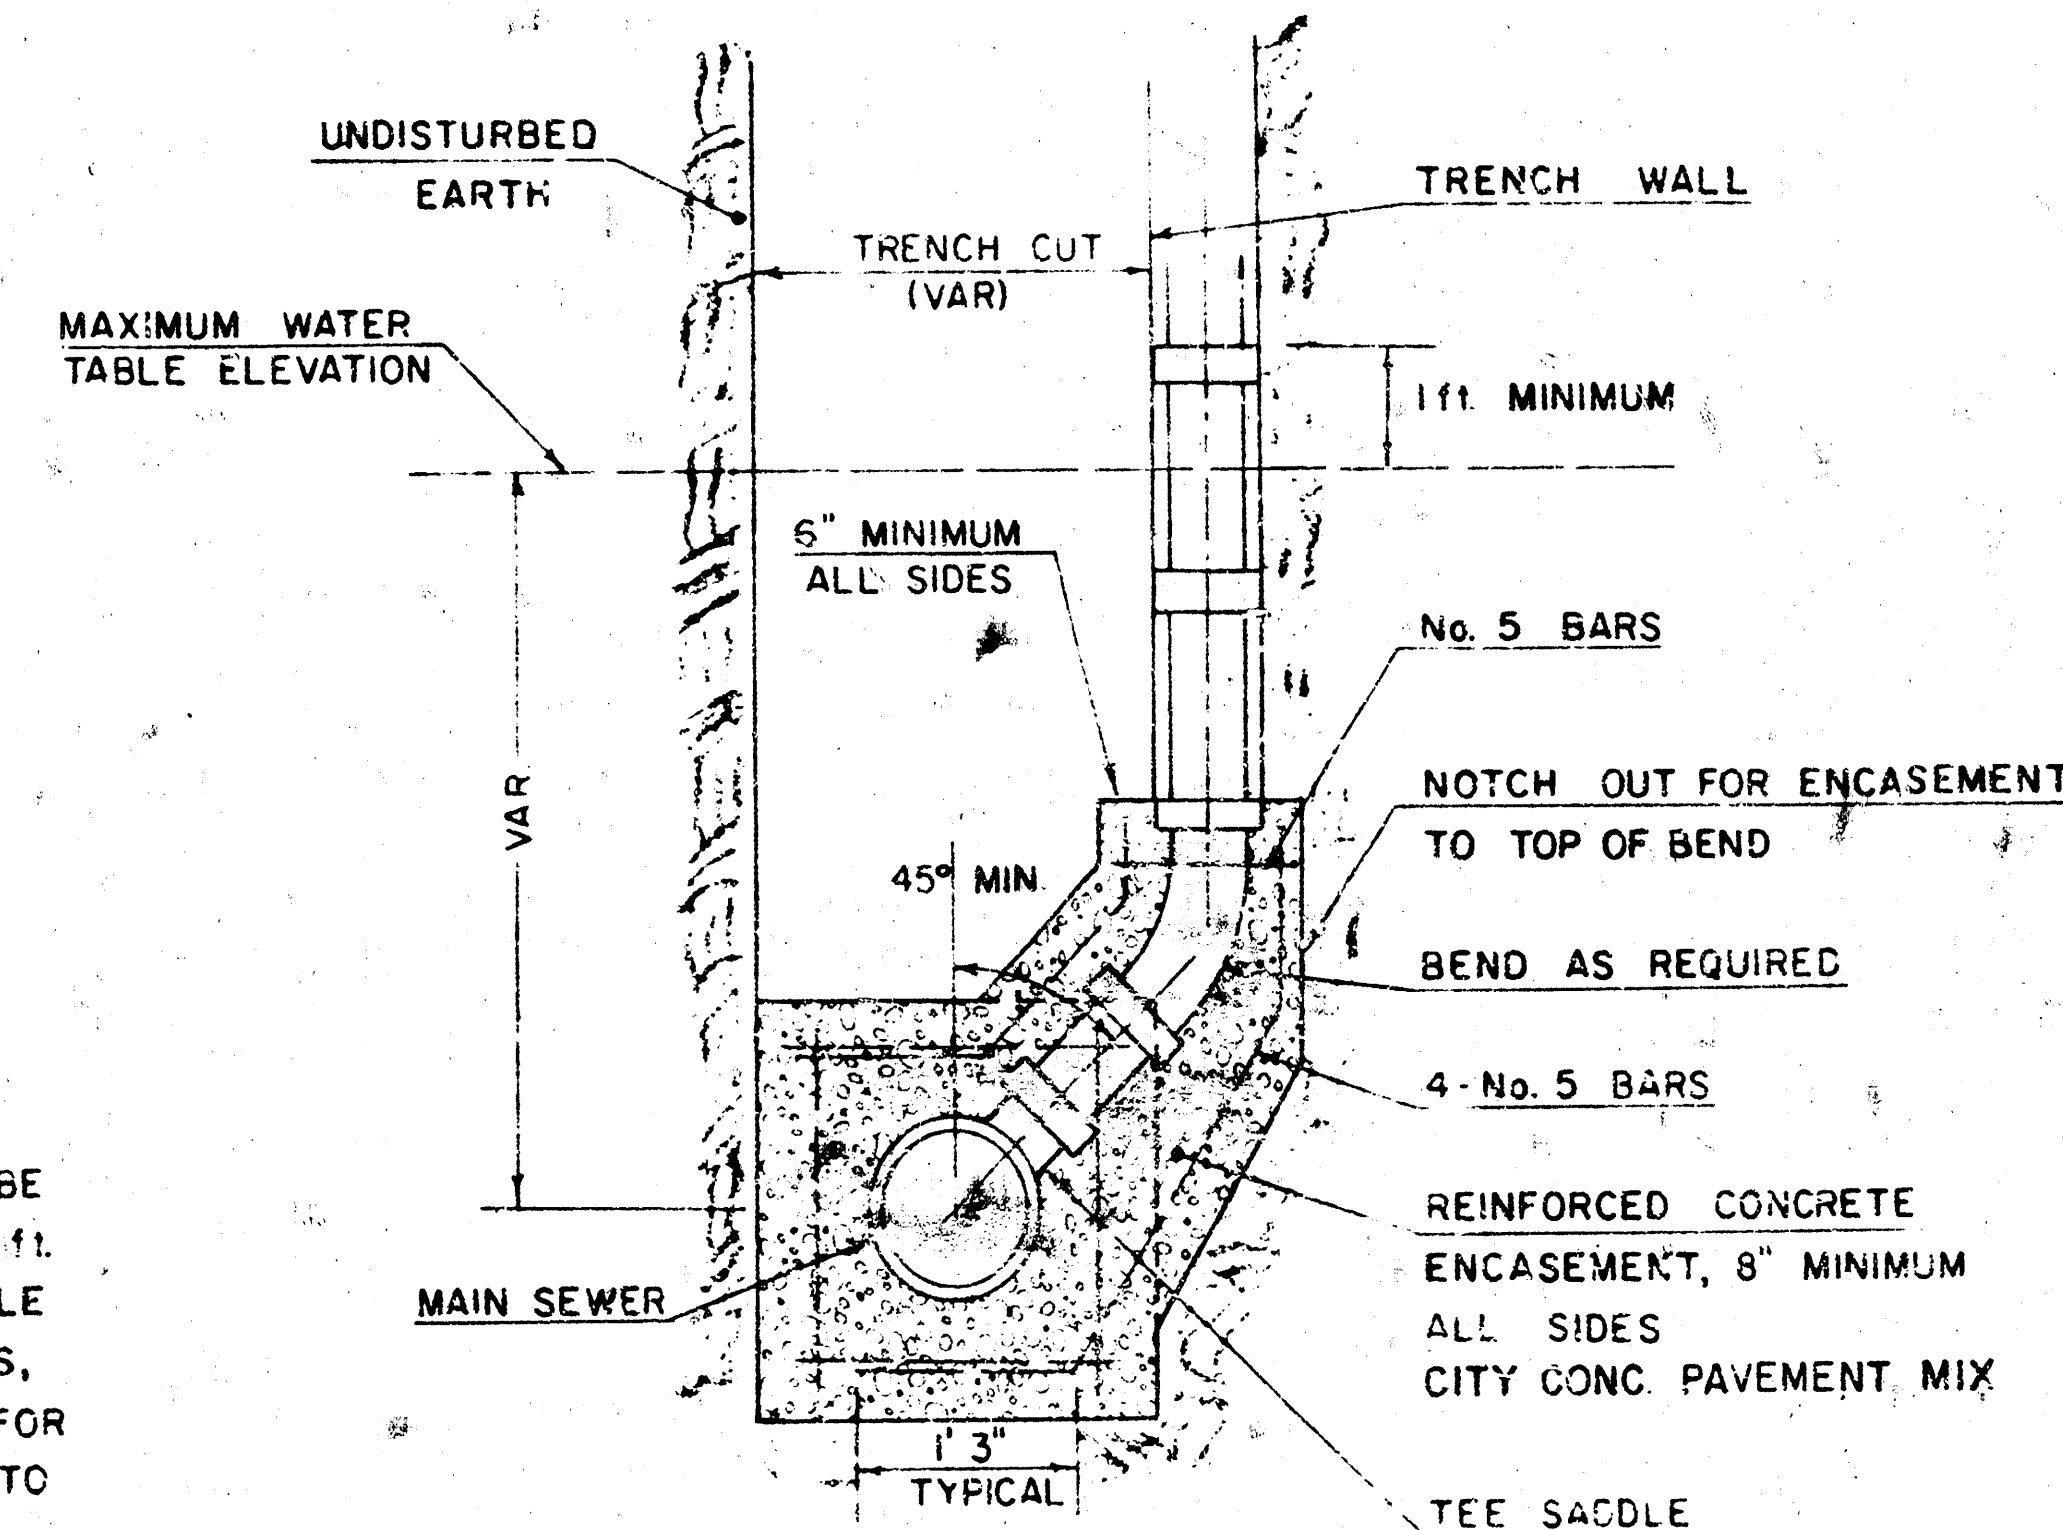

TYPICAL RISER FOR VERTICAL TRENCH WALLS

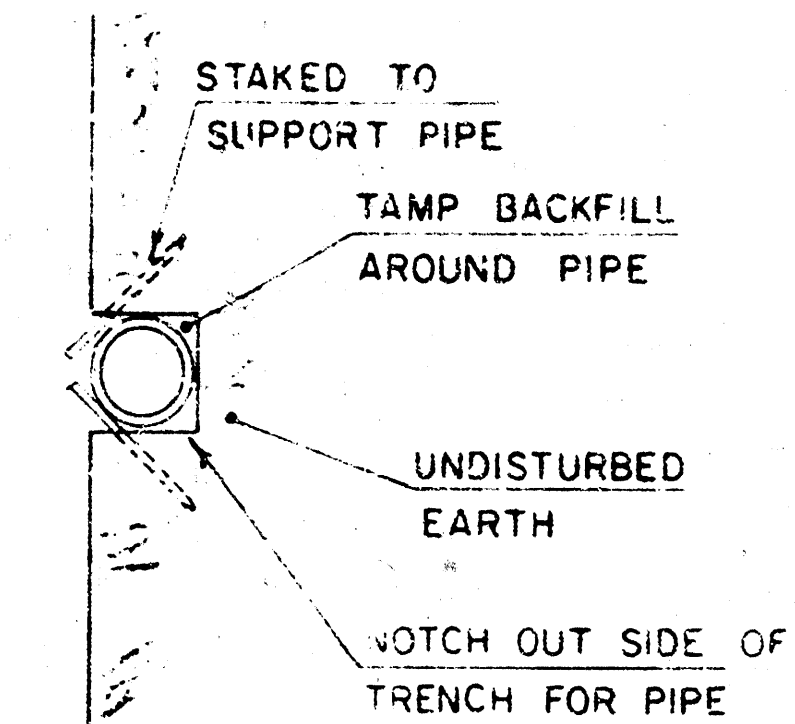

RISER WALL SHALL BE CONSTRUCTED OF REINFORCED CONCRETE OR BRICK. THE MAIN SEWER PIPE SHALL BE 4\"/>

FURNISHED AND UNLESS OTHERWISE SPECIFIED, ALL RISERS SHALL BE PAID FOR AT THE UNIT PRICE BID FOR 4\"/>

THE PROJECT INSPECTOR SHALL REPORT TO INSPECTOR CARDS THE LOCATION OF ALL RISERS CONSTRUCTED AS HEREIN PROVIDED FROM THE NEAREST MANHOLE, THE DIRECTION OF SERVICE, THE ELEVATION OF THE TOP OF THE RISER AND THE DISTANCE FROM THE MANHOLE TO THE RISER. THE PROJECT INSPECTOR SHALL ALSO REPORT ON INSPECTOR CARDS THE LOCATION, DIRECTION OF SERVICE, AND SIZE OF ALL RISERS ALIGNED IN MANHOLES.

LATERAL 73
WAR INDUSTRIES SEWER
City of Wichita, Kansas
Project no. 468-76-245-81158-000-000-001

ED BAUGHMAN COMPANY, P.A.
SPECIALTY & ENGINEERING
314/242-7271 • 230 LAURA • WICHITA, KANSAS 67213