
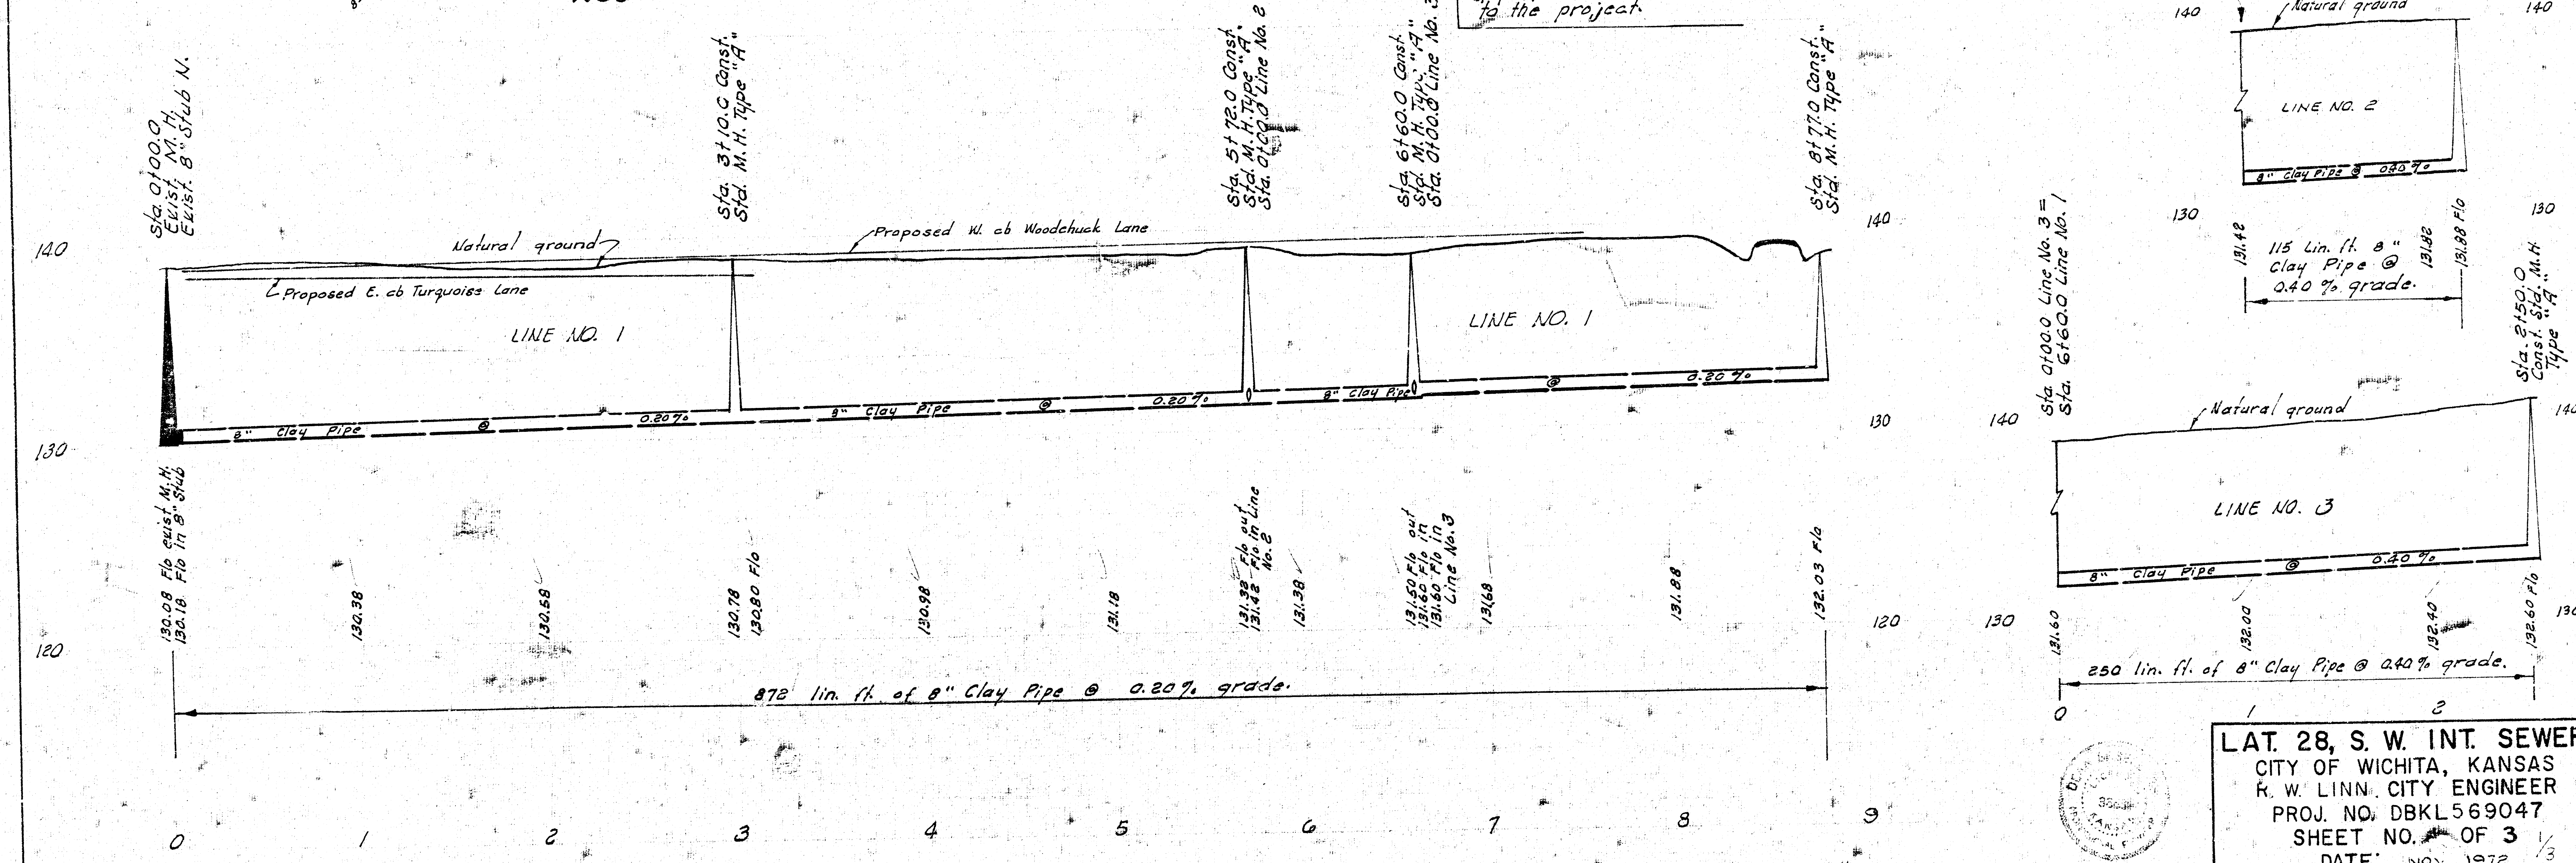



M. 140.97 R.R. Spike in Power Pole S.W. corner Woodchuck and Hendryx.

NOTE:
Contractor to reset all fences and clotheslines

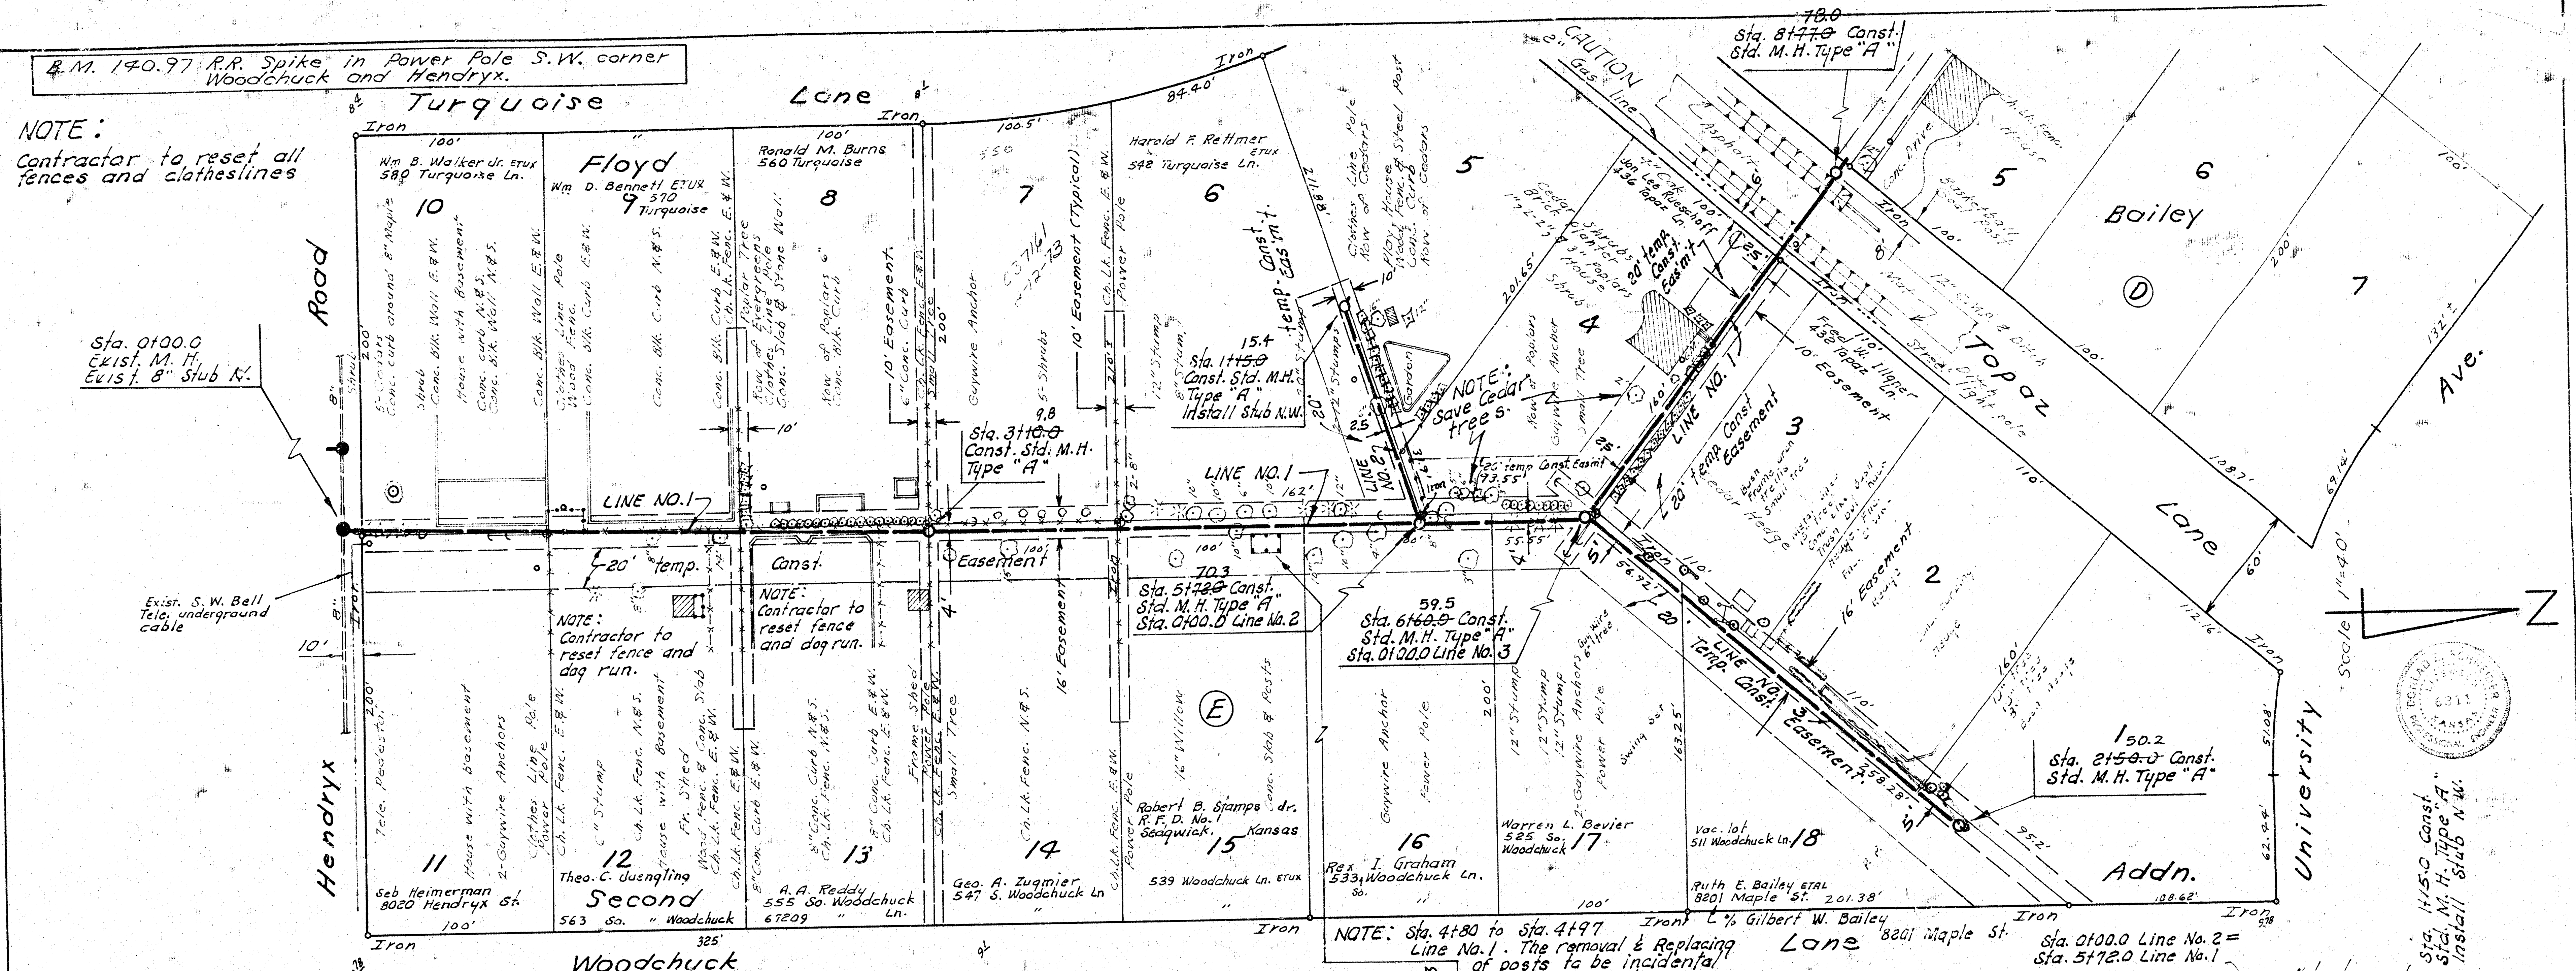

LAT. 28, S. W. INT. SEWER
CITY OF WICHITA, KANSAS
R. W. LINN, CITY ENGINEER
PROJ. NO. DBKL569047
SHEET NO. 1 OF 3
DATE: NOV. 1972


AS BUILT Final Meas. K-101

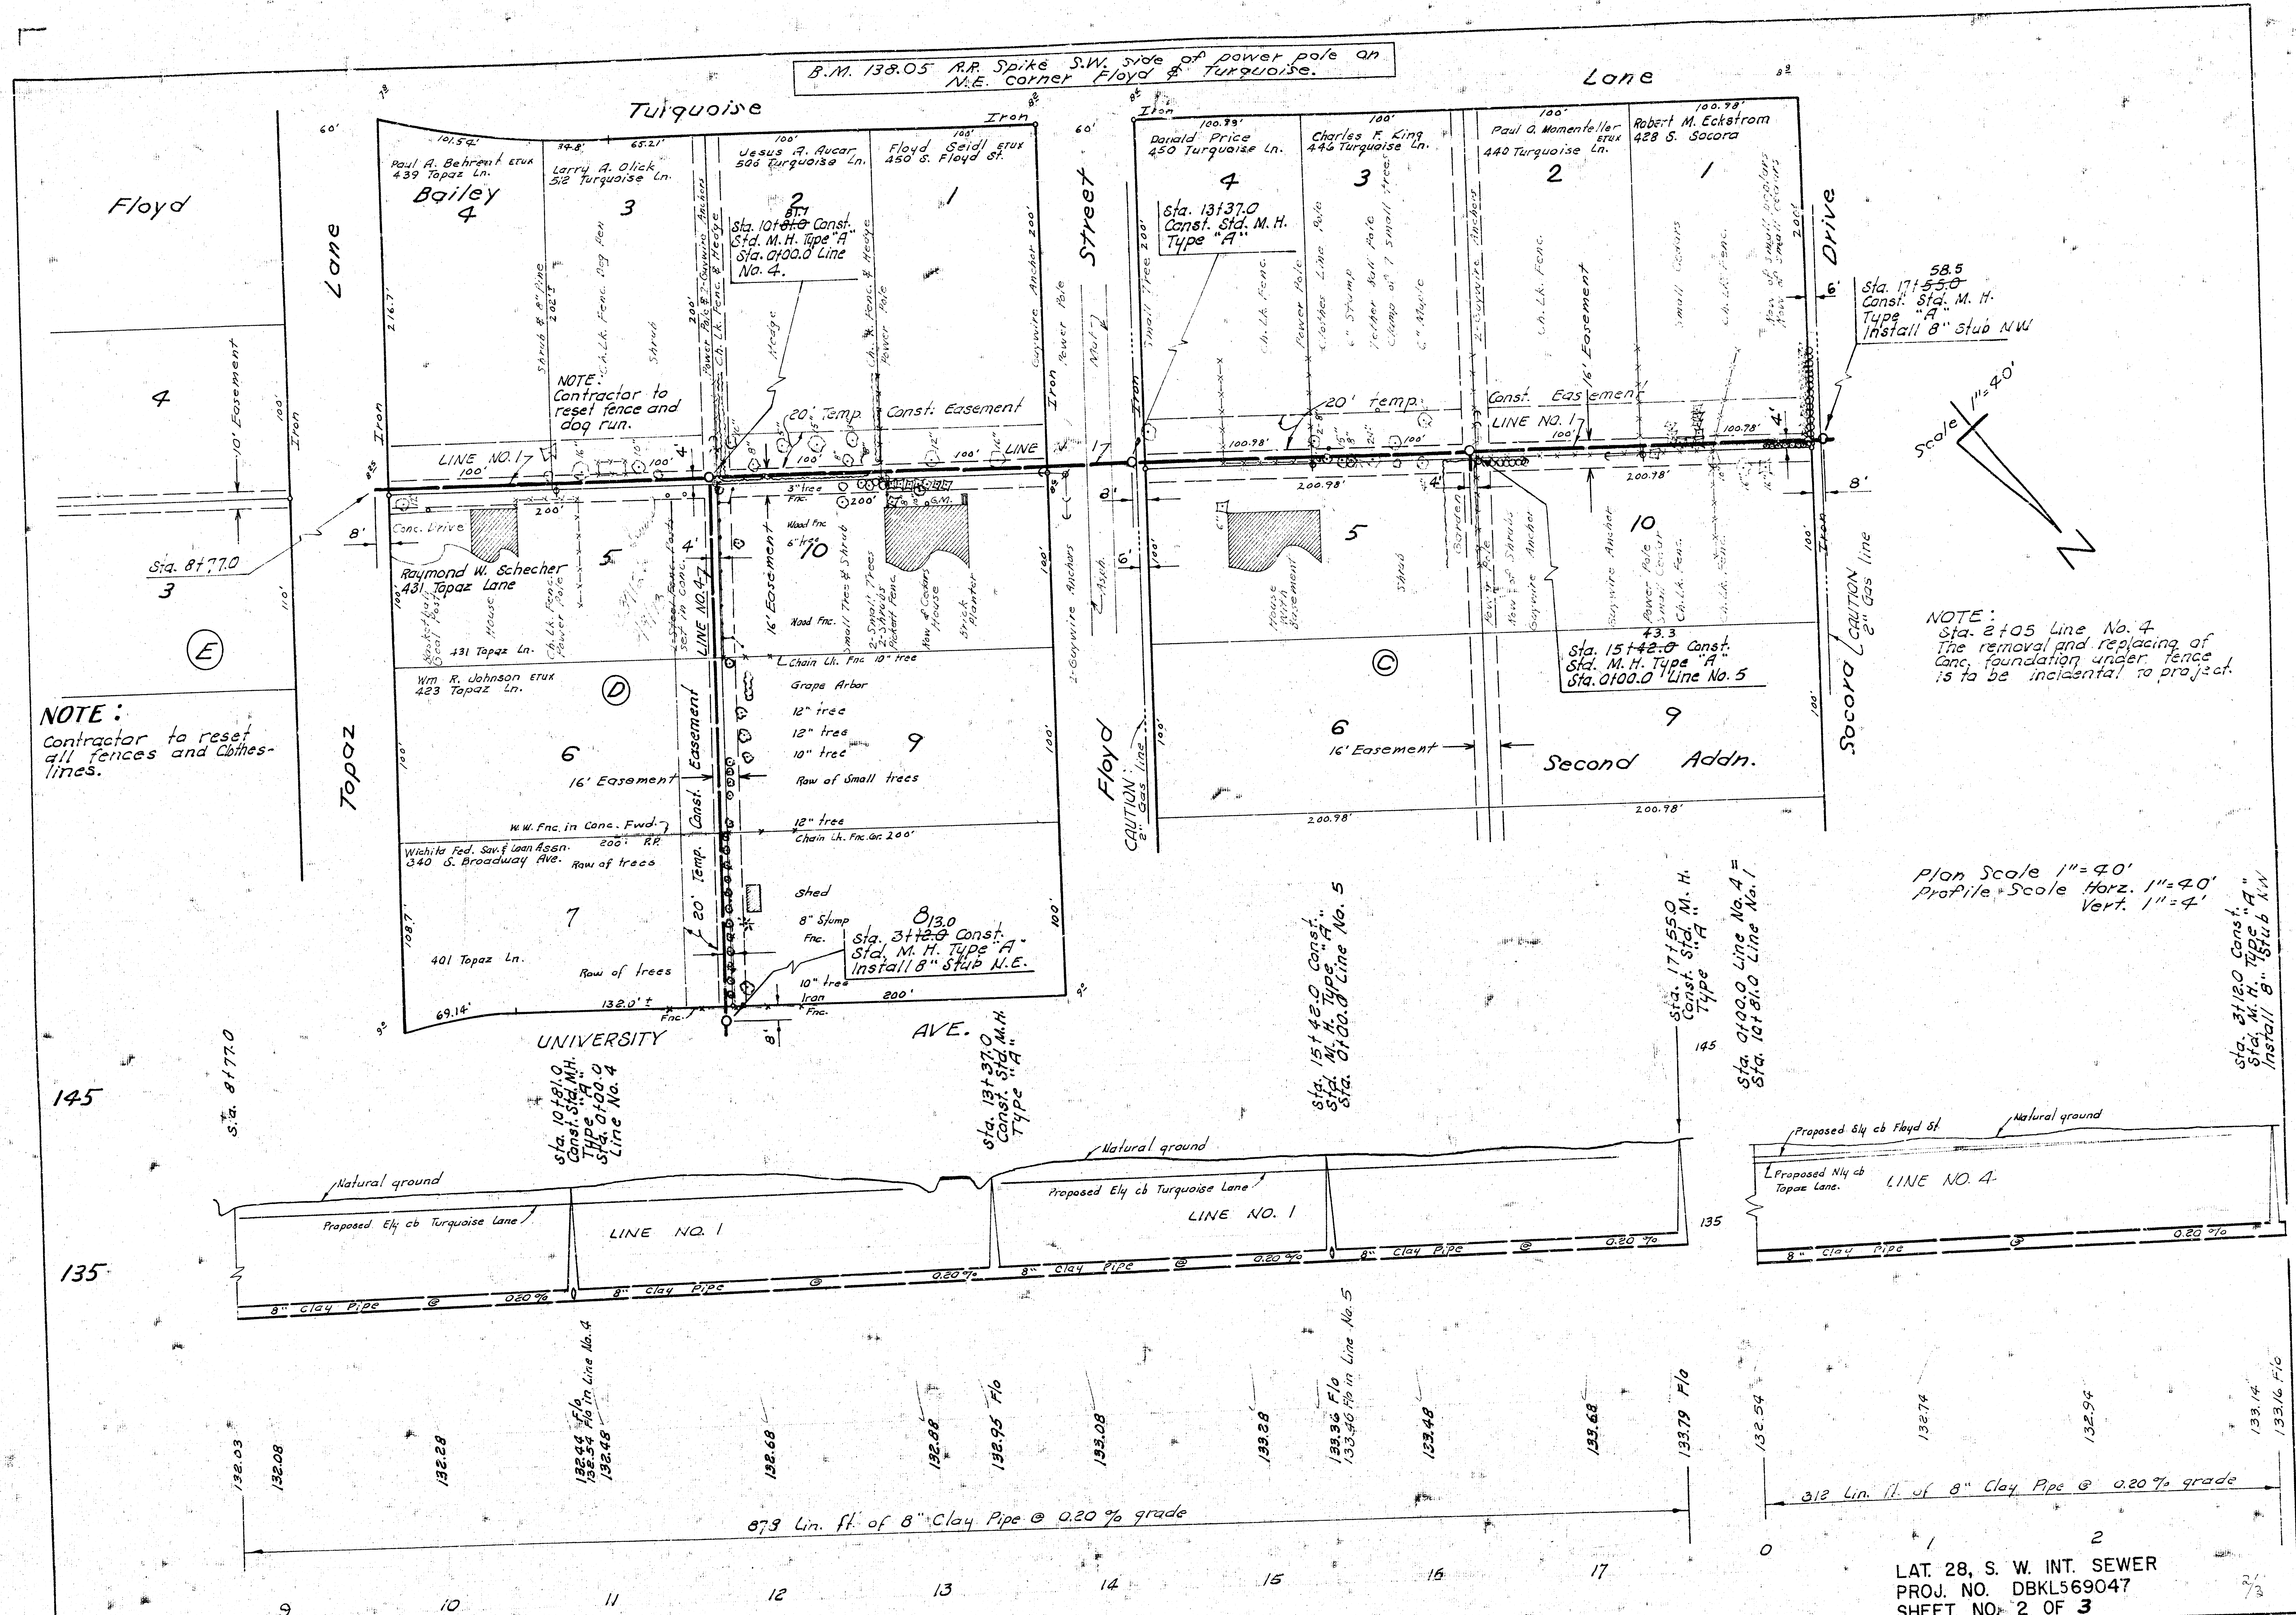

NOTE:
Contractor to reset
all fences and clothes-
lines.

NOTE:
Sta. 2+05 Line No. 4
The removal and replacing of
conc. foundation under fence
is to be incidental to project.


Plan Scale 1"=40'
Profile Scale Horiz. 1"=40'
Vert. 1"=4'

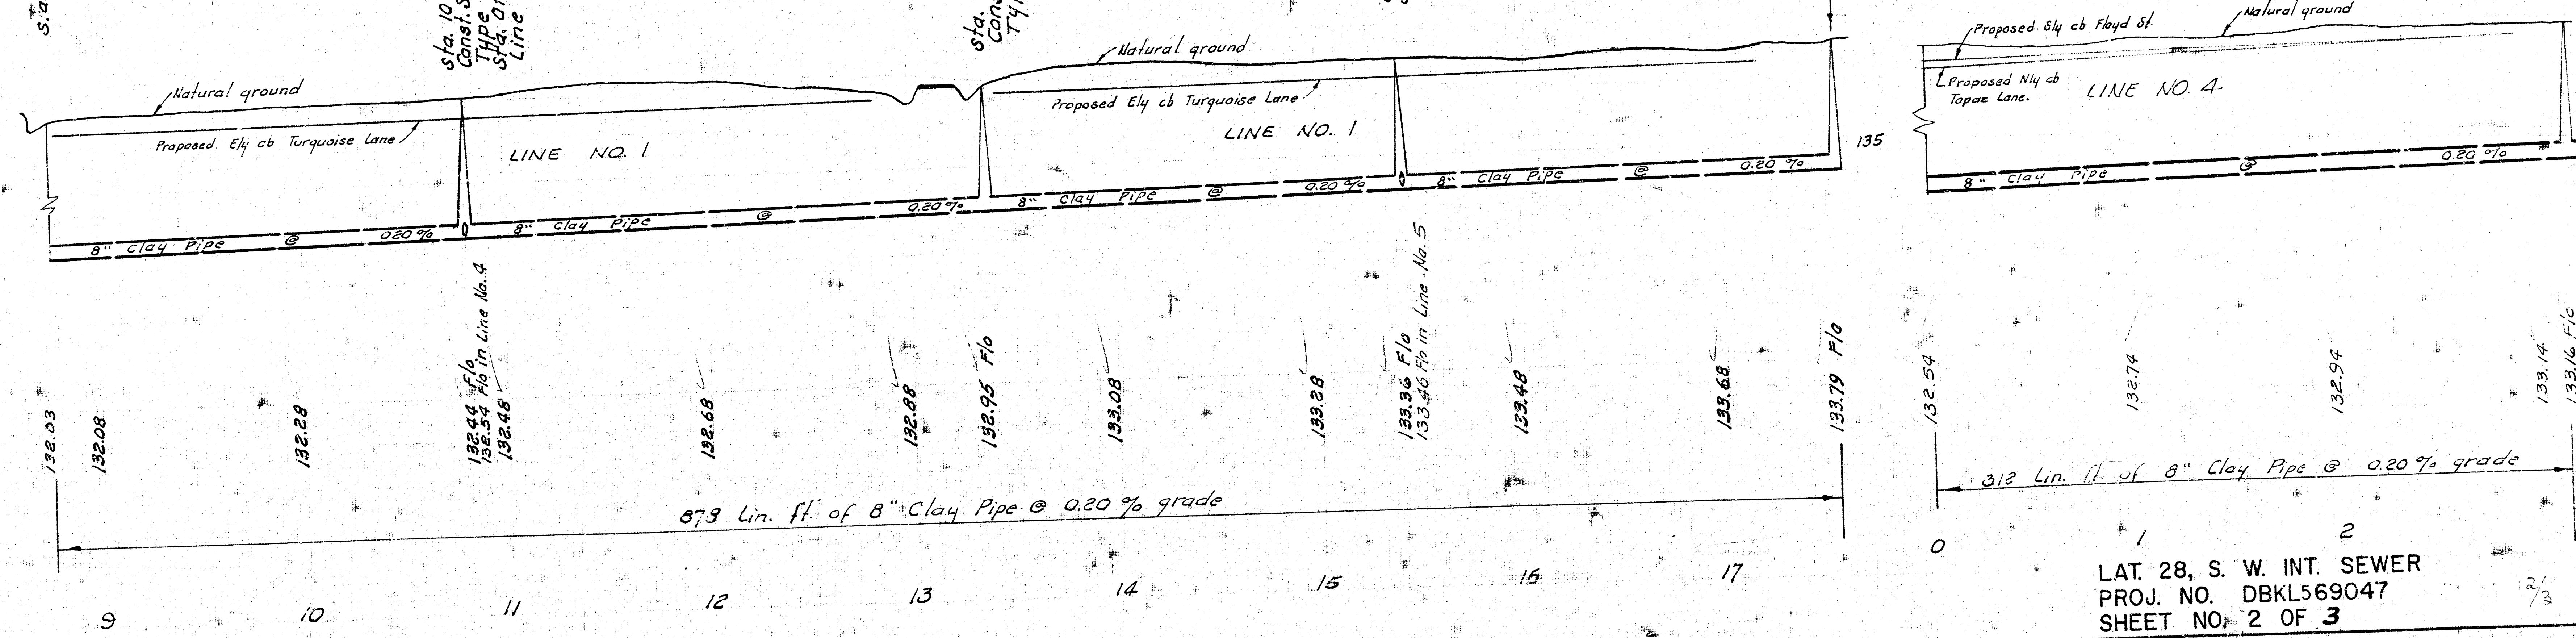

LAT. 28, S. W. INT. SEWER
PROJ. NO. DBKL569047
SHEET NO. 2 OF 3

NOTE:
Contractor to reset all
fences and clotheslines.

Sta. 0+00.0 Line No. 5 =
Sta. 15+42.6 Line No. 1

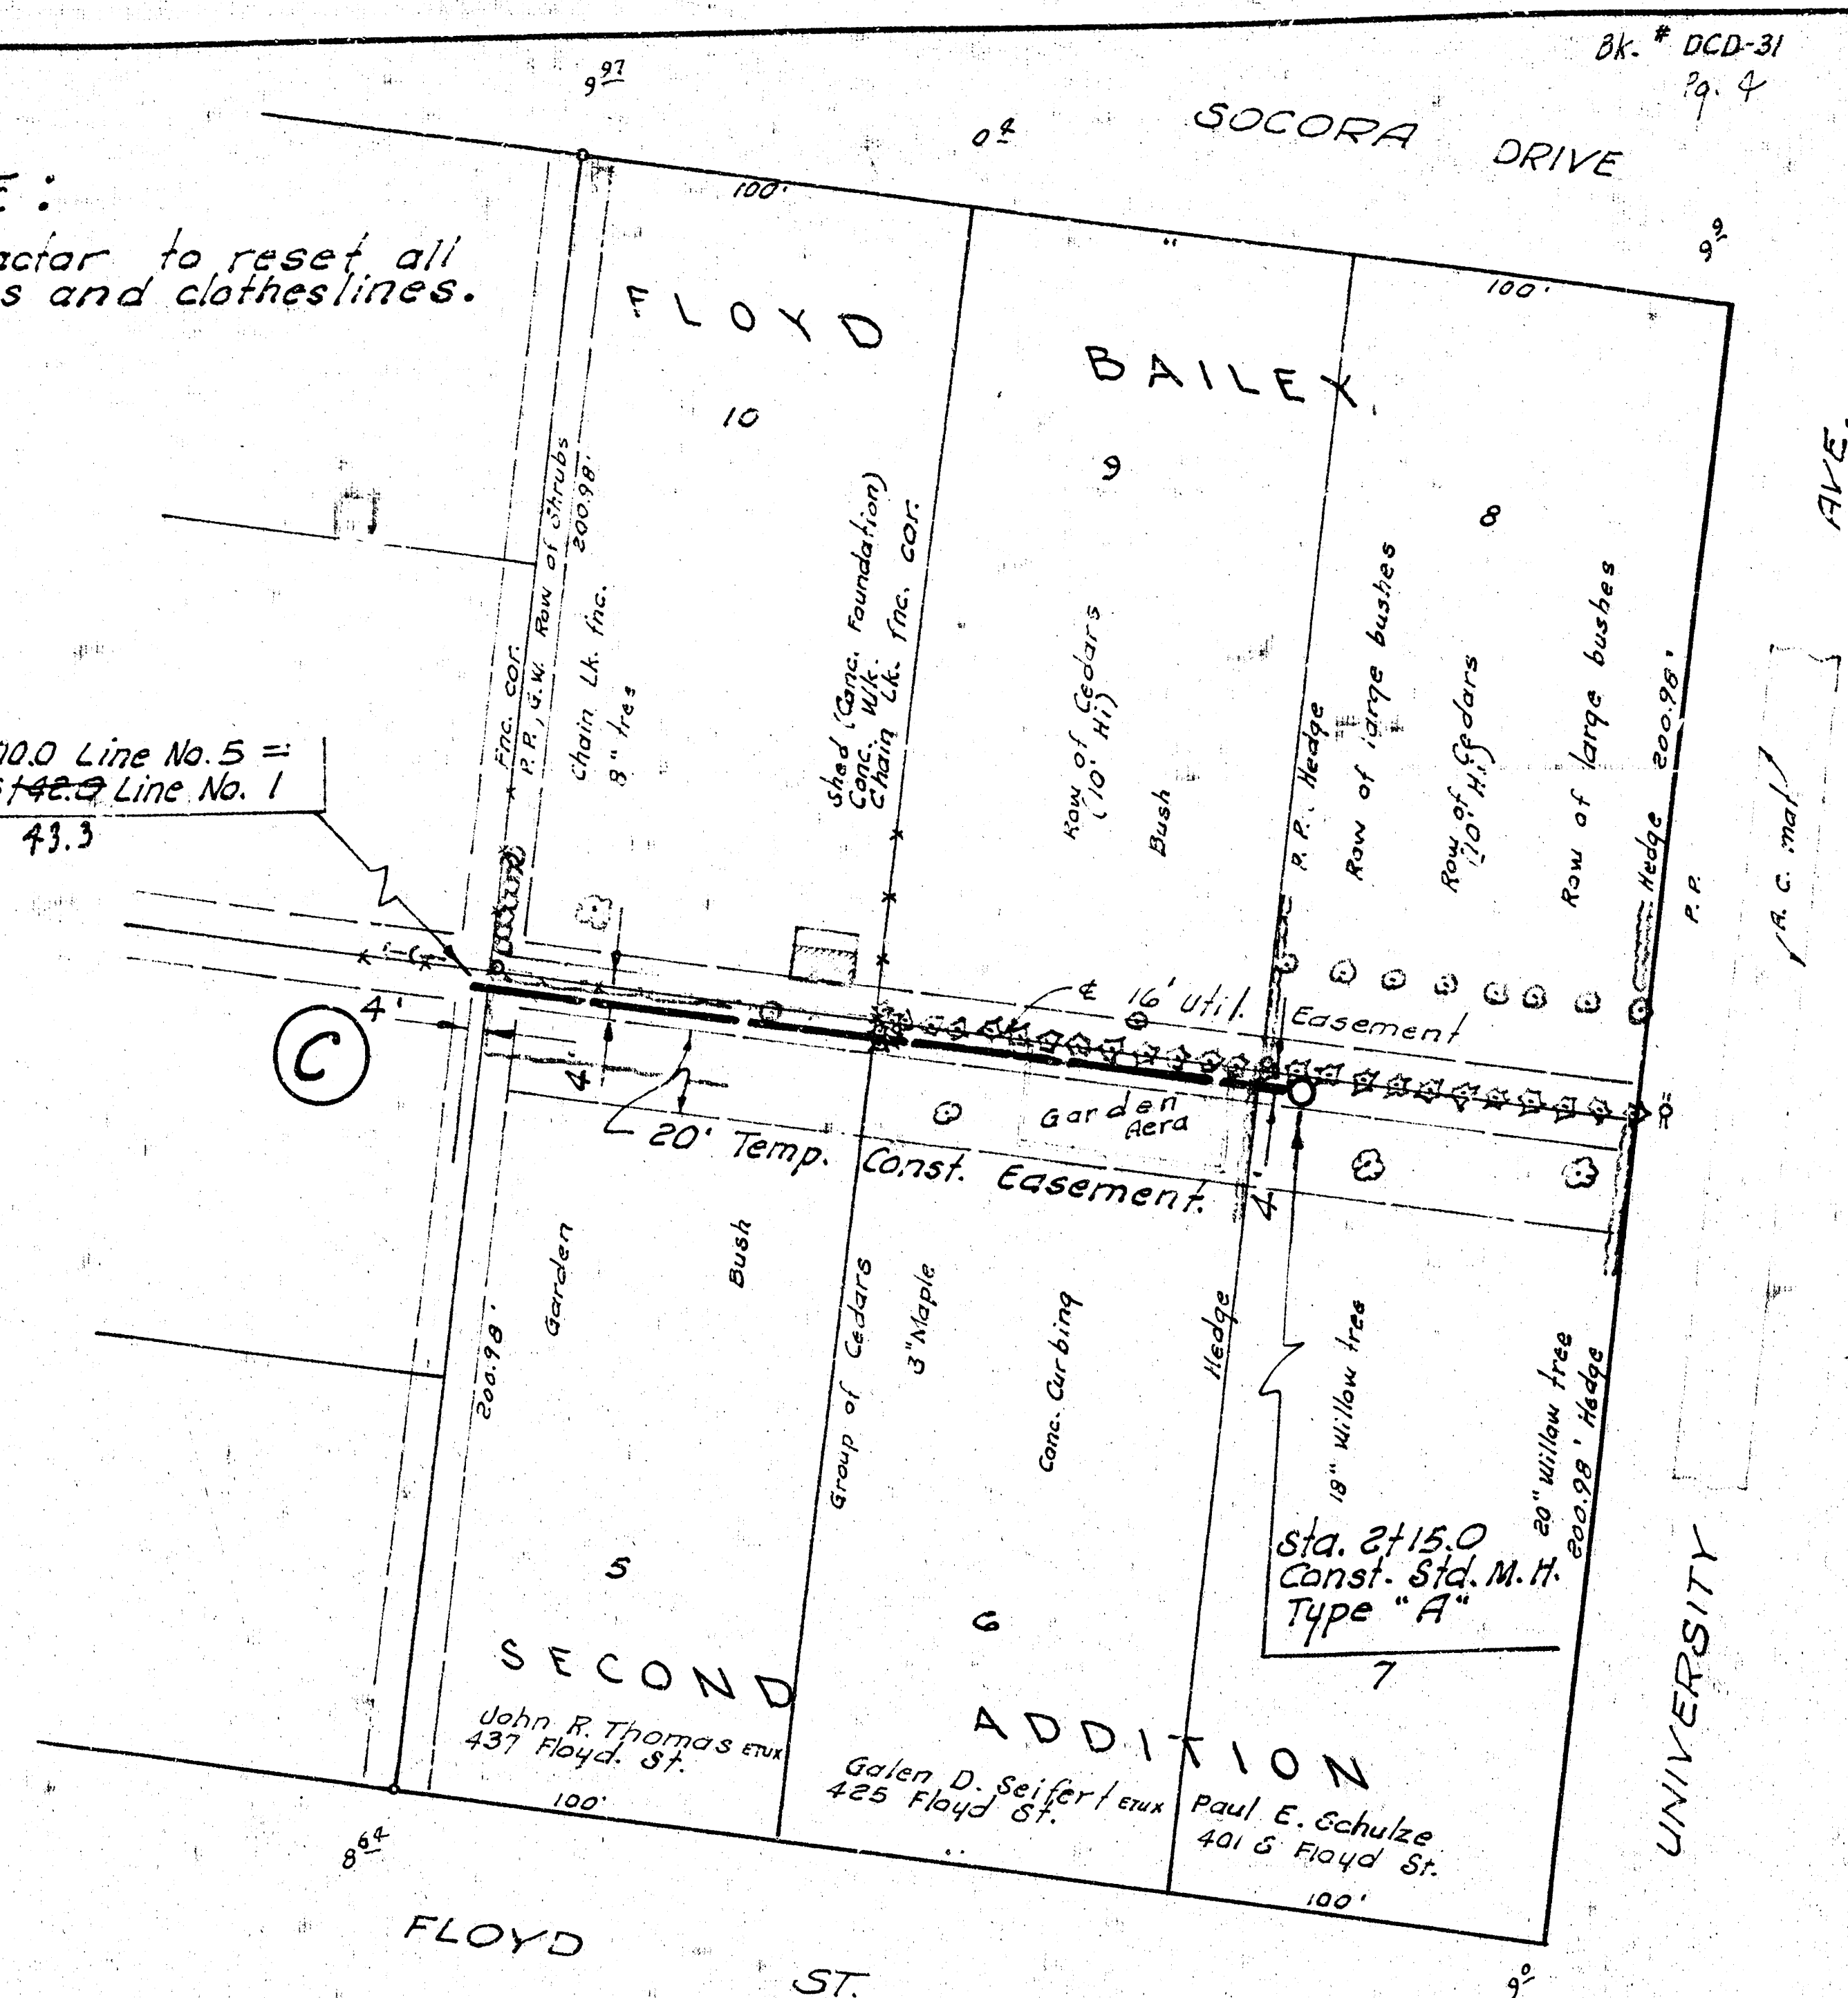

Sta. 0+00.0 Line No. 5 =
Sta. 15+42.6 Line No. 1

Sta. 21+15.0 Const.
Sta. M.H. Type "A"

