

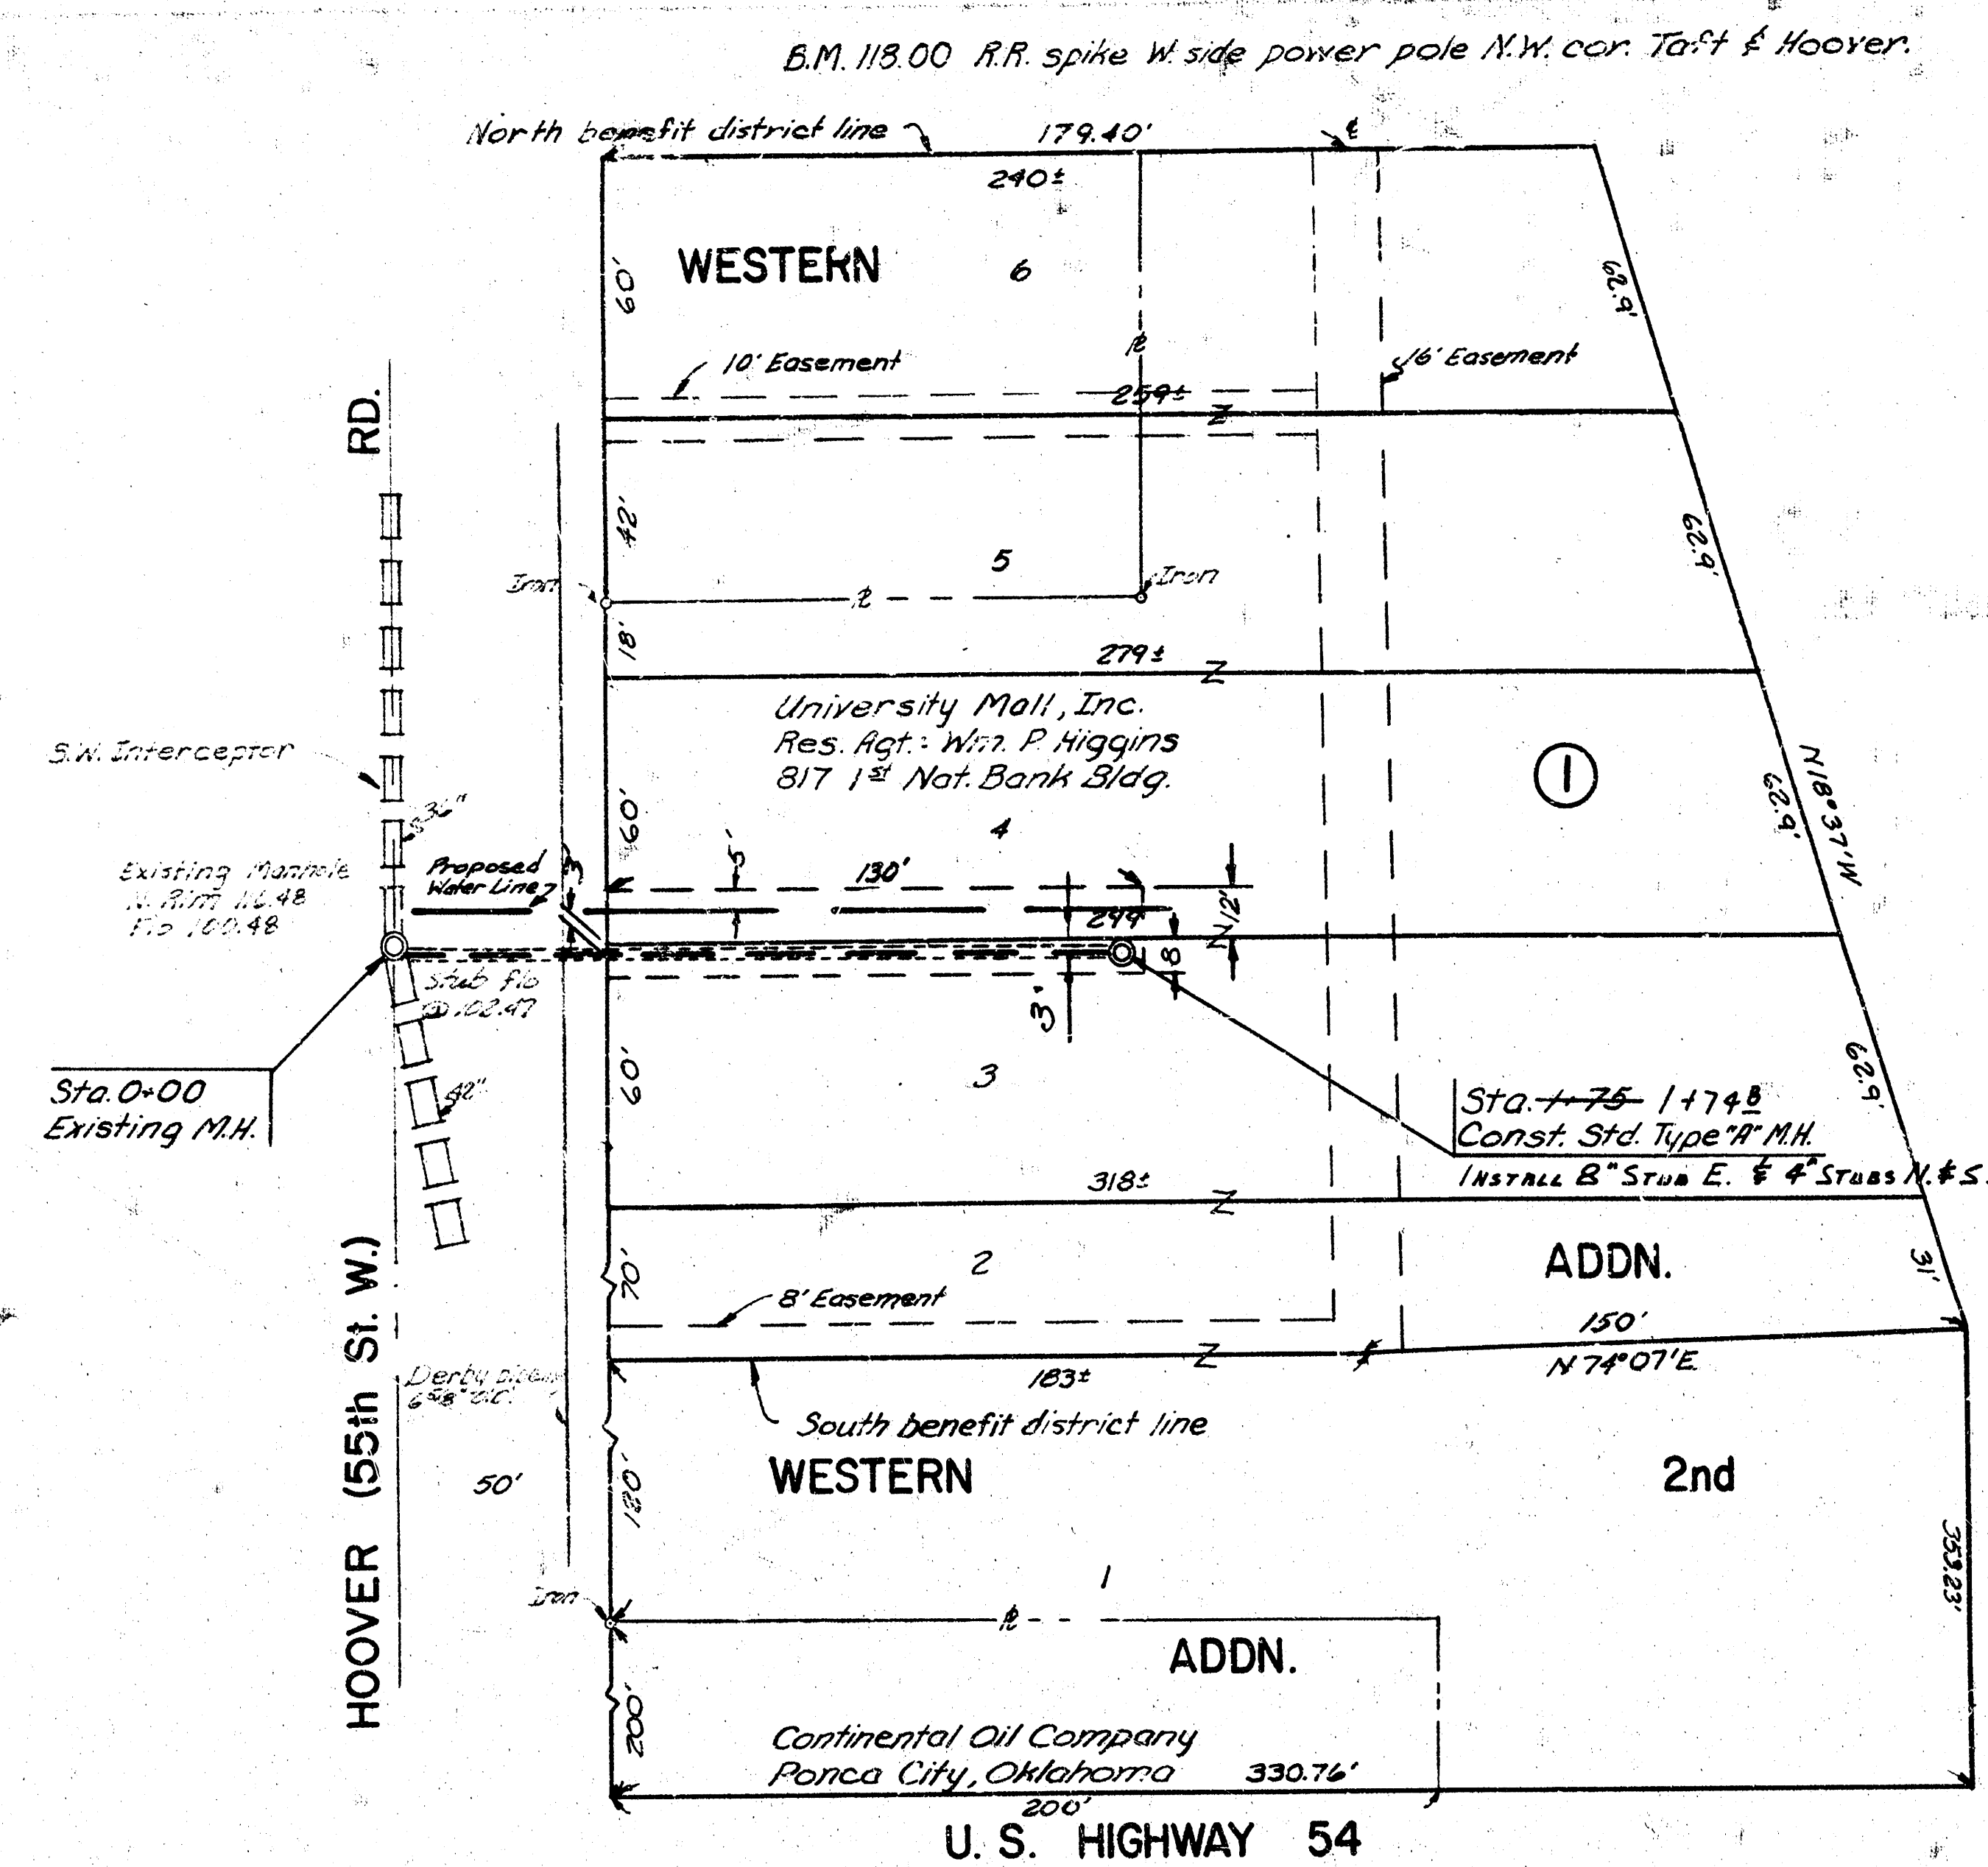


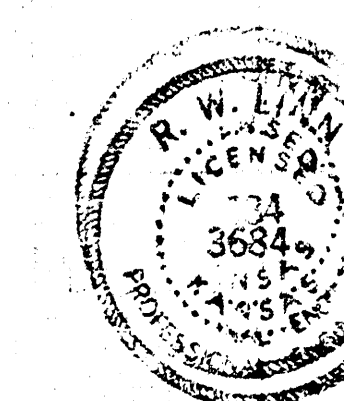

Note: Contractor shall contact Ben Atkins of Derby Pipe Line Co. prior to crossing under Derby pipeline. Ph. no. 755-1591.

Note: Field Engineer shall check stub's flow elevation prior to construction of sanitary sewer.

Plan Scale 1"=40'
Profile Scale Max. 1"=40'
Profile Scale Ver. 1"=5'

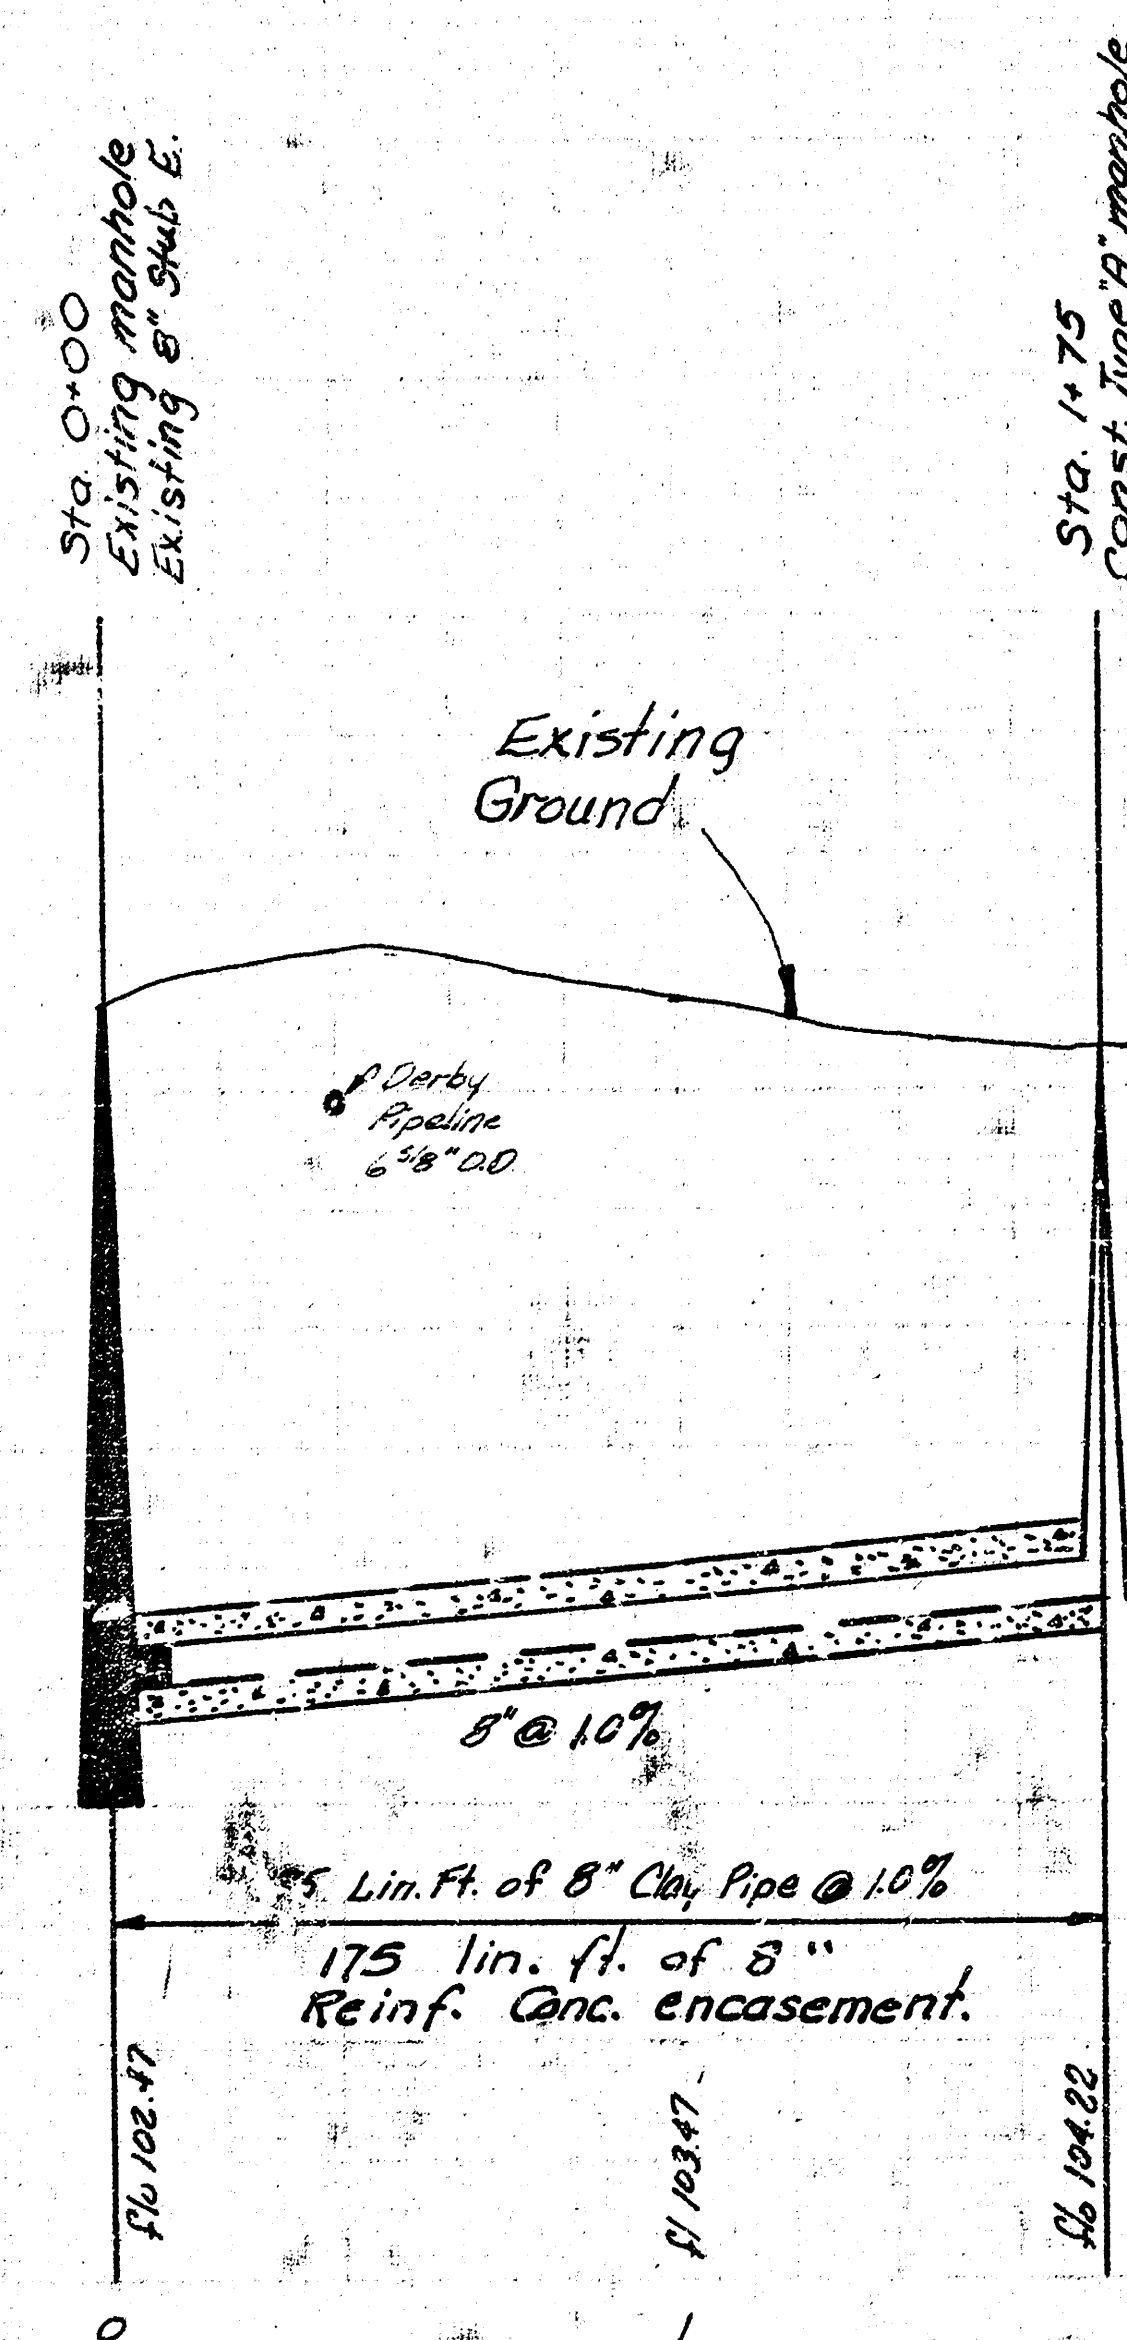

As Built Final Measurements 11-28

LAT. 50 S.W. INTERCEPT
R. W. LINN CITY ENGINEER
CITY OF WICHITA, KS.
PROJ. NO. DBKL 572033
DATE 7-72

FILMED FROM THE BEST