

B. M. 109.85 R.R. Spk. in N.S.
P.P. N.W. cor. Hoover & 31st
St. So.

NOTE: CONTRACTOR TO SECURE HIS WORK ON THIS PROJECT
IN SUCH A MANNER THAT NO OTHER ST. WILL BE
CLOSED FOR A MINIMUM LENGTH OF TIME.

WICHITA-VALLEY CENTER FLOODWAY

RANGLAND - SANDERS
ADDITION

UNPLATTED

Plan Scale 1" = 40'
Profile Scale 1" = 40' Vert.

CAUTION
UNDERGROUND
UTILITIES

Please check with K.G. & E. or
Schwabenland Bell
Telephone Co. for Location

Sta. 1+25.4 Const.
Std. M.H. Type "B"
Install 6" x 15' Stub No.
97 @ 0.4% grade.
Install 4" Stub N.E.

NOTE:
Replace 24" R.C.P.
Replace gravel drive.
Replace A.C. mat.

Sta. 4+35.0 Const.
Std. M.H. Type "A"

CAUTION:
S.W. Bell Tele.
underground cable
6" x 10" of E.P.
Call 268-1556
prior to construction.

Sta. 7+40.0
Const. Std. M.H.
Type "A"
Install 6" Stub East

Sta. 0+00.0
Exist. M.H.
8" Opening is 3' South
of Center of manhole.

NOTE: Replace fence.

NOTE:
Remove Stone coping.
Do not replace.

Exist. 4" Continental Jet Fuel line
4 strand barbwire fnc.
4" City Service pipe line
Exist. 42" San. Sewer

EXIST. M.H.
80+40.1
Flo in 91.39
Flo out 91.09
10" STUB W. 93.00
8" Stub S. 93.00

Sta. 0+00.0 Exist. M.H.
8" Opening is 3' South of
Center of manhole.
Exist. City Service & pipe line
Exist. Continental Jet Fuel line.

Sta. 1+25.4 Const.
Std. M.H. Type "B"
Install 6" x 15' Stub No.
97 @ 0.4% grade.
Install 4" Stub N.E.

Sta. 4+35.0 Const.
Std. M.H. Type "A"

Sta. 7+40.0 Const.
Std. M.H. Type "A"
Install 6" Stub East

110
105
100
95
90


110
105
100
95
90

Sta. 0+00.0
125.4 Lin. ft. of 8" Reinf.
Conc. encasement.
125.4 Lin. ft. of 8" clay pipe
@ 0.40% grade

614.6 Lin. ft. of 8" clay Pipe at 0.40% grade.

"As Built" Final Mean K-106

LAT. 51, S.W. INTERCEPTOR SEWER
CITY OF WICHITA, KANSAS
R. W. LINN - CITY ENGINEER
JAN. 1973 PROJECT NO. DBKL572045

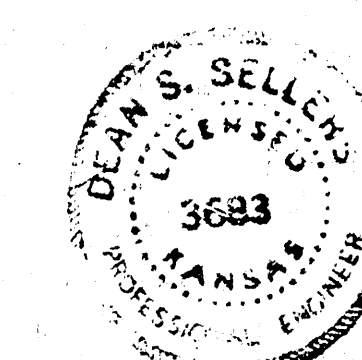

19 Eng
water