



BM 141.05 R.R. Spike E. face Power Pole West side Tyler on N.L. Tyler Ct. extended
 BM 139.20 R.R. Spike E. side PP. S.W. corner University-Tyler Road
 BM 141.64 "□" top S cb University at W. end rad. at 1st curve east of Robin Road

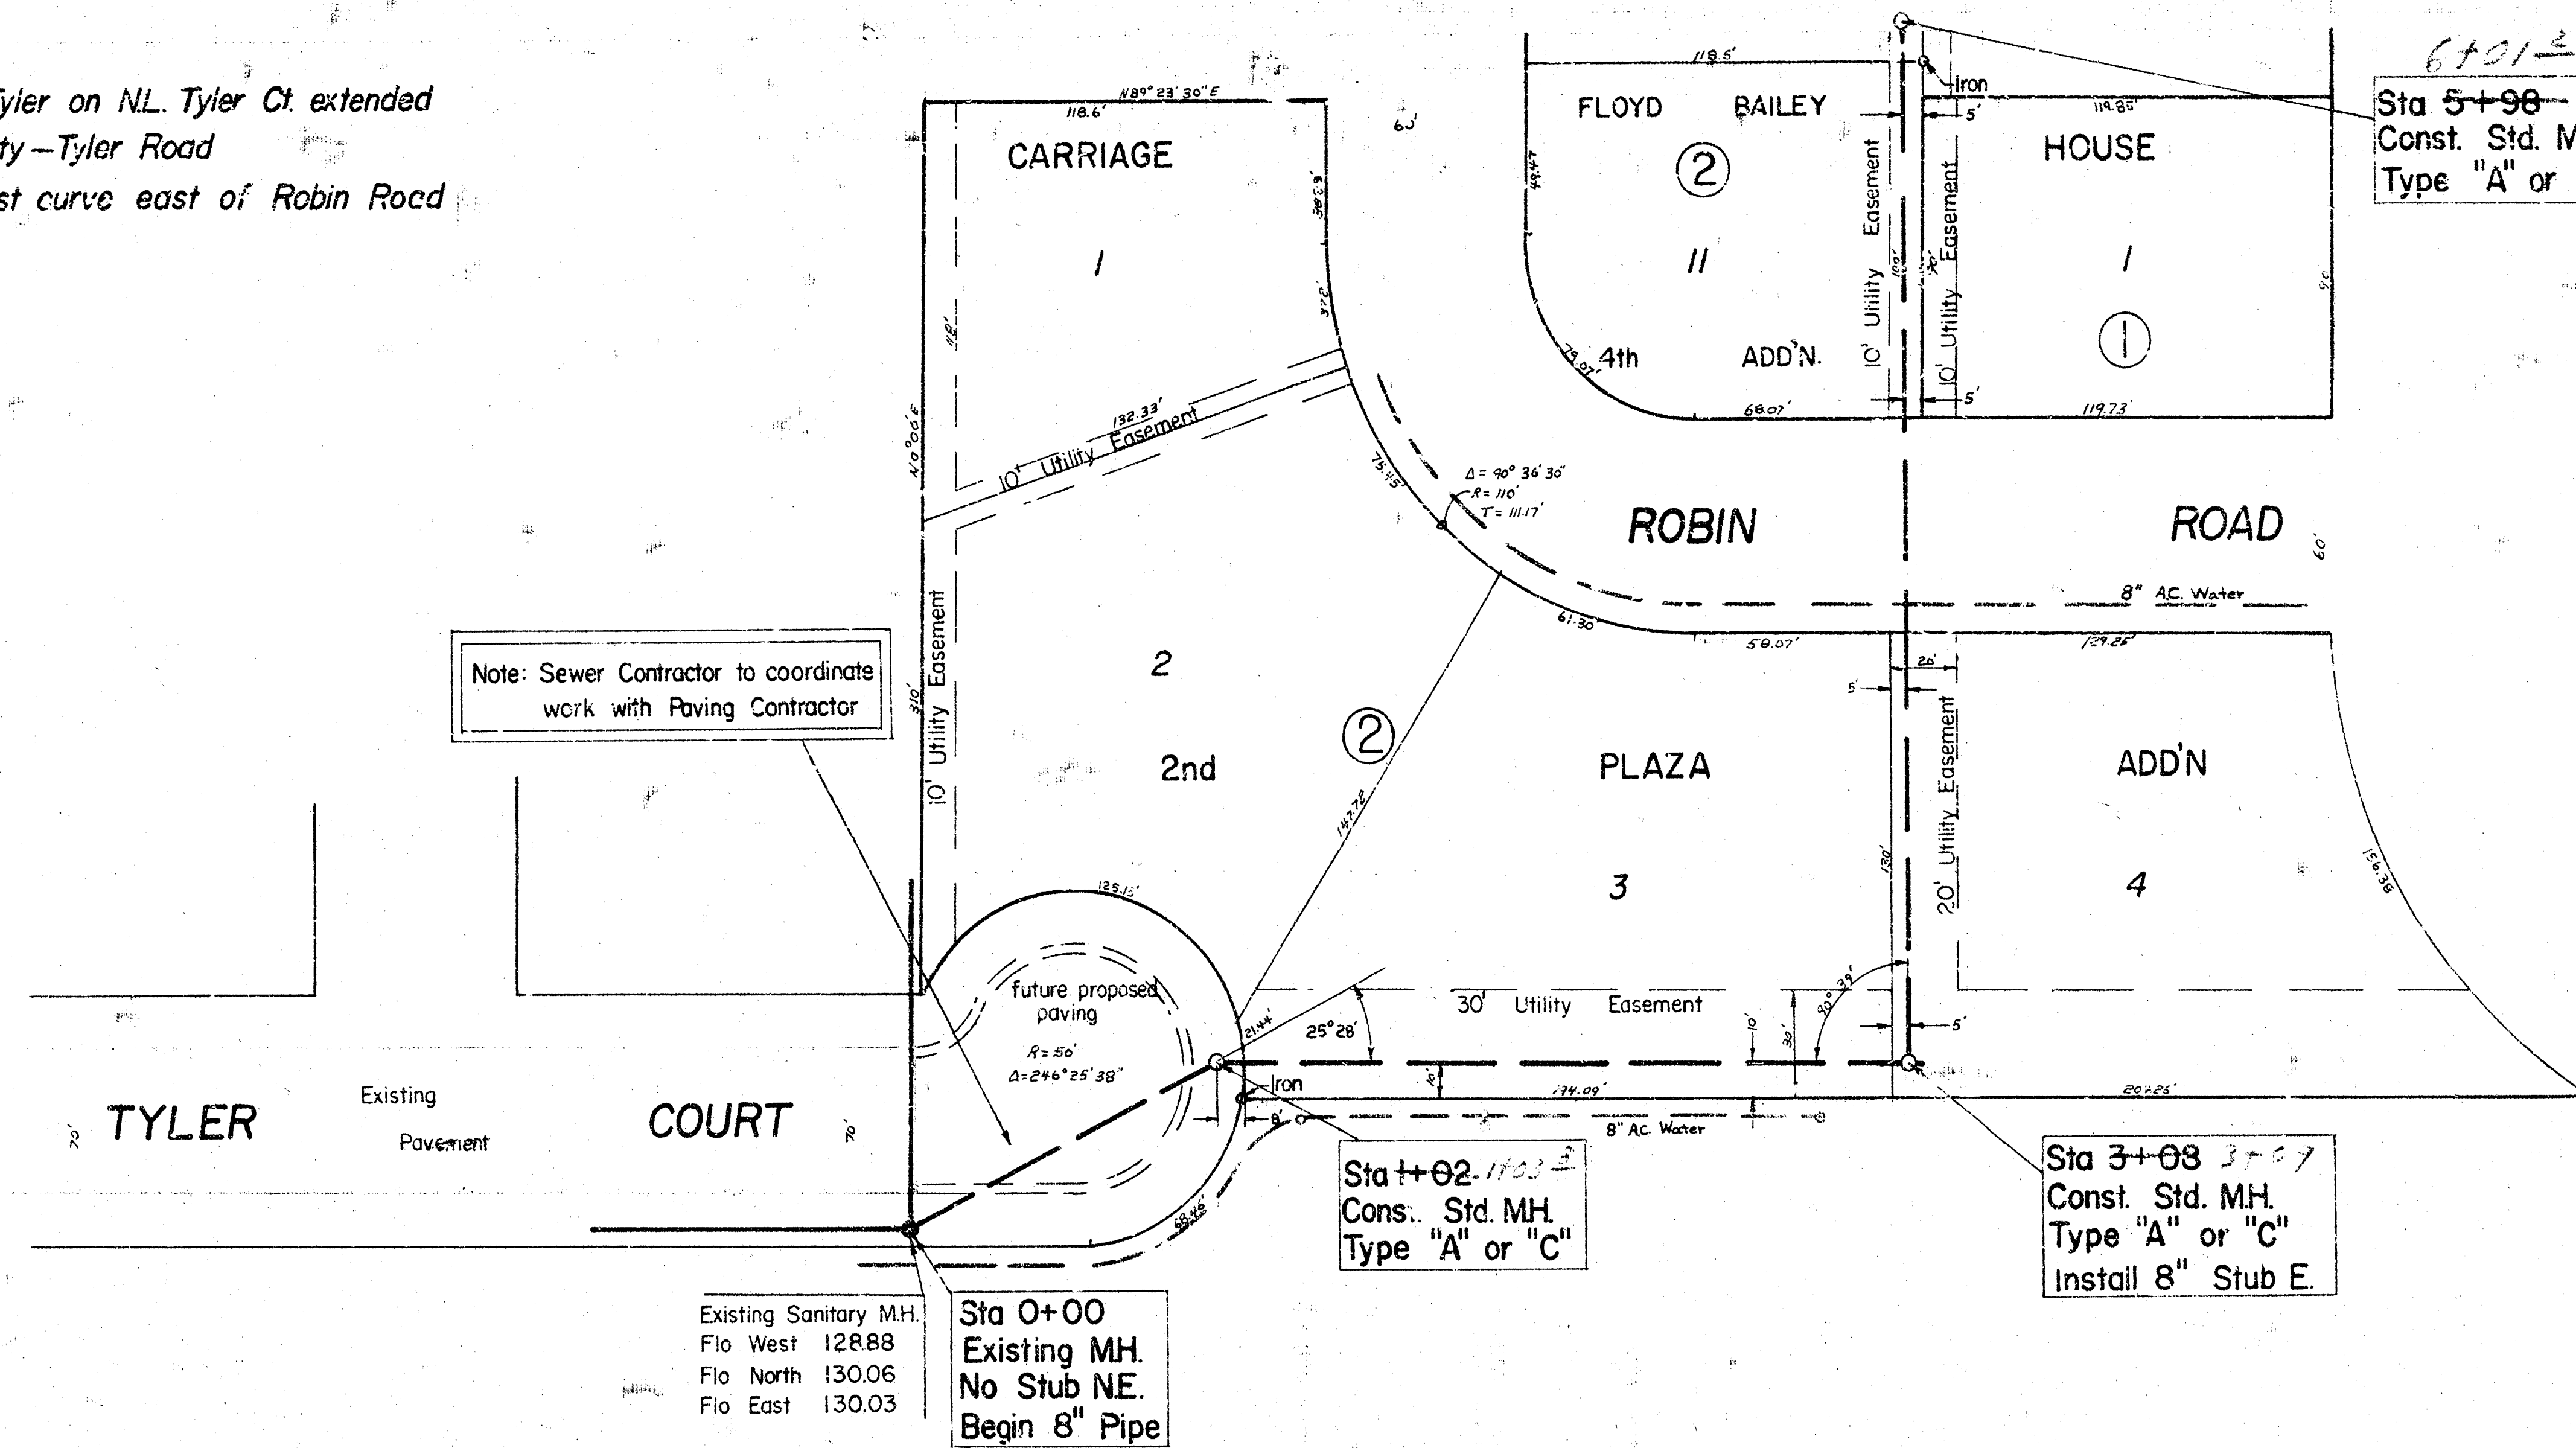

Plan Scale 1" = 40'
 Profile Scale 1" = 40' Horiz
 1" = 5' Vert.

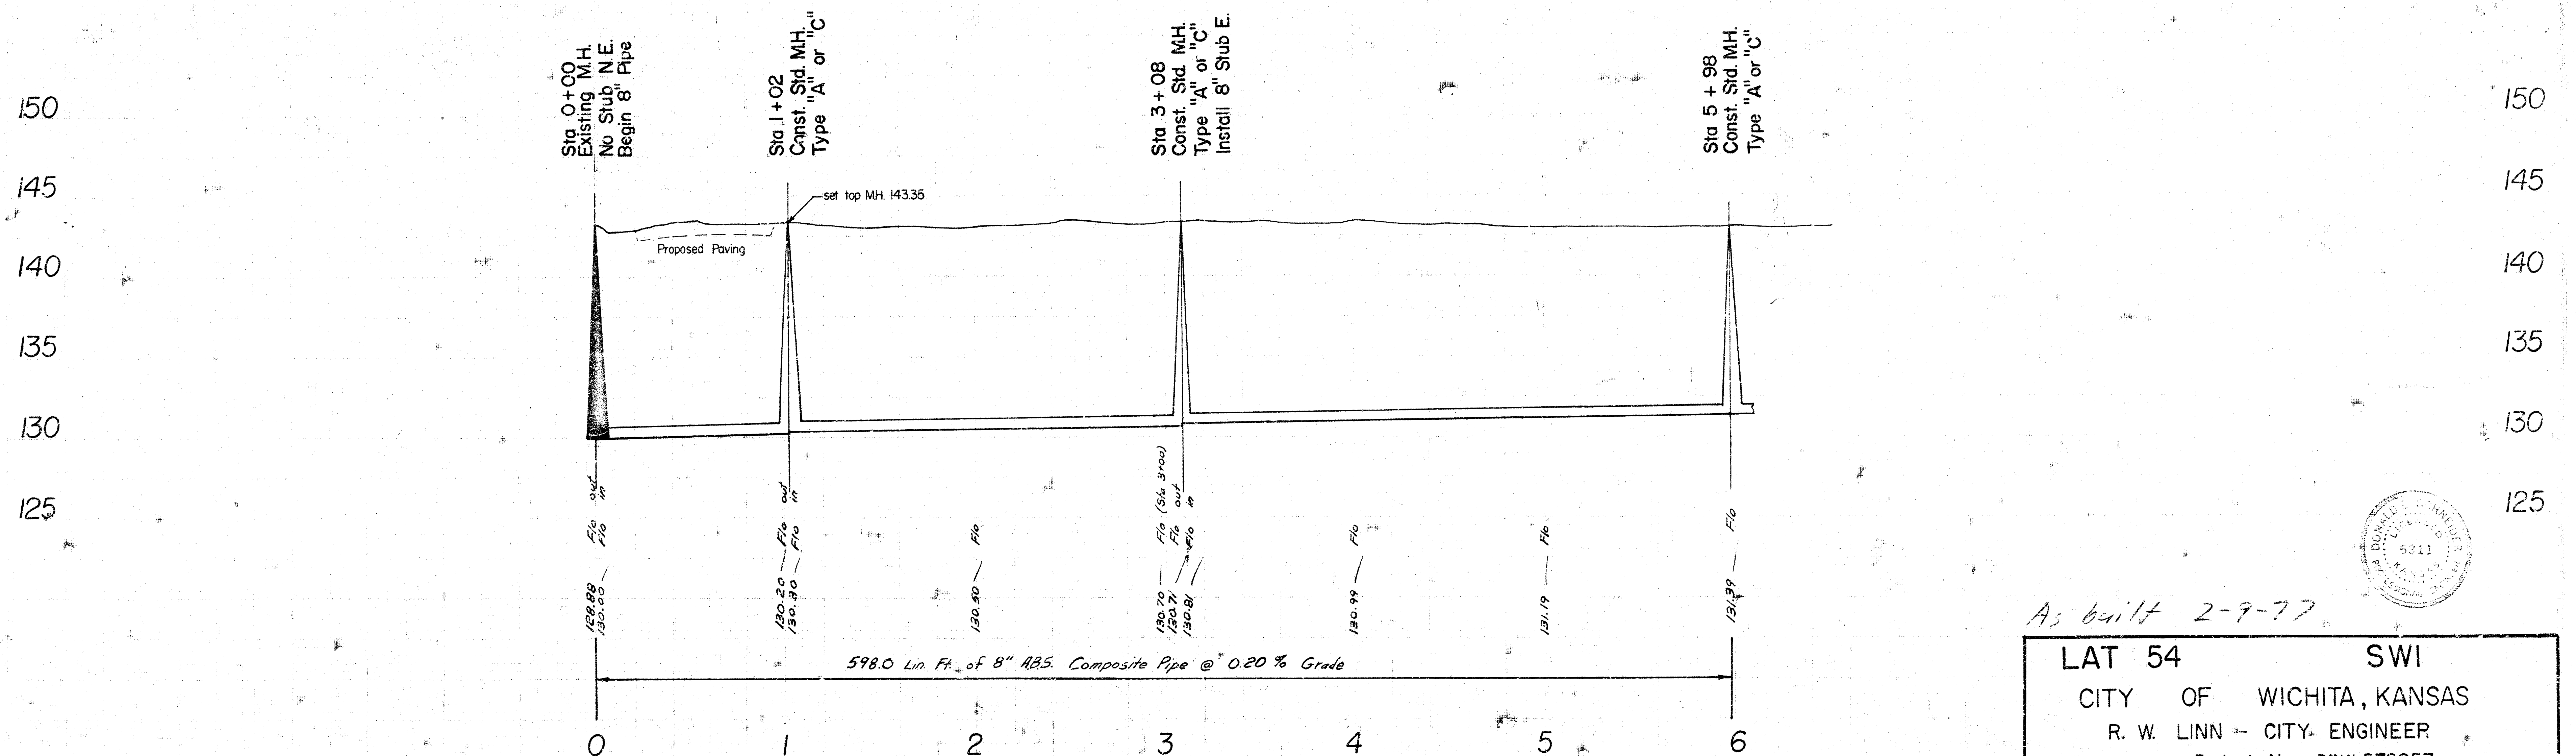

As built 2-9-77

LAT 54 SWI
 CITY OF WICHITA, KANSAS
 R. W. LINN - CITY ENGINEER
 Project No. DBKL572057

