


B. M. 141.66 "a" Top E. cb Paula
@ S. L. University.

B. M. 142.94 N.E. cor. conc.
Porch 434 S. Evergreen.

NOTE:
Contractor to excavate
at Sta. 1149.0 to verify
Flo elev. prior to
construction.

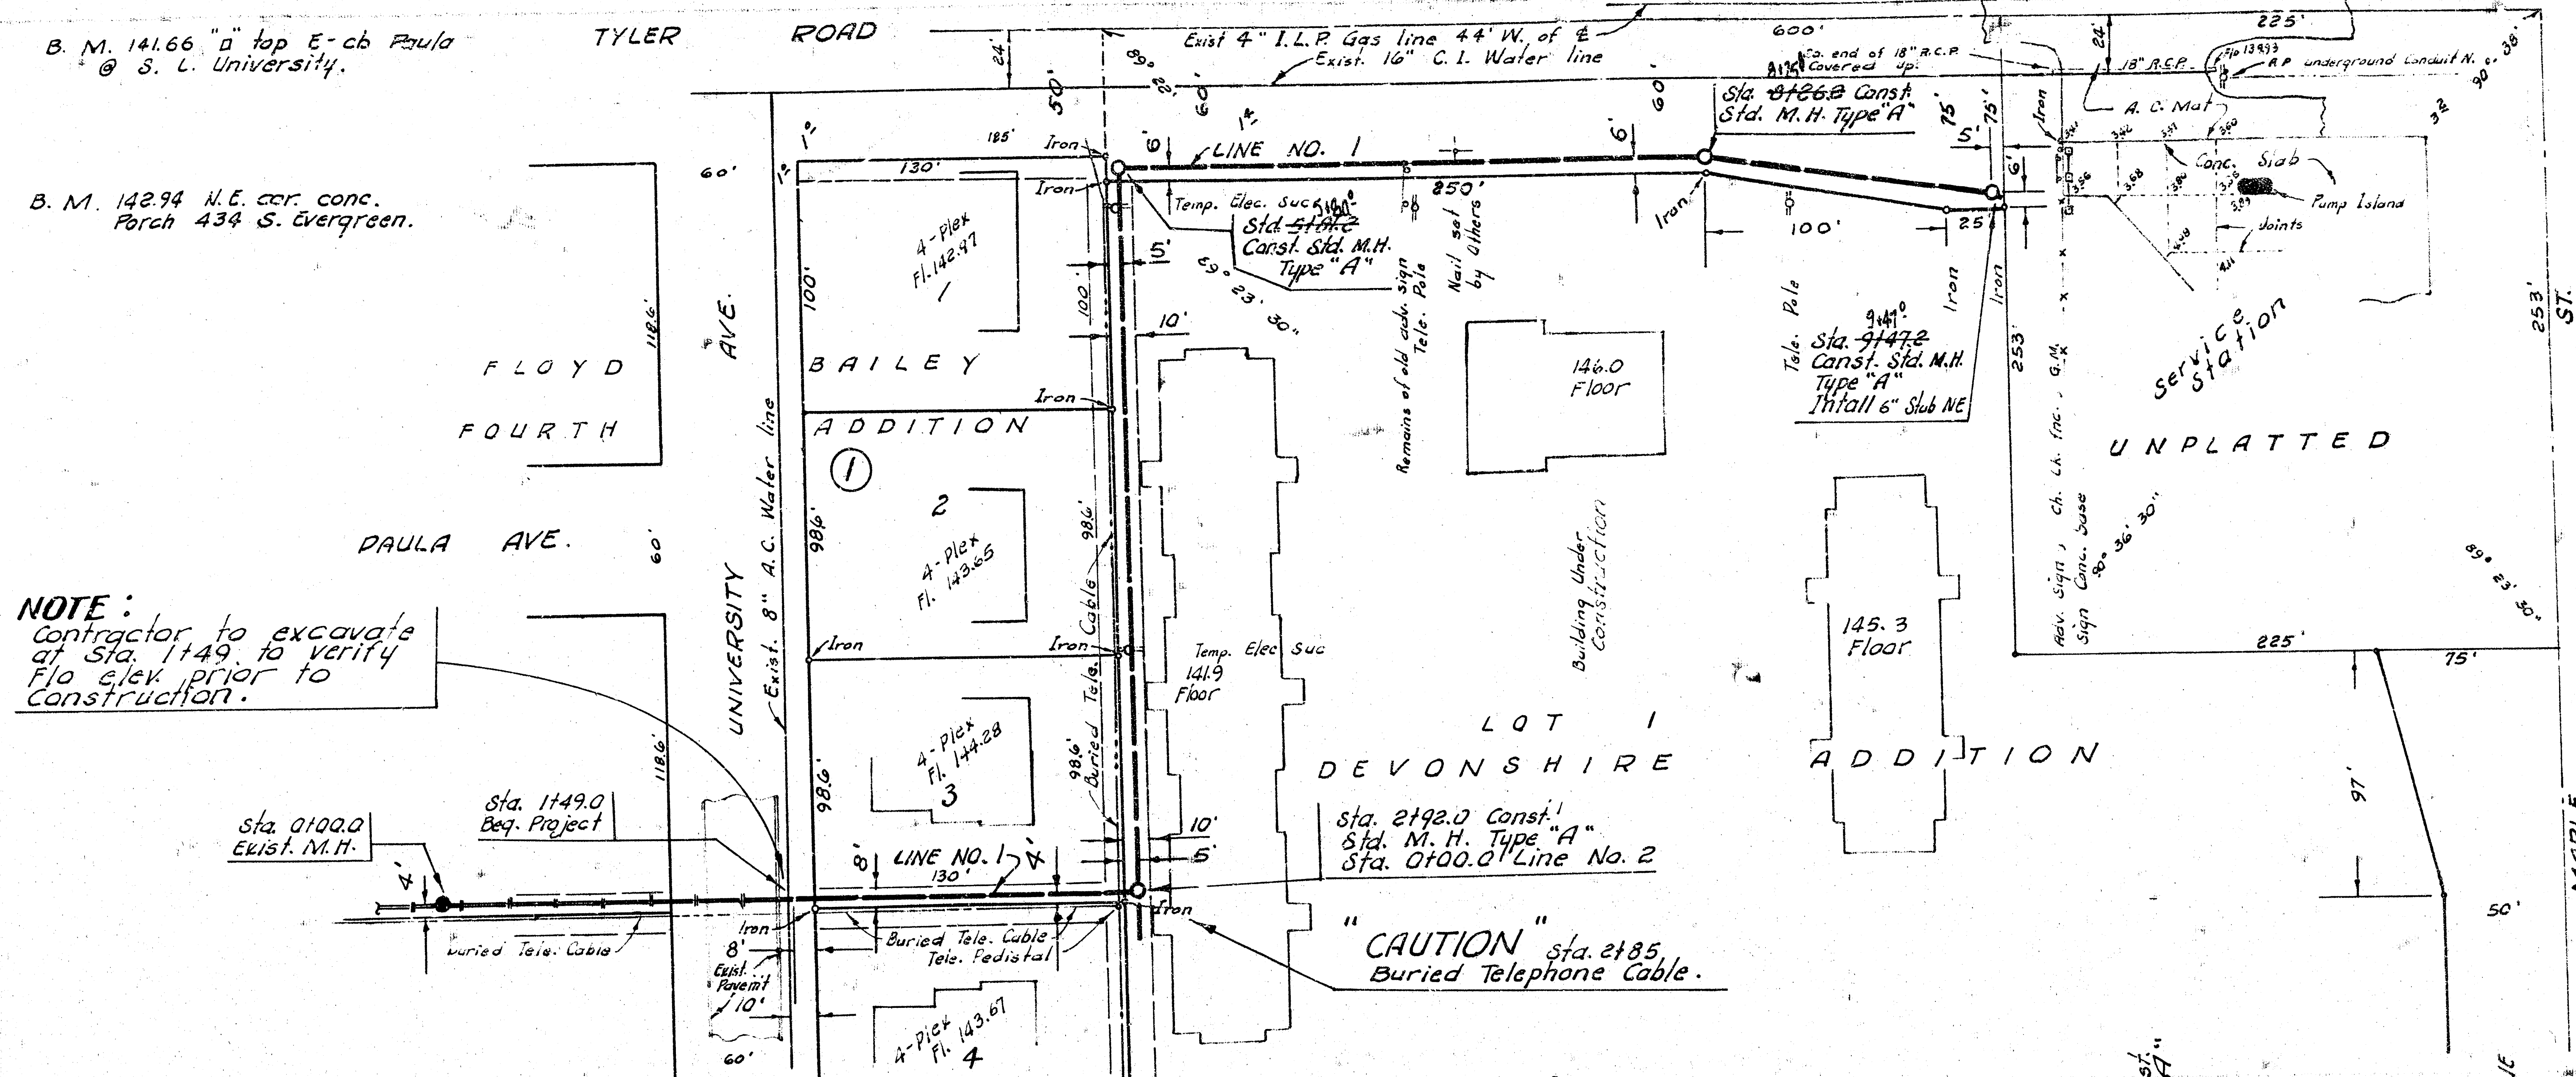

Plan Scale 1" = 40'
Profile Scale 1" = 40' Vert.



B. M. 143.53 Std. 34.2' E. and 27.2'
S. of E. Tyler and Maple.

B. M. 139.31 R. R. Spk. E. face P.P. S.W.
cor. Tyler Rd. & University.

B. M. 141.76 "a" Top S. cb University
at West end of Road 1st curve
east of Robin Road.



CAUTION
UNDERGROUND
UTILITIES

Please check with owner of
structure for location
of underground utilities.

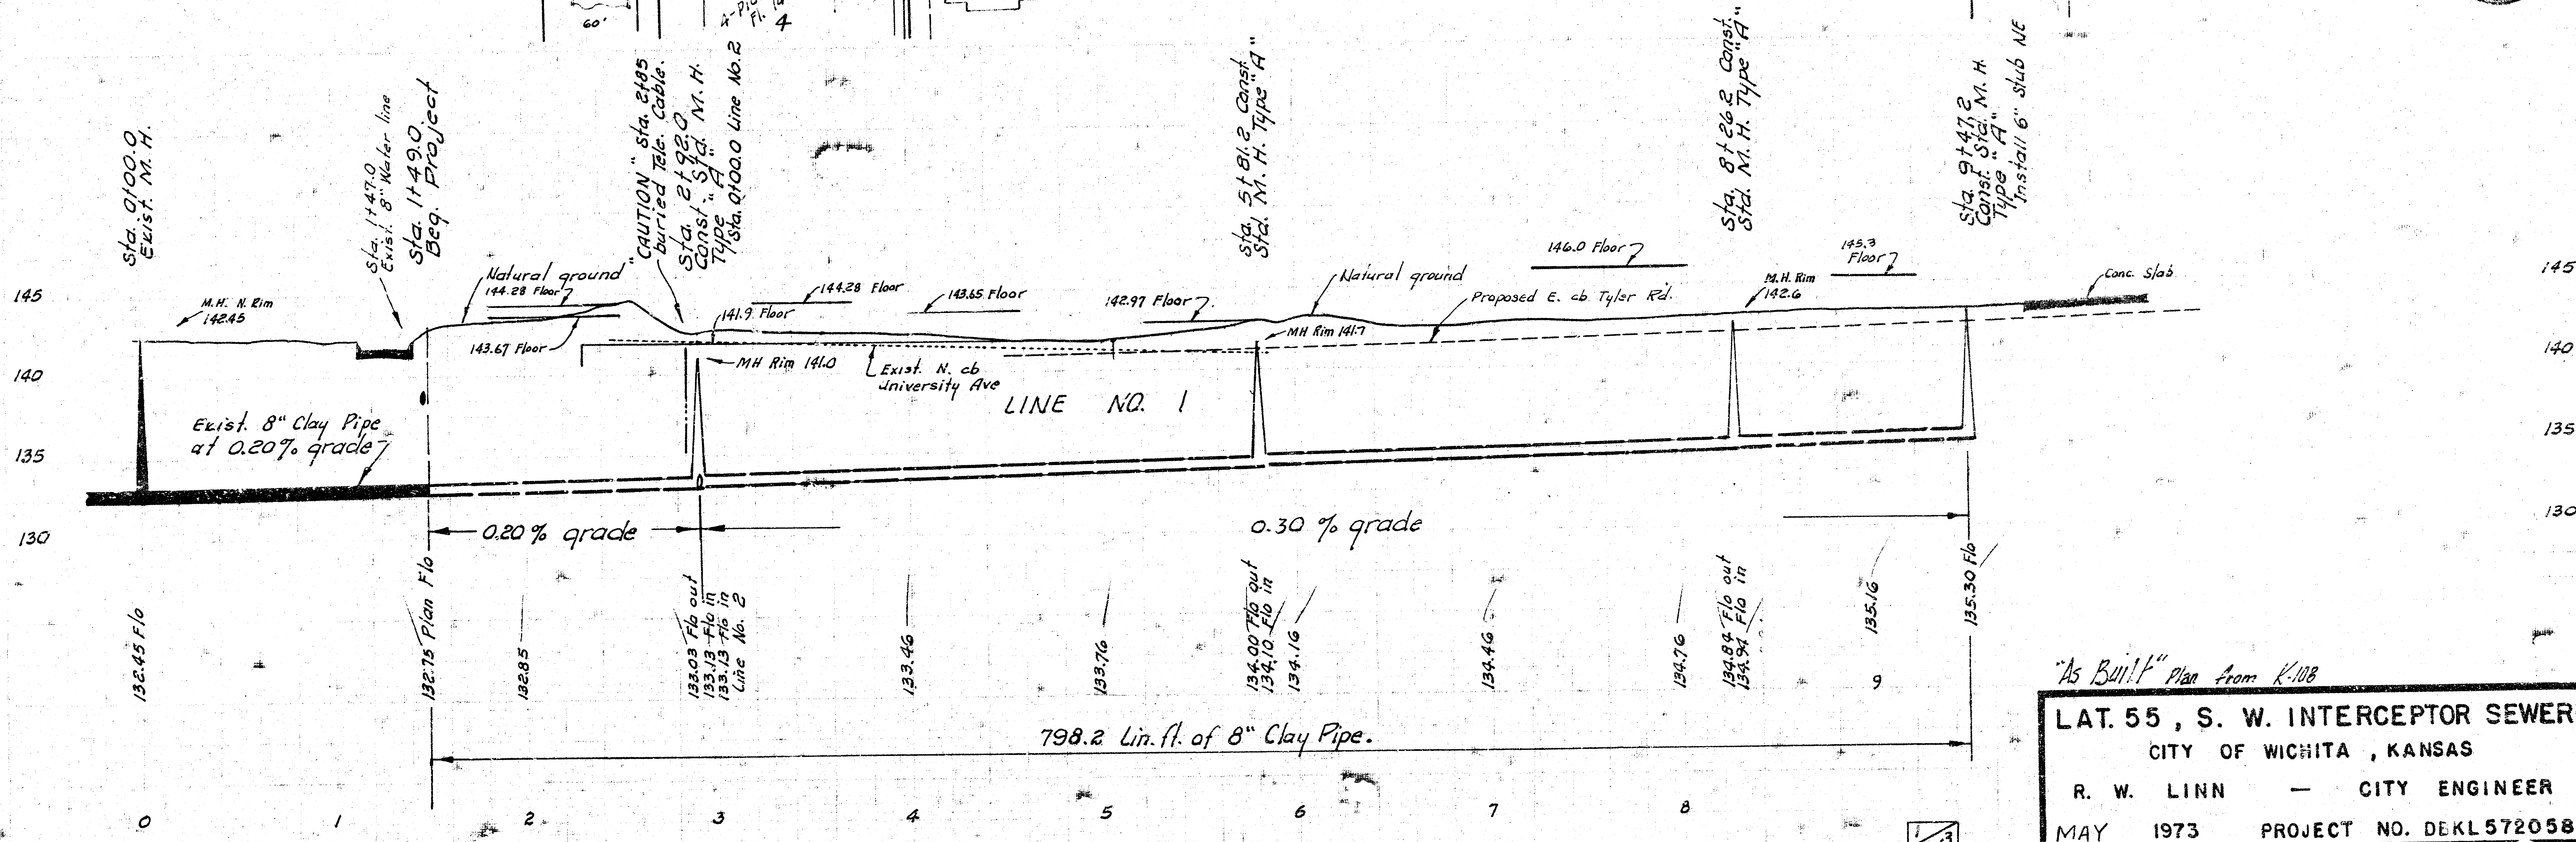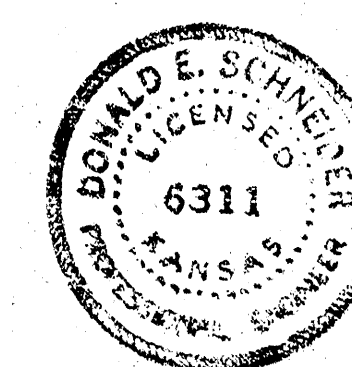

"As Built" Plan from K-108

LAT. 55, S. W. INTERCEPTOR SEWER
CITY OF WICHITA, KANSAS
R. W. LINN — CITY ENGINEER
MAY 1973 PROJECT NO. DEKL572058

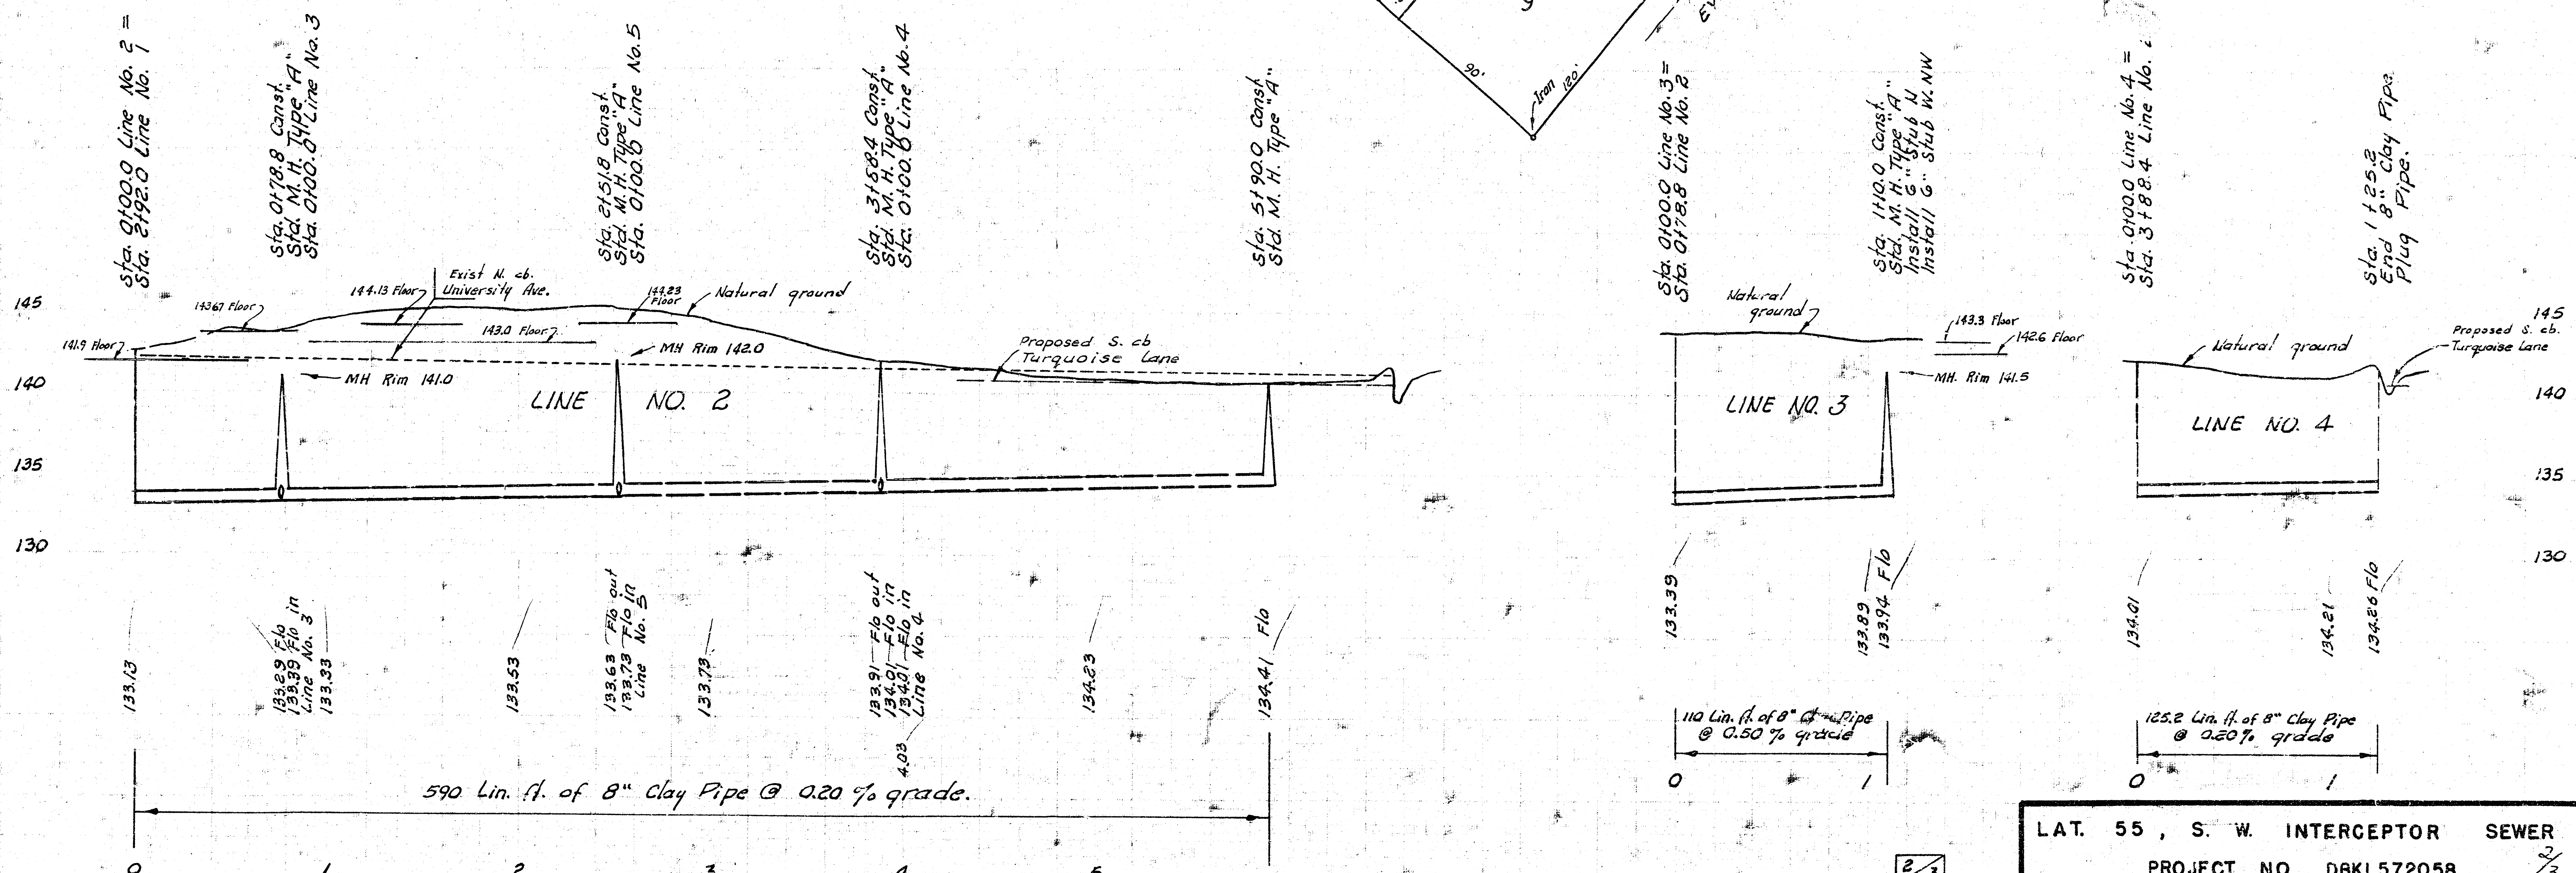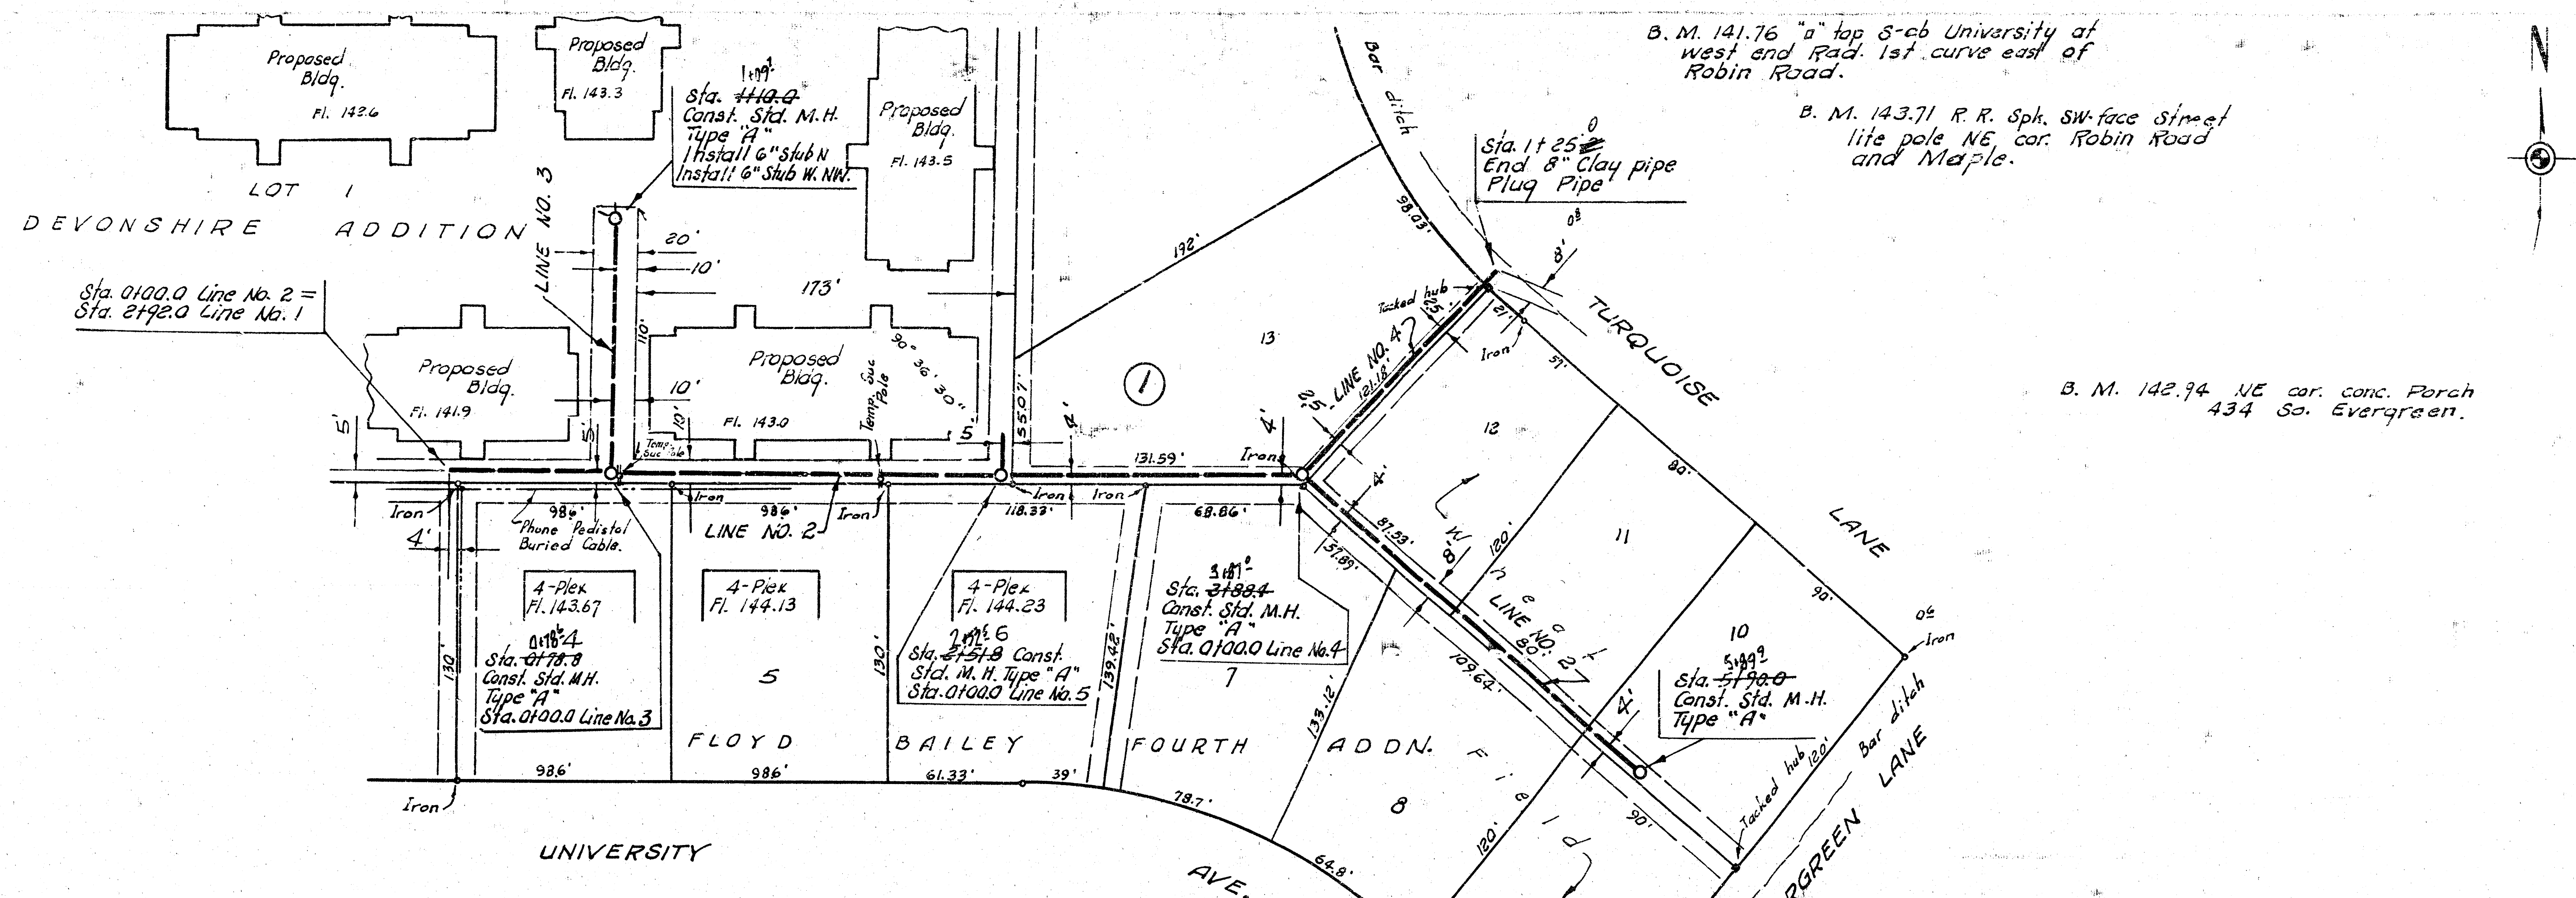

LAT. 55, S. W. INTERCEPTOR SEWER
PROJECT NO. DBKL572058

10-Eng-
1-water

